


Notes:

- Data were collected by APTIM on the following dates:
 October 29 through November 1, 2019
 November 18 through November 21, 2019
 December 17 through December 19, 2019
 March 23 through March 27, 2020
- Dashed lines represent interpreted subsurface pipelines and were not surveyed in the field.
- Elevations are in feet NAVD88.
- Background imagery is ESRI's World Imagery basemap.

Legend:

Stormwater Survey

- | | | |
|-------------------------|-----------------|---------------------------------------|
| ▲ Outfall | ● Manhole | --- Ditch |
| ▲ Outfall with Backflow | ● Pipe with Lid | - - - Unverified Subsurface Pipelines |
| ■ Culvert | ⊕ Top of Path | — Wall with Backflow |
| ● Inlet | ◇ Weir | — Weir |
| Ⓟ Pump | | ■ Retention Pond |
| | | ■ Mangrove Habitat (FWCC) |

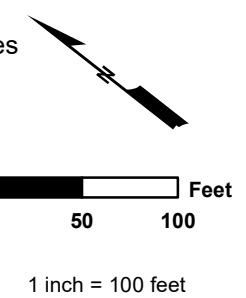

TITLE:

**Longboat Key
Stormwater Atlas
Aerial Map**



APTIM
Environmental & Infrastructure, LLC.
 2481 N. W. Boca Raton Boulevard
 Boca Raton, FL 33431
 Ph. (561) 391-8102
 Fax (561) 391-9116 COA#9317

Date: April 2020 By: HMV Comm No. : 631005068

Figure 2