




A map of the Longview area showing numbered locations 1 through 11. The map includes major roads like Winslow Pl, Longview Dr, Buttonwood Dr, Triton Bend, Neptune Av, Hwy 788, and Bay Isles Rd. A diagonal line representing the Gulf of Mexico is shown on the left.

	SURVEY CONTROL POINT
	CONCRETE MONUMENT FOUND
	IRON PIPE FOUND
	IRON ROD FOUND
	NAIL AND DISC FOUND
	UTILITY POLE (WOOD)
	UTILITY POLE (CONCRETE)
	GUY WIRE
	SANITARY MANHOLE
	CLEANOUT
	GRATE INLET
	STORMWATER MANHOLE
	MITERED END SECTION
	UTILITY MANHOLE
	GAS LINE MARKER
	FIRE HYDRANT
	WATER VALVE
	WATER METER
	BACKFLOW PREVENTER
	TRANSFORMER
	CABLE MARKER
	GAS VALVE / METER
	LIGHT POLE
	LANDSCAPE LIGHT
	BOLLARD
	SIGN
	UTILITY RISER / PEDESTAL
	CONTROL PANEL
	TRAFFIC / PEDESTRIAN CONTROL
	IRRIGATION VALVE
	GUY POLE
	SERVICE BOX (ELECTRIC)
	SERVICE BOX (CABLE)
	SERVICE BOX (TELEPHONE)
	MAILBOX
	FIBER OPTIC HANDHOLE
	STREET LIGHT HANDHOLE
	PROPOSED STREET LIGHT
	EXISTING STREET POST LIGHT
	EXISTING STREET POST LIGHT WITH STREET SIGN
	EXISTING MASTARM STREET LIGHT

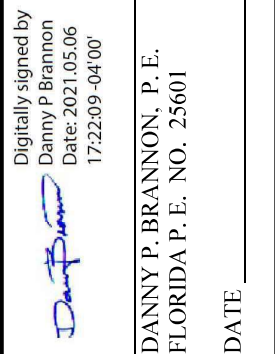

Brannon & Gillespie, LLC
Consulting Engineers
631 US Highway 1, Suite 301
North Palm Beach, Florida 33408
(561) 847-4435 CA# 6784

of CK Sheets

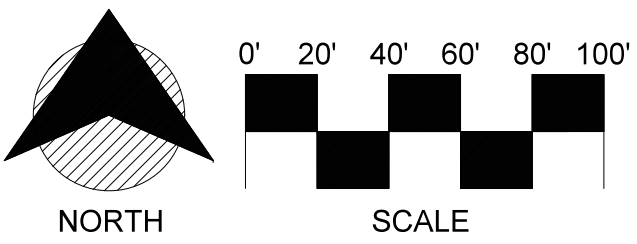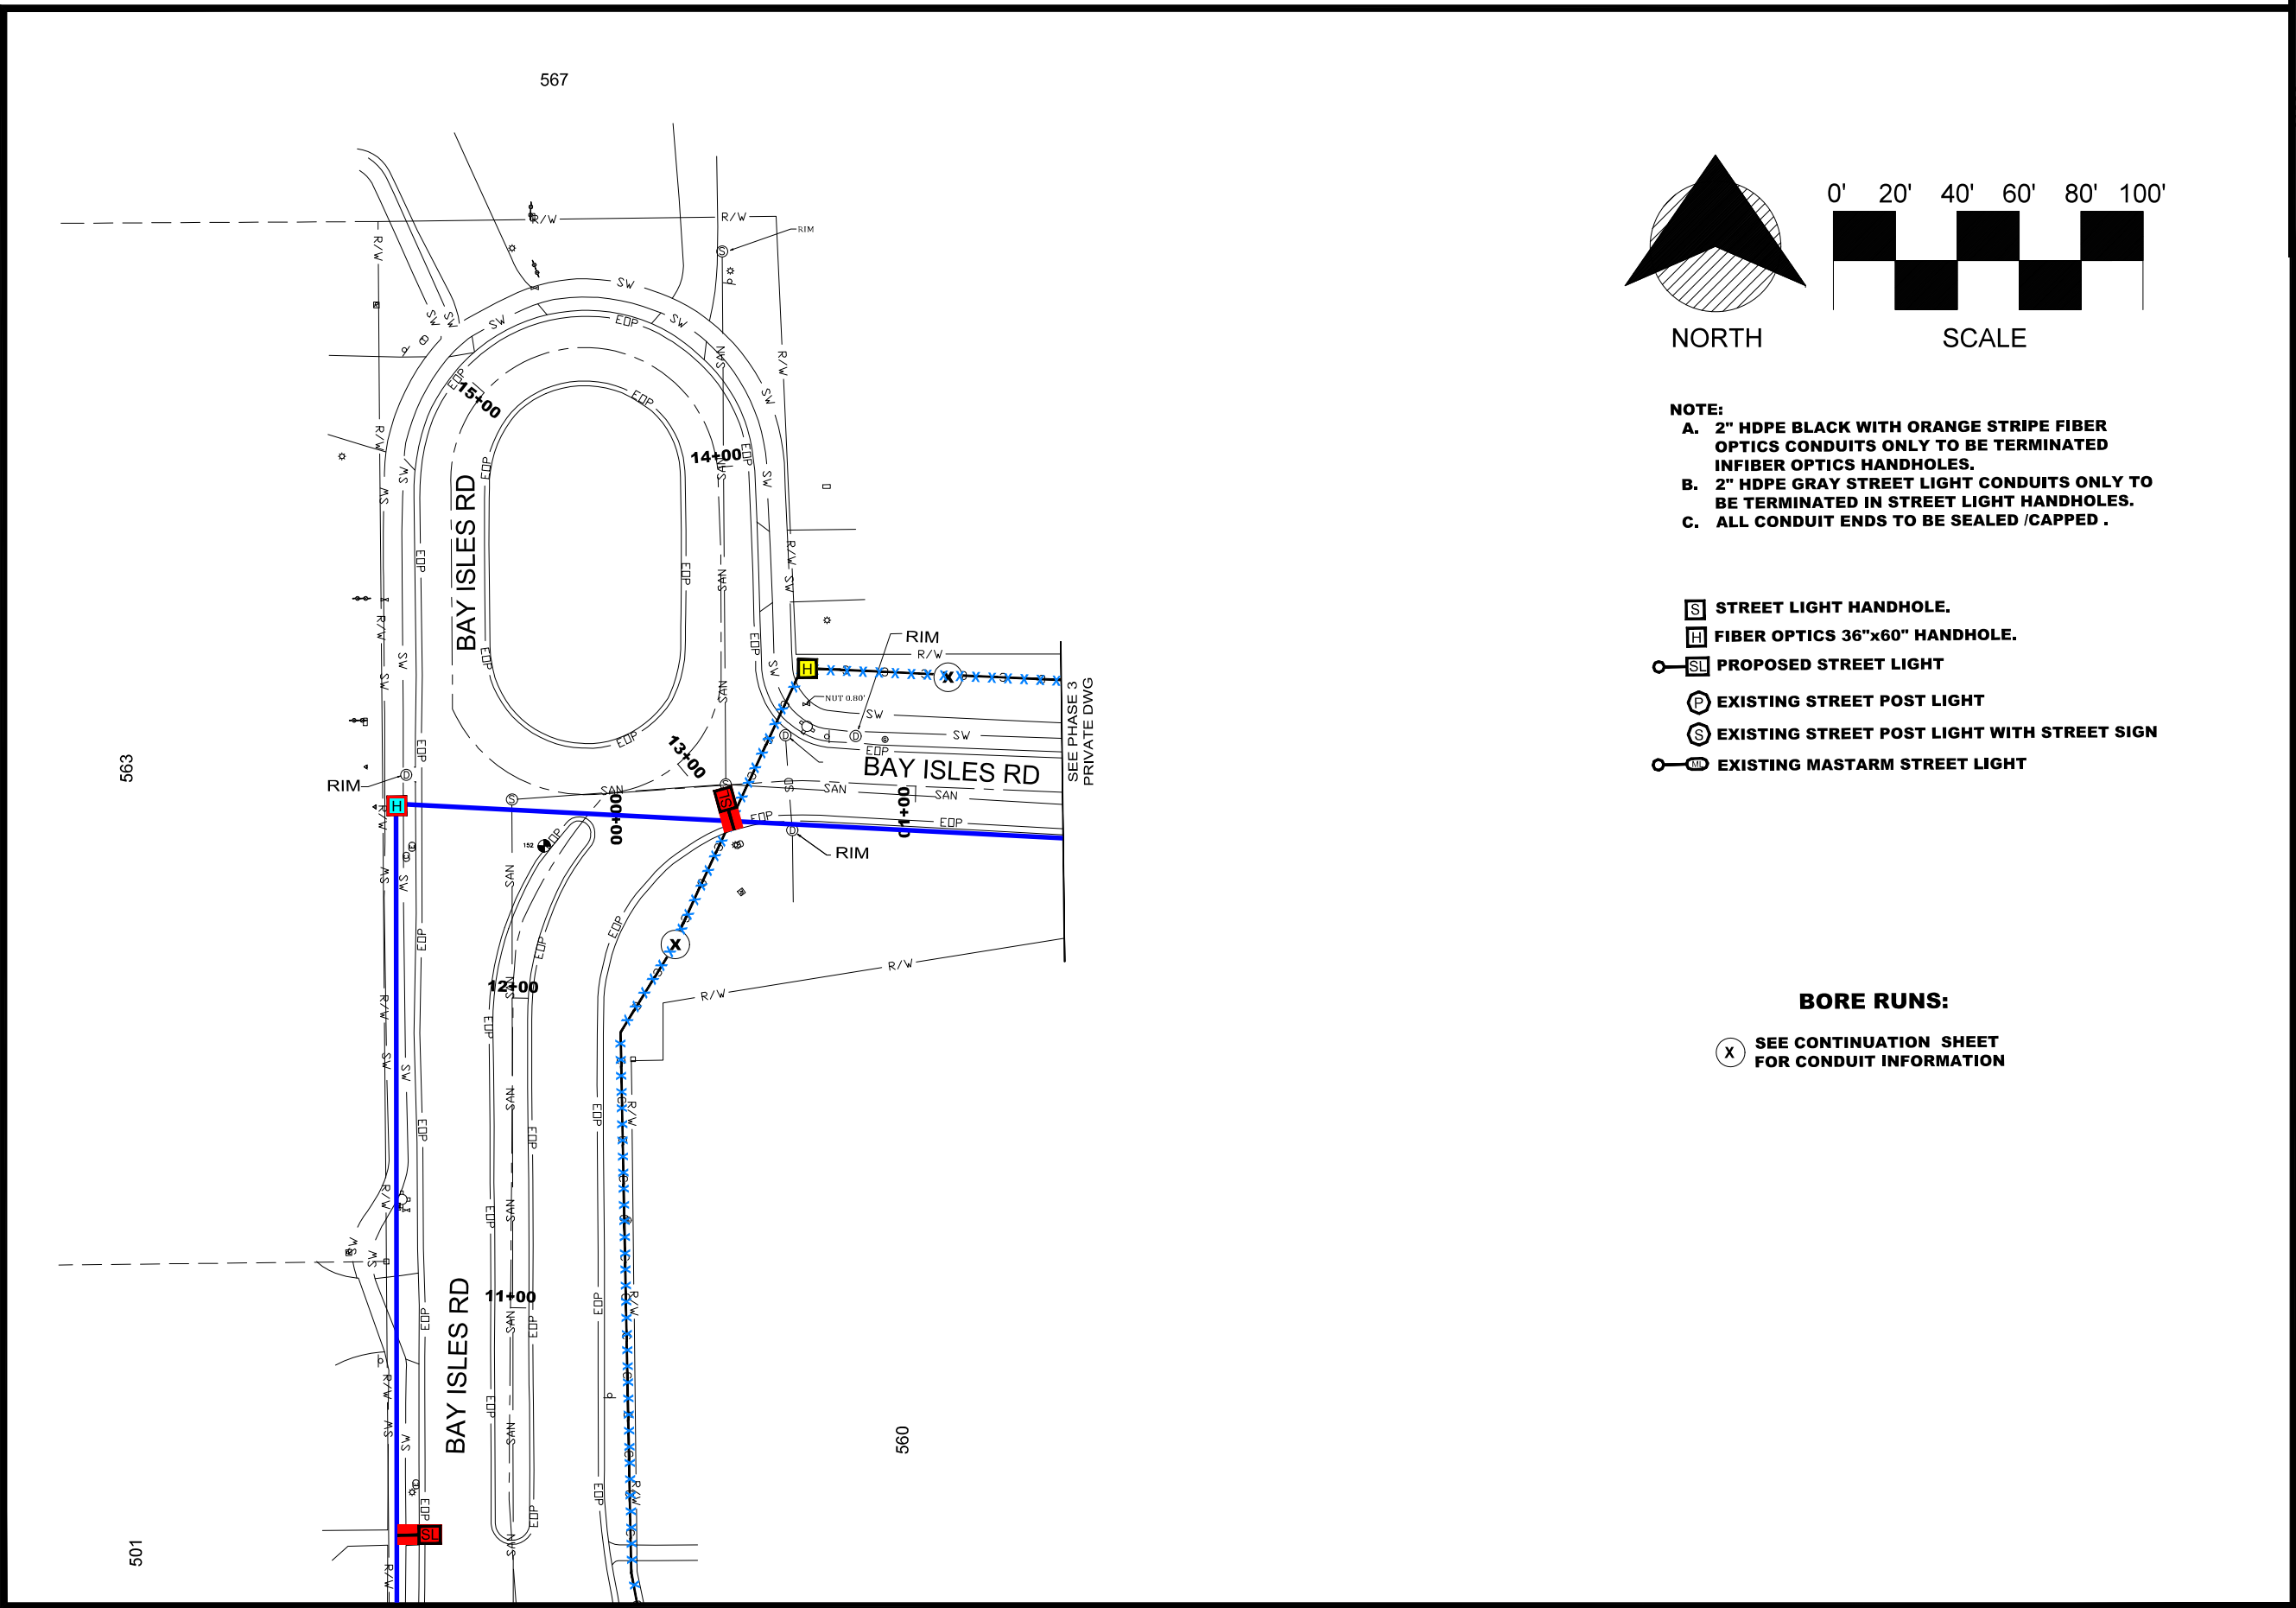


- NOTE:**
- A. 2" HDPE BLACK WITH ORANGE STRIPE FIBER OPTICS CONDUITS ONLY TO BE TERMINATED IN FIBER OPTICS HANDHOLES.
 - B. 2" HDPE GRAY STREET LIGHT CONDUITS ONLY TO BE TERMINATED IN STREET LIGHT HANDHOLES.
 - C. ALL CONDUIT ENDS TO BE SEALED /CAPPED .

- [S] STREET LIGHT HANDHOLE.
- [H] FIBER OPTICS 36"x60" HANDHOLE.
- [SL] PROPOSED STREET LIGHT
- [P] EXISTING STREET POST LIGHT
- [S] EXISTING STREET POST LIGHT WITH STREET SIGN
- [ML] EXISTING MASTARM STREET LIGHT

BORE RUNS:

[X] SEE CONTINUATION SHEET FOR CONDUIT INFORMATION

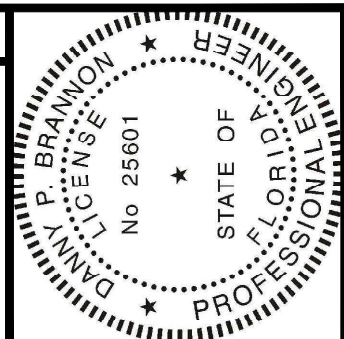


Digitally signed by
Danny P Brannon
Date: 2021.05.06
17:22:09 -04'00'

DANNY P. BRANNON, P.E.
FLORIDA P. E. NO. 25601

DATE

Town of Longboat Key

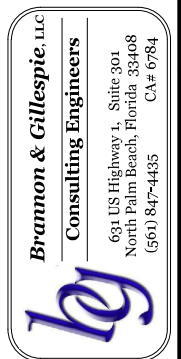


DRAWINGS FOR:
**FIBER OPTIC AND STREET LIGHTING UTILITY
PHASE 3 CONSTRUCTION**
LONGBOAT KEY, FLORIDA



Date:	12/01/2020
Scale:	AS NOTED
Drawn:	DPB
Checked:	DPB
Job #	2014-LBK
Sheet	C1
of	Sheets

MATCHLINE-STA 10+04
FOR CONTINUATION SEE SHEET 1

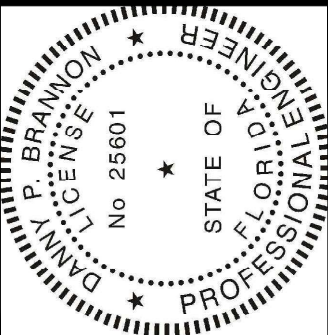


Digitally signed by
Danny P. Brannon
Date: 2021.05.06
17:22:09 -04'00'

Danny Brannon

DANNY P. BRANNON, P.E.
FLORIDA P. E. NO. 25601

DATE

Town of Longboat Key

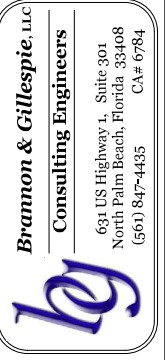

DRAWINGS FOR:
**FIBER OPTIC AND STREET
LIGHTING UTILITY
PHASE 3 CONSTRUCTION**
LONGBOAT KEY, FLORIDA




Date: 12/01/2020
Scale: AS NOTED
Drawn: DPB
Checked: DPB
Job # 2014-LBK

Sheet

C2

of Sheets

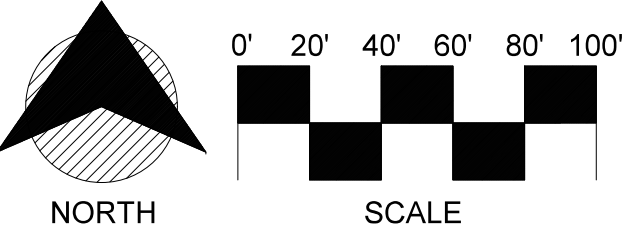


- NOTE:**
- A. 2" HDPE BLACK WITH ORANGE STRIPE FIBER OPTICS CONDUITS ONLY TO BE TERMINATED IN FIBER OPTICS HANDHOLES.
 - B. 2" HDPE GRAY STREET LIGHT CONDUITS ONLY TO BE TERMINATED IN STREET LIGHT HANDHOLES.
 - C. ALL CONDUIT ENDS TO BE SEALED /CAPPED .

- [S] STREET LIGHT HANDHOLE.
- [H] FIBER OPTICS 36"x60" HANDHOLE.
- [SL] PROPOSED STREET LIGHT
- [P] EXISTING STREET POST LIGHT
- [S] EXISTING STREET POST LIGHT WITH STREET SIGN
- [ML] EXISTING MASTARM STREET LIGHT


BORE RUNS:

- 96 948' (1) 2" HDPE FIBER OPTICS CONDUITS
- X SEE CONTINUATION SHEET FOR CONDUIT INFORMATION

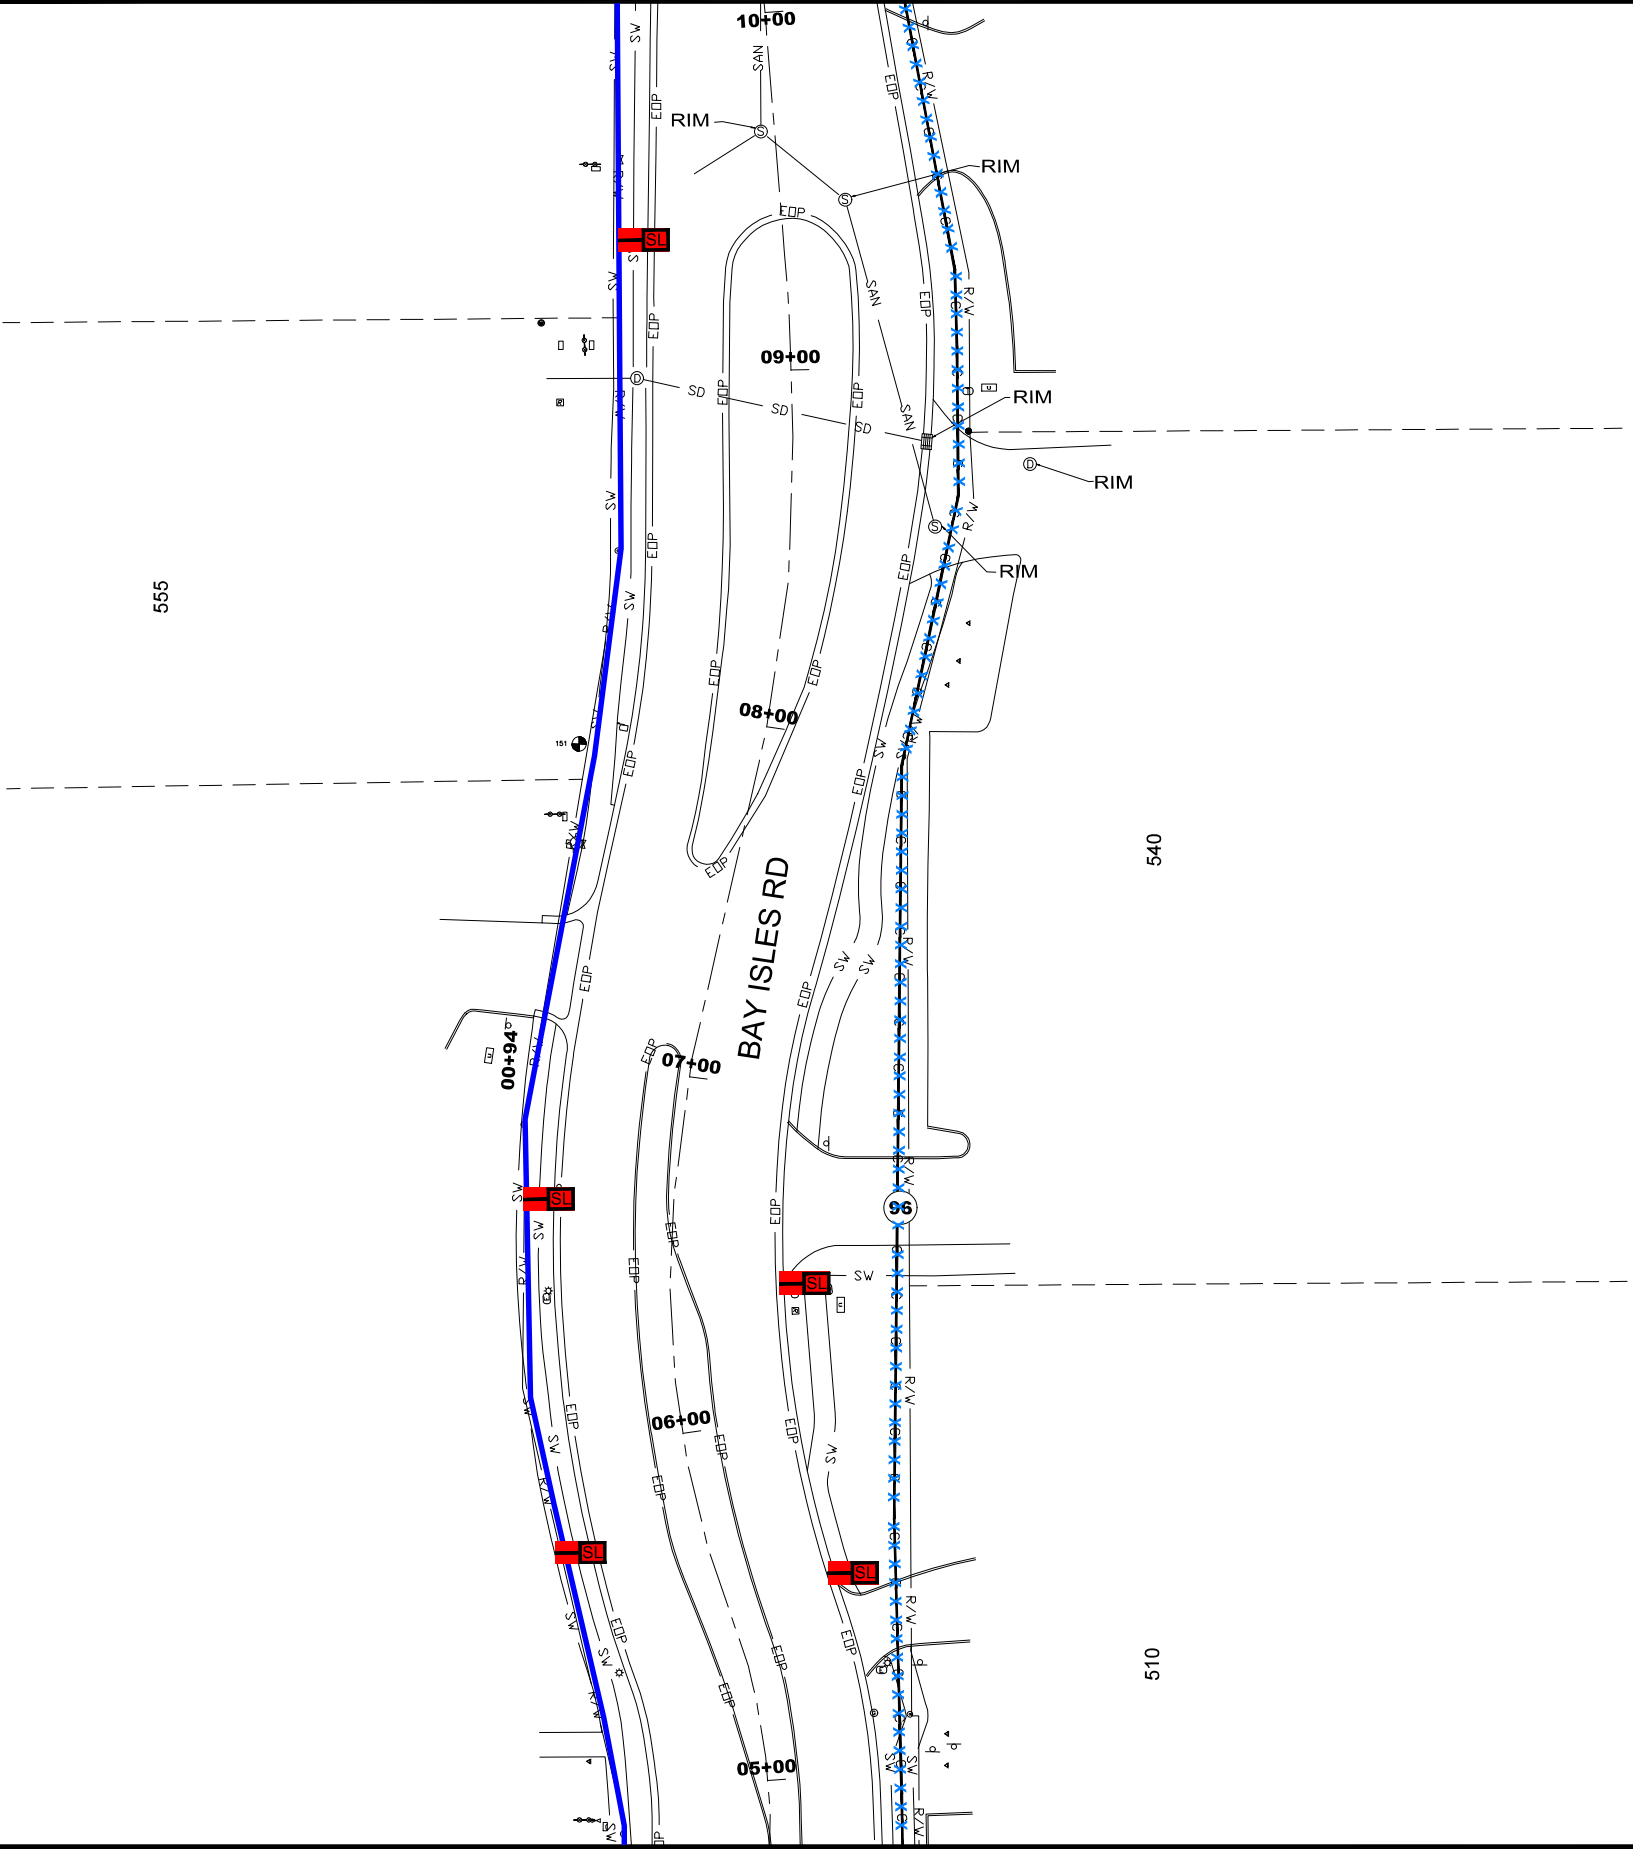


MATCHLINE-STA 04+81
FOR CONTINUATION SEE SHEET 3

MATCHLINE-STA 04+81
FOR CONTINUATION SEE SHEET 2

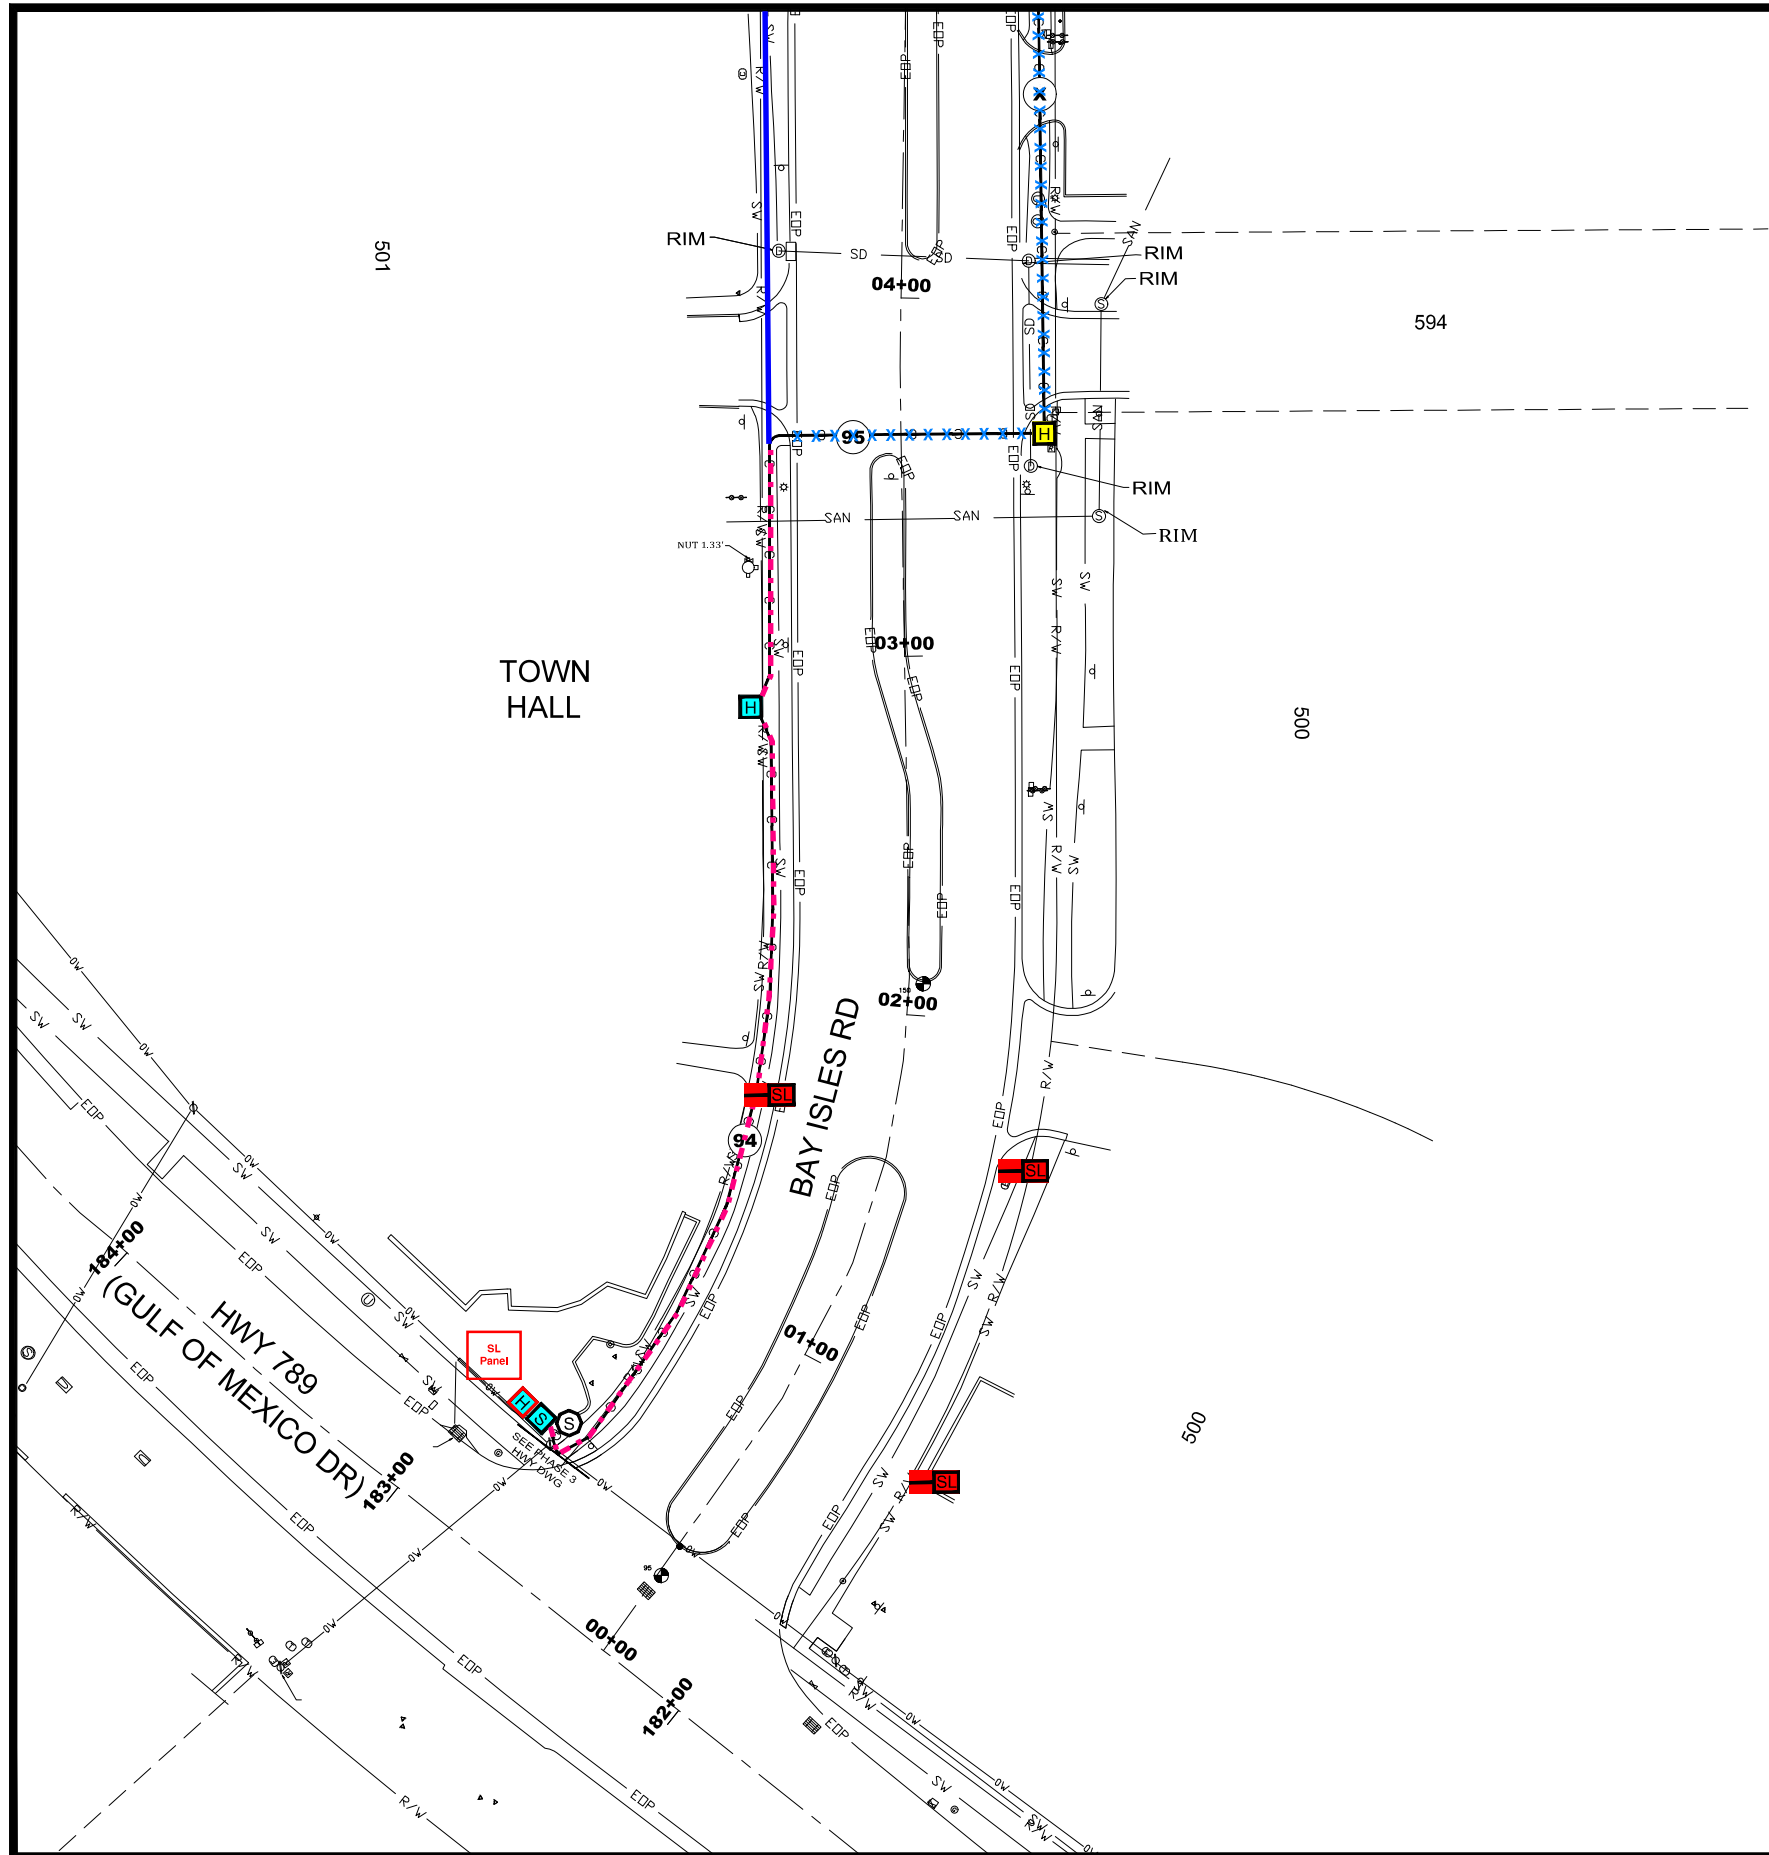


- NOTE:**
- A. 2" HDPE BLACK WITH ORANGE STRIPE FIBER OPTICS CONDUITS ONLY TO BE TERMINATED IN FIBER OPTICS HANDHOLES.
 - B. 2" HDPE GRAY STREET LIGHT CONDUITS ONLY TO BE TERMINATED IN STREET LIGHT HANDHOLES.
 - C. ALL CONDUIT ENDS TO BE SEALED /CAPPED .

- [S] STREET LIGHT HANDHOLE.
- [H] FIBER OPTICS 36"x60" HANDHOLE.
- [SL] PROPOSED STREET LIGHT
- [P] EXISTING STREET POST LIGHT
- [S] EXISTING STREET POST LIGHT WITH STREET SIGN
- [M] EXISTING MASTARM STREET LIGHT

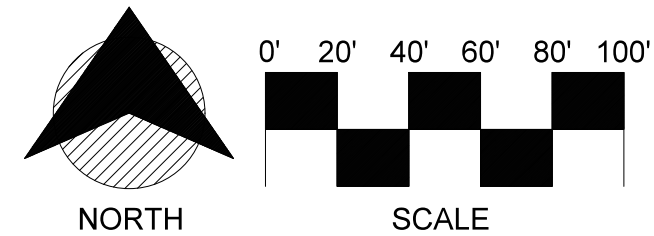

BORE RUNS:

- 94 225' (2) 2" HDPE FIBER OPTICS CONDUITS
- 95 149' (1) 2" HDPE FIBER OPTICS CONDUITS
- X SEE CONTINUATION SHEET FOR CONDUIT INFORMATION

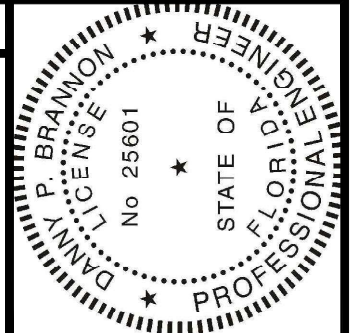


Digitally signed by
Danny P Brannon
Date: 2021.05.06
17:22:09 -04'00'

DANNY P. BRANNON, P.E.
FLORIDA P. E. NO. 25601

DATE

Town of Longboat Key

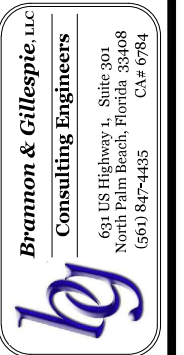


DRAWINGS FOR:
**FIBER OPTIC AND STREET LIGHTING UTILITY
PHASE 3 CONSTRUCTION**
LONGBOAT KEY, FLORIDA



Date:	12/01/2020
Scale:	AS NOTED
Drawn:	DPB
Checked:	DPB
Job #	2014-LBK
Sheet	C3

of Sheets

MATCHLINE-STA 15+52
FOR CONTINUATION SEE SHEET 5

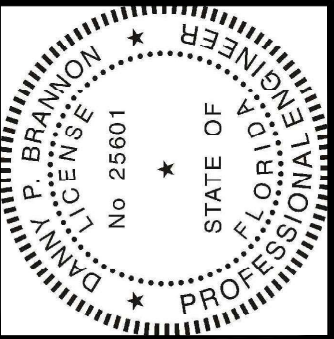


Digitally signed by
Danny P. Brannon
Date: 2021.05.06
17:22:09 -04'00'

Danny Brannon

DANNY P. BRANNON, P. E.
FLORIDA P. E. NO. 25601

DATE

Town of Longboat Key

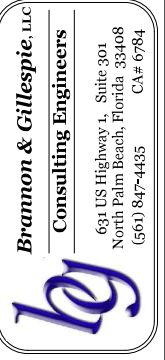

DRAWINGS FOR:
**FIBER OPTIC AND STREET
LIGHTING UTILITY
PHASE 3 CONSTRUCTION**
LONGBOAT KEY, FLORIDA



Date:	12/01/2020
Scale:	AS NOTED
Drawn:	DPB
Checked:	DPB
Job #	2014-LBK

Sheet



C4

of Sheets


BORE RUNS:
(X) SEE CONTINUATION SHEET
FOR CONDUIT INFORMATION

- NOTE:**
- A. 2" HDPE BLACK WITH ORANGE STRIPE FIBER OPTICS CONDUITS ONLY TO BE TERMINATED IN FIBER OPTICS HANDHOLES.
 - B. 2" HDPE GRAY STREET LIGHT CONDUITS ONLY TO BE TERMINATED IN STREET LIGHT HANDHOLES.
 - C. ALL CONDUIT ENDS TO BE SEALED /CAPPED .

- [S] STREET LIGHT HANDHOLE.
- [H] FIBER OPTICS 36"x60" HANDHOLE.
- [SL] PROPOSED STREET LIGHT
- [P] EXISTING STREET POST LIGHT
- [S] EXISTING STREET POST LIGHT WITH STREET SIGN
- [ML] EXISTING MASTARM STREET LIGHT

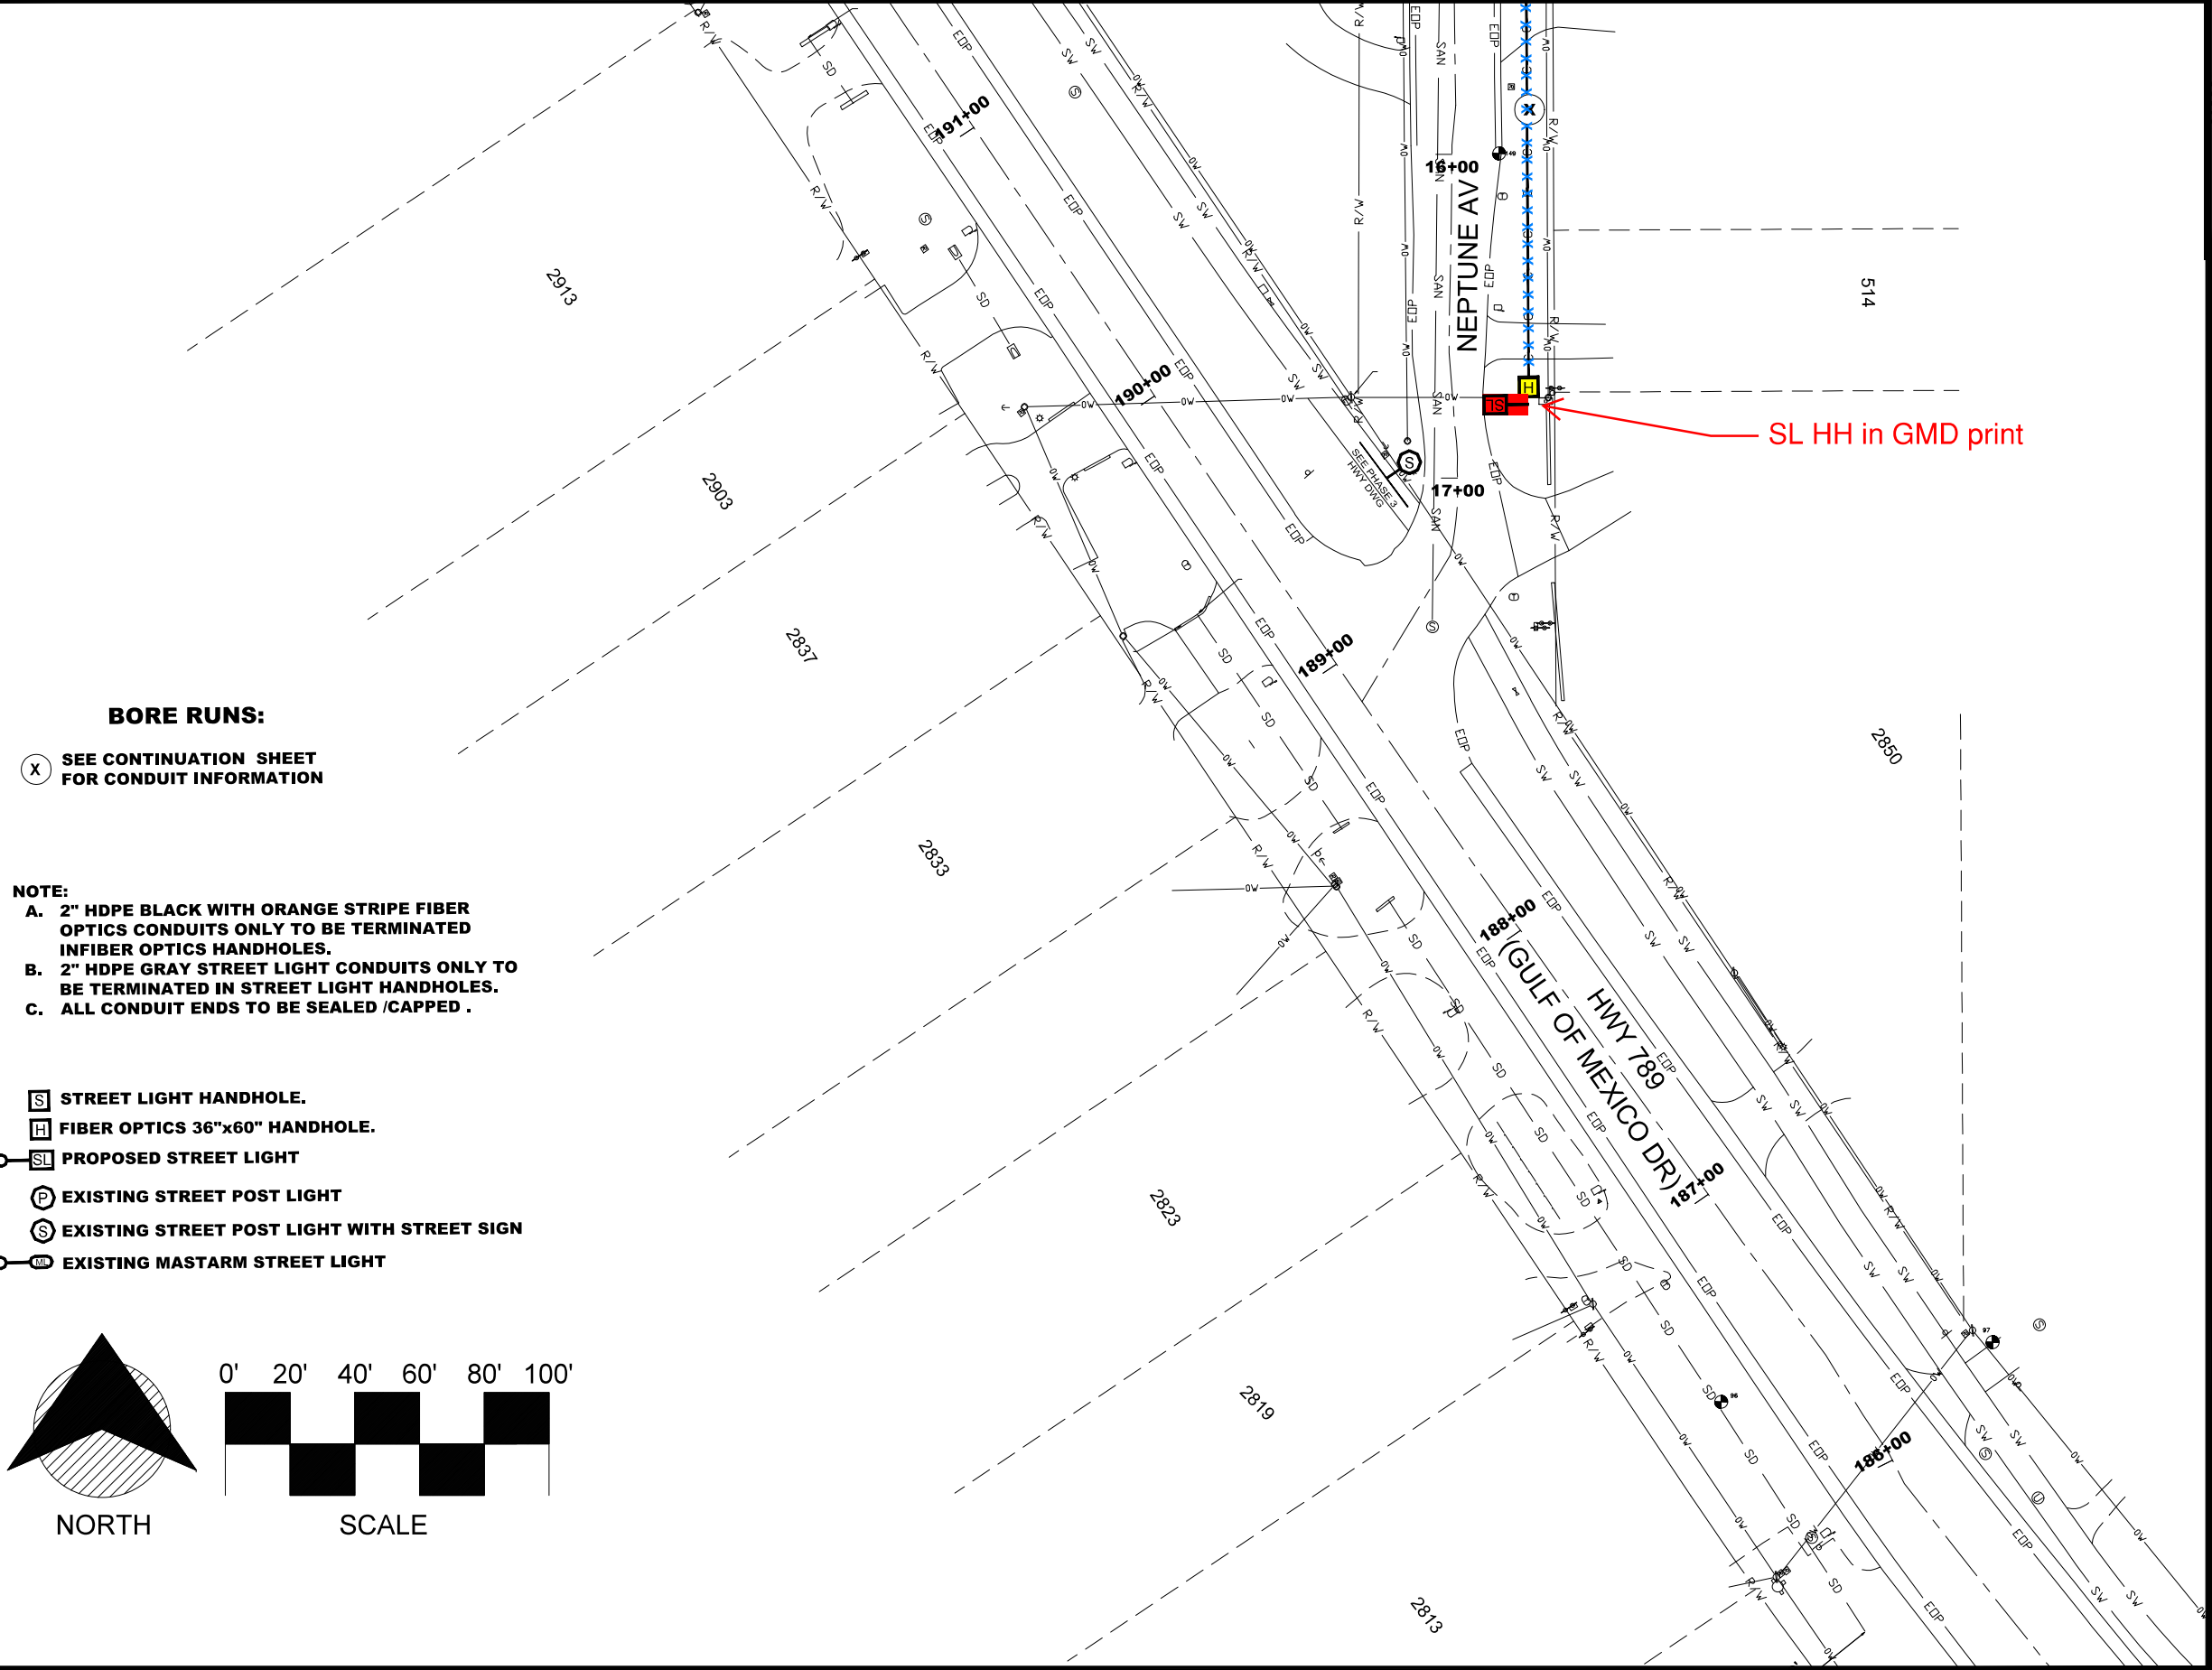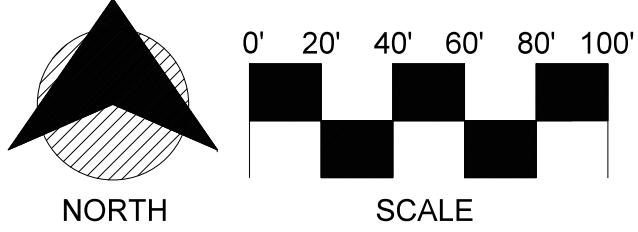

MATCHLINE-STA 10+36
FOR CONTINUATION SEE SHEET 6

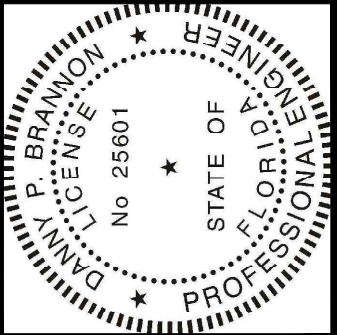


Digitally signed by
Danny P. Brannon
Date: 2021.05.06
17:22:09 -04'00'

Danny Brannon

DANNY P. BRANNON, P.E.
FLORIDA P.E. NO. 25601

DATE

Town of Longboat Key

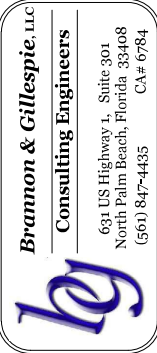

DRAWINGS FOR:
**FIBER OPTIC AND STREET
LIGHTING UTILITY
PHASE 3 CONSTRUCTION**
LONGBOAT KEY, FLORIDA



Date: 12/01/2020
Scale: AS NOTED
Drawn: DPB
Checked: DPB
Job # 2014-LBK
Sheet

C5


of Sheets

BORE RUNS:


(X) SEE CONTINUATION SHEET
FOR CONDUIT INFORMATION

- NOTE:
- A. 2" HDPE BLACK WITH ORANGE STRIPE FIBER OPTICS CONDUITS ONLY TO BE TERMINATED INFIBER OPTICS HANDHOLES.
 - B. 2" HDPE GRAY STREET LIGHT CONDUITS ONLY TO BE TERMINATED IN STREET LIGHT HANDHOLES.
 - C. ALL CONDUIT ENDS TO BE SEALED /CAPPED .

- [S] STREET LIGHT HANDHOLE.
- [H] FIBER OPTICS 36"x60" HANDHOLE.
- [SL] PROPOSED STREET LIGHT
- [P] EXISTING STREET POST LIGHT
- [S] EXISTING STREET POST LIGHT WITH STREET SIGN
- [M] EXISTING MASTARM STREET LIGHT

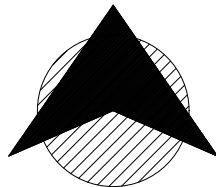


NORTH

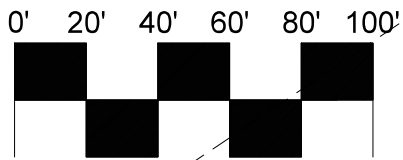


SCALE

MATCHLINE-STA 15+52
FOR CONTINUATION SEE SHEET 4


MATCHLINE-STA 02+63
FOR CONTINUATION SEE SHEET 7

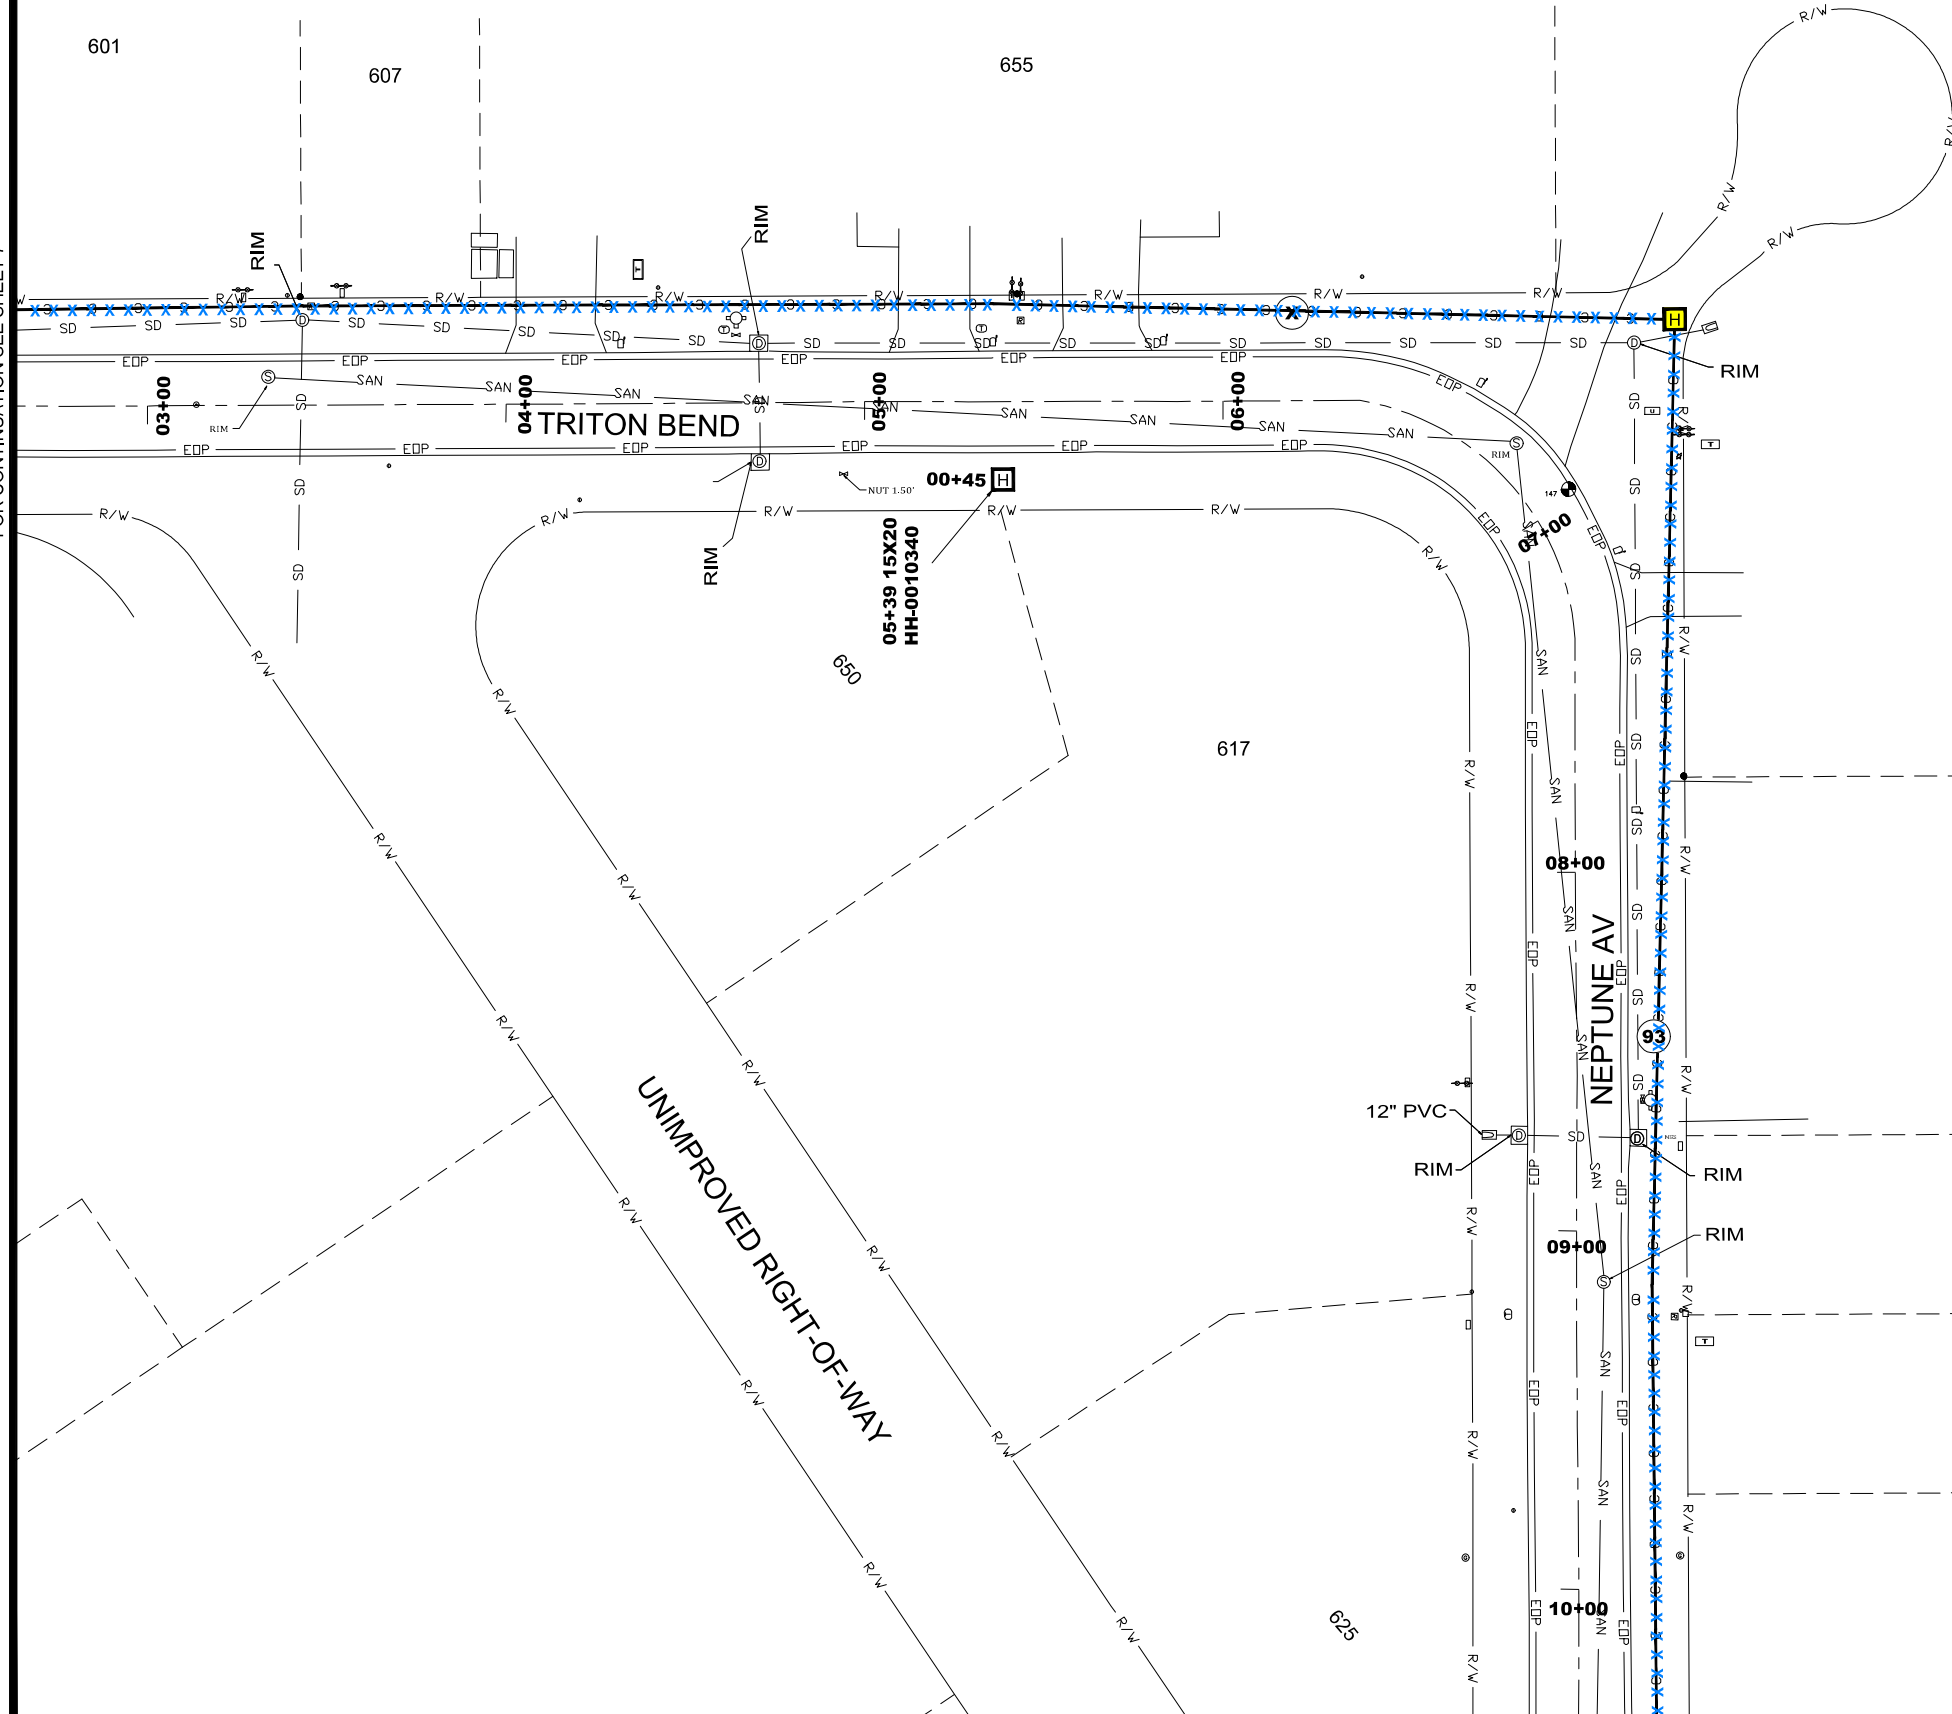

MATCHLINE-STA 10+36
FOR CONTINUATION SEE SHEET 5

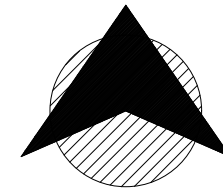

NORTH

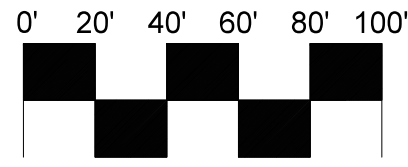

SCALE


NOTE:

- A. 2" HDPE BLACK WITH ORANGE STRIPE FIBER OPTICS CONDUITS ONLY TO BE TERMINATED INFIBER OPTICS HANDHOLES.
- B. 2" HDPE GRAY STREET LIGHT CONDUITS ONLY TO BE TERMINATED IN STREET LIGHT HANDHOLES.
- C. ALL CONDUIT ENDS TO BE SEALED /CAPPED .

- [S] STREET LIGHT HANDHOLE.
- [H] FIBER OPTICS 36"x60" HANDHOLE.
- [SL] PROPOSED STREET LIGHT
- [P] EXISTING STREET POST LIGHT
- [S] EXISTING STREET POST LIGHT WITH STREET SIGN
- [ML] EXISTING MASTARM STREET LIGHT

BORE RUNS:

- (93) 1020' (1) 2" HDPE FIBER OPTICS CONDUITS
- (X) SEE CONTINUATION SHEET FOR CONDUIT INFORMATION

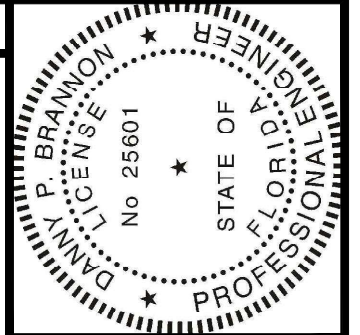


Digitally signed by
Danny P Brannon
Date: 2021.05.06
17:22:09 -04'00'

Danny Brannon

DANNY P. BRANNON, P.E.
FLORIDA P. E. NO. 25601

DATE

Town of Longboat Key

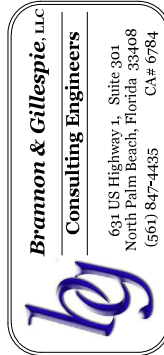

DRAWINGS FOR:
**FIBER OPTIC AND STREET
LIGHTING UTILITY
PHASE 3 CONSTRUCTION**
LONGBOAT KEY, FLORIDA




Date: 12/01/2020
Scale: AS NOTED
Drawn: DPB
Checked: DPB
Job # 2014-LBK

Sheet

C6

of Sheets

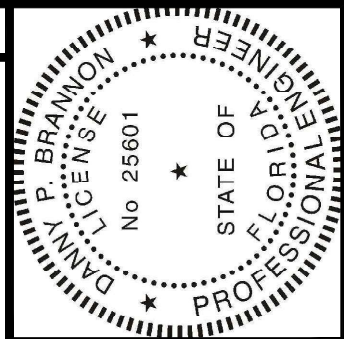

MATCHLINE-STA 02+63
FOR CONTINUATION SEE SHEET 6

Digitally signed by
Danny P Brannon
Date: 2021.05.06
17:22:09 -04'00'


DANNY P. BRANNON, P.E.
FLORIDA P.E. NO. 25601
DATE

Town of Longboat Key

Brannon & Gillespie, LLC
Consulting Engineers
631 US Highway 1, Suite 301
North Palm Beach, Florida 33408
(561) 847-4435 CA# 6784

DRAWINGS FOR:
**FIBER OPTIC AND STREET
LIGHTING UTILITY
PHASE 3 CONSTRUCTION**
LONGBOAT KEY, FLORIDA

Date:	12/01/2020
Scale:	AS NOTED
Drawn:	DPB
Checked:	DPB
Job #	2014-LBK
Sheet	C7
of	Sheets

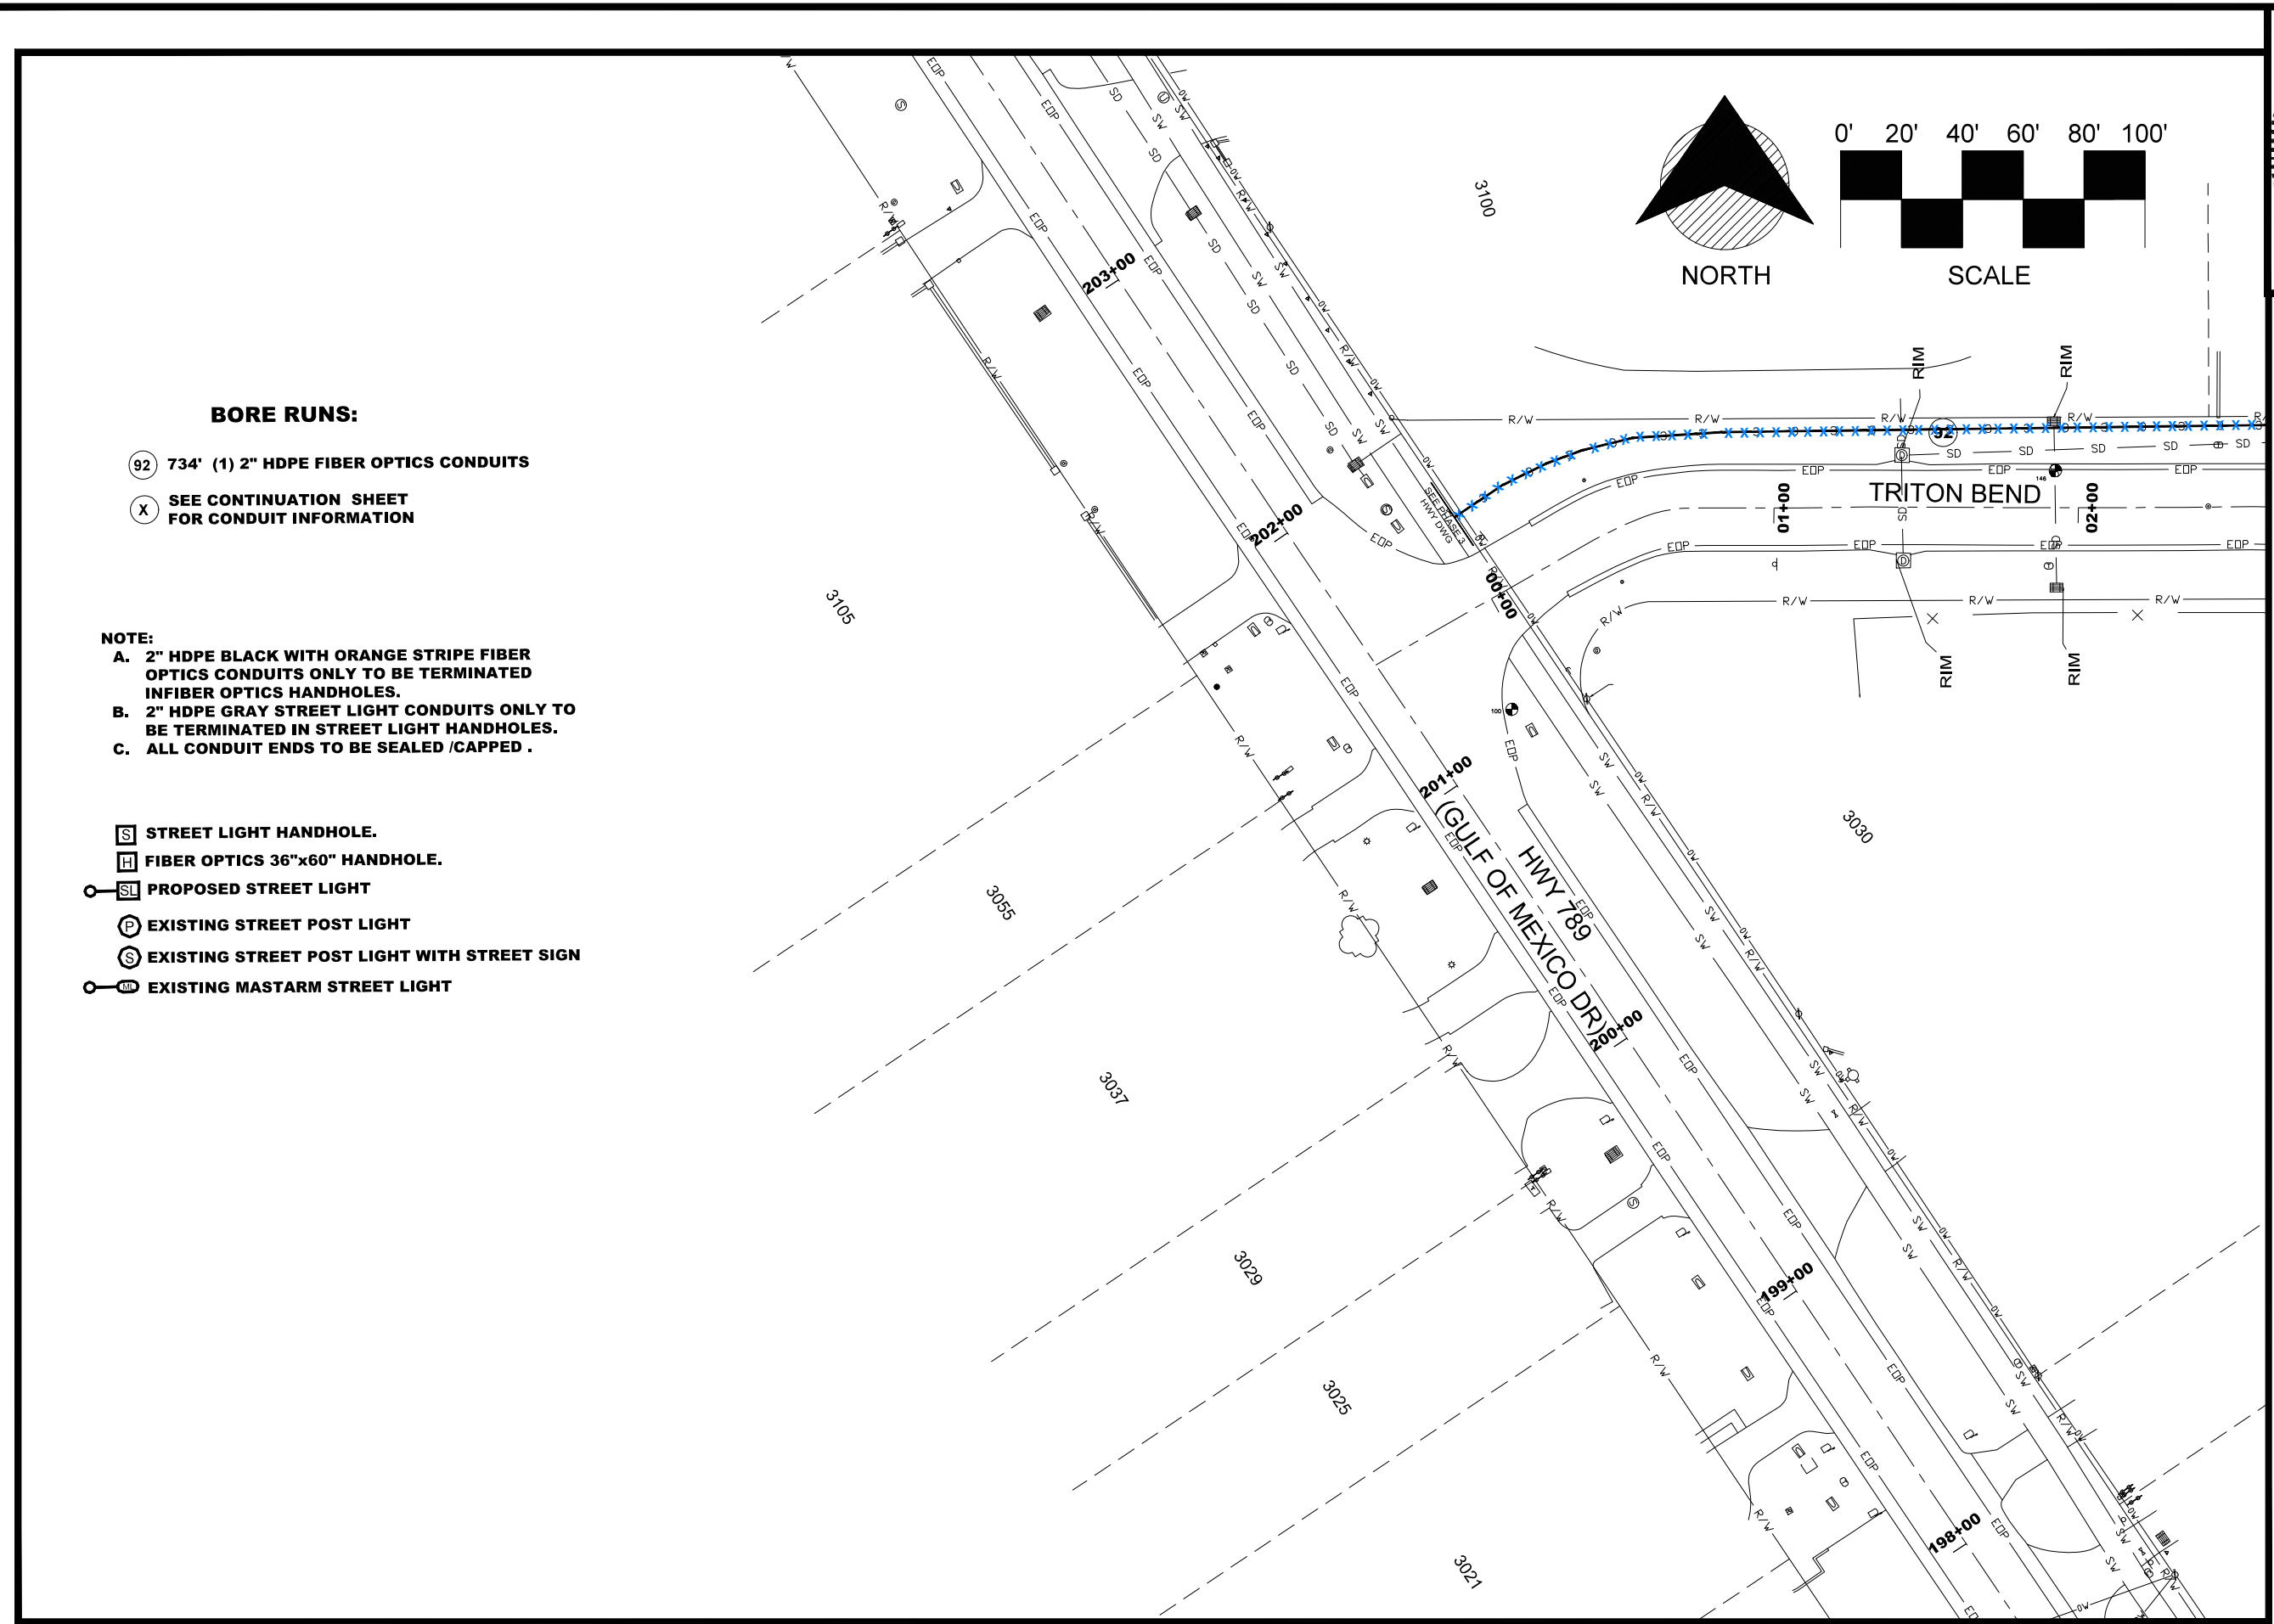


BORE RUNS:

- 92 734' (1) 2" HDPE FIBER OPTICS CONDUITS
- X SEE CONTINUATION SHEET FOR CONDUIT INFORMATION

- NOTE:**
- A. 2" HDPE BLACK WITH ORANGE STRIPE FIBER OPTICS CONDUITS ONLY TO BE TERMINATED IN FIBER OPTICS HANDHOLES.
 - B. 2" HDPE GRAY STREET LIGHT CONDUITS ONLY TO BE TERMINATED IN STREET LIGHT HANDHOLES.
 - C. ALL CONDUIT ENDS TO BE SEALED /CAPPED .

- S STREET LIGHT HANDHOLE.
- H FIBER OPTICS 36"x60" HANDHOLE.
- SL PROPOSED STREET LIGHT
- P EXISTING STREET POST LIGHT
- S EXISTING STREET POST LIGHT WITH STREET SIGN
- ML EXISTING MASTARM STREET LIGHT

MATCHLINE-STA 05+82
FOR CONTINUATION SEE SHEET 11

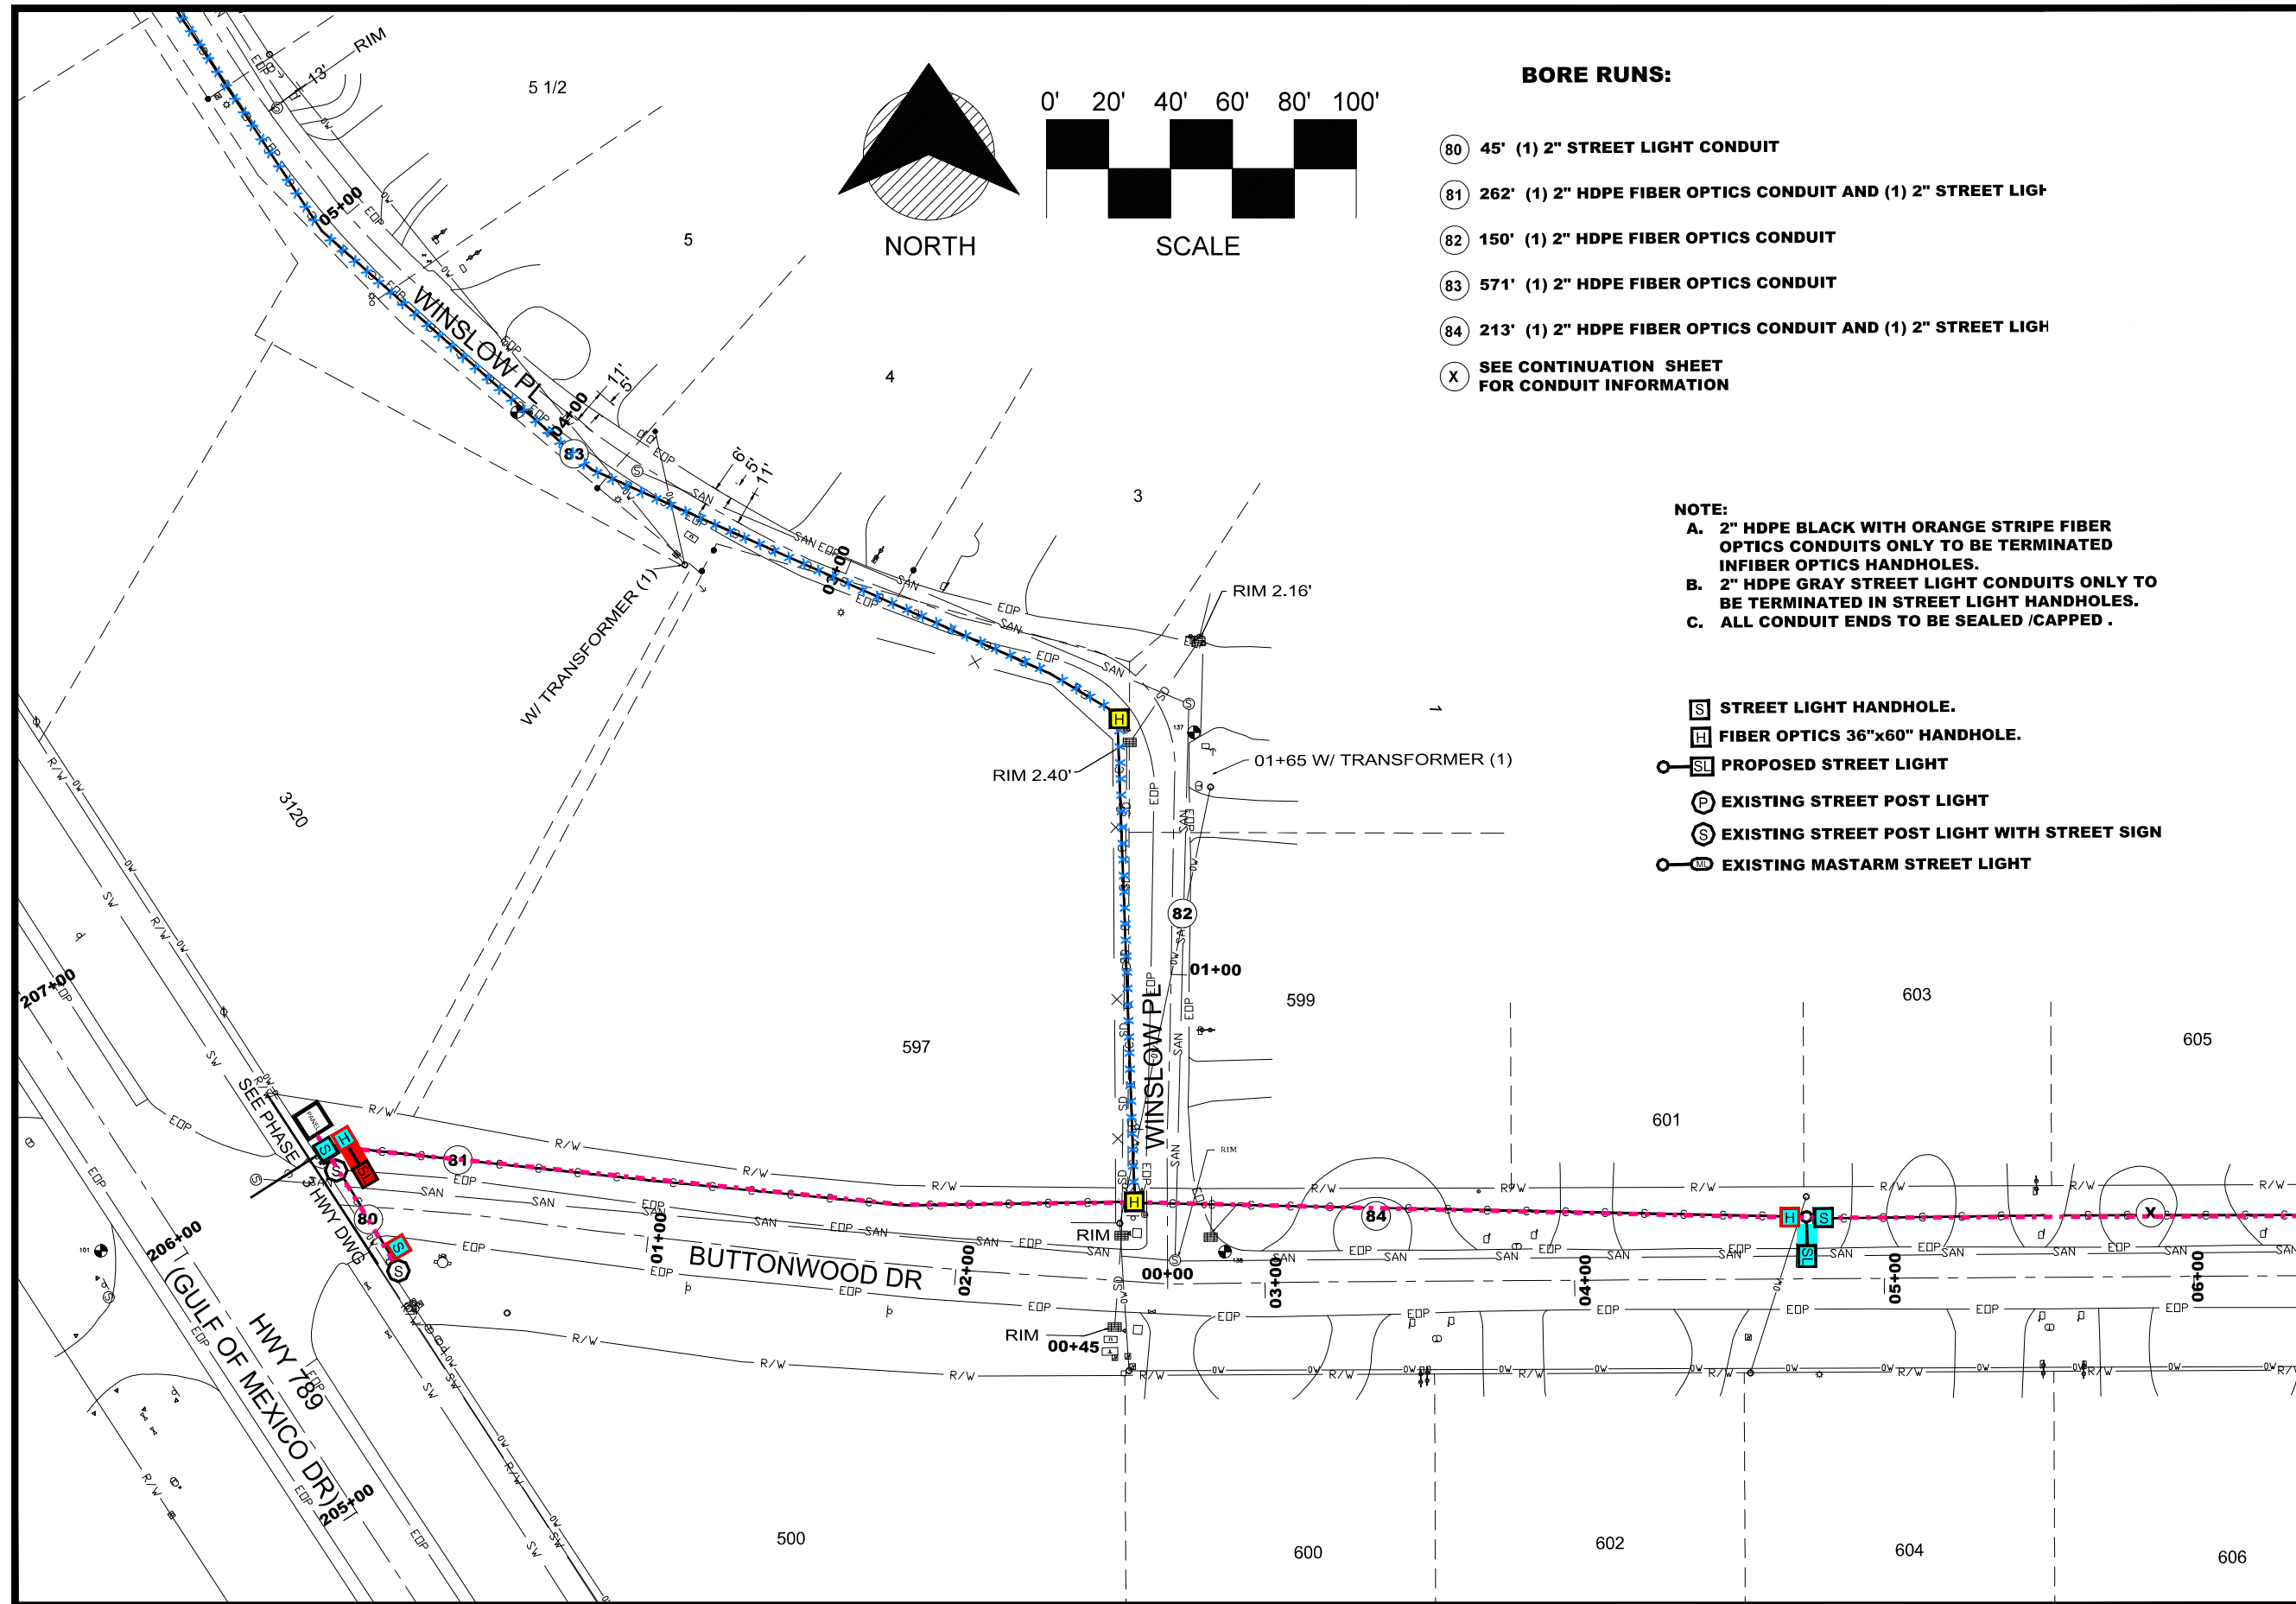

BORE RUNS:


- 80 45' (1) 2" STREET LIGHT CONDUIT
- 81 262' (1) 2" HDPE FIBER OPTICS CONDUIT AND (1) 2" STREET LIGHT
- 82 150' (1) 2" HDPE FIBER OPTICS CONDUIT
- 83 571' (1) 2" HDPE FIBER OPTICS CONDUIT
- 84 213' (1) 2" HDPE FIBER OPTICS CONDUIT AND (1) 2" STREET LIGHT
- X SEE CONTINUATION SHEET FOR CONDUIT INFORMATION

NOTE:

- A. 2" HDPE BLACK WITH ORANGE STRIPE FIBER OPTICS CONDUITS ONLY TO BE TERMINATED IN FIBER OPTICS HANDHOLES.
- B. 2" HDPE GRAY STREET LIGHT CONDUITS ONLY TO BE TERMINATED IN STREET LIGHT HANDHOLES.
- C. ALL CONDUIT ENDS TO BE SEALED /CAPPED .

- [S] STREET LIGHT HANDHOLE.
- [H] FIBER OPTICS 36"x60" HANDHOLE.
- [SL] PROPOSED STREET LIGHT
- [P] EXISTING STREET POST LIGHT
- [S] EXISTING STREET POST LIGHT WITH STREET SIGN
- [M] EXISTING MASTARM STREET LIGHT

MATCHLINE-STA 06+36
FOR CONTINUATION SEE SHEET 9

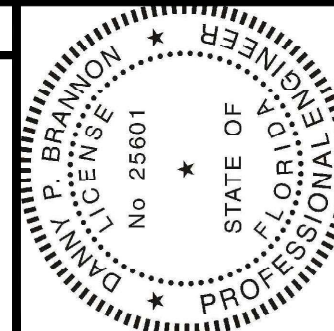


Digitally signed by
Danny P. Brannon
Date: 2021.05.06
17:22:09 -04'00'

DANNY P. BRANNON, P.E.
FLORIDA P. E. NO. 25601

DATE

Town of Longboat Key

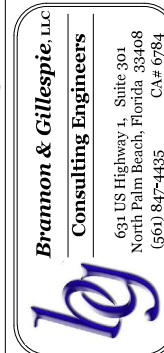

DRAWINGS FOR:
FIBER OPTIC AND STREET
LIGHTING UTILITY
PHASE 3 CONSTRUCTION
LONGBOAT KEY, FLORIDA




Date: 12/01/2020
Scale: AS NOTED
Drawn: DPB
Checked: DPB
Job # 2014-LBK

Sheet


C8

of Sheets

MATCHLINE-STA 06+36
FOR CONTINUATION SEE SHEET 8

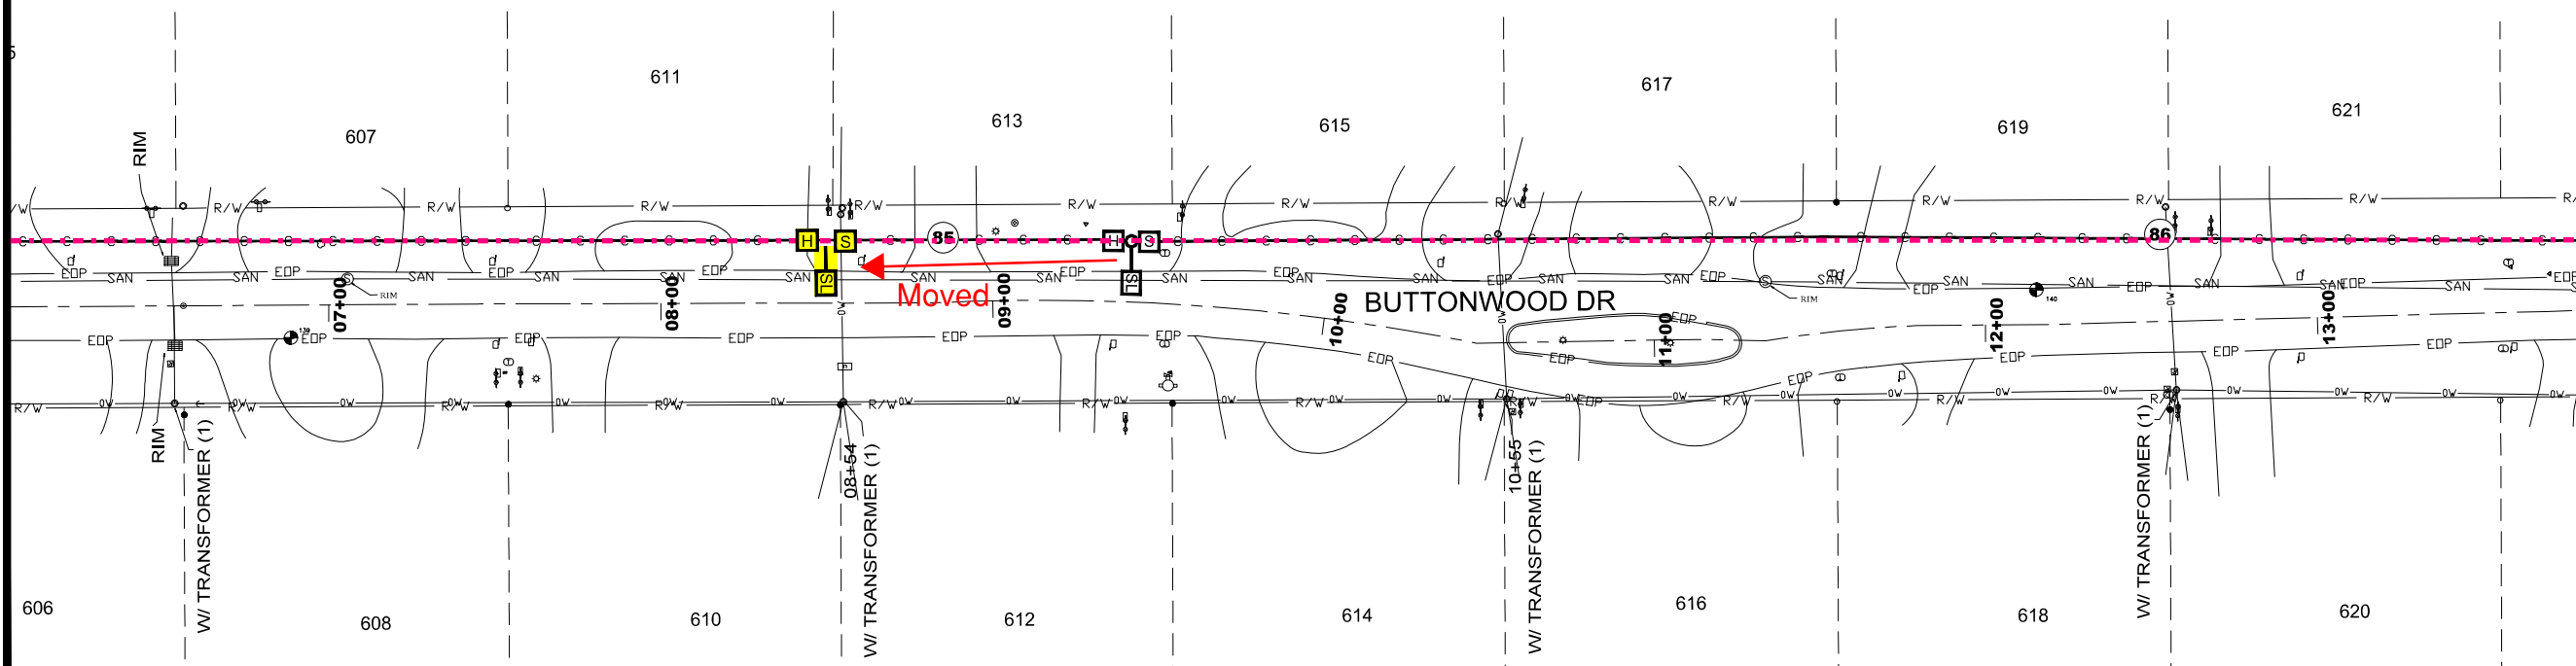

MATCHLINE-STA 13+76
FOR CONTINUATION SEE SHEET 10

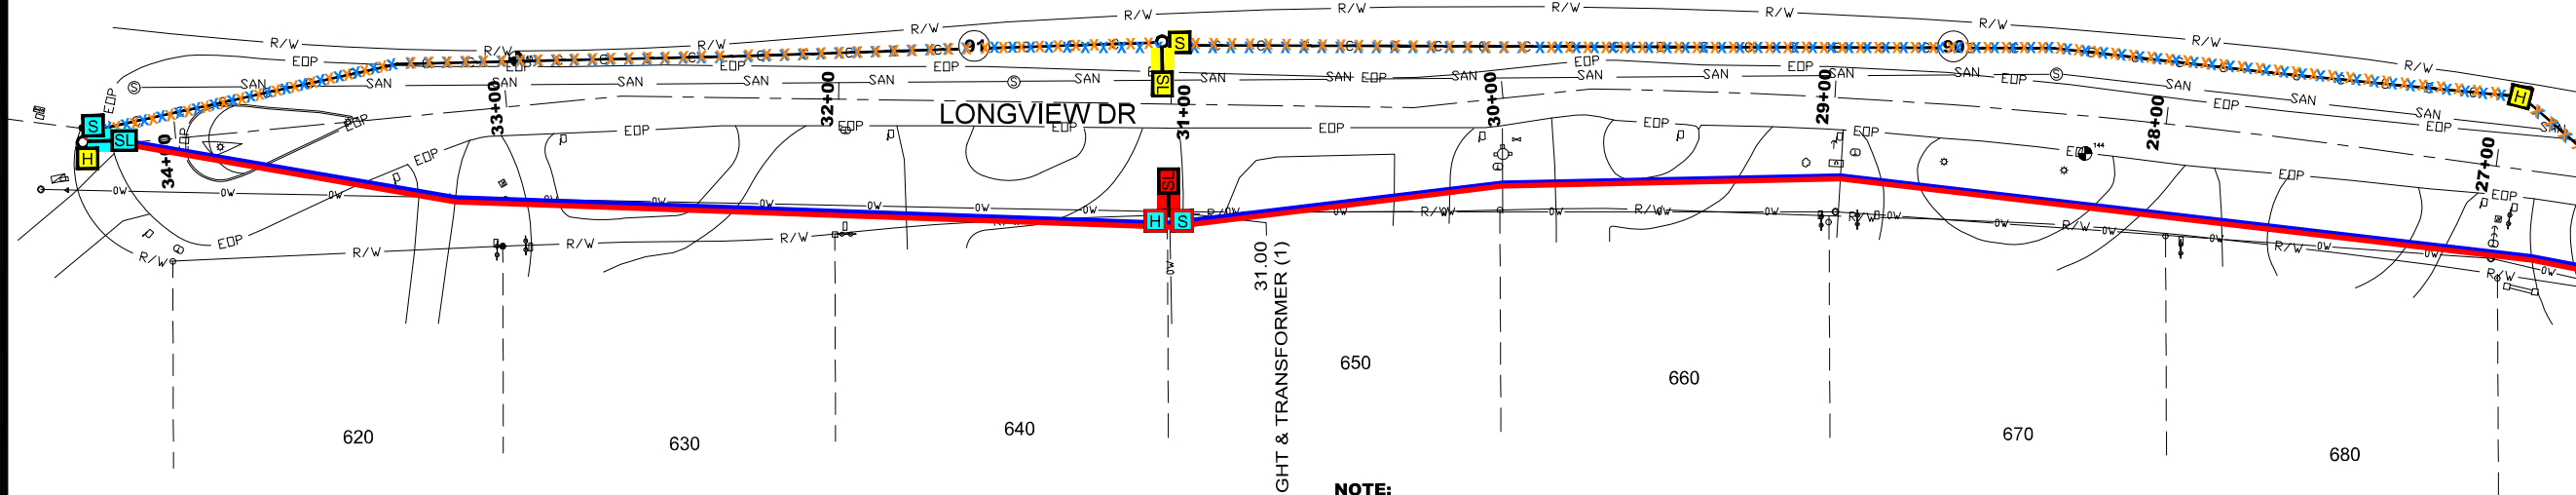


BORE RUNS:

- 85 468' (1) 2" HDPE FIBER OPTICS CONDUIT AND (1) 2" STREET LIGHT CONDUIT
- 86 515' (1) 2" HDPE FIBER OPTICS CONDUIT AND (1) 2" STREET LIGHT CONDUIT
- 90 398' (1) 2" HDPE FIBER OPTICS CONDUIT AND (1) 2" STREET LIGHT CONDUIT
- 91 319' (1) 2" HDPE FIBER OPTICS CONDUIT AND (1) 2" STREET LIGHT CONDUIT
- (X) SEE CONTINUATION SHEET FOR CONDUIT INFORMATION


NOTE:

- A. 2" HDPE BLACK WITH ORANGE STRIPE FIBER OPTICS CONDUITS ONLY TO BE TERMINATED INFIBER OPTICS HANDHOLES.
- B. 2" HDPE GRAY STREET LIGHT CONDUITS ONLY TO BE TERMINATED IN STREET LIGHT HANDHOLES.
- C. ALL CONDUIT ENDS TO BE SEALED /CAPPED .

- [S] STREET LIGHT HANDHOLE.
- [H] FIBER OPTICS 36"x60" HANDHOLE.
- [SL] PROPOSED STREET LIGHT
- [P] EXISTING STREET POST LIGHT
- [S] EXISTING STREET POST LIGHT WITH STREET SIGN
- [ML] EXISTING MASTARM STREET LIGHT

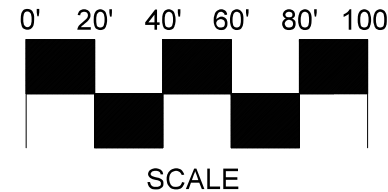

MATCHLINE-STA 26+77
FOR CONTINUATION SEE SHEET 10

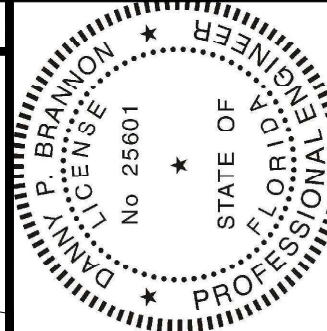


Digitally signed by
Danny P Brannon
Date: 2021.05.06
17:22:09 -04'00'

DANNY P. BRANNON, P. E.
FLORIDA P. E. NO. 25601

DATE

Town of Longboat Key


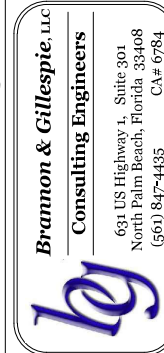


DRAWINGS FOR:
**FIBER OPTIC AND STREET
LIGHTING UTILITY
PHASE 3 CONSTRUCTION**
LONGBOAT KEY, FLORIDA



Date:	12/01/2020
Scale:	AS NOTED
Drawn:	DPB
Checked:	DPB
Job #	2014-LBK
Sheet	C9

of Sheets

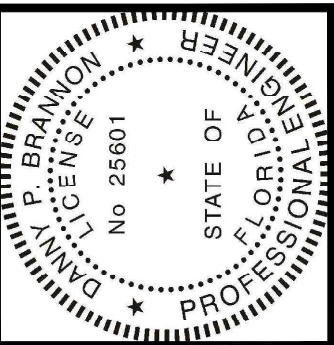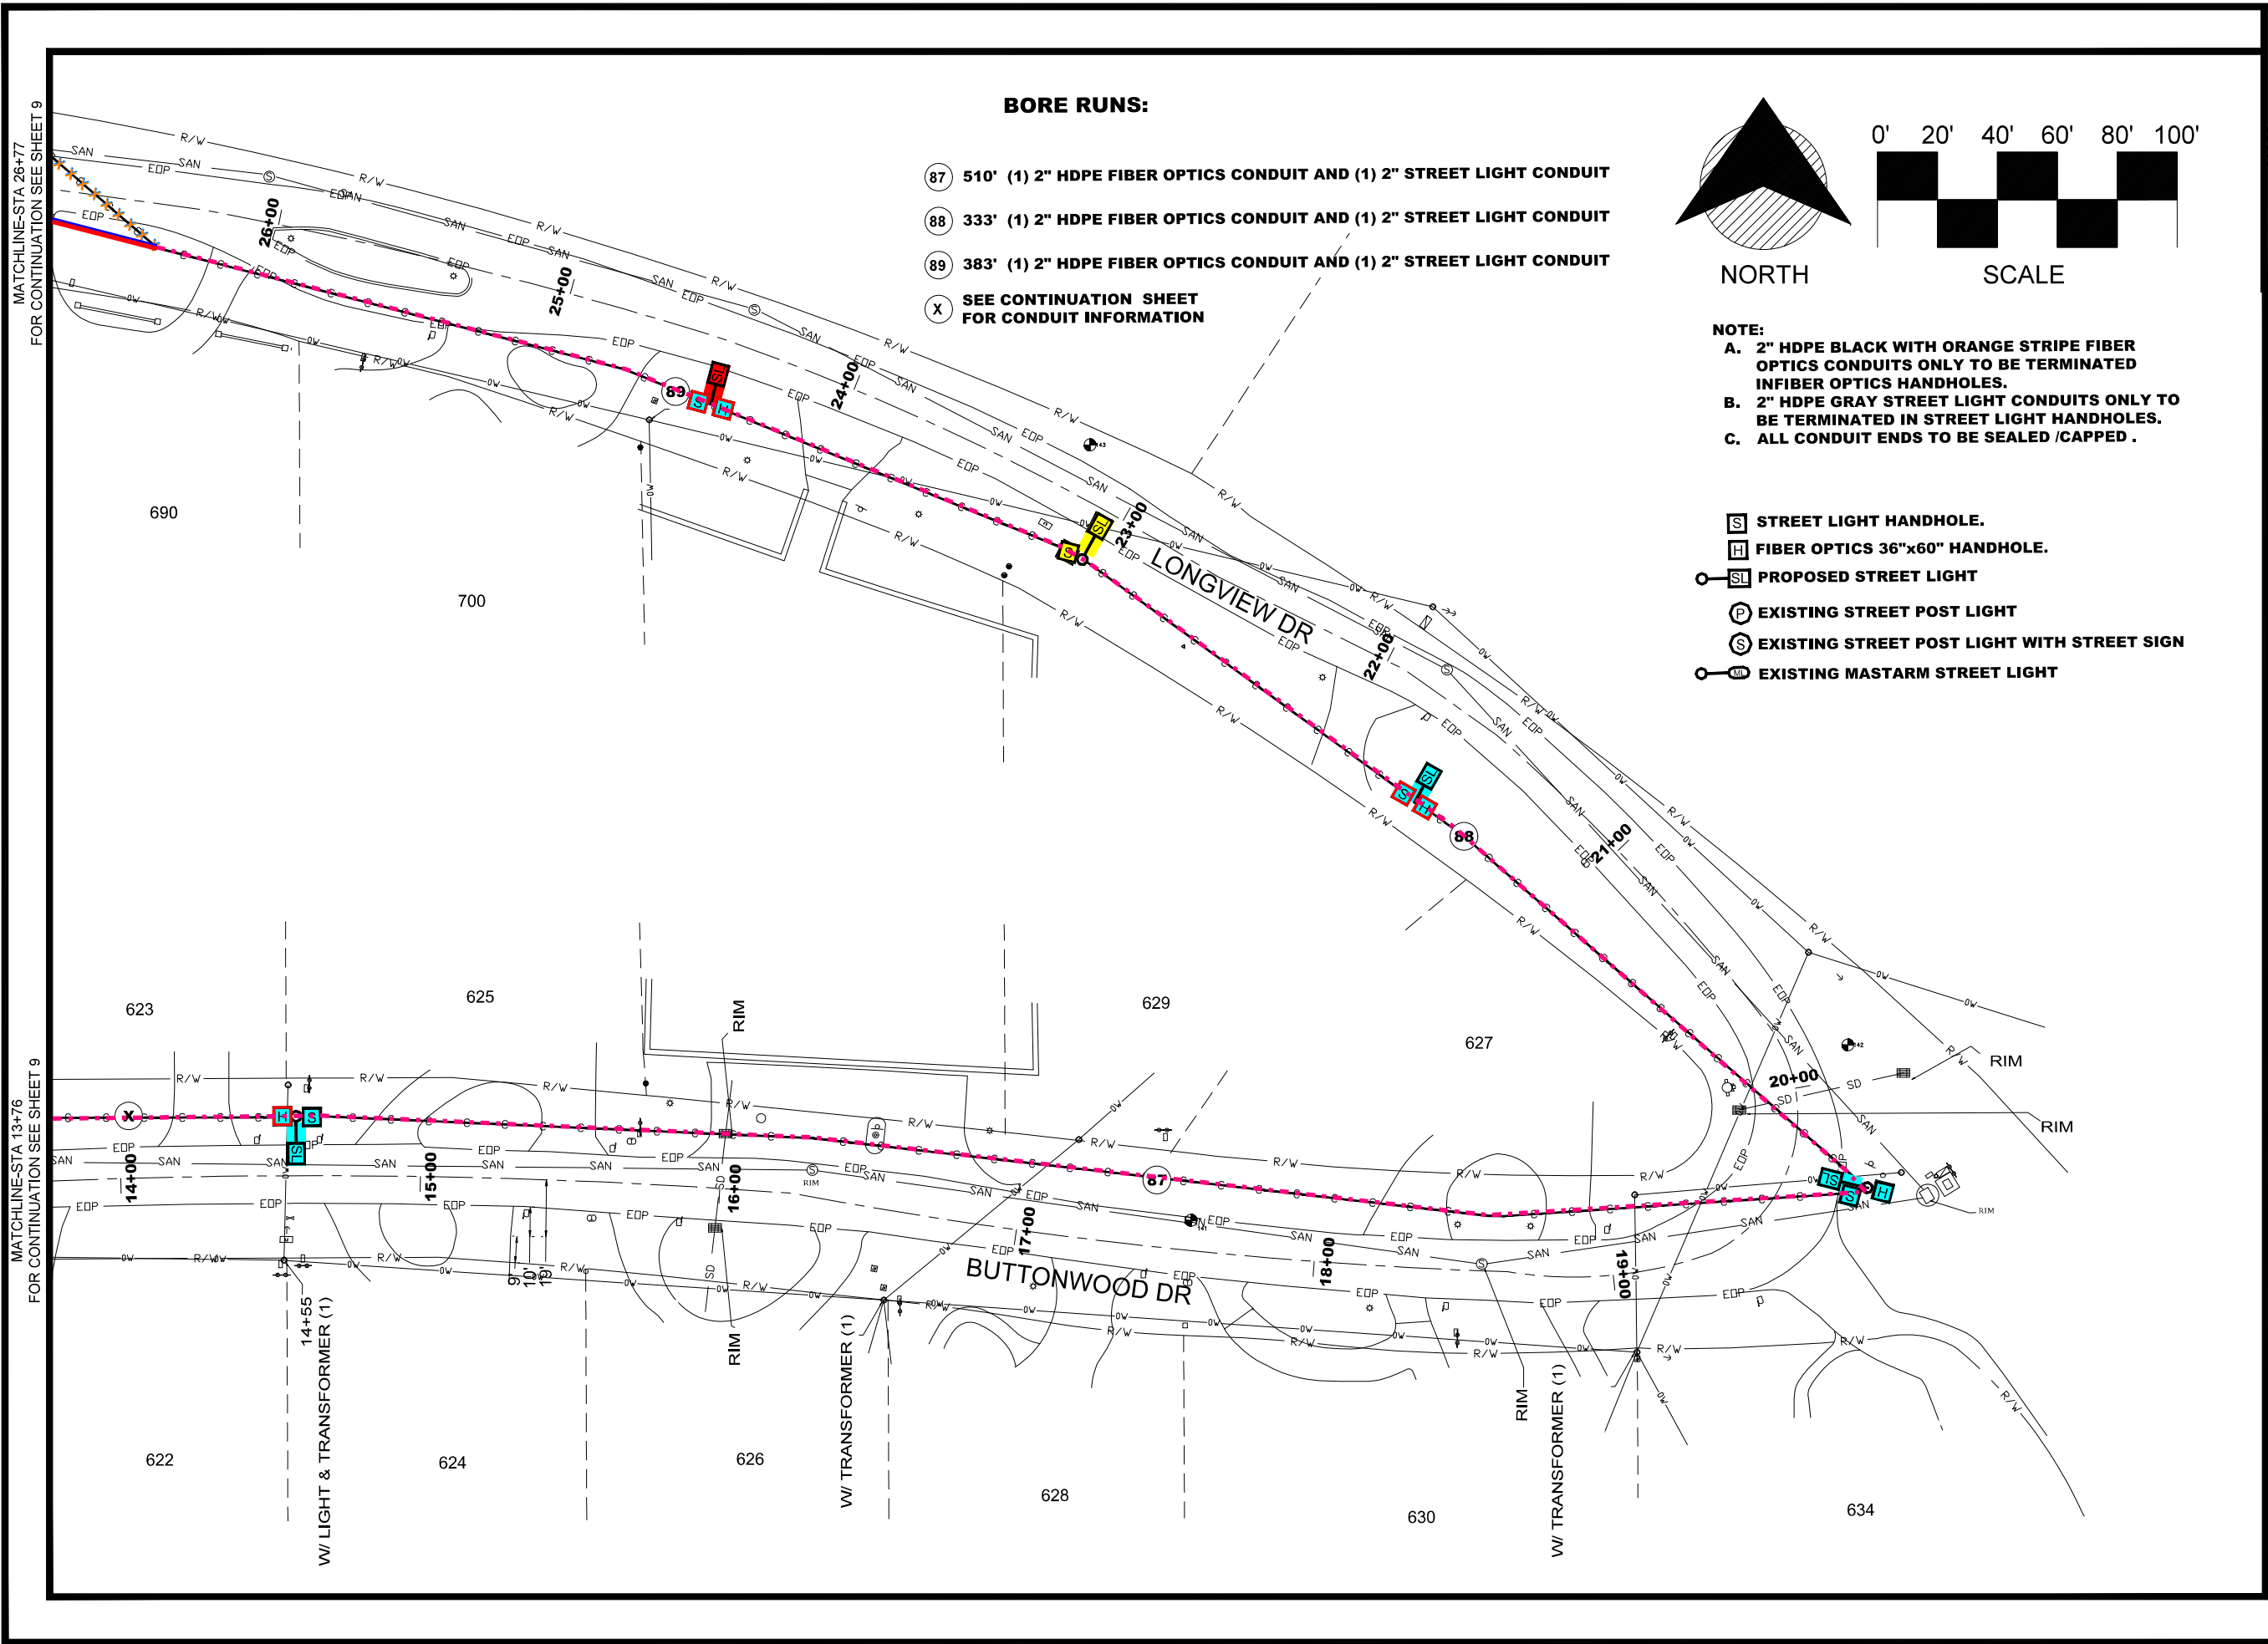


Digitally signed by
Danny P. Brannon
Date: 2021.05.06
17:22:09 -04'00'

DANNY P. BRANNON, P.E.
FLORIDA P.E. NO. 25601

DATE


Town of Longboat Key

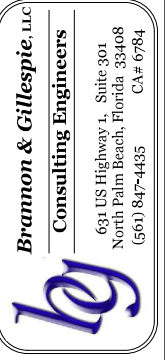

DRAWINGS FOR:
FIBER OPTIC AND STREET LIGHTING UTILITY
PHASE 3 CONSTRUCTION
LONGBOAT KEY, FLORIDA



Date:	12/01/2020
Scale:	AS NOTED
Drawn:	DPB
Checked:	DPB
Job #	2014-LBK
Sheet	C10
of	Sheets

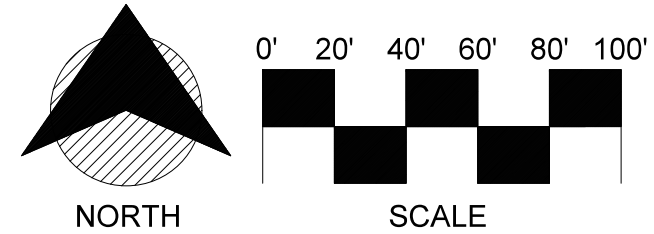


NOTE:
A. 2" HDPE BLACK WITH ORANGE STRIPE FIBER OPTICS CONDUITS ONLY TO BE TERMINATED INFIBER OPTICS HANDHOLES.
B. 2" HDPE GRAY STREET LIGHT CONDUITS ONLY TO BE TERMINATED IN STREET LIGHT HANDHOLES.
C. ALL CONDUIT ENDS TO BE SEALED /CAPPED .

- [S] STREET LIGHT HANDHOLE.
- [H] FIBER OPTICS 36"x60" HANDHOLE.
- [SL] PROPOSED STREET LIGHT
- [P] EXISTING STREET POST LIGHT
- [S] EXISTING STREET POST LIGHT WITH STREET SIGN
- [M] EXISTING MASTARM STREET LIGHT


BORE RUNS:
[X] SEE CONTINUATION SHEET FOR CONDUIT INFORMATION

MATCHLINE-STA 05+82
FOR CONTINUATION SEE SHEET 8

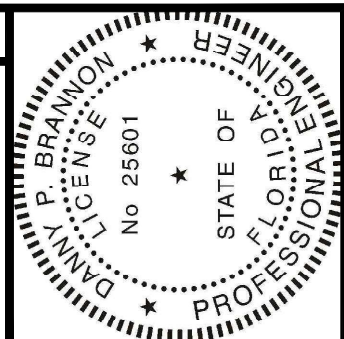

Digitally signed by
Danny P. Brannon
Date: 2021.05.06
17:22:09 -04'00'
Dan Brannon
DANNY P. BRANNON, P. E.
FLORIDA P. E. NO. 25601
DATE

Town of Longboat Key

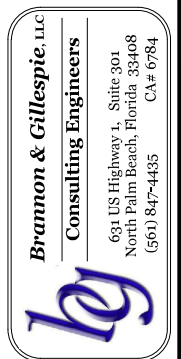


DRAWINGS FOR:
FIBER OPTIC AND STREET LIGHTING UTILITY
PHASE 3 CONSTRUCTION
LONGBOAT KEY, FLORIDA



Date:	12/01/2020
Scale:	AS NOTED
Drawn:	DPB
Checked:	DPB
Job #	2014-LBK
Sheet	C11
of	Sheets

MATCHLINE-STA 01+39 & 04+13
FOR CONTINUATION SEE SHEET 14

MATCHLINE-STA 03+65
FOR CONTINUATION SEE SHEET 14

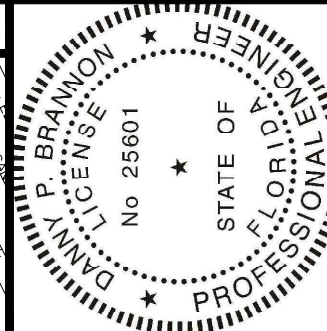


MATCHLINE-STA 03+10
FOR CONTINUATION SEE SHEET 13

Digitally signed by
Danny P Brannon
Date: 2021.05.06
17:22:09 -04'00'

DANNY P. BRANNON, P.E.
FLORIDA P. E. NO. 25601

DATE

Town of Longboat Key

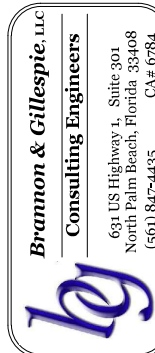

DRAWINGS FOR:
FIBER OPTIC AND STREET
LIGHTING UTILITY
PHASE 3 CONSTRUCTION
LONGBOAT KEY, FLORIDA



Date: 12/01/2020
Scale: AS NOTED
Drawn: DPB
Checked: DPB
Job #: 2014-LBK

Sheet

C12

of Sheets

BORE RUNS:


74 80' (1) 2" HDPE FIBER OPTICS CONDUITS

X SEE CONTINUATION SHEET
FOR CONDUIT INFORMATION


NOTE:

- 2" HDPE BLACK WITH ORANGE STRIPE FIBER OPTICS CONDUITS ONLY TO BE TERMINATED IN FIBER OPTICS HANDHOLES.
- 2" HDPE GRAY STREET LIGHT CONDUITS ONLY TO BE TERMINATED IN STREET LIGHT HANDHOLES.
- ALL CONDUIT ENDS TO BE SEALED /CAPPED .

- SL STREET LIGHT HANDHOLE.
- H FIBER OPTICS 36"x60" HANDHOLE.
- SL PROPOSED STREET LIGHT
- P EXISTING STREET POST LIGHT
- S EXISTING STREET POST LIGHT WITH STREET SIGN
- ML EXISTING MASTARM STREET LIGHT

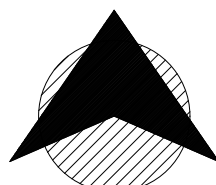

NORTH


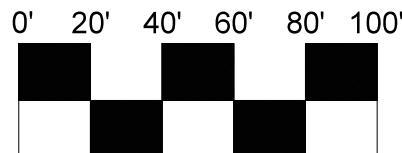


SCALE

MATCHLINE-STA 03+78
FOR CONTINUATION SEE SHEET 15

MATCHLINE-STA 07+76
FOR CONTINUATION SEE SHEET 15

MATCHLINE-STA 03+10
FOR CONTINUATION SEE SHEET 12

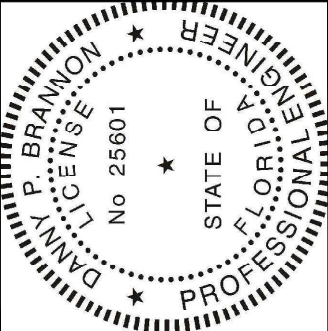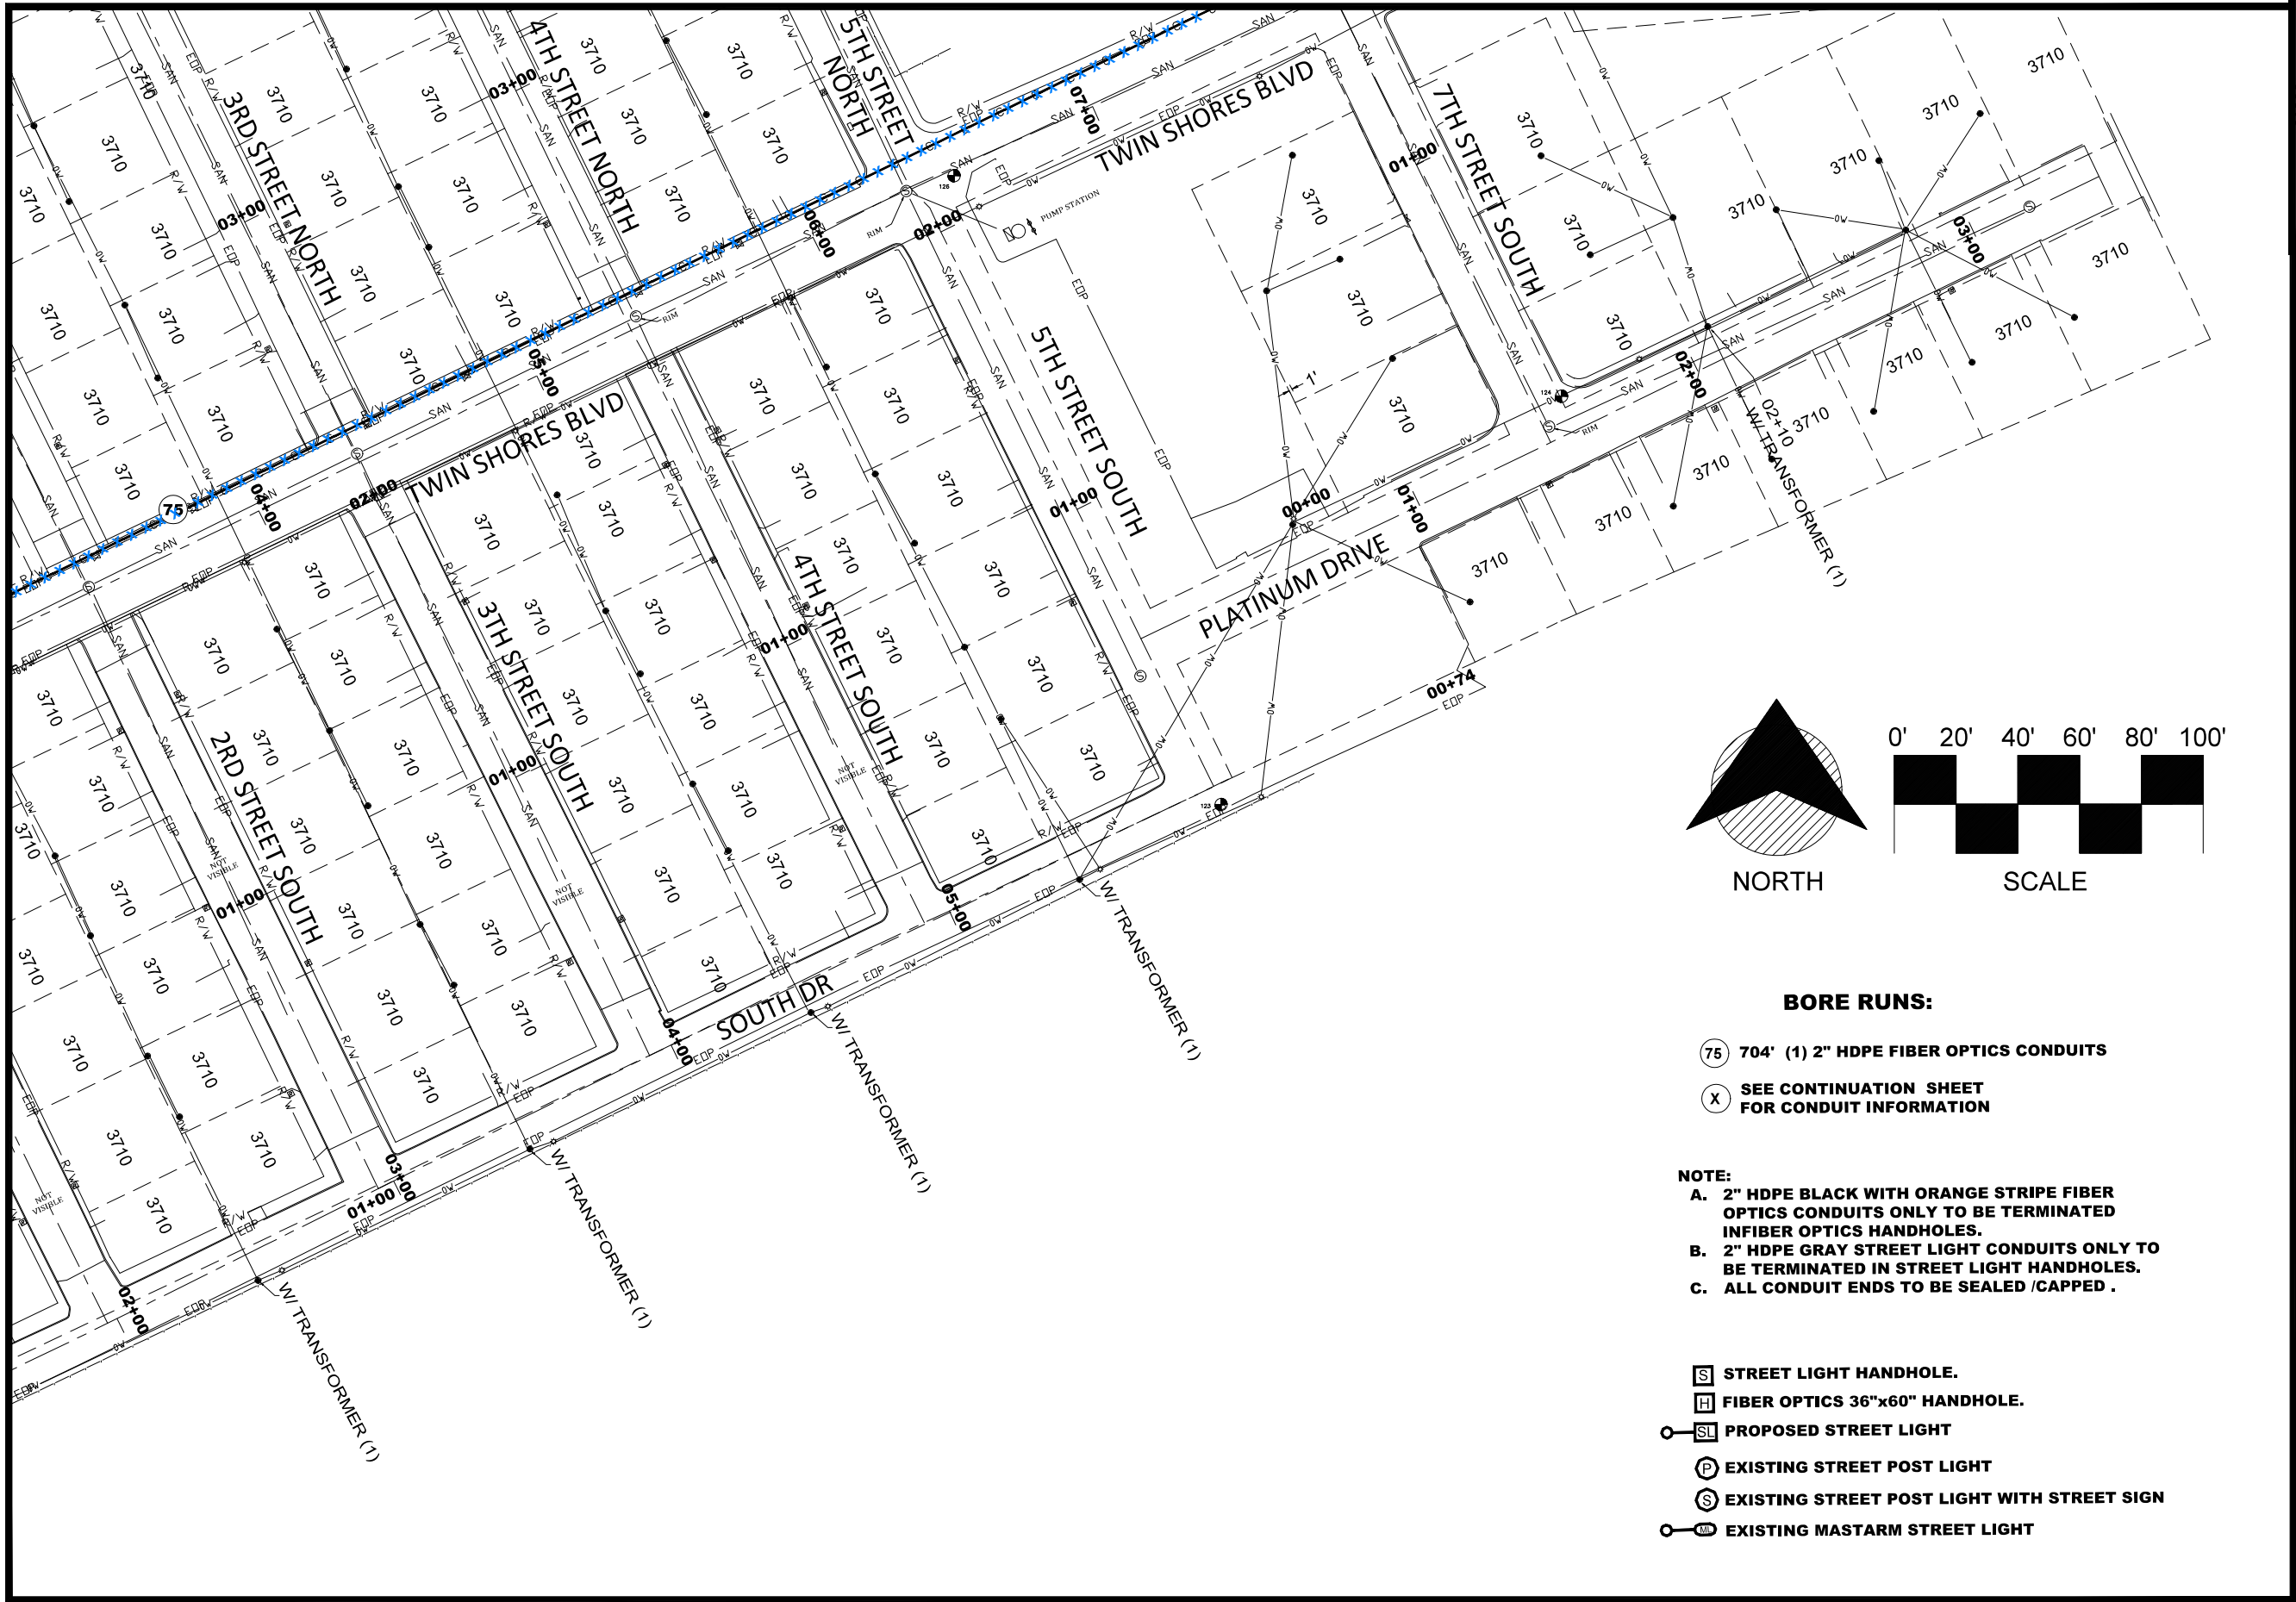


Digitally signed by
Danny P. Brannon
Date: 2021.05.06
17:22:09 -04'00'

DANNY P. BRANNON, P.E.
FLORIDA P. E. NO. 25601

DATE

Town of Longboat Key

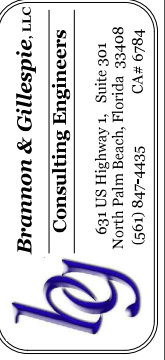

DRAWINGS FOR:
**FIBER OPTIC AND STREET
LIGHTING UTILITY
PHASE 3 CONSTRUCTION**
LONGBOAT KEY, FLORIDA




Date: 12/01/2020
Scale: AS NOTED
Drawn: DPB
Checked: DPB
Job # 2014-LBK

Sheet

C13

of Sheets

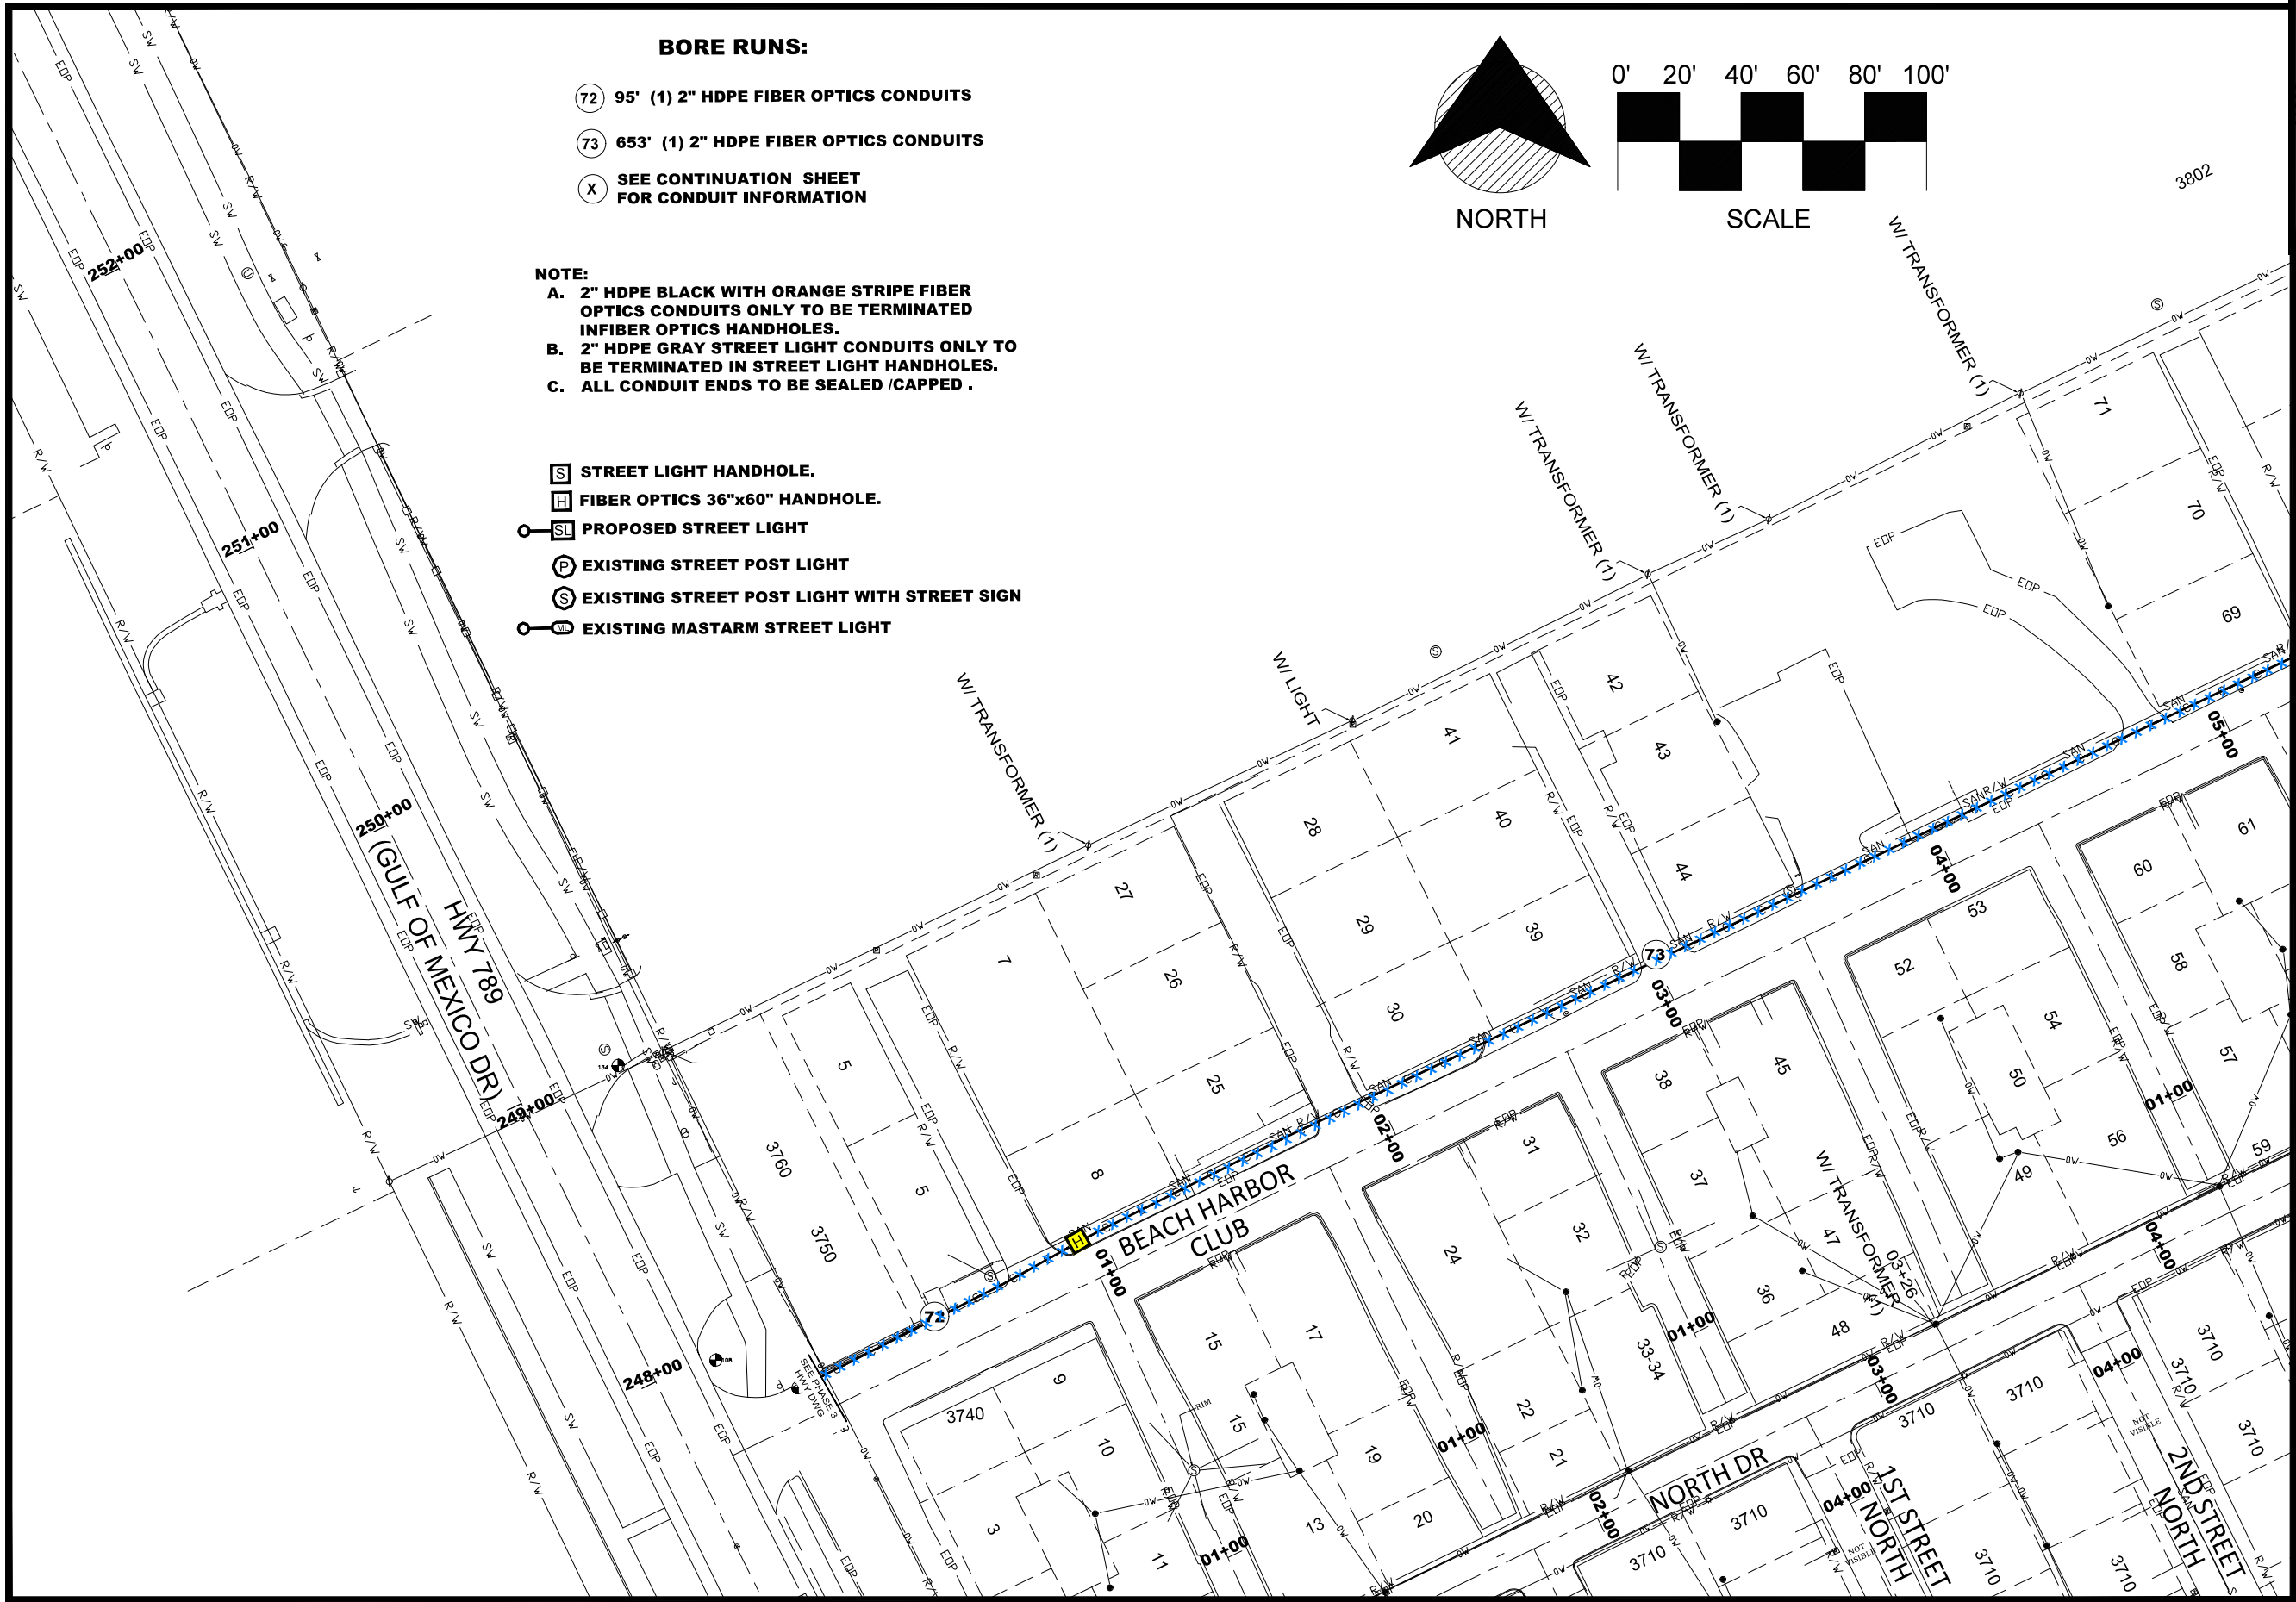


BORE RUNS:

- 72 95' (1) 2" HDPE FIBER OPTICS CONDUITS
- 73 653' (1) 2" HDPE FIBER OPTICS CONDUITS
- X SEE CONTINUATION SHEET FOR CONDUIT INFORMATION


NOTE:

- A. 2" HDPE BLACK WITH ORANGE STRIPE FIBER OPTICS CONDUITS ONLY TO BE TERMINATED IN FIBER OPTICS HANDHOLES.
- B. 2" HDPE GRAY STREET LIGHT CONDUITS ONLY TO BE TERMINATED IN STREET LIGHT HANDHOLES.
- C. ALL CONDUIT ENDS TO BE SEALED /CAPPED .


- STREET LIGHT HANDHOLE.
- FIBER OPTICS 36"x60" HANDHOLE.
- PROPOSED STREET LIGHT
- EXISTING STREET POST LIGHT
- EXISTING STREET POST LIGHT WITH STREET SIGN
- EXISTING MASTARM STREET LIGHT

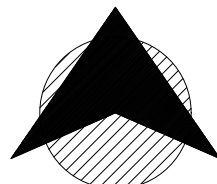

NORTH

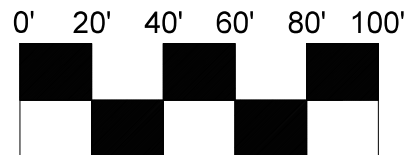

SCALE

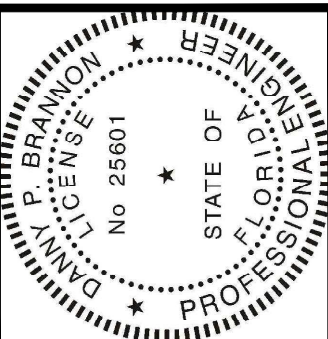

Digitally signed by
Danny P. Brannon
Date: 2021.05.06
17:22:09 -04'00'


DANNY P. BRANNON, P.E.
FLORIDA P.E. NO. 25601

DATE

MATCHLINE-STA 05+23 & 01+81
FOR CONTINUATION SEE SHEET 15

MATCHLINE-STA 04+50
FOR CONTINUATION SEE SHEET 15

Town of Longboat Key

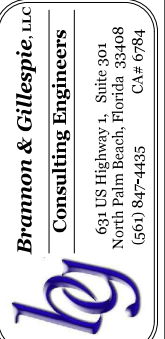

DRAWINGS FOR:
FIBER OPTIC AND STREET
LIGHTING UTILITY
PHASE 3 CONSTRUCTION
LONGBOAT KEY, FLORIDA



Date: 12/01/2020
Scale: AS NOTED
Drawn: DPB
Checked: DPB
Job # 2014-LBK



Sheet

C14


of Sheets

MATCHLINE-STA 01+39 & 04+13
FOR CONTINUATION SEE SHEET 12

MATCHLINE-STA 03+65 & 04+50
FOR CONTINUATION SEE SHEET 12

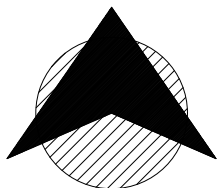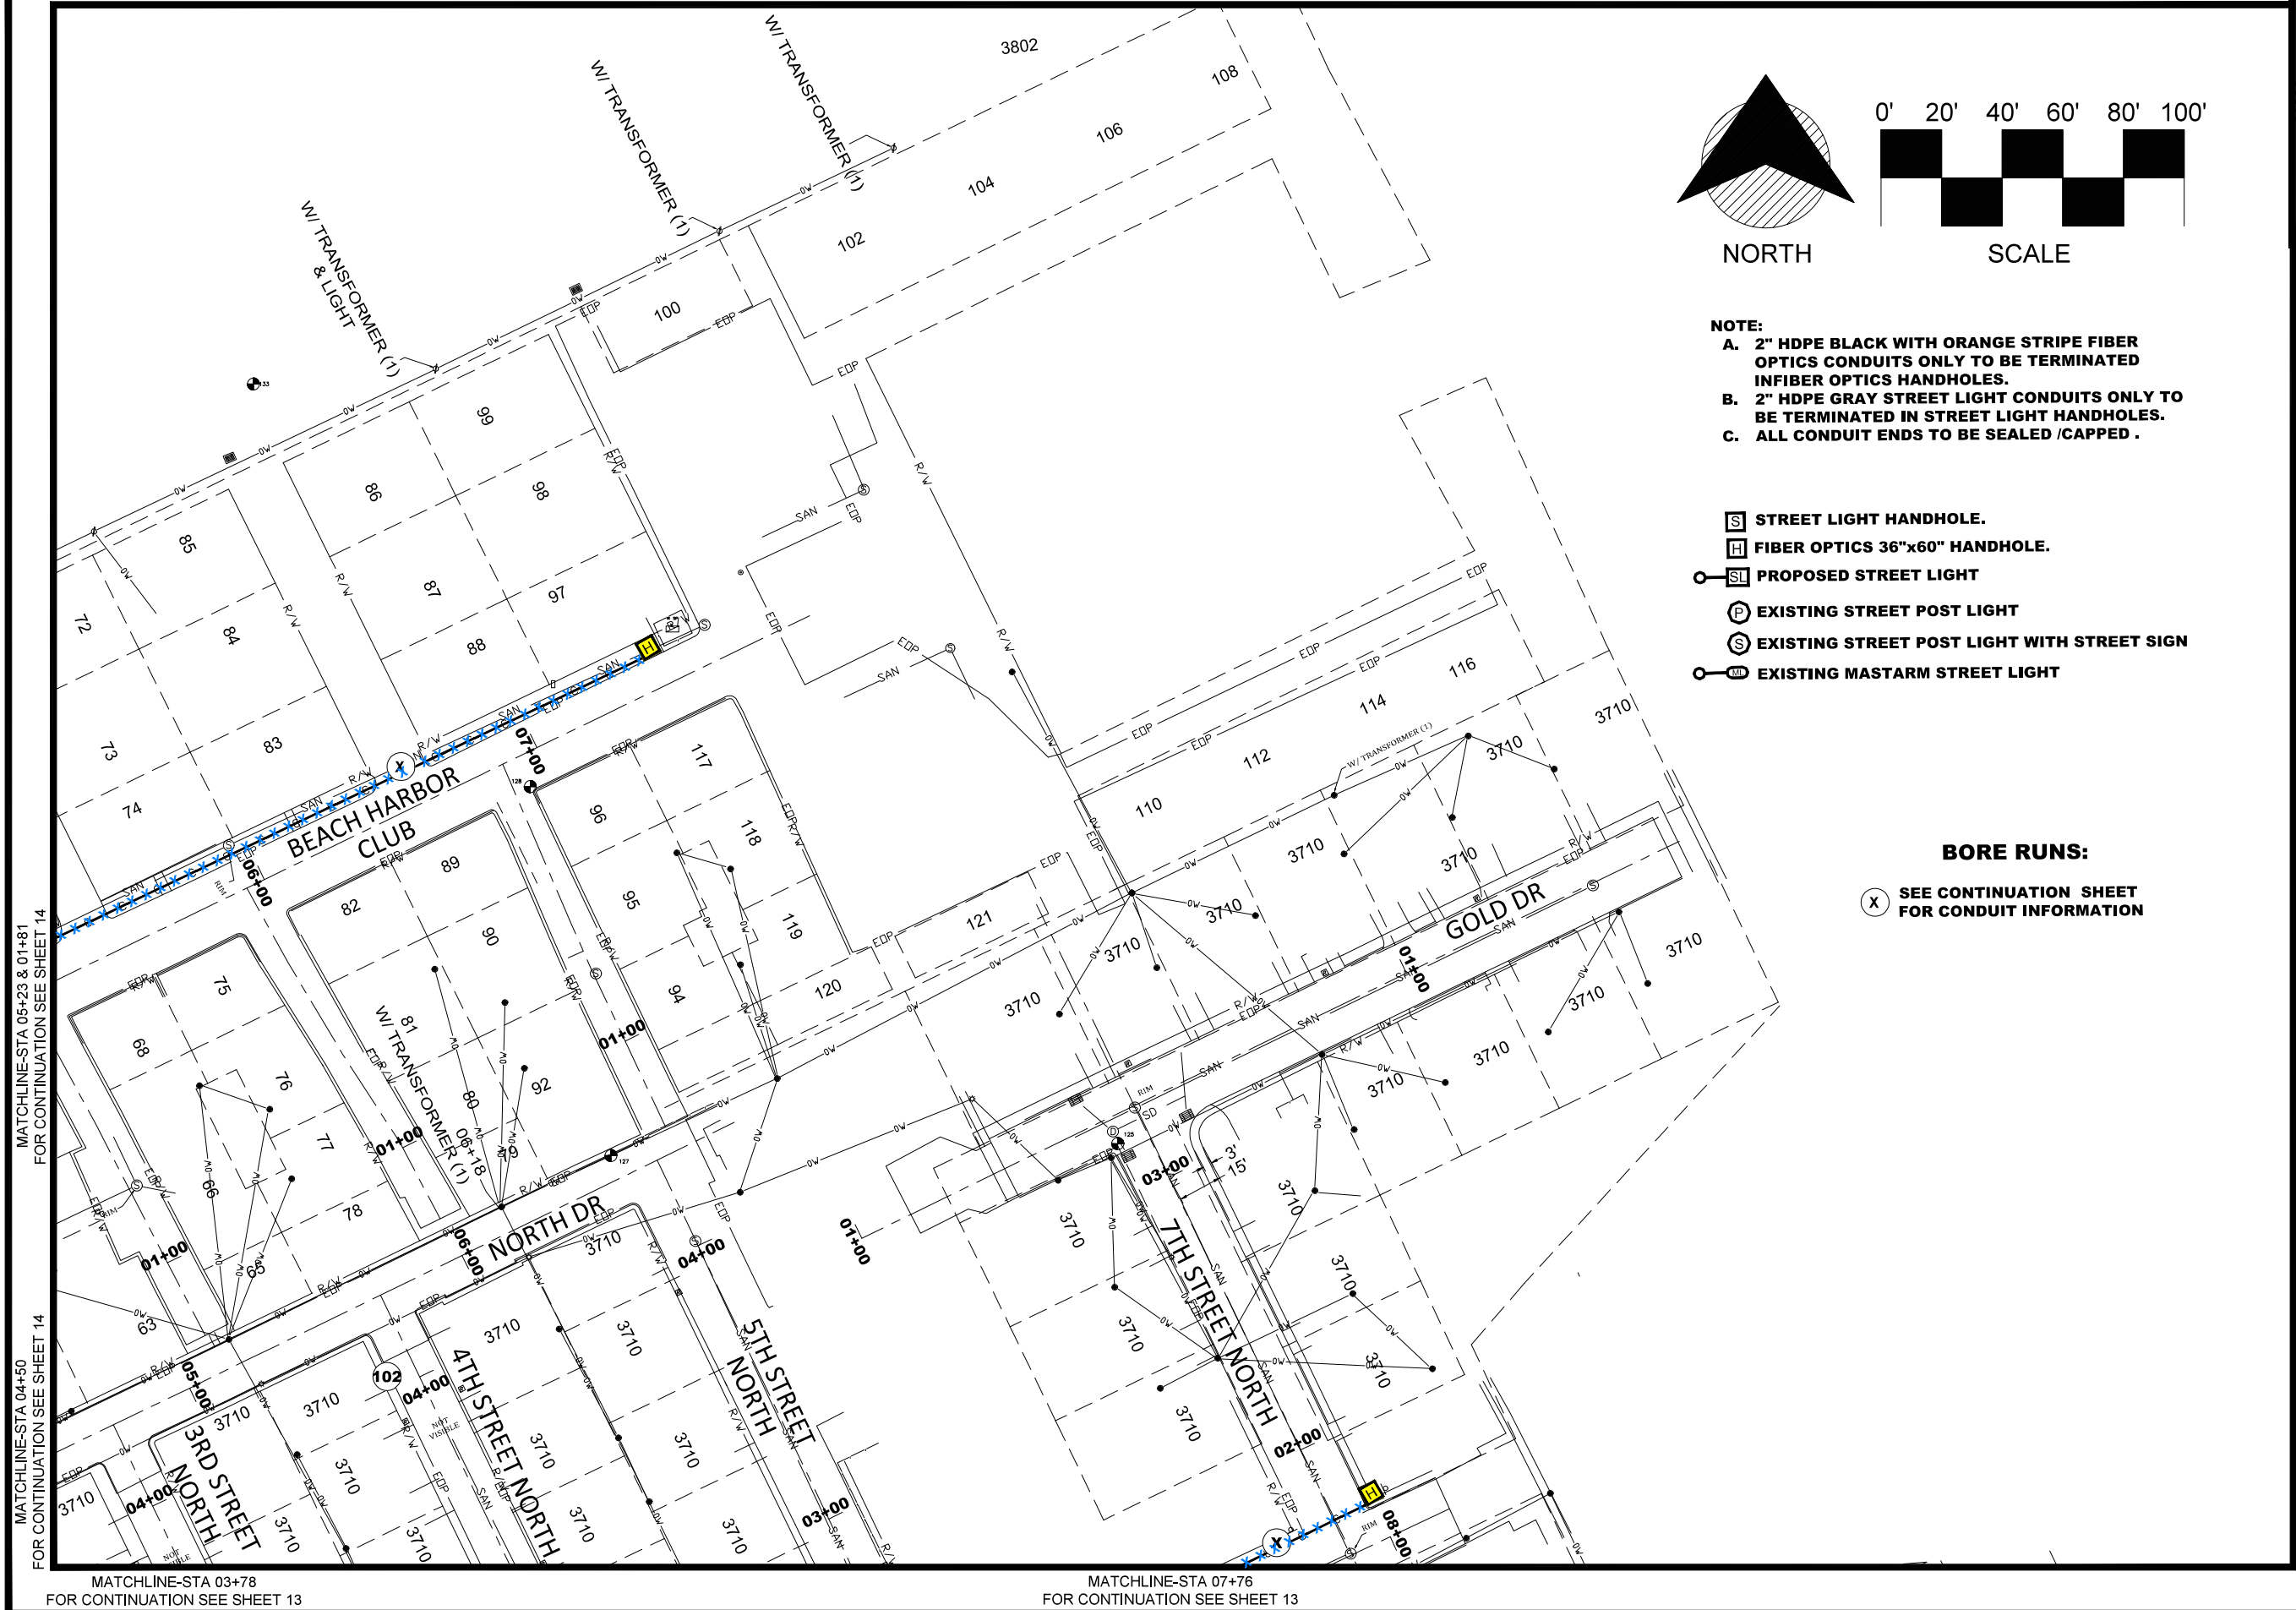

NORTH

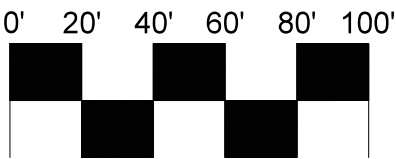


SCALE

- NOTE:**
- A. 2" HDPE BLACK WITH ORANGE STRIPE FIBER OPTICS CONDUITS ONLY TO BE TERMINATED IN FIBER OPTICS HANDHOLES.
 - B. 2" HDPE GRAY STREET LIGHT CONDUITS ONLY TO BE TERMINATED IN STREET LIGHT HANDHOLES.
 - C. ALL CONDUIT ENDS TO BE SEALED /CAPPED .

- [S] STREET LIGHT HANDHOLE.
- [H] FIBER OPTICS 36"x60" HANDHOLE.
- [SL] PROPOSED STREET LIGHT
- [P] EXISTING STREET POST LIGHT
- [S] EXISTING STREET POST LIGHT WITH STREET SIGN
- [M] EXISTING MASTARM STREET LIGHT

BORE RUNS:

- (X) SEE CONTINUATION SHEET FOR CONDUIT INFORMATION

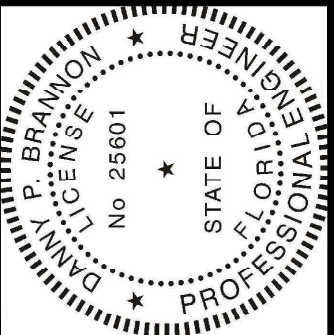


Digitally signed by
Danny P Brannon
Date: 2021.05.06
17:22:09 -04'00'

DANNY P. BRANNON, P.E.
FLORIDA P. E. NO. 25601

DATE

Town of Longboat Key

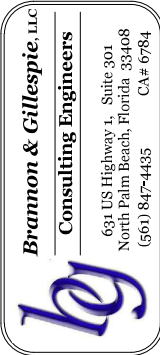

DRAWINGS FOR:
**FIBER OPTIC AND STREET
LIGHTING UTILITY
PHASE 3 CONSTRUCTION**
LONGBOAT KEY, FLORIDA




Date:	12/01/2020
Scale:	AS NOTED
Drawn:	DPB
Checked:	DPB
Job #	2014-LBK

Sheet

C15

of Sheets

MATCHLINE-STA 02+66
FOR CONTINUATION SEE SHEET 19

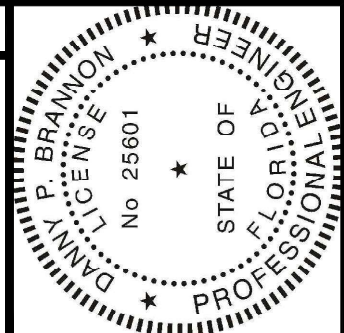

Matchline-STA 01+89
FOR CONTINUATION SEE SHEET 17


Digitally signed by
Danny P. Brannon
Date: 2021.05.06
17:22:09 -04'00'

DANNY P. BRANNON, P.E.
FLORIDA P.E. NO. 25601

DATE

- NOTE:
- A. 2" HDPE BLACK WITH ORANGE STRIPE FIBER OPTICS CONDUITS ONLY TO BE TERMINATED INFIBER OPTICS HANDHOLES.
 - B. 2" HDPE GRAY STREET LIGHT CONDUITS ONLY TO BE TERMINATED IN STREET LIGHT HANDHOLES.
 - C. ALL CONDUIT ENDS TO BE SEALED /CAPPED .

- [S] STREET LIGHT HANDHOLE.
- [H] FIBER OPTICS 36"x60" HANDHOLE.
- [SL] PROPOSED STREET LIGHT
- [P] EXISTING STREET POST LIGHT
- [S] EXISTING STREET POST LIGHT WITH STREET SIGN
- [M] EXISTING MASTARM STREET LIGHT

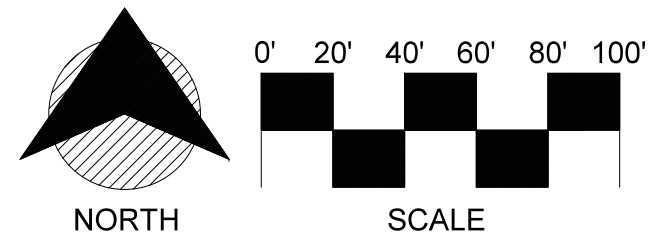


BORE RUNS:

- 60 214' (1) 2" HDPE FIBER OPTICS CONDUIT AND (1) 2" STREET LIGHT CONDUIT
- 61 68' (1) 2" HDPE FIBER OPTICS CONDUIT AND (1) 2" STREET LIGHT CONDUIT
- 64 342' (1) 2" HDPE FIBER OPTICS CONDUIT AND (1) 2" STREET LIGHT CONDUIT
- 67 171' (1) 2" HDPE FIBER OPTICS CONDUIT AND (1) 2" STREET LIGHT CONDUIT
- 68 357' (1) 2" HDPE FIBER OPTICS CONDUIT AND (1) 2" STREET LIGHT CONDUIT
- X SEE CONTINUATION SHEET FOR CONDUIT INFORMATION

Matchline-STA 04+46
FOR CONTINUATION SEE SHEET 17

Town of Longboat Key

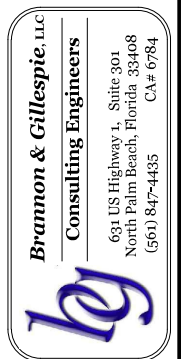



DRAWINGS FOR:
FIBER OPTIC AND STREET LIGHTING UTILITY
PHASE 3 CONSTRUCTION
LONGBOAT KEY, FLORIDA




Date:	12/01/2020
Scale:	AS NOTED
Drawn:	DPB
Checked:	DPB
Job #	2014-LBK
Sheet	C16
of	Sheets

MATCHLINE-STA 09+34
FOR CONTINUATION SEE SHEET 17

MATCHLINE-STA 11+92
FOR CONTINUATION SEE SHEET 17

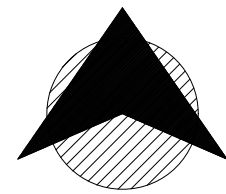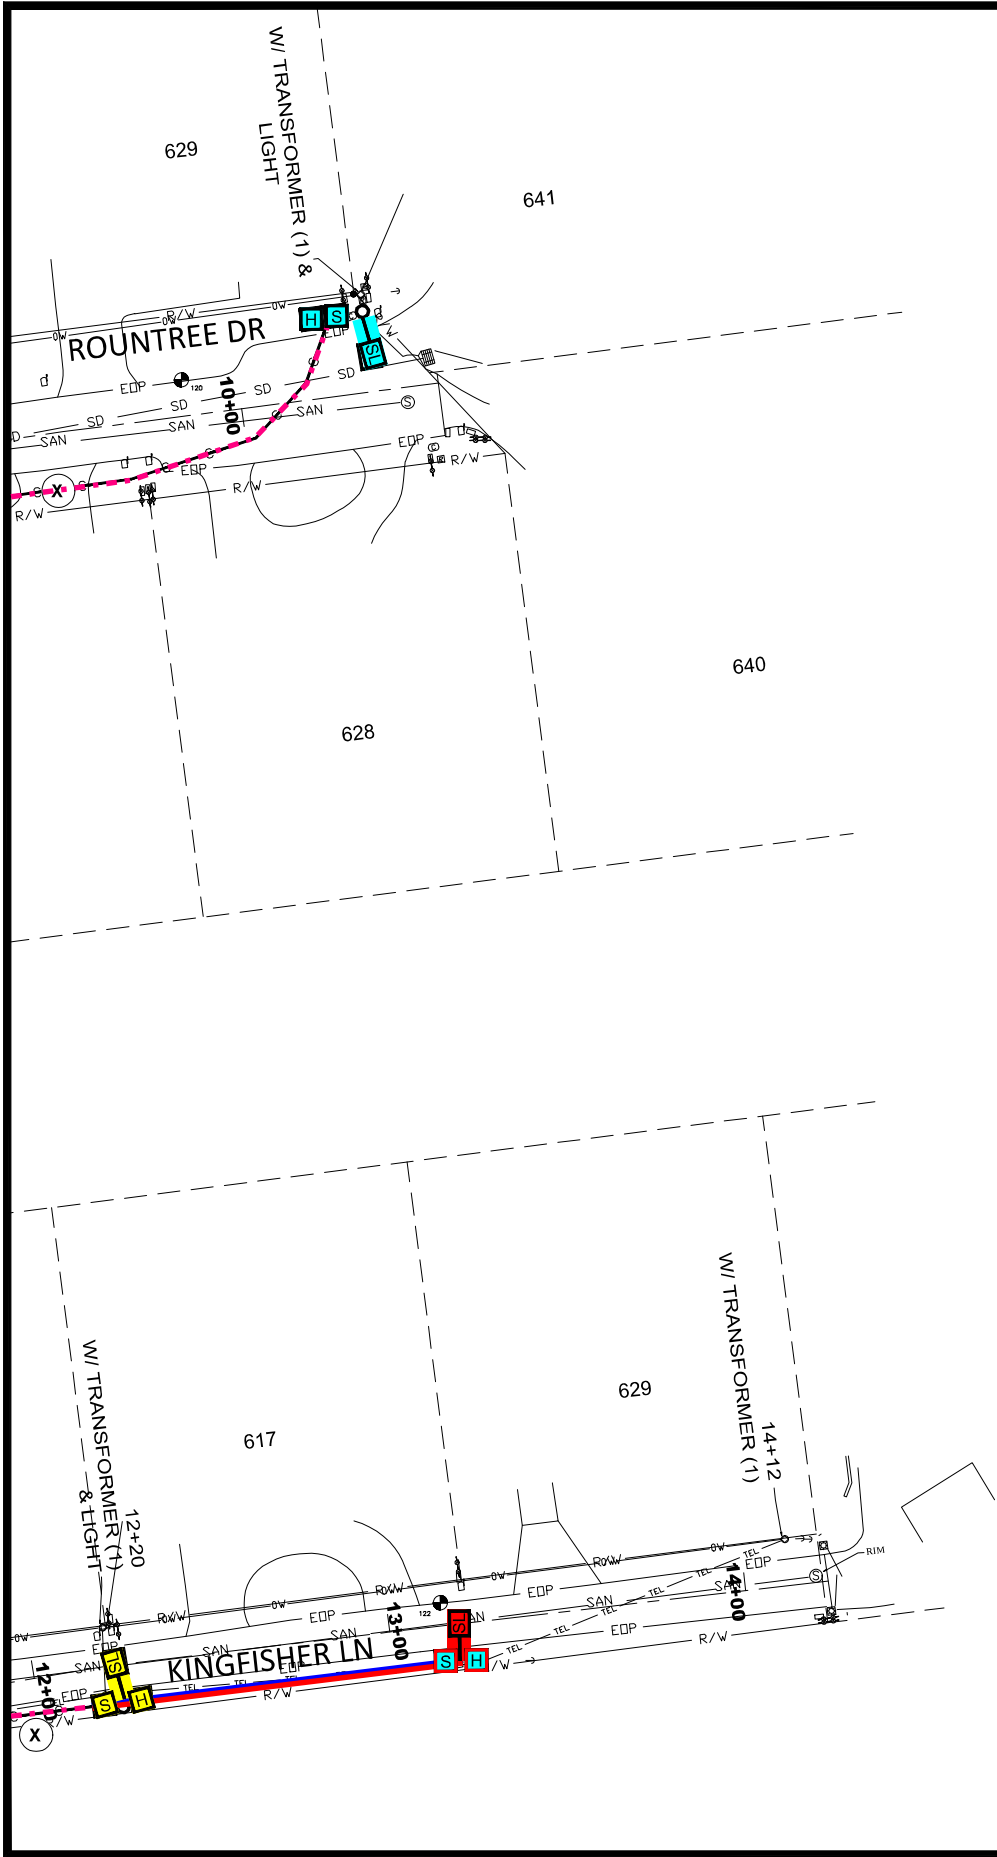

NORTH

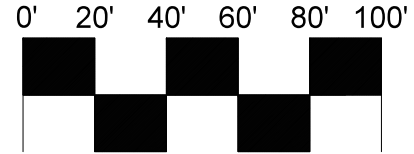

SCALE


NOTE:

- A. 2" HDPE BLACK WITH ORANGE STRIPE FIBER OPTICS CONDUITS ONLY TO BE TERMINATED IN FIBER OPTICS HANDHOLES.
- B. 2" HDPE GRAY STREET LIGHT CONDUITS ONLY TO BE TERMINATED IN STREET LIGHT HANDHOLES.
- C. ALL CONDUIT ENDS TO BE SEALED /CAPPED .

- STREET LIGHT HANDHOLE.
- FIBER OPTICS 36"x60" HANDHOLE.
- PROPOSED STREET LIGHT
- EXISTING STREET POST LIGHT
- EXISTING STREET POST LIGHT WITH STREET SIGN
- EXISTING MASTARM STREET LIGHT

BORE RUNS:

- SEE CONTINUATION SHEET FOR CONDUIT INFORMATION

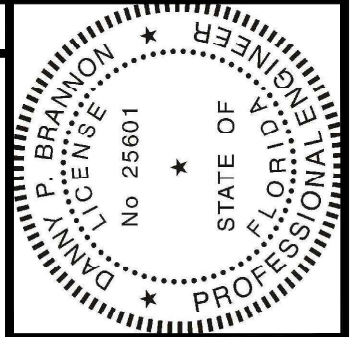

Digitally signed by
Danny P Brannon
Date: 2021.05.06
17:22:09 -04'00'

DANNY P. BRANNON, P. E.
FLORIDA P. E. NO. 25601

DATE

Town of Longboat Key



DRAWINGS FOR:
**FIBER OPTIC AND STREET
LIGHTING UTILITY
PHASE 3 CONSTRUCTION**
LONGBOAT KEY, FLORIDA





Date: 12/01/2020
Scale: AS NOTED
Drawn: DPB
Checked: DPB
Job # 2014-LBK

Sheet

C18


of Sheets

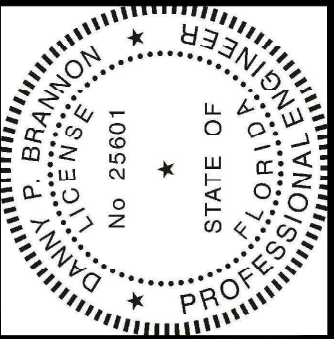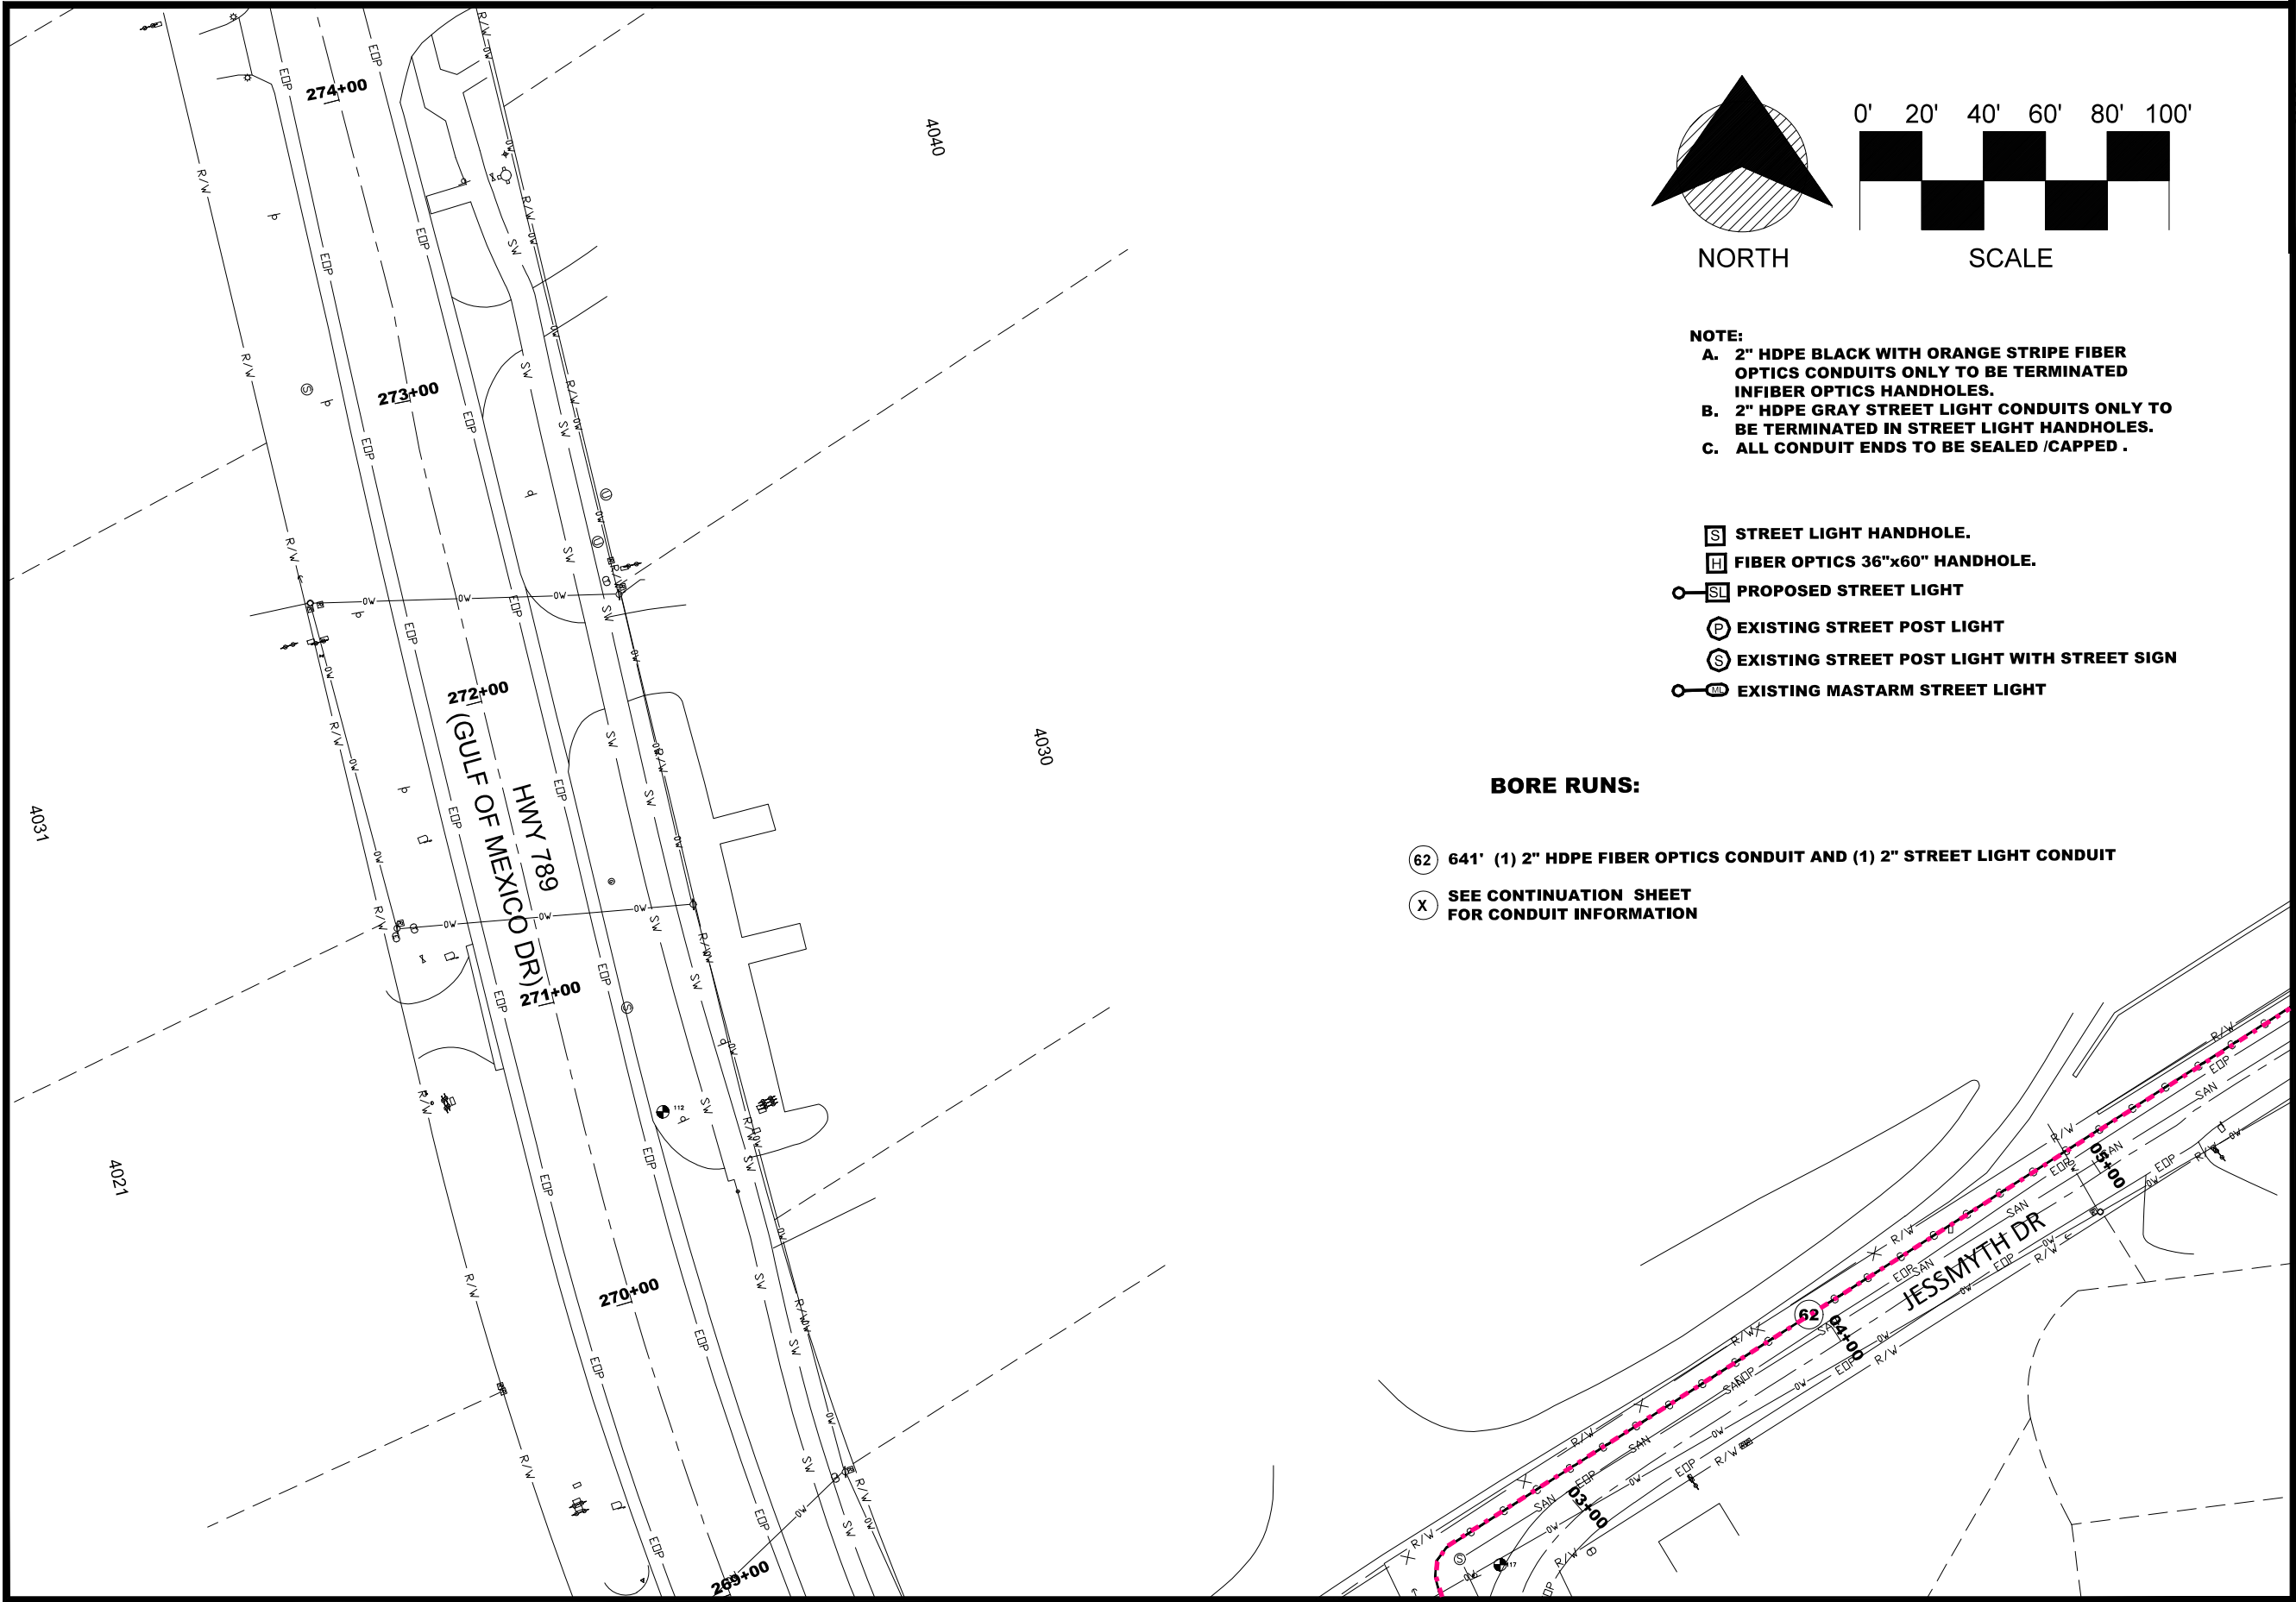

Digitally signed by
Danny P. Brannon
Date: 2021.05.06
17:22:09 -04'00'

DANNY P. BRANNON, P.E.
FLORIDA P. E. NO. 25601
DATE

Town of Longboat Key

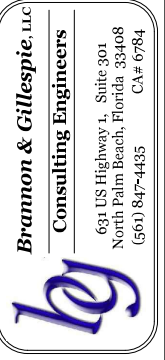


DRAWINGS FOR:
FIBER OPTIC AND STREET
LIGHTING UTILITY
PHASE 3 CONSTRUCTION
LONGBOAT KEY, FLORIDA



Date:	12/01/2020
Scale:	AS NOTED
Drawn:	DPB
Checked:	DPB
Job #	2014-LBK
Sheet	C19
of	Sheets

MATCHLINE-STA 05+74
FOR CONTINUATION SEE SHEET 19


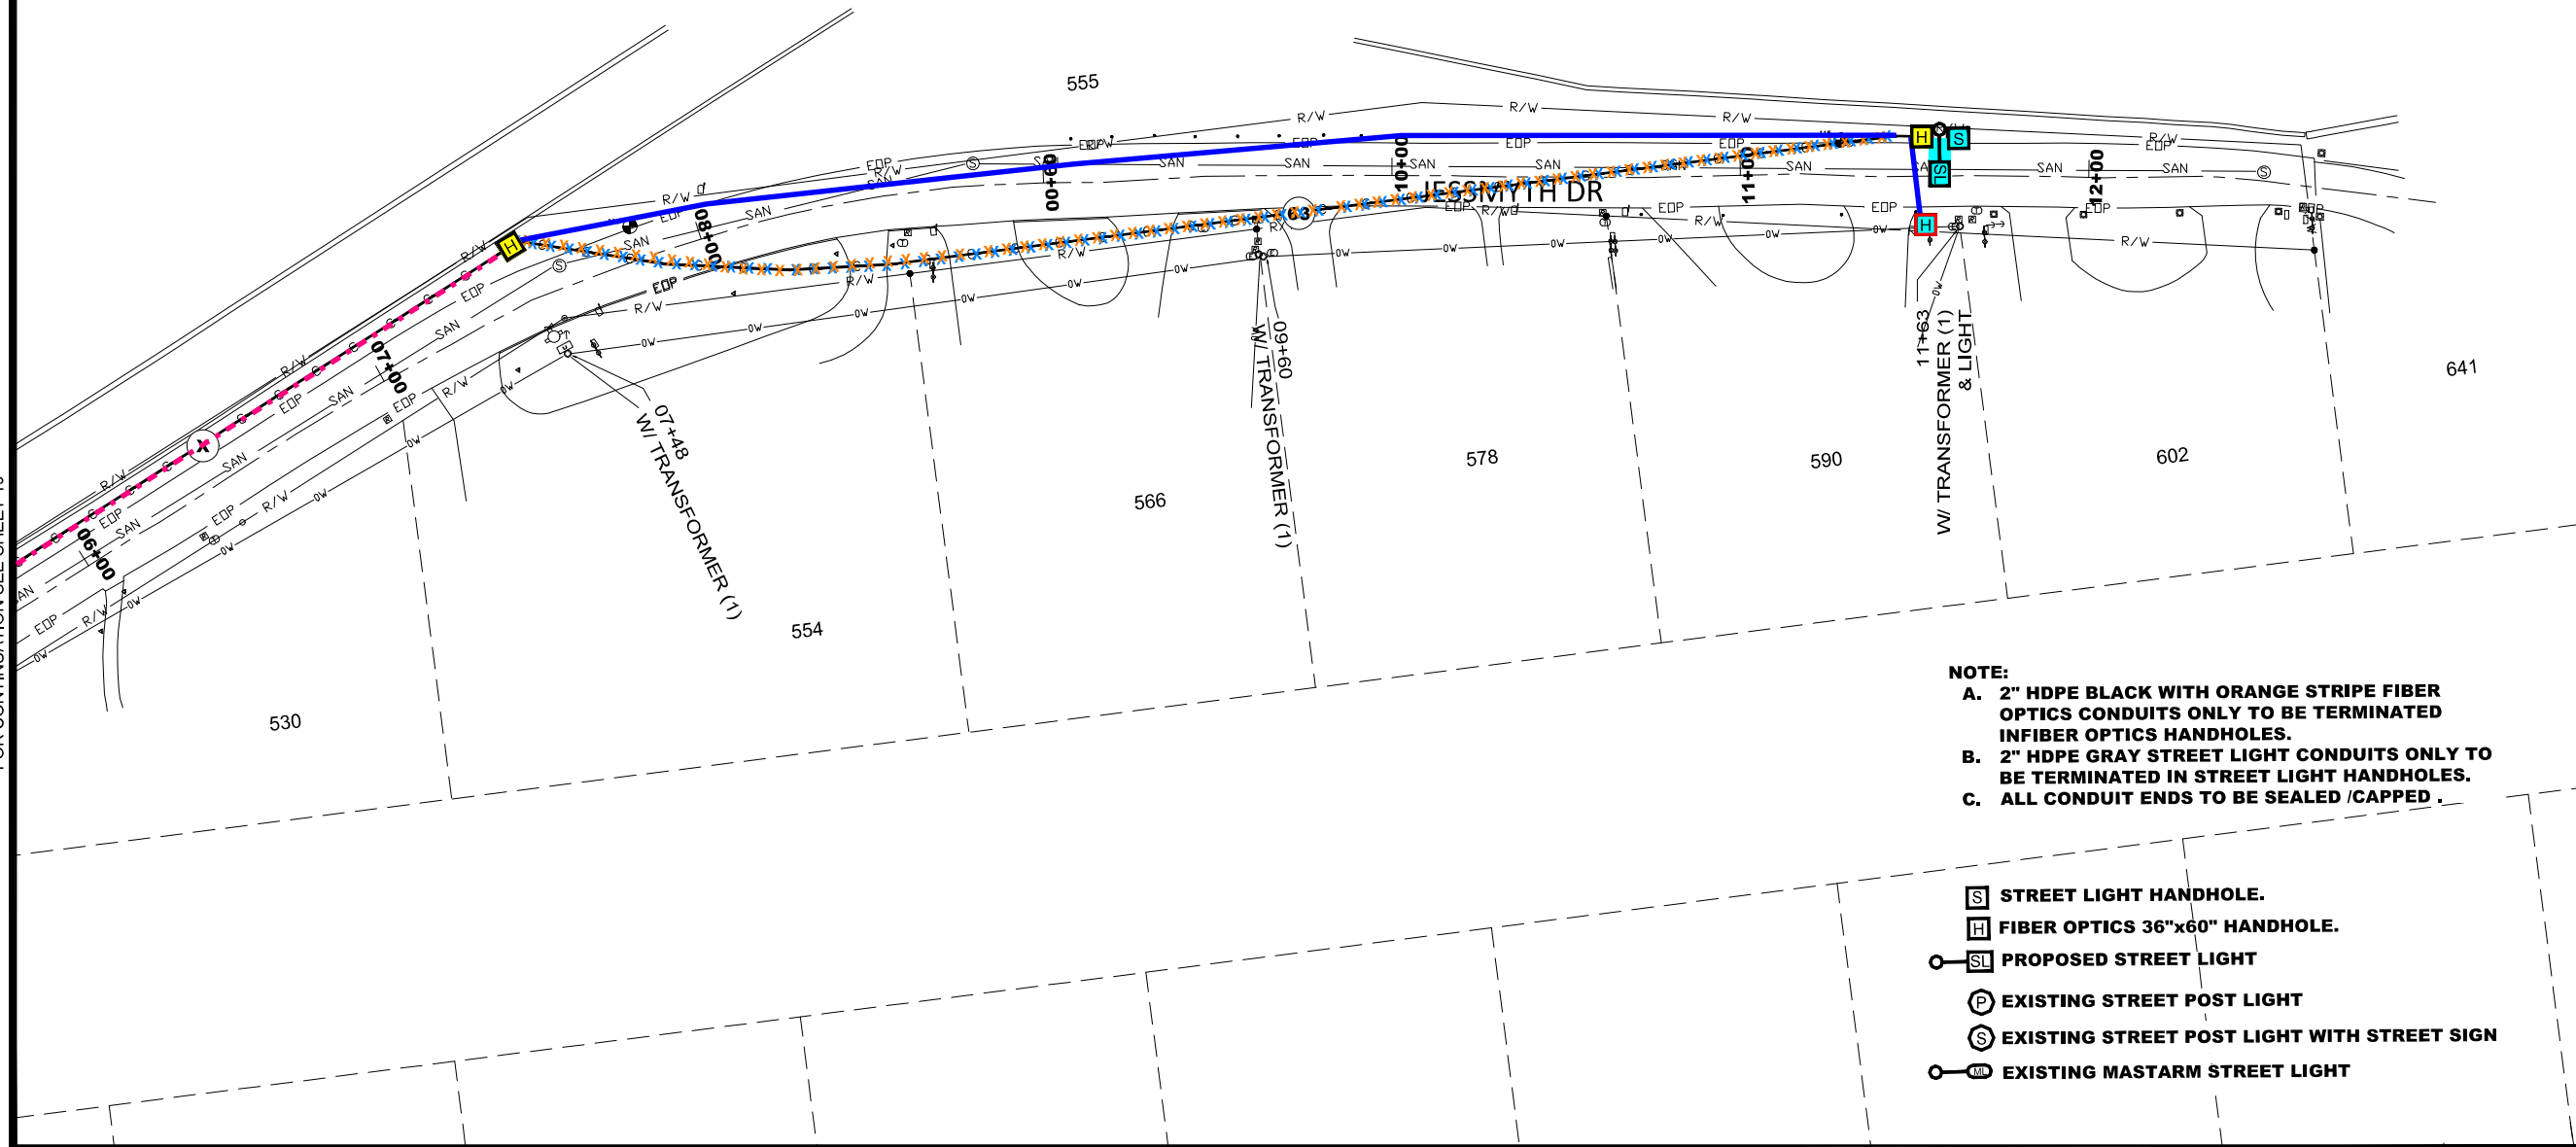


- NOTE:**
- A. 2" HDPE BLACK WITH ORANGE STRIPE FIBER OPTICS CONDUITS ONLY TO BE TERMINATED INFIBER OPTICS HANDHOLES.
 - B. 2" HDPE GRAY STREET LIGHT CONDUITS ONLY TO BE TERMINATED IN STREET LIGHT HANDHOLES.
 - C. ALL CONDUIT ENDS TO BE SEALED /CAPPED .

- [S] STREET LIGHT HANDHOLE.
- [H] FIBER OPTICS 36"x60" HANDHOLE.
- [SL] PROPOSED STREET LIGHT
- [P] EXISTING STREET POST LIGHT
- [S] EXISTING STREET POST LIGHT WITH STREET SIGN
- [M] EXISTING MASTARM STREET LIGHT

BORE RUNS:


- 63 398' (1) 2" HDPE FIBER OPTICS CONDUIT AND (1) 2" STREET LIGHT CONDUIT
- X SEE CONTINUATION SHEET FOR CONDUIT INFORMATION

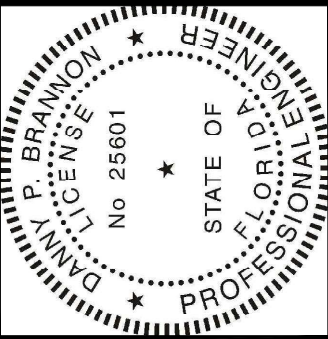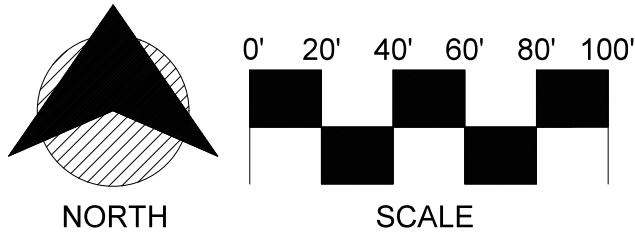

Digitally signed by
Danny P. Brannon
Date: 2021.05.06
17:22:09 -04'00'

DANNY P. BRANNON, P. E.
FLORIDA P. E. NO. 25601
DATE

Town of Longboat Key

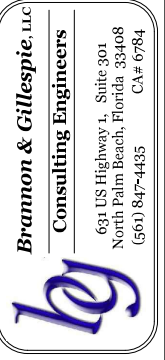

DRAWINGS FOR:
**FIBER OPTIC AND STREET LIGHTING UTILITY
PHASE 3 CONSTRUCTION**
LONGBOAT KEY, FLORIDA



Date:	12/01/2020
Scale:	AS NOTED
Drawn:	DPB
Checked:	DPB
Job #	2014-LBK
Sheet	C20
of	Sheets