

BP 20889

FEDERAL EMERGENCY MANAGEMENT AGENCY
NATIONAL FLOOD INSURANCE PROGRAM

O.M.B. No. 3067-0077
Expires December 31, 2005

ELEVATION CERTIFICATE

Important: Read the instructions on pages 1 - 7.

SECTION A - PROPERTY OWNER INFORMATION

BUILDING OWNER'S NAME RAY R. AND MARLA DILS		For Insurance Company Use:	
BUILDING STREET ADDRESS (Including Apt., Unit, Suite, and/or Bldg. No.) OR P.O. ROUTE AND BOX NO. 1621 HARBOR CAY LANE		Policy Number	
CITY LONGBOAT KEY		STATE FLORIDA	ZIP CODE 34228
PROPERTY DESCRIPTION (Lot and Block Numbers, Tax Parcel Number, Legal Description, etc.) LOT 19, BAY ISLES UNIT 1			
BUILDING USE (e.g., Residential, Non-residential, Addition, Accessory, etc. Use a Comments area, if necessary.) RESIDENTIAL			
LATITUDE/LONGITUDE (OPTIONAL) (##° - ##' - ##.###" or ###.####")		HORIZONTAL DATUM: SOURCE: <input type="checkbox"/> GPS (Type): _____ <input type="checkbox"/> NAD 1927 <input type="checkbox"/> NAD 1983 <input type="checkbox"/> USGS Quad Map <input type="checkbox"/> Other: _____	

SECTION B - FLOOD INSURANCE RATE MAP (FIRM) INFORMATION

B1. NFIP COMMUNITY NAME & COMMUNITY NUMBER LONGBOAT KEY 125126		B2. COUNTY NAME SARASOTA		B3. STATE FLORIDA	
B4. MAP AND PANEL NUMBER 1251260010	B5. SUFFIX B	B6. FIRM INDEX DATE 5/18/92	B7. FIRM PANEL EFFECTIVE/REVISED DATE 8/15/82	B8. FLOOD ZONE(S) AE 13	B9. BASE FLOOD ELEVATION(S) (Zone AO, use depth of flooding) 11'

B10. Indicate the source of the Base Flood Elevation (BFE) data or base flood depth entered in B9.
 FIS Profile FIRM Community Determined Other (Describe): _____

B11. Indicate the elevation datum used for the BFE in B9: NGVD 1929 NAVD 1988 Other (Describe): _____

B12. Is the building located in a Coastal Barrier Resources System (CBRS) area or Otherwise Protected Area (OPA)? Yes No Designation Date _____

SECTION C - BUILDING ELEVATION INFORMATION (SURVEY REQUIRED)

C1. Building elevations are based on: Construction Drawings* Building Under Construction* Finished Construction
 *A new Elevation Certificate will be required when construction of the building is complete.


C2. Building Diagram Number 1 (Select the building diagram most similar to the building for which this certificate is being completed - see pages 6 and 7. If no diagram accurately represents the building, provide a sketch or photograph.)

C3. Elevations - Zones A1-A30, AE, AH, A (with BFE), VE, V1-V30, V (with BFE), AR, AR/A, AR/AE, AR/A1-A30, AR/AH, AR/AO
 Complete Items C3.-a-i below according to the building diagram specified in Item C2. State the datum used. If the datum is different from the datum used for the BFE in Section B, convert the datum to that used for the BFE. Show field measurements and datum conversion calculation. Use the space provided or the Comments area of Section D or Section G, as appropriate, to document the datum conversion.
 Datum NGVD 1929 Conversion/Comments _____

Elevation reference mark used SARCO BM#9 Does the elevation reference mark used appear on the FIRM? Yes No

<input type="checkbox"/> a) Top of bottom floor (including basement or enclosure)	13. 0 ft.(m)
<input type="checkbox"/> b) Top of next higher floor	N. A ft.(m)
<input type="checkbox"/> c) Bottom of lowest horizontal structural member (V zones only)	N. A ft.(m)
<input type="checkbox"/> d) Attached garage (top of slab)	9. 0 ft.(m)
<input type="checkbox"/> e) Lowest elevation of machinery and/or equipment servicing the building (Describe in a Comments area)	12. 0 ft.(m)
<input type="checkbox"/> f) Lowest adjacent (finished) grade (LAG)	7. 7 ft.(m)
<input type="checkbox"/> g) Highest adjacent (finished) grade (HAG)	8. 5 ft.(m)
<input type="checkbox"/> h) No. of permanent openings (flood vents) within 1 ft. above adjacent grade 8	
<input type="checkbox"/> i) Total area of all permanent openings (flood vents) in C3.h 1024 sq. in. (sq. cm)	

License Number, Embossed Seal, Signature, and Date

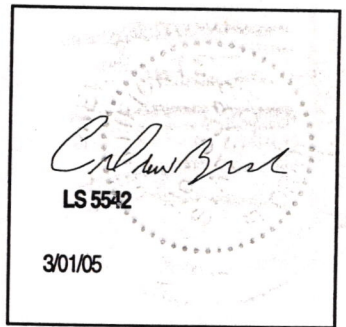

SECTION D - SURVEYOR, ENGINEER, OR ARCHITECT CERTIFICATION

This certification is to be signed and sealed by a land surveyor, engineer, or architect authorized by law to certify elevation information.
 I certify that the information in Sections A, B, and C on this certificate represents my best efforts to interpret the data available.
 I understand that any false statement may be punishable by fine or imprisonment under 18 U.S. Code, Section 1001.

CERTIFIER'S NAME C. DREW BRANCH	LICENSE NUMBER LS 5542		
TITLE PRESIDENT, PROFESSIONAL SURVEYOR & MAPPER	COMPANY NAME DREW BRANCH SURVEYING & MAPPING, INC.		
ADDRESS 909 CATTLEMEN ROAD	CITY SARASOTA	STATE FLORIDA	ZIP CODE 34232
SIGNATURE <i>C. Drew Branch</i>	DATE 3/01/05	TELEPHONE 941-342-6595	

PLANNING, ZONING & RECORDING
TOWN OF LONGBOAT KEY
MAR 7 2005

IMPORTANT: In these spaces, copy the corresponding information from Section A.

BUILDING STREET ADDRESS (Including Apt., Unit, Suite, and/or Bldg. No.) OR P.O. ROUTE AND BOX NO.

For Insurance Company Use:

Policy Number

CITY
SARASOTA

STATE
FL

ZIP CODE
34235

Company NAIC Number

SECTION D - SURVEYOR, ENGINEER, OR ARCHITECT CERTIFICATION (CONTINUED)

Copy both sides of this Elevation Certificate for (1) community official, (2) insurance agent/company, and (3) building owner.

COMMENTS

PROJECT #0310564

Check here if attachments

SECTION E - BUILDING ELEVATION INFORMATION (SURVEY NOT REQUIRED) FOR ZONE AO AND ZONE A (WITHOUT BFE)

For Zone AO and Zone A (without BFE), complete Items E1 through E4. If the Elevation Certificate is intended for use as supporting information for a LOMA or LOMR-F, Section C must be completed.

E1. Building Diagram Number __ (Select the building diagram most similar to the building for which this certificate is being completed - see pages 6 and 7. If no diagram accurately represents the building, provide a sketch or photograph.)

E2. The top of the bottom floor (including basement or enclosure) of the building is __ ft.(m) __ in.(cm) above or below (check one) the highest adjacent grade. (Use natural grade, if available).

E3. For Building Diagrams 6-8 with openings (see page 7), the next higher floor or elevated floor (elevation b) of the building is __ ft.(m) __ in.(cm) above the highest adjacent grade. Complete items C3.h and C3.i on front of form.

E4. The top of the platform of machinery and/or equipment servicing the building is __ ft.(m) __ in.(cm) above or below (check one) the highest adjacent grade. (Use natural grade, if available).

E5. For Zone AO only: If no flood depth number is available, is the top of the bottom floor elevated in accordance with the community's floodplain management ordinance?
 Yes No Unknown. The local official must certify this information in Section G.

SECTION F - PROPERTY OWNER (OR OWNER'S REPRESENTATIVE) CERTIFICATION

The property owner or owner's authorized representative who completes Sections A, B, C (Items C3.h and C3.i only), and E for Zone A (without a FEMA-issued or community-issued BFE) or Zone AO must sign here. *The statements in Sections A, B, C, and E are correct to the best of my knowledge.*

PROPERTY OWNER'S OR OWNER'S AUTHORIZED REPRESENTATIVE'S NAME

ADDRESS

CITY

STATE

ZIP CODE

SIGNATURE

DATE

TELEPHONE

COMMENTS

Check here if attachments

SECTION G - COMMUNITY INFORMATION (OPTIONAL)

The local official who is authorized by law or ordinance to administer the community's floodplain management ordinance can complete Sections A, B, C (or E), and G of this Elevation Certificate. Complete the applicable item(s) and sign below.

G1. The information in Section C was taken from other documentation that has been signed and embossed by a licensed surveyor, engineer, or architect who is authorized by state or local law to certify elevation information. (Indicate the source and date of the elevation data in the Comments area below.)

G2. A community official completed Section E for a building located in Zone A (without a FEMA-issued or community-issued BFE) or Zone AO.

G3. The following information (Items G4-G9) is provided for community floodplain management purposes.

G4. PERMIT NUMBER	G5. DATE PERMIT ISSUED	G6. DATE CERTIFICATE OF COMPLIANCE/OCCUPANCY ISSUED
-------------------	------------------------	---

G7. This permit has been issued for: New Construction Substantial Improvement

G8. Elevation of as-built lowest floor (including basement) of the building is:

__ . __ ft.(m)

Datum: __

G9. BFE or (in Zone AO) depth of flooding at the building site is:

__ . __ ft.(m)

Datum: __

LOCAL OFFICIAL'S NAME

TITLE


COMMUNITY NAME

TELEPHONE


SIGNATURE

DATE

COMMENTS

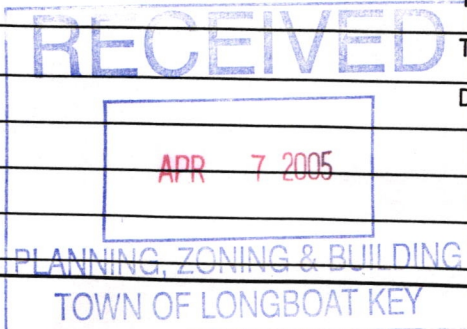

Check here if attachments

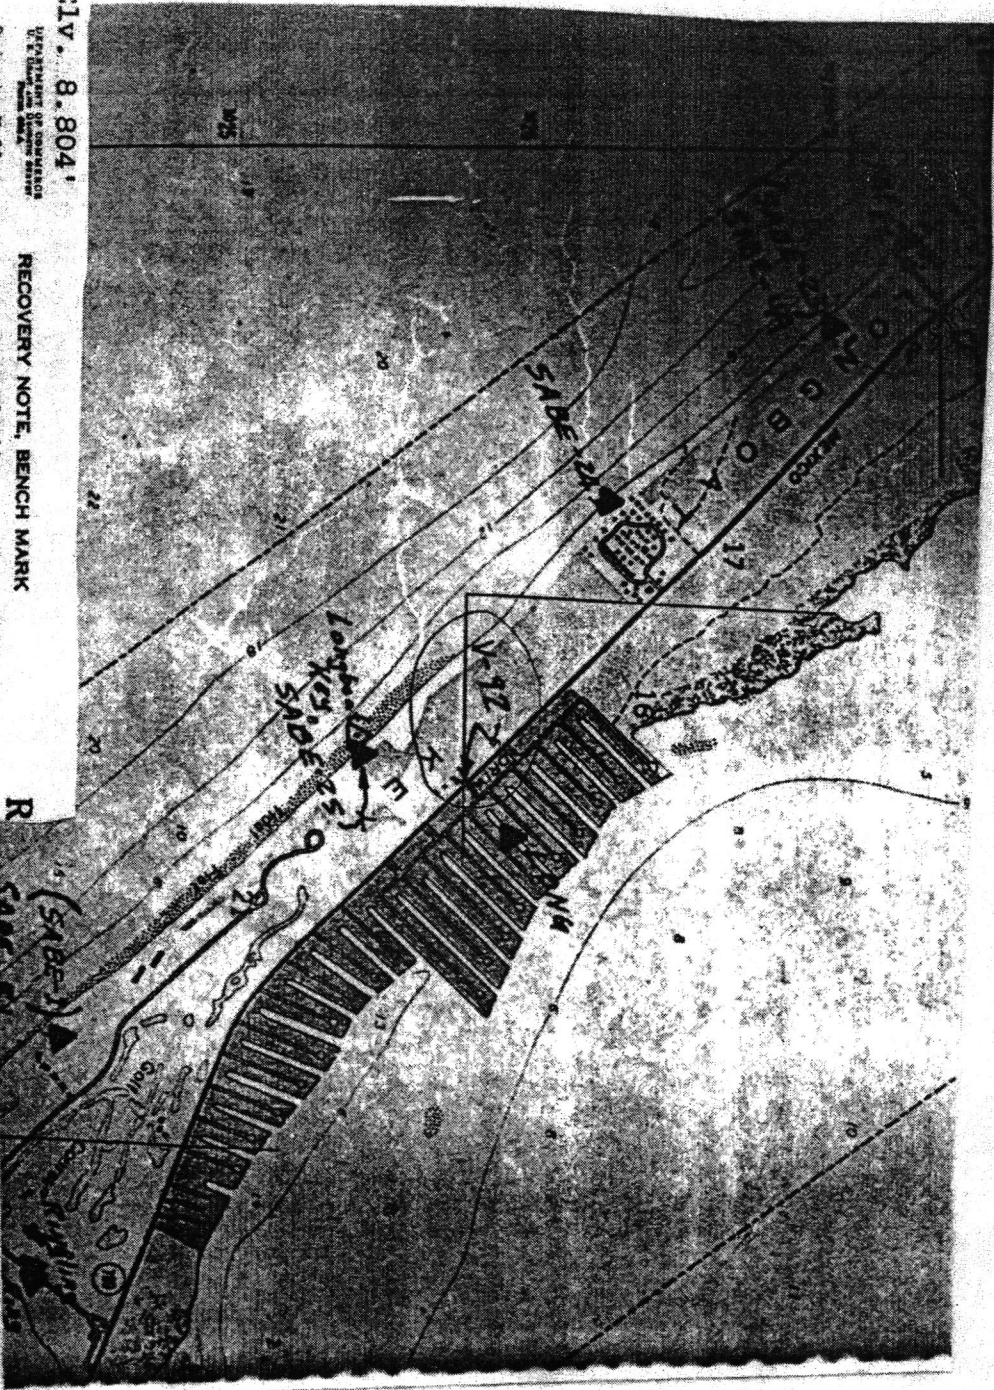

Elev. 8.804'



RECOVERY NOTE, BENCH MARK

DEPARTMENT OF TRANSPORTATION
 STATE ENGINEERING DIVISION
 DESIGNATION: V 92
 NEAREST TOWN: Sarasota
 CHARACTER OF MARK: standard disk
 ESTABLISHED BY: Coast and Geodetic Survey
 PRESENT CONDITION: Good
 DETAILED REPORT: Recovered as described. The following corrections are applicable:

1. State Highway No. 16 has been renumbered 780
2. The wooden witness post no longer exists.

6.0 miles northeast along State Highway 16 from the post office at Sarasota, on Long Beach Road on Longport Key, at a road intersection, 35.6 feet northeast of the centerline of the highway, 17 feet northwest of the centerline of the cross road, 2 feet southwest of a white wooden witness post, and about 1-1/2 feet lower than the highway.

R

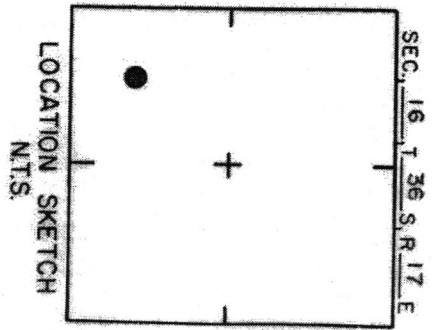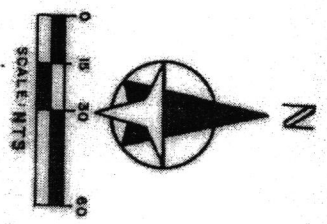

<p>SARASOTA COUNTY TRANSPORTATION DEPARTMENT ENGINEERING DIVISION</p>				<p>BENCH MARK DATA SHEET</p>	
				DATE DRAWN: APRIL 1987	BY: RJJ
<p>REF: NOS V-92</p>		DATE 5/53	<p>REVISIONS</p>		
<p>ELEV. BASED ON B.M. NO.</p>		BM NO.	<p>9</p>		