



SHALLOW MANHOLE (DEPTH TO INVERT 4'-0" OR LESS)
SCALE: 1/2" = 1'-0"

TYPICAL MANHOLE (4'-0" TO 10'-0" DEPTH TO INVERT)
SCALE: 1/2" = 1'-0"

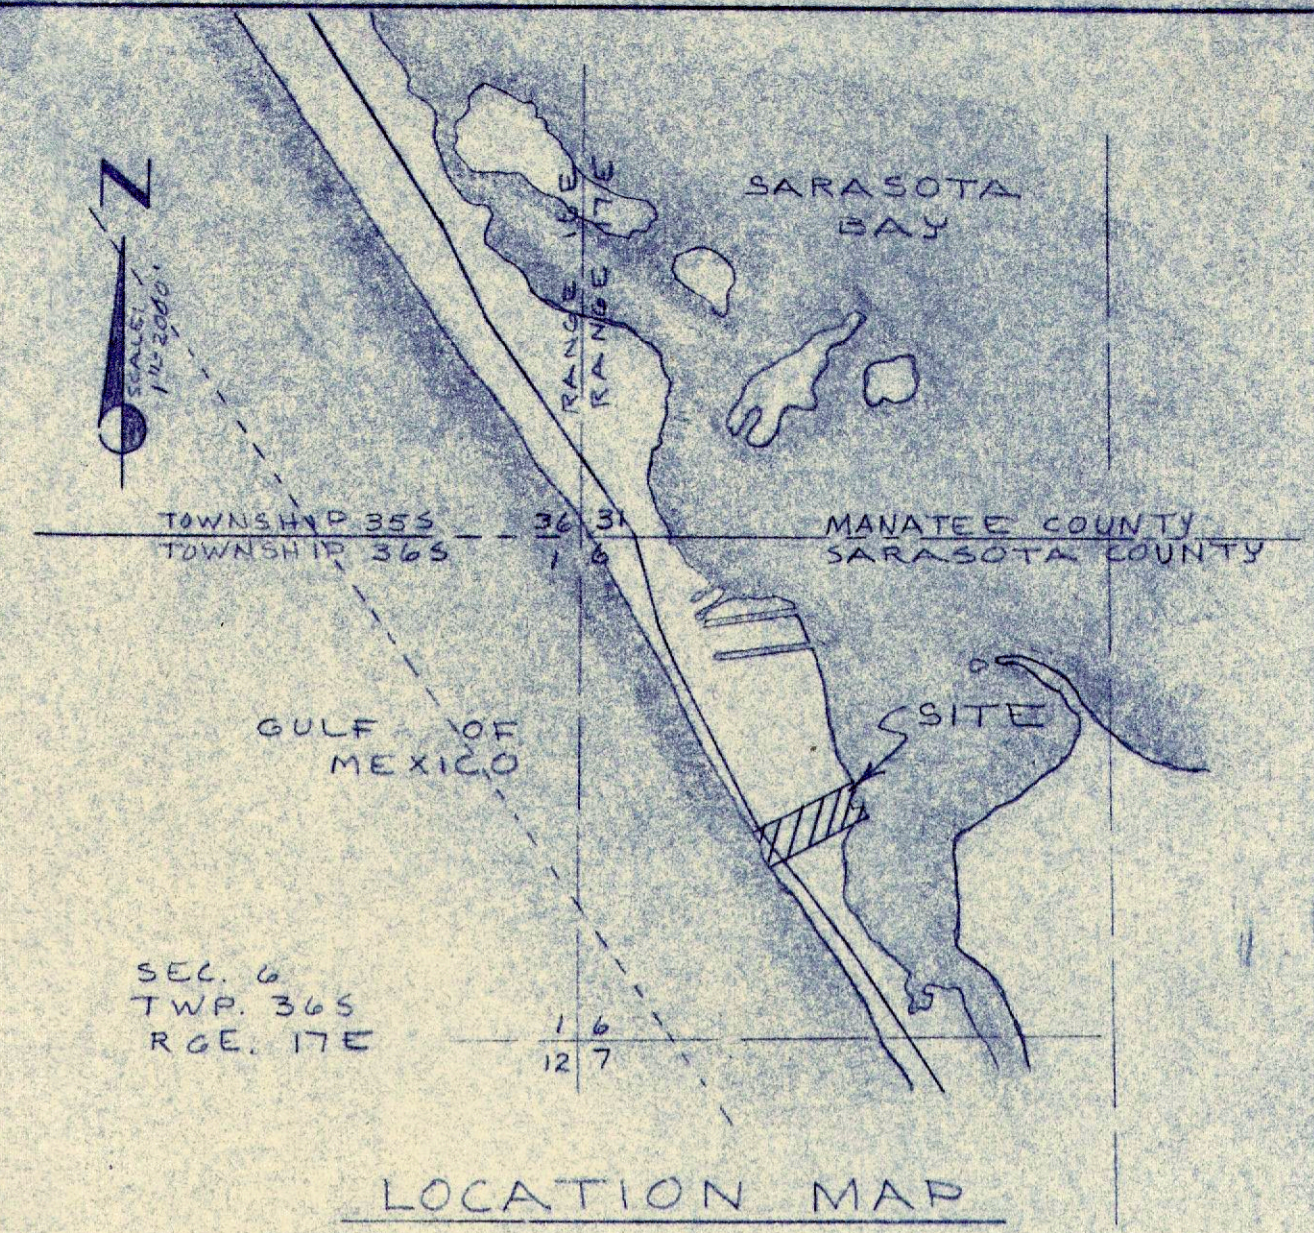



LOCATION MAP

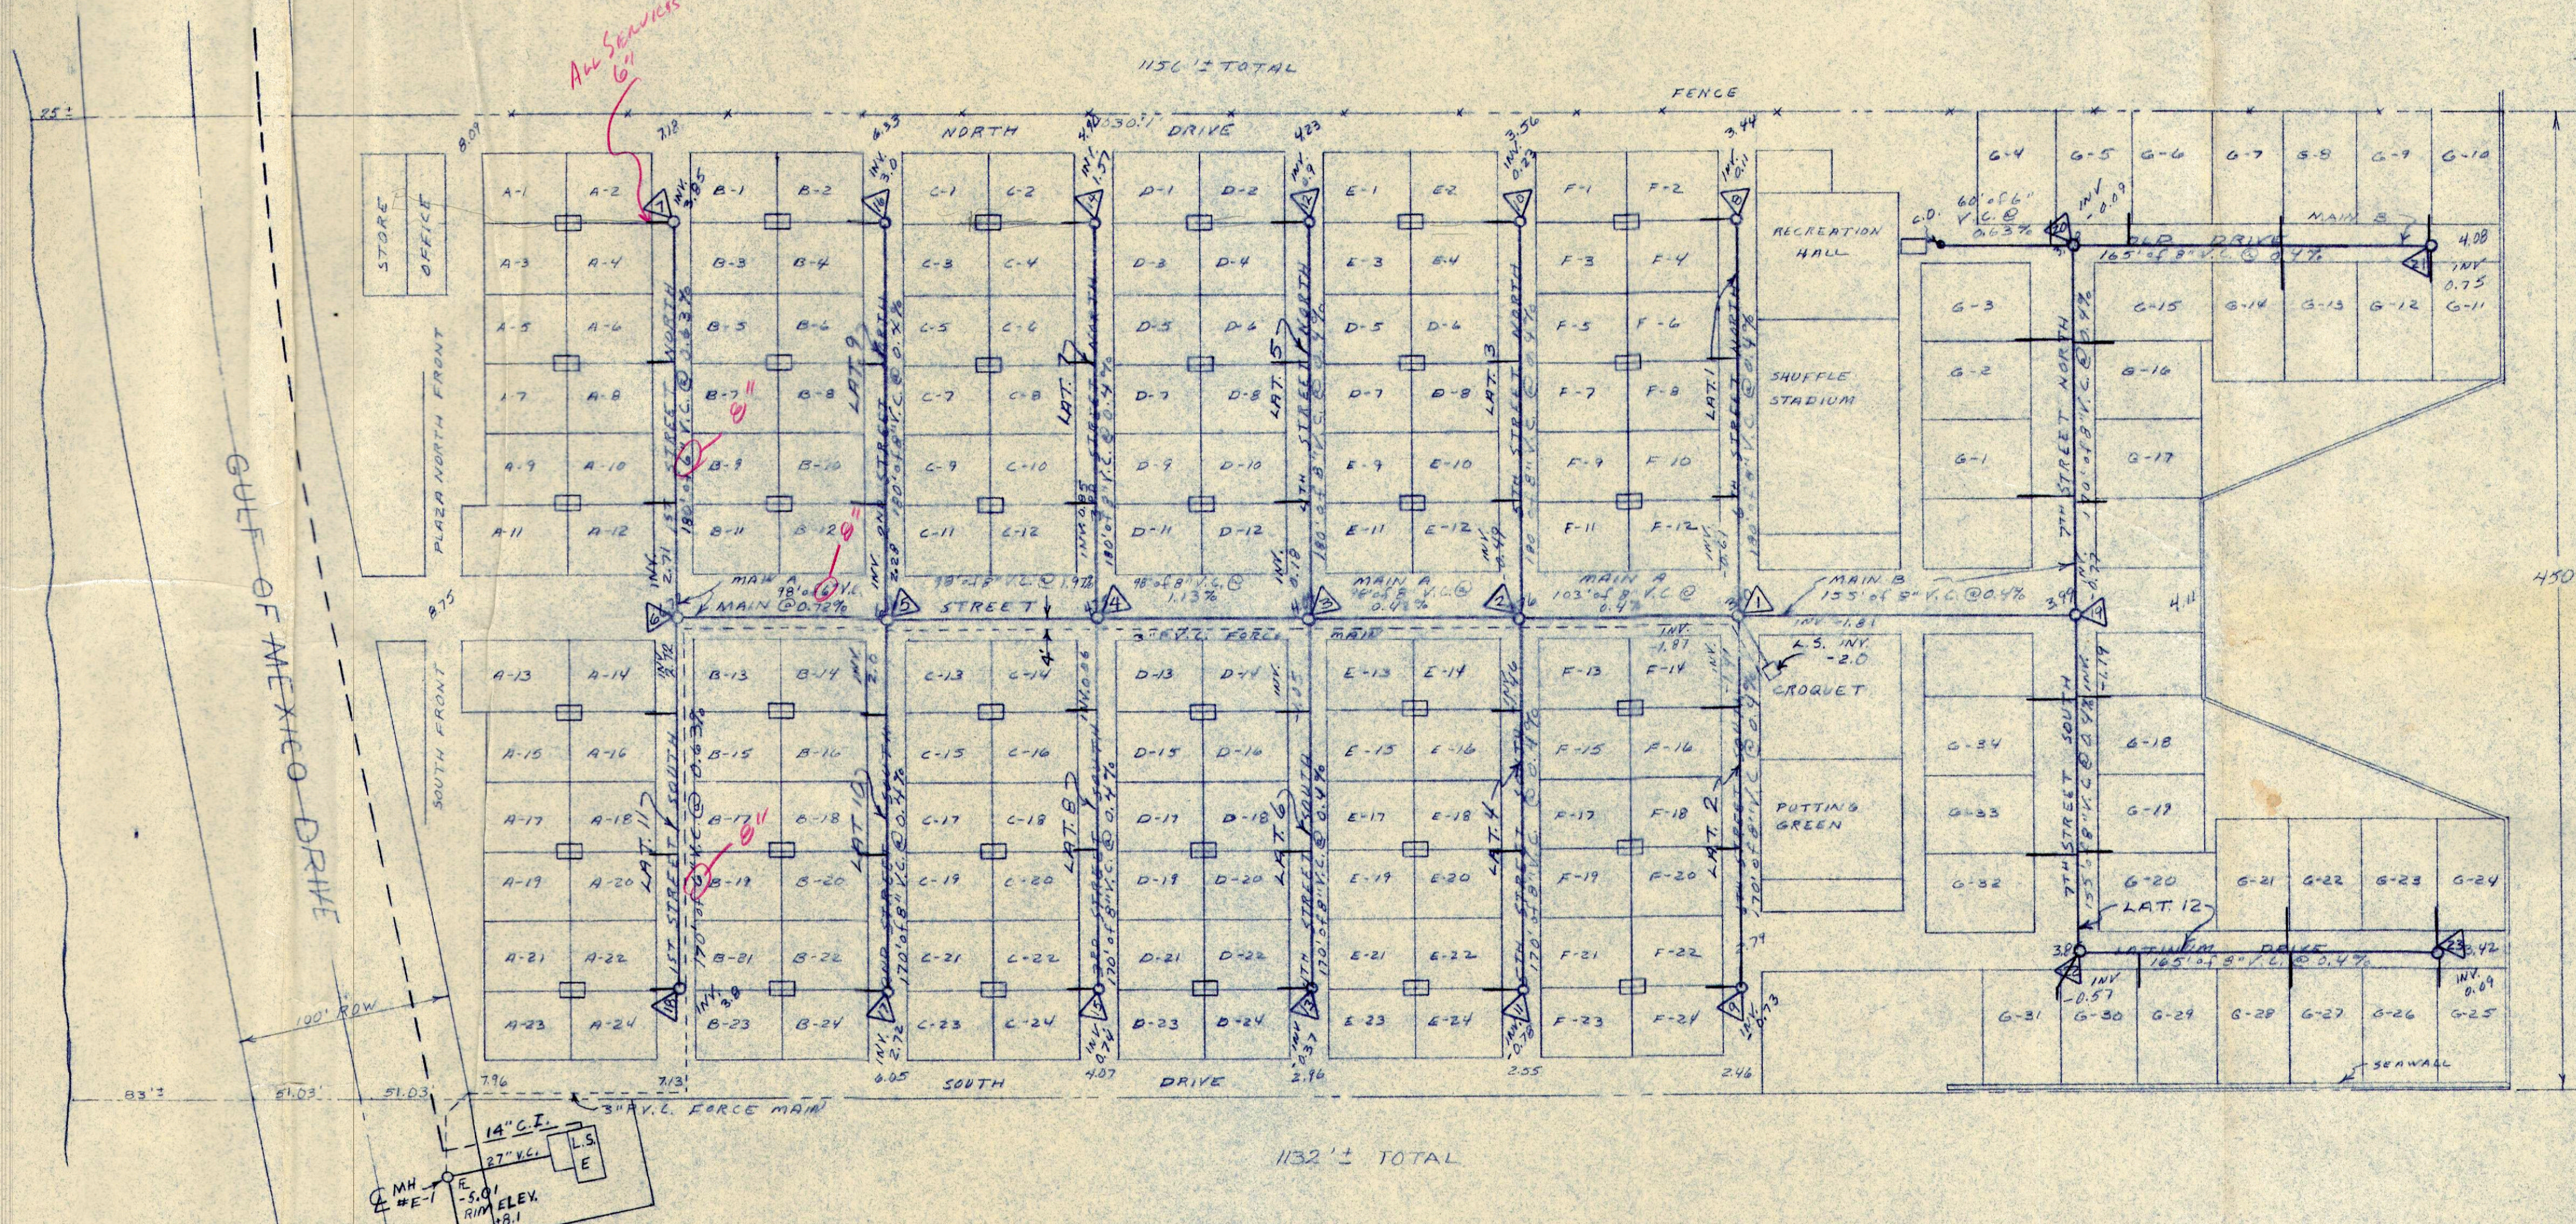

GULF OF MEXICO

SARASOTA BAY

- Note
1. Conn For Store-Office?
 2. Conn For Rec. Bldg?
 3. Cover 26" or Conc.
 4. Service Lat=6" UCD

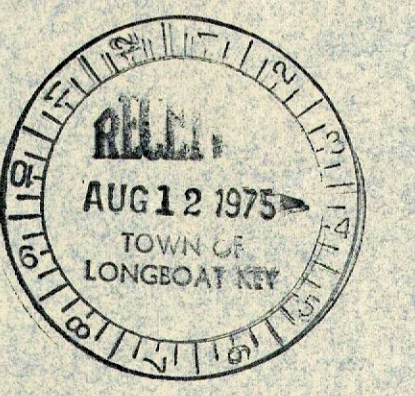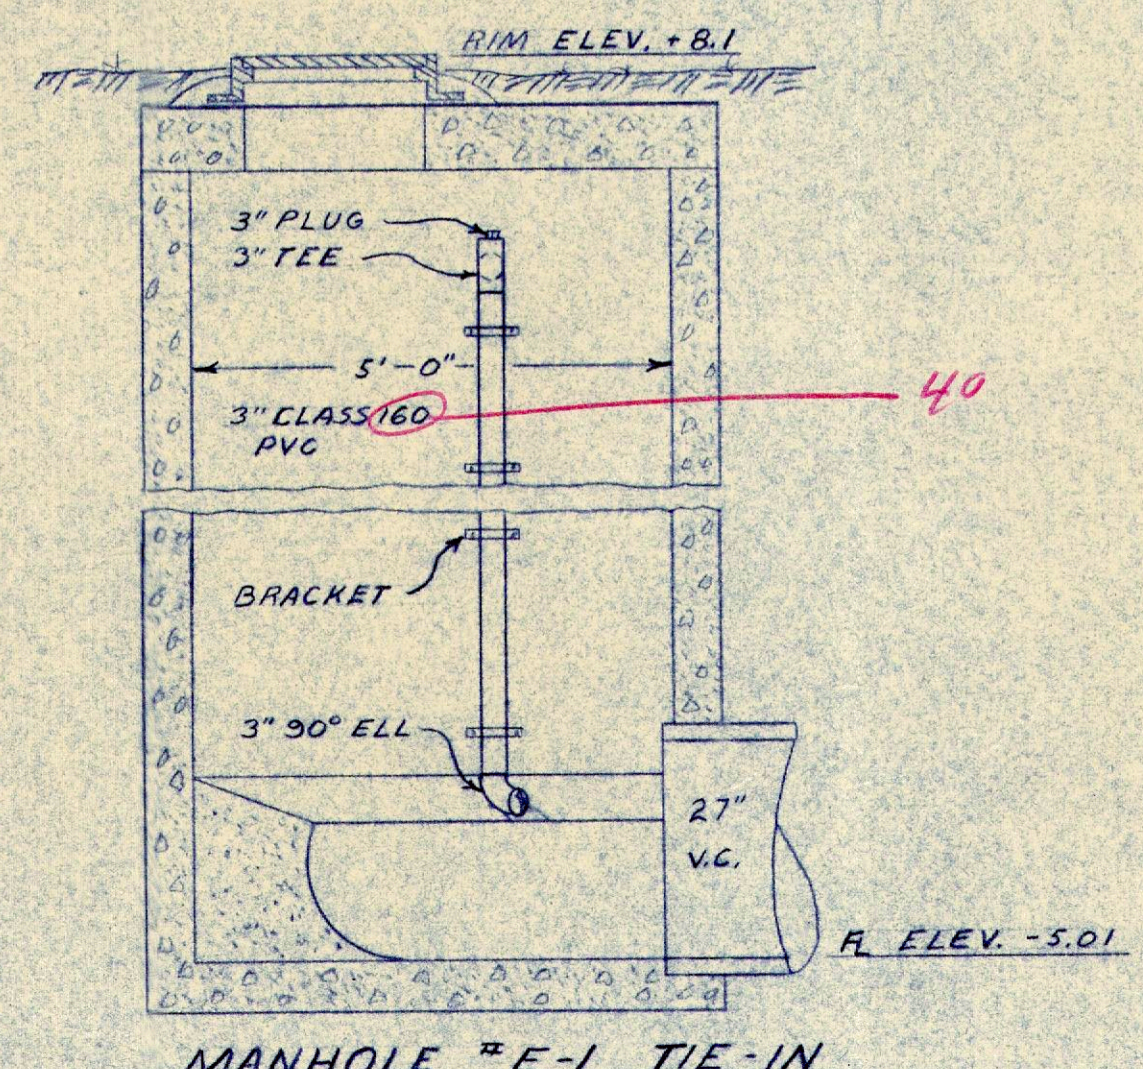

RE TURN

SEWER PLAN
GULFSHORE TRAILER CITY
SARASOTA, FLORIDA

TRIAD TECH., INC.
6027-17TH STREET EAST
BRADENTON, FLA. 33507
PHONE: 756-6311

DATE: 7-24-75 SCALE: 1"=50' DRAWN BY: mmo

APPROVED: James B. Kennedy
FLORIDA REGISTERED ENGINEER NO. 6500

SHEET 1 OF 4