
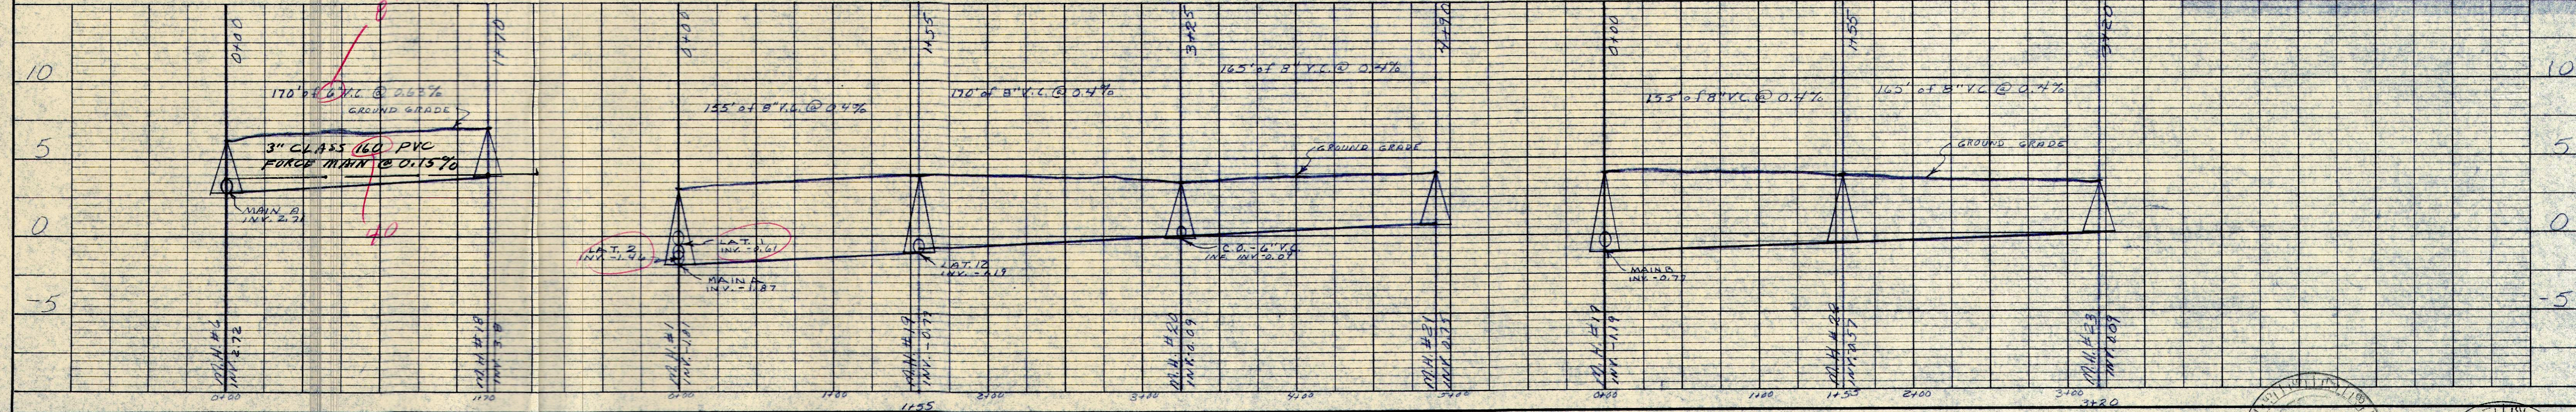
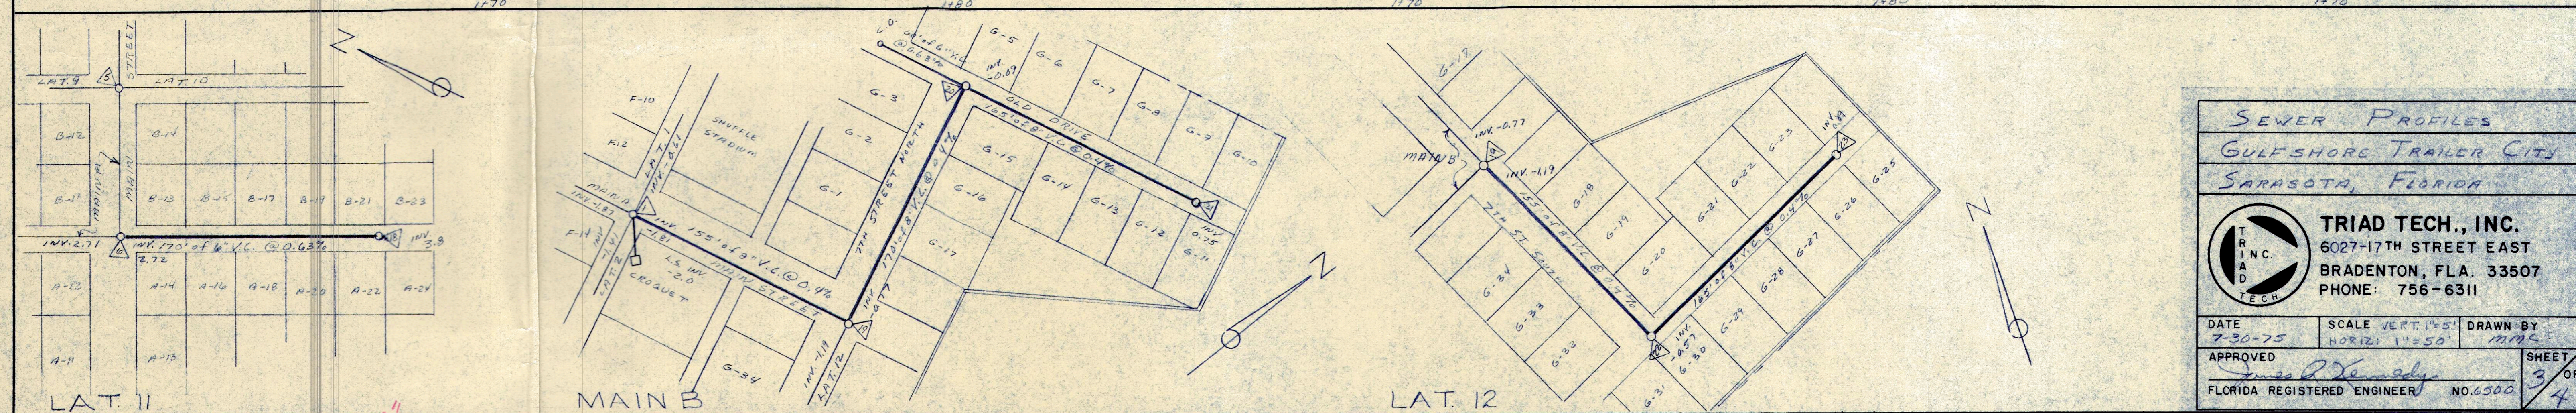
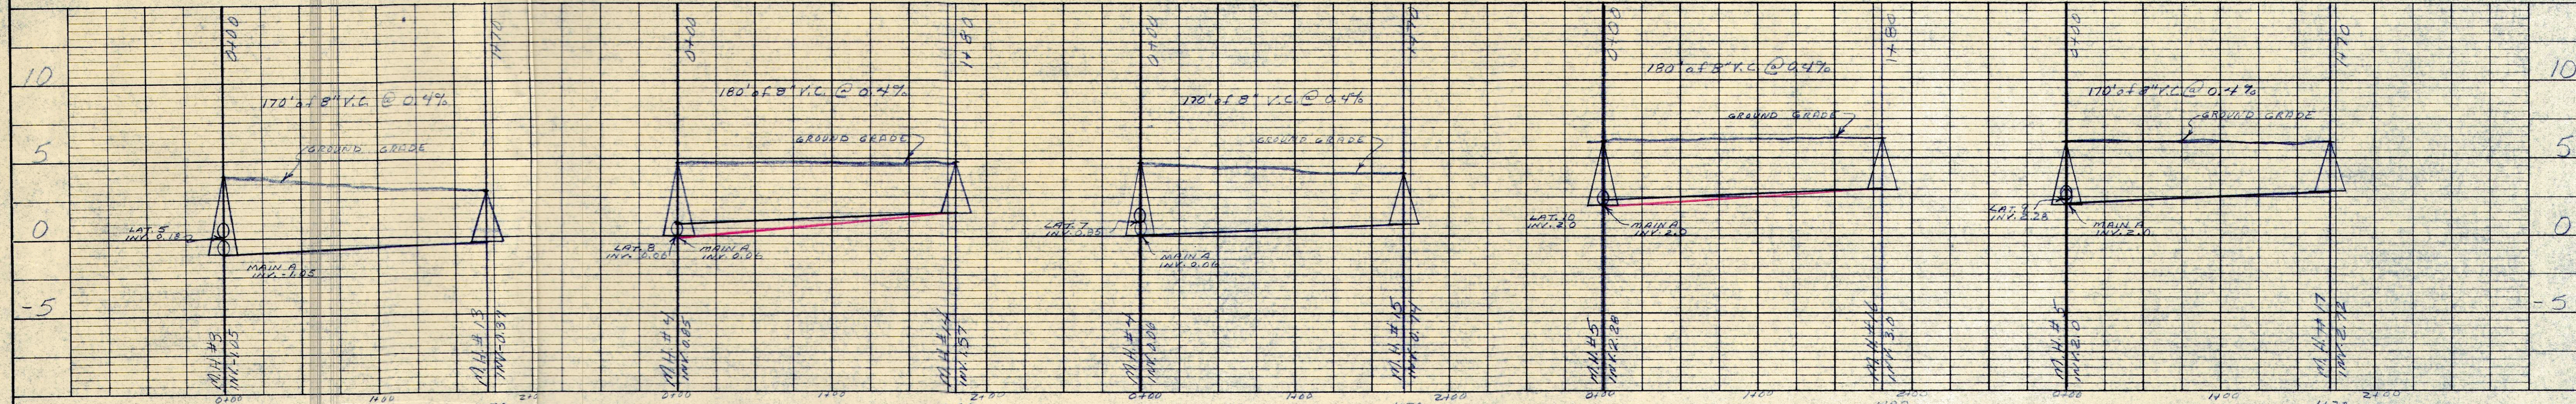


DATE: _____ BY: _____
 PLAN
 ALIGNMENT CHECKER
 NO. _____

DATE: _____ BY: _____
 PROFILE
 GRADE CHECKER
 NO. _____

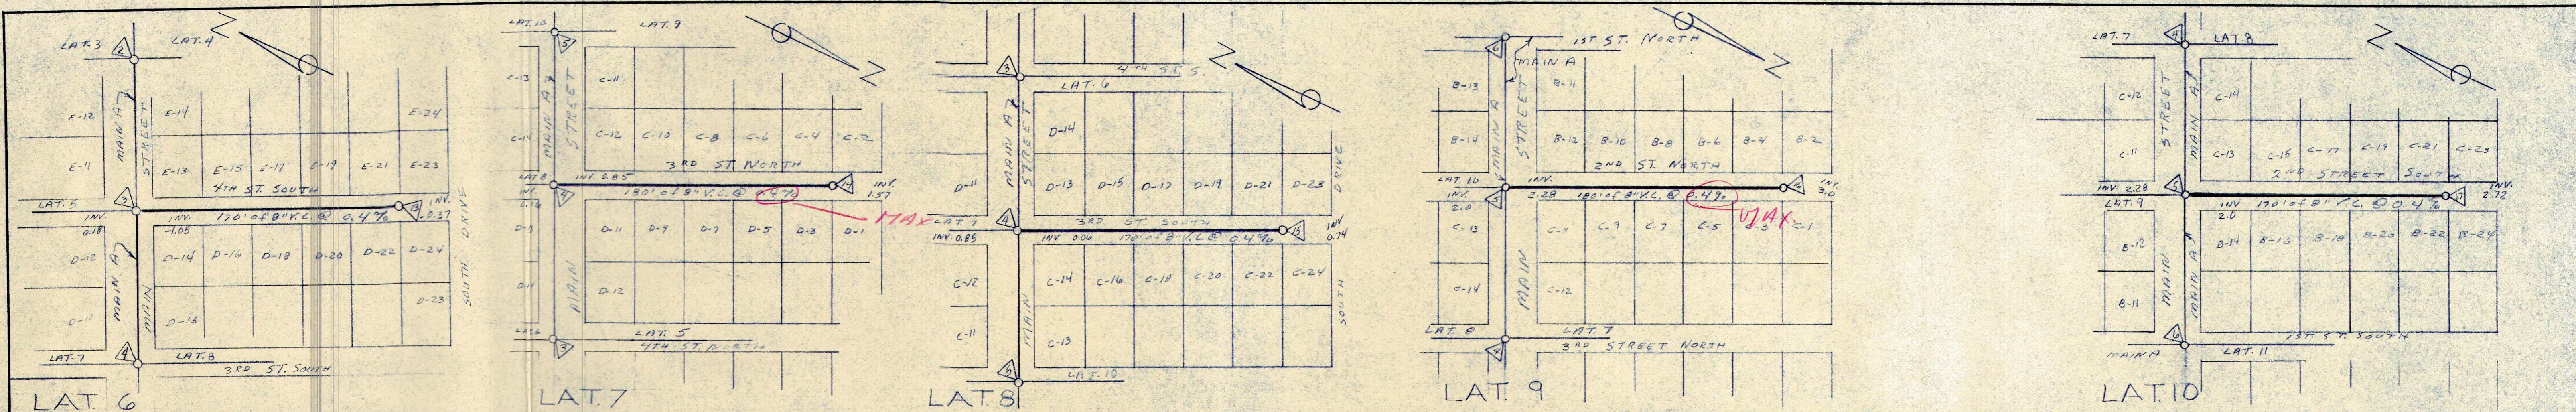

SEWER PROFILES
 GULFSHORE TRAILER CITY
 SARASOTA, FLORIDA

TRIAD TECH., INC.
 6027-17TH STREET EAST
 BRADENTON, FLA. 33507
 PHONE: 756-6311

DATE: 7-30-75 SCALE VERT. 1"=5' DRAWN BY: MMS
 HORIZ. 1"=50'
 APPROVED: *James P. Kennedy* SHEET 3 OF 4
 FLORIDA REGISTERED ENGINEER NO. 6500

