


PLAN

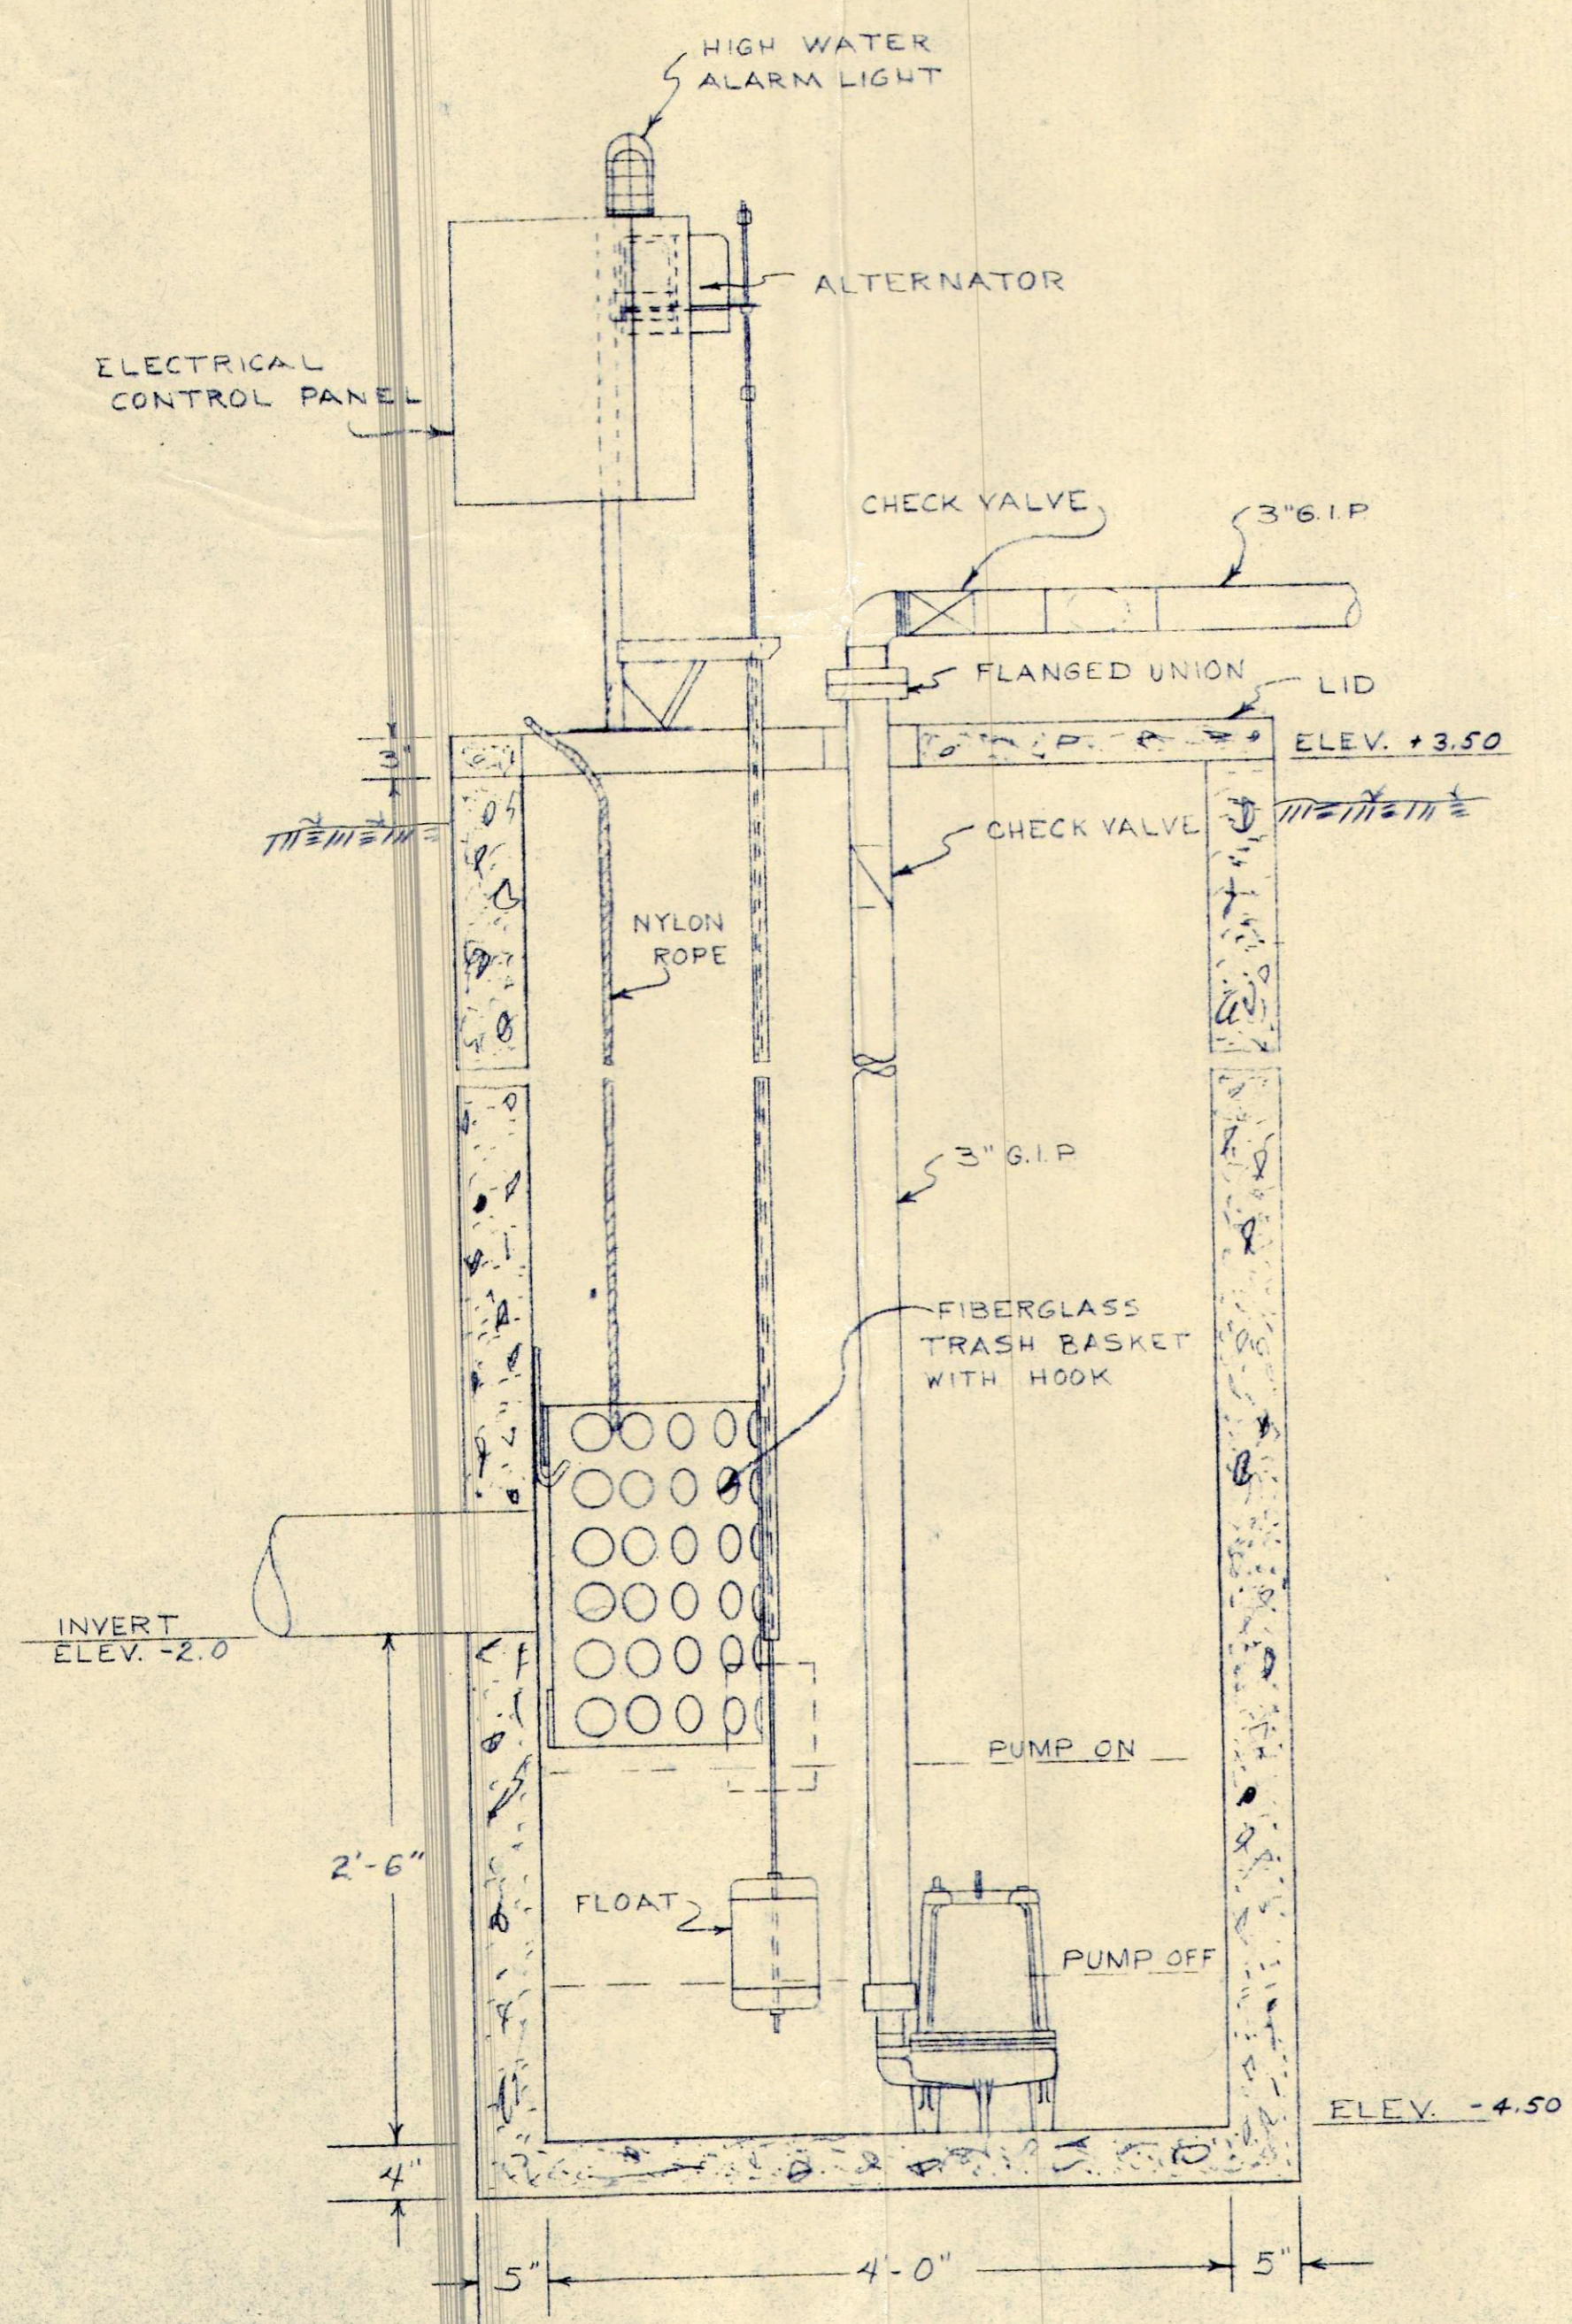

SECTION


NOTES:

1. THE WET WELL CONSISTS OF A 48" REINFORCED CONCRETE PIPE AND BASE WITH A 22" SQUARE MANHOLE AND FIBERGLASS COVER.
2. A 14" x 16" x 24" FIBERGLASS TRASH BASKET SHALL BE INCLUDED WITH FIBERGLASS HOOK AND A NYLON ROPE.
3. A FLOAT CONTROLLED, AUTOMATIC ALTERNATOR SHALL BE INCLUDED WITH AN ODOMETER TO MEASURE FLOW AND A HIGH WATER ALARM LIGHT.
4. ALL PIPING SHALL BE SCHEDULE 40 G.I.P.

2 Pumps reqd.

PUMPS	BARNES
MODEL	SE-54
SIZE	3"
H.P.	1/2
PHASE	SINGLE
VOLTAGE	250
R.P.M.	1750
S.P.M.	70
T.D.H.	18

SCALE: 1"=1'-0"

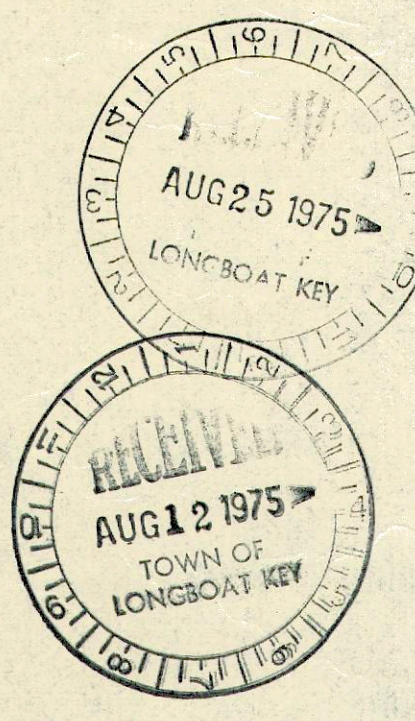

LIFT STATION
GULFSHORE TRAILER CITY
LONGBOAT KEY, FLORIDA

TRIAD TECH., INC.
6027-17TH STREET EAST
BRADENTON, FLA. 33507
PHONE: 756-6311

DATE: 8-6-75 SCALE: 1"=1'-0" DRAWN BY: MMS

APPROVED: *James R. Kennedy*
FLORIDA REGISTERED ENGINEER NO. 6500

SHEET 4 OF 4