


INSTALLATION OF TOWN OWNED FIBER OPTIC AND STREET LIGHTING ALONG GULF OF MEXICO DRIVE

PHASE 4

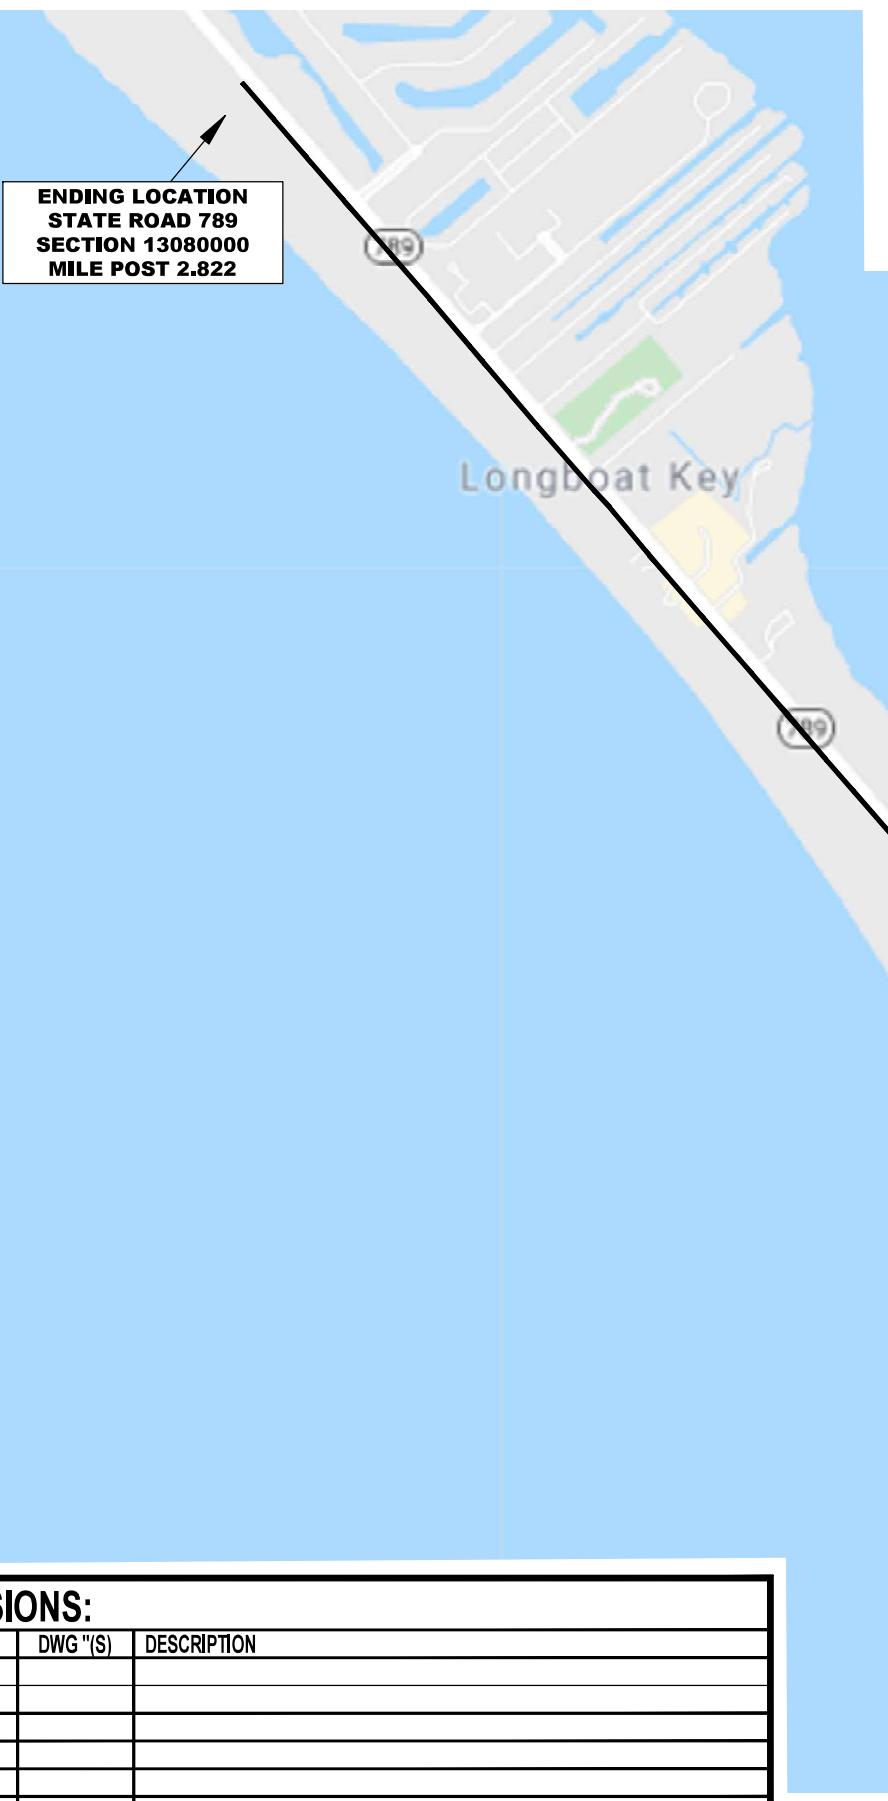

REVISIONS:

DATE	DWG "(S)"	DESCRIPTION

DRAWING LEGEND

- K1- RISERS AND LOAD CALCS
- K2- RISERS AND LOAD CALCS
- K3- RISERS AND LOAD CALCS
- D1- GMD POLE DETAIL
- D2- NEIGHBORHOOD POLE DETAIL
- D3- POLE WIRING DETAIL
- D4- PANEL RACK DETAIL
- P1- GMD PHOTOMETRICS
- P2- GMD PHOTOMETRICS
- P3- GMD PHOTOMETRICS
- S1- GMD SECTION DRAWINGS
- S2- GMD SECTION DRAWINGS
- S3- GMD SECTION DRAWINGS

DRAWING LEGEND

- COVER
- GMD SHEET KEY MAP
- G1- GMD PLAN DRAWING
- G2- GMD PLAN DRAWING
- G3- GMD PLAN DRAWING
- G4- GMD PLAN DRAWING
- G5- GMD PLAN DRAWING
- G6- GMD PLAN DRAWING
- G7- GMD PLAN DRAWING
- G8- GMD PLAN DRAWING
- G9- GMD PLAN DRAWING
- G10- GMD PLAN DRAWING
- G11- GMD PLAN DRAWING
- G12- GMD PLAN DRAWING
- G13- GMD PLAN DRAWING
- G14- GMD PLAN DRAWING
- G15- GMD PLAN DRAWING
- G16- GMD PLAN DRAWING
- G17- GMD PLAN DRAWING
- G18- GMD PLAN DRAWING
- G19- GMD PLAN DRAWING
- G20- GMD PLAN DRAWING
- G21- GMD PLAN DRAWING
- G22- GMD PLAN DRAWING

CALL BEFORE YOU DIG




IT IS THE CONTRACTOR'S RESPONSIBILITY TO CONTACT UTILITIES TO DETERMINE THE EXACT LOCATION OF UTILITIES SHOWN ON THIS PLAN. THESE ARE APPROXIMATE AND POSSIBLY INCOMPLETE. THEREFORE CERTIFICATION TO THE LOCATION OF ALL UNDERGROUND UTILITIES IS WITHHELD.

CONTRACTOR SHALL VERIFY ALL PLAN & EXISTING DIMENSIONS & CONDITIONS ON THE ROUTE BEFORE PROCEEDING WITH THE WORK AND IS RESPONSIBLE FOR SAME

UTILITIES SHOWN ON PLANS ARE APPROXIMATE LOCATIONS AND WERE ACQUIRED FROM THE BEST AVAILABLE DATA AND REASONABLY OBTAINED BY PHYSICAL FIELD SURVEY.

RECLAIMED	YES
WATER MAIN	YES
SEWER - F/M	YES
ELECTRIC	YES
CATV	YES
GAS	YES
TELEPHONE	YES

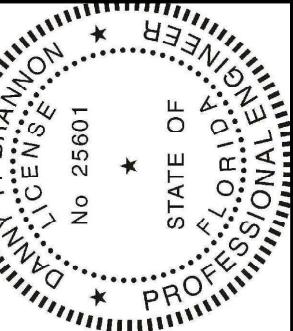

Digital signature by
Danny P. Brannon
Date: 2021-09-11
16:25:18-04'00'

DANNY P. BRANNON, P.E.
FLORIDA P.E. NO. 25601

DATE

Town of Longboat Key

DRAWINGS FOR:
FIBER OPTIC AND STREET
LIGHTING UTILITY
CONSTRUCTION
LONGBOAT KEY, FLORIDA



Date: 12/01/2019

Scale: AS NOTED


Drawn: DPB

Checked: DPB

Job # 2014-LBK

Sheet

G1

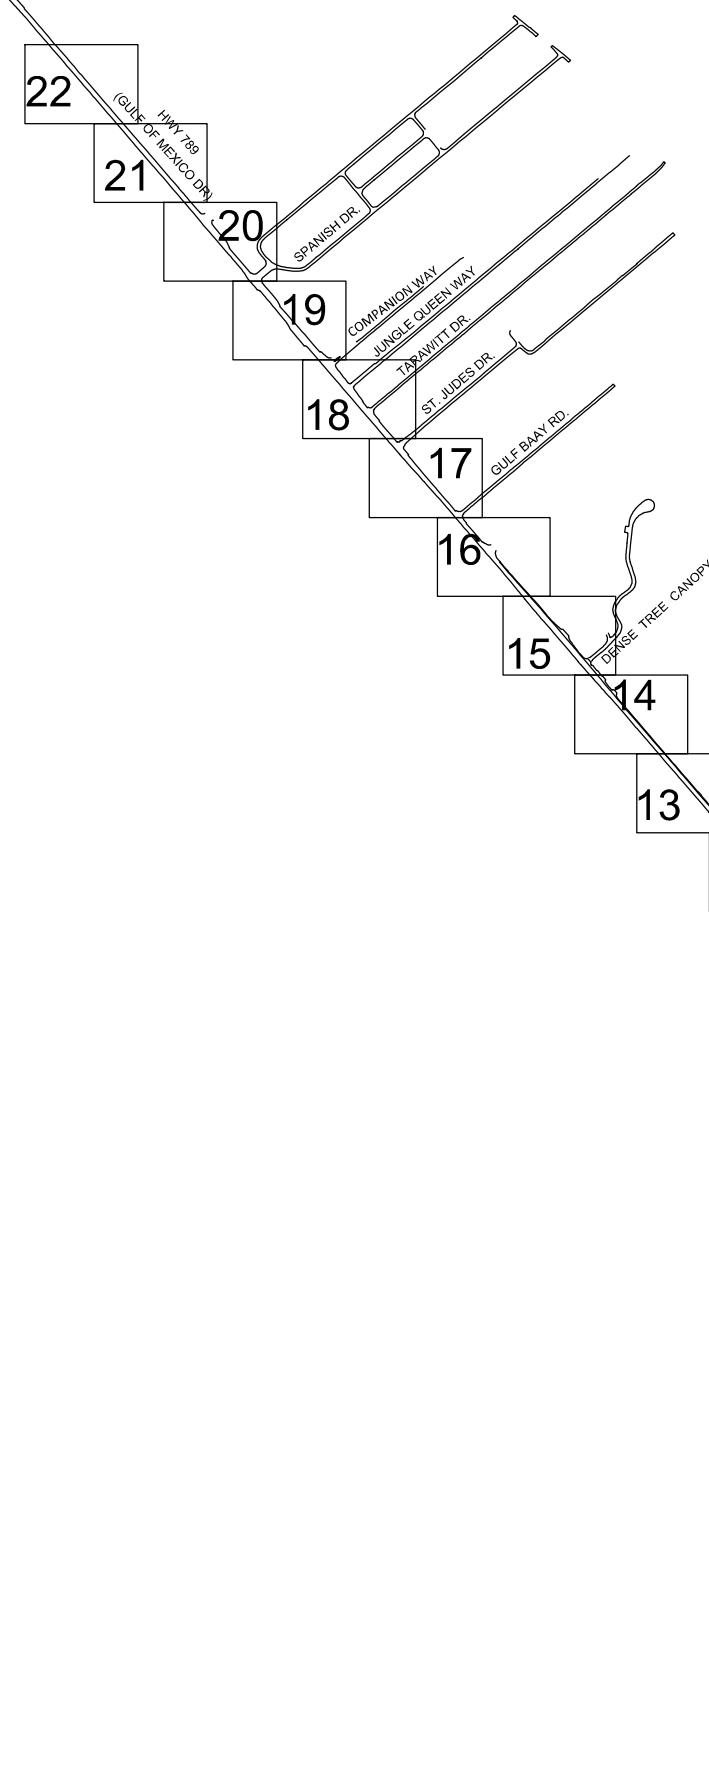

Legend	
Description	
	1 Fiber (original)
	1 Fiber+1 SL (original)
	1 SL (original)
	2 Fiber (original)
	2 Fiber+1 SL (original)
	Fiber 1-2" (added)
	Fiber 2-2" (added)
	Fiber 2-2" (removed)
	Fiber HH (added)
	Fiber HH (original)
	Fiber HH (removed)
	SL (added)
	SL (removed)
	SL 1-2" (added)
	SL 1-2" (removed)
	SL HH (added)
	SL HH (original)
	SL HH (removed)
	SL Panel (added)

1F = 1-2" Fiber

2F = 2-2" Fiber

1S = 1-2" Streetlight

2S = 2-2" Streetlight

1F+1S = 1-2" Fiber and 1-2" Streetlight

2F+1S = 2-2" Fiber and 1-2" Streetlight

1F+2S = 1-2" Fiber and 2-2" Streetlight

2F+2S = 2-2" Fiber and 2-2" Streetlight

SYMBOL LEGEND

	CENTERLINE
	EDGE OF PAVEMENT
	RIGHT OF WAY
	SIDEWALK
	SANITARY SEWER
	OVERHEAD LINES
	PROPERTY LINES
	SURVEY CONTROL POINT
	CONCRETE MONUMENT FOUND
	IRON PIPE FOUND
	IRON ROD FOUND
	NAIL AND DISC FOUND
	UTILITY POLE (WOOD)
	UTILITY POLE (CONCRETE)
	GUY WIRE
	SANITARY MANHOLE
	CLEANOUT
	GRATE INLET
	STORMWATER MANHOLE
	MITERED END SECTION
	UTILITY MANHOLE
	GAS LINE MARKER
	FIRE HYDRANT
	WATER VALVE
	WATER METER
	BACKFLOW PREVENTER
	TRANSFORMER
	CABLE MARKER
	GAS VALVE / METER
	LIGHT POLE
	LANDSCAPE LIGHT
	BOLLARD
	SIGN
	UTILITY RISER / PEDESTAL
	CONTROL PANEL
	TRAFFIC / PEDESTRIAN CONTROL
	IRRIGATION VALVE
	GUY POLE
	SERVICE BOX (ELECTRIC)
	SERVICE BOX (CABLE)
	SERVICE BOX (TELEPHONE)
	MAILBOX
	STREET LIGHT 10" x 17" HANDHOLE.
	FIBER OPTICS 30"x48" HANDHOLE UNLESS MARKED OTHERWISE.
	PROPOSED STREET LIGHT
	EXISTING STREET POST LIGHT
	EXISTING STREET POST LIGHT WITH STREET SIGN
	EXISTING MASTARM STREET LIGHT

Town of Longboat Key

DRAWINGS FOR:
FIBER OPTIC AND STREET
LIGHTING UTILITY
CONSTRUCTION
LONGBOAT KEY, FLORIDA



Date: 12/01/2019

Scale: AS NOTED


Drawn: DPB

Checked: DPB

Job # 2014-LBK

Sheet

KEY MAP


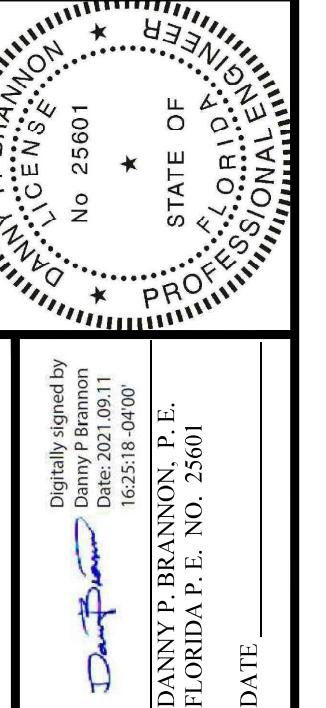


Digitally signed by
Danny P. Brannon
Date: 2021-09-11
16:25:18-04'00'

DANNY P. BRANNON, P.E.
FLORIDA P. E. NO. 25601

Brannon & Gillespie, Inc.
Consulting Engineers

634 US Highway 1, Suite 301
North Palm Beach, Florida 33408
(561) 847-7435
C.A.# 6784

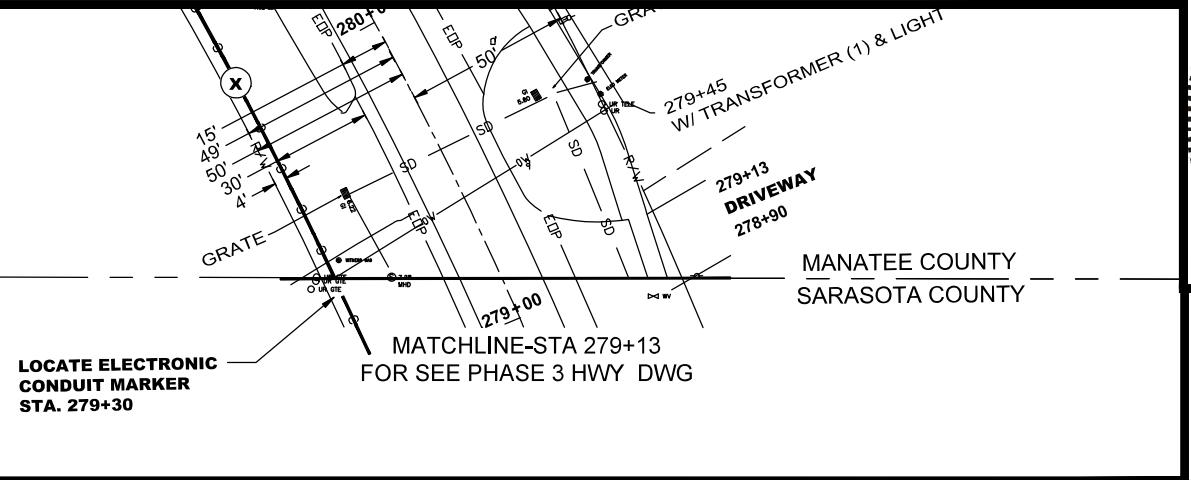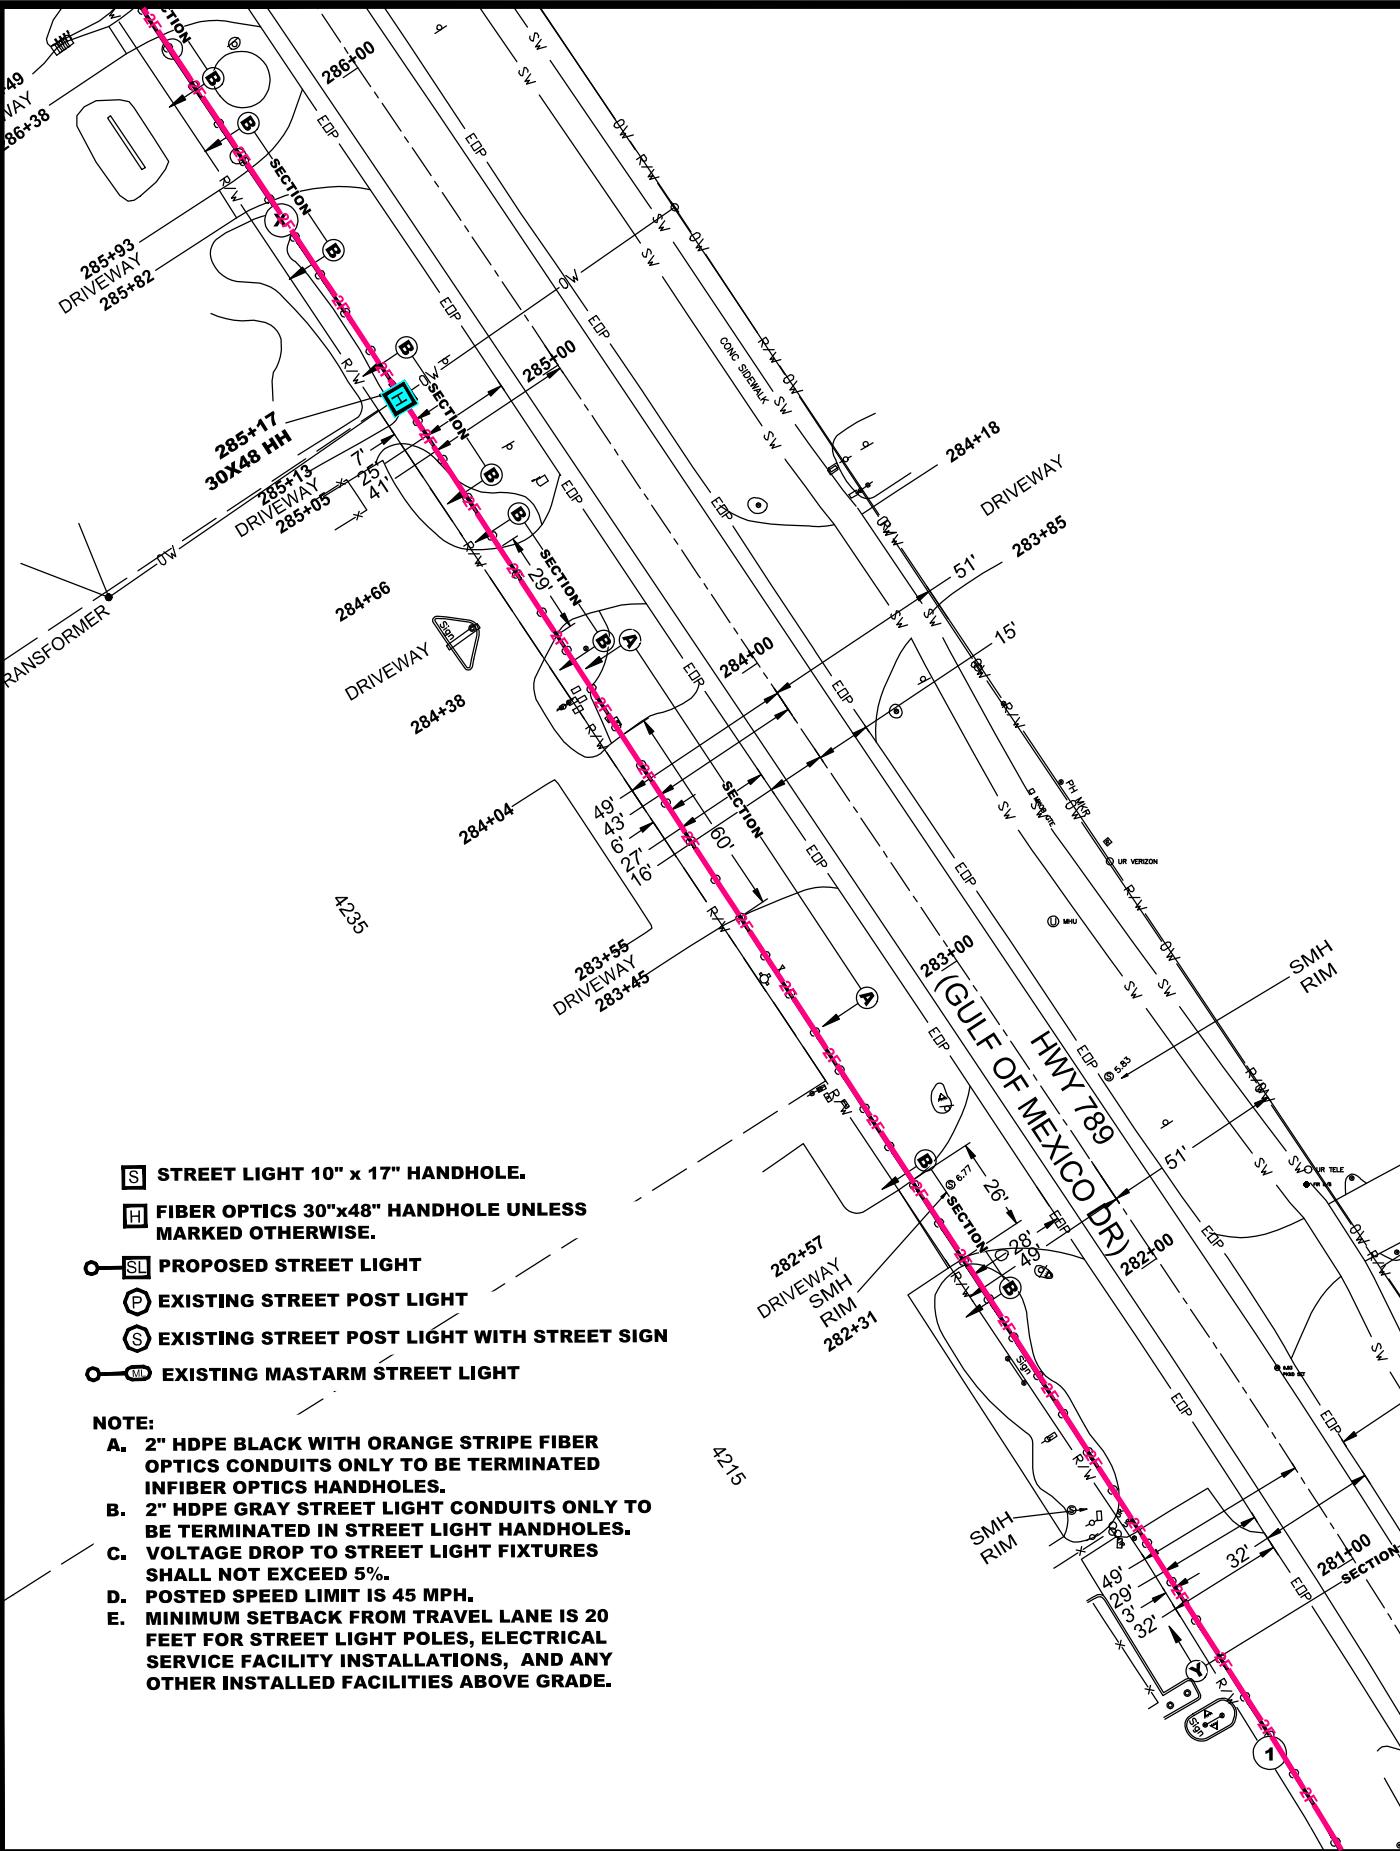

Town of Longboat Key

DRAWINGS FOR:
FIBER OPTIC AND STREET
LIGHTING UTILITY
CONSTRUCTION
LONGBOAT KEY, FLORIDA





Date: 12/01/2019
Scale: AS NOTED
Drawn: DPB
Checked: DPB
Job #: 2014-LBK
Sheet



1 OF 22

Digital signature by
Danny P. Brannon
Date: 2021-09-11
16:25:18-04'00'

Danny P. Brannon, P.E.
FLORIDA P. E. NO. 25601
DATE

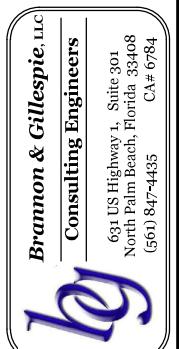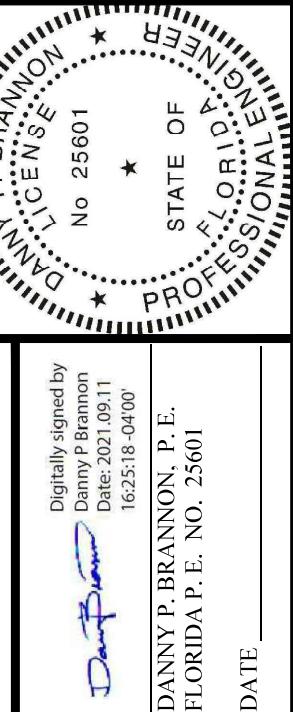

Brannon & Gillespie, Inc.
Consulting Engineers
634 US Highway 1, Suite 301
North Palm Beach, Florida 33408
(561) 847-7435
C.A. # 6784

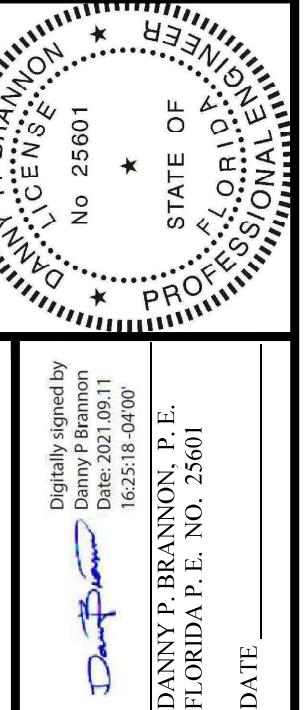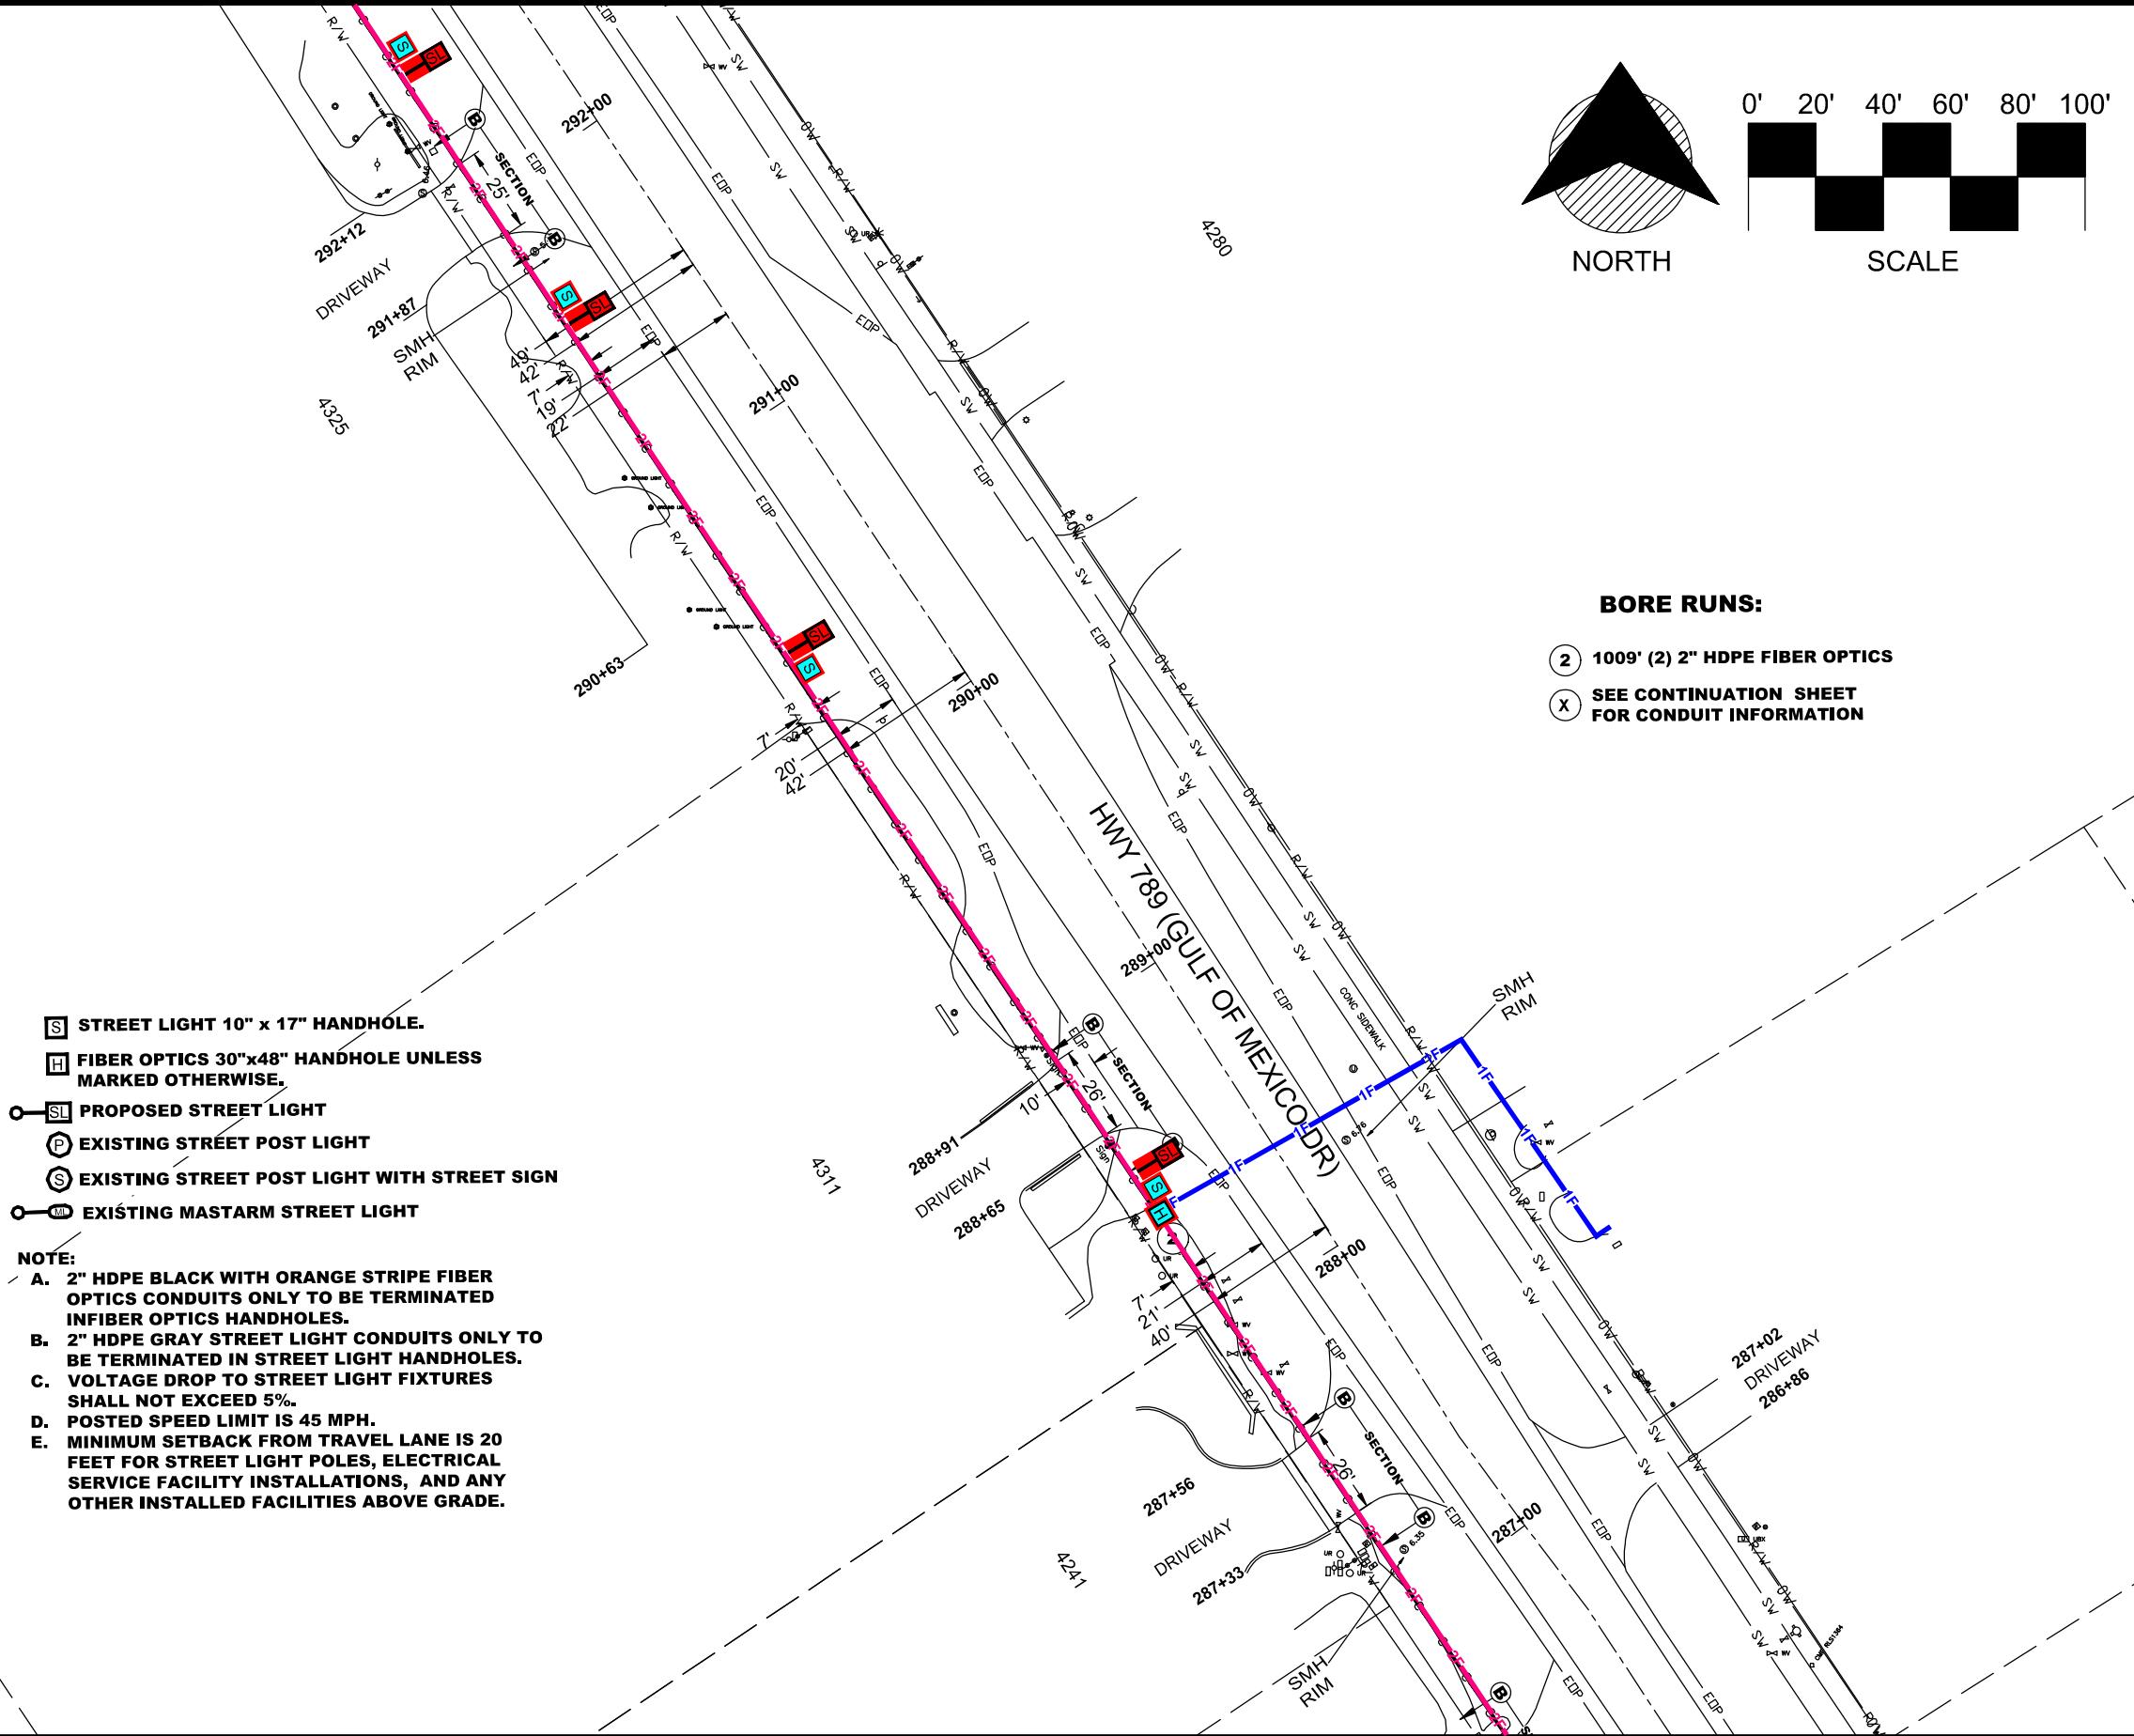


Town of Longboat Key

DRAWINGS FOR:
FIBER OPTIC AND STREET
LIGHTING UTILITY
CONSTRUCTION
LONGBOAT KEY, FLORIDA







Date: 12/01/2019
Scale: AS NOTED
Drawn: DPB
Checked: DPB
Job # 2014-LBK
Sheet

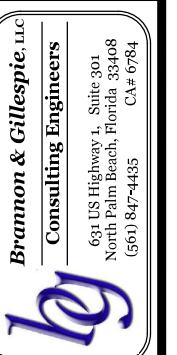

Brannon & Gillespie, Inc.
Consulting Engineers

634 US Highway 1, Suite 301
North Palm Beach, Florida 33408
(561) 847-7435
C.A. # 6784

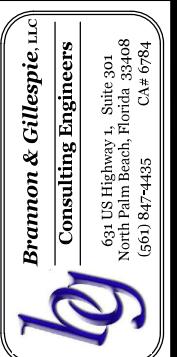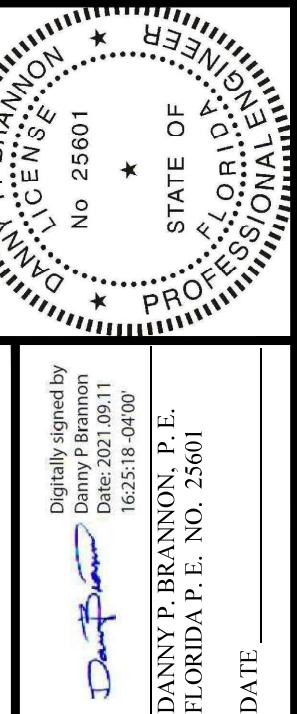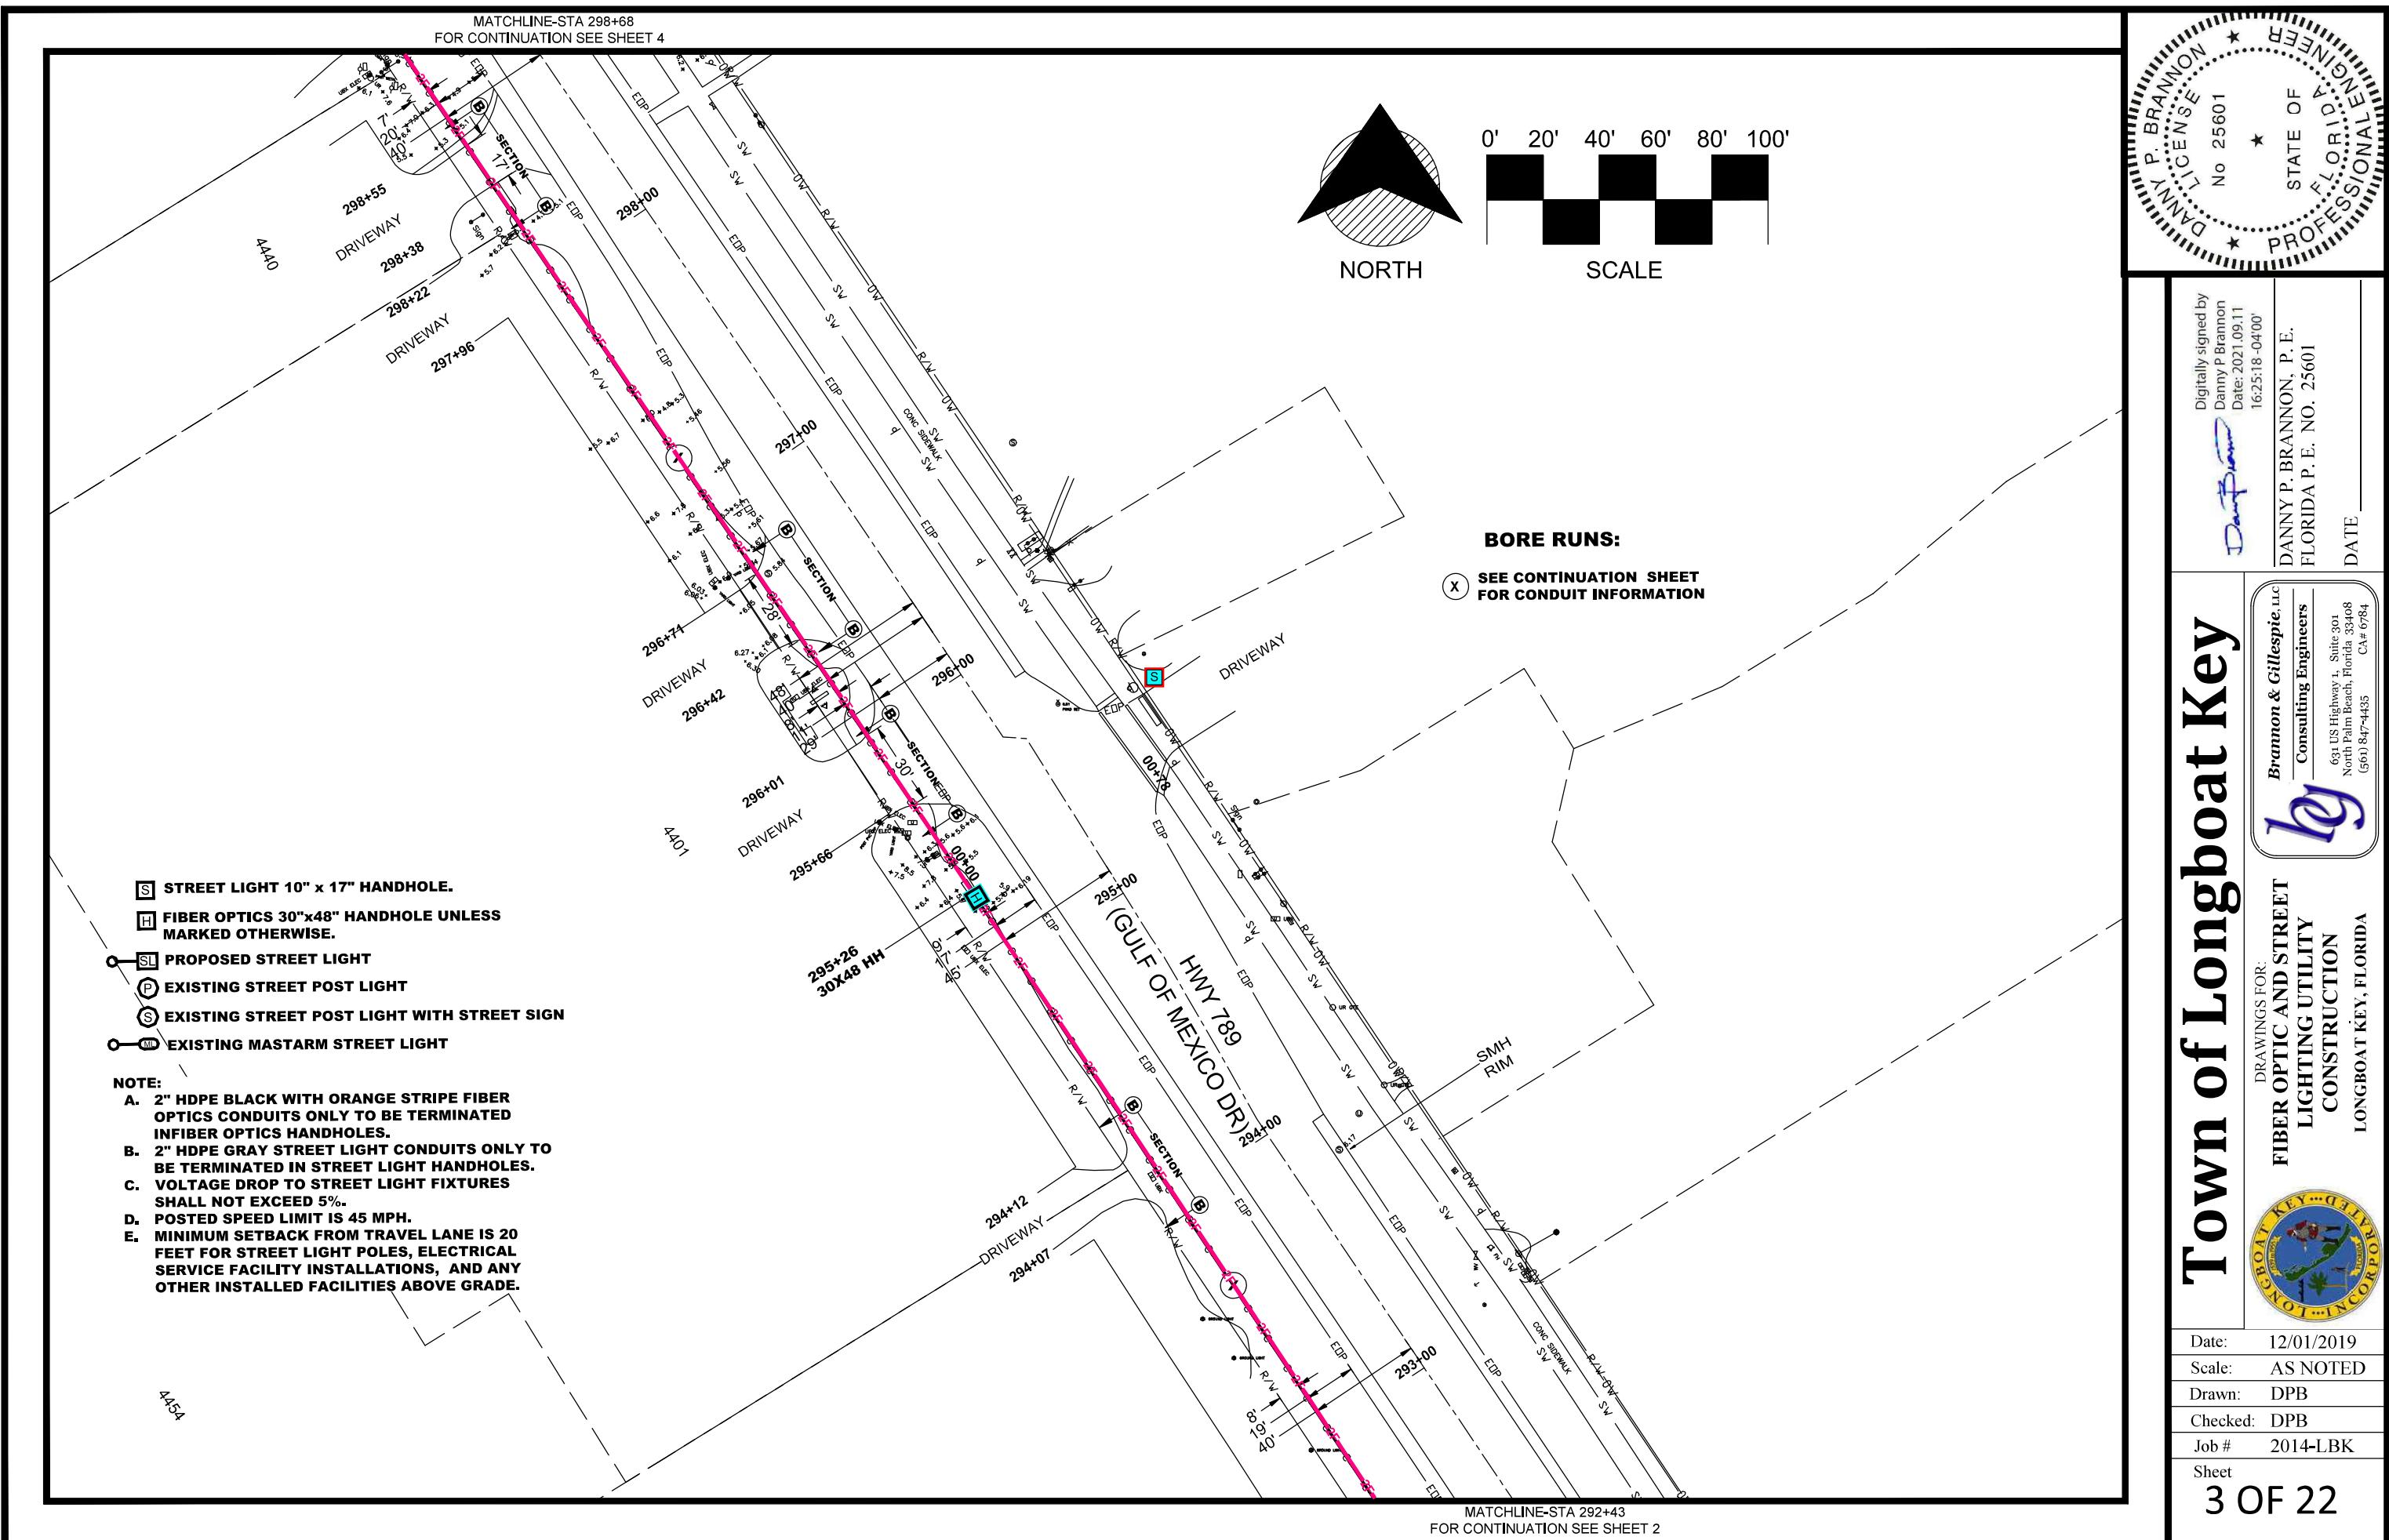

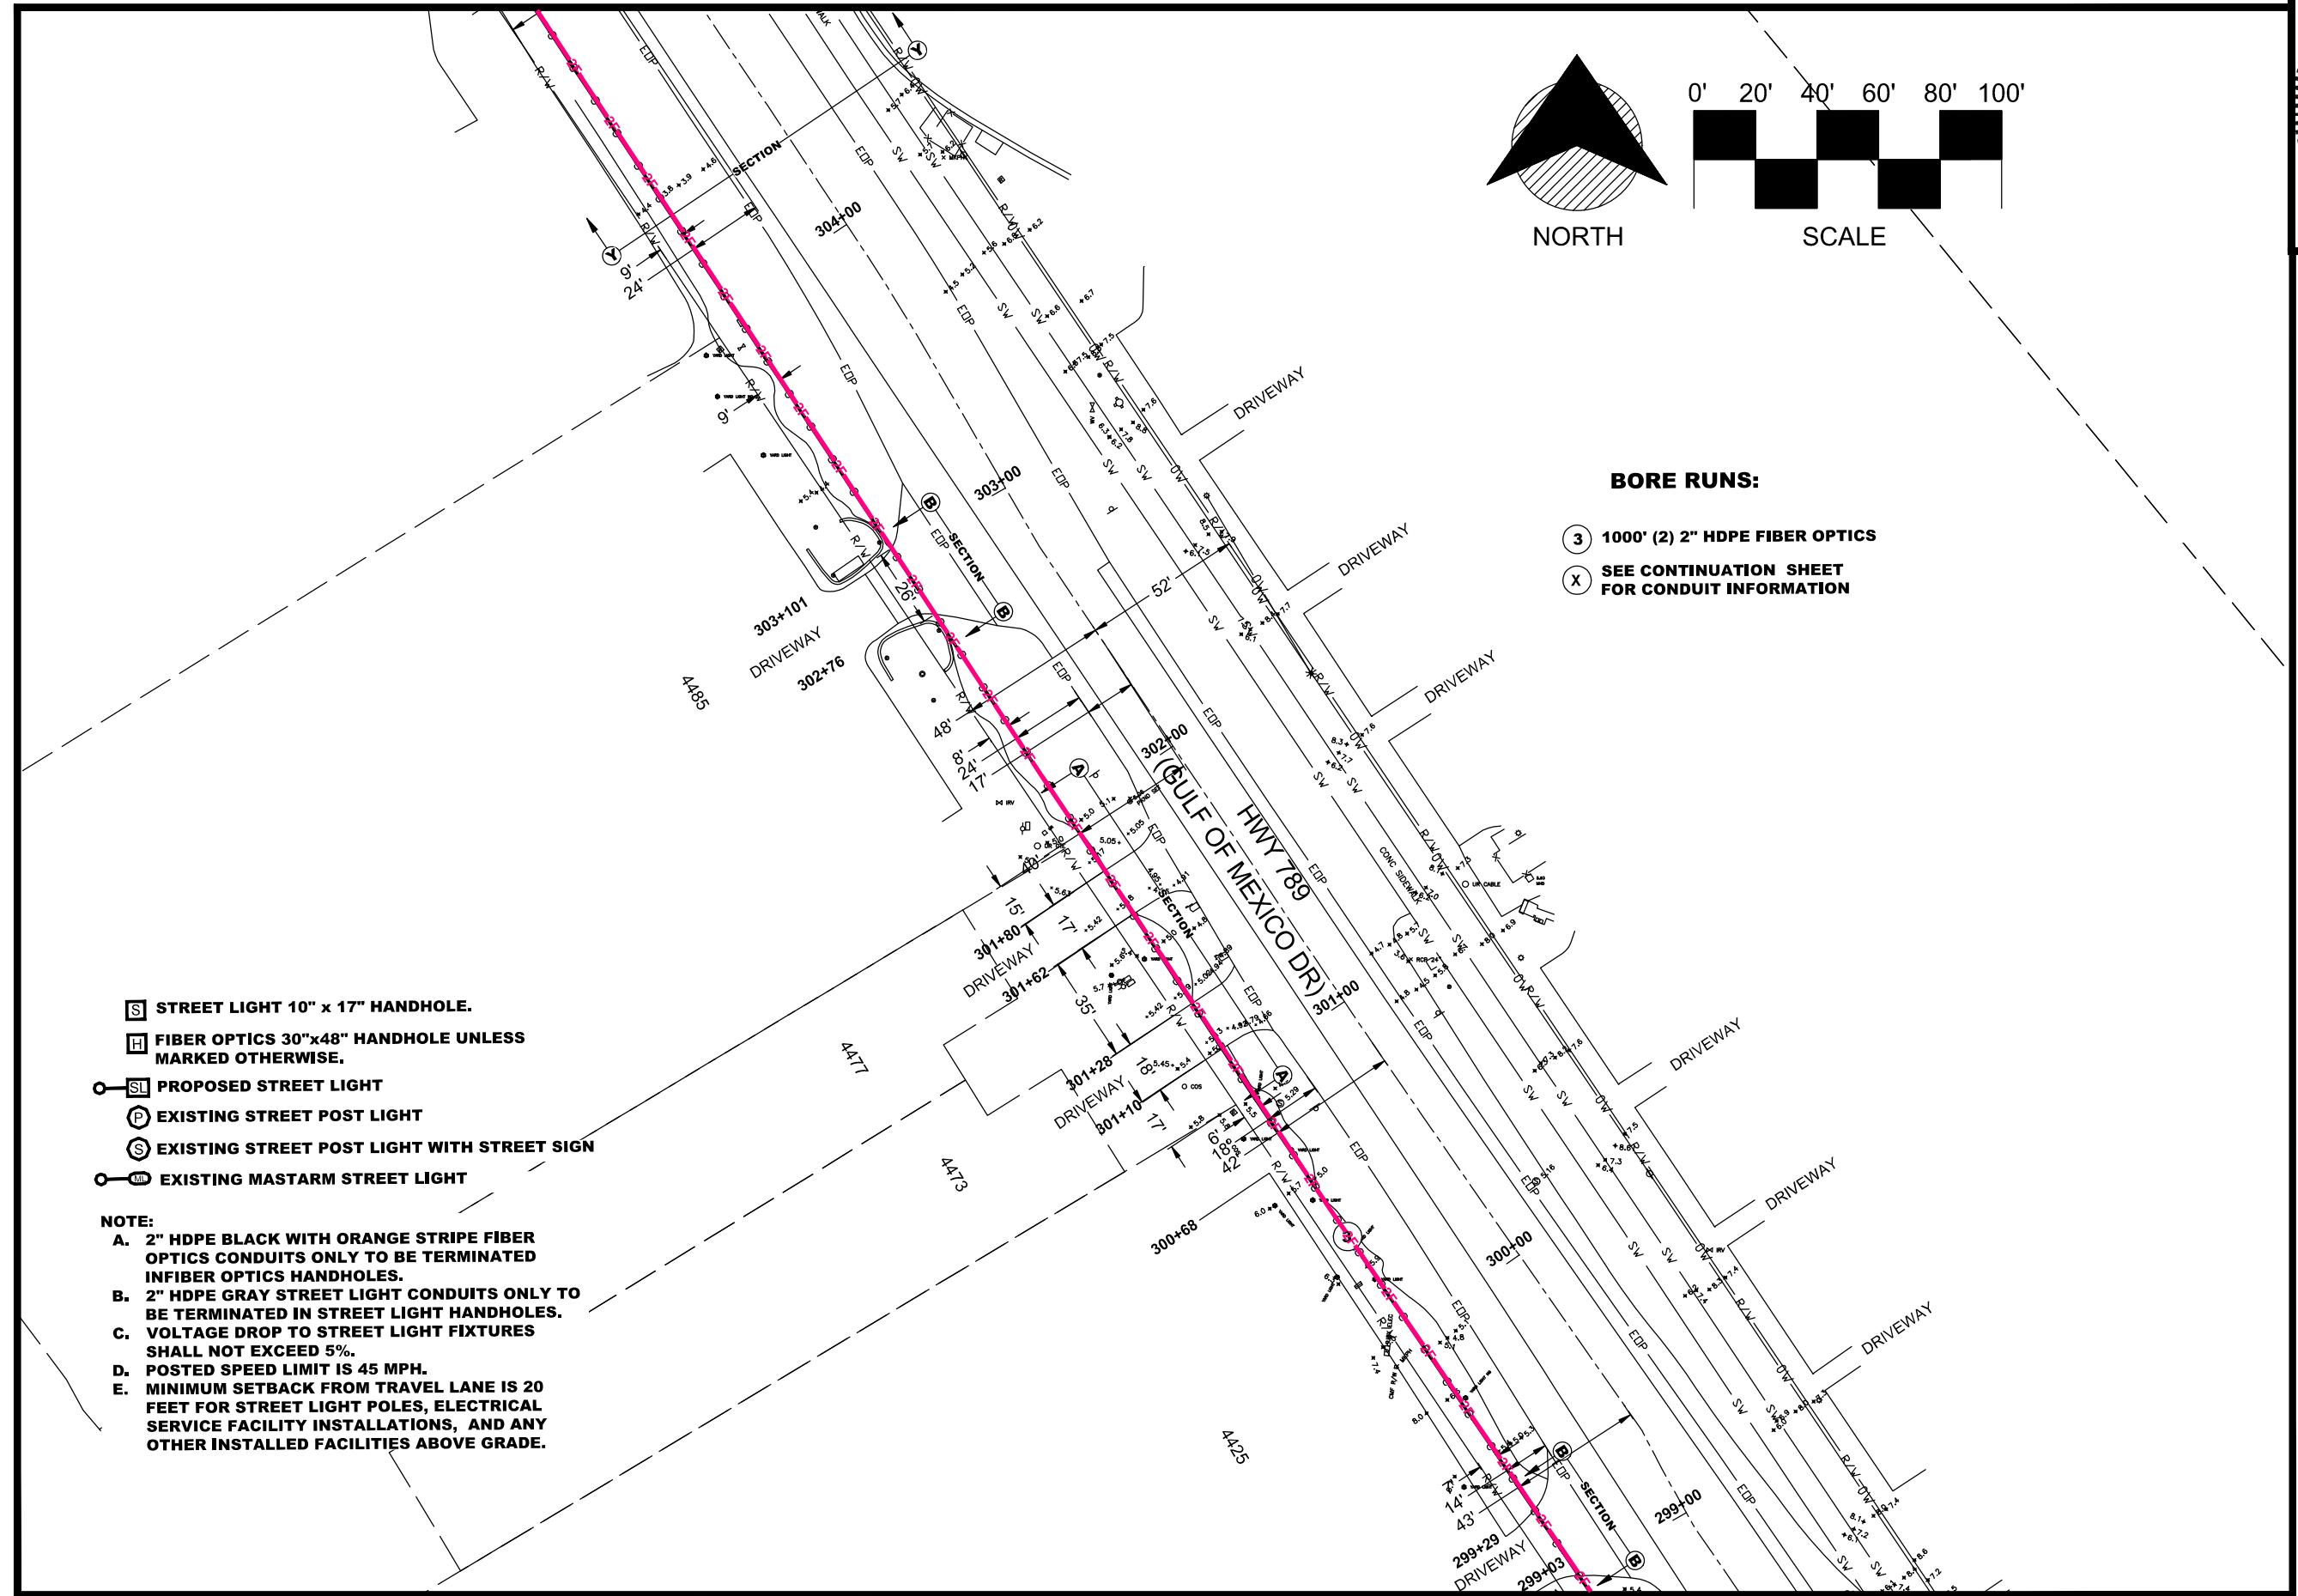

Town of Longboat Key

DRAWINGS FOR:
FIBER OPTIC AND STREET
LIGHTING UTILITY
CONSTRUCTION
LONGBOAT KEY, FLORIDA






Date: 12/01/2019
Scale: AS NOTED
Drawn: DPB
Checked: DPB
Job # 2014-LBK
Sheet

4 OF 22

Digital signature by
Danny P Brannon
Date: 2021-09-11
16:25:18-04'00'

DANNY P. BRANNON, P. E.
FLORIDA P. E. NO. 25601
DATE

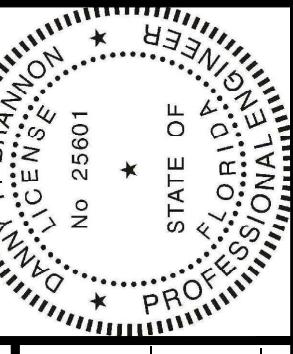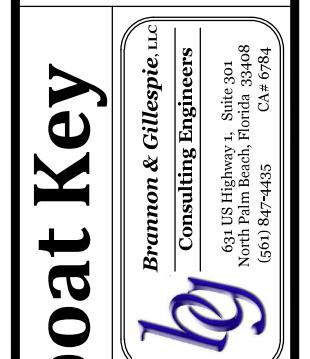

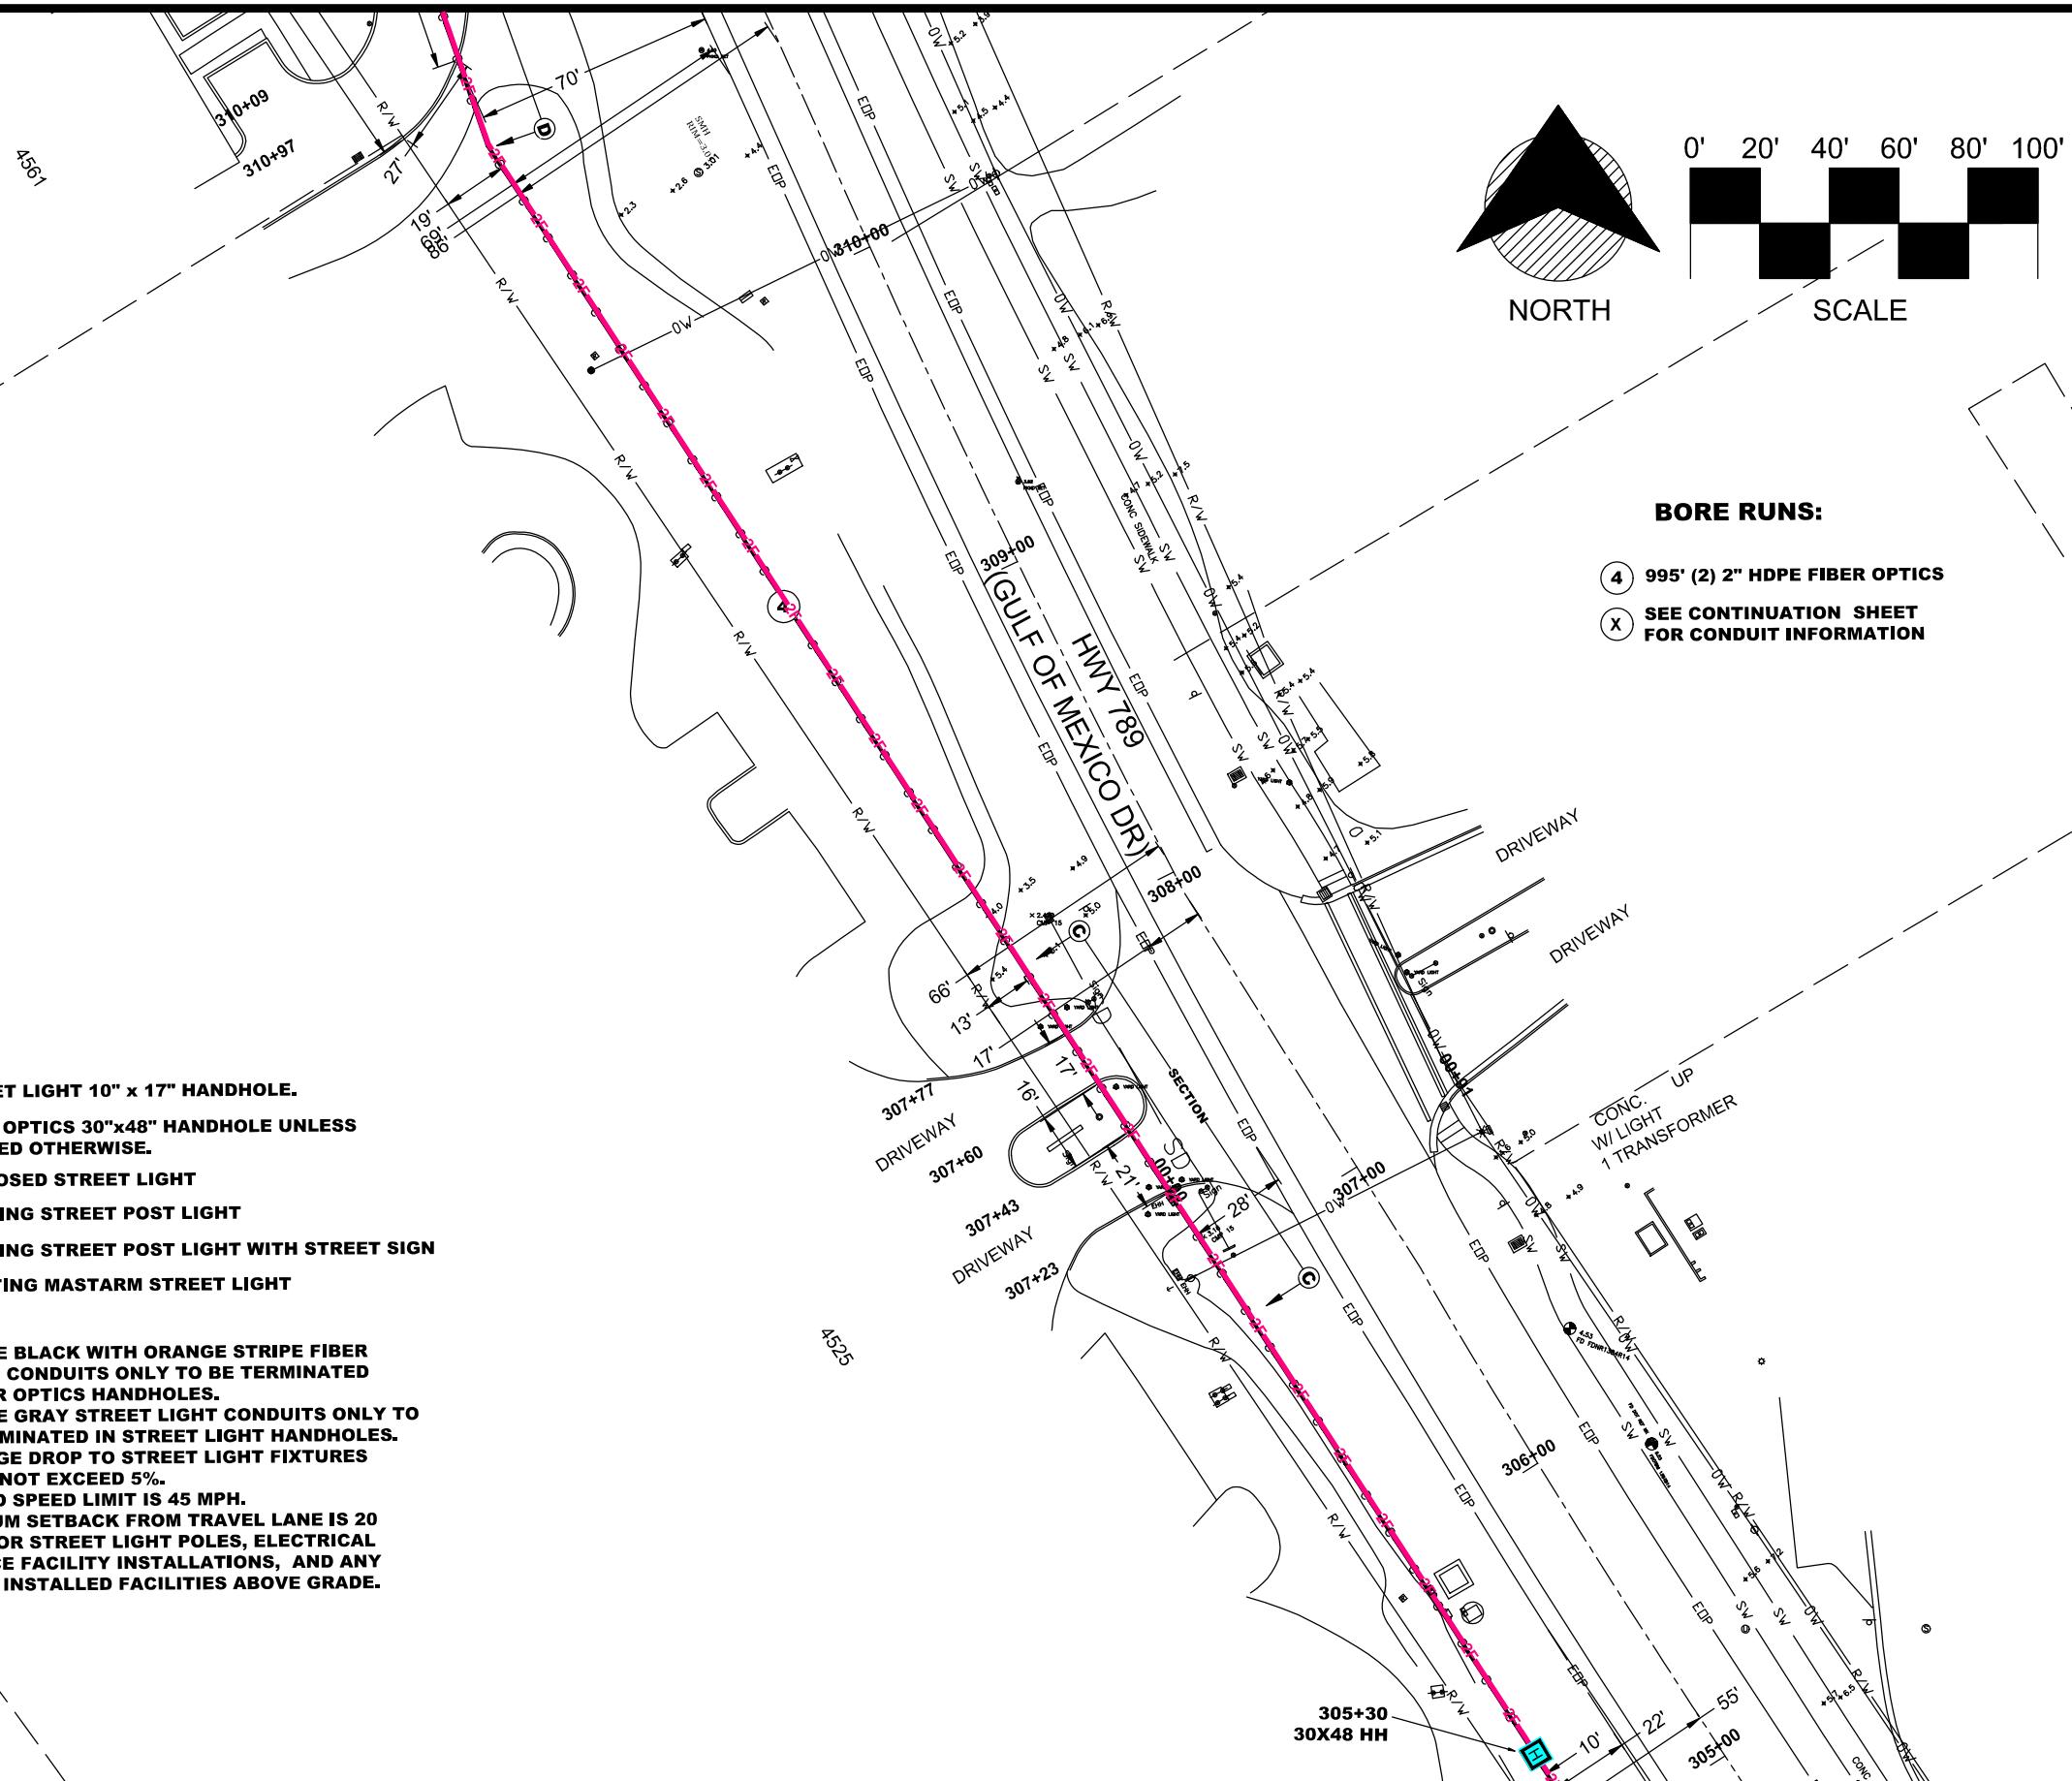

Town of Longboat Key



DRAWINGS FOR:
FIBER OPTIC AND STREET
LIGHTING UTILITY
CONSTRUCTION
LONGBOAT KEY, FLORIDA






Date: 12/01/2019
Scale: AS NOTED
Drawn: DPB
Checked: DPB
Job # 2014-LBK
Sheet

5 OF 22

Digital signature by
Danny P. Brannon
Date: 2021-09-11
16:25:18 -04'00'
DANNY P. BRANNON, P. E.
FLORIDA P. E. NO. 25601
DATE

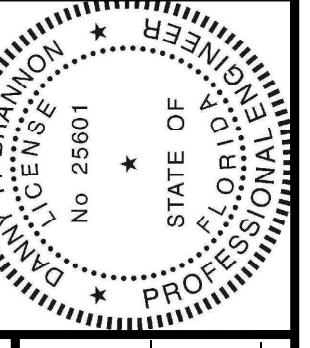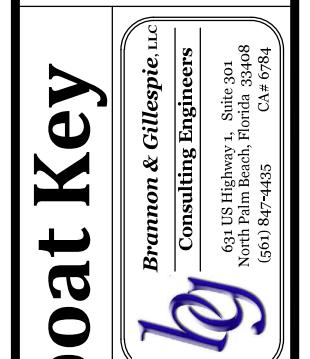

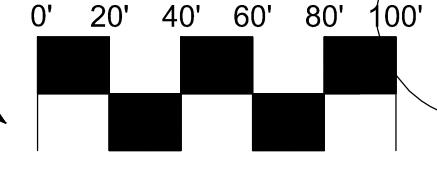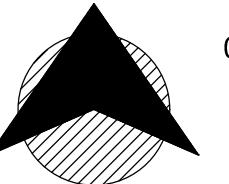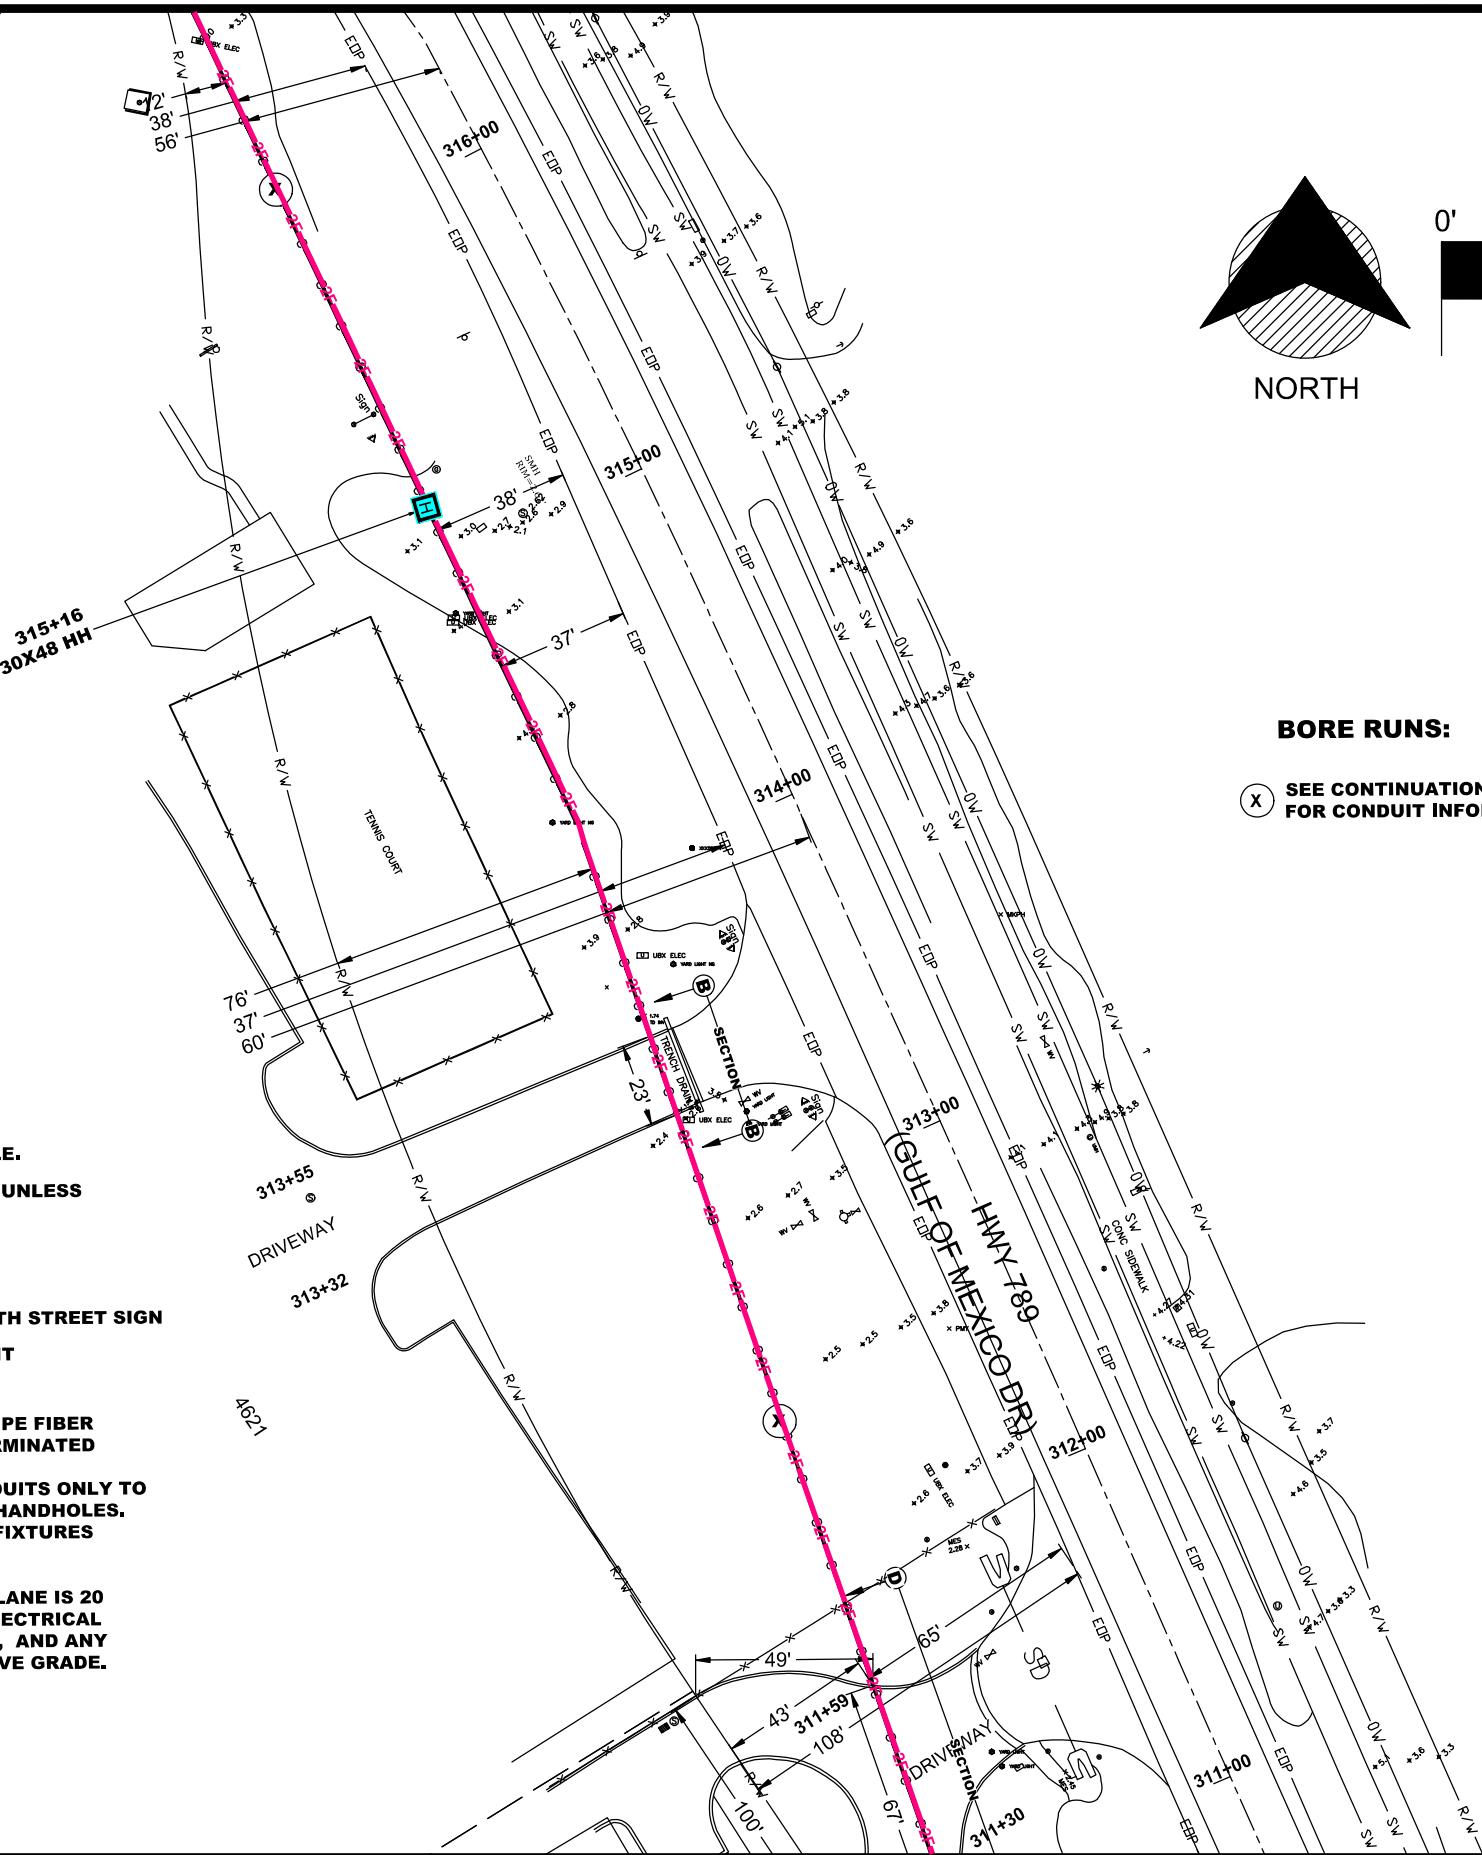

NORTH

SCALE


Town of Longboat Key

DRAWINGS FOR:
FIBER OPTIC AND STREET
LIGHTING UTILITY
CONSTRUCTION
LONGBOAT KEY, FLORIDA




Date: 12/01/2019
Scale: AS NOTED
Drawn: DPB
Checked: DPB
Job # 2014-LBK
Sheet



6 OF 22

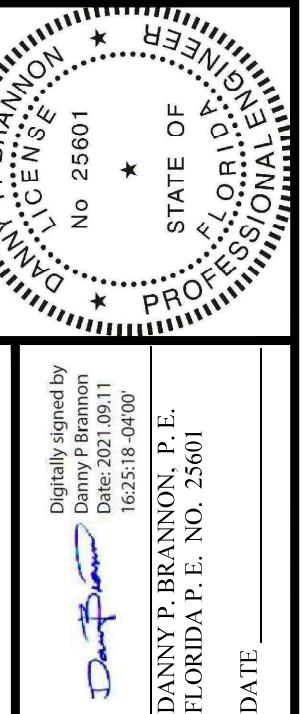


Digital signature by
Danny P. Brannon
Date: 2021-09-11
16:25:18-04'00'

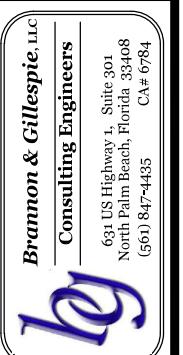

634 US Highway 1, Suite 301
North Palm Beach, Florida 33408
(561) 847-7435
C.A.# 6784

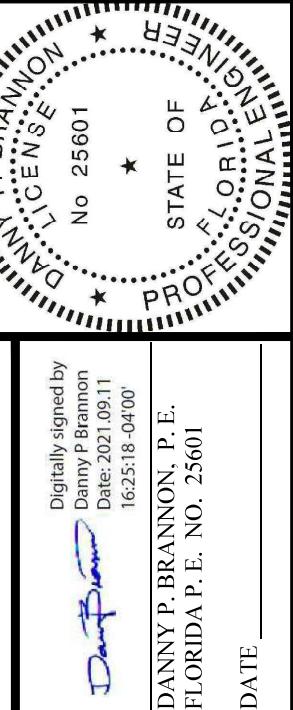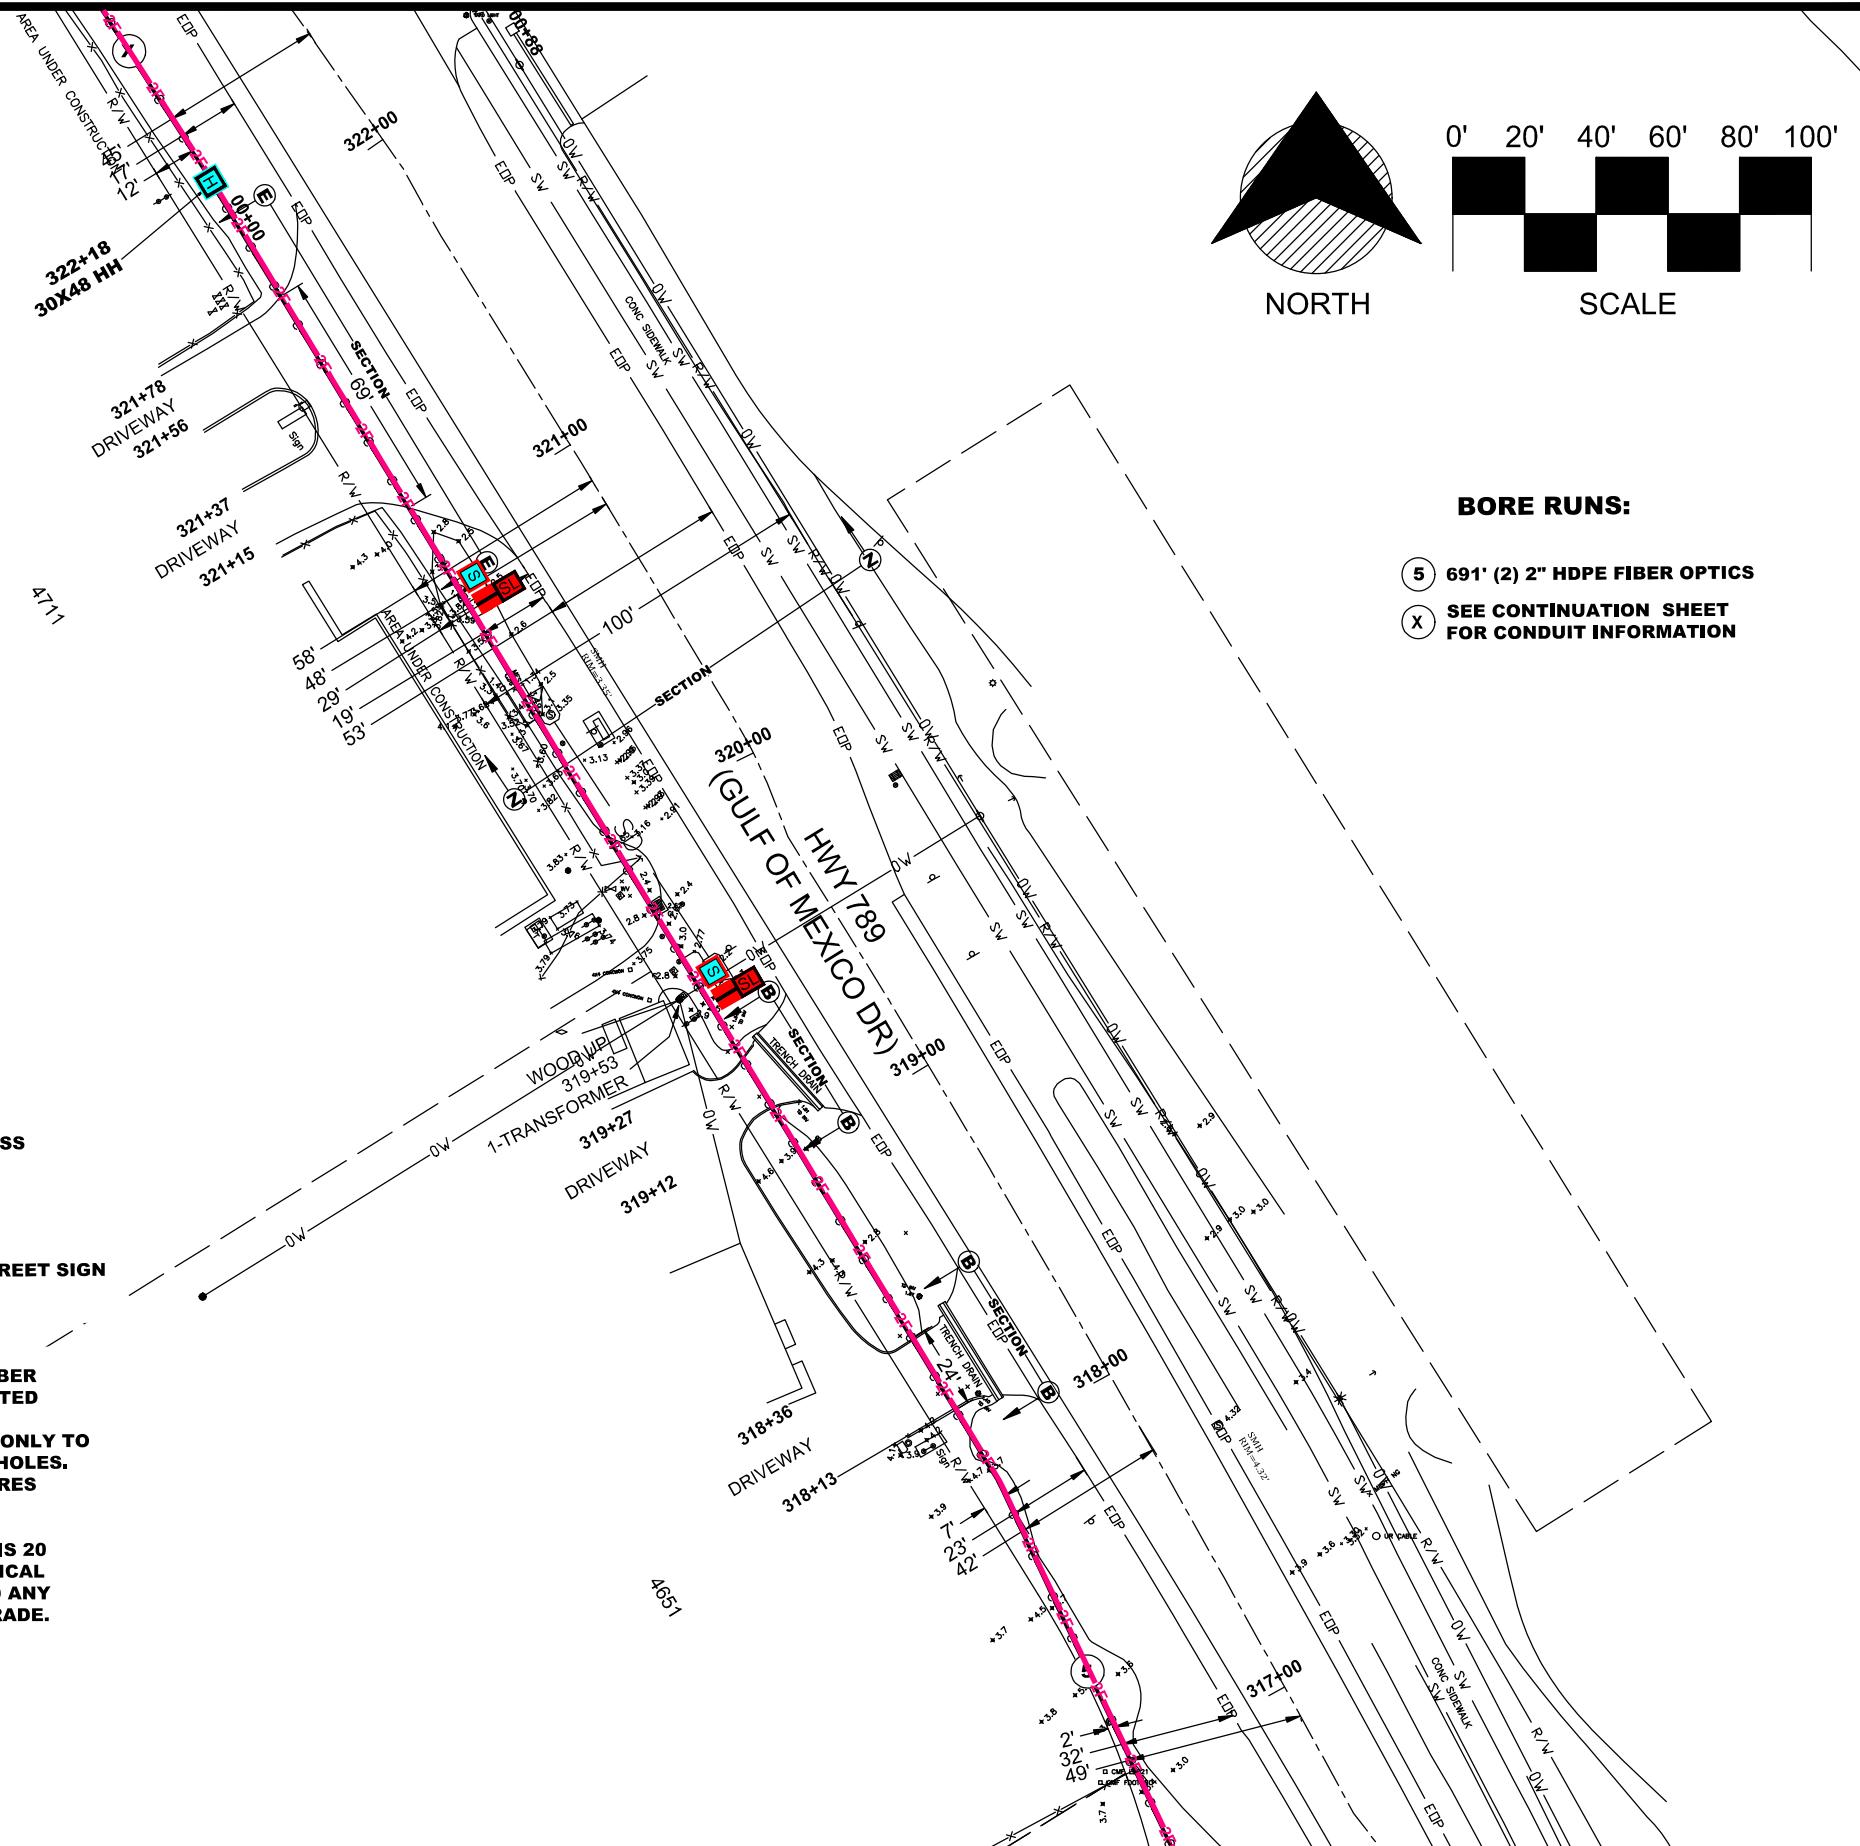

Digitally signed by
Danny P. Brannon
Date: 2021-09-11
16:25:18-04'00'

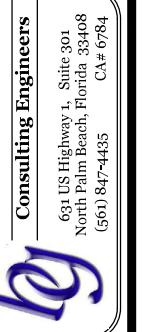


DRAWINGS FOR:
FIBER OPTIC AND STREET
LIGHTING UTILITY
CONSTRUCTION
LONGBOAT KEY, FLORIDA



Town of Longboat Key

Date: 12/01/2019
Scale: AS NOTED
Drawn: DPB
Checked: DPB
Job # 2014-LBK
Sheet

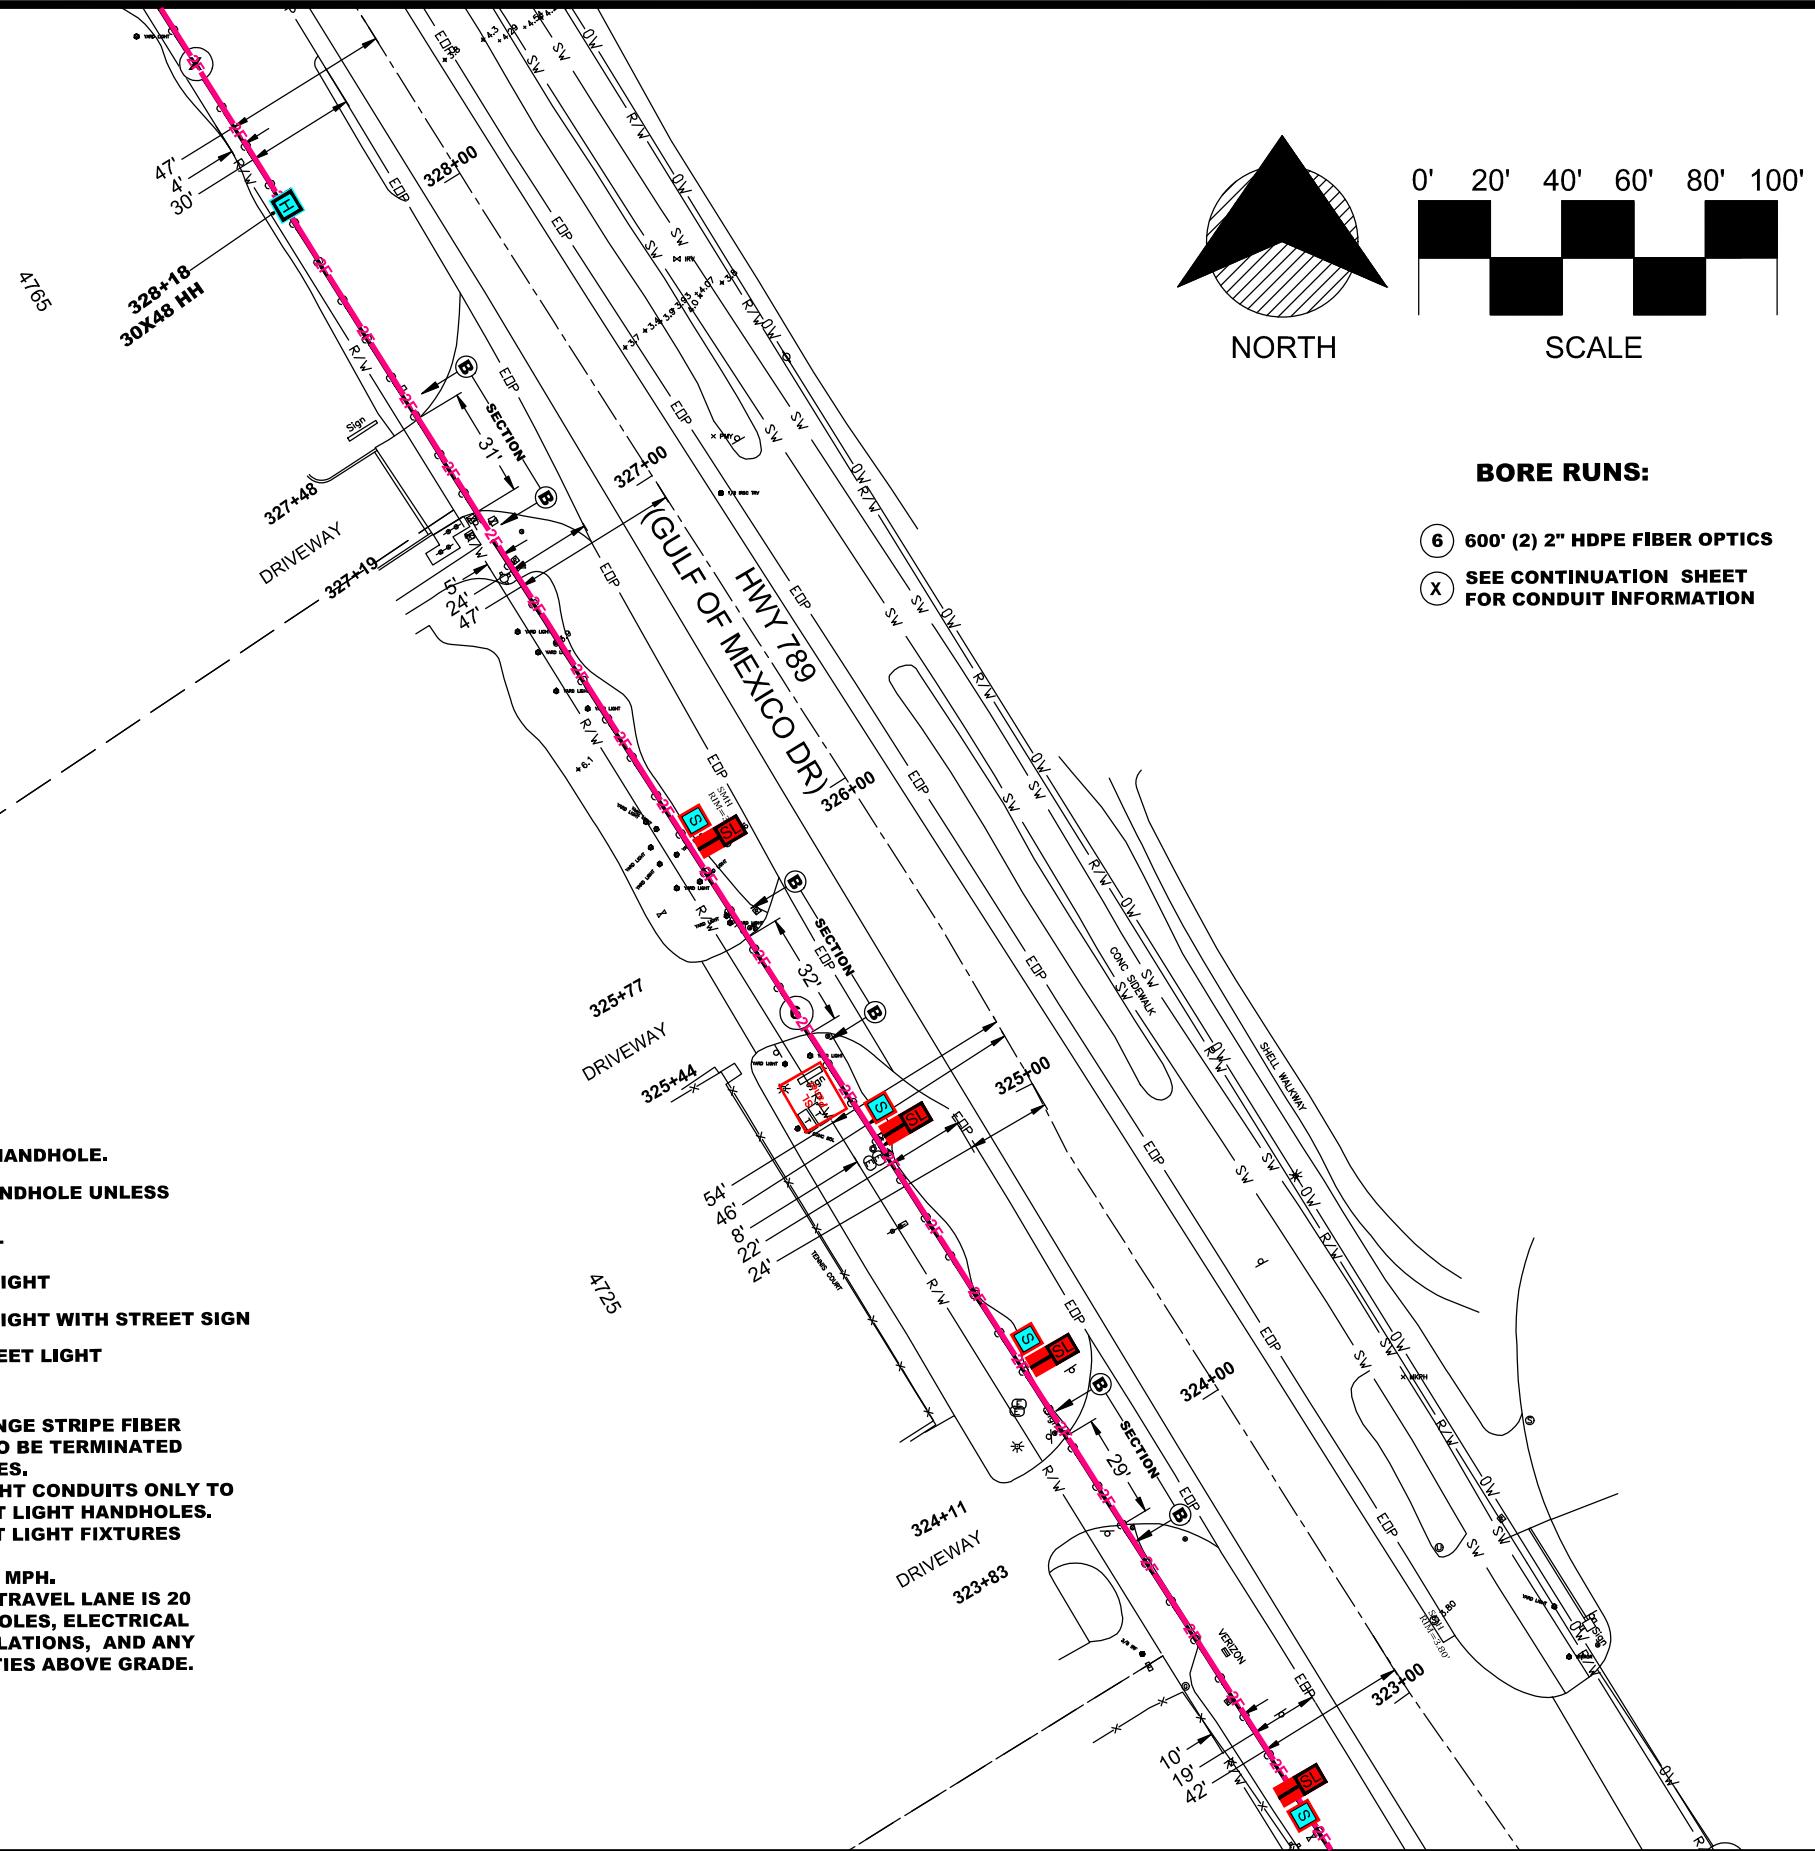

Town of Longboat Key

DRAWINGS FOR:
FIBER OPTIC AND STREET
LIGHTING UTILITY
CONSTRUCTION
LONGBOAT KEY, FLORIDA





Date: 12/01/2019
Scale: AS NOTED
Drawn: DPB
Checked: DPB
Job # 2014-LBK
Sheet

Digital signature by
Danny P. Brannon
Date: 2021-09-11
16:25:18-04'00'

Danny P. Brannon, P.E.
FLORIDA PROFESSIONAL
LICENSE No 25601



Brannon & Gillespie, Inc.
Consulting Engineers
634 US Highway 1, Suite 301
North Palm Beach, Florida 33408
(561) 847-7435
CA# 6784

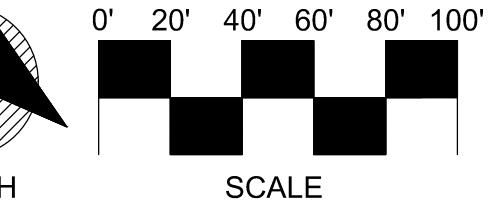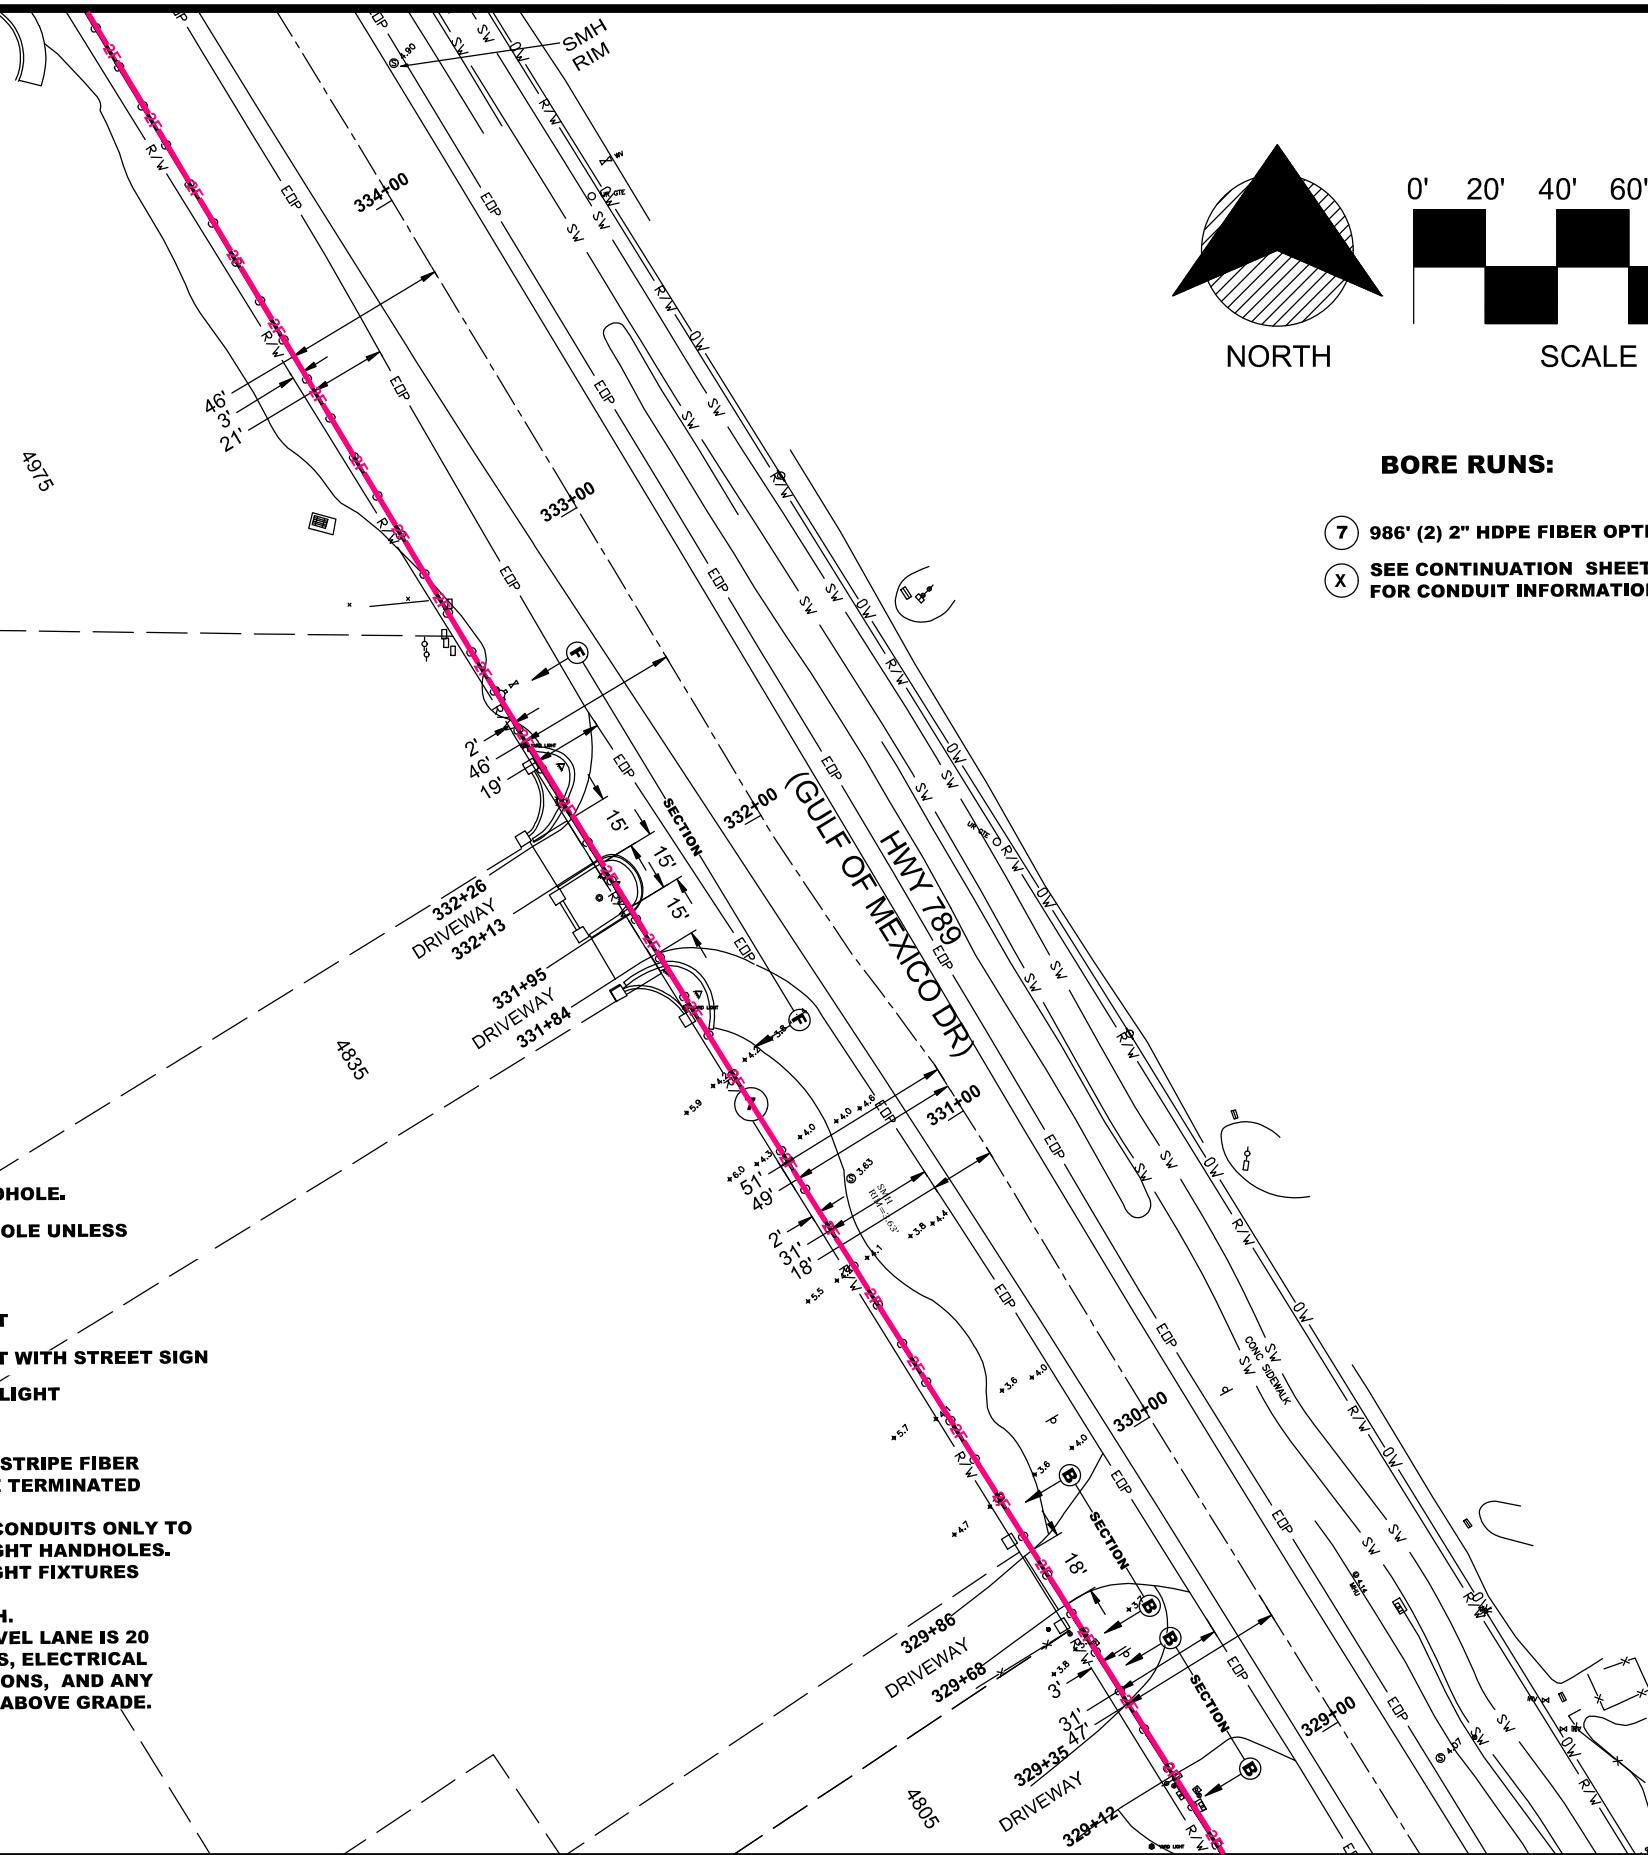

BORE RUNS:

- 7 986' (2) 2" HDPE FIBER OPTICS
- X SEE CONTINUATION SHEET FOR CONDUIT INFORMATION

Town of Longboat Key

DRAWINGS FOR:
FIBER OPTIC AND STREET
LIGHTING UTILITY
CONSTRUCTION
LONGBOAT KEY, FLORIDA




Brannon & Gillespie, Inc.
Consulting Engineers
634 US Highway 1, Suite 301
North Palm Beach, Florida 33408
(561) 847-7435
C.A. # 6784

P. BRANNON
LICEN
No 25601
★
STATE OF
FLORIDA
PROFESSIONAL
ENGINEER
DANNY P. BRANNON, P.E.
FLORIDA P.E. NO. 25601
DATE

Danny P. Brannon
Digitally signed by
Date: 2021-09-11
16:25:18-04'00'

Date:	12/01/2019
Scale:	AS NOTED
Drawn:	DPB
Checked:	DPB
Job #	2014-LBK
Sheet	9 OF 22


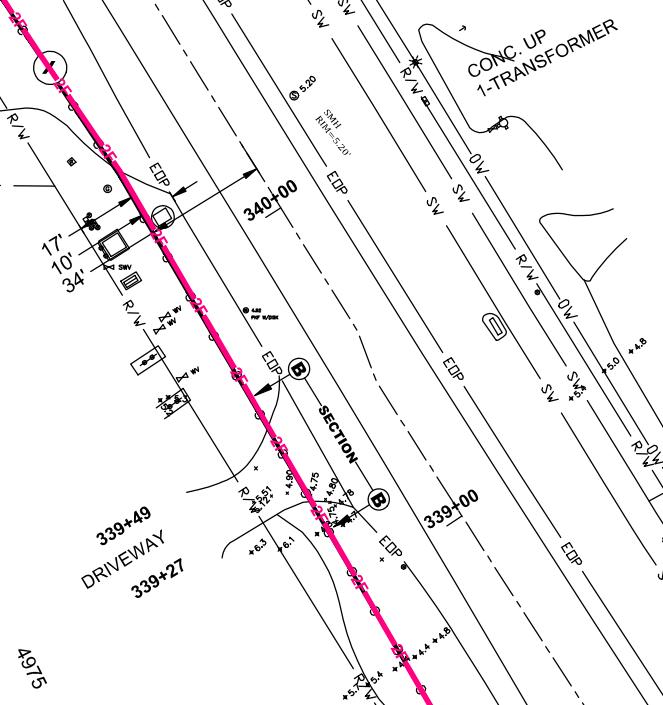


GLD7

- [S] STREET LIGHT 10" x 17" HANDHOLE.
- [H] FIBER OPTICS 30"x48" HANDHOLE UNLESS MARKED OTHERWISE.
- [O] PROPOSED STREET LIGHT
- [P] EXISTING STREET POST LIGHT
- [S] EXISTING STREET POST LIGHT WITH STREET SIGN
- [M] EXISTING MASTARM STREET LIGHT

NOTE:

- A. 2" HDPE BLACK WITH ORANGE STRIPE FIBER OPTICS CONDUITS ONLY TO BE TERMINATED IN FIBER OPTICS HANDHOLES.
- B. 2" HDPE GRAY STREET LIGHT CONDUITS ONLY TO BE TERMINATED IN STREET LIGHT HANDHOLES.
- C. VOLTAGE DROP TO STREET LIGHT FIXTURES SHALL NOT EXCEED 5%.
- D. POSTED SPEED LIMIT IS 45 MPH.
- E. MINIMUM SETBACK FROM TRAVEL LANE IS 20 FEET FOR STREET LIGHT POLES, ELECTRICAL SERVICE FACILITY INSTALLATIONS, AND ANY OTHER INSTALLED FACILITIES ABOVE GRADE.

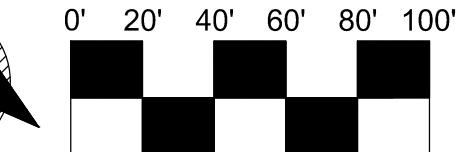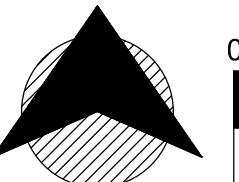


NORTH

SCALE

BORE RUNS:

(X) SEE CONTINUATION SHEET FOR CONDUIT INFORMATION

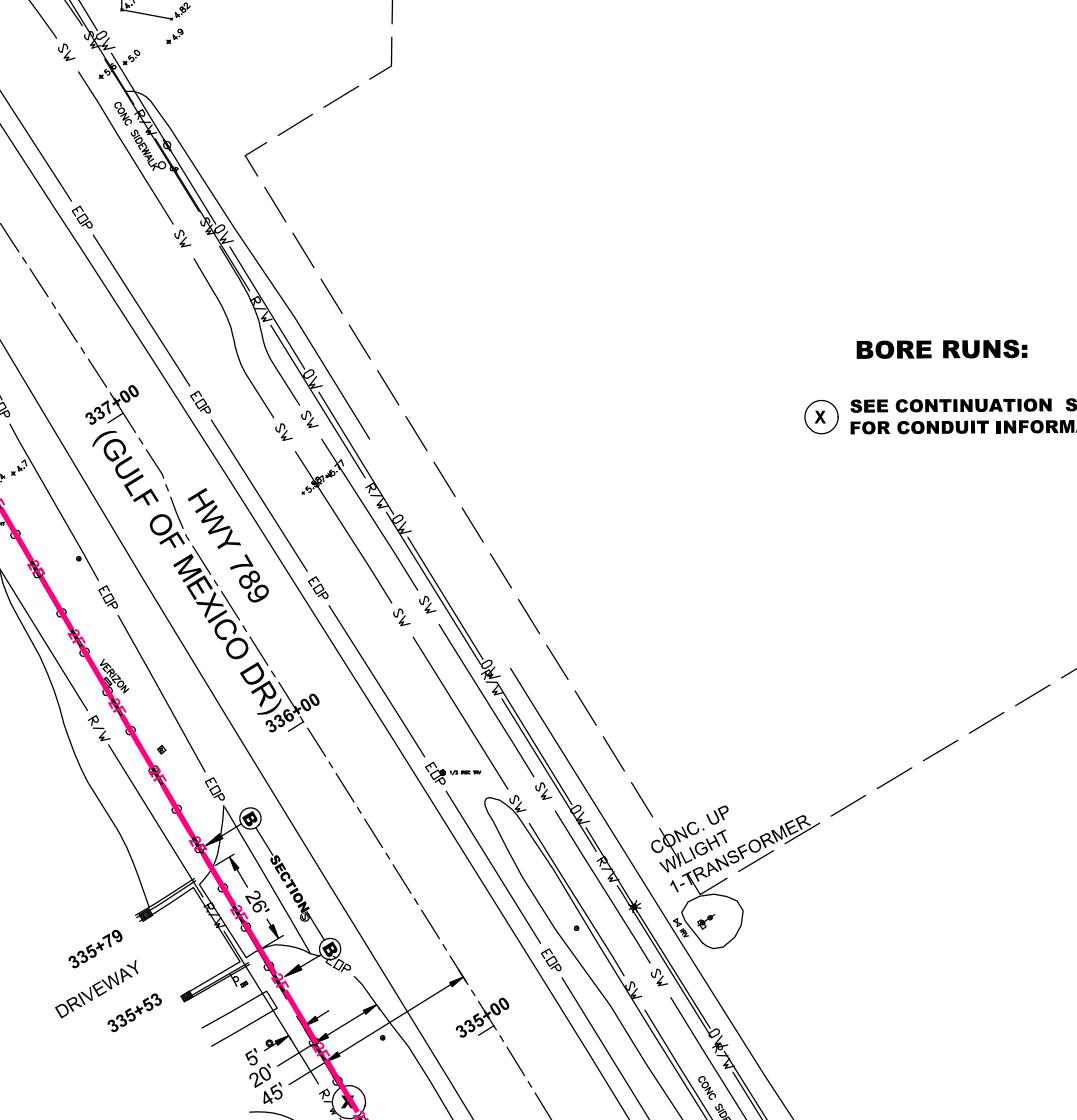


Town of Longboat Key

DRAWINGS FOR:
FIBER OPTIC AND STREET
LIGHTING UTILITY
CONSTRUCTION
LONGBOAT KEY, FLORIDA




Date: 12/01/2019
Scale: AS NOTED
Drawn: DPB
Checked: DPB
Job # 2014-LBK
Sheet

10 OF 22


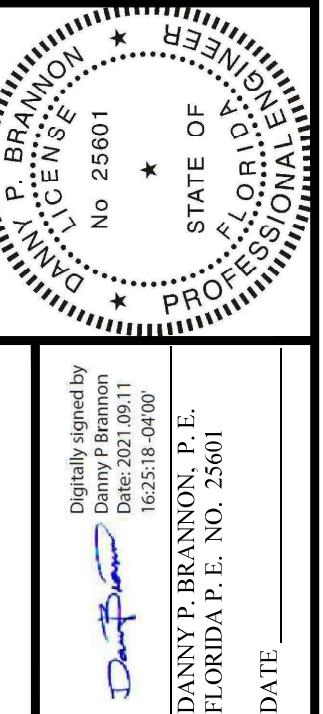


Digital signature by
Danny P. Brannon
Date: 2021-09-11
16:25:18-04'00'

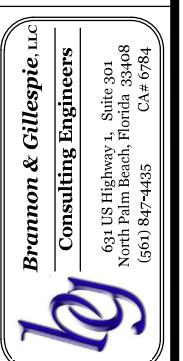


Brannon & Gillespie, Inc.
Consulting Engineers
634 US Highway 1, Suite 301
North Palm Beach, Florida 33408
(561) 847-4435
C.A. # 6784

MATCHLINE-STA 347+11
FOR CONTINUATION SEE SHEET 12

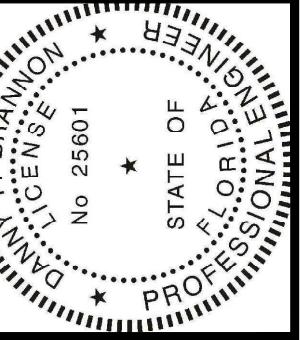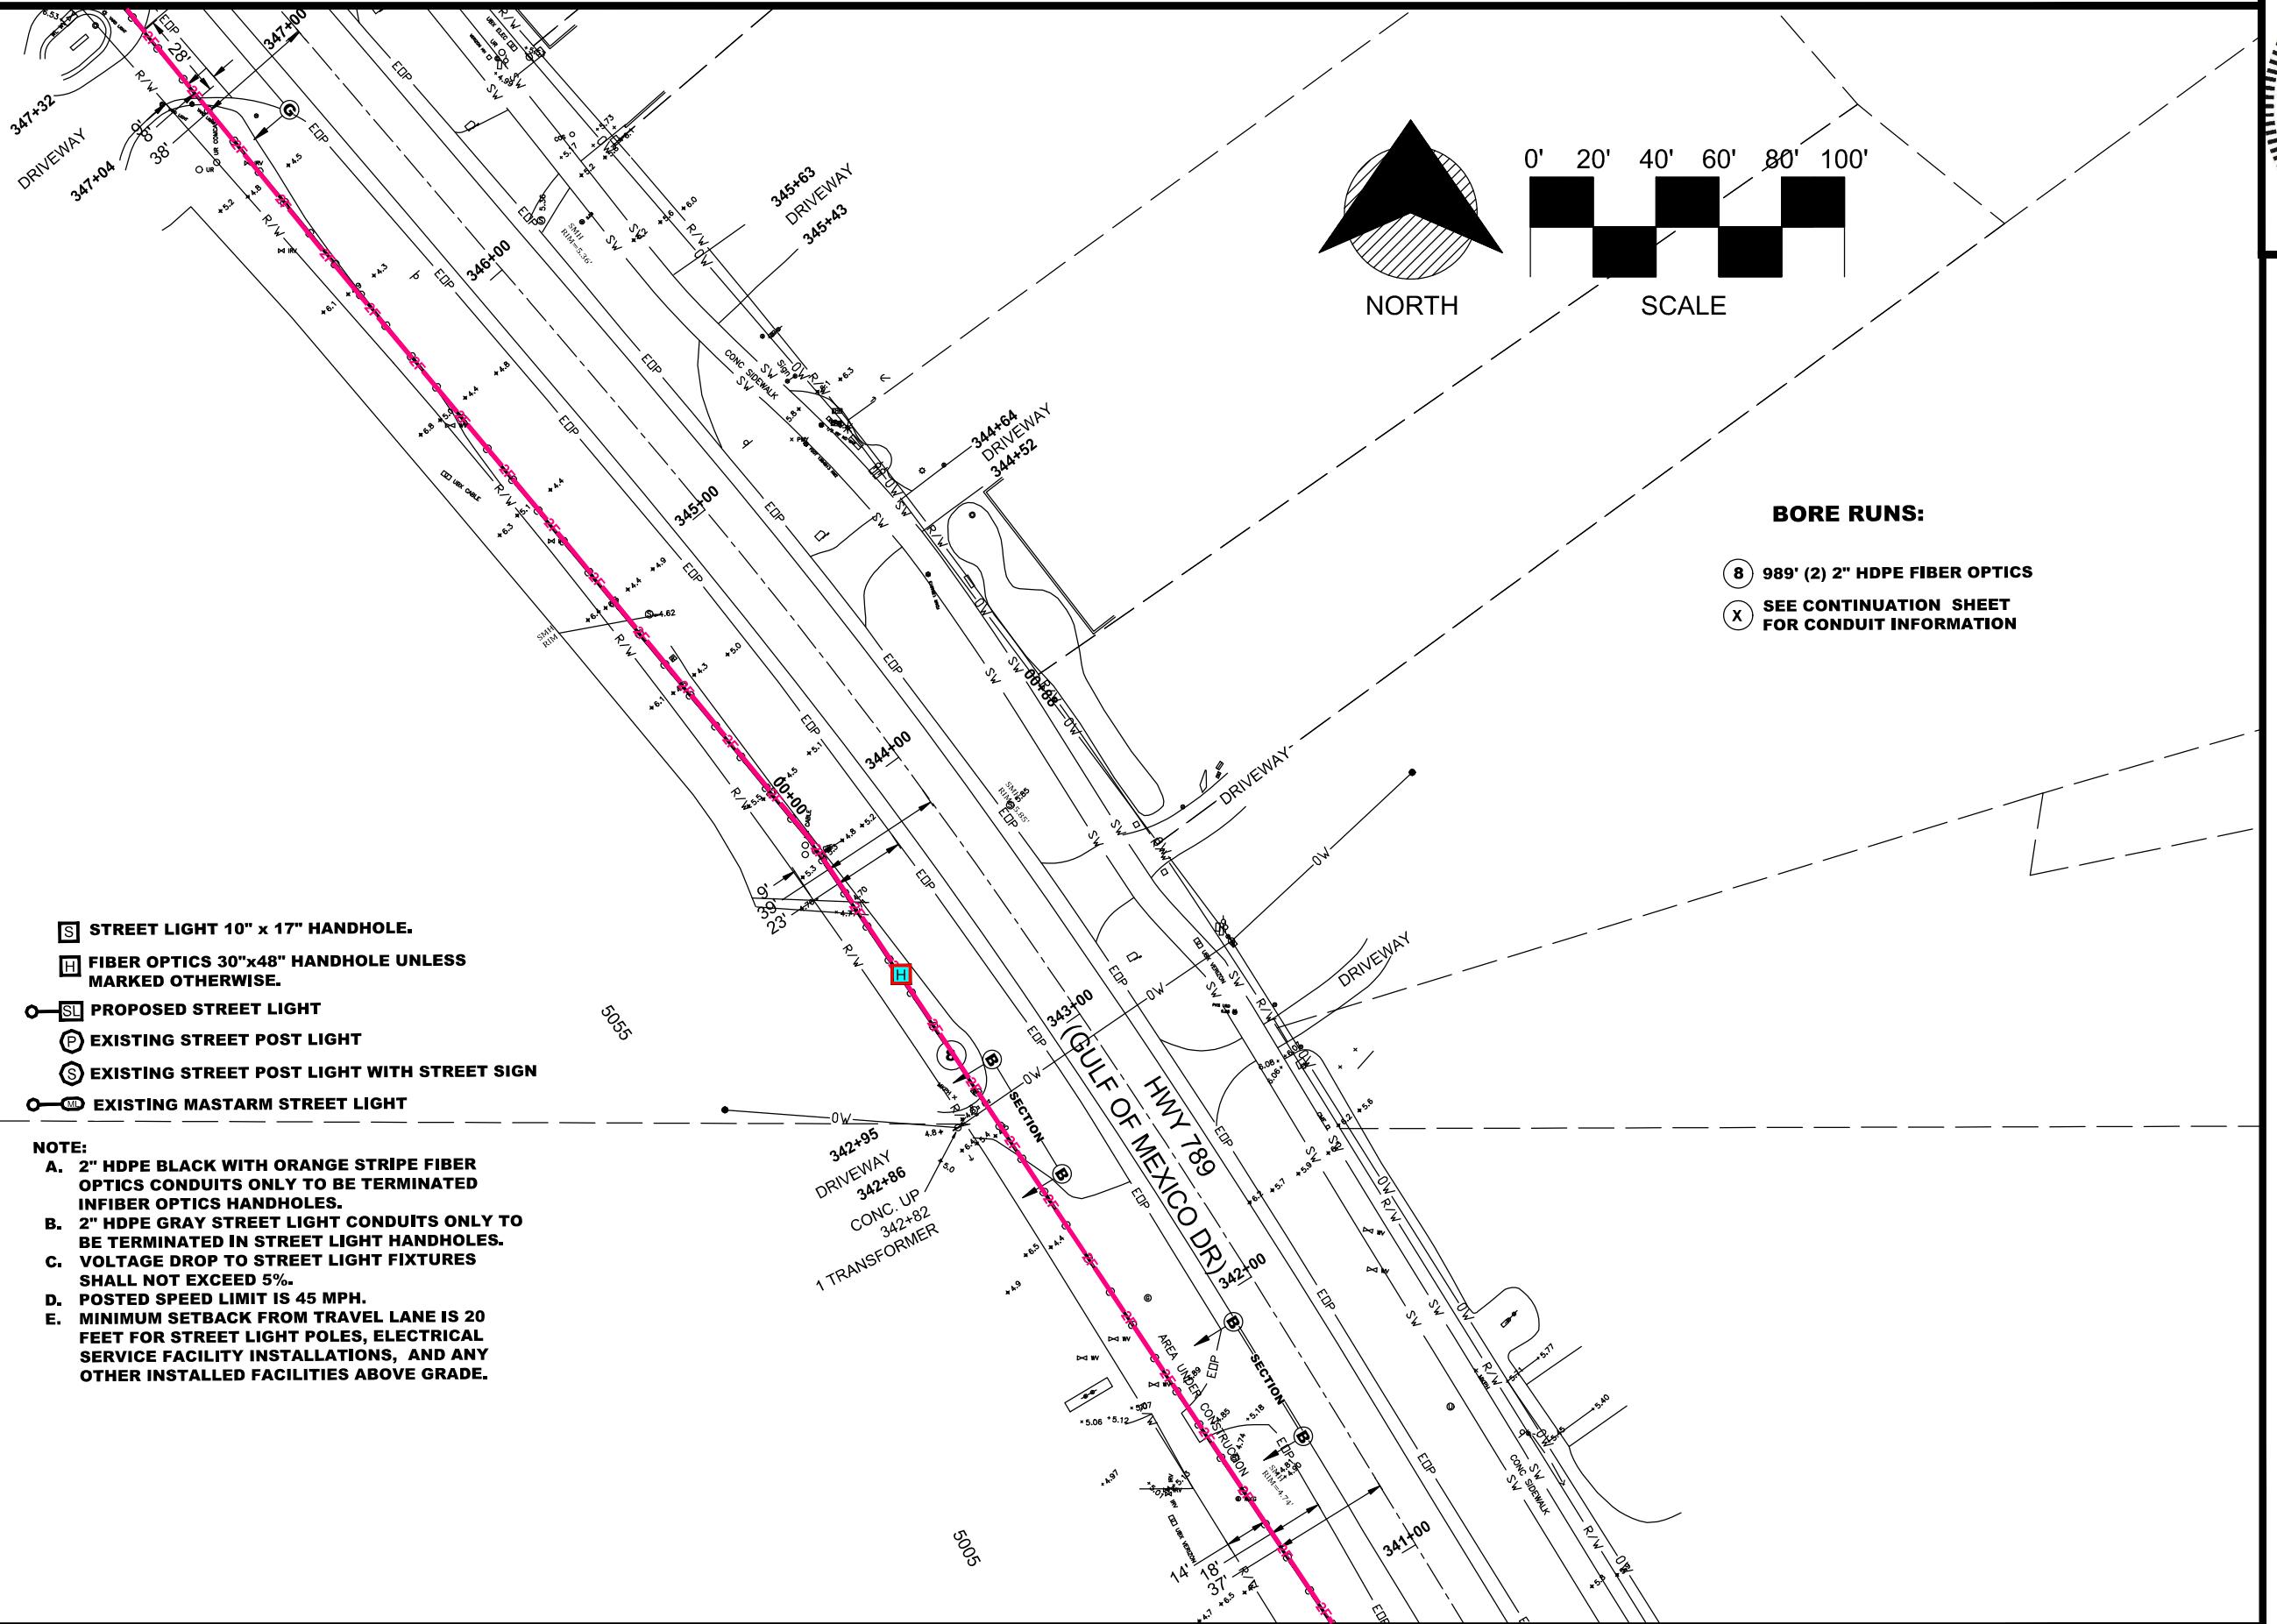

Digitally signed by
Danny P. Brannon
Date: 2021-09-11
16:25:18-04'00'


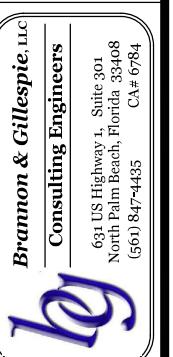


Town of Longboat Key


DRAWINGS FOR:
FIBER OPTIC AND STREET
LIGHTING UTILITY
CONSTRUCTION
LONGBOAT KEY, FLORIDA



Date: 12/01/2019
Scale: AS NOTED
Drawn: DPB
Checked: DPB
Job # 2014-LBK
Sheet

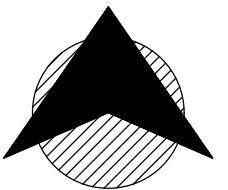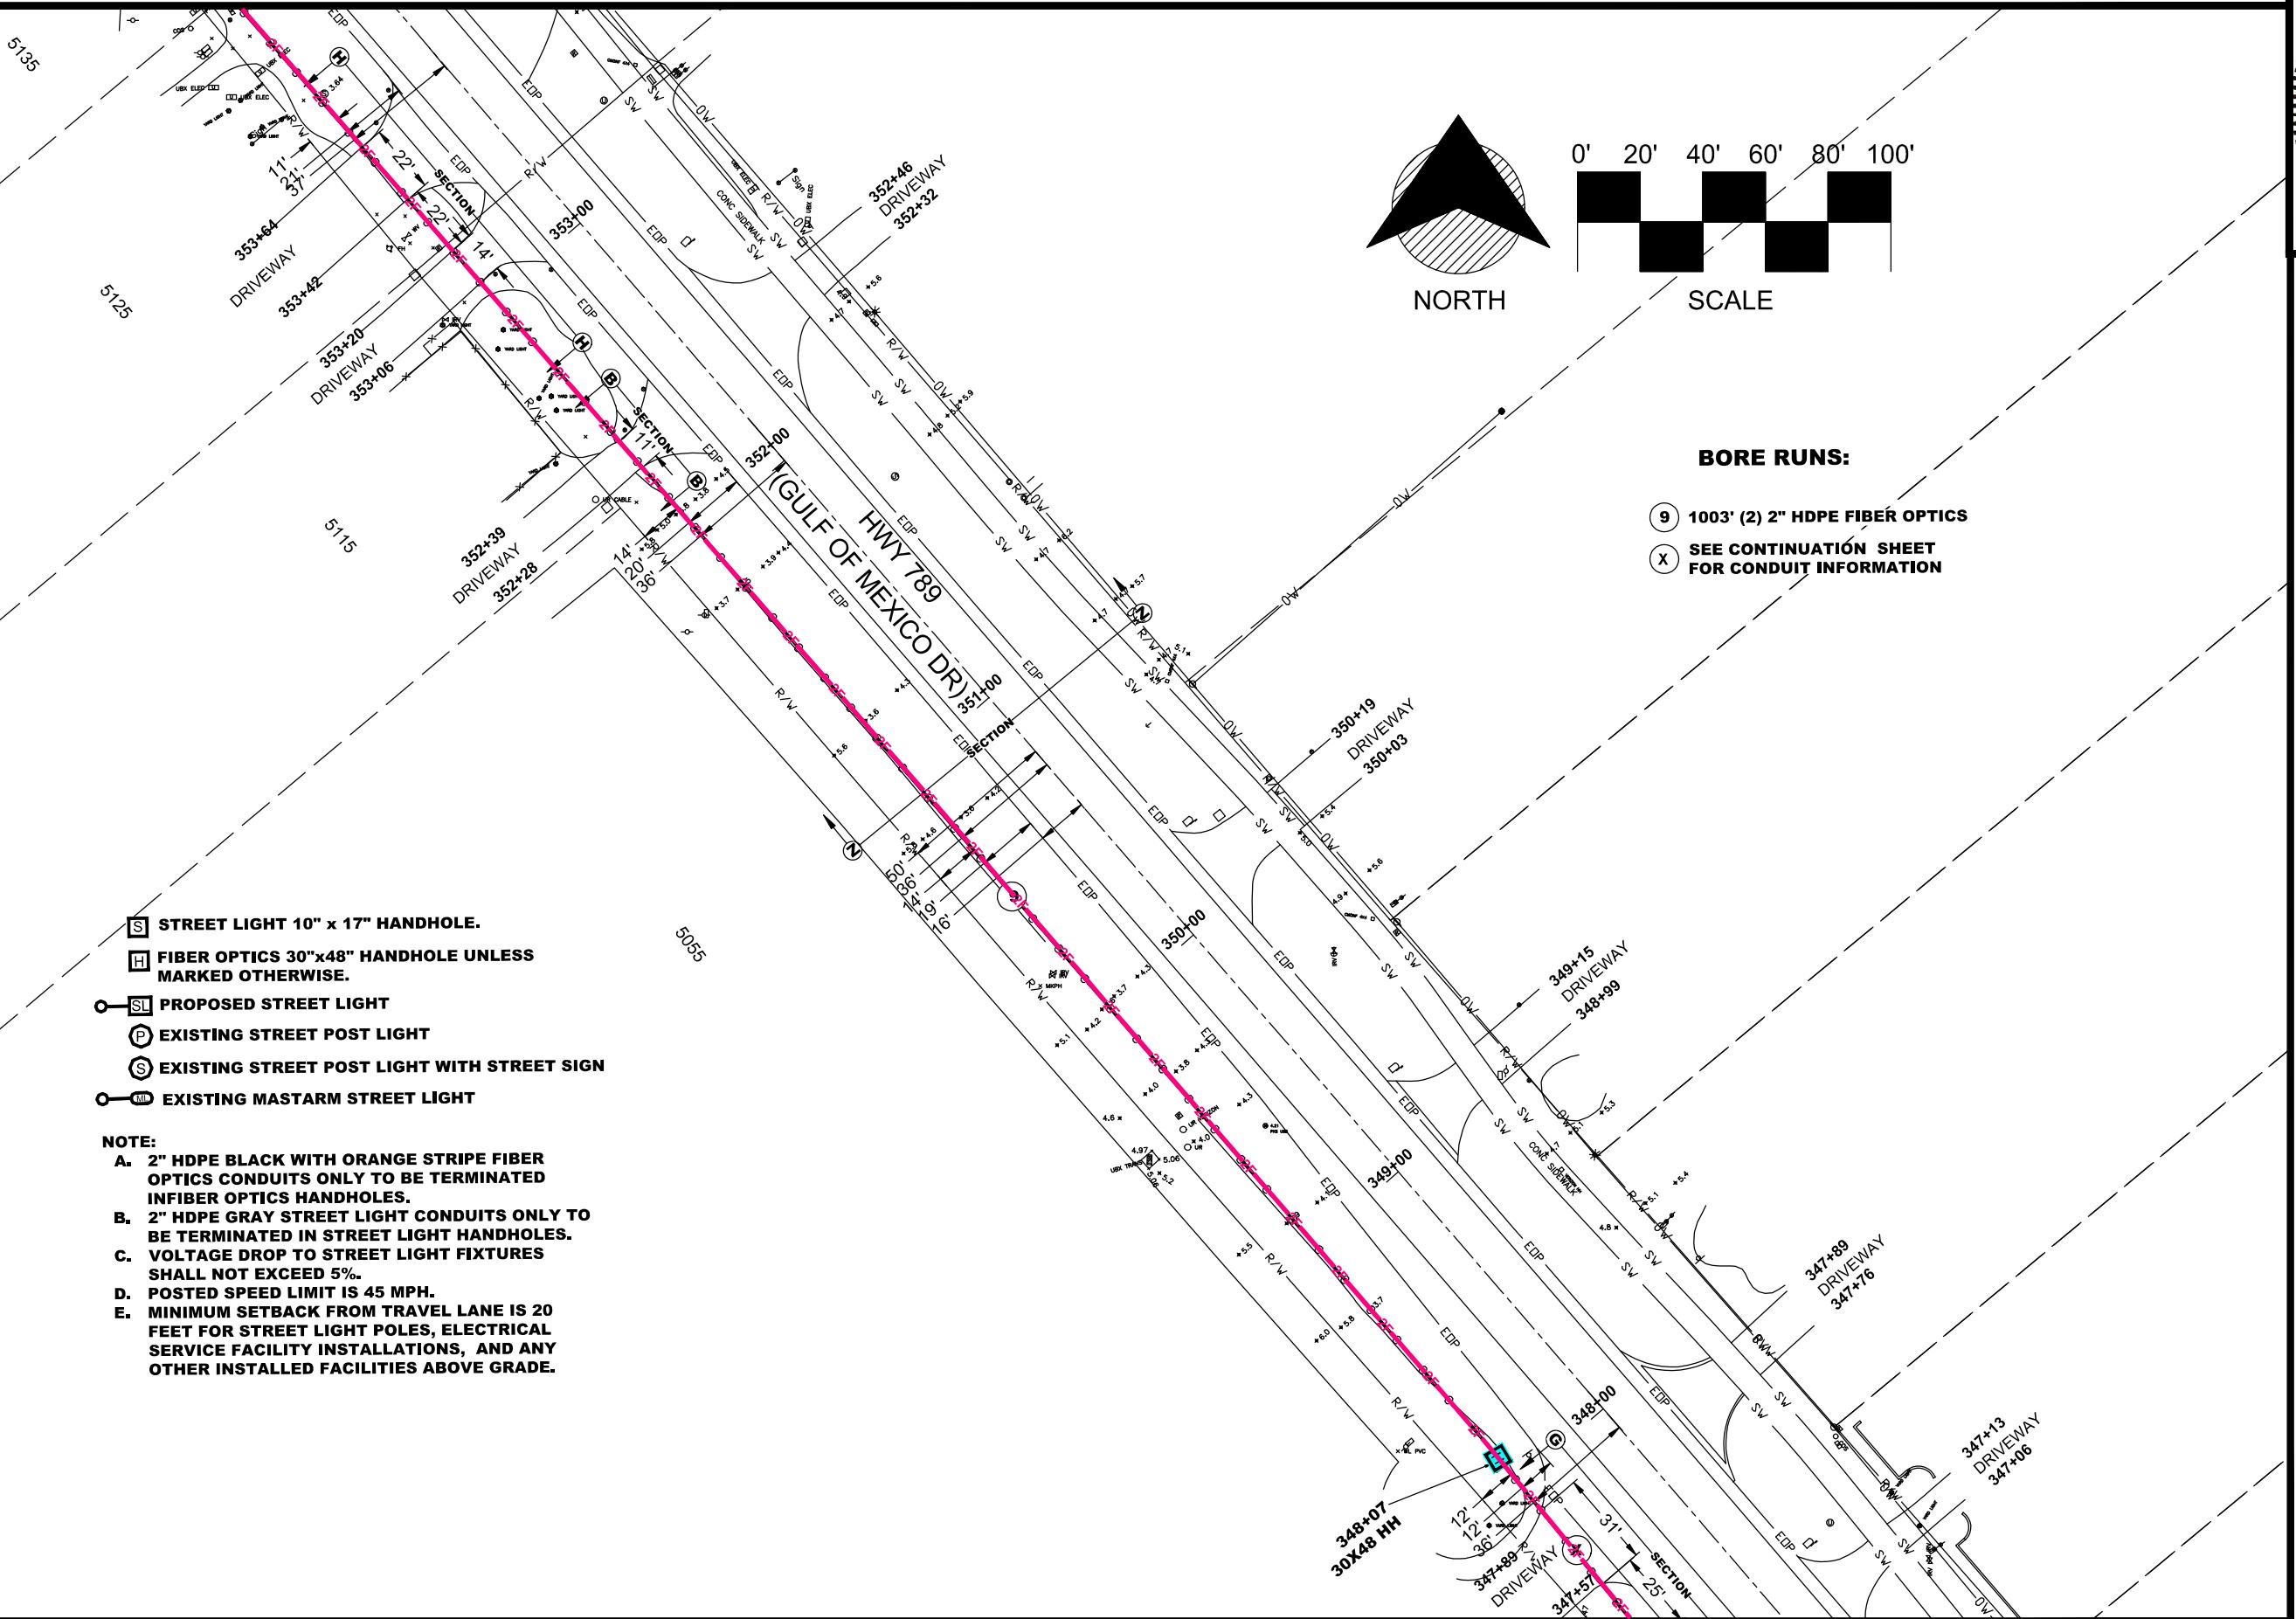

NORTH

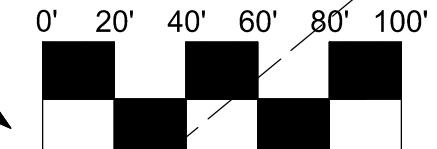

SCALE

BORE RUNS:

- ⑨ 1003' (2) 2" HDPE FIBER OPTICS
- ⑩ SEE CONTINUATION SHEET FOR CONDUIT INFORMATION

Town of Longboat Key

DRAWINGS FOR:
FIBER OPTIC AND STREET
LIGHTING UTILITY
CONSTRUCTION
LONGBOAT KEY, FLORIDA



Date: 12/01/2019

Scale: AS NOTED



Drawn: DPB


Checked: DPB

Job # 2014-LBK

Sheet

12 OF 22

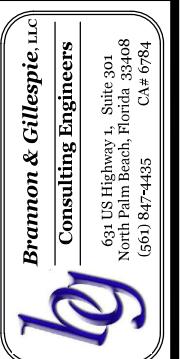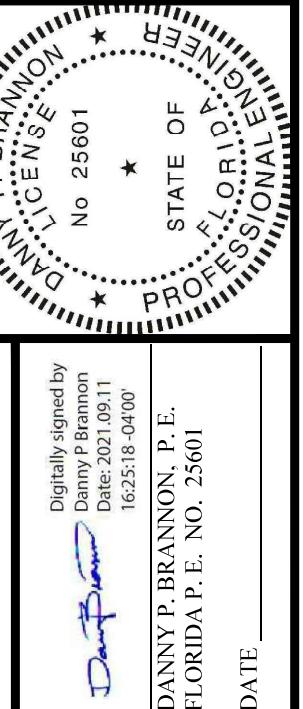

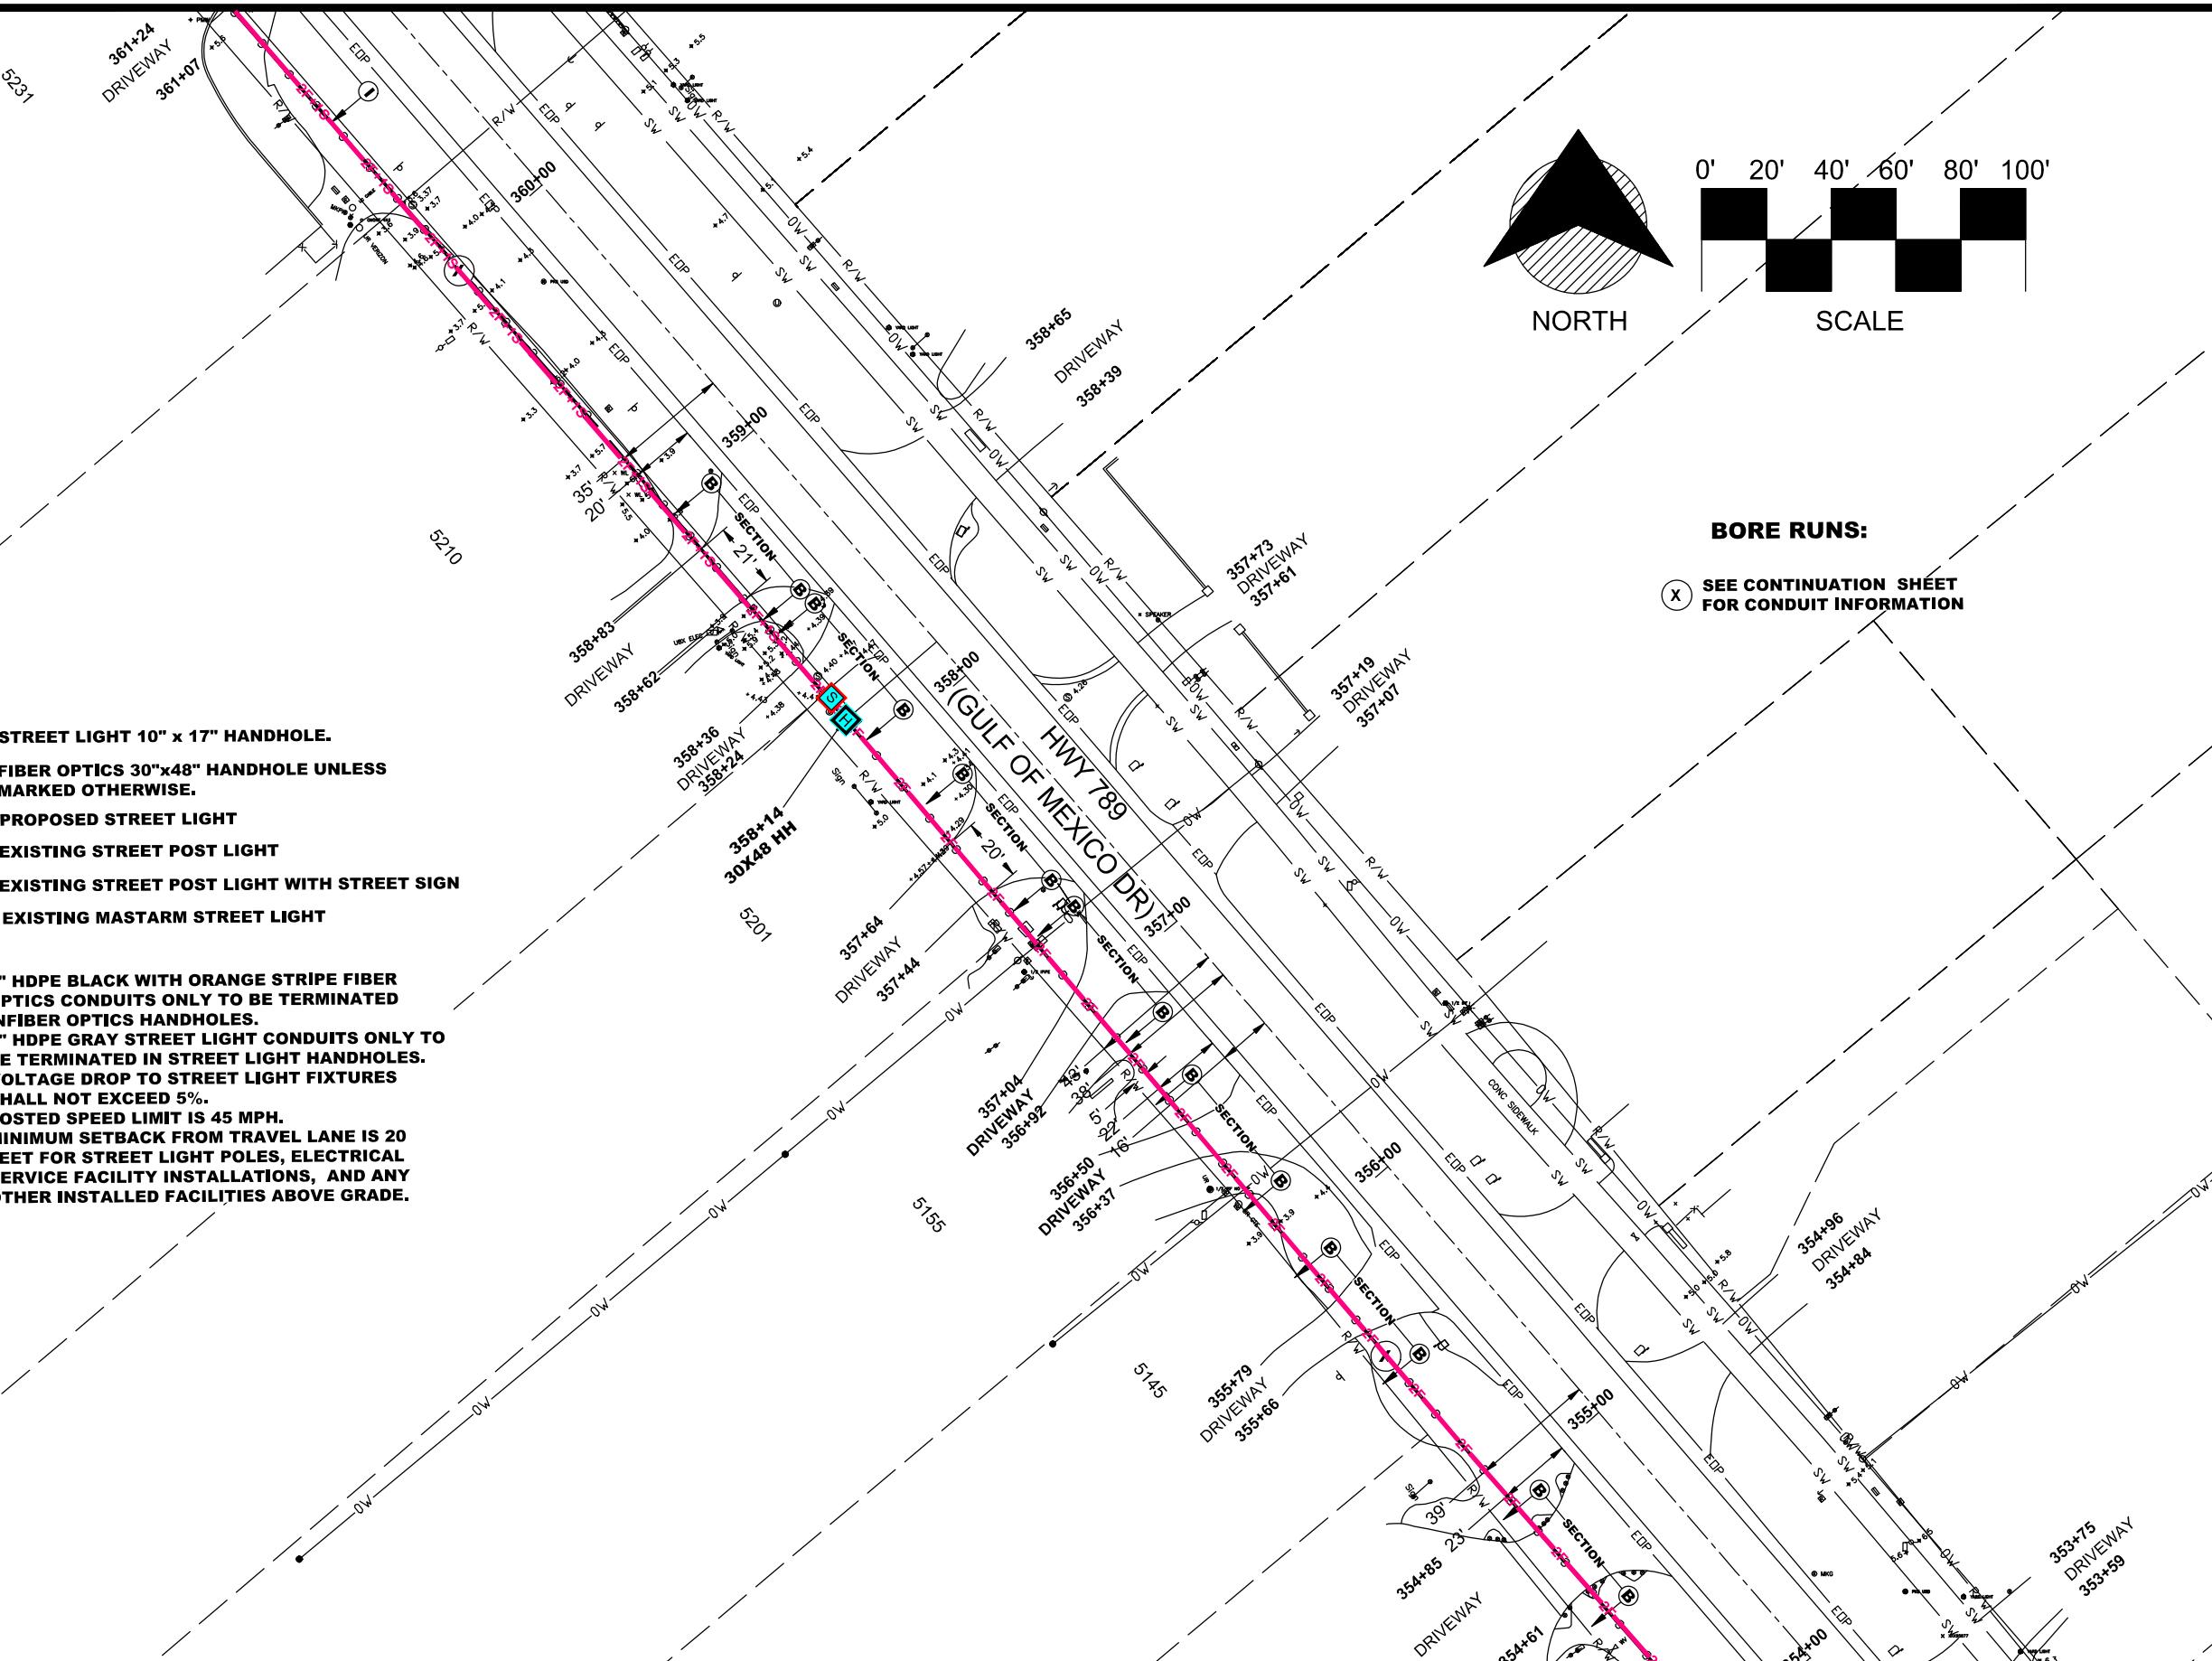

Town of Longboat Key


DRAWINGS FOR:
FIBER OPTIC AND STREET
LIGHTING UTILITY
CONSTRUCTION
LONGBOAT KEY, FLORIDA




Date: 12/01/2019
Scale: AS NOTED
Drawn: DPB
Checked: DPB
Job # 2014-LBK


Sheet
13 OF 22

Digital signature by
Danny P. Brannon
Date: 2021-09-11
16:25:18 -04'00'
DANNY P. BRANNON, P. E.
FLORIDA P. E. NO. 25601
DATE

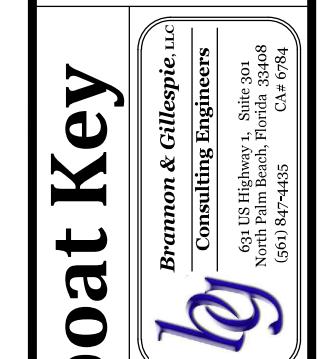

Brannon & Gillespie, Inc.
Consulting Engineers
634 US Highway 1, Suite 301
North Palm Beach, Florida 33408
CA# 6784
(561) 847-4435

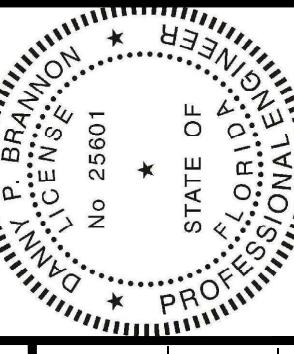

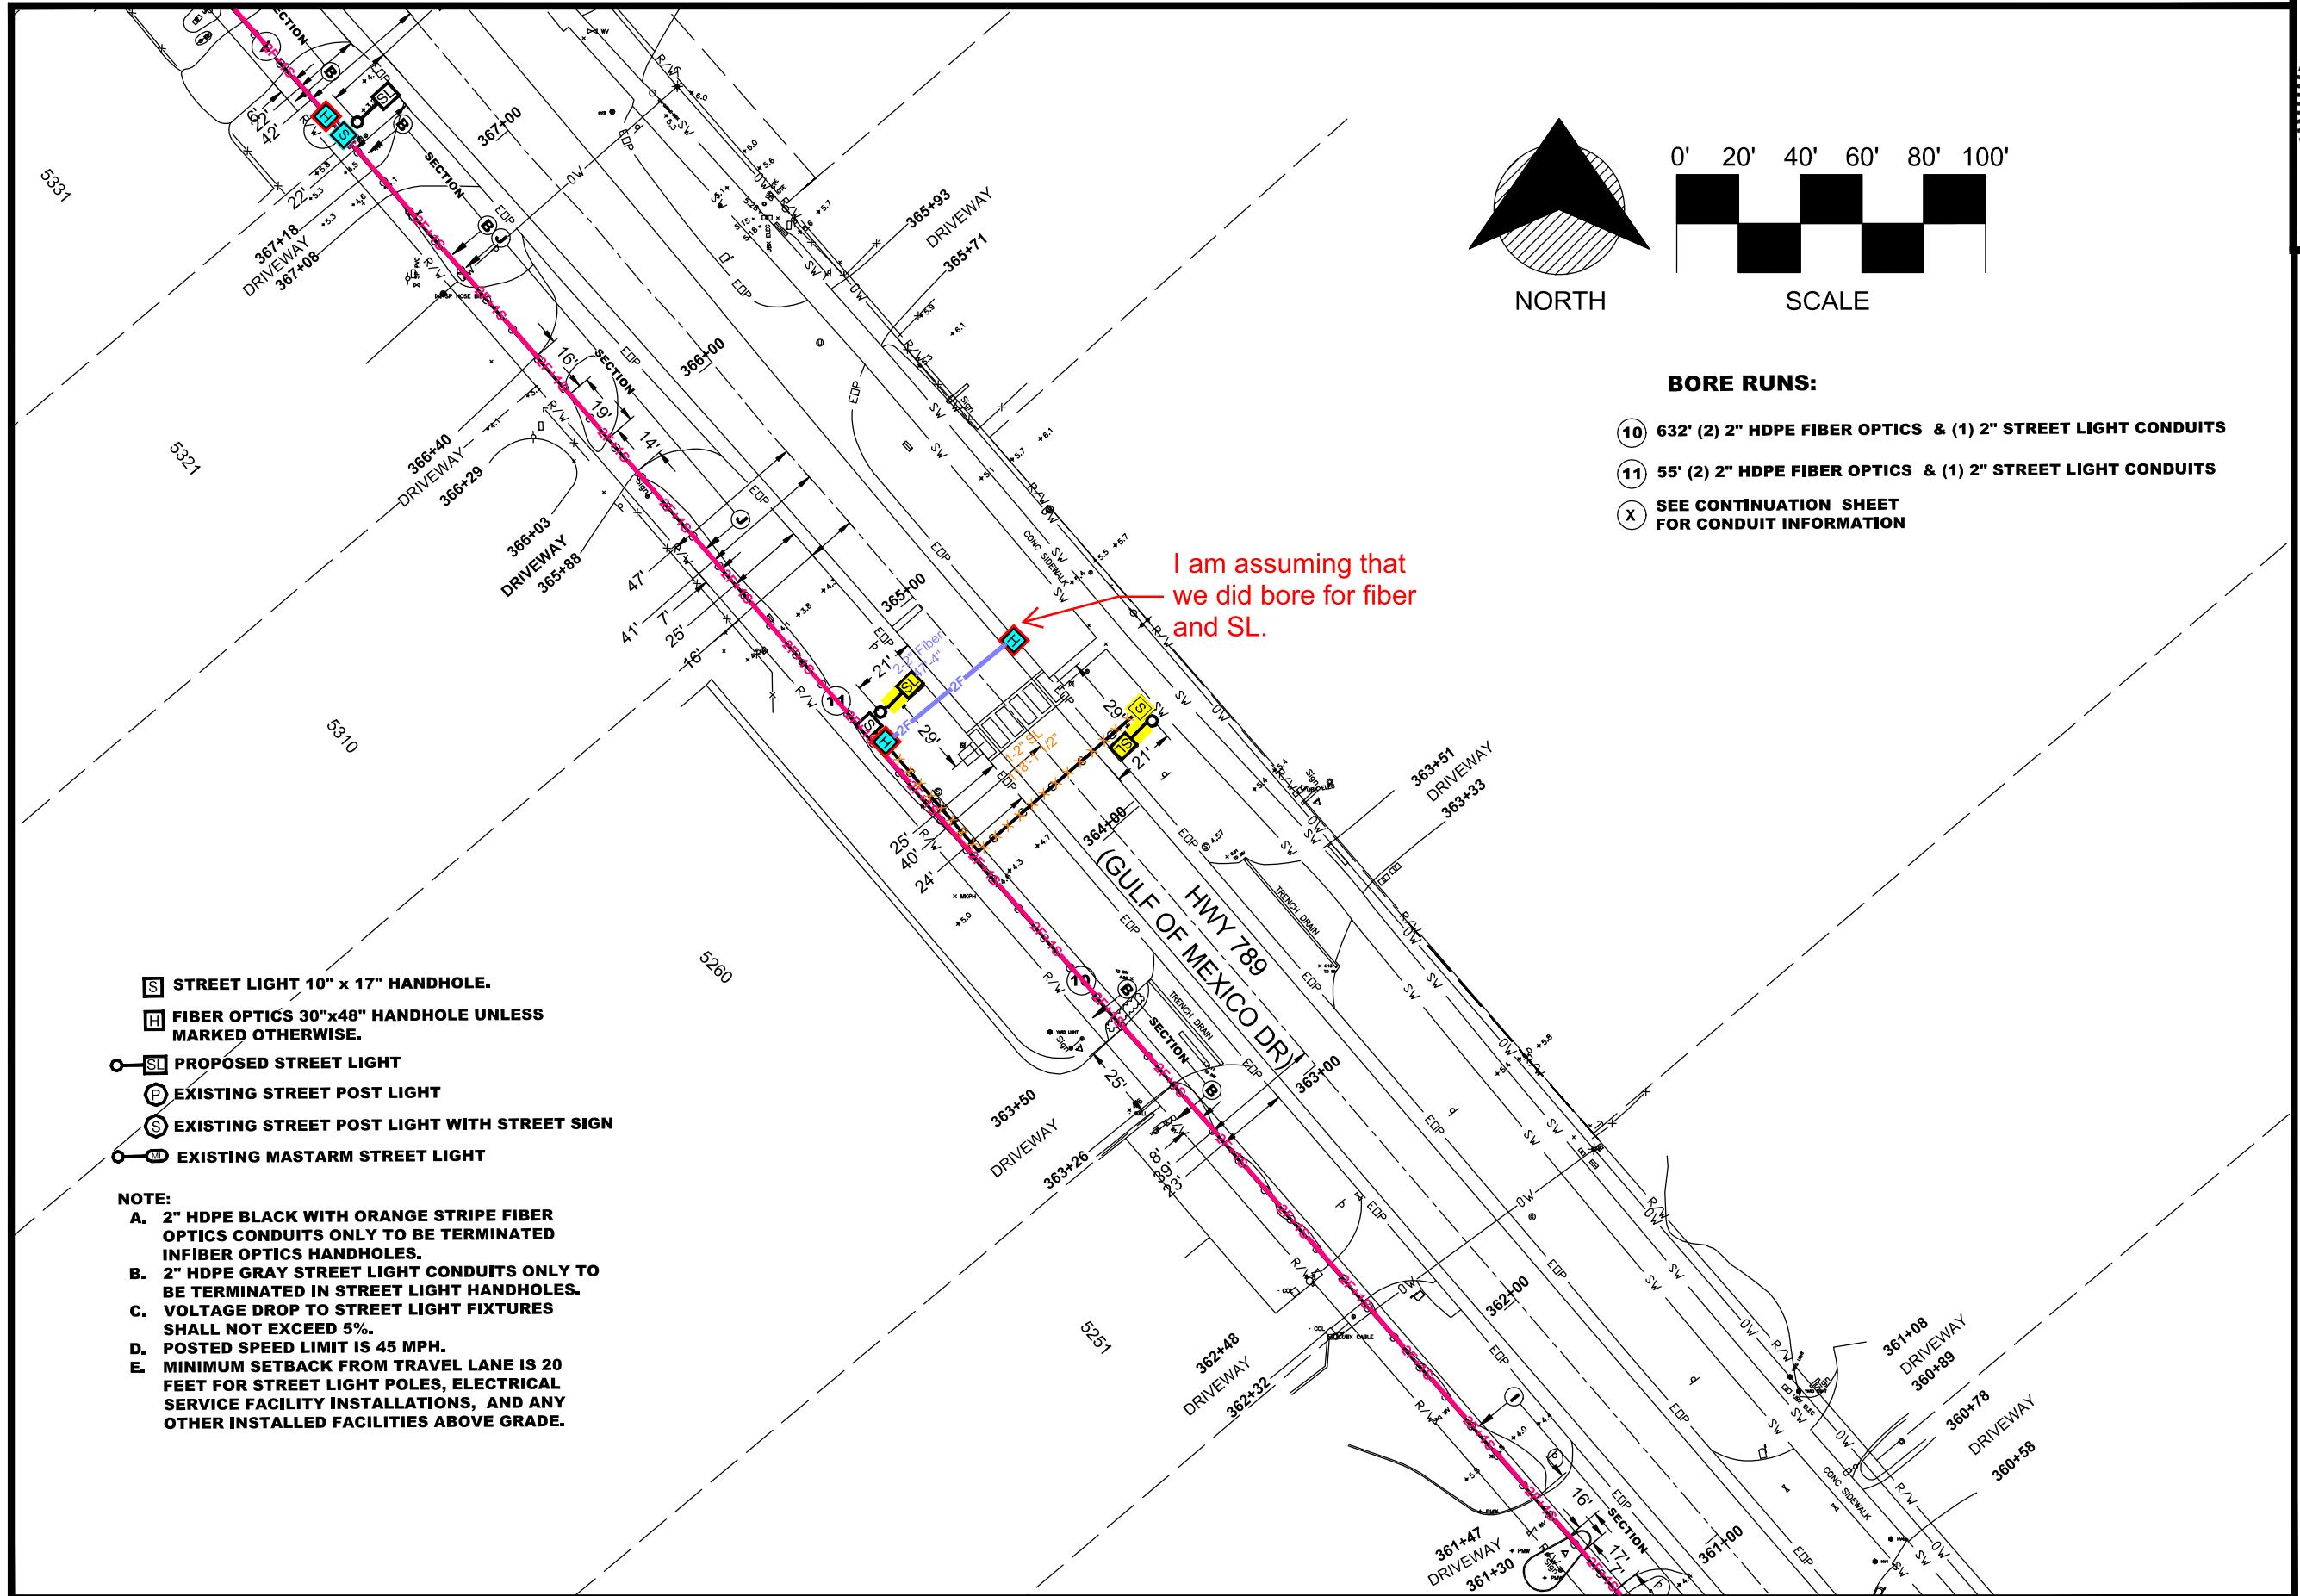

Town of Longboat Key


DRAWINGS FOR:
FIBER OPTIC AND STREET LIGHTING UTILITY CONSTRUCTION
LONGBOAT KEY, FLORIDA




Date: 12/01/2019
Scale: AS NOTED
Drawn: DPB
Checked: DPB
Job #: 2014-LBK
Sheet



Digital signed by
Danny P. Brannon
Date: 2021-09-11
16:25:18-04:00

DANNY P. BRANNON, P.E.
FLORIDA P.E. NO. 25601
DATE

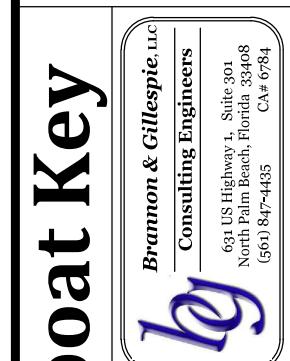


Brannon & Gillespie, Inc.
Consulting Engineers
631 US Highway 1, Suite 301
North Palm Beach, Florida 33408
(561) 847-4435
CA# 6784

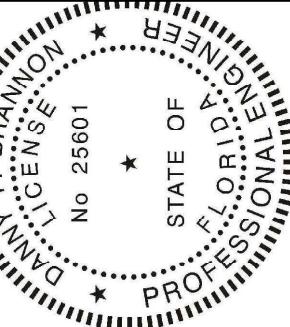

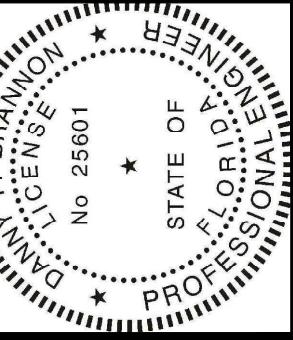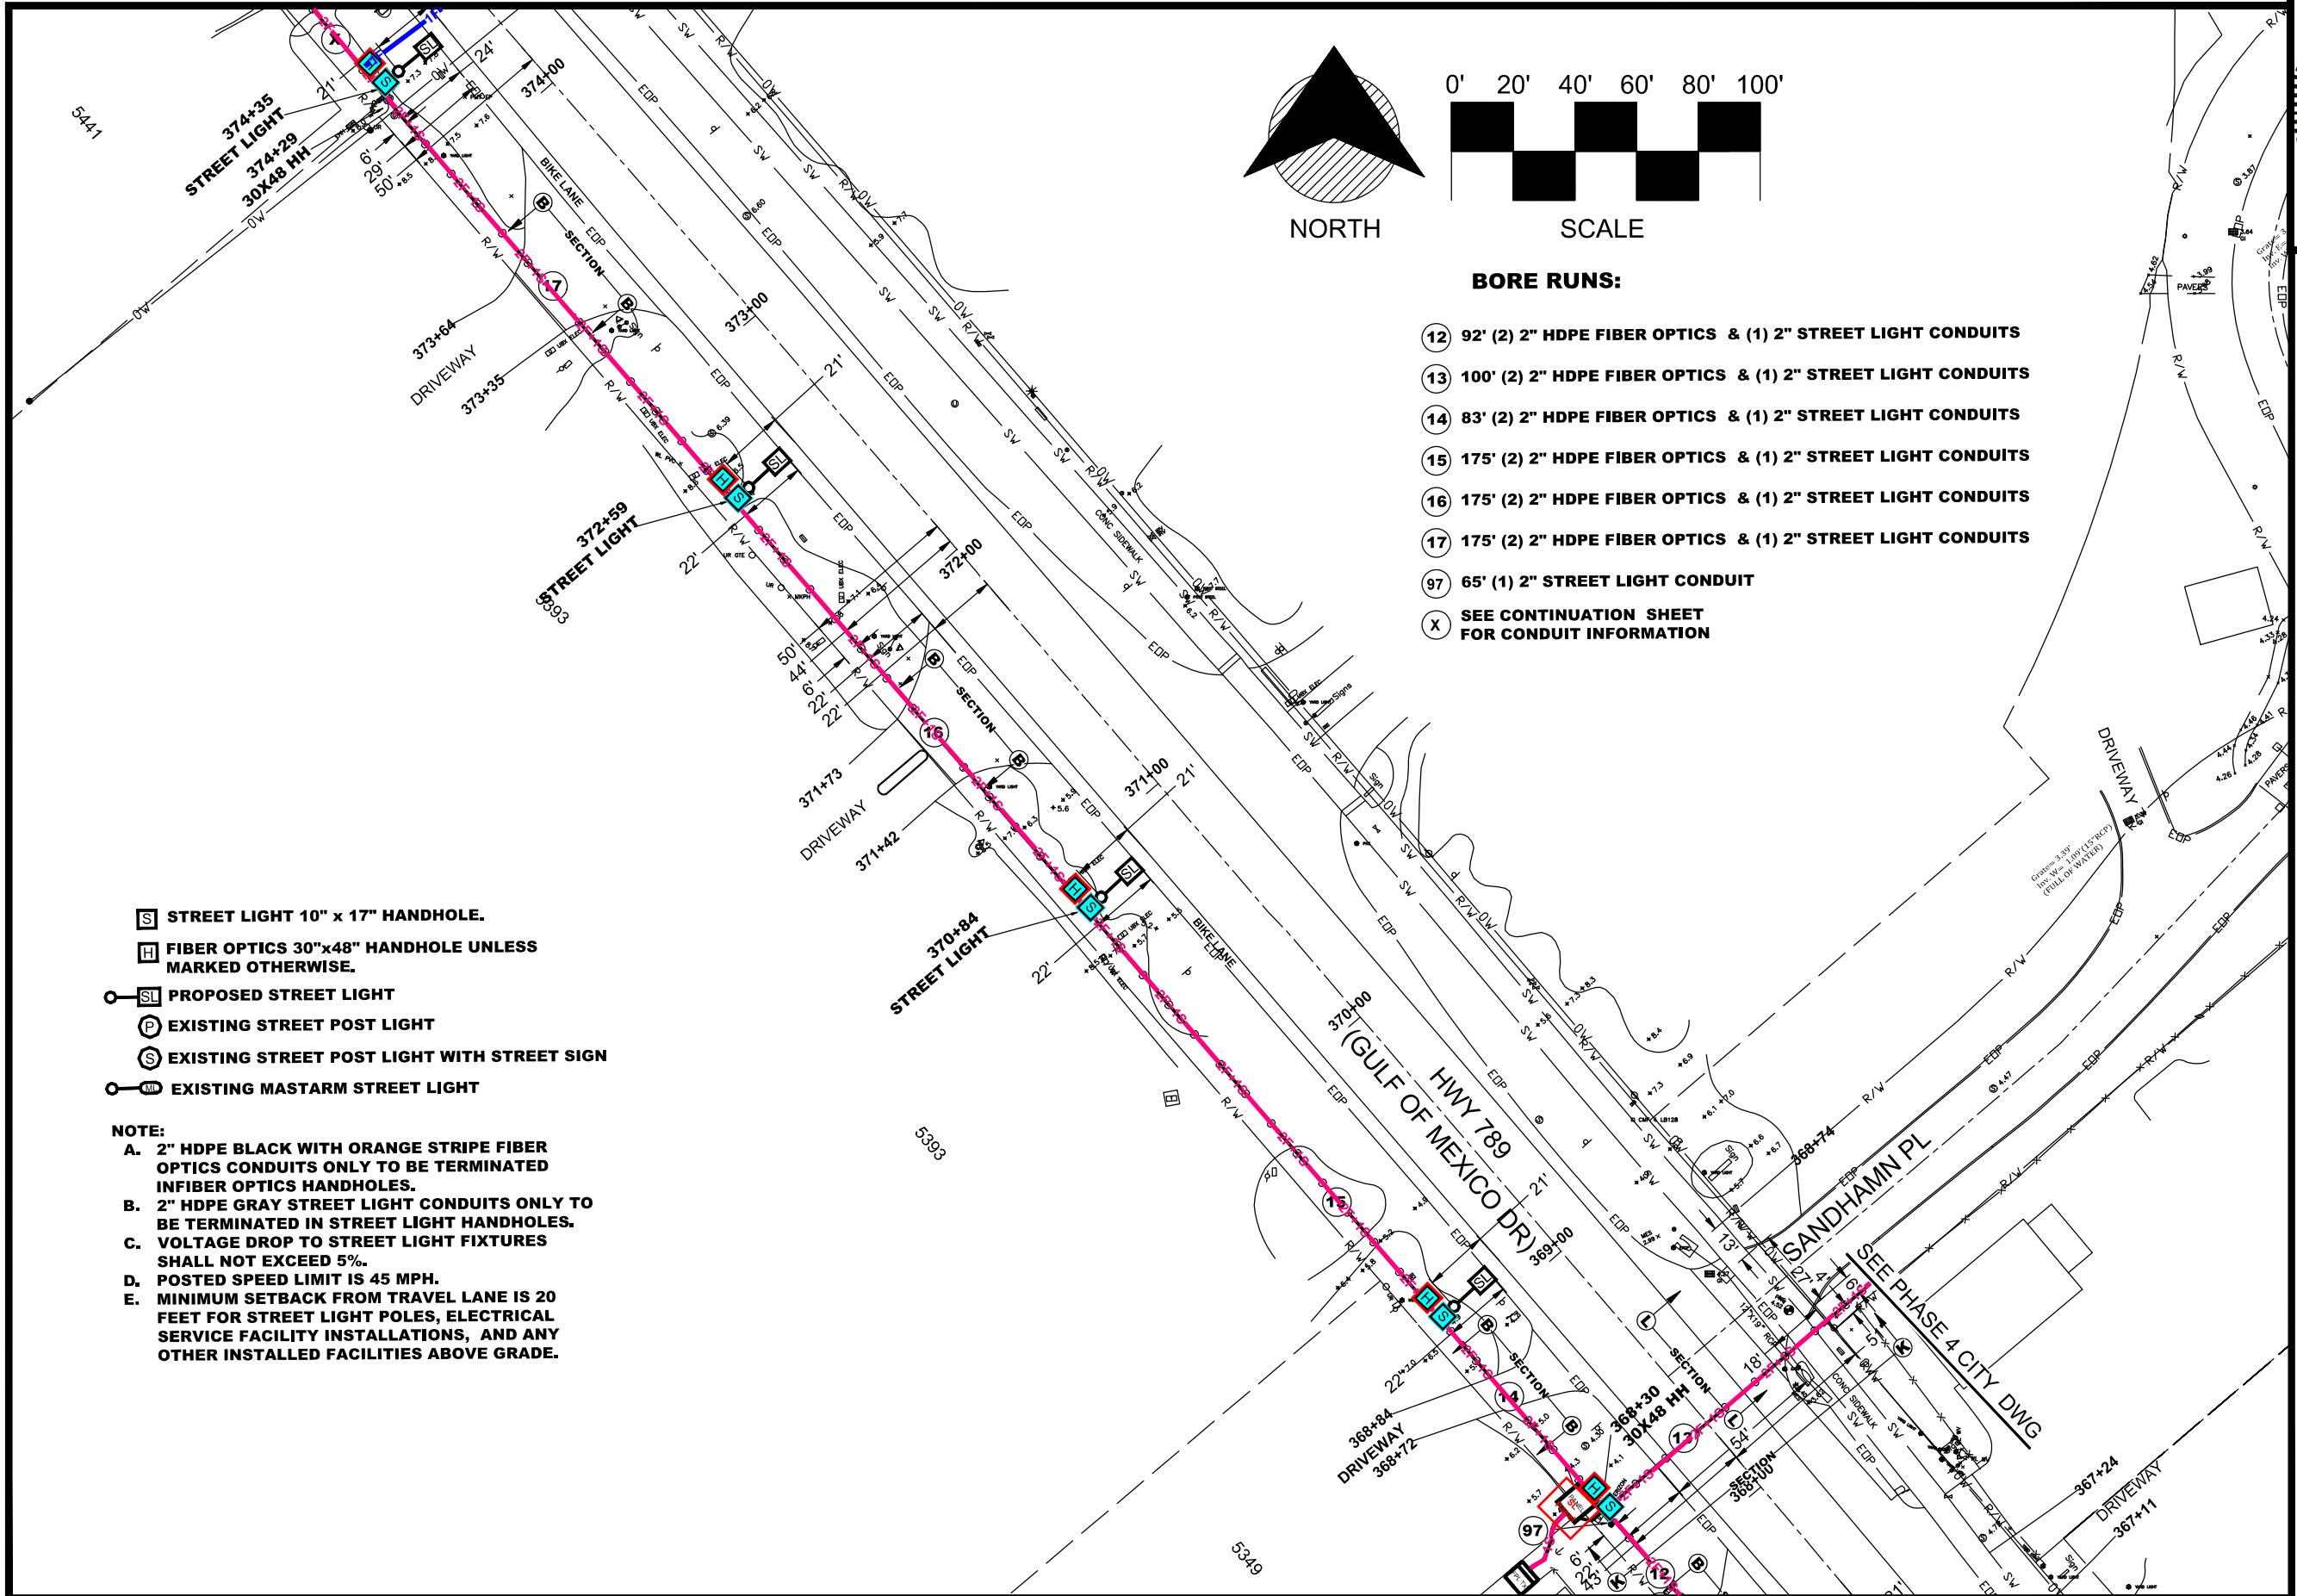

Digitally signed by
Danny P. Brannon
Date: 2021-09-11
16:25:18-04'00'

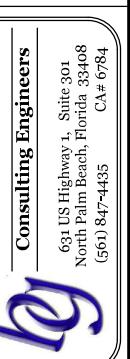

634 US Highway 1, Suite 301
North Palm Beach, Florida 33408
CA# 6784
(561) 847-4435


Town of Longboat Key

DRAWINGS FOR:
FIBER OPTIC AND STREET
LIGHTING UTILITY
CONSTRUCTION
LONGBOAT KEY, FLORIDA



Date: 12/01/2019
Scale: AS NOTED
Drawn: DPB
Checked: DPB
Job # 2014-LBK

Sheet
15 OF 22

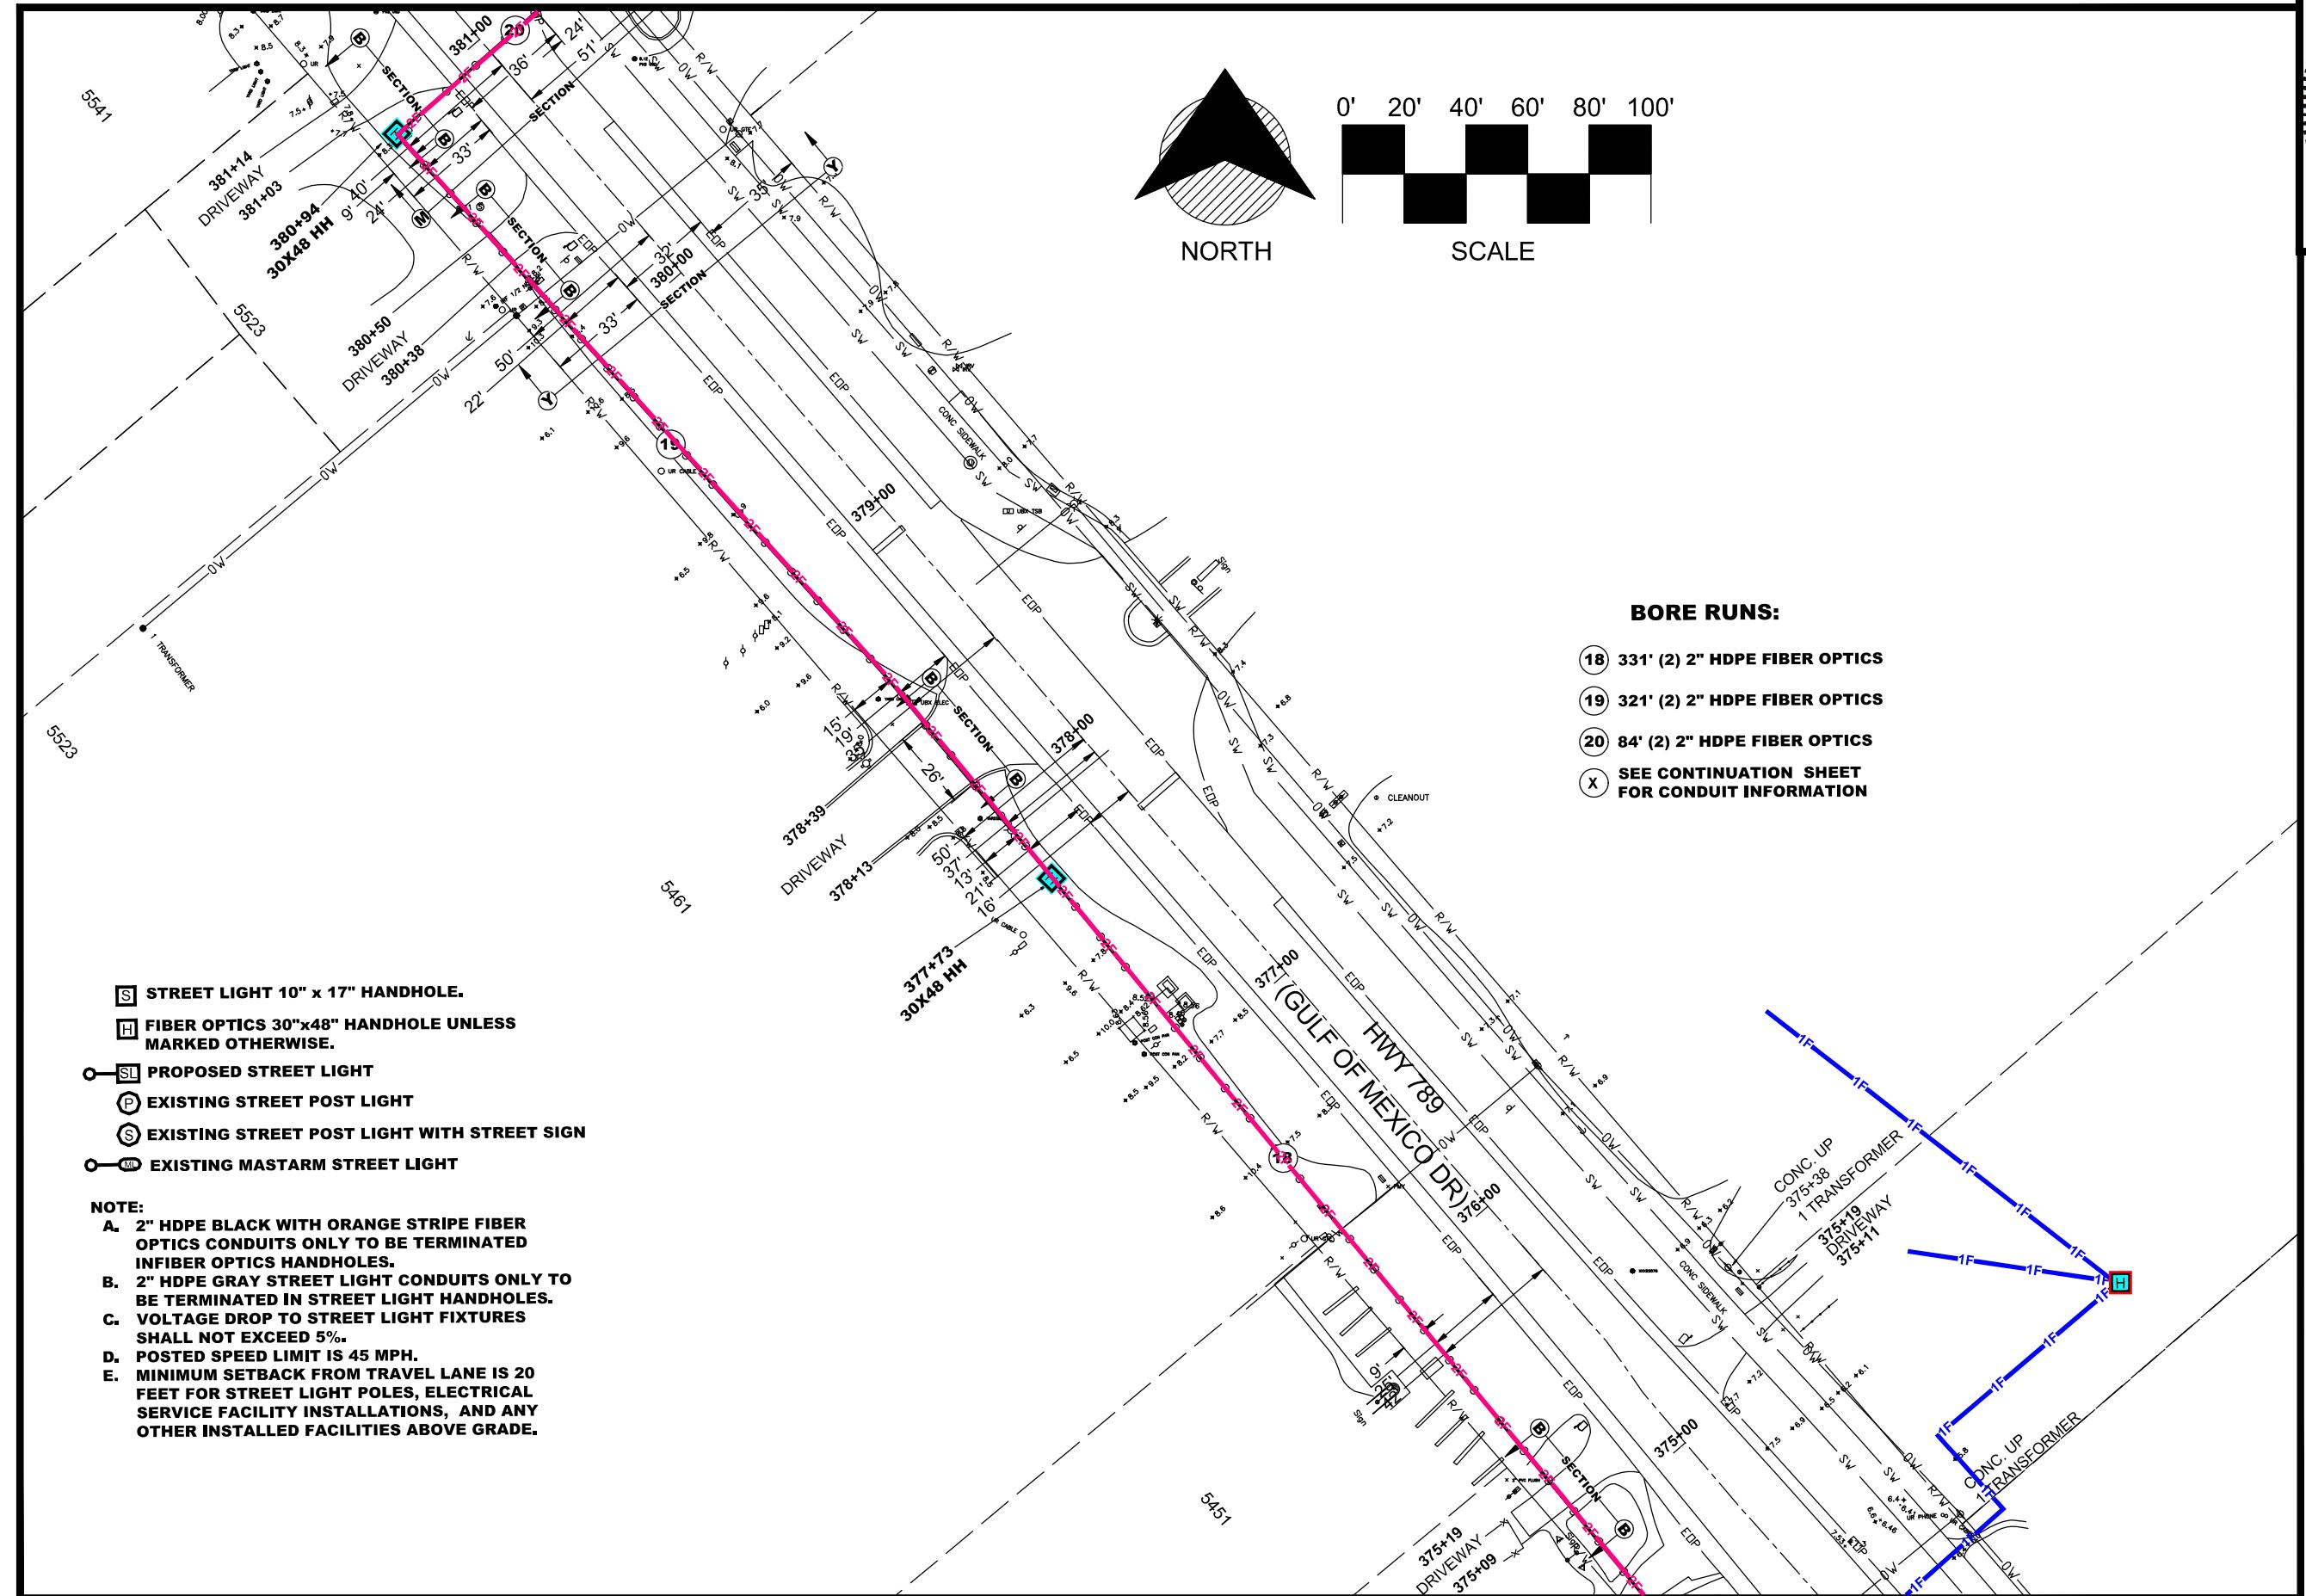

Town of Longboat Key

DRAWINGS FOR:
FIBER OPTIC AND STREET
LIGHTING UTILITY
CONSTRUCTION
LONGBOAT KEY, FLORIDA




Date: 12/01/2019
Scale: AS NOTED
Drawn: DPB
Checked: DPB
Job # 2014-LBK
Sheet

16 OF 22


Digital signature by
Danny P. Brannon
Date: 2021-09-11
16:25:18 -04'00'



DANNY P. BRANNON, P. E.
FLORIDA P. E. NO. 25601
DATE

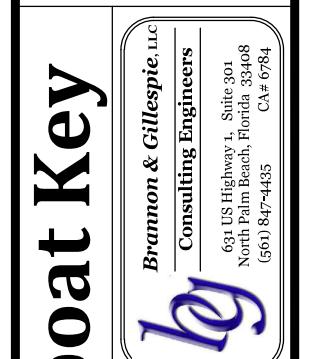


Brannon & Gillespie, Inc.
Consulting Engineers

634 US Highway 1, Suite 301
North Palm Beach, Florida 33408
CA# 6784
(561) 847-7435

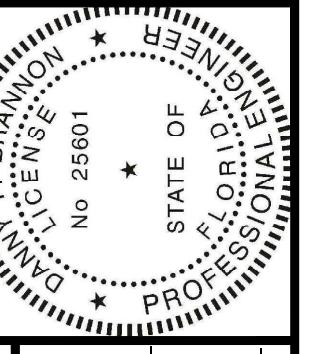

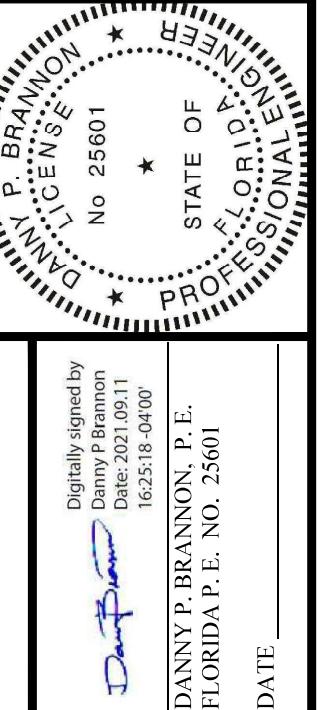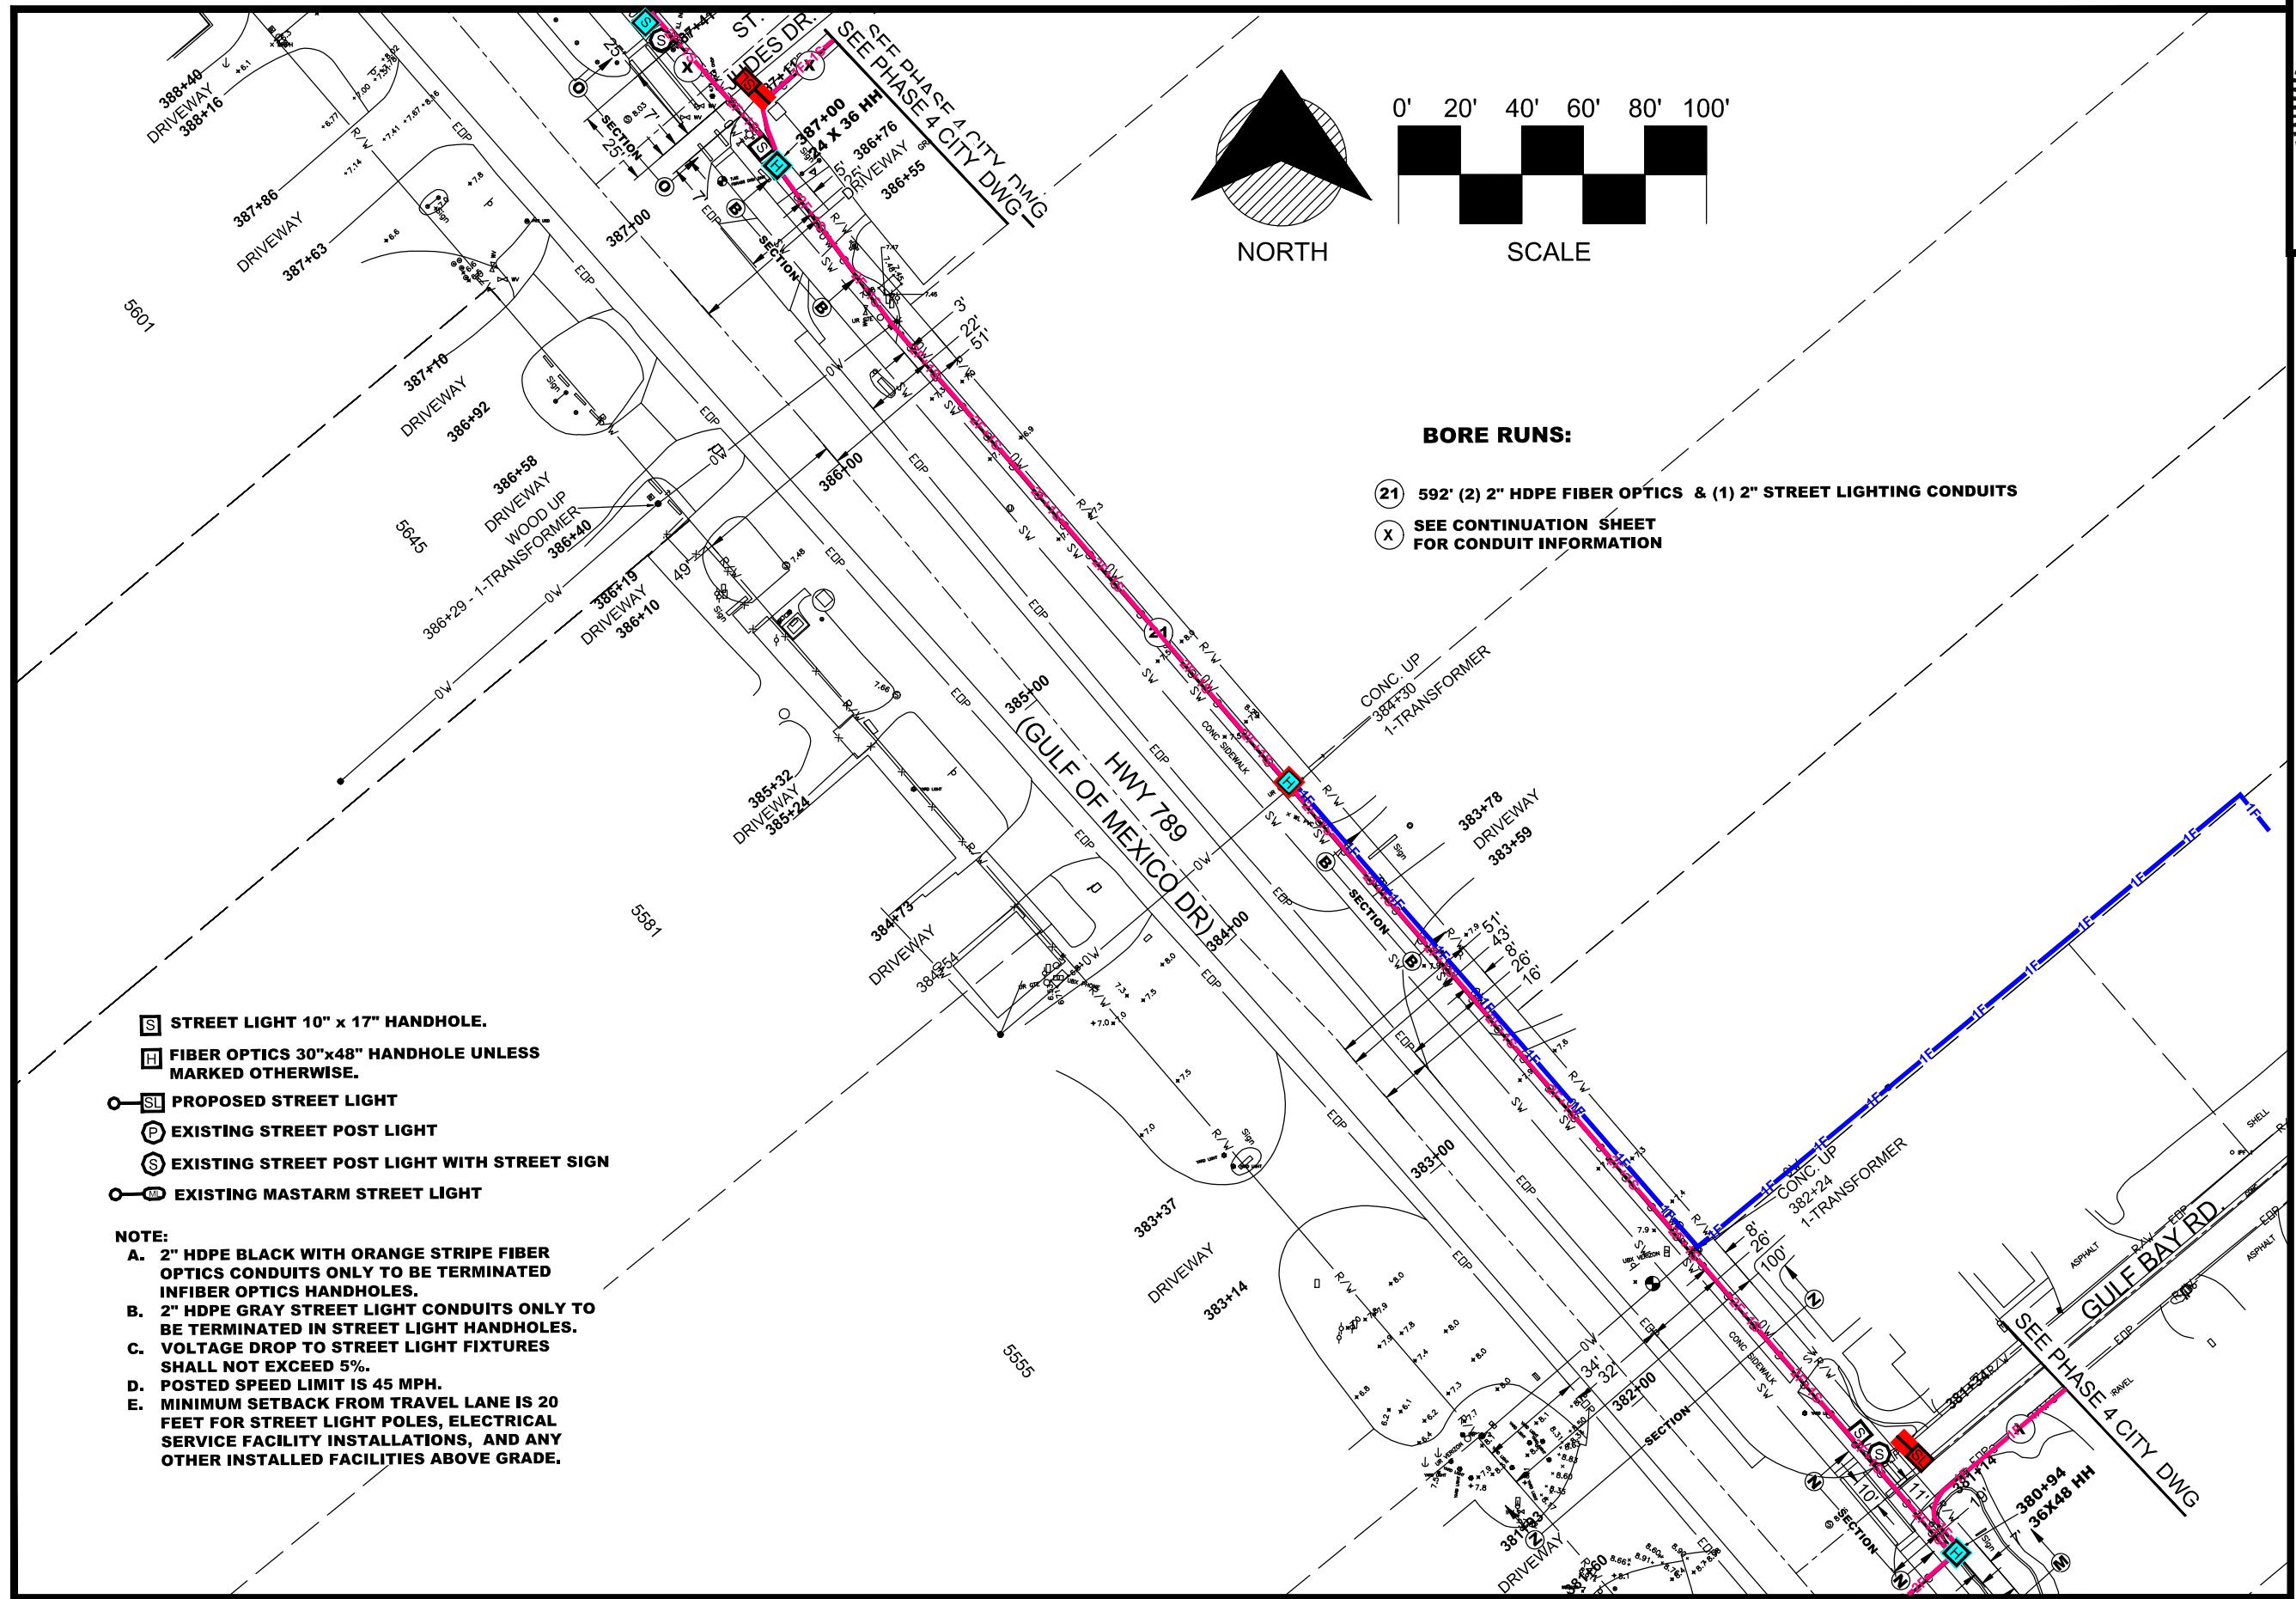

Digital signature by
Danny P. Brannon
Date: 2021-09-11
16:25:18-04'00'

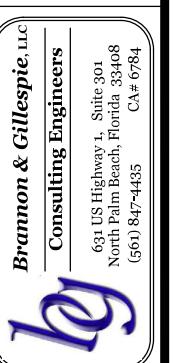


Town of Longboat Key

DRAWINGS FOR:
FIBER OPTIC AND STREET
LIGHTING UTILITY
CONSTRUCTION
LONGBOAT KEY, FLORIDA



Date: 12/01/2019
Scale: AS NOTED
Drawn: DPB
Checked: DPB
Job # 2014-LBK
Sheet

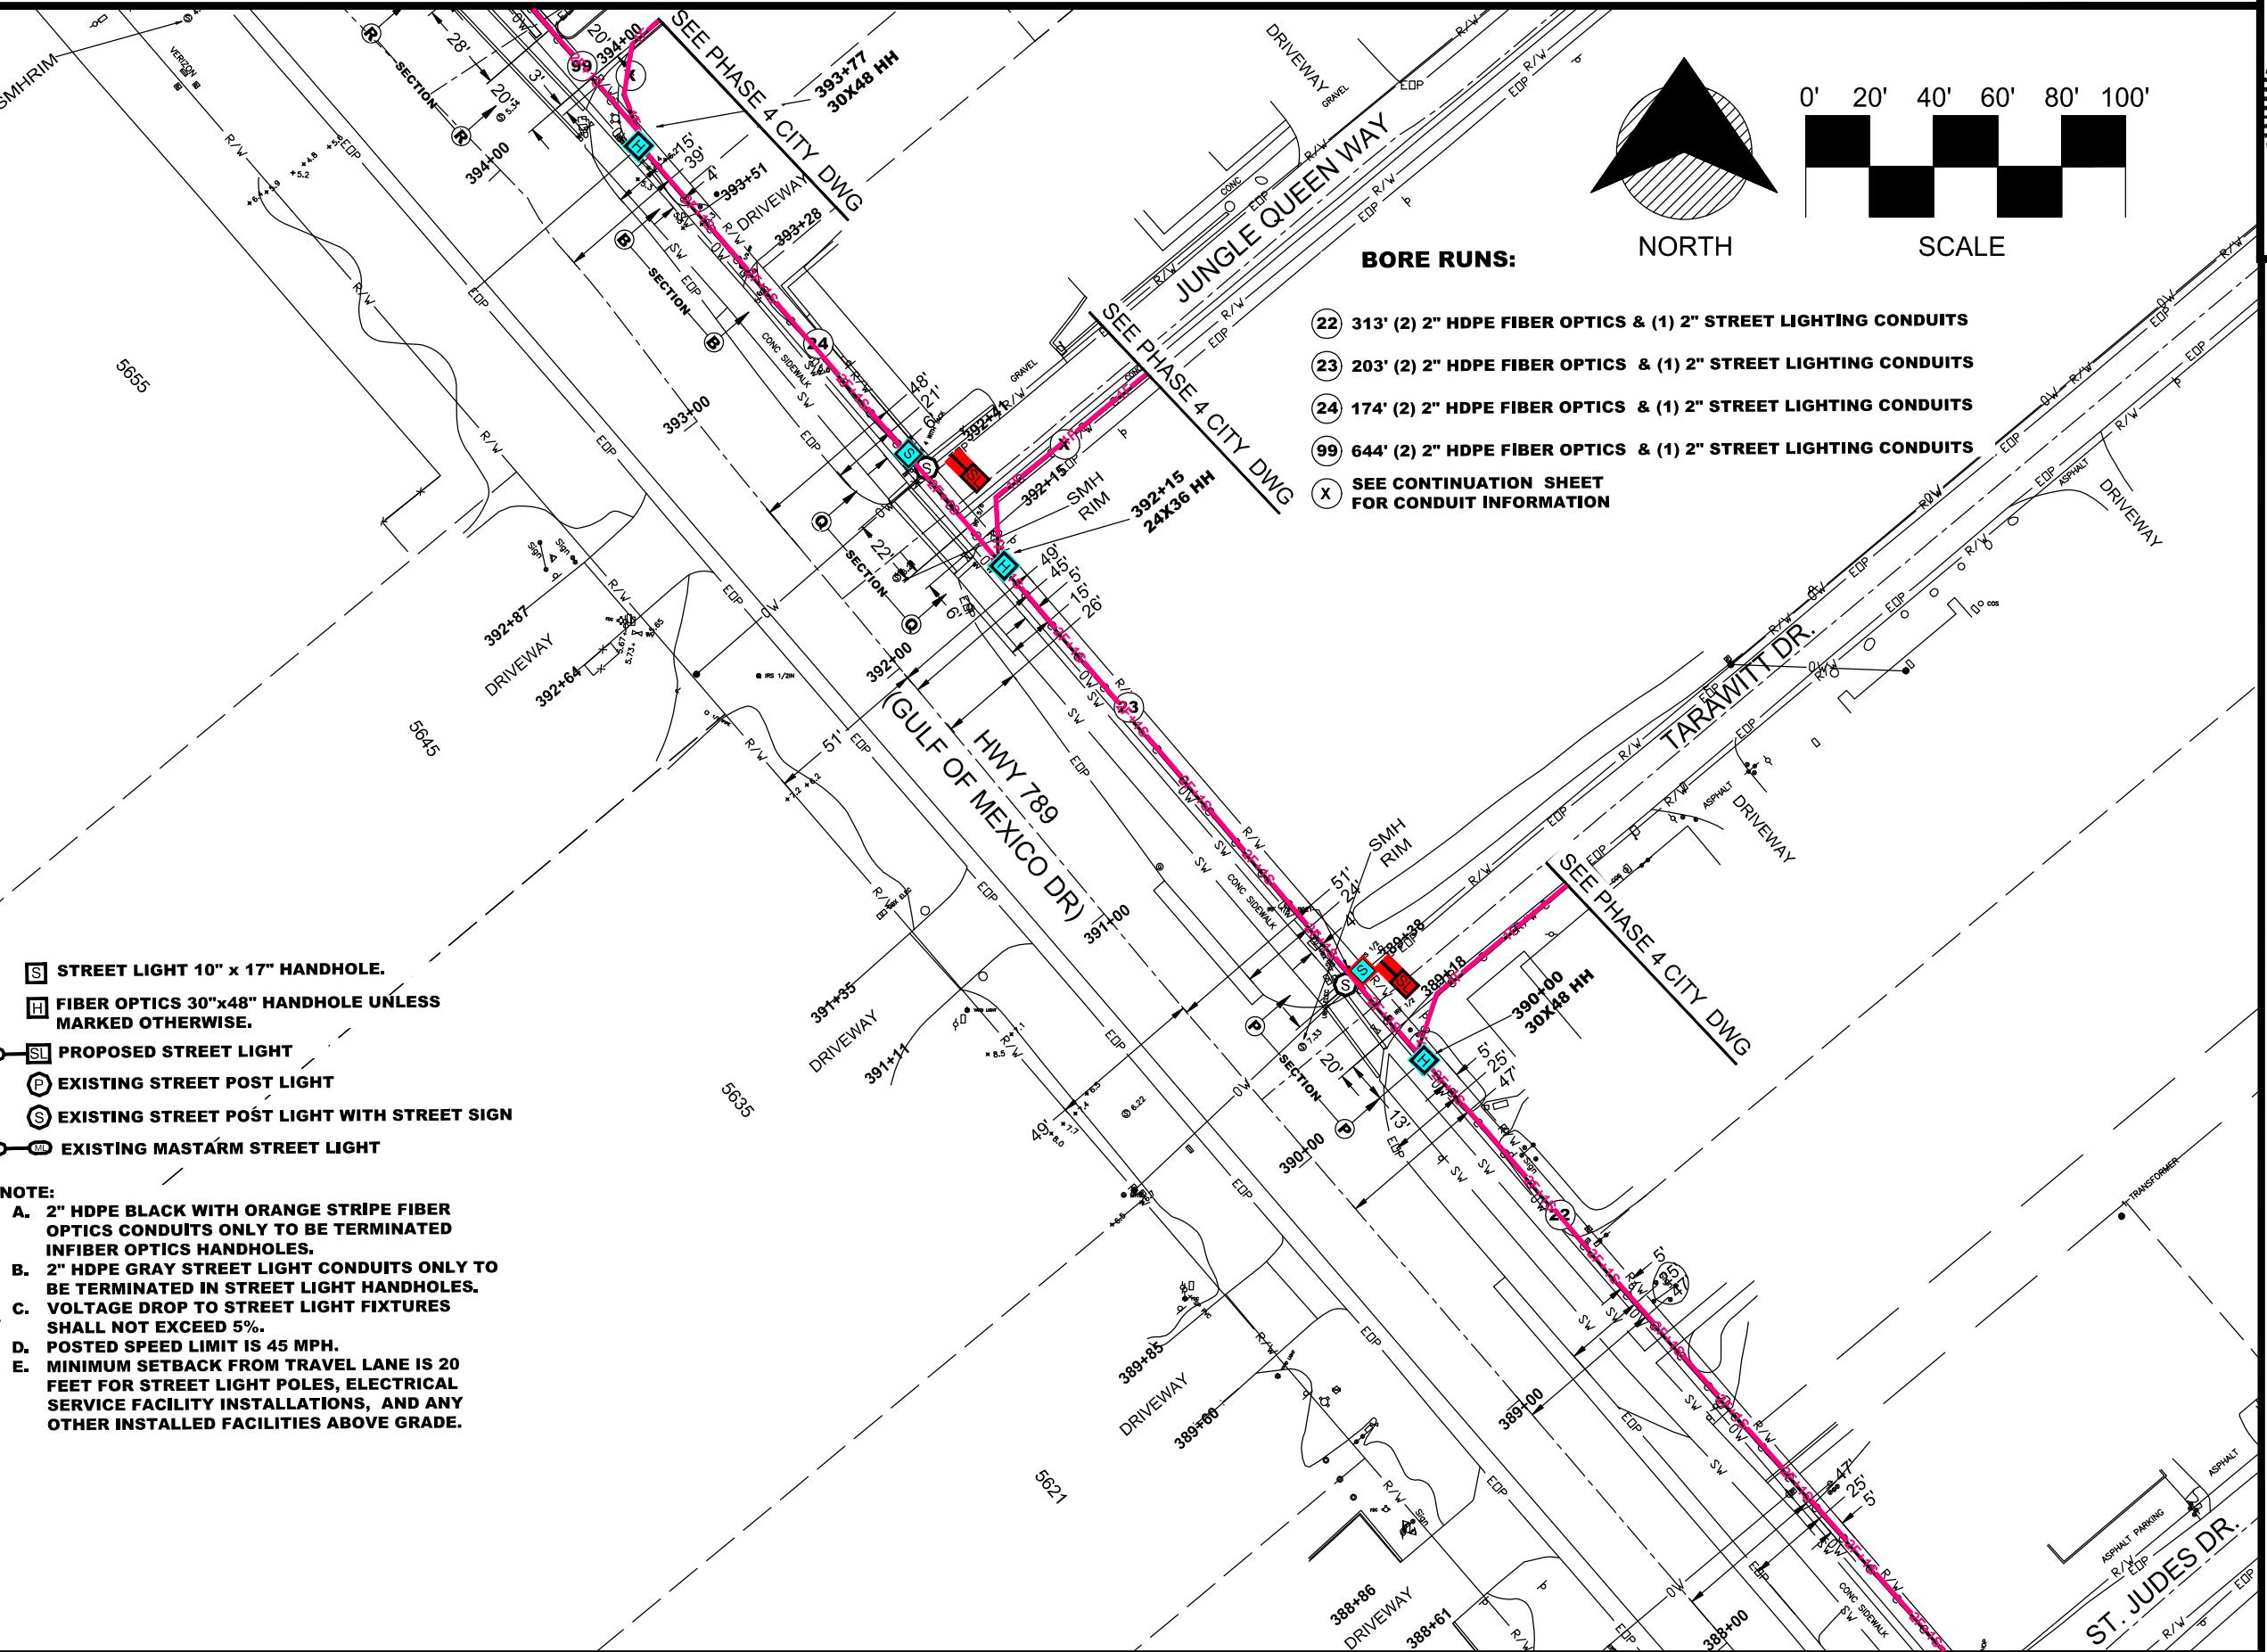

Town of Longboat Key

DRAWINGS FOR:
FIBER OPTIC AND STREET
LIGHTING UTILITY
CONSTRUCTION
LONGBOAT KEY, FLORIDA





Date: 12/01/2019
Scale: AS NOTED
Drawn: DPB
Checked: DPB
Job # 2014-LBK

Sheet
18 OF 22


Digitally signed by
Danny P. Brannon
Date: 2021-09-11
16:25:18-04'00'

Danny P. Brannon, P.E.
FLORIDA E. NO. 25601
DATE

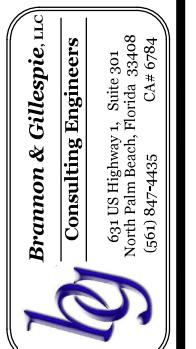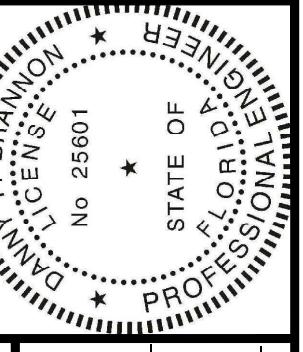

Brannon & Gillespie, Inc.
Consulting Engineers

634 US Highway 1, Suite 301
North Palm Beach, Florida 33408
(561) 847-7435
C.A. # 6784

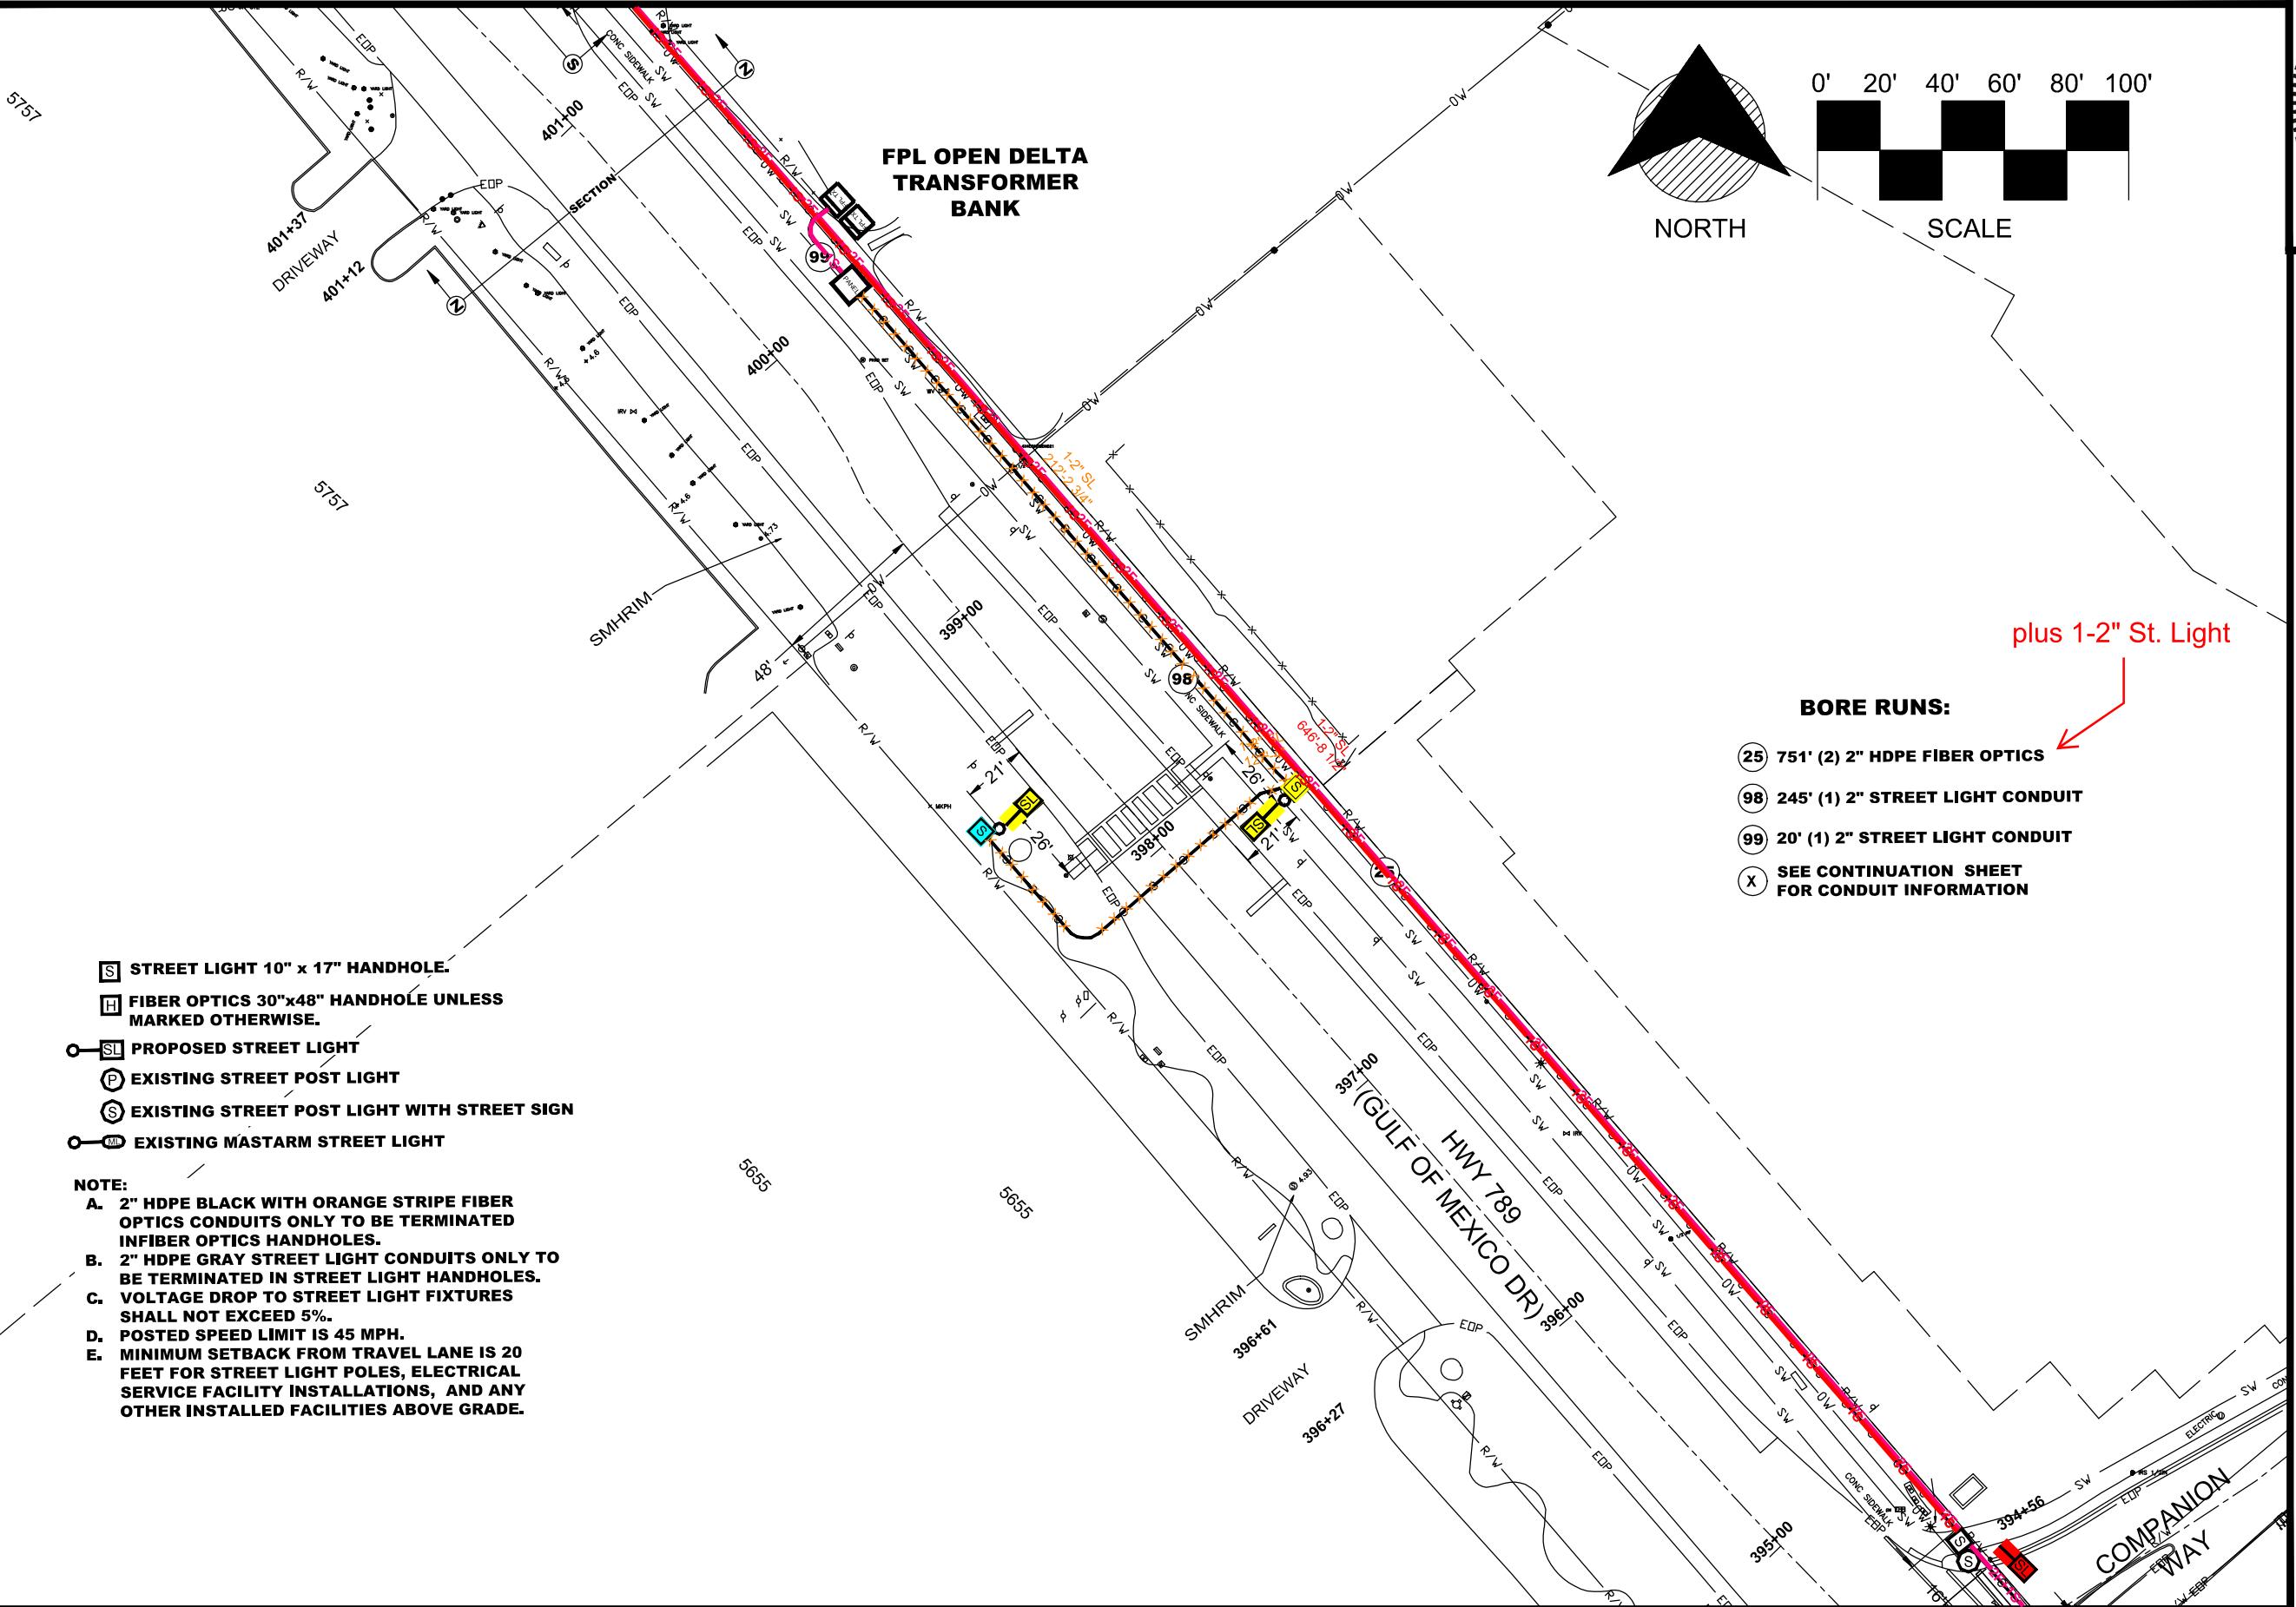


Town of Longboat Key


DRAWINGS FOR:
FIBER OPTIC AND STREET
LIGHTING UTILITY
CONSTRUCTION
LONGBOAT KEY, FLORIDA





Date: 12/01/2019
Scale: AS NOTED
Drawn: DPB
Checked: DPB
Job # 2014-LBK
Sheet

Digitally signed by
Danny P. Brannon
Date: 2021.09.11
16:25:18 -04'00'
DANNY P. BRANNON, P.E.
FLORIDA P. E. NO. 25601
DATE

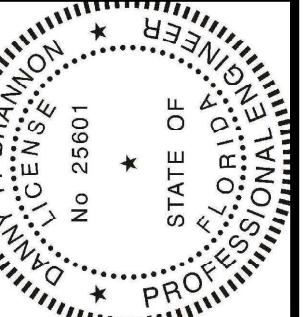

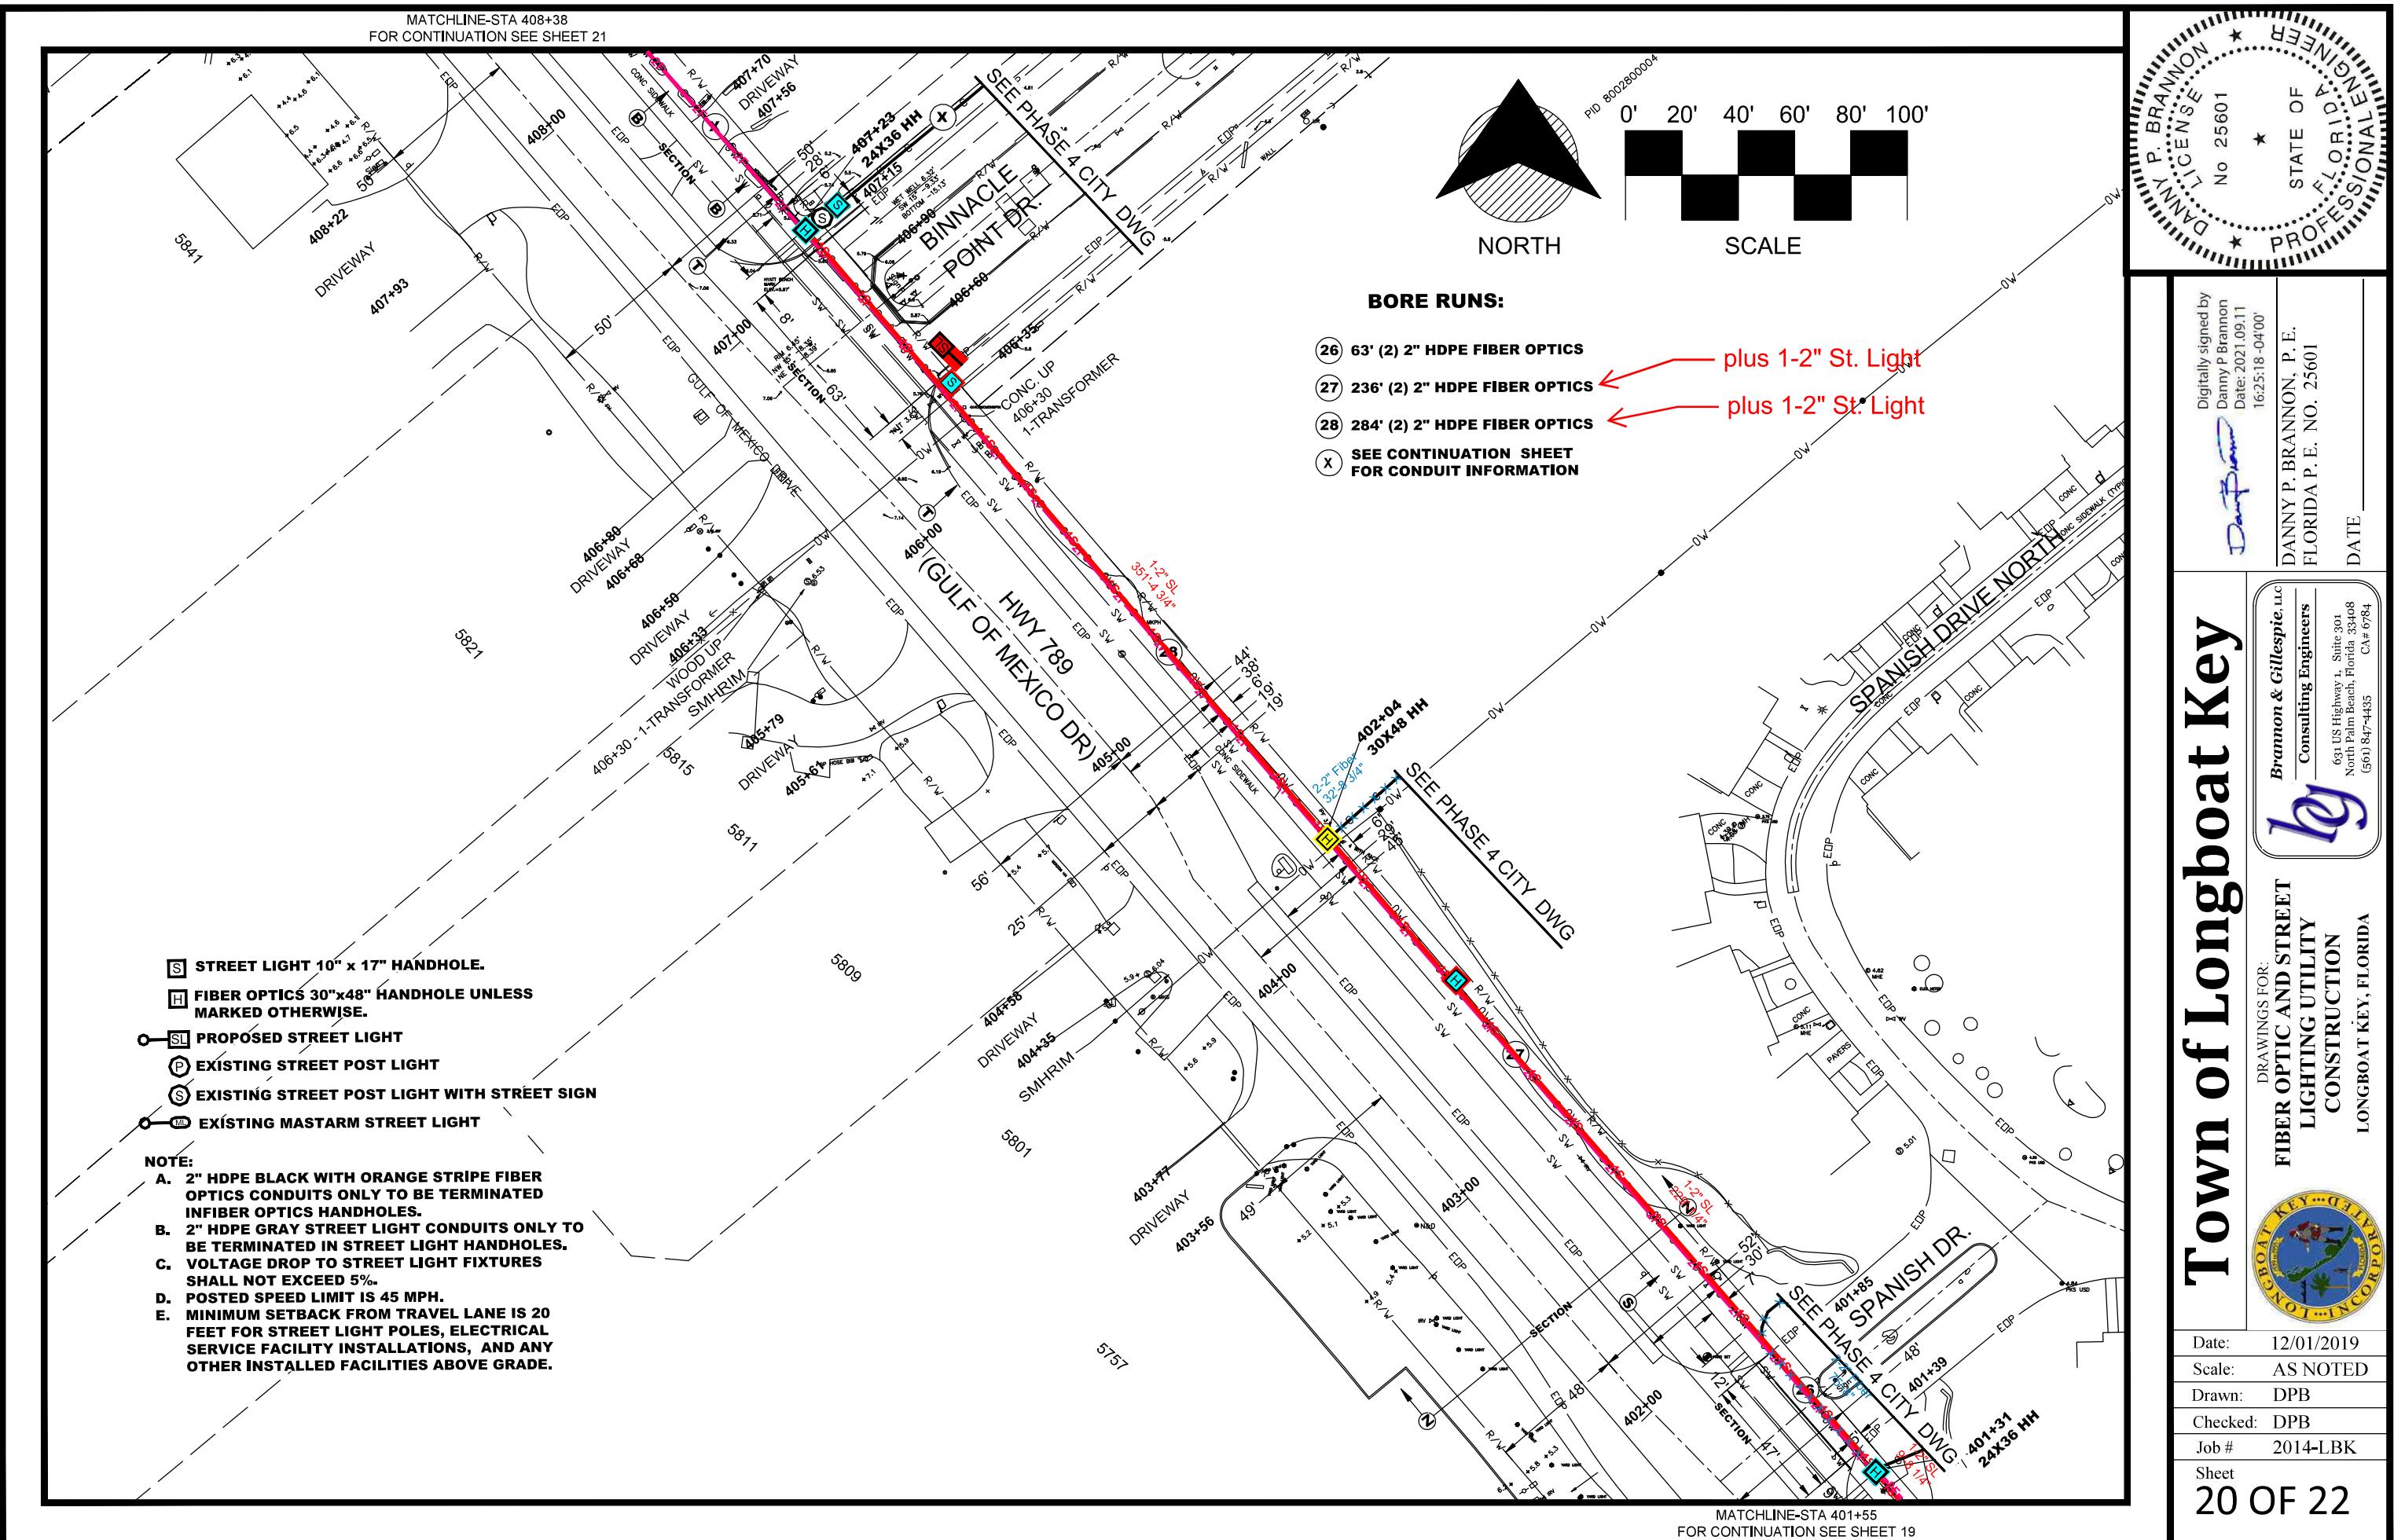

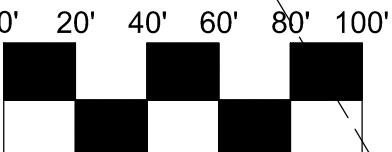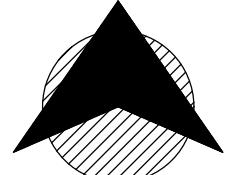

NORTH

SCALE

29 1111' (2" HDPE FIBER OPTICS
X SEE CONTINUATION SHEET
FOR CONDUIT INFORMATION

[S] STREET LIGHT 10" x 17" HANDHOLE.
[H] FIBER OPTICS 30"x48" HANDHOLE UNLESS
MARKED OTHERWISE.
[S] PROPOSED STREET LIGHT
[P] EXISTING STREET POST LIGHT
[S] EXISTING STREET POST LIGHT WITH STREET SIGN
[M] EXISTING MASTARM STREET LIGHT

NOTE:
A. 2" HDPE BLACK WITH ORANGE STRIPE FIBER
OPTICS CONDUITS ONLY TO BE TERMINATED
IN FIBER OPTICS HANDHOLES.
B. 2" HDPE GRAY STREET LIGHT CONDUITS ONLY TO
BE TERMINATED IN STREET LIGHT HANDHOLES.
C. VOLTAGE DROP TO STREET LIGHT FIXTURES
SHALL NOT EXCEED 5%.
D. POSTED SPEED LIMIT IS 45 MPH.
E. MINIMUM SETBACK FROM TRAVEL LANE IS 20
FEET FOR STREET LIGHT POLES, ELECTRICAL
SERVICE FACILITY INSTALLATIONS, AND ANY
OTHER INSTALLED FACILITIES ABOVE GRADE.

Town of Longboat Key


DRAWINGS FOR:
FIBER OPTIC AND STREET
LIGHTING UTILITY
CONSTRUCTION
LONGBOAT KEY, FLORIDA




Date: 12/01/2019
Scale: AS NOTED
Drawn: DPB
Checked: DPB
Job # 2014-LBK
Sheet


21 OF 22

Digital signature by
Danny P. Brannon
Date: 2021-09-11
16:25:18-04'00'

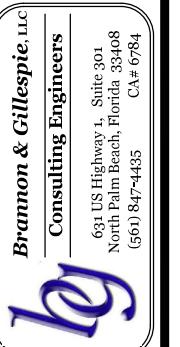


Brannon & Gillespie, Inc.
Consulting Engineers
634 US Highway 1, Suite 301
North Palm Beach, Florida 33408
(561) 847-7435
C.A. # 6784

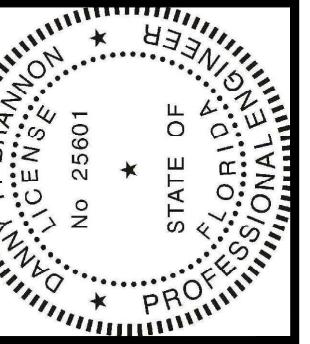

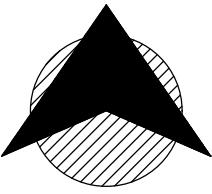

NORTH

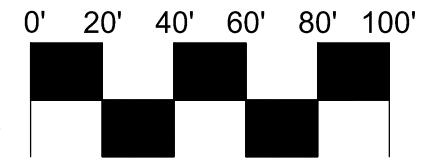

SCALE


BORE RUNS:

**X SEE CONTINUATION SHEET
FOR CONDUIT INFORMATION**


- [S] STREET LIGHT 10" x 17" HANDHOLE.**
- [H] FIBER OPTICS 30"x48" HANDHOLE UNLESS
MARKED OTHERWISE.**
- [SL] PROPOSED STREET LIGHT**
- [P] EXISTING STREET POST LIGHT**
- [S] EXISTING STREET POST LIGHT WITH STREET SIGN**
- [ML] EXISTING MASTARM STREET LIGHT**

NOTE

- A. 2" HDPE BLACK WITH ORANGE STRIPE FIBER OPTICS CONDUITS ONLY TO BE TERMINATED IN FIBER OPTICS HANDHOLES.**
- B. 2" HDPE GRAY STREET LIGHT CONDUITS ONLY TO BE TERMINATED IN STREET LIGHT HANDHOLES.**
- C. VOLTAGE DROP TO STREET LIGHT FIXTURES SHALL NOT EXCEED 5%.**
- D. POSTED SPEED LIMIT IS 45 MPH.**
- E. MINIMUM SETBACK FROM TRAVEL LANE IS 20 FEET FOR STREET LIGHT POLES, ELECTRICAL SERVICE FACILITY INSTALLATIONS, AND ANY OTHER INSTALLED FACILITIES ABOVE GRADE.**

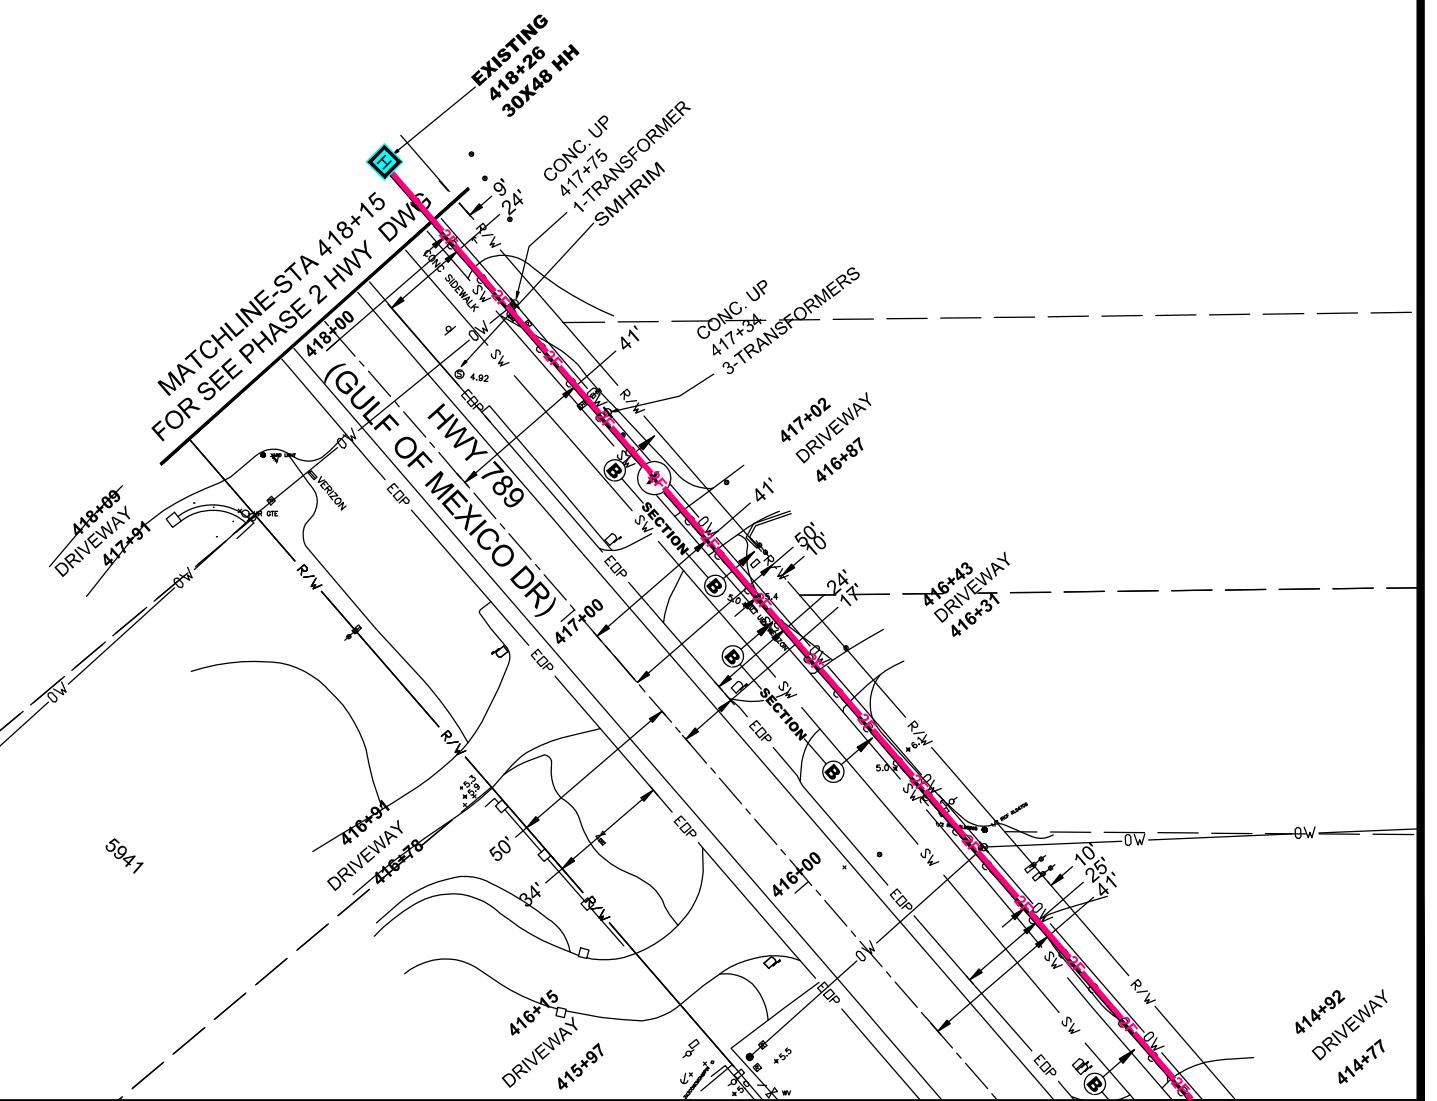

MATCHLINE-STA 415+18
FOR CONTINUATION SEE SHEET 21

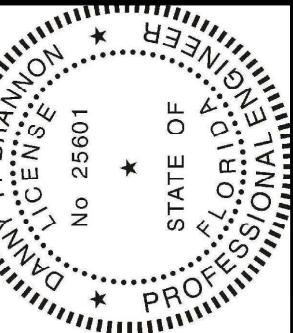

 DANNY P. BRANNON, P. E.
FLORIDA P. E. NO. 25601
Date: 2021.09.11
16:25:18 -0400

FLON
DATE

Town of Longboat Key

DRAWINGS FOR:
**FIBER OPTIC AND STREET
LIGHTING UTILITY
CONSTRUCTION**
1. LONGBOAT KEY, FLORIDA



Date: 12/01/2019
Sale: AS NOTED
Owner: DPB
Checked: DPB
Job #: 2014-LBK

Sheet
22 OF 22