

TOWN OF LONGBOAT KEY FIRE RESCUE STATION 91

5490 GULF OF MEXICO DRIVE LONGBOAT KEY, FLORIDA 34228





TOWN OF LONGBOAT KEY PUBLIC WORKS 600 GENERAL HARRIS STREET LONGBOAT KEY, FLORIDA 34228

CONTACT: CHARLES MOPPS TOWN PROJECTS MANAGER 941.316.1988 EXT. 2226 PHONE

ARCHITECT

SWEET SPARKMAN ARCHITECTS 2168 MAIN STREET SARASOTA, FLORIDA 34237

CONTACT: JENNA KISER, AIA PROJECT MANAGER 941.952.0084 PHONE

941.952.0201 FAX

CIVIL ENGINEER

GEORGE F. YOUNG, INC. 10540 PORTAL CROSSING, SUITE 105 BRADENTON, FLORIDA 34211

CONTACT: MICHAEL E. RISSMAN, JR., P.E. PSM SENIOR PROJECT MANAGER 941.747.2981 PHONE

TABLE OF CONTENTS

- A0.0 COVER
- A0.1 CODE ANALYSIS, NOTES & LEGENDS, PRODUCT APPROVAL A0.2 ARCHITECTURAL SITE PLAN

ARCHITECTURAL

- AD2.1 FIRST FLOOR DEMO PLAN AD3.1 FIRST FLOOR DEMO RCP
- A1.0 LIFE SAFETY PLAN, LEGENDS & SITE DETAILS
- A2.1 FIRST FLOOR PLANS & LEGENDS A3.1 REFLECTED CEILING PLAN & DETAILS
- A4.1 SCHEDULES, LEGENDS & DETAILS
- A7.1 ENLARGED PLANS AND INTERIOR ELEVATIONS
- A7.2 CASEWORK DETAILS

STRUCTURAL

- S-1 STRUCTURAL NOTES
- S-2 TYPICAL DETAILS S-3 FOUNDATION PLAN
- S-5 SECTIONS

STRUCTURAL ENGINEER

SNELL ENGINEERING CONSULTANTS, INC. 1517 STATE STREET, SUITE 202 SARASOTA, FLORIDA 34236

CONTACT: CORD VAN NOSTRAND, P.E. SI DIRECTOR OF ENGINEERING 941.954.0681 PHONE

MEP ENGINEER

QUEST DESIGN GROUP, INC. 1859 NORTHGATE BOULEVARD, SUITE 1 SARASOTA, FLORIDA 34234

CONTACT: CHRISTOPHER BAKER, P.E. VICE PRESIDENT OF ENGINEERING

941.351.9996 PHONE

SWEET ¦ SPARKMAN ARCHITECTS

MECHANICAL

M1.0 MECHANICAL DEMOLITION PLAN

- M1.1 MECHANICAL PLAN
- M2.0 MECHANICAL NOTES, DETAILS, AND SCHEDULES

ELECTRICAL

- E1.0 ELECTRICAL LIGHTING DEMOLITION PLAN
- E1.1 ELECTRICAL POWER DEMOLITION PLAN E1.2 ELECTRICAL LIGHTING PLAN
- E1.3 ELECTRICAL POWER PLAN
- E2.0 ELECTRICAL NOTES AND LEGEND
- E2.1 ELECTRICAL DETAILS AND SCHEDULES E2.2 ELECTRICAL RISER AND CALCULATIONS
- E2.3 ELECTRICAL PANELBOARD SCHEDULES
- E2.4 FIRE ALARM NOTES, DETAILS AND RISER

<u>PLUMBING</u>

- P1.0 EX PLUMBING PLAN
- P1.1 PLUMBING PLAN P1.2 PLUMBING NOTES AND DETAILS

FIRE PROTECTION

FP1.0 FIRE PROTECTION PLAN - DEMO FP1.1 FIRE PROTECTION PLAN



NOTE: THE SCALE OF THESE PLANS MAY HAVE CHANGED DUE TO REPRODUCTION

Ζ O Ś Ш О \bigcirc S ШК FIRE Ш \mathbf{X} 4 Ο GB Ž O Ο NMO.

0

Ο \sim \mathbf{N} S \mathbf{O} S Ш RM \bigcirc Ζ \mathcal{O} S ∞

 $\overline{}$

BUILDING CODE: MECHANICAL CODE: ENERGY CONSERVATIC ELECTRICAL CODE: PLUMBING CODE: FUEL GAS CODE: ACCESSIBILITY CODE: FIRE SAFETY CODE: OTHER:	FBC, M FBC, EI FBC - C FBC, PI FBC, FI 2017 FL	ECHANICA NERGY CC HAPTER 2 LUMBING 2 JEL GAS 2 LORIDA AC	L 2017 NSER' 7; NFP 017 W 017 WI CESSI	WITH APPL VATION 201 A 70 (N.E.C ITH APPLIC TH APPLIC BILITY COD	7 WITH APPLICA LICABLE AMEND 7 WITH APPLICA .) WITH APPLICA ABLE AMENDME ABLE AMENDME E FOR BUILDING , 6TH EDITION W	MENTS BLE AMENDA BLE AMENDA NTS S CONSTRUC	MENTS MENTS TION	ENTS			
BUILDING CAT	EGORIZ	ATION	& Pł	HYSICA	L PROPER	RTIES				_	
				FLORID	A BUILDING CO	DE	FLORID	A FIRE PREV CODE	ENTION	_	
OCCUPANCY CLASSIFIC	CATION			CHAPTE	R 3, SECTION 30)2		CHAPTER 6		_	
				BUSINESS C	IGE FROM EXIST GROUP B, RESID & STORAGE GRO	ENTIAL					
EXISTING BUILDING AL	TERATIONS			LEVEL	2 ALTERATIONS	6					
					CHAPTER 6		Т	ABLE A8.2.1.	2		
CONSTRUCTION TYPE					TYPE II B						
WIND LOADS (FBC CHA	PTER 16)		FBG	C CHAPTER	16	ATEGORY					
* SEE STRUCTURAL DRA	WINGS.			165 MPH *	TABL	E 1604.5 V *		N/A			
BUILDING PHYSICAL PR	OPERTIES				ABLES: 504.3, 504)1, PER OCCI (CHAPTERS		PRO	VIDED
MAXIMUM HEIGHT IN FEI	ET				[55] FEET					[30] F	EET ±
MAXIMUM NUMBER OF S	TORIES				STORIES		-			ORIES	
ALLOWABLE BUILDING A	REA		48,000 SQ FT PER FLOOR		N/A			33 SF L BLDG)			
SPRINKLER SYSTEM			YES		YES		Y	ES			
EXITING REQU		TS		FLORI	DA BUILDING CO	DDE		RE PREVENT		PRO	VIDED
COMMON PATH OF TRAVE		Т) FEET [1006.2.1]			ET [ANNEX A			FEET
MAXIMUM DEAD END CORRIDOR MAXIMUM TRAVEL DISTANCE TO EXIT		50 FEET [1020.4] 250 FEET [1017.2]				ET [ANNEX A ET [ANNEX A	-		FEET		
MINIMUM CORRIDOR WID		-	44 INCHES [1020.2]		36	INCHES [7.3	4]	>	36"		
MINIMUM CLEAR OPNG O MINIMUM STAIR WIDTH		S	32 INCHES [1010] 44 INCHES [1011]		32 INCHES [7.2.1.2.3.2] >36 INCHES			32" 8"			
OCCUPANCY LO		EGRE	SS						IOST STRING		
					ABLE 1004.1.1 - TABLE 7.3.1.2	NC	ON-STAIR EGF	RESS	S	TAIR EGRES	SS
OCCUPANCY		AREA (SF)	AR OC	EA PER CUPANT (SF)	OCC. LOAD	EGRESS WIDTH PEF PERSON	REQ'D	EGRESS WIDTH PROVIDED	EGRESS WIDTH PER	REQ'D EGRESS	EGRESS WIDTH PROVIDED
BUSINESS (B)		4,372		GROSS	44	.2"	8.8"	36" MIN	.3"	N/A	N/A
RESIDENTIAL (R-2)		2,603	200	GROSS	14	.2"	2.8"	36" MIN	.3"	N/A	N/A
STORAGE (S-2)		3,208	200	GROSS	17	.2"	3.4"	36" MIN	.3"	N/A	N/A
		9,183			75						
IUTALS		LCULA	τιοι	N							
		RATIO P		WC REQUIREE	WC PROVIDED	LAV REQUIRED	lav Provided	UNISEX TOILET RM	SHOWERS	DRINKING FOUNTAIN	REMARKS
	OCC. LOAD	TABLE 4				1/1	1/1				
PLUMBING FIXT		1/25 FIRS		1/1	1/1	1/ 1					
TOTALS PLUMBING FIXT FIXTURE COUNT OCCUPANCY GROUP [B] OCCUPANCY GROUP [R-2]	LOAD 22 MALE 22 FEMALE	1/25 FIRS	ER 50	1/1 2	2	2	2		2 REQUIRED		
PLUMBING FIXT FIXTURE COUNT OCCUPANCY GROUP [B]	LOAD 22 MALE 22 FEMALE 7 MALE 7 FEMALE	1/25 FIRS 1/50 AFTE	ER 50				2				

FIRE EXTINGUI

FIRE EXTINGUISHER COM

MAXIMUM FLOOR AREA P MAXIMUM FLOOR AREA P MAXIMUM TRAVEL DISTAN


REMARKS: 1. FIRE EXTINGUIS

GEN	ERAL NO
1.	THE INTENT
	DETAILS RE
	OF THESE D
	FROM THIS
2.	THE INTENT
	DEVIATION
3.	THE BUILDI
	AND SPECIE
	ARCHITECT
4.	THE CONTR
	CONDITION
	BIDDING TH
_	THE CONTR
5.	THE CONTR
•	APPLICABLE
6.	CONTRACT
	AND/OR AC
7	CONSTRUC
7.	WHERE AS-
8.	INDICATE F
0.	SIDES OF W
9.	THE CONTR
5.	WATER AND
	SHOULD BE
10.	MINIMUM TH
10.	

DIMENSION NOT DO NOT SCALE [1.


	TRADES. IF NO D
	OR COMMENCING
2.	DIMENSIONS TO
3.	DIMENSIONS LOC
4.	DIMENSIONS LOC
	THE CLEAR DIME
5.	OPENINGS NOT L
6.	CENTER ANY INT
7.	IF THE LOCATION
	THE ARCHITECT

CODE ANALYSIS N.T.S

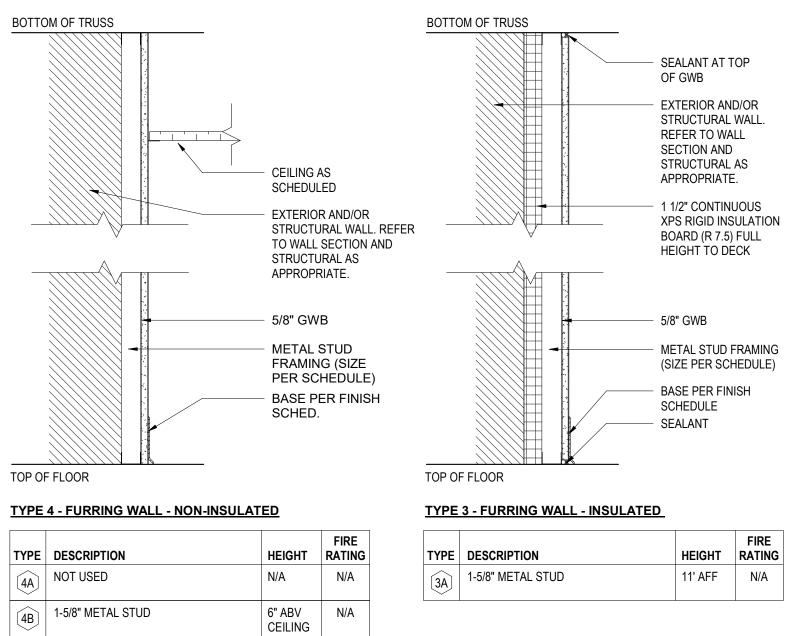

DESCRIPTION	HEIGHT	FIRE RATING
NOT USED	N/A	N/A
1-5/8" METAL STUD	6" ABV CEILING	N/A

UISHER REQUIREMEN	ITS			ABBRE	VIATIONS
OMPONENT	FLORIDA BUILDING CODE	NFPA 10, TABLE 5.2.1 PER HAZARD OCCUPANCY	PROVIDED	ABV AC, A/C	ABOVE AIR CONDITIONING
A PER UNIT OF A			REMARK 1	ACT AF	ACOUSTIC CEILING TILE ACCESS FLOORING
A PER EXTINGUISHER	11,250 SQ FT	11,250 SQ FT		AFF ALUM	ABOVE FINISHED FLOOR ALUMINUM
TANCE	75 FEET	75 FEET	<75 FEET	BCE	BOTTOM CHORD EXTENSION
UISHERS ARE ALL EXISTING TO RE	MAIN.			BD BIT BOD BOF BOS BS BSE	BOARD BITUMINOUS BOTTOM OF DECK BOTTOM OF FOOTING BOTTOM OF STEEL BOTH SIDES BRICK SHELF ELEVATION
				CB CEM BD C-FCI CFM CIP CJ CLR CMU COL CONC CONC CONT CPT CT CU CU	COVE BASE CEMENTITIOUS BACKER BOARD CONTRACTOR FURNISH, CONTRAC CUBIC FEET PER MINUTE CAST-IN-PLACE CONTROL JOINT; CONSTRUCTION CLEAR CONCRETE MASONRY UNIT COLUMN CONCRETE CONTINUOUS CARPET CERAMIC TILE AIR CONDITIONING CONDENSER U CABINET UNIT HEATER
ELATING TO THIS INTENT AND BY B DETAILS. SHOULD THE CONTRACTO GENERAL INTENT SHOULD BE BRO OF THE DRAWINGS AND SPECIFIC FROM THIS GENERAL INTENT SHO NG SHALL BE CONSTRUCTED IN FL FICATIONS. ANY CODE DEFICIENCI FOR CLARIFICATION. CACTOR SHALL BE RESPONSIBLE F	CATIONS IS TO PROVIDE FOR A WATERTIGHT & IDDING OR ENTERING INTO THIS CONSTRUCTIO OR TAKE EXCEPTION TO THESE DETAILS, HE SH DUGHT TO THE ATTENTION OF THE ARCHITECT CATIONS IS TO PROVIDE FOR A PLUMB, LEVEL, A ULD BE BROUGHT TO THE ATTENTION OF THE A JLL COMPLIANCE WITH ALL APPLICABLE CODES ES IN THE DRAWINGS RECOGNIZED BY THE COI OR THE ACCURATE PLACEMENT OF THE BUILDI WINGS AND ACTUAL SITE CONDITIONS SHALL B	IN CONTRACT WARRANTS FOR ONE FULL IALL NOTIFY THE ARCHITECT PRIOR TO BI FOR CLARIFICATION. AND SQUARE STRUCTURE UNLESS OTHER ARCHITECT FOR CLARIFICATION. , ORDINANCES AND REGULATIONS AS WE NTRACTOR SHOULD BE BROUGHT TO THE NG ON THE SITE AND VERIFY ALL DIMENS	YEAR THE ADEQUACY DDING. ANY DEVIATION WISE NOTED. ANY LL AS THE DRAWINGS ATTENTION OF THE IONS AND EXISTING	DF DW EF EJ ELEC EP ESS EW EWC EXIST EXP	DRINKING FOUNTAIN DISHWASHER EXHAUST FAN; EACH FACE EXPANSION JOINT ELECTRICAL EPOXY PAINT EXTERIOR SOFFIT SYSTEM EACH WAY ELECTRIC WATER COOLER EXISTING EXPOSED
IE PROJECT OR THE COMMENCEM RACTOR TO FAMILIARIZE HIMSELF N RACTOR SHALL PROVIDE ALL PERM E CODES AND GOVERNING REGUL/ OR TO FURNISH AND INSTALL CON CESSORIES. WOOD BLOCKING SHA TION. BUILT DRAWINGS ARE REQUIRED A INAL LOCATIONS OF SLEEVES AND OR SHALL PROTECT PIPES WITHIN (ALL. RACTOR SHALL VERIFY THE SIZES A	ENT OF WORK. THE OWNER SHALL NOT BE RES WITH EXISTING CONDITIONS. IITS AND INSPECTIONS NECESSARY FOR THE PI	PONSIBLE FOR CHANGES TO THE WORK I ROPER EXECUTION OF THE WORK IN ACC S REQUIRED TO FIRMLY SECURE WALL-MC BUILDING SECTION 603 FOR COMBUSTIBL PENETRATE MASONRY OR RATED WALLS, RECORD. NER PROTECTION (FROM POTENTIAL PUN CTRICAL EQUIPMENT PADS AND BASES, AS	DUE TO THE FAILURE OF ORDANCE WITH DUNTED EQUIPMENT LE MATERIAL IN TYPE II CONTRACTOR SHALL CTURE) FROM FINISHED S WELL AS POWER,	FAAP FACP FBO FCO FD FEC FF FIN FRP FS FV	FIRE ALARM ANNUCIATOR PANEL FIRE ALARM CONTROL PANEL FURNISHED BY OTHERS FLOOR CLEAN-OUT FLOOR DRAIN FIRE EXTINGUISHER CABINET FINISHED FLOOR; FAR FACE FINISH FIBERGLASS REINFORCED PLASTIC FAR SIDE FIELD VERIFY
BROUGHT TO THE ATTENTION OF	THE ARCHITECT FOR CLARIFICATION. S SHALL BE PROVIDED UNLESS SPECIFIED THIC			GB GC GDT GV GWB	GRAB BAR GENERAL CONTRACTOR GYPSUM DROP-IN TILE GRAVITY VENT GYPSUM WALL BOARD
D DIMENSIONS ARE GIVEN OR DISC CING THE WORK. TO EXTERIOR MASONRY WALLS AF LOCATING NEW INTERIOR MASONF LOCATING NEW INTERIOR STUD W. IMENSION THAT IS TO BE PROVIDE DT LOCATED BY DIMENSION IN INTE INTERIOR OPENINGS (NOT LOCATE	ISIONS SHALL HAVE PREFERENCE OVER SCALE CREPANCIES FOUND, THE CONTRACTOR SHALL RE TO EXTERIOR FACE OF MASONRY, TYPICAL. RY WALLS ARE TO FACE OF MASONRY, TYPICAL ALLS ARE TO FACE OF STUD, TYPICAL. WHEN A ID AFTER INSTALLATION OF ALL WALL FINISH M/ ERIOR WALLS, AND NOT ABUTTING ADJACENT V ED BY DIMENSION), THAT APPEAR TO BE CENTE NOT OBVIOUS OR CANNOT BE DETERMINED BY IENT.	NOTIFY THE ARCHITECT FOR CLARIFICAT DIMENSION IS INDICATED AS "CLEAR" OR ATERIALS. VALLS ARE TO BE CENTERED ON THE WAL RED IN A WALL.	ION BEFORE BIDDING "CLR", THIS INDICATES L.	H HC HOR HM HR HRU HT H&V HVAC IB IF IJ	HORIZONTAL; HIGH HANDICAPPED HORIZONTAL HOLLOW METAL HOUR HEAT RECOVERY UNIT HEIGHT HEATING AND VENTILATING HEATING, VENTILATING AND AIR CONDITIONING INTEGRAL BASE INSIDE FACE ISOLATION JOINT
				IMP INV L LAM LLH LLV LP STANDAR N.T.S	IMPACT RESISTANT INVERT LONG LAMINATED LONG LEG HORIZONTAL LONG LEG VERTICAL LIGHTING PANEL; LIQUEFIED PROP

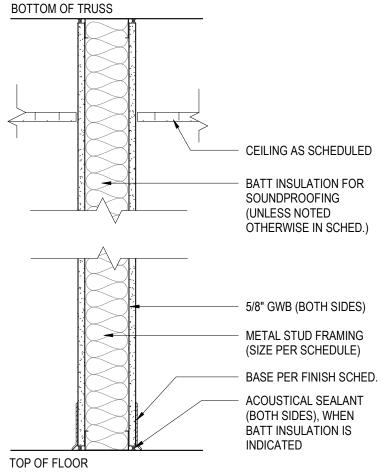

TYPE 1 - STUD PARTITION WALL

TYPE	DESCRIPTION	HEIGHT	FIRE RATIN
1A	3-5/8" METAL STUD	11' AFF	N/A
(1B)	3-5/8" METAL STUD, NO BATT INSULATION	11' AFF	N/A
(1D)	6" METAL STUD	11' AFF	N/A

PARTITION TYPE NOTES

- PARTITION TYPES ARE TAGGED ON THE FLOOR PLANS.
- REFER TO WALL SECTIONS FOR EXTERIOR WALL ASSEMBLIES.
- REFER TO "GYPSUM BOARD ASSEMBLIES" SPECIFICATION FOR FULL REQUIREMENTS FOR GYPSUM BOARD ASSEMBLIES AND NON-LOAD-BEARING STEEL FRAMING MEMBERS FOR GYPSUM BOARD ASSEMBLIES.
- ALL STUDS AND FURRING CHANNELS ARE TO BE SPACED 16" O.C., UNLESS NOTED OTHERWISE. ALL PARTITIONS SHALL EXTEND FROM FLOOR SLAB OR DECK TO THE UNDERSIDE OF THE STRUCTURAL DECK TO ACHIEVE COMPLETE
- CLOSURE, UNLESS NOTED OTHERWISE. PARTITION TYPES DESCRIBE THE PRIMARY WALL MEMBER AND SHEATHING. REFER TO FINISH SCHEDULE FOR ALL PARTITION FINISH
- 6. DESIGNATIONS. PROVIDE TYPE "M-R" MOISTURE RESISTANT GYPSUM BACKING BOARD IN ALL WET AREAS, INCLUDING TOILET, LOCKER AND SHOWER 7.
- ROOMS. PROVIDE 1/2" CEMENT BOARD WITH WATER-RESISTANT COATING AS A SUBSTRATE FOR WALL AREAS SCHEDULED TO RECEIVE TILE. 8. CONSTRUCTION OF FIRE RATED PARTITIONS, INCLUDING TAPING AND FINISHING OF GYPSUM BOARD, SHALL BE IN ACCORDANCE WITH U.L. 9.
- SYSTEM ASSEMBLY OR OTHER APPROVED ASSEMBLY TO ACHIEVE THE RATING INDICATED. PROVIDE FIRESTOPPING PER FIRESTOPPING MANUFACTURER'S RECOMMENDATIONS FOR PENETRATIONS THROUGH RATED WALLS. 10. PROVIDE SLIP JOINT CONNECTIONS AT THE TOPS OF ALL PARTITIONS WHICH INTERSECT THE STRUCTURE ABOVE, CAPABLE OF
- ACCOMMODATING UPWARD AND DOWNWARD VERTICAL DISPLACEMENT OF PRIMARY STRUCTURE THROUGH POSITIVE MECHANICAL ATTACHMENT TO STUD WEB. PROVIDE FIRE SAFING AT ALL SLIP JOINT CONNECTIONS IN FIRE RATED PARTITIONS. 11. PROVIDE GYPSUM BOARD CONTROL JOINTS WHERE DESIGNATED ON THE INTERIOR ELEVATIONS, AND ANYWHERE THERE IS A CONTINUOUS RUN OF GYPSUM BOARD THAT IS GREATER THAN 30 FEET IN LENGTH. CONFIRM THE LOCATION OF ADDITIONAL CONTROL
- JOINTS WITH THE ARCHITECT PRIOR TO INSTALLATION. 12. IN PARTITIONS WHERE BATT INSULATION FOR SOUNDPROOFING IS INDICATED, SEAL CONSTRUCTION AT PERIMETERS, BEHIND CONTROL AND EXPANSION JOINNTS, OPENINGS, AND PENETRATIONS WITH A CONTINUOUS BEAD OF ACOUSTICAL SEALANT, INCLUDING A BEAD AT
- BOTH FACES OF THE PARTITIONS. 13. AT METAL STUD WALLS, BLOCKING IS REQUIRED AT ALL WALL MOUNTED ITEMS INCLUDING, BUT NOT LIMITED TO, THE FOLLOWING LOCATIONS:
 - WALL MOUNTED COUNTERS AND COUNTERTOP SUPPORTS Α.
 - WALL MOUNTED ACCESSORIES AND EQUIPMENT WALL MOUNTED DOORSTOPS
 - WALL MOUNTED DOOR HOLD OPEN DEVICES AND/OR CLOSURES
 - TOILET ROOM PARTITIONS AND ACCESSORIES WALL MOUNTED TV / MONITORS AND BRACKETS


FIRE RESISTANCE RATING OF CONCRETE MASONRY WALLS

FIRE RESISTANCE RATING OF CONCRETE MASONRY WALLS
PER FBC BUILDING TABLE 722.3.2, THE FIRE RESISTANCE RATING OF WALLS AND PARTITIONS CONSTRUCTION OF CONCRETE MASONRY UNITS SHALL BE BASED ON THE EQUIVALENT THICKNESS OF THE MASONRY AND TYPE USED.
<u>CALCAREOUS OR SILICEOUS GRAVEL AGGREGATE</u> 1 HOUR RATING = 2.8" MINIMUM EQUIVALENT THICKNESS 2 HOUR RATING = 4.2" MINIMUM EQUIVALENT THICKNESS


	MDO	MEDIUM DENSITY OVERLAY	SYMBOL	<u>.</u> S	STREET FL 34237 FL 34237 2.0084 2.0201
	MDF	MEDIUM DENSITY FIBERBOARD		_	AIN ST TA, FL .952.0 .952.0
	MO	MASONRY OPENING		BUILDING SECTION	58 M / ASO ⁻ 941 941
	MTL	METAL	A		2 16 2 2 16 1 1
	NR	NONE REQUIRED	A	WALL SECTION	
	OC	ON CENTER			
	OF	OUTSIDE FACE			
	O-FOI	OWNER FURNISH, OWNER INSTALL			
				EXTERIOR ELEVATION	
PLAN PLANTER			A		S S
			A		
PHONE	PLF	POUND PER LINEAR FOOT			
PP	PP	POWER PANEL	C → B	INTERIOR ELEVATION	2
PP Model District Constraints P District Constraints P PP District Constraints District Constraints P District Constraints P District Constraints District Constraints District Constraints P P District Constraints District Constraints District Constraints District Constraints	PSF	POUNDS PER SQUARE FOOT	.		l is
MC MCLONER MCLANDOR PHO MCLANDOR MCLANDOR R BORRENDER MCLANDOR R MCLANDOR MCLANDOR R BORRENDER MCLANDOR R MCLANDOR MCLANDOR R			TILE		
ST SUBRY THE Image: Subscription of the subsc	PTD	PAPER TOWEL DISPENSER	1	DRAWING NOTE	
Provide P				WINDOW/LOUVER TAG	
BD BDC DYM BB BDC DYM BC SCH 123 SCH 124 SCH 123 SCH 125 SCH 123					
BEOD BEOL/RED CL WeLL N2 State State State State State State </td <td></td> <td></td> <td></td> <td></td> <td></td>					
Bit International International State Provided Pr	REQ'D	REQUIRED		WALL TAG	
Sol Hadd Dockstering Image: Sol Hadd Sol Hadd Sol Hadd Sol	RO	ROUGH OPENING			
BT SUBJECTOR MARK DEPORT FAM BIN BIN BIN BIN BIN BIN BIN BIN BIN BIN				SIGN TAG	
SN STANDARD SYMBOLS STANDARD SYMBOLS TO TO TO TO TO TO TO TO TO TO	SF	SQUARE FOOT; SUPPLY FAN			
STRE STREETLEM MARK LUBBY INTERPORT MARK STREETLEMENT MARK STREETLEMENT MARK STREETLEMENT MARK STREETLEMENT STREETLEMENT	SN	SANITARY NAPKIN (DISPENSER)		DOOR TAG	
T BE PERSON DE SAN DE				ROOM NAMF	
Trib					
TOB TOP CREAM CONTRALING CONTRALING CONTRALING CONTRALING CONTRALING CONTRALING TOP TOP CREAM CONTRALING CONTRALING UND UND CREAT CONTRALING CONTRALING UND UND CREAT CONTRALING CONTRALING CONTRALING VER VERT VERT CONTRALING	T&B	TOP AND BOTTOM			
TOG TOP OF CONNECTE TOG TOP OF ECONNO TOG TOP OF ECONNO TOG TOP OF FEEL TOG TOP OF FEEL TOG TOP OF FEEL TOG TOP OF STEEL TO TOG TOP OF OF STEEL TO TOG TOP OF OF STEEL TO TOG TOP OF STEEL TO TOD OF MALE TOLET ACCESSORY TAG UND UNDER LANGE OF STEEL TO W WORE WARKER W WITH WILL COURDING TO W WITH WILL COURSING TO </td <td>ТОВ</td> <td>TOP OF BEAM</td> <td>(A)</td> <td></td> <td></td>	ТОВ	TOP OF BEAM	(A)		
TOM TOP OF MARKING TOP OF ALL TOP OF REAL TOP TOP OF STELLEN OF OF SLAB X101 NUMBER DISTRIBUTION TOP TOP OF STELLEN OF OF SLAB X101 NUMBER DISTRIBUTION TOP TOP OF STELLEN OF OF SLAB SSUBARD ERF RUDOR TOP TOP OF STELLEN OF OF SLAB SSUBARD ERF RUDOR TOP TOP OF STELLEN OF OF SLAB SSUBARD ERF RUDOR TOP TOP OF STELLEN OF OF SLAB SSUBARD ERF RUDOR UND UND TABLES NOTE OF OFFICE TOP N SSUBARD ERF RUDOR VER WER VERTOR STANDARD SYMBOLS NOT NITHOUT NUMER PLACE WWF WEREPASSE PRODUCT APPROVAL / NOA ELORIDA PRODUCT APPROVAL / NOA STANDARD SYMBOLS NUM STANDARD SYMBOLS NITHOUT NUM STOREFRONT STANDARD SYMBOLS NUM STOREFRONT UNTAWN STANDARD SYMBOLS NUM STOREFRONT STANDARD SYMBOLS NUM STOREFRONT STANDARD SYMBOLS NUM STOREFRONT STANDARD SYMBOLS NUM STOREFRONT	TOC	TOP OF CONCRETE			
105 TOP OF STRILL TOP OF START AND INTERIOR 106 TOP OF WALL SEQUENCE THEFT.LOOR 107 TOPLAL SEQUENCE THEFT.LOOR 108 TOPLAL SEQUENCE THEFT.LOOR 109 UNDERTWATER Y SEQUENCE THEFT.LOOR 1000 WIT HOUSEN THE ROOP SEQUENCE THEFT.LOOR 1000 WITH HOUSEN THE ROOP SEQUENCE THEFT.LOOR 1000 WITH HOUSEN THE ROOP SEQUENCE THEFT.LOOR 1000 WITH HOUSEN THE ROOP SEQUENCE THEFT.LOOR 1000 SEQUENCE THEFT.LOOR SEQUENCE THEFT.LOOR 10000 SEQUENCE THEFT.LOOR	TOM	TOP OF MASONRY		'X': EXTERIOR	
TP TOLET PARE (DISPENSER) SSOURCE PER FLOOR UP UNT PECAL TOLET ACCESSOR'T AG UP UNT PECAL DISPENSER VE WARK COMPRETION THE DISPENSE VET VERT VERTICAL DISPENSE WIT WET VERTICAL WIT WIT STANDARD SYMBOLS NT.S STANDARD SYMBOLS ISTANDARD SYMBOLS VIE STANDARD SYMB	TOS	TOP OF STEEL; TOP OF SLAB	X101	AND INTERIOR	
TYP TYPICAL HI UNITERATE UNITERATE UNITERATE UNITERATES DIRECTION OF SLOPED WB WAPOR BARKER VIT WIT VIT WIT VIT WIT VIT WIT VIT WIT WIT WIT VIT WIT VIT WIT VIT WIT WIT					
UH HUPP UNTERLANDOR IN PREVNOUTION UNTERLANDOR PREVNER WO WIT WERE ANDRONG THE HUP PREVNOUTINE WIT WERE AND A THEORY AND A THE ANDROP WIT WERE AND A THE ANDROP AND A THE AND					
UNO UNIESS NOTED DTHERWISE STANDARD SYMBOLS STANDARD SYMBOLS N.T.S					
VOT VINL COMPOSITION THE VERT VERTICAL					
WHE WIDE FLANGE WH WATER HEATER WOM WITHOUT WOM WITHOUT WM WALCOFF MAT WM STANDARD SYMBOLS N.T.S STANDARD SYMBOLS WINDOWS STOREFRONT MANUF_YKK AP AMERICA MANUF_YKK AP AMERICA CUITAIN WALL MANUF_YKK AP AMERICA EXTERIOR DOORS STOREFRONT OUTSWING STOREFRONT OUTSWING MANUF_YKK AP AMERICA HOULOW METAL OUTSWING MANUF_YKK AP AMERICA HOULOW METAL OUTSWING SERIES MODELS STRESS WINTHOUTSWING SERIES MOULOW METAL OUTSWING SERIES MOULOW METAL OUTSWING SERIES MOULOW METAL OUTSWING SERIES MOULOW METAL OUTSWING	VIF VTR VWC W	VERIFY IN FIELD VENT THROUGH THE ROOF VINYL WALL COVERING WIDE; WASHER WITH			
WOM WITHOUT WALK OFF MAT WP WALK OFF MAT WALK OFF MAT WP WALK OFF MAT WALK OF	WF	WIDE FLANGE			V 91
STANDARD STMBOLS N.T.S FLORIDA PRODUCT APPROVAL / NOA	W/O	WITHOUT			
STANDARD STMBOLS N.T.S FLORIDA PRODUCT APPROVAL / NOA	WP	WATERPROOF			SET SET
FLORIDA PRODUCT APPROVAL / NOA CATEGORY WINDOWS STOREFRONT SERIES: YHS 50 FI CURTAIN WALL SERIES: YHS 50 FI Iddata Iddata Iddata Iddata Iddata Iddata Iddata Iddata Iddata PRODUCT APPROVAL (FL# MIAM-DADE NOA MIAM-DADE NOA REMARKS WINDOWS STOREFRONT MANUE: YKK AP AMERICA 14218.5 Iddata CURTAIN WALL SERIES: YHC 300 OG 13433.2 Iddata Iddata DVERHEAD DOORS OVERHEAD SECTIONAL MANUE: CLOPAY 17671 Iddata	WWF	WELDED WIRE FABRIC	STANDARD	SYMBOLS	
FLORIDA PRODUCT APPROVAL / NOA			N.T.S		E LC KEY, KEY,
FLORIDA PRODUCT APPROVAL / NOA					
FLORIDA PRODUCT APPROVAL / NOA CATEGORY MANUFACTURER DOCUMENTATION TYPE REMARKS WINDOWS STOREFRONT MANUE YKK AP AMERICA 14/218.5					
CATEGORY SUBCATEGORY MANUFACTURER DOCUMENTATION TYPE REMARKS MINDOWS STOREFRONT MANUE: YKK AP AMERICA. MIAMI-DADE MIAMI-DADE CURTAIN WALL MANUE: YKK AP AMERICA. 14218.5 Image: String Str					
PRODUCT NUMBER FLORIDAL APPROVAL (FL#) MIAMI-DADE NOA WINDOWS STOREFRONT MANUF: YKK AP AMERICA 14218.5 Image: Comparison of the	FLORIDA PR	ODUCT APPROVAL / N	OA		
PRODUCT NUMBER FLORIDAL APPROVAL (FL#) MIAMI-DADE NOA WINDOWS STOREFRONT MANUF: YKK AP AMERICA 14218.5 Image: Comparison of the			MANUFACTURER	DOCUMENTATION TYPE	PROJEC TITLE: SSUED
INCLUST NORMELIX APPROVAL (FL#) NOA WINDOWS STOREFRONT SERIES: YHS 30 FI 14218.5 CURTAIN WALL SERIES: YHS 300 FI 14218.5 Image: Series: Ser	CATEGORY	SUBCATEGORY			
NINDONS STOREFNONT SERIES; YHS 50 FI 1421.0.3 CURTAIN WALL SERIES; YHS 50 FI 13433.2 EXTERIOR DOORS STOREFRONT OUTSWING MANUE; YKK AP AMERICA 16554 HOLLOW METAL OUTSWING MANUE; XKK AP AMERICA 16554 HOLLOW METAL OUTSWING MANUE; LOPAY 17671 OVERHEAD SECTIONAL MANUE; OVERHEAD DOOR CO 15960 OVERHEAD COILING MANUE; OVERHEAD DOOR CO 15960 SERIES: SERIES: 16554 PRODUCT APPROVAL NOTES MANUE; SCHEDULE DOES NOT IMPLY OR PRESUME THAT THE PRODUCT LISTED WILL BE INSTALLED MACCEPTANCE, AND APPROVAL BY THE BUILDING DEPARTMENT. IT IS THE CONTRACTOR'S RESPONSIBILITY TO SUBMIT REV INCLUSION OF A PRODUCT IN THIS SCHEDULE DOES NOT IMPLY OR PRESUME THAT THE PRODUCT LISTED WILL BE INSTALLED REV A. INCLUSION OF A PRODUCT IN THIS SCHEDULE DOES NOT IMPLY OR PRESUME THAT THE PRODUCT LISTED WILL BE INSTALLED REV A. COEPTANCE, AND APPROVAL. SERIES: BERUIDING DEPARTMENT FOR THE ALTERNATE PRODUCT'S EVALUATION AND APPROVAL. SCALE: As in ACCEPTANCE, AND APPROVAL. SCALE: As in PROJECT MANAGER: DRAWN BY: AC OF RECORD: PROJECT NO:					
CURTAIN WALL MANUE: YKK AP AMERICA SERIES: YHC 300 OG 13433.2	WINDOWS	STOREFRONT	SERIES: YHS 50 FI	14218.5	
EXTERIOR DOORS STOREFRONT OUTSWING MANUF: YKK AP AMERICA SERIES: 35H SERIES: 35H SERIES: 35H SERIES: 35H SERIES: 15ERIES: 15ERIES: 14022		CURTAIN WALL	MANUF: YKK AP AMERICA SERIES: YHC 300 OG	13433.2	
HOLLOW METAL OUTSWING MANUE: ALLEGION SERIES: MSERIES 14022 Image: Comparison of the series of	EXTERIOR DOORS	STOREFRONT OUTSWING	MANUF: YKK AP AMERICA	16554	
OVERHEAD DOORS OVERHEAD SECTIONAL MANUE: CLOPAY SERIES: MODEL 3718 17671 Image: Clopay OVERHEAD COILING MANUE: OVERHEAD DOOR CO SERIES: 610 15960 Image: Clopay		HOLLOW METAL OUTSWING	MANUF: ALLEGION	14022	
OVERHEAD COILING MANUF: SERIES: 610 15960 MANUF: SERIES: MANUF: SERIES: Rev Rev PRODUCT APPROVAL NOTES Inclusion of A PRODUCT IN THIS SCHEDULE DOES NOT IMPLY OR PRESUME THAT THE PRODUCT LISTED WILL BE INSTALLED IN THIS PROJECT. ALTERNATE PRODUCTS COMPLYING WITH CODE REQUIREMENTS MAY BE UTILIZED UPON EVALUATION, ACCEPTANCE, AND APPROVAL BY THE BUILDING DEPARTMENT. IT IS THE CONTRACTOR'S RESPONSIBILITY TO SUBMIT INFORMATION AND DOCUMENTATION THAT MAY BE REQUIRED BY THE BUILDING DEPARTMENT FOR THE ALTERNATE PRODUCT'S EVALUATION AND APPROVAL. REV DESCRIPTION SCALE: As in PROJECT MANAGER: O" 1 DRAWN BY: A/E OF RECORD: PROJECT NO: SHEET TITLE: SHEET TITLE:	OVERHEAD DOORS		MANUF: CLOPAY	17671	
SERIES: 610 0.000 MANUF: 0.000 SERIES: 0.000 NOLUSION OF A PRODUCT IN THIS SCHEDULE DOES NOT IMPLY OR PRESUME THAT THE PRODUCT LISTED WILL BE INSTALLED IN THIS PROJECT. ALTERNATE PRODUCTS COMPLYING WITH CODE REQUIREMENTS MAY BE UTILIZED UPON EVALUATION, ACCEPTANCE, AND APPROVAL BY THE BUILDING DEPARTMENT. IT IS THE CONTRACTOR'S RESPONSIBILITY TO SUBMIT INFORMATION AND DOCUMENTATION THAT MAY BE REQUIRED BY THE BUILDING DEPARTMENT FOR THE ALTERNATE PRODUCT'S EVALUATION AND APPROVAL. GRAPHIC SCALE: 0" 1 SCALE: As in PROJECT MANAGER: DRAWN BY: A/E OF RECORD: PROJECT NO: SHEET TITLE:			MANUF: OVERHEAD DOOR CO		
PRODUCT APPROVAL NOTES A. INCLUSION OF A PRODUCT IN THIS SCHEDULE DOES NOT IMPLY OR PRESUME THAT THE PRODUCT LISTED WILL BE INSTALLED IN THIS PROJECT. ALTERNATE PRODUCTS COMPLYING WITH CODE REQUIREMENTS MAY BE UTILIZED UPON EVALUATION, ACCEPTANCE, AND APPROVAL BY THE BUILDING DEPARTMENT. IT IS THE CONTRACTOR'S RESPONSIBILITY TO SUBMIT INFORMATION AND DOCUMENTATION THAT MAY BE REQUIRED BY THE BUILDING DEPARTMENT FOR THE ALTERNATE PRODUCT'S EVALUATION AND APPROVAL. SCALE: As i PROJECT MANAGER: DRAWN BY: A/E OF RECORD: PROJECT NO: SHEET TITLE:			MANUF:		
A. INCLUSION OF A PRODUCT IN THIS SCHEDULE DOES NOT IMPLY OR PRESUME THAT THE PRODUCT LISTED WILL BE INSTALLED IN THIS PROJECT. ALTERNATE PRODUCTS COMPLYING WITH CODE REQUIREMENTS MAY BE UTILIZED UPON EVALUATION, ACCEPTANCE, AND APPROVAL BY THE BUILDING DEPARTMENT. IT IS THE CONTRACTOR'S RESPONSIBILITY TO SUBMIT INFORMATION AND DOCUMENTATION THAT MAY BE REQUIRED BY THE BUILDING DEPARTMENT FOR THE ALTERNATE PRODUCT'S EVALUATION AND APPROVAL. SCALE: As ii PROJECT MANAGER: DRAWN BY: A/E OF RECORD: PROJECT NO: SHEET TITLE:		1	JENIEJ.		
IN THIS PROJECT. ALTERNATE PRODUCTS COMPLYING WITH CODE REQUIREMENTS MAY BE UTILIZED UPON EVALUATION, ACCEPTANCE, AND APPROVAL BY THE BUILDING DEPARTMENT. IT IS THE CONTRACTOR'S RESPONSIBILITY TO SUBMIT INFORMATION AND DOCUMENTATION THAT MAY BE REQUIRED BY THE BUILDING DEPARTMENT FOR THE ALTERNATE PRODUCT'S EVALUATION AND APPROVAL. SCALE: As i PROJECT MANAGER: DRAWN BY: A/E OF RECORD: PROJECT NO: SHEET TITLE:			E DOES NOT IMPLY OR PRESUME	THAT THE PRODUCT LISTED WILL BE INSTALLEI	REV DESCRIPTION
INFORMATION AND DOCUMENTATION THAT MAY BE REQUIRED BY THE BUILDING DEPARTMENT FOR THE ALTERNATE PRODUCT'S EVALUATION AND APPROVAL. SCALE: As in PROJECT MANAGER: DRAWN BY: A/E OF RECORD: PROJECT NO: SHEET TITLE:	IN THIS PR	OJECT. ALTERNATE PRODUCTS CO	MPLYING WITH CODE REQUIREM	IENTS MAY BE UTILIZED UPON EVALUATION,	
SCALE: As i PROJECT MANAGER: DRAWN BY: A/E OF RECORD: PROJECT NO: SHEET TITLE:	INFORMAT	ION AND DOCUMENTATION THAT M			0" 1"
PROJECT MANAGER: DRAWN BY: A/E OF RECORD: PROJECT NO: SHEET TITLE:					SCALE:
DRAWN BY: A/E OF RECORD: PROJECT NO: SHEET TITLE:					
A/E OF RECORD: PROJECT NO: SHEET TITLE:					
PROJECT NO: SHEET TITLE:					
SHEET TITLE:					
					CODE ANALYSIS
PRODUCT					PRODUCT

SHEET No.: A0.1


8 SWEET SPARKMAN ARCH

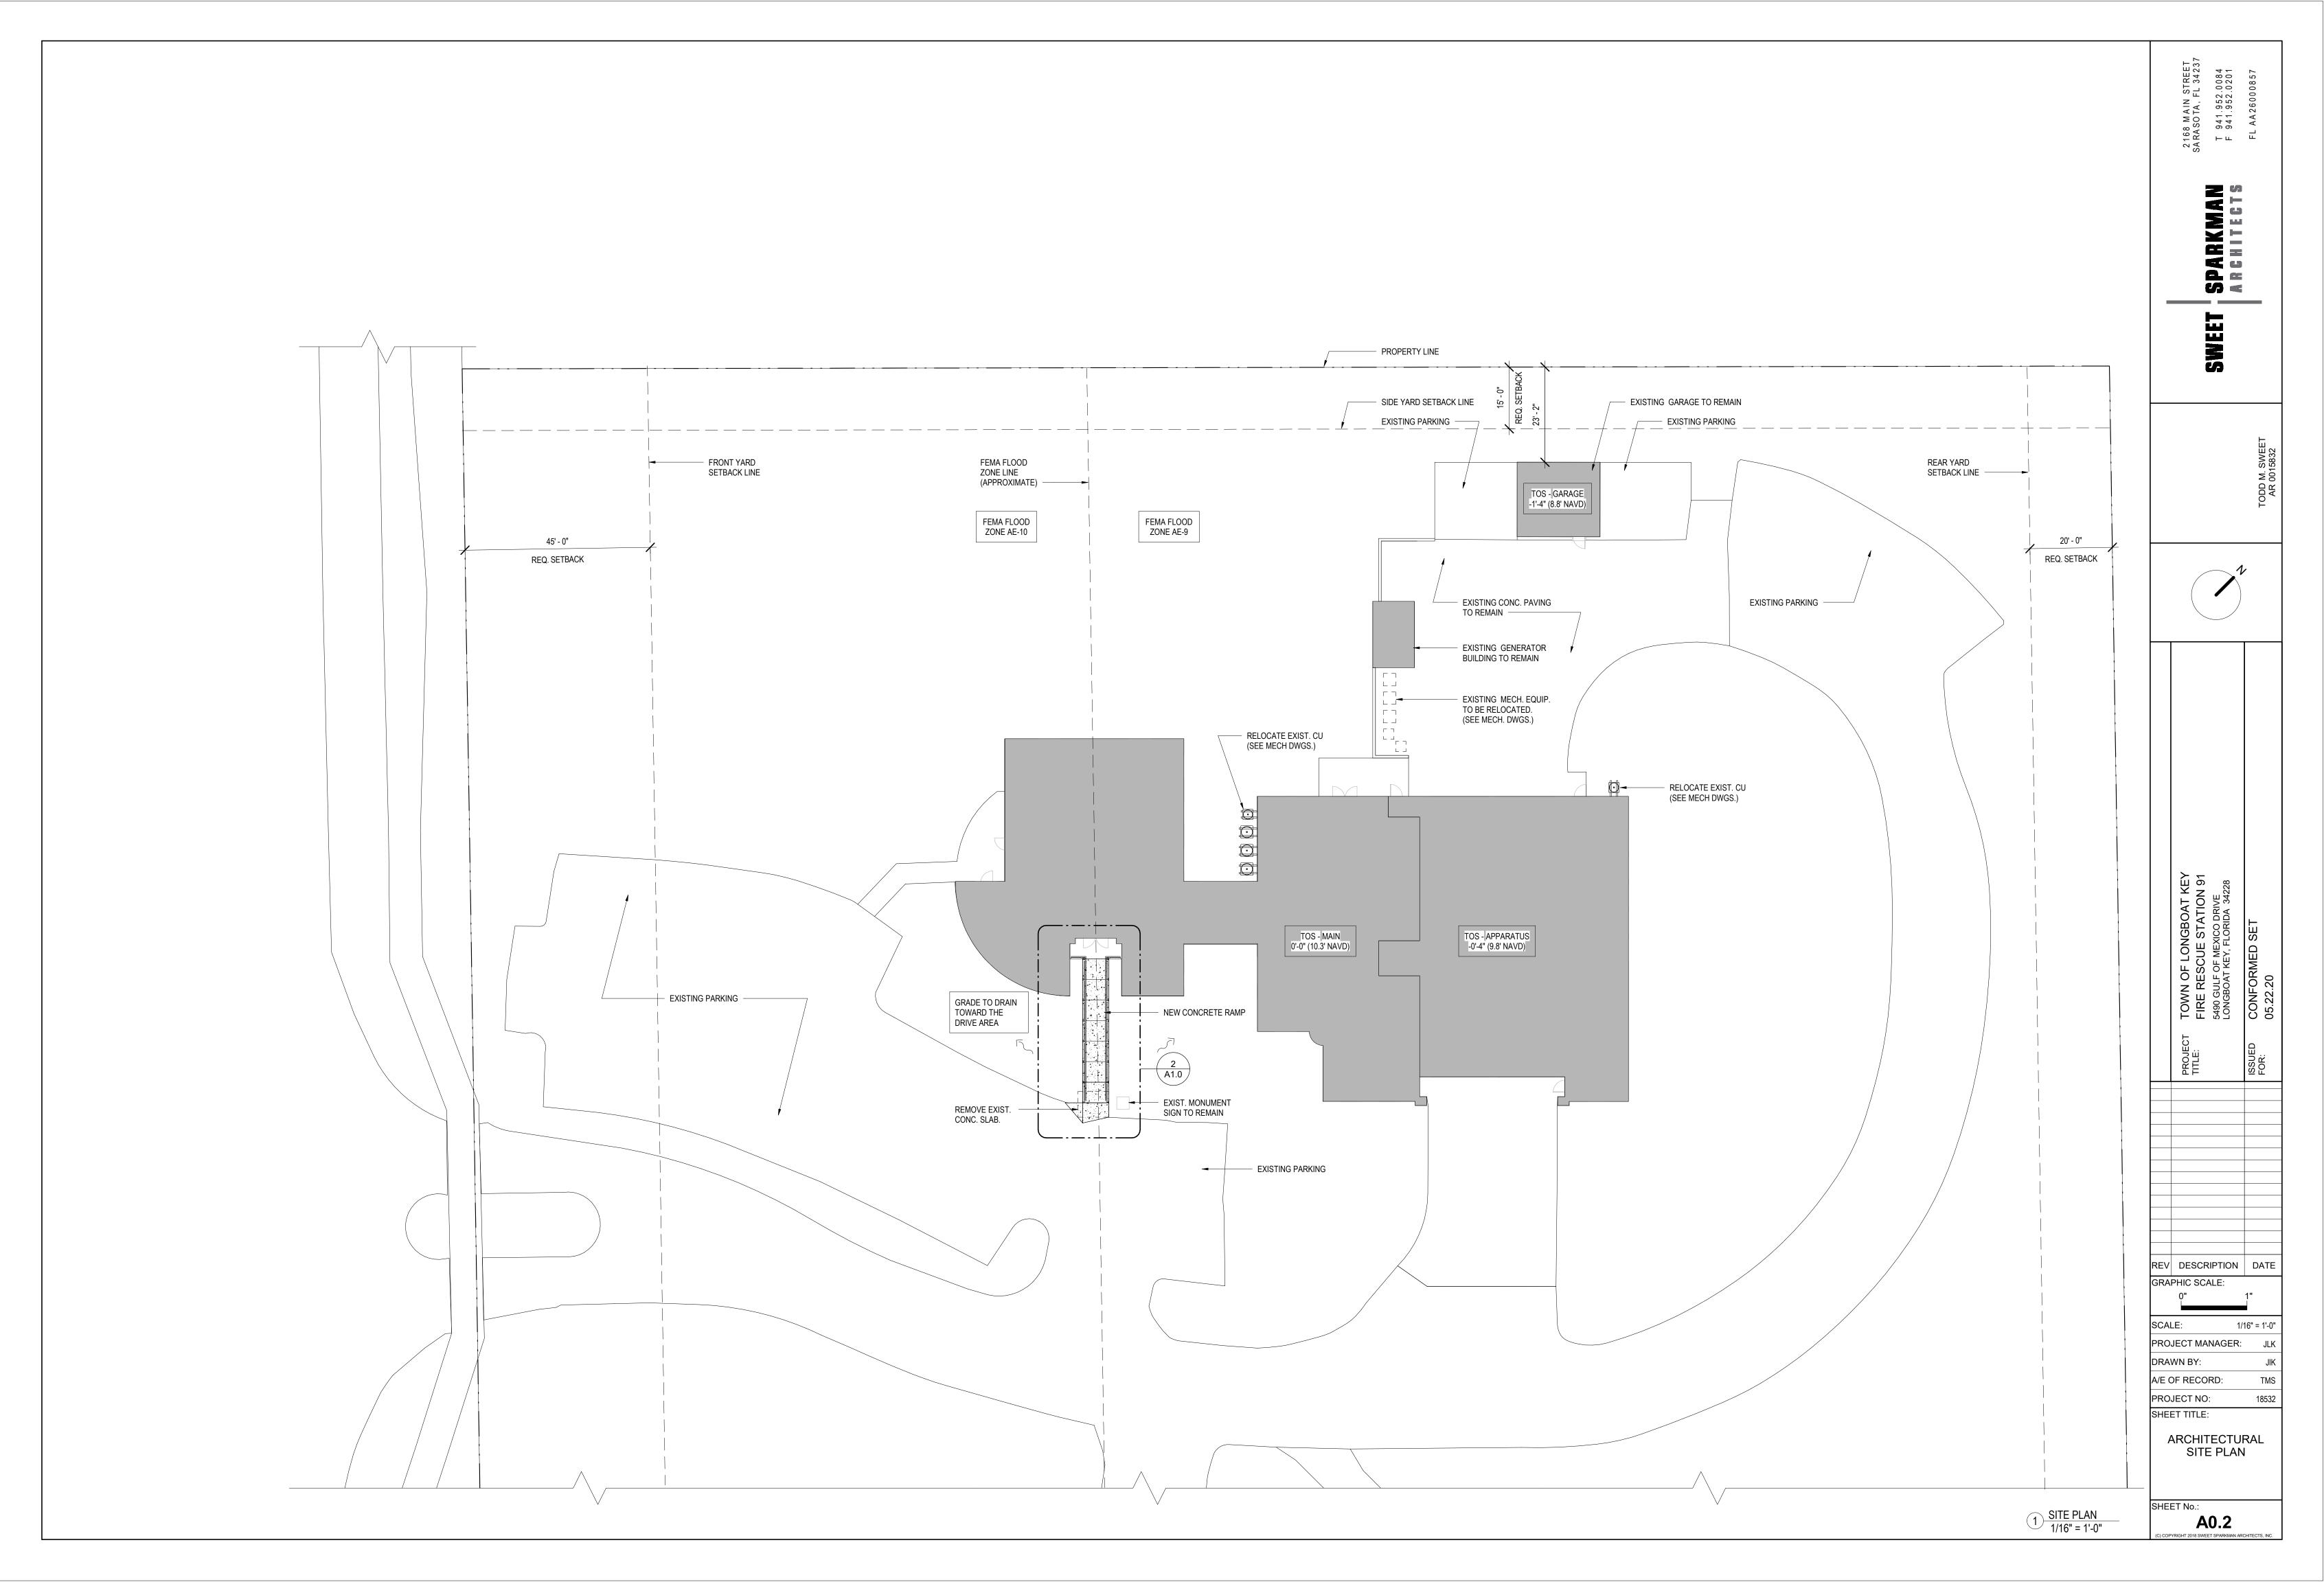

	NOTES SHOWN IN DRAWINGS ON THIS
	LY ONLY TO THE NUMBERED NOTES IN
	IENT FOR NEW DOOR OPENING.
2 REMOVE OVERHEAD	TION WITH FLOOR PLAN) DOOR ASSEMBLY & DOOR OPENER.
EXISTING STEEL JAM 3 REMOVE CONCRETE 4 REMOVE EQUIPMEN	
 4 REMOVE EQUIPMEN 5 REMOVE PLUMBING 6 REMOVE SWINGING 	FIXTURE
7 REMOVE CASEWOR	((COUNTERTOP, UPPER & BASE CABINETS)
9 REMOVE WOOD DEC 9 REMOVE WALL CONS 10 REMOVE LOUVER AS	STRUCTION
11 REMOVE KITCHEN A	
13 REMOVE EXISTING F	
DEMOLITION V	VALL LEGEND
	EXISTING WALLS TO REMAIN
	EXISTING WALLS TO BE REMOVED
- -	
	EXISTING DOOR TO BE REMOVED
د	

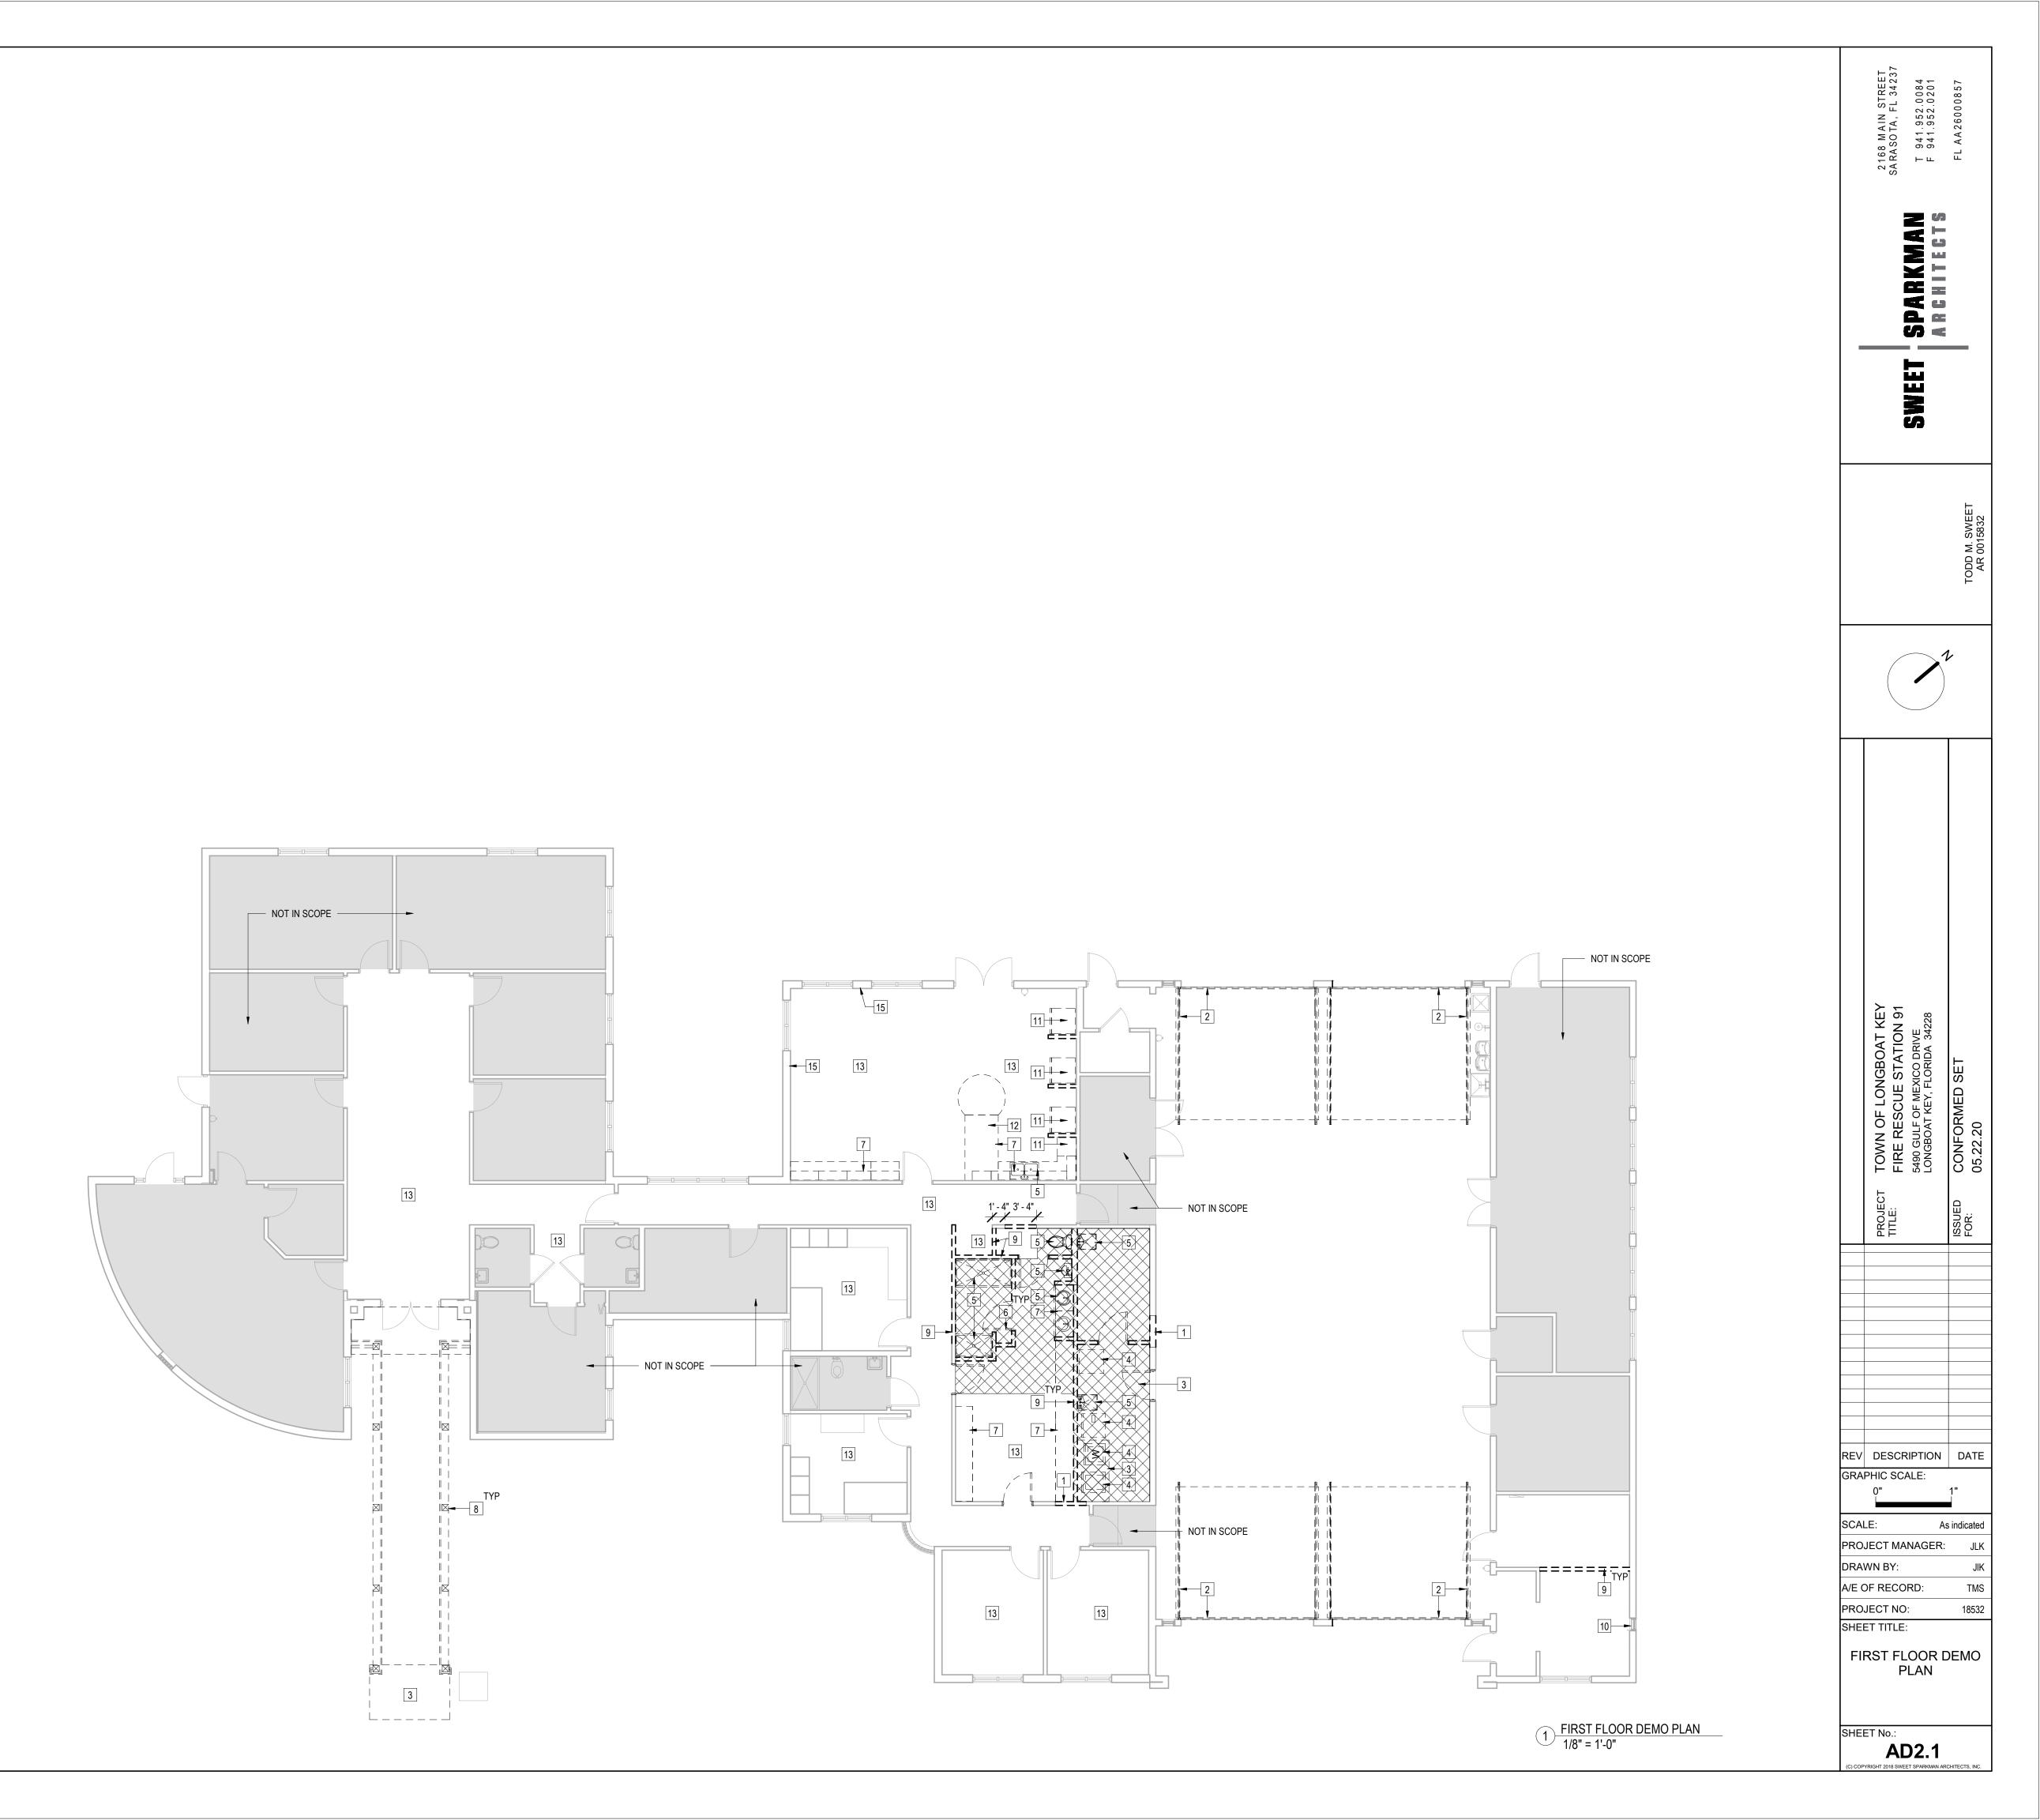

SHEET NOTES NUMBERED NOTES SHOWN IN DRAWINGS ON THIS SHEET APPLY ONLY TO THE NUMBERED NOTES IN THE TABLE BELOW.	
 REMOVE EXISTING CEILING, LIGHTING AND MECHANICAL DEVICES. REMOVE LIGHT FIXTURE. PATCH/REPAIR CEILING FINISH AS REQUIRED. 	

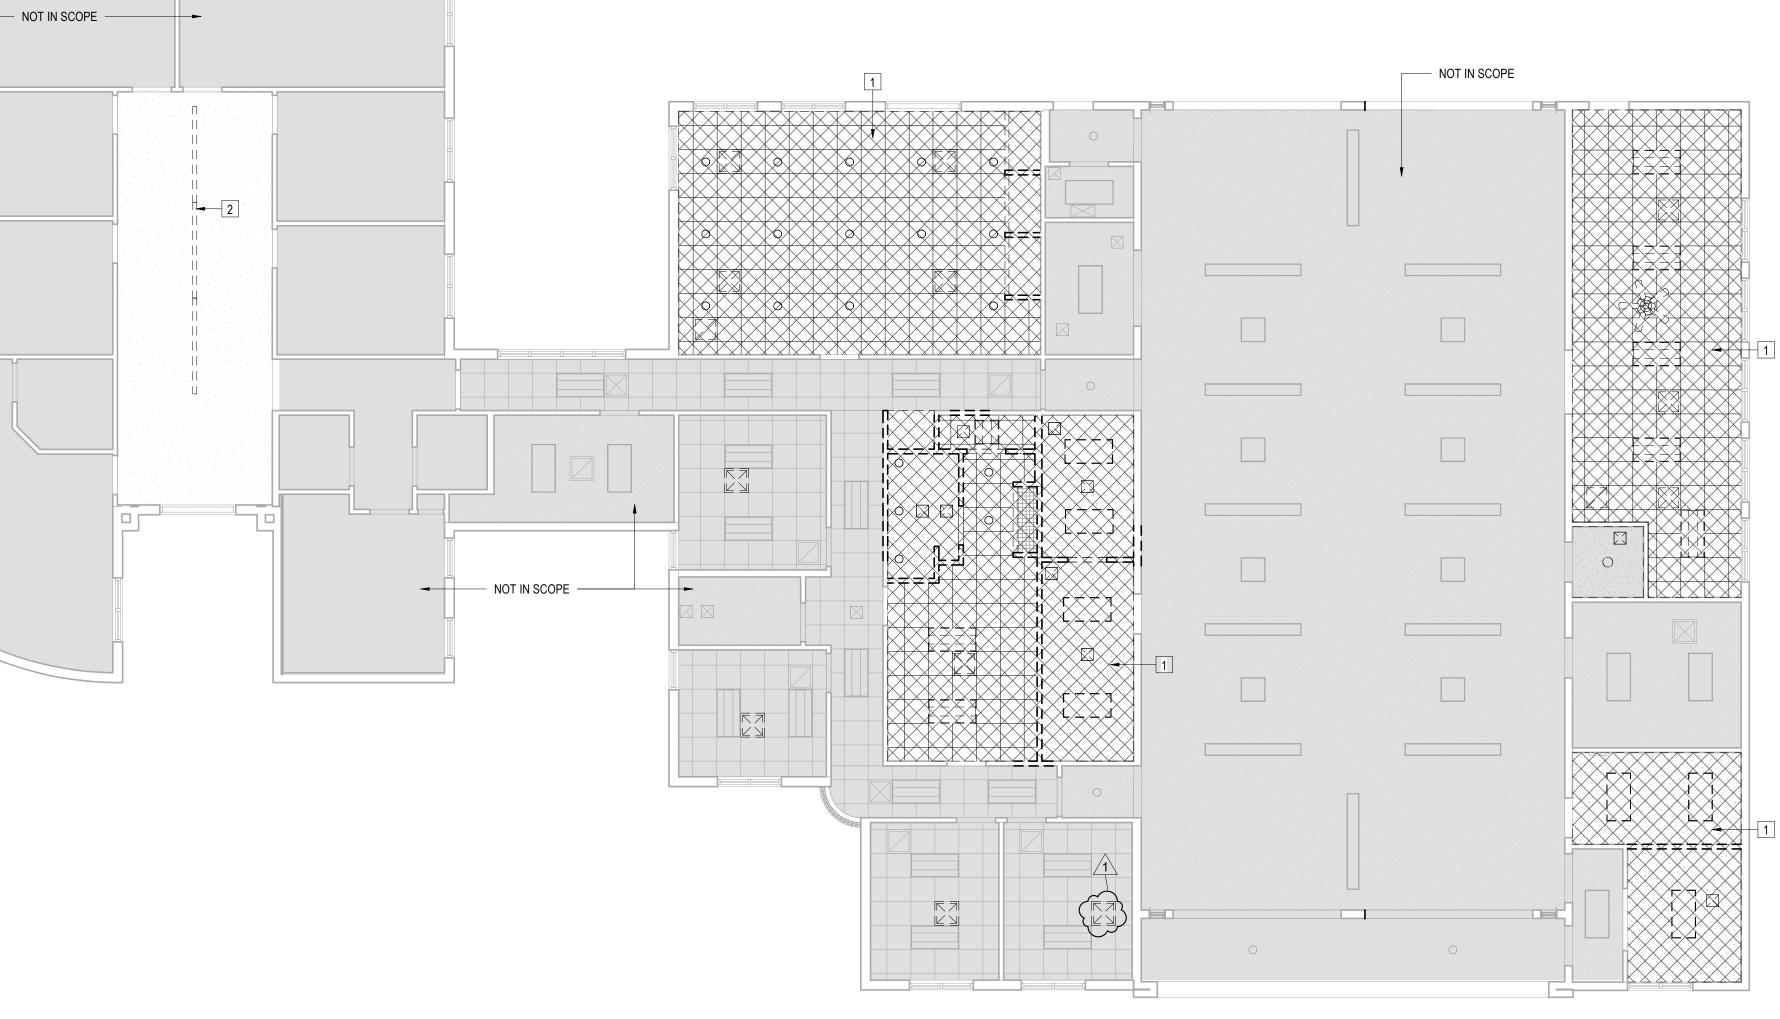



	2168 MAIN STREET SARASOTA, FL 34237 T 941.952.0084 F 941.952.0201 FL AA26000857
	SWEET SPARKMAN Architegts
	SM TODD M. SWEET AR 0015832
-	
	PROJECT TOWN OF LONGBOAT KEY TITLE: FIRE RESCUE STATION 91 5490 GULF OF MEXICO DRIVE 5490 GULF OF MEXICO DRIVE LONGBOAT KEY, FLORIDA 34228 34228 ISSUED CONFORMED SET FOR: 05.22.20
L	1 ASI 01 08.26.20 REV DESCRIPTION DATE GRAPHIC SCALE: 0" 1"
	SCALE: 1/8" = 1'-0" PROJECT MANAGER: JLK DRAWN BY: JIK A/E OF RECORD: TMS PROJECT NO: 18532 SHEET TITLE: FIRST FLOOR DEMO RCP SHEET No.: AD3.1

1 FIRST FLOOR DEMO RCP 1/8" = 1'-0"

SHEET NOTES X - NUMBERED NOTES SHOWN IN DRAWINGS ON THIS SHEET APPLY ONLY TO THE NUMBERED NOTES IN	
THE TABLE BELOW.	
1 REMOVE EXISTING CEILING, LIGHTING AND MECHANICAL DEVICES. 2 REMOVE LIGHT FIXTURE. PACTH/REPAIR CEILING FINISH AS	
REQUIRED.	



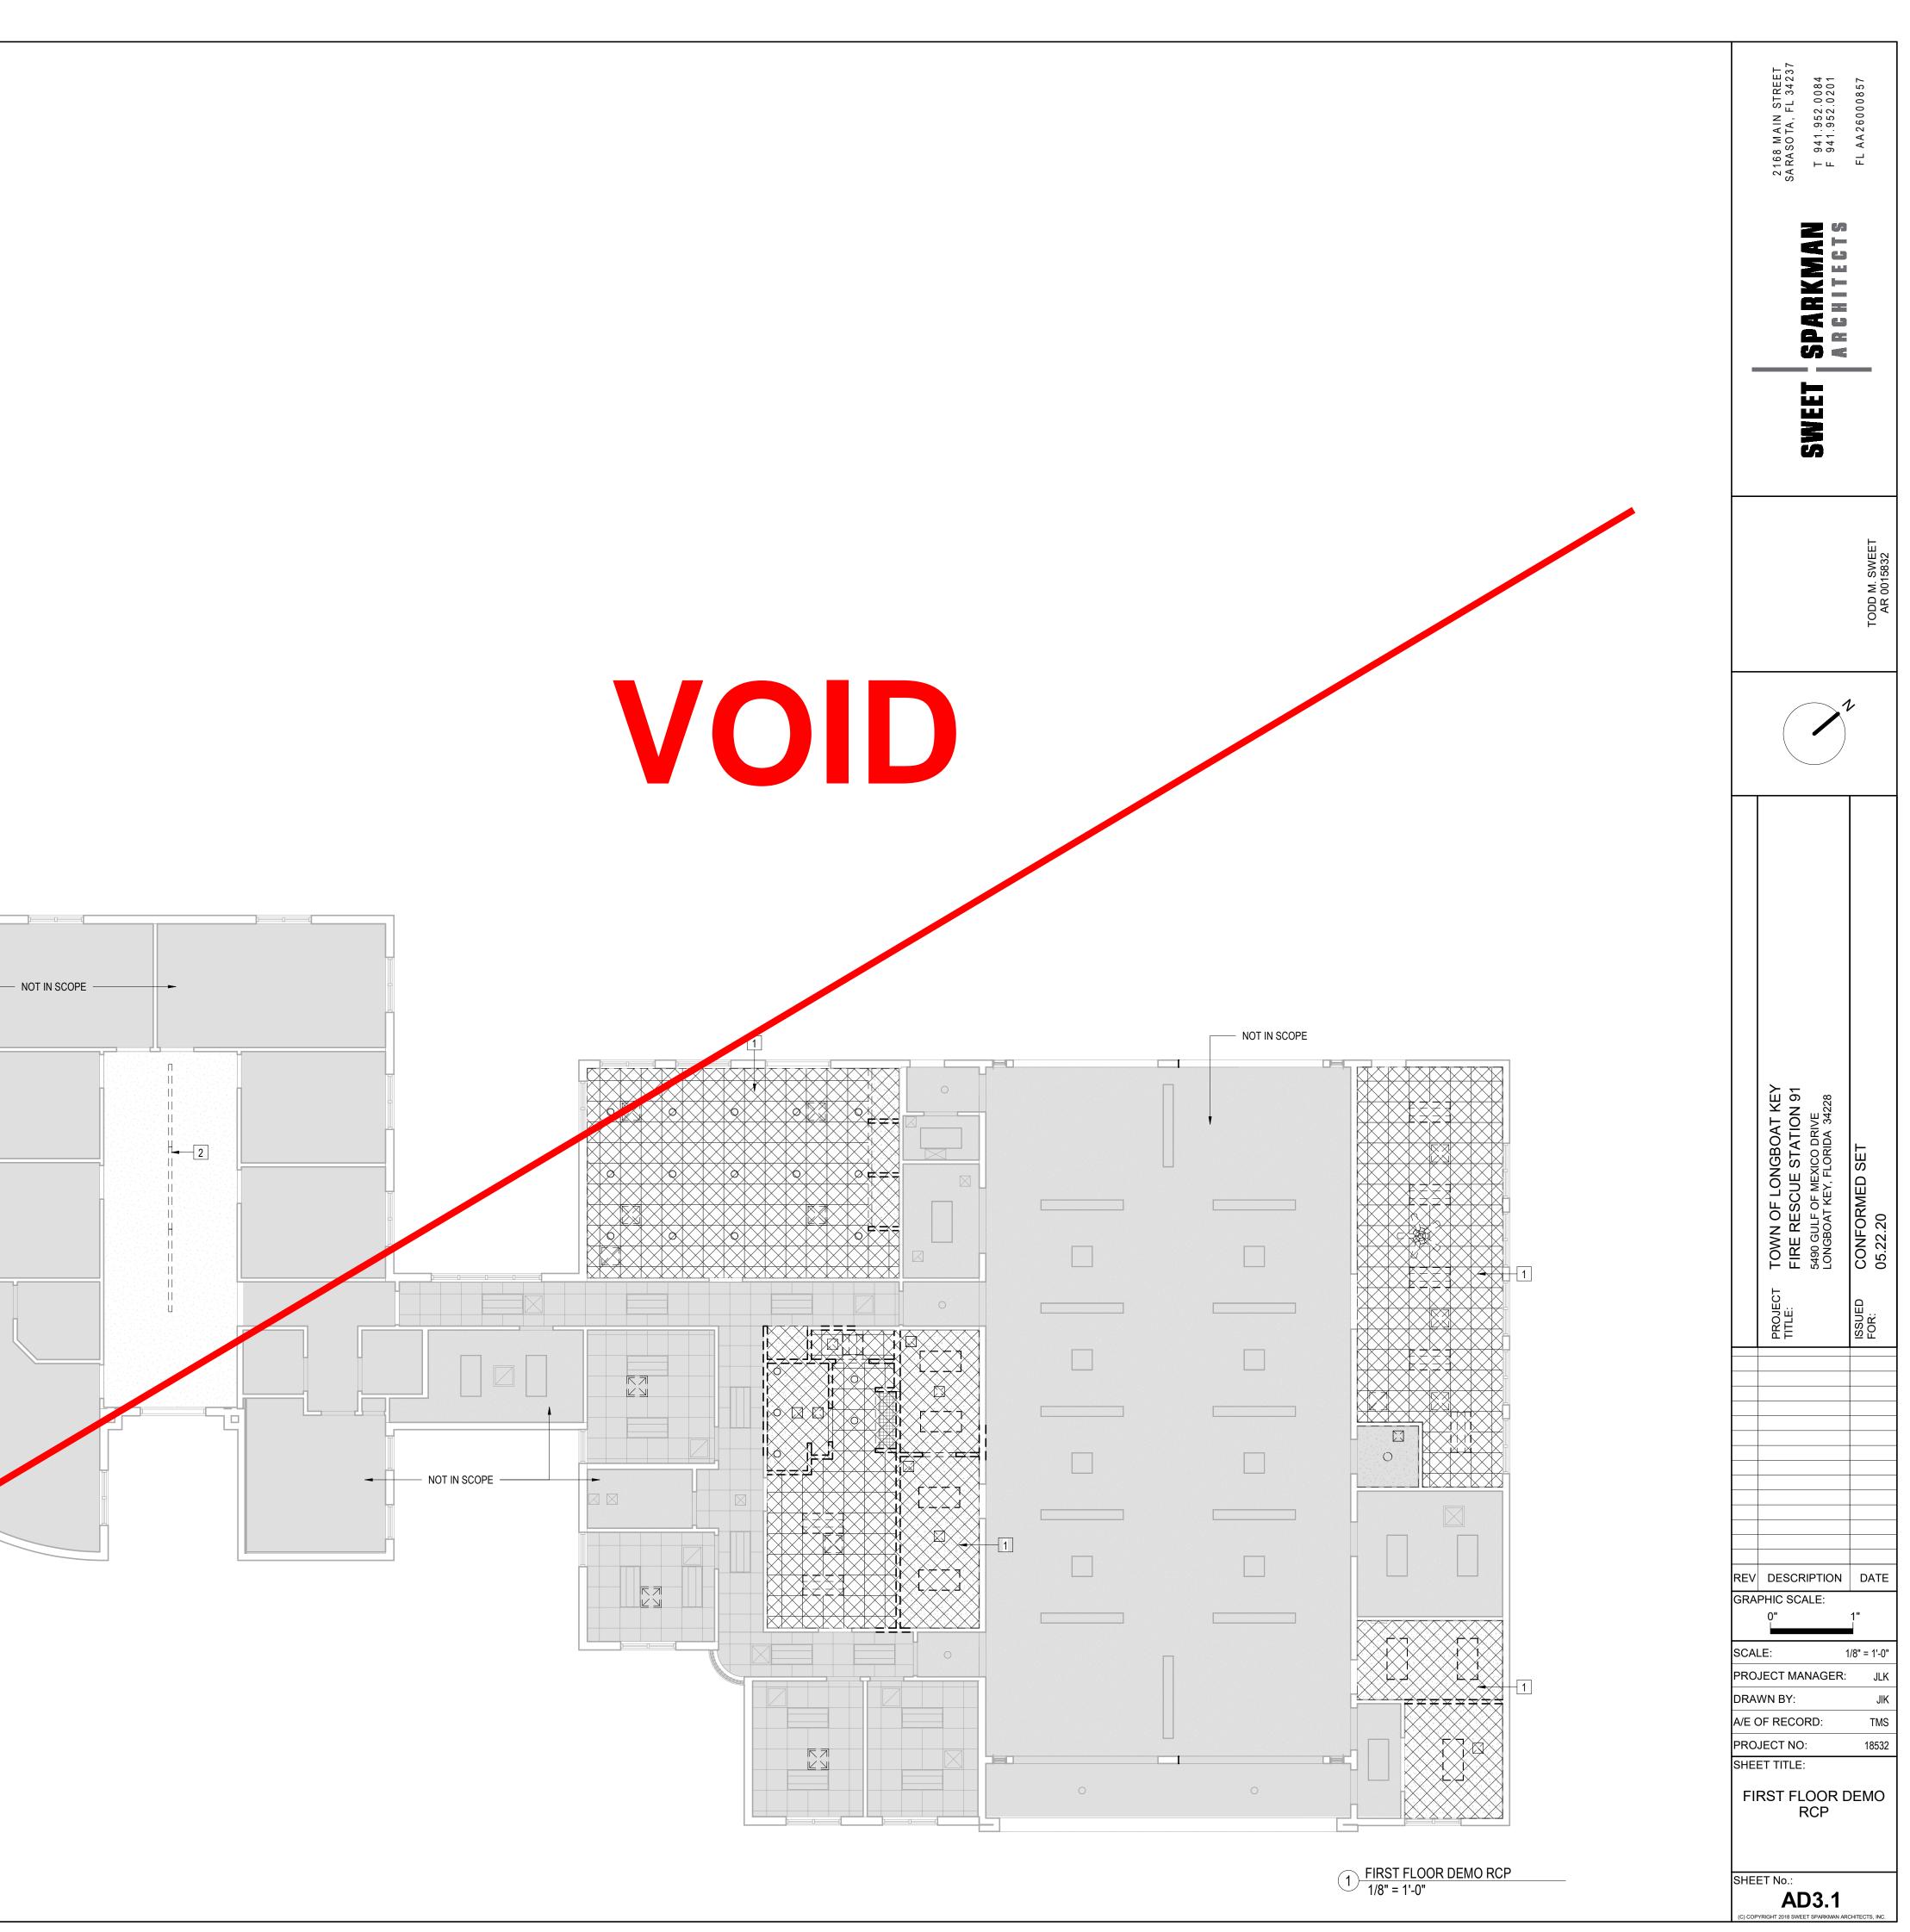

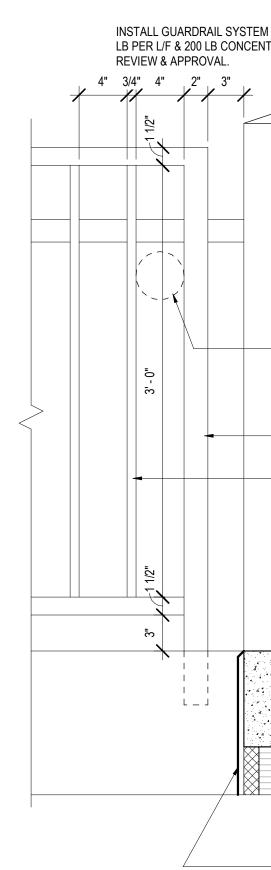



	SIZE	USAGE	NUMBER OF OCCUPANTS	
	X-X	DE GR	SIGNATION OF OUP PER FBC S	
	← ·····	- TR	APHIC ILLUSTR AVEL DISTANCE OM REMOTE PC	Е ТО
	\bigotimes	EX	IT SIGN	
CLR WIDT OF DOOR		00	IT EGRESS CAP CUPANTS)	ACI
	FACP		RE ALARM CONT	ROI
	$\overset{\bigtriangledown}{\bigcirc}$	FIR	RE EXTINGUISH	ΞR
	FEC	FIR	RE EXTINGUISHE	ER C
		<u> </u>	IR WALL	


ROOM NAME


ROOM NUMBER


LIFE SAFETY LEGEND N.T.S

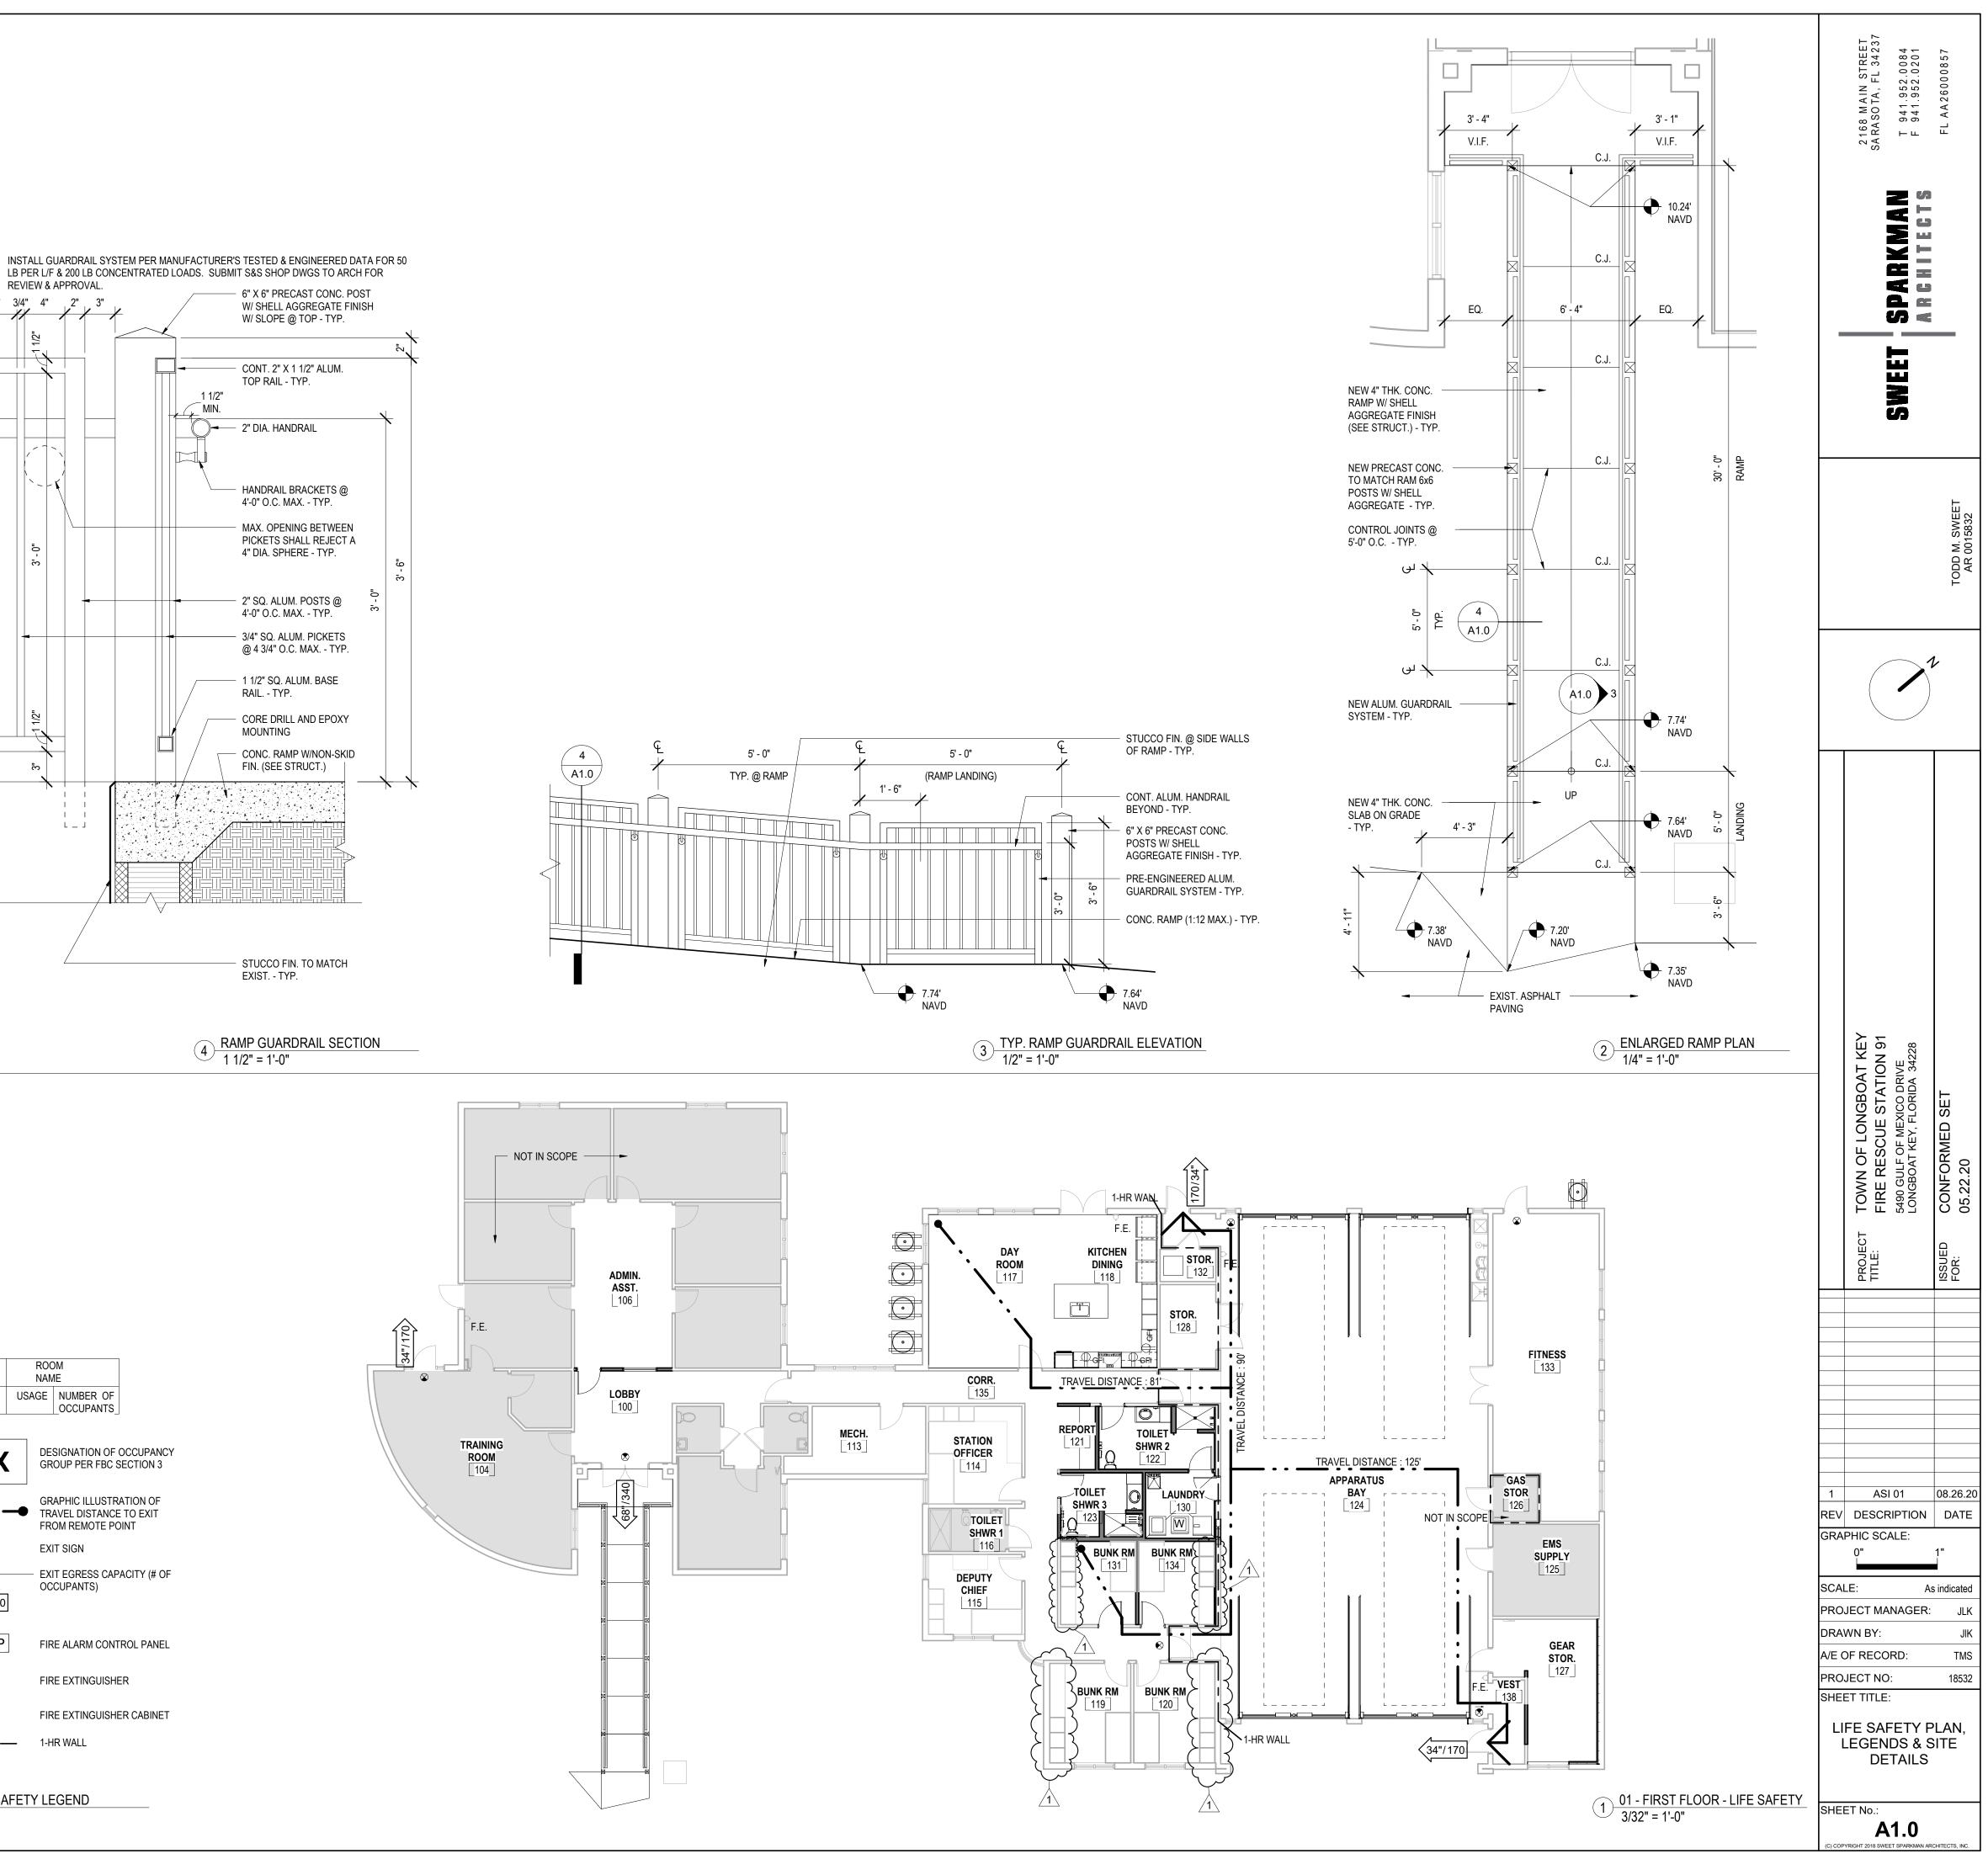


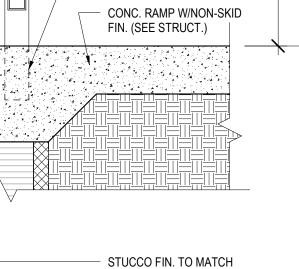

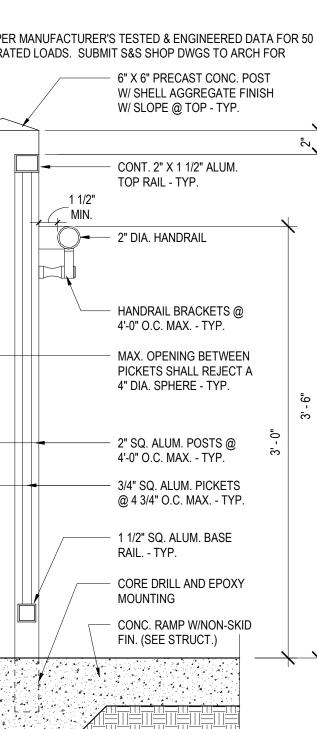

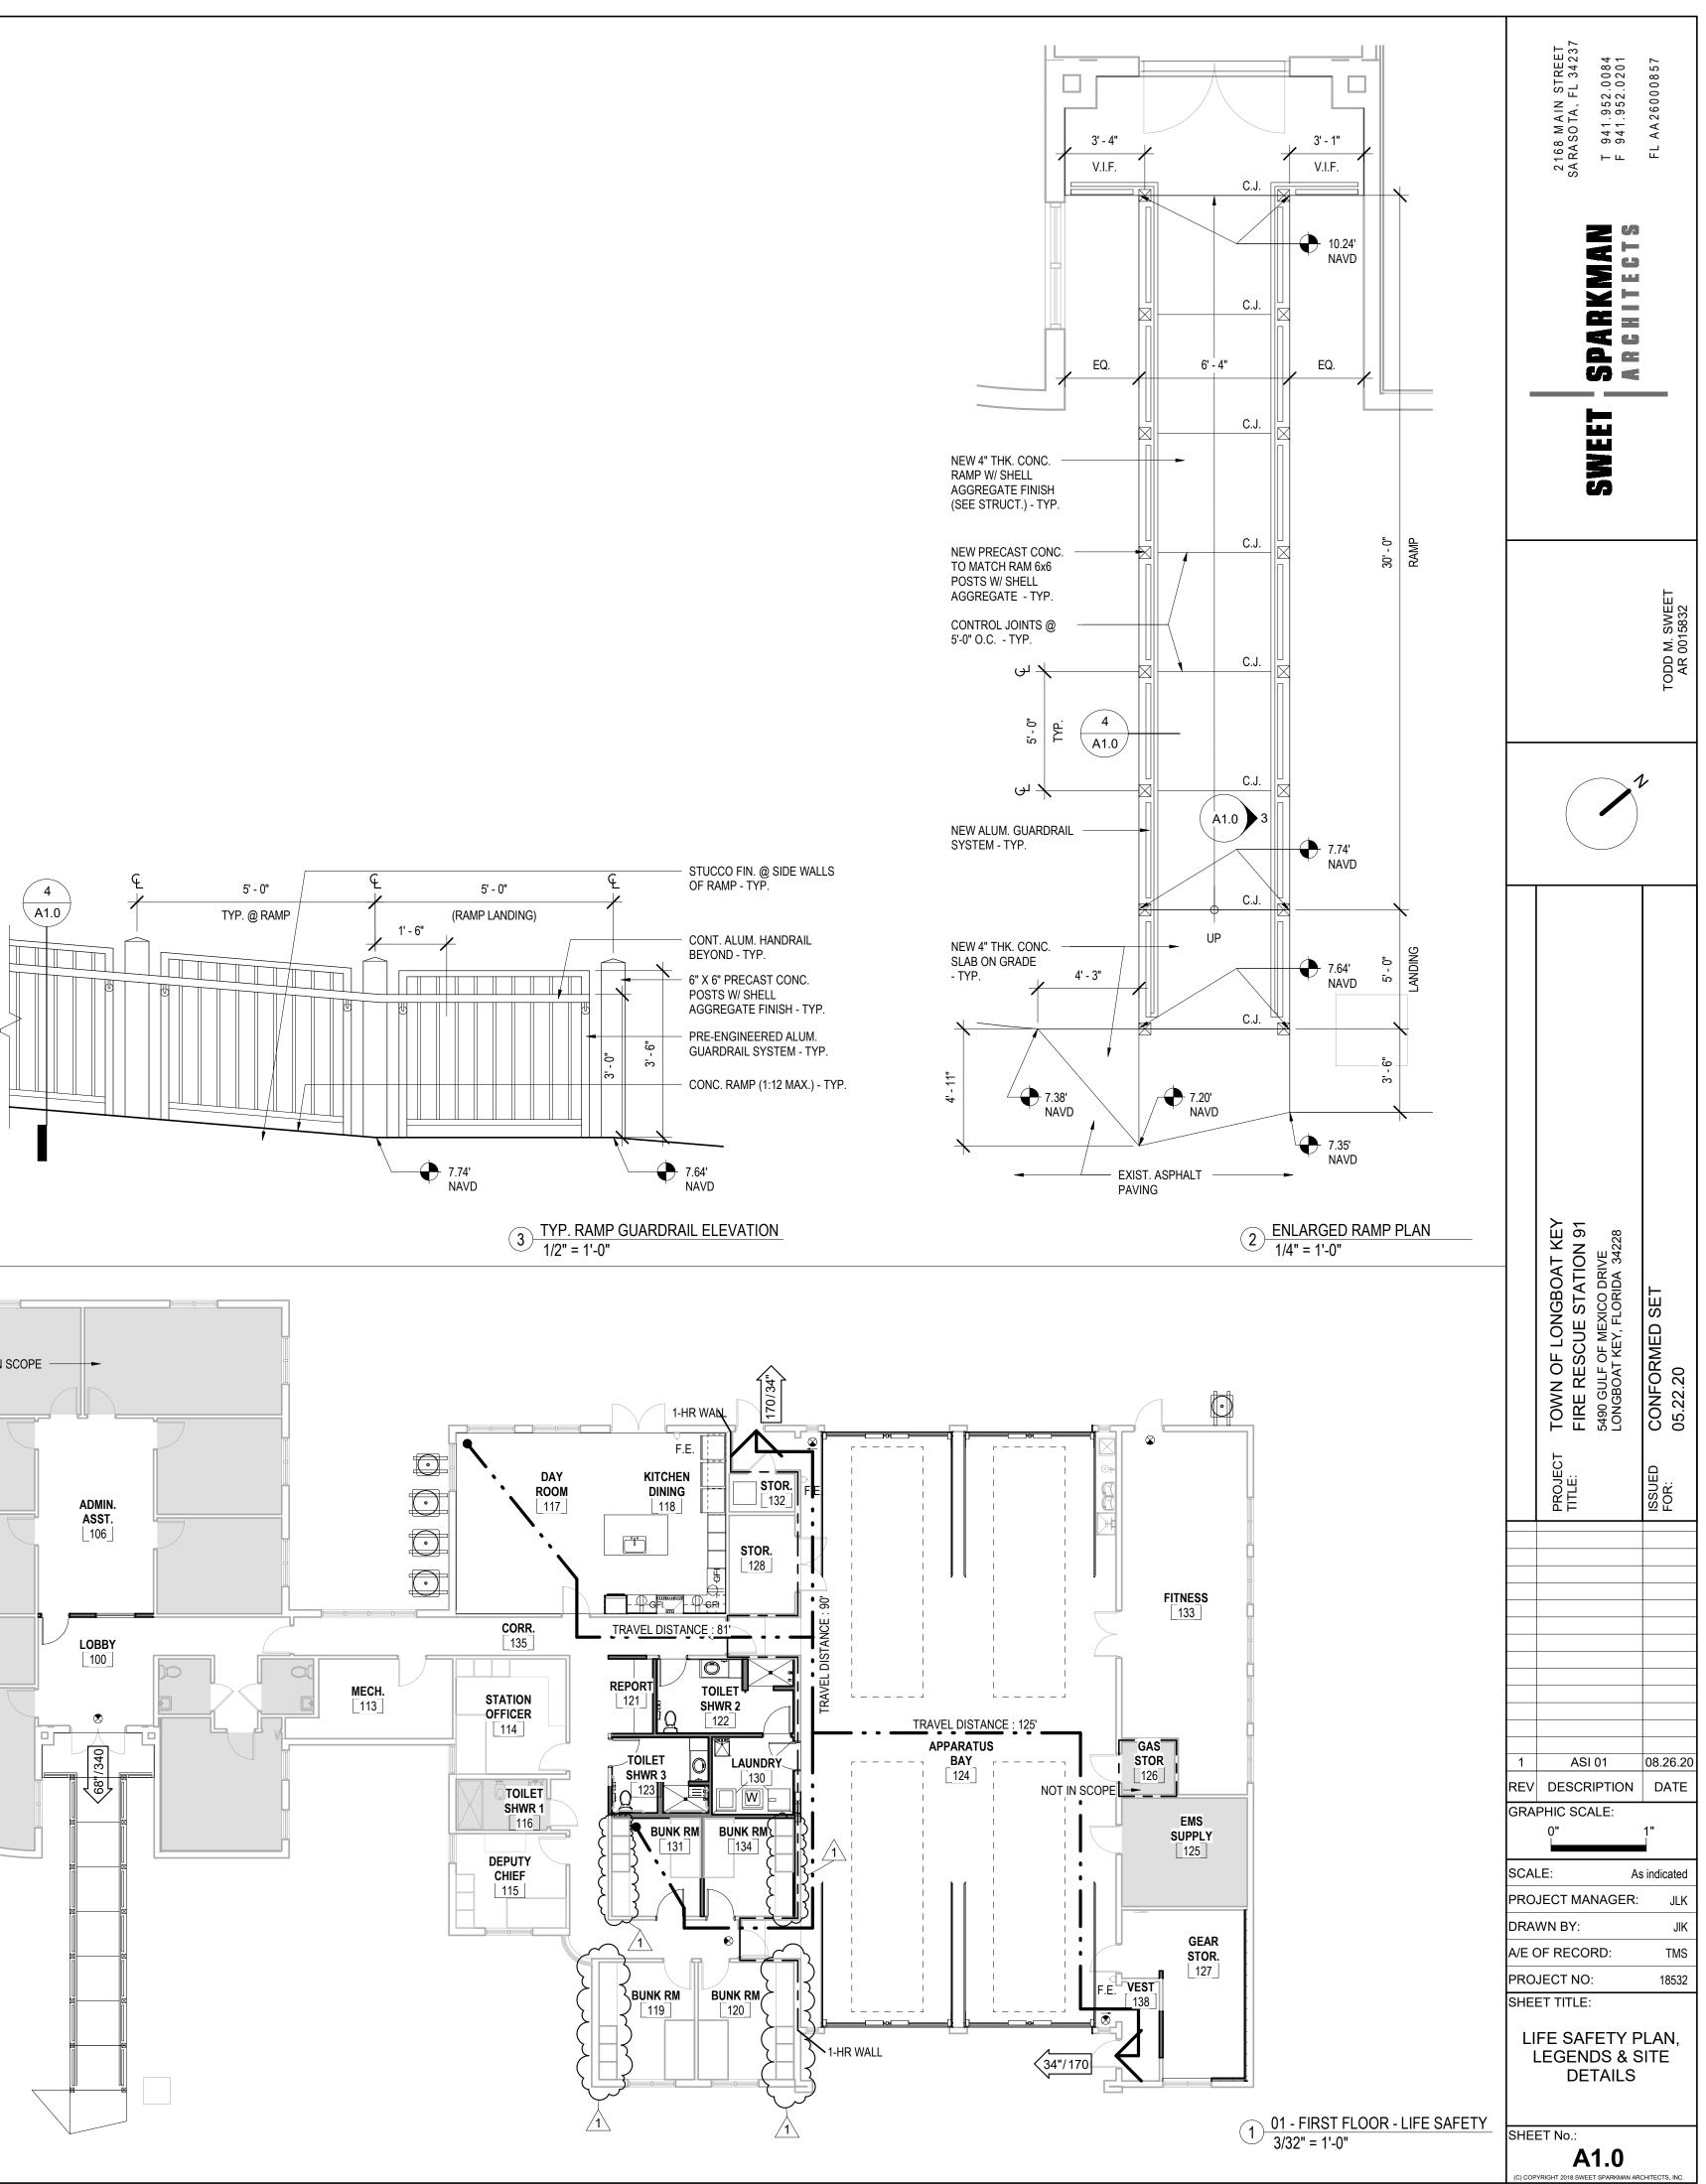

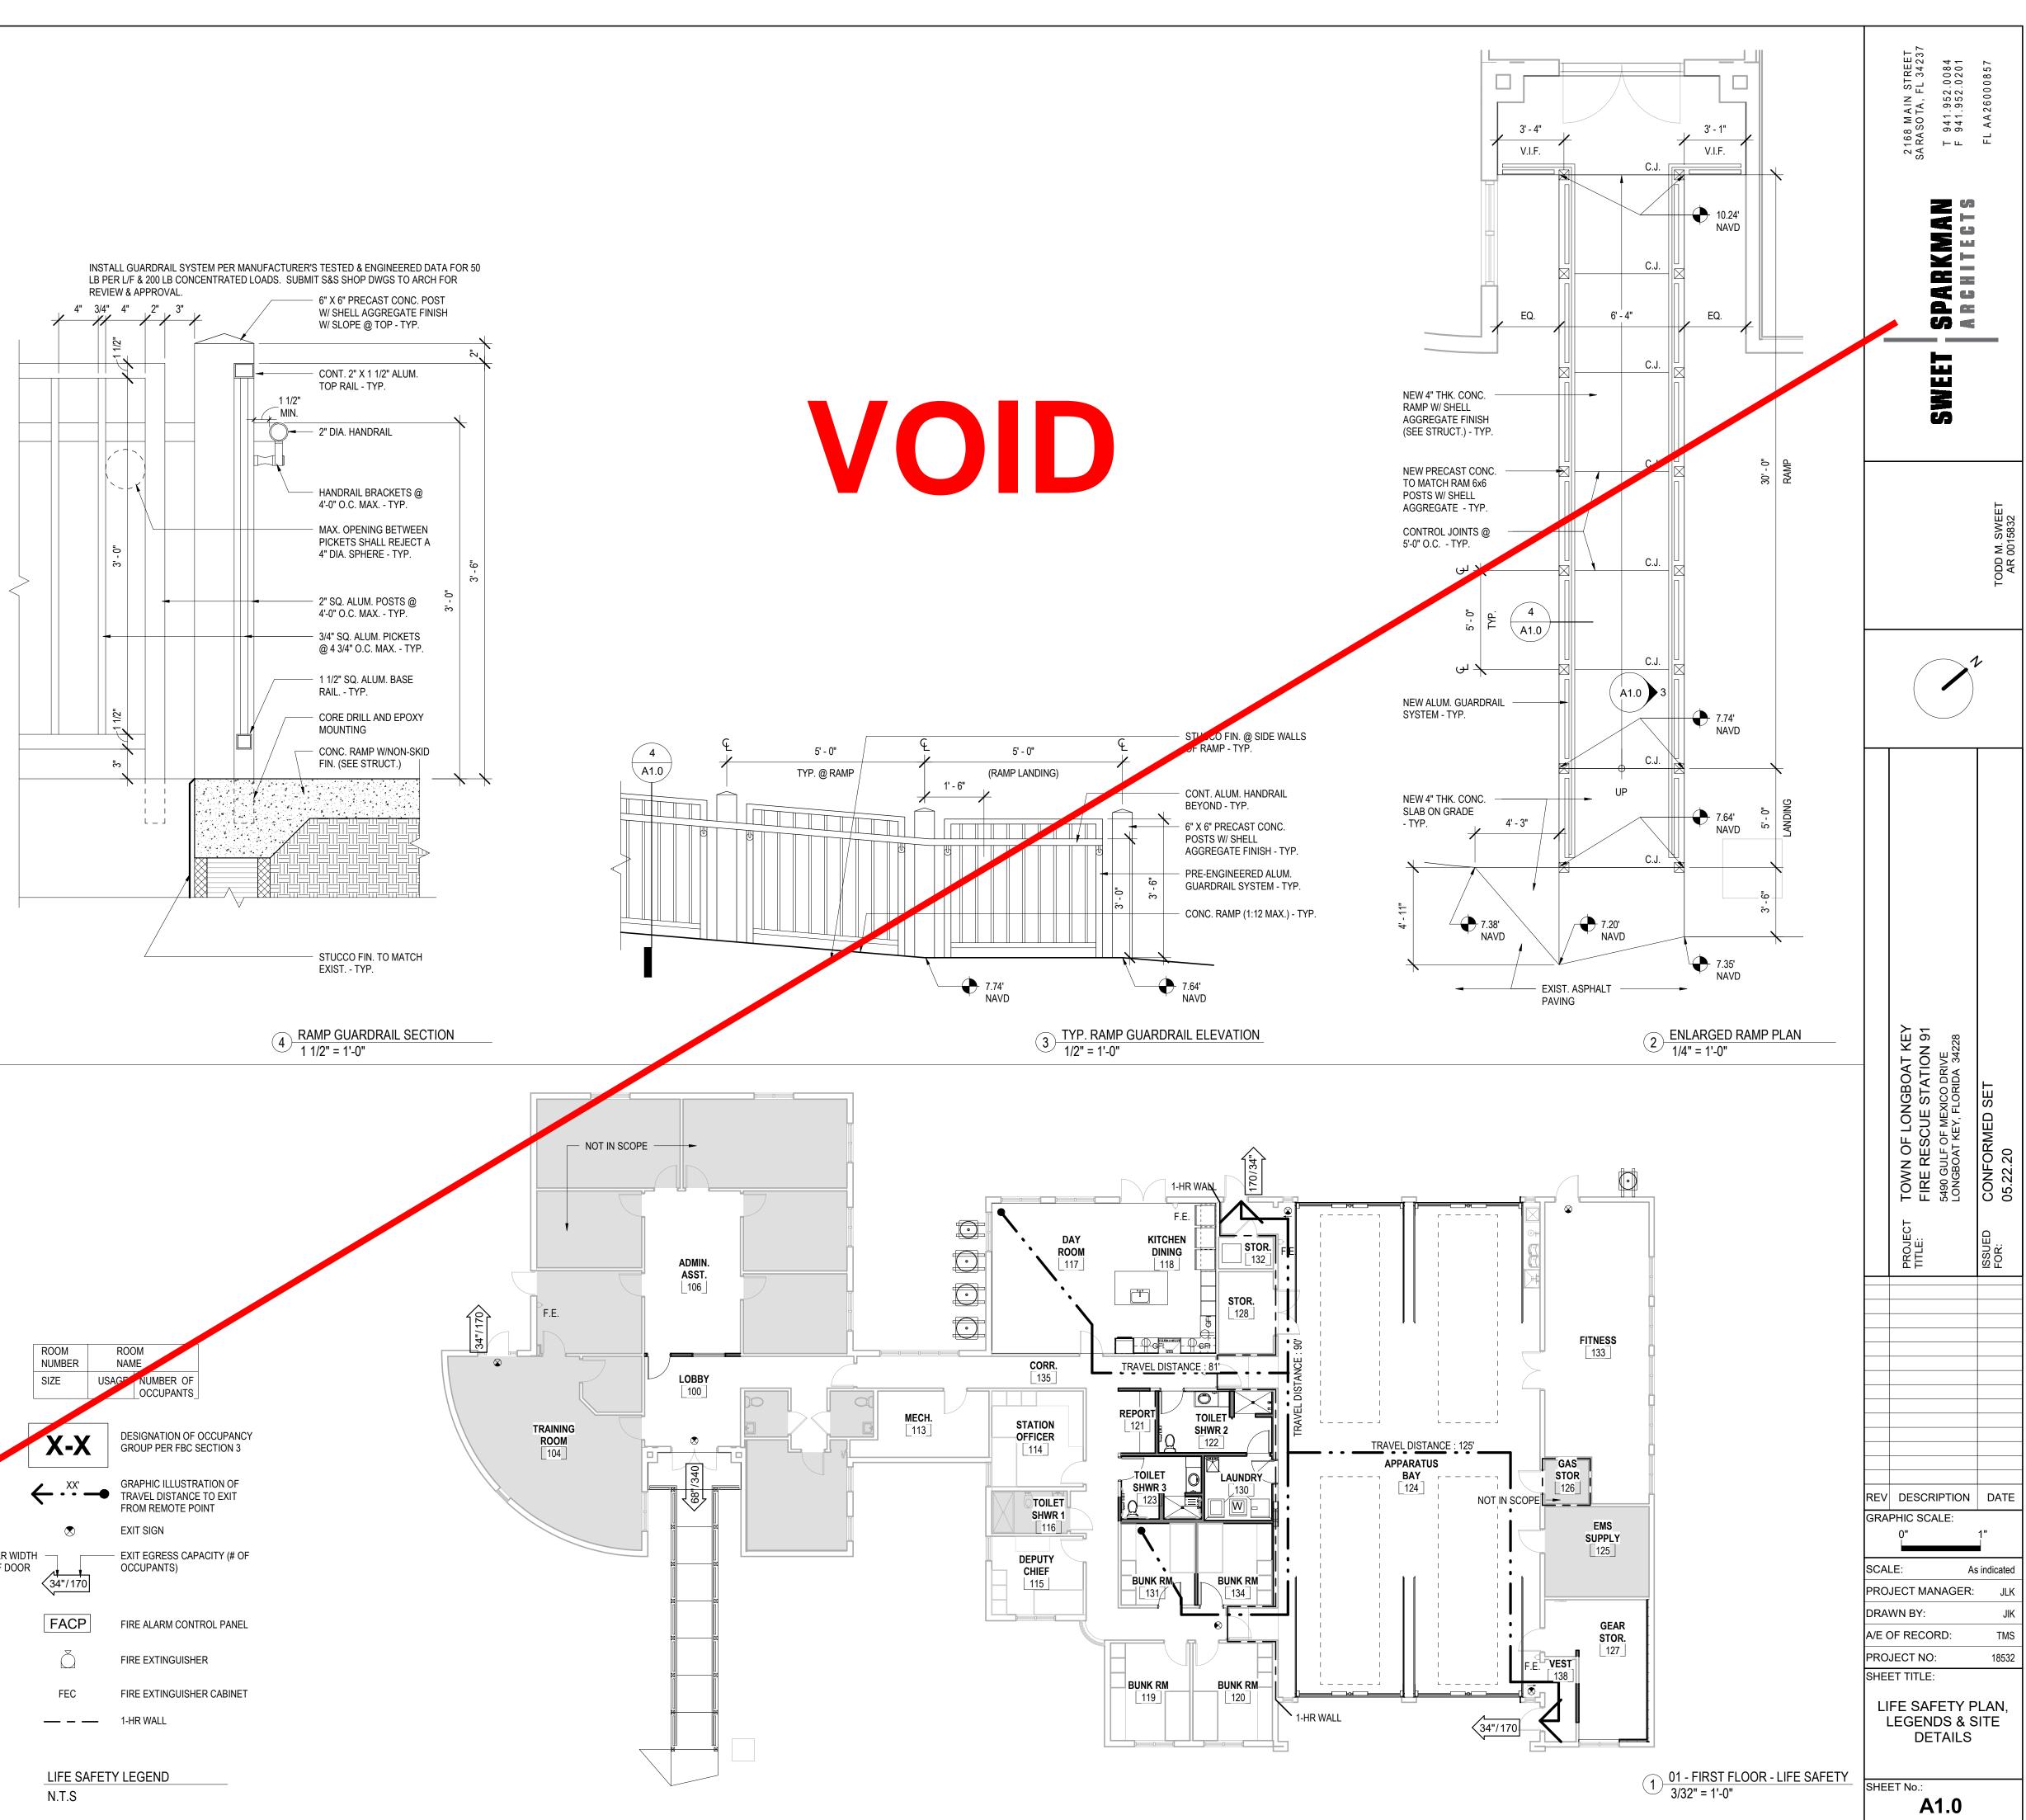


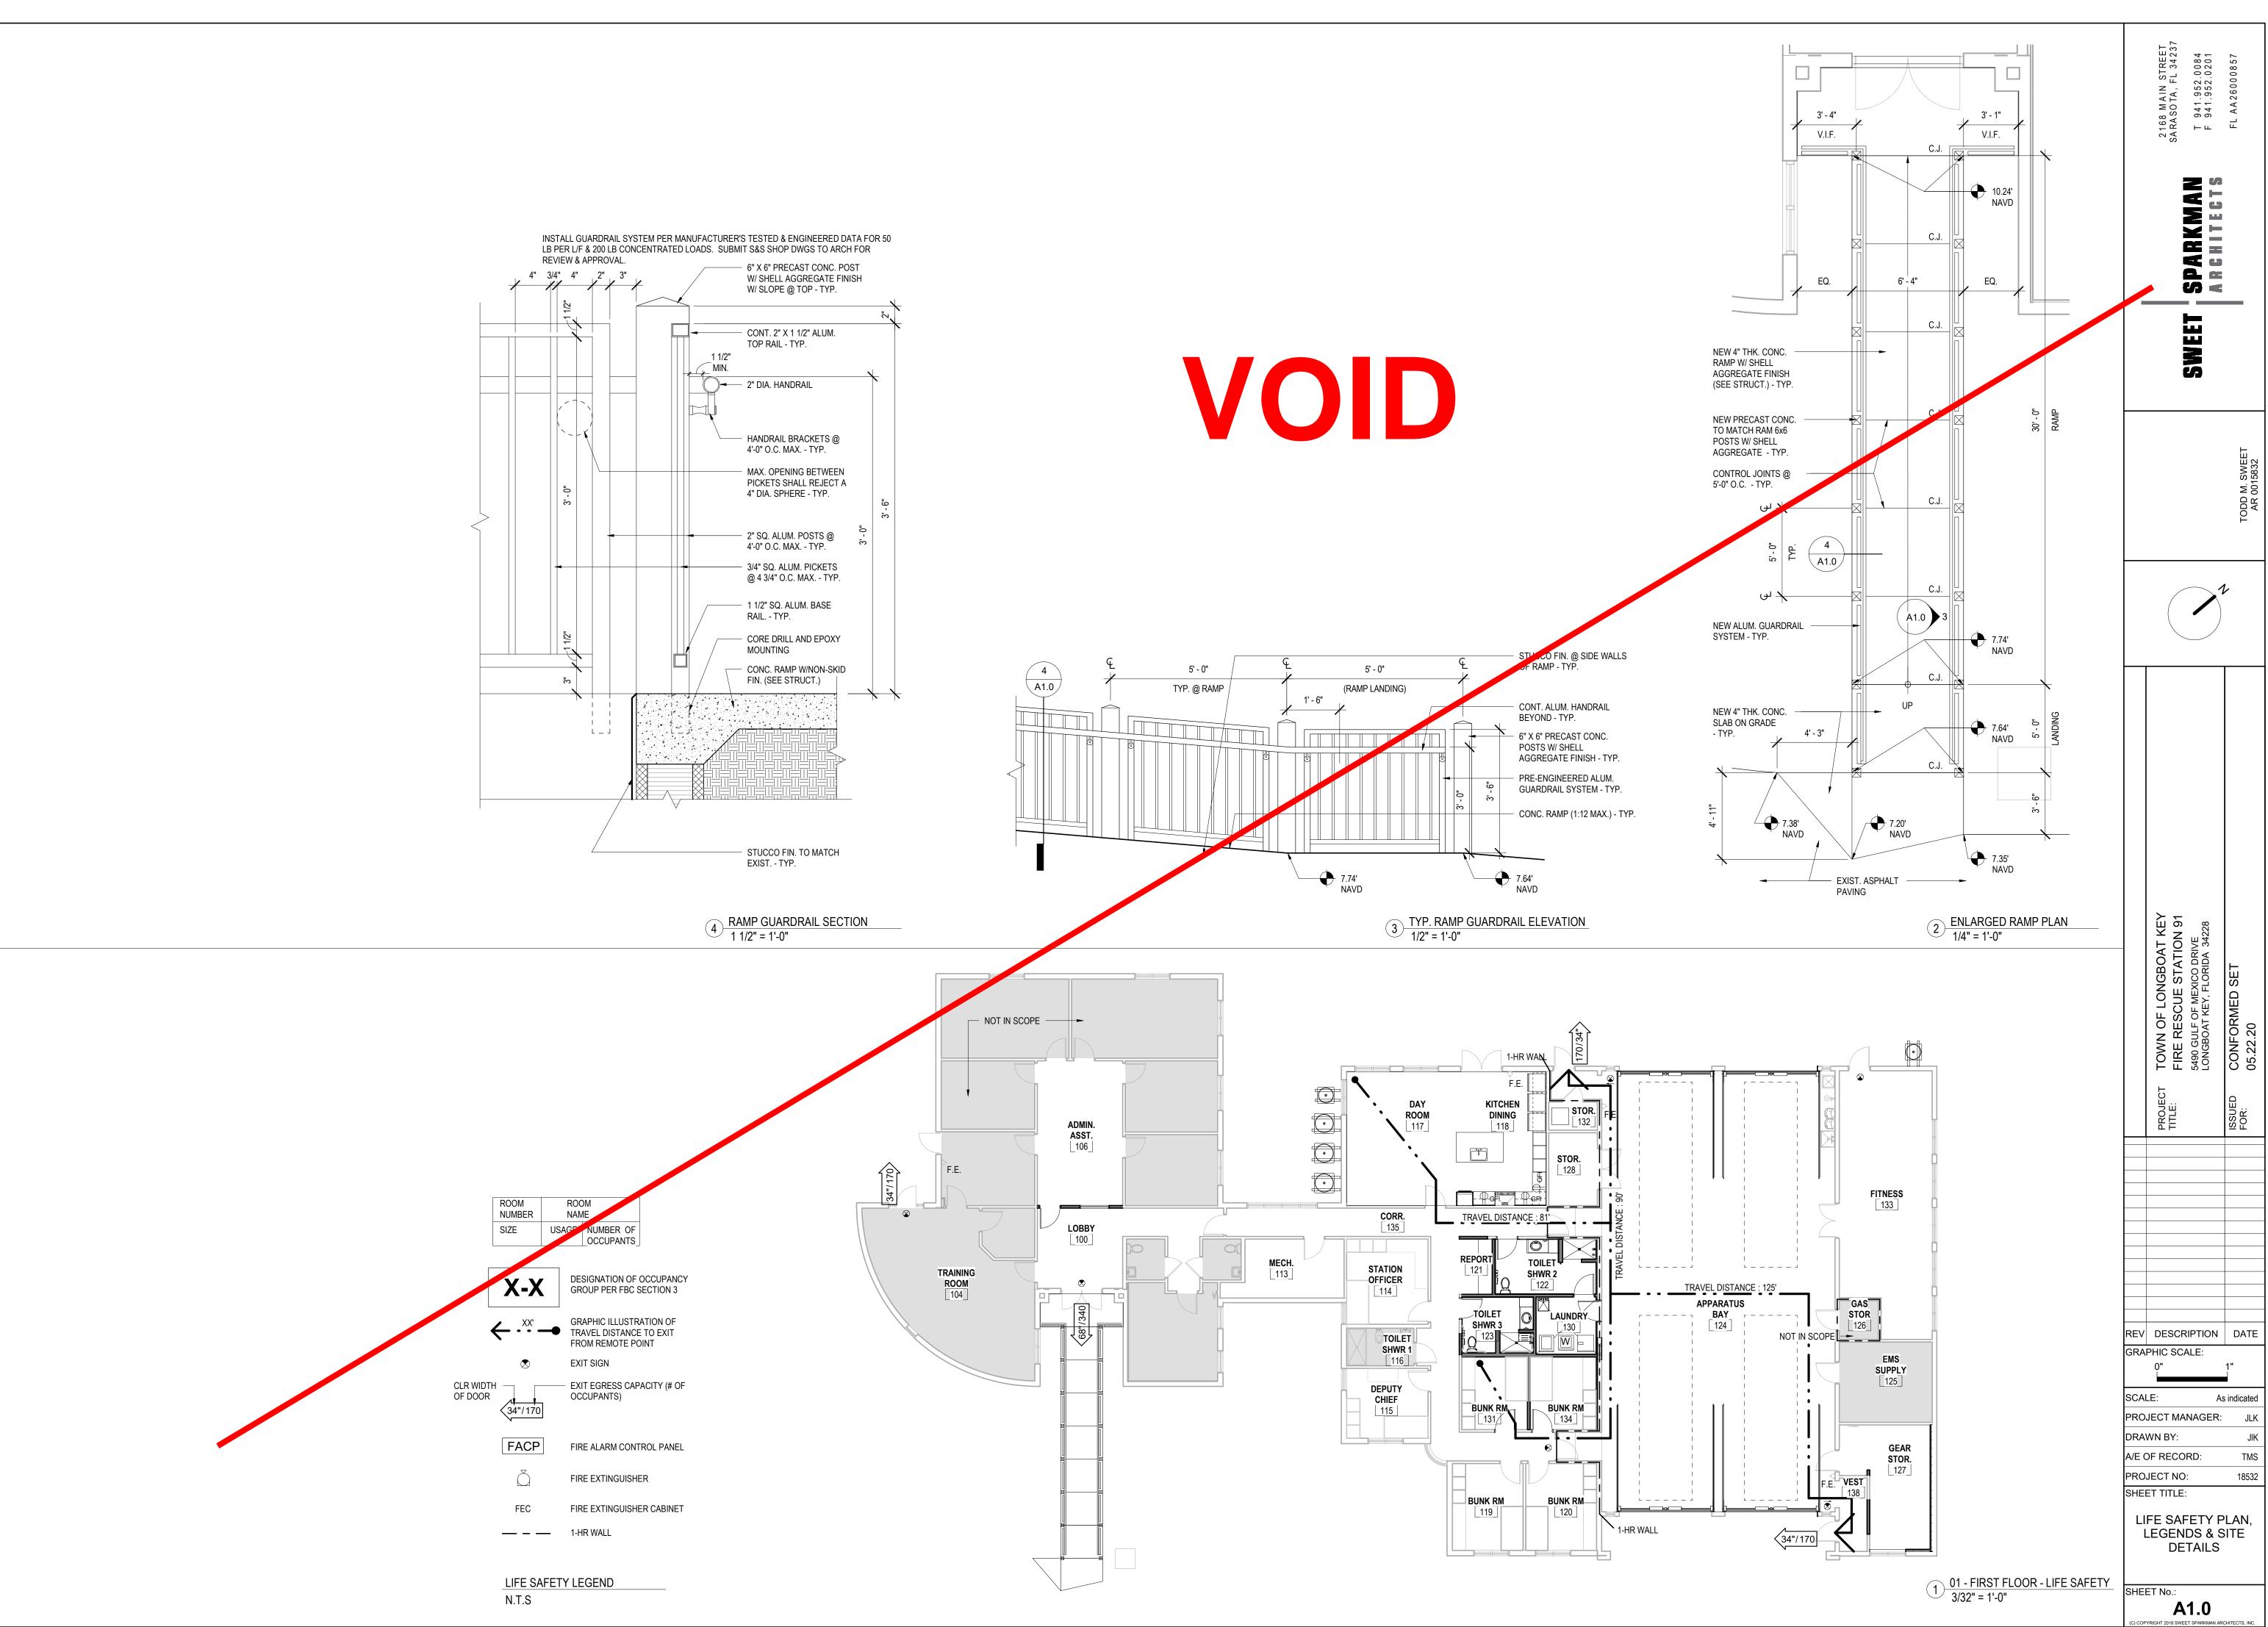

SHEET NOTES
X
1 EXISTING CONC. SLAB TO REMAIN
2 PROPOSED RELOCATION OF EXISTING CONDENSER UNITS. SEE MECH. DWGS FOR REQ. CLEARANCES - TYP.
3 RELOCATE EXISTING BED
4 REMOVE DRYWALL FINISH; ADD SPRAY FOAM INSULATION TO WALL CAVITY (FULL HEIGHT TO UNDERSIDE OF ROOF TRUSSES); INSTALL DB3 ACOUSTICAL SOUND BARRIER, INSTALL NEW DRYWALL FINISH.
5 CMU INFILL AT LOUVER OPENING. MATCH EXIST. STUCCO FINISH.
6 ALIGN FLUSH WITH EXISTING WALL
7 NEW ICE MAKER & WATER FILTRATION SYSTEM, SEE EQUIPMENT SCHEDULE THIS SHEET
9 BUNKER GEAR STORAGE, SEE LOCKER SPECIFICATION

ROOM NUMBER	ROOM NAME	FLOOR FINISH	BASE FINISH	WALL FINISH	CEILING	REMARKS
100	LOBBY	RF1	RB1	P1	EXISTING	
104	TRAINING ROOM	NIS	NIS	NIS	NIS	
106	ADMIN. ASST.	RF1	RB1	P1	EXISTING	
108	BREAK ROOM	NIS	NIS	NIS	NIS	
113	MECH.	EXISTING	EXISTING	EXISTING	EXISTING	
114	STATION OFFICER	RF1	RB1	P1	EXISTING	
115	DEPUTY CHIEF	RF1	RB1	P1	EXISTING	
116	TOILET SHWR 1	NIS	NIS	NIS	NIS	
117	DAY ROOM	RF1	RB1	P1	ACT1	
118	KITCHEN DINING	RF1	RB1	P1	ACT1/P3	
119	BUNK RM	RF1	RB1	P1	EXISTING	
120	BUNK RM	RF1	RB1	P1	EXISTING	
121	REPORT	RF1	RB1	P1	ACT1	
122	TOILET SHWR 2	T1/T2		T1/T3	P3	
122B	LIN.	T-1	WT-1	WT-1	GWB	
123	TOILET SHWR 3	T1/T2		T1/T3	P3	
123B	LIN.	T-1	WT-1	WT-1	GWB	
124	APPARATUS BAY	NA	NA	NA	P4	
125	EMS SUPPLY	NIS	NIS	NIS	NIS	
126	GAS STOR	NIS	NIS	NIS	NIS	
127	GEAR STOR.	SC	RB1	P1	ACT1	
128	STOR.	NIS	NIS	NIS	NIS	
129	ELEC.	SC	VB-1	PNT-1	ACT-1	
130	LAUNDRY	SC	RB1	P1	ACT1	
131	BUNK RM	RF1	RB1	P1	ACT1	
132	STOR.	NIS	NIS	NIS	NIS	
133	FITNESS	EXISTING	EXISTING	EXISTING	ACT1	
134	BUNK RM	RF1	RB1	P1	ACT1	
135	CORR.	RF1	RB1	P1	EXISTING	
138	VEST	SC	RB1	P1	ACT1	
139	GARAGE	NIS	NIS	NIS	NIS	
140	GARAGE	SC	VB-1	PNT-1	N/A	
141	VEST	NIS	NIS	NIS	NIS	

ITEM	DESCRIPTION	BY
REF	REFRIGERATOR : 26 CU.FT. FRENCH DOORS FREEZER DRAWER	CFCI
ICE	ICE MACHINE : HOSHIZAKI AMERICA, INC. CUBER: KML-351-MAH (AIR COOLED) BIN: B-250	CFCI
DW	DISHWASHER : TOP CONTROL BUILT-IN TALL TUB DISHWASHER W/ FAN DRY, 51 DBA	CFCI
MW	MICROWAVE : 1.6 CU. FT. COUNTERTOP MICROWAVE W/ 1,200 - WATT COOKING POWER	CFCI
OVN	DOUBLE OVEN : 30" DOUBLE ELECTRIC WALL OVEN, SELF-CLEANING WITH CONVECTION AND EASY CLEAN	CFCI
GR	GAS RANGE : 36" ALL GAS PROFESSIONAL RANGE, FRONT CONTROLS	CFCI
HD	HOOD : SEE INTERIOR ELEVATION AND MECHANICAL ENGINEERS SPECIFICATIONS FOR HOOD REQUIREMENTS	CFCI
CM	COFFEE MAKER : CUISINART 12-CUP PROGRAMMABLE BLACK DRIP COFFEE MAKER W/ AUTOMATIC SHUT-OFF AND HOT WATER SIDE FEATURE	CFCI
APPLIANCE	RES ABOVE ARE BASIS OF DESIGN. ALL MAJOR IS TO BE FROM THE SAME PRODUCT LINE. FIXT ESS STEEL FINGERPROOF RESISTANT. $\bigcirc \frac{EQUIPMENT SCHED}{3/16" = 1'-0"}$	TURES TO
X-X REF	_EGEND ER TO A0.2 FOR INTERIOR PARTITION TYPES. ER TO WALL SECTIONS FOR EXTERIOR WALL A EXISTING WALLS.	SSEMBLIES.

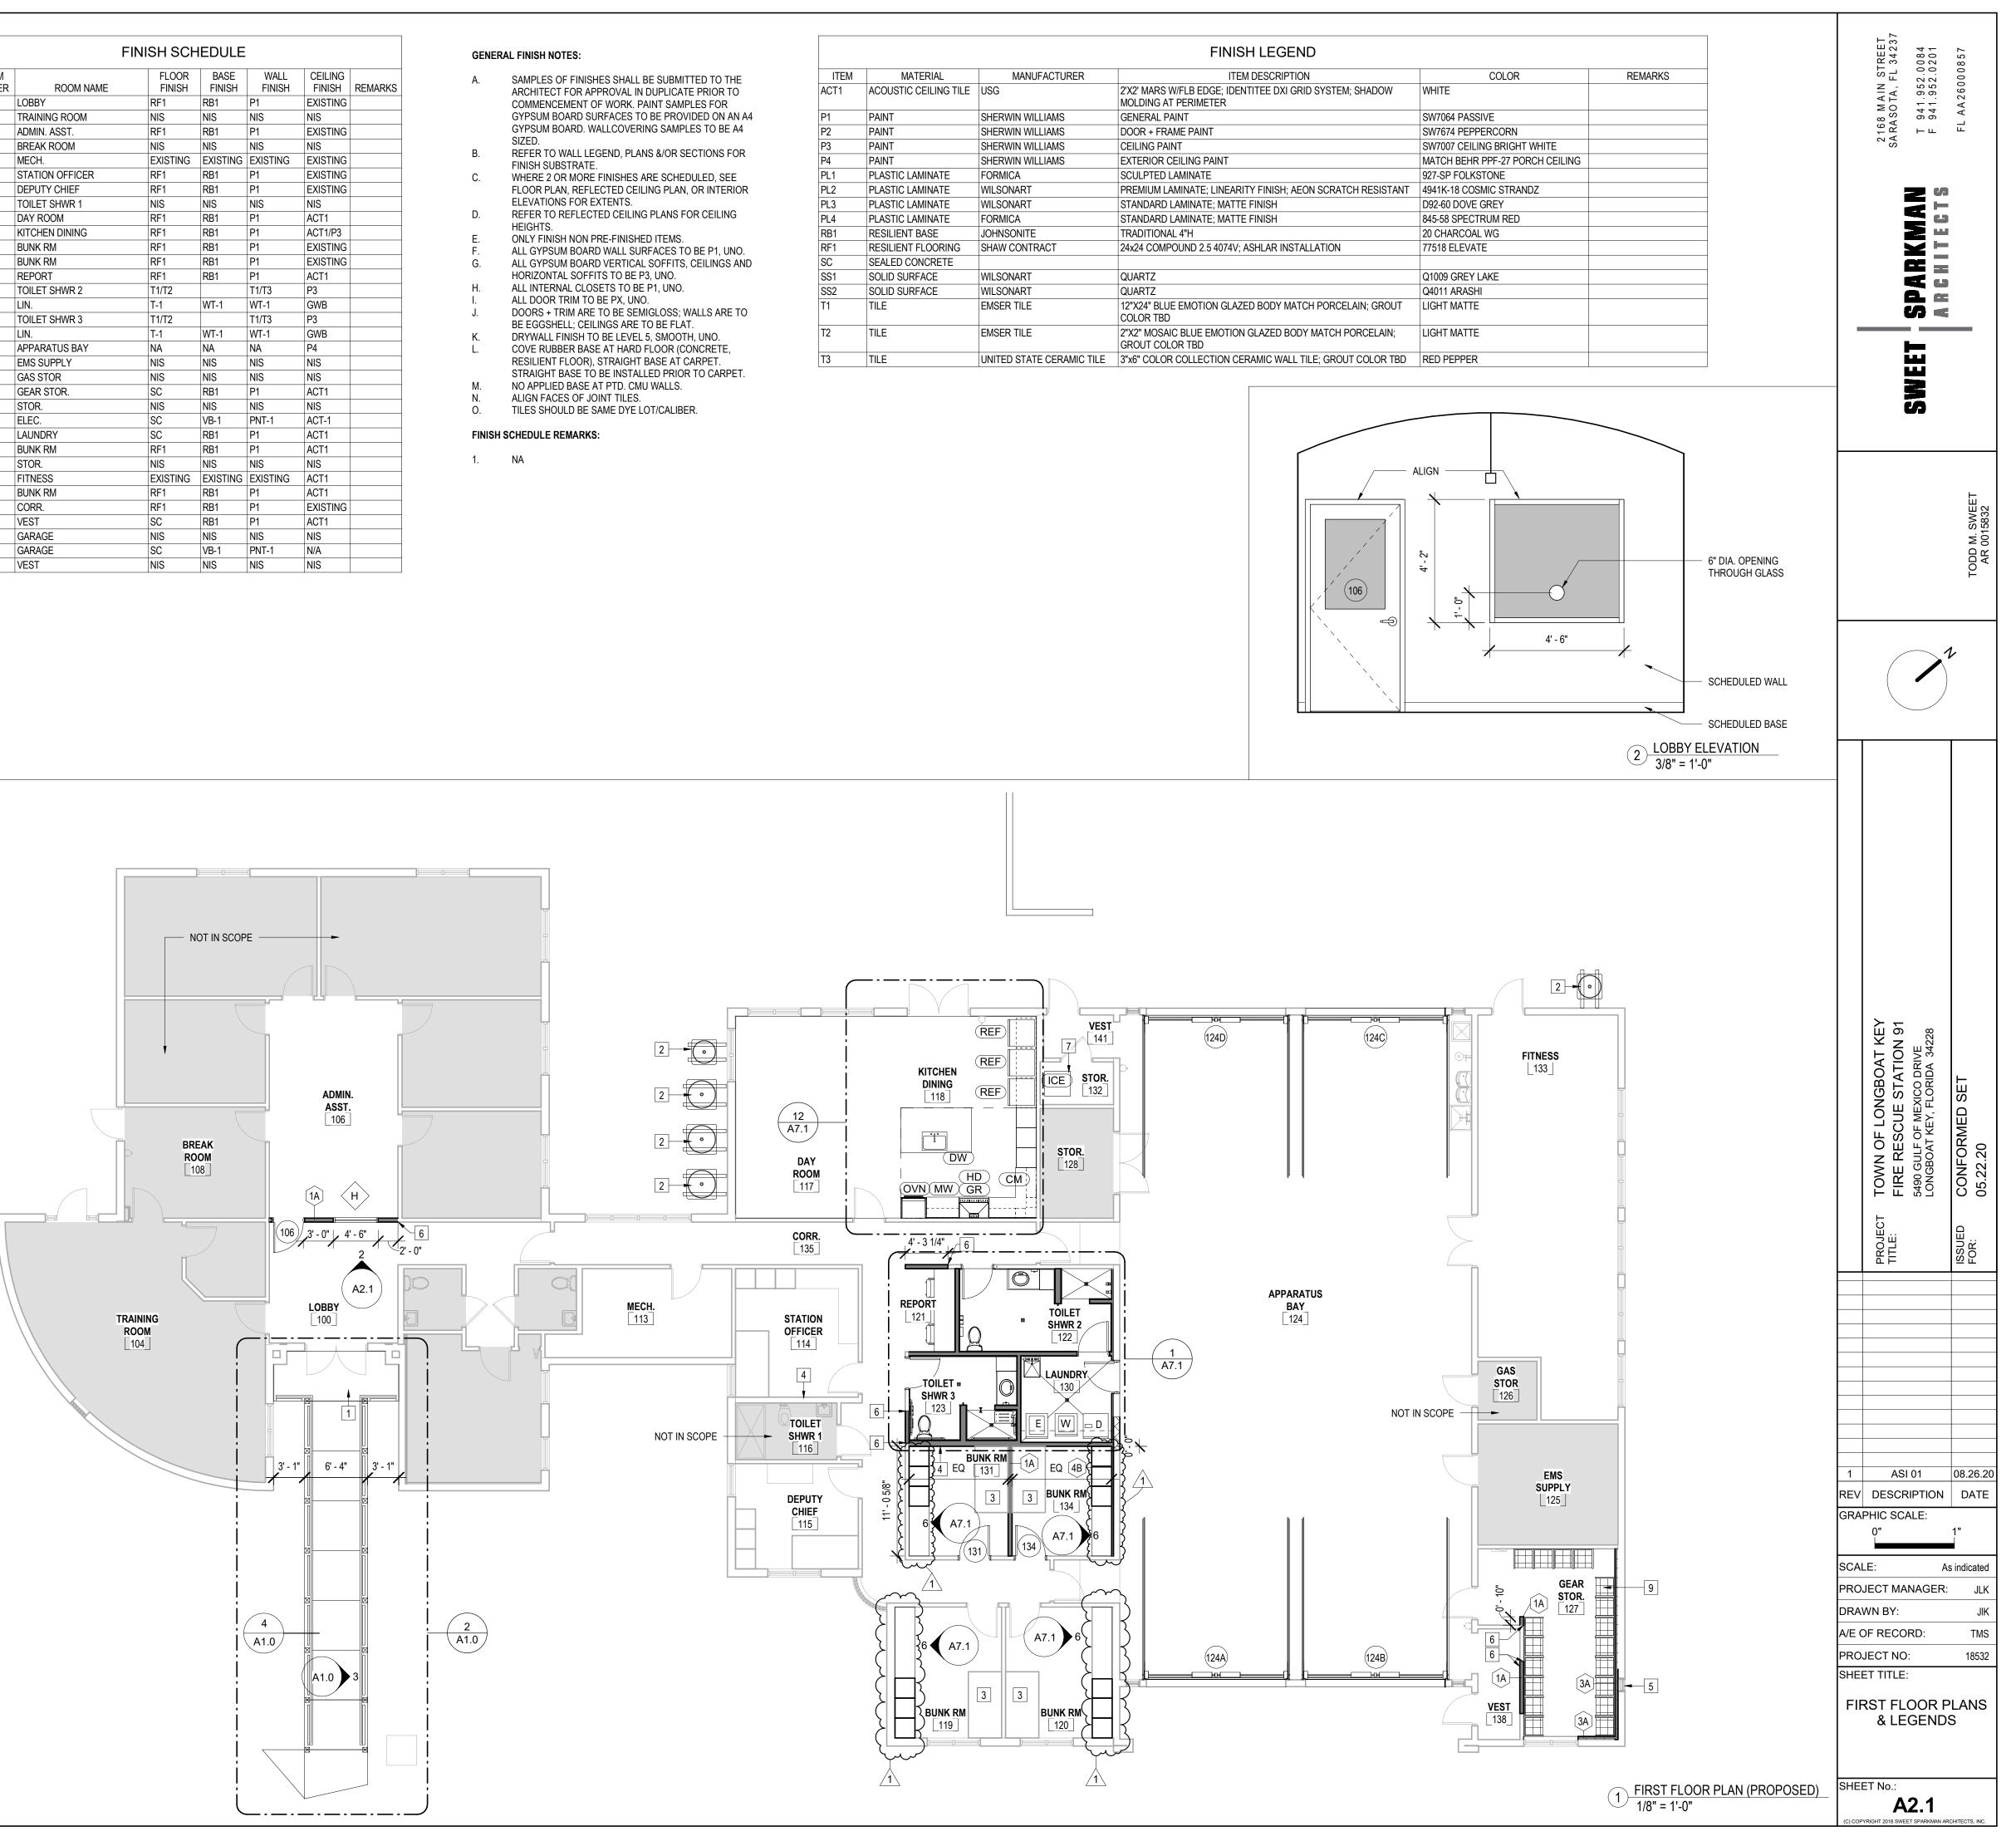

NEW CMU WALLS. FURRING/FACING CONDITIONS MAY VARY BY TYPE NEW STUD WALLS. FACING CONDITIONS MAY VARY BY TYPE

 $\times\!\!\times\!\!\times\!\!\times\!\!\times\!\!\times$


ITEM	MATERIAL	MANUFACTURER	
ACT1	ACOUSTIC CEILING TILE	USG	2'X2' MARS W MOLDING AT
P1	PAINT	SHERWIN WILLIAMS	GENERAL PA
P2	PAINT	SHERWIN WILLIAMS	DOOR + FRA
P3	PAINT	SHERWIN WILLIAMS	CEILING PAIN
P4	PAINT	SHERWIN WILLIAMS	EXTERIOR C
PL1	PLASTIC LAMINATE	FORMICA	SCULPTED L
PL2	PLASTIC LAMINATE	WILSONART	PREMIUM LA
PL3	PLASTIC LAMINATE	WILSONART	STANDARD L
PL4	PLASTIC LAMINATE	FORMICA	STANDARD L
RB1	RESILIENT BASE	JOHNSONITE	TRADITIONA
RF1	RESILIENT FLOORING	SHAW CONTRACT	24x24 COMP
SC	SEALED CONCRETE		
SS1	SOLID SURFACE	WILSONART	QUARTZ
SS2	SOLID SURFACE	WILSONART	QUARTZ
T1	TILE	EMSER TILE	12"X24" BLUE COLOR TBD
T2	TILE	EMSER TILE	2"X2" MOSAI GROUT COL
Т3	TILE	UNITED STATE CERAMIC TILE	3"x6" COLOR


SHEET NOTES
X
SHEET APPLY ONLY TO THE NUMBERED NOTES IN

ROOM		FINISH SCHEDUL	WALL CEIL	ING	GENEF A.	AL FINISH NOTES: SAMPLES OF FINISHES SHALL BE SUBMITTED TO THE	ITEM	MATERIAL	MANUFACTURER	
	ROOM NAME	FINISH FINISH RF1 RB1	P1 EXIS			ARCHITECT FOR APPROVAL IN DUPLICATE PRIOR TO COMMENCEMENT OF WORK. PAINT SAMPLES FOR	ACT1	ACOUSTIC CEILING TILI		2'X2' MARS W MOLDING AT
)6	TRAINING ROOM ADMIN. ASST.	NIS NIS RF1 RB1	NIS NIS P1 EXIS	TING		GYPSUM BOARD SURFACES TO BE PROVIDED ON AN A4 GYPSUM BOARD. WALLCOVERING SAMPLES TO BE A4 SIZED.	P2	PAINT PAINT	SHERWIN WILLIAMS SHERWIN WILLIAMS	GENERAL PA
3	BREAK ROOM MECH.		NIS NIS G EXISTING EXIS		В.	REFER TO WALL LEGEND, PLANS &/OR SECTIONS FOR FINISH SUBSTRATE.	P3 P4	PAINT PAINT	SHERWIN WILLIAMS SHERWIN WILLIAMS	CEILING PAIN EXTERIOR CE
5	STATION OFFICER DEPUTY CHIEF TOILET SHWR 1	RF1 RB1 RF1 RB1 NIS NIS	P1 EXIS P1 EXIS NIS NIS		C.	WHERE 2 OR MORE FINISHES ARE SCHEDULED, SEE FLOOR PLAN, REFLECTED CEILING PLAN, OR INTERIOR ELEVATIONS FOR EXTENTS.	PL1 PL2	PLASTIC LAMINATE PLASTIC LAMINATE	FORMICA WILSONART	SCULPTED LA PREMIUM LAI
7	DAY ROOM KITCHEN DINING	RF1 RB1	P1 ACT1		D.	REFER TO REFLECTED CEILING PLANS FOR CEILING HEIGHTS.	PL3 PL4 RB1	PLASTIC LAMINATE PLASTIC LAMINATE RESILIENT BASE	WILSONART FORMICA JOHNSONITE	STANDARD L STANDARD L TRADITIONAL
)	BUNK RM BUNK RM	RF1 RB1 RF1 RB1 RF1 RB1	P1 ACTI P1 EXIS P1 EXIS	TING	E. F.	ONLY FINISH NON PRE-FINISHED ITEMS. ALL GYPSUM BOARD WALL SURFACES TO BE P1, UNO.	RF1 SC	RESILIENT BASE RESILIENT FLOORING SEALED CONCRETE	SHAW CONTRACT	24x24 COMPC
1	REPORT TOILET SHWR 2	RF1 RB1 T1/T2	P1 EXIS P1 ACT1 T1/T3 P3		G. H.	ALL GYPSUM BOARD VERTICAL SOFFITS, CEILINGS AND HORIZONTAL SOFFITS TO BE P3, UNO. ALL INTERNAL CLOSETS TO BE P1, UNO.	SC SS1 SS2	SOLID SURFACE SOLID SURFACE	WILSONART	QUARTZ
2B	LIN. TOILET SHWR 3	T-1 WT-1 T1/T2	T1/13 F3 WT-1 GWB T1/T3 P3		I. J.	ALL DOOR TRIM TO BE PX, UNO. DOORS + TRIM ARE TO BE SEMIGLOSS; WALLS ARE TO	552 T1	TILE	EMSER TILE	12"X24" BLUE COLOR TBD
B	LIN. APPARATUS BAY	T-1 WT-1 NA NA	WT-1 GWB NA P4		K. L.	BE EGGSHELL; CEILINGS ARE TO BE FLAT. DRYWALL FINISH TO BE LEVEL 5, SMOOTH, UNO. COVE RUBBER BASE AT HARD FLOOR (CONCRETE,	T2	TILE	EMSER TILE	2"X2" MOSAIC GROUT COLC
5	EMS SUPPLY GAS STOR	NIS NIS NIS NIS	NIS NIS NIS NIS		L.	RESILIENT FLOOR), STRAIGHT BASE AT CARPET. STRAIGHT BASE TO BE INSTALLED PRIOR TO CARPET.	Т3	TILE	UNITED STATE CERAMIC 1	ILE 3"x6" COLOR
	GEAR STOR. STOR.	SC RB1 NIS NIS	P1 ACT1 NIS NIS		M. N.	NO APPLIED BASE AT PTD. CMU WALLS. ALIGN FACES OF JOINT TILES.				
	ELEC.	SC VB-1 SC RB1	PNT-1 ACT- P1 ACT1		o. Finish	TILES SHOULD BE SAME DYE LOT/CALIBER. SCHEDULE REMARKS:				
	BUNK RM STOR.	RF1 RB1 NIS NIS	P1 ACT1 NIS NIS		1.	NA				
	FITNESS BUNK RM		G EXISTING ACT1							
	CORR. VEST	RF1 RB1 SC RB1	P1 EXIS P1 ACT1	TING		_				
)	GARAGE	NIS NIS SC VB-1	NIS NIS PNT-1 N/A							
1	VEST	NIS NIS	NIS NIS							
				DMIN.				KITCHEN DINING 118		/EST 141 OR. 32
		BREAK ROOM 108	(1A)	106			DAY ROOM 117			
			(106) _3' - 0'	' _ 4'-6"	6		CORR			
		Ĩ		2 2'-	0"		CORR.	4' - 3 1/4"		
			LOB	A2.1		MECH.		REPORT		
\		RAINING ROOM					STATION OFFICER		TOILET SHWR 2	
		104								
								TOILET =	LAUNDRY 130	
							TOILET			
				K			SHWR 1 116			
			3' - 1" (5' - 4" 3' - 1"				₩ <u> </u> 4 EQ	L131 UN EQ (4B	2 0.
				X		 	DEPUTY <u>Chief</u>	11 0 5/8"	3 3 BUNK RM	
							115	6 A7.	1 131 A7.1	6—
					İ					
					ļ					
			4							
			A1.0		A1.0			6 A7.1	A7.1 6	
			A1.	0 3					3 3	╽╽┝═┢══
								BUNK 1 119	RM BUNK RM	
				×	Ì					


ITEM	DESCRIPTION	BY
REF	REFRIGERATOR : 26 CU.FT. FRENCH DOORS FREEZER DRAWER	CFCI
	ICE MACHINE : HOSHIZAKI AMERICA, INC. CUBER: KML-351-MAH (AIR COOLED) BIN: B-250	CFCI
DW	DISHWASHER : TOP CONTROL BUILT-IN TALL TUB DISHWASHER W/ FAN DRY, 51 DBA	CFCI
MW	MICROWAVE : 1.6 CU. FT. COUNTERTOP MICROWAVE W/ 1,200 - WATT COOKING POWER	CFCI
OVN	DOUBLE OVEN : 30" DOUBLE ELECTRIC WALL OVEN, SELF-CLEANING WITH CONVECTION AND EASY CLEAN	CFCI
GR	GAS RANGE : 36" ALL GAS PROFESSIONAL RANGE, FRONT CONTROLS	CFCI
HD	HOOD : SEE INTERIOR ELEVATION AND MECHANICAL ENGINEERS SPECIFICATIONS FOR HOOD REQUIREMENTS	CFCI
CM	COFFEE MAKER : CUISINART 12-CUP PROGRAMMABLE BLACK DRIP COFFEE MAKER W/ AUTOMATIC SHUT-OFF AND HOT WATER SIDE FEATURE	CFCI
	EQUIPMENT SCHED 3/16" = 1'-0"	ULE
WALL I	EGEND	
	ER TO A0.2 FOR INTERIOR PARTITION TYPES. ER TO WALL SECTIONS FOR EXTERIOR WALL A	SSEMBLIES
	EXISTING WALLS.	
	NEW CMU WALLS. FURRING/FACIN CONDITIONS MAY VARY BY TYPE	G


NEW STUD WALLS. FACING CONDITIONS MAY VARY BY TYPE

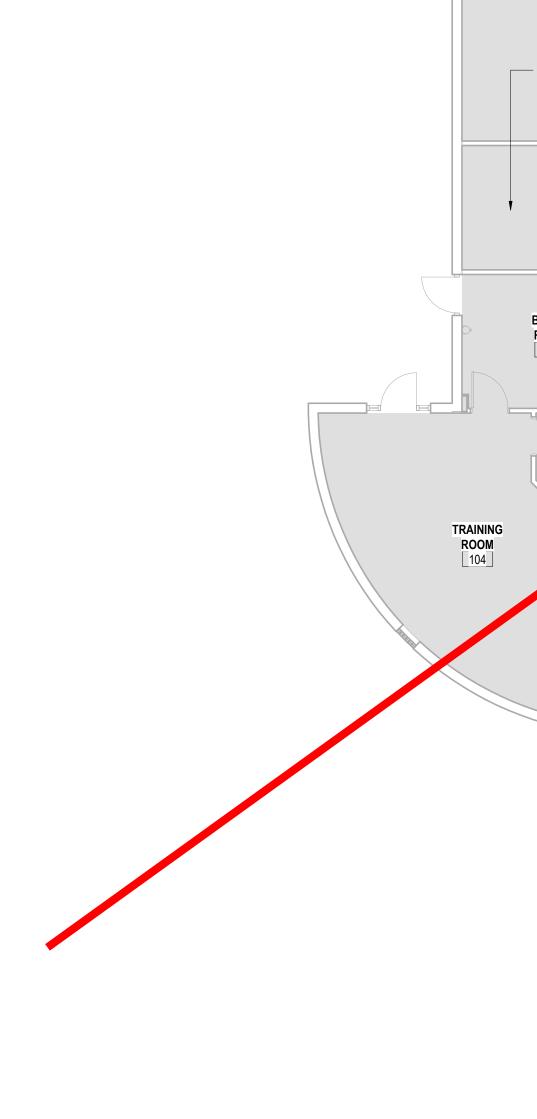

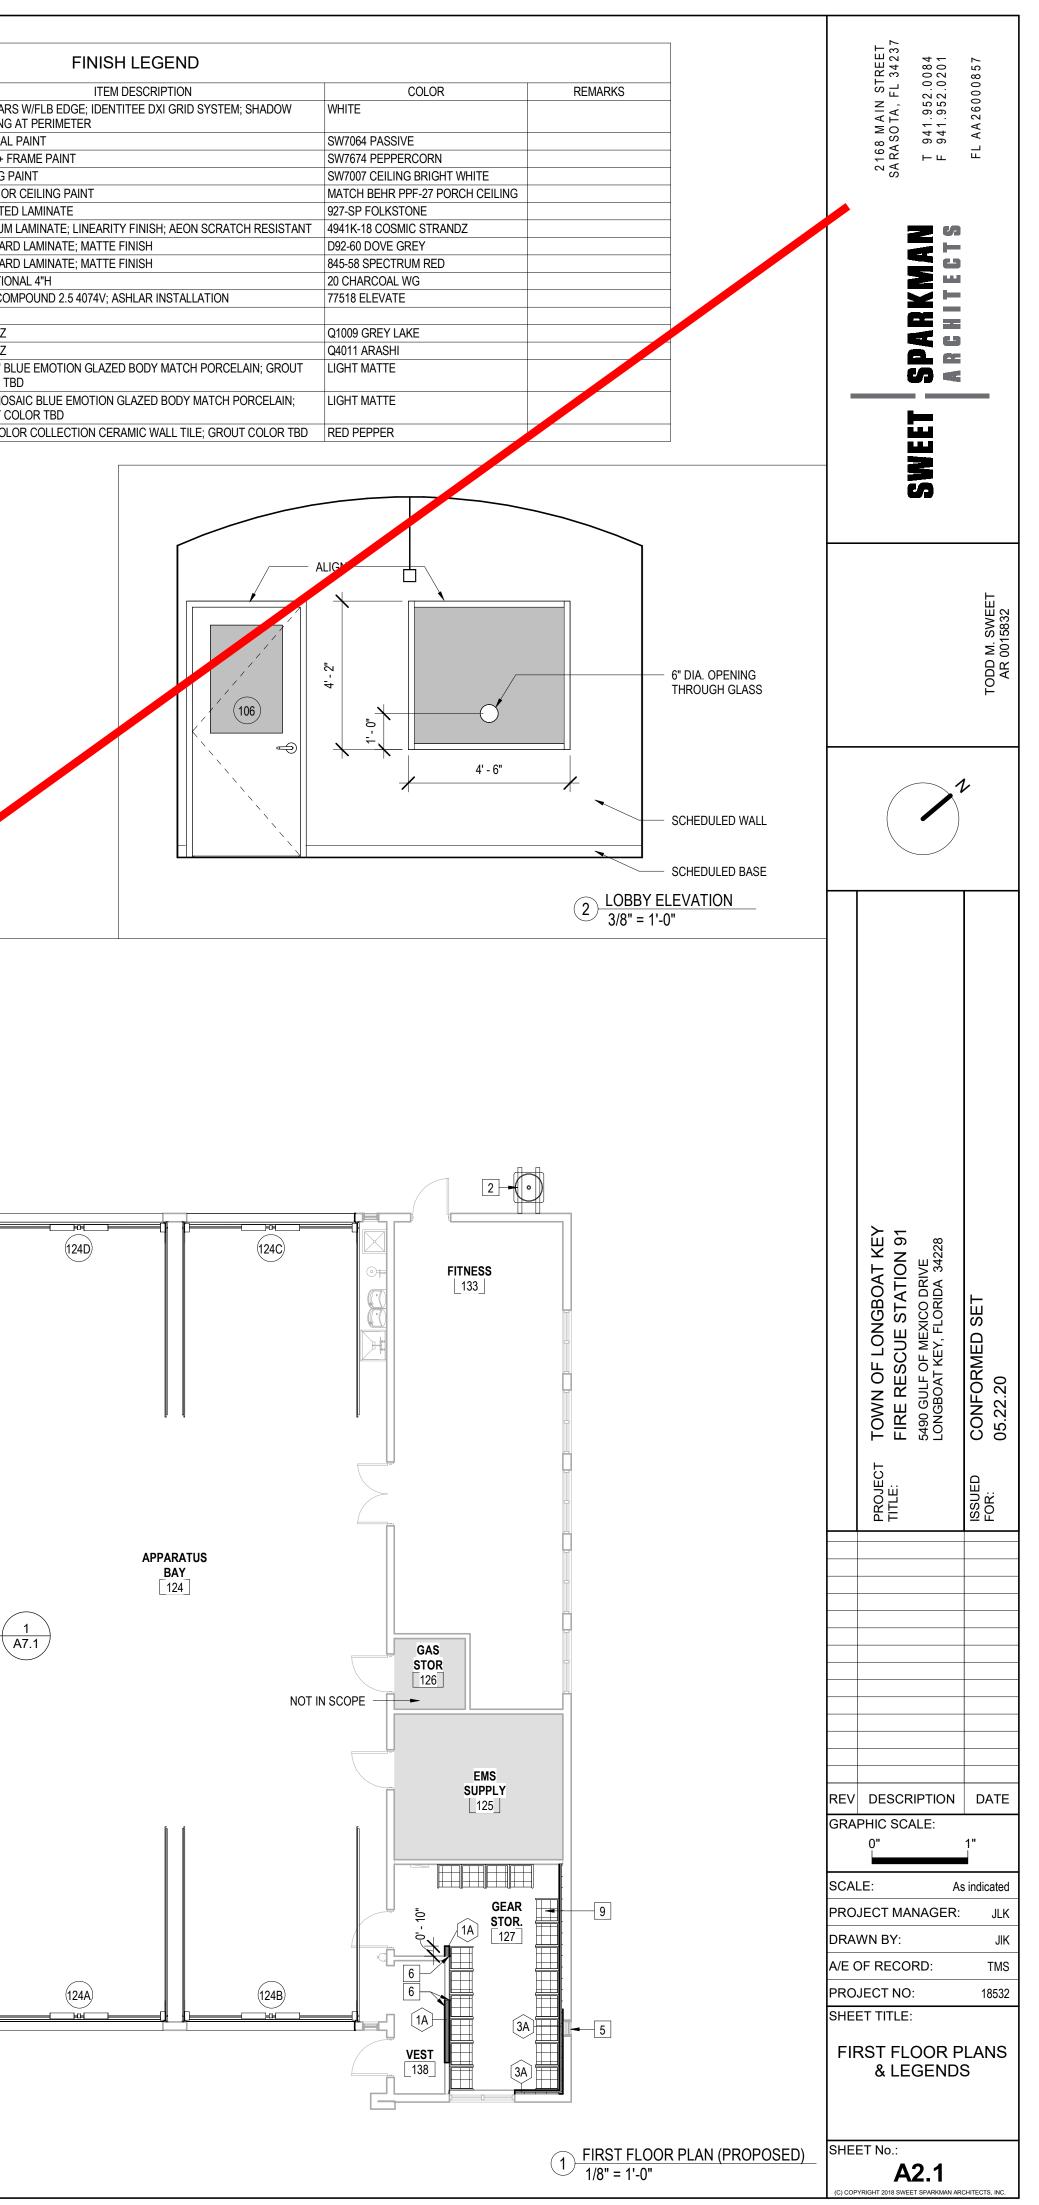



SHEET NOTES X - NUMBERED NO SHEET APPLY THE TABLE BE	DTES SHOWN IN DRAWINGS ON THIS ONLY TO THE NUMBERED NOTES IN LOW.	
1 1-HR FIRE RATED CEILI	NG	
~ ^		
	CEILING FAN	
\checkmark		
	ACOUSTICAL PANEL CEILING	
	MOISTURE RESISTANT GYPSUM	
	BOARD CEILING	
	2' X 2' FLUORESCENT LIGHT FIXTURE	
	2' X 4' FLUORESCENT LIGHT FIXTURE	TRAINING ROOM 104
	SUSPENDED LIGHT FIXTURE	
	EXHAUST FAN	
	MECHANICAL SUPPLY DIFFUSER	
	MECHANICAL RETURN DIFFUSER	
•	EXIT SIGN SPRINKLER	
0	RECESSED LIGHT	
~~~	CEILING FINISH	
REFLECTED CEILIN	G LEGEND	

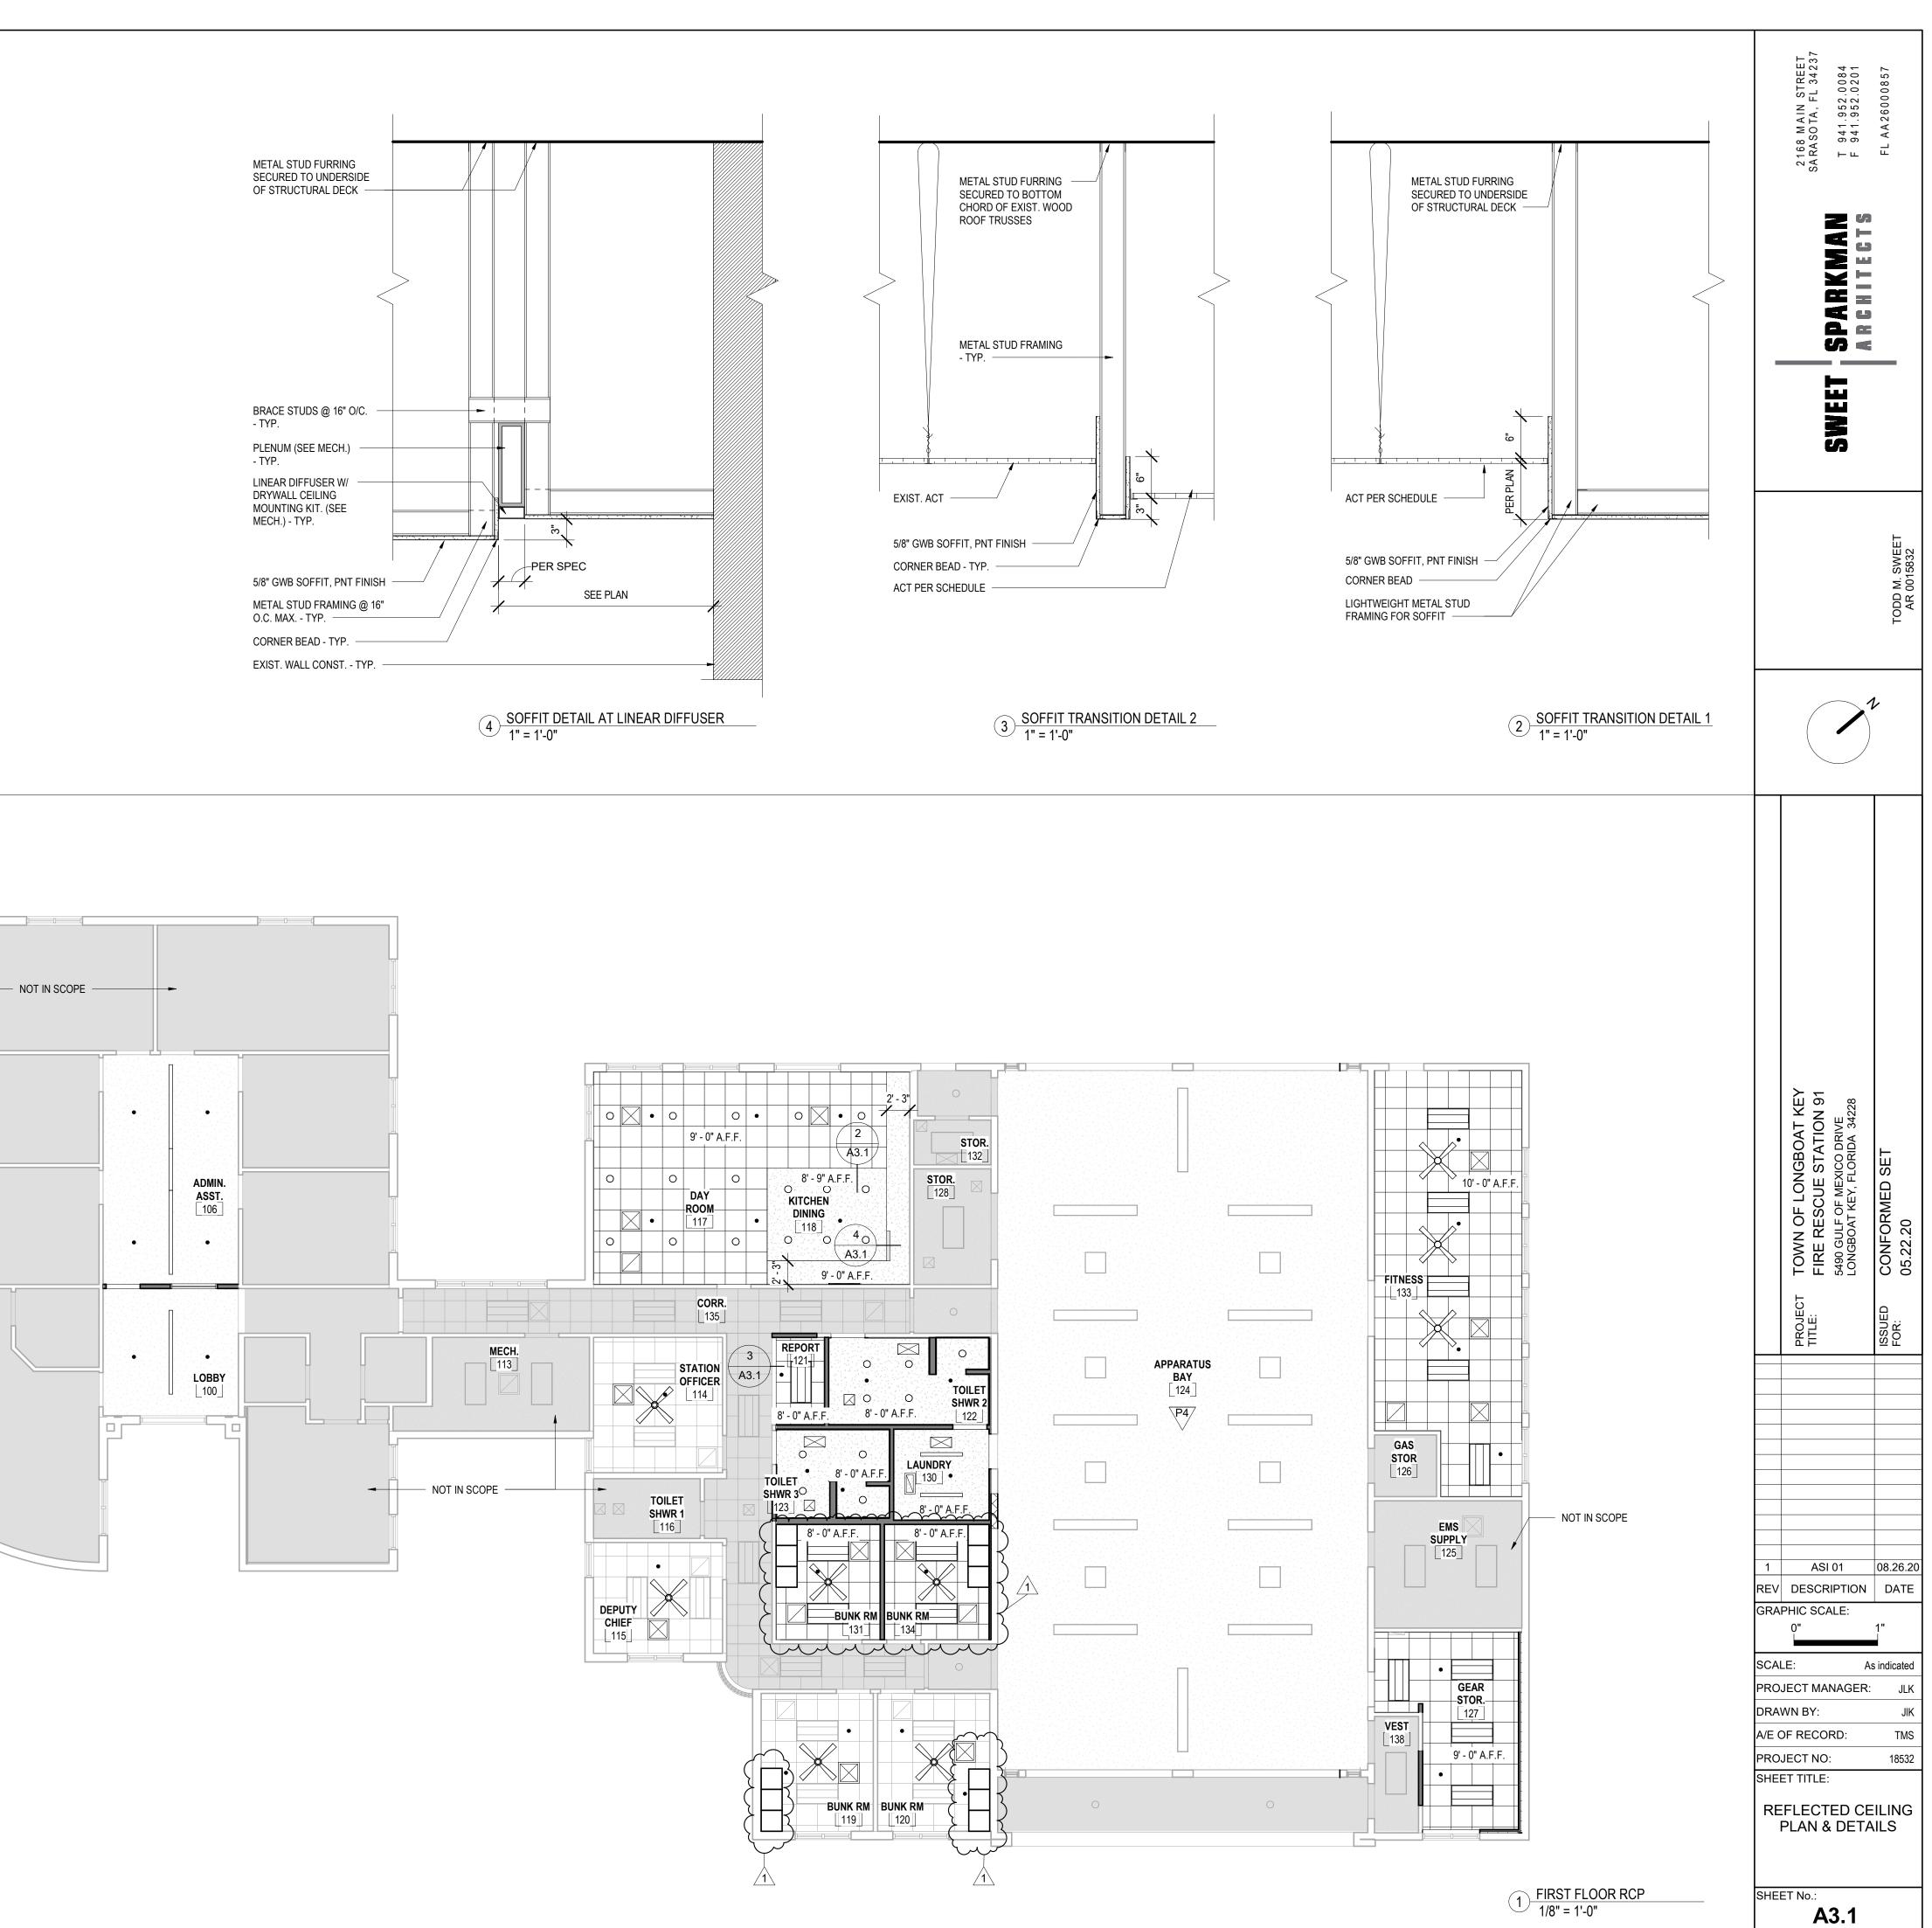

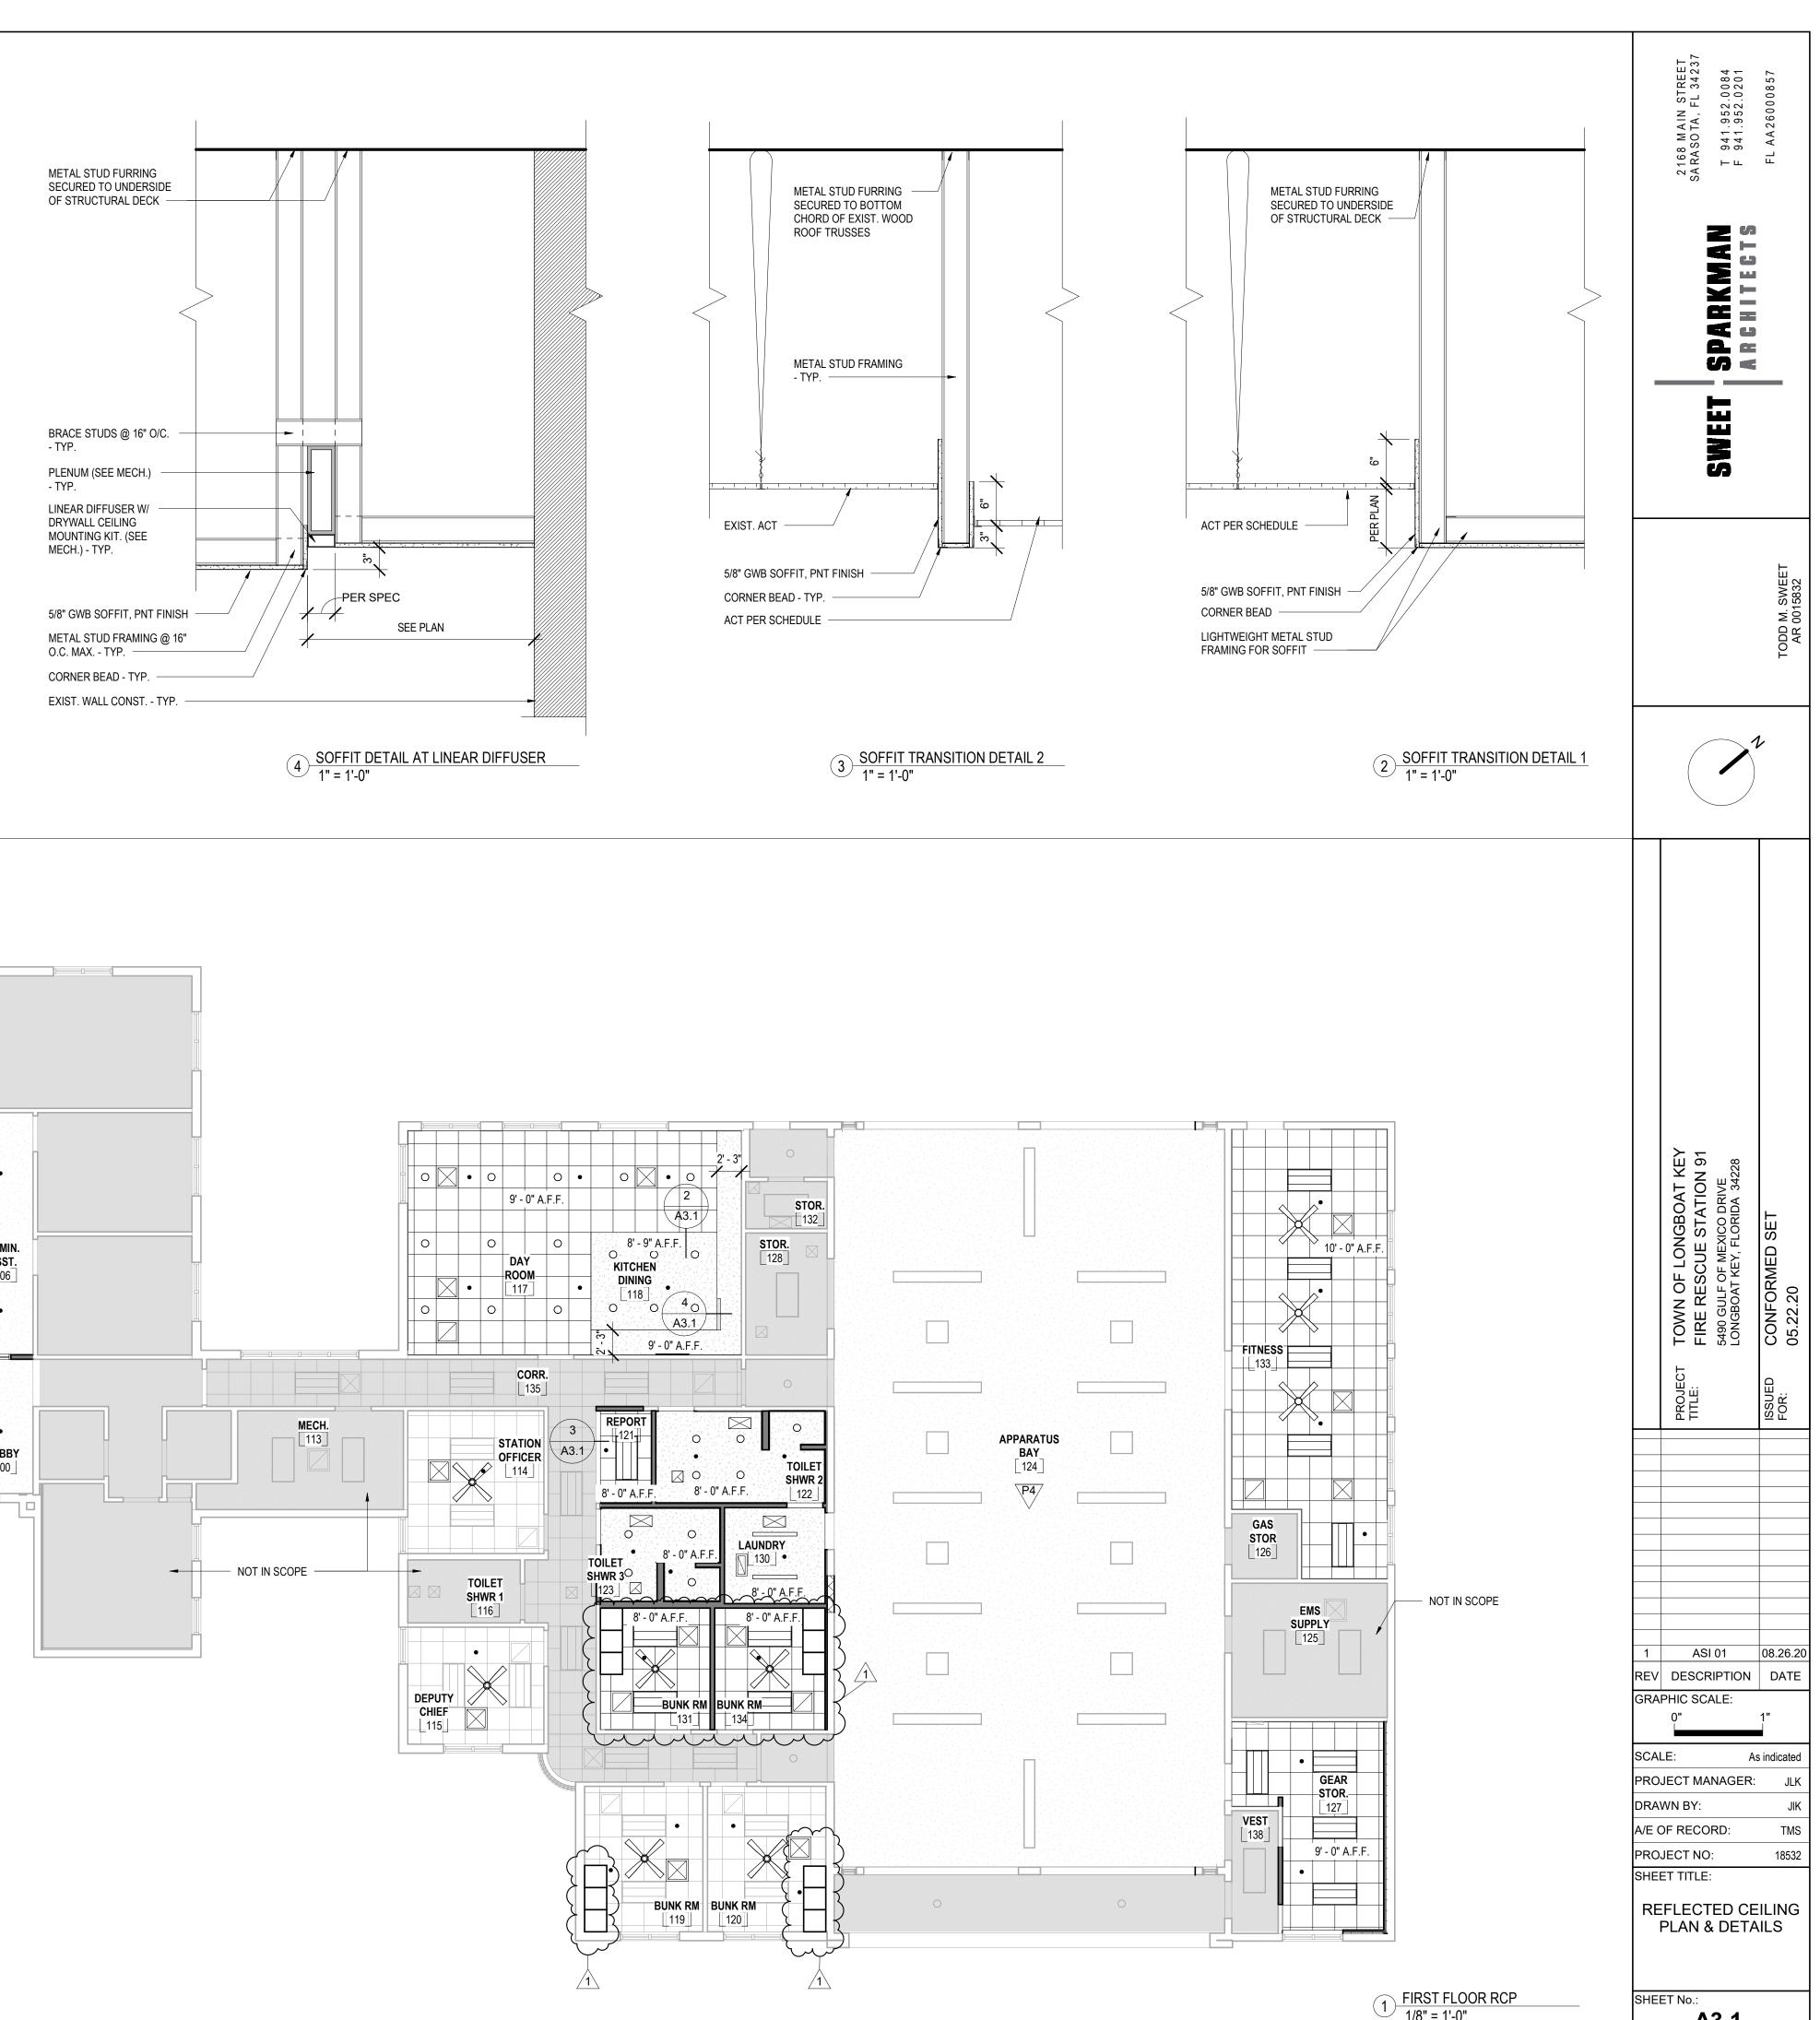


18 SWEET SPARKMAN ARCH

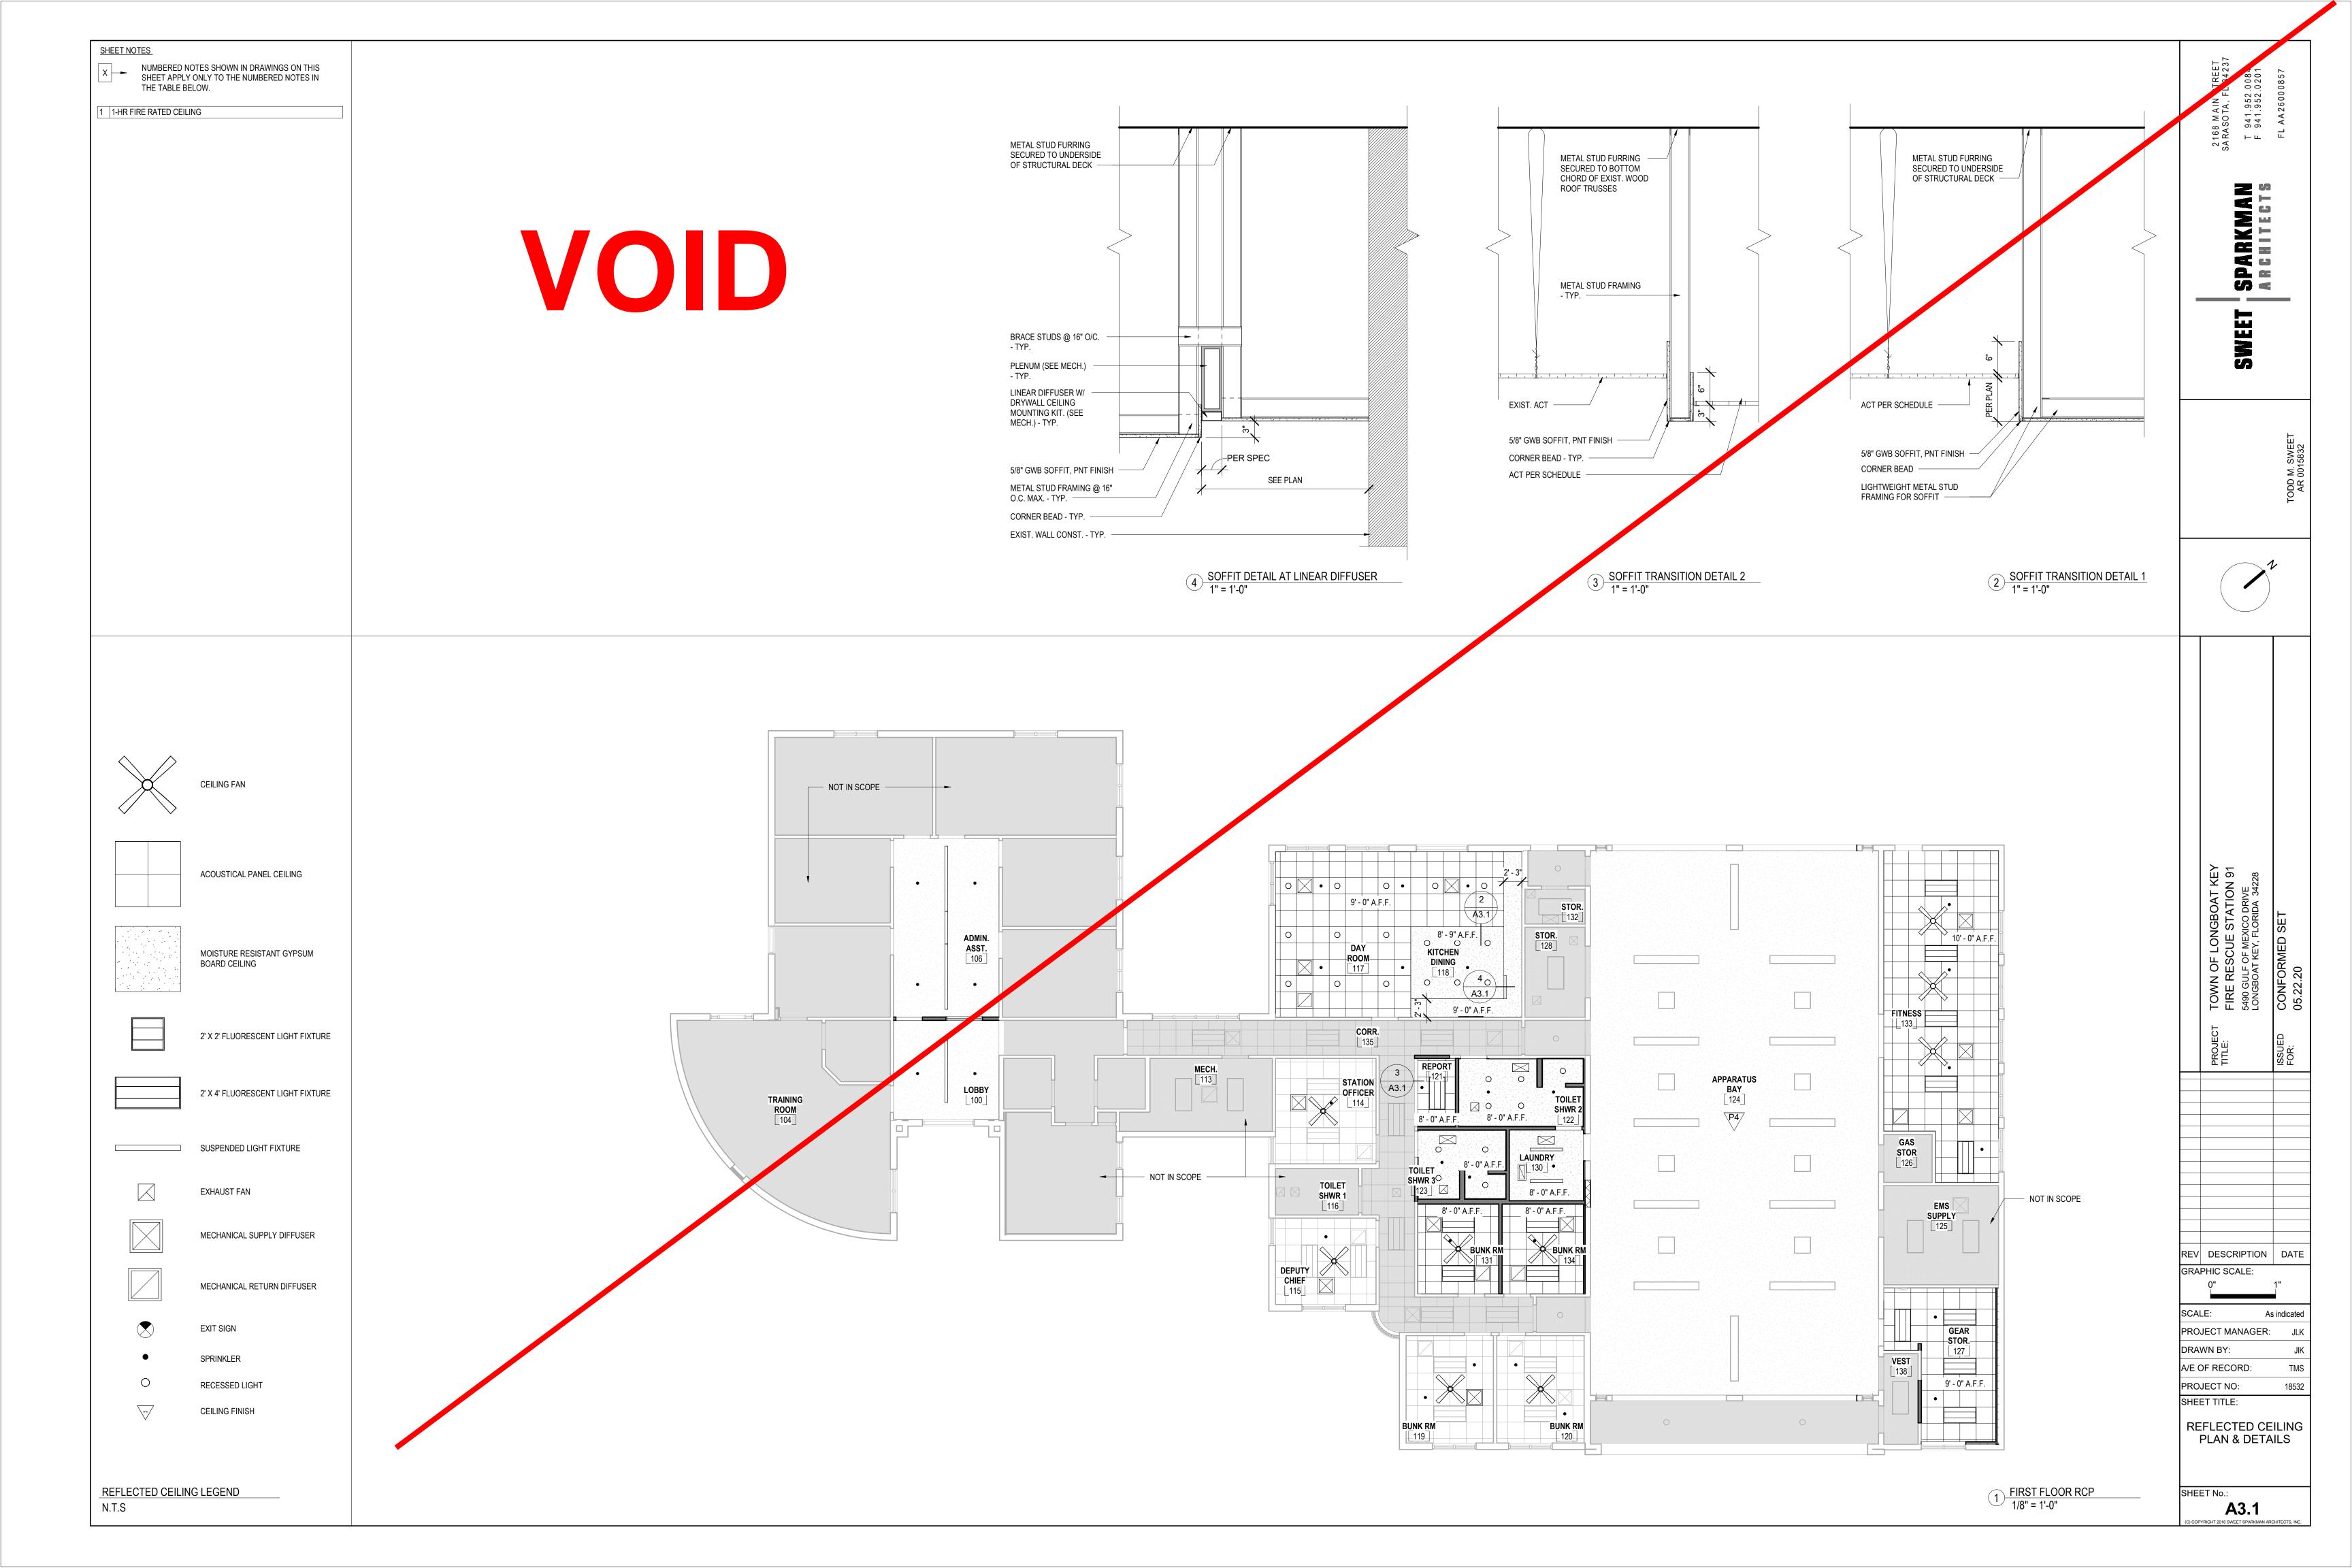


 


DOOR NUMBER         INT/EXT         TYPE         WIDTH         HEIGHT         MATERIAL         FINIS           106         INT         A         3'-0"         7'-0"         SCWD         PNT           122A         INT         A         3'-0"         7'-0"         SCWD         PNT           123A         INT         A         3'-0"         7'-0"         SCWD         PNT           123A         INT         A         3'-0"         7'-0"         SCWD         PNT           124A         EXT         E         14'-0"         14'-0"         STEEL         GALV           124B         EXT         E         14'-0"         14'-0"         STEEL         GALV           124D         EXT         E         14'-0"         14'-0"         He         GALV           130         INT         A         3'-0"         7'-0"         MD         PNT           134         INT         A         3'-0"         7'-0"         SCWD         PNT           134         INT         A         3'-0"         7'-0"         SCWD         PNT           1           1         1         1         1							DOR S
122A       INT       A       3'-0"       7'-0"       SCWD       PNT         122B       INT       A       3'-0"       7'-0"       SCWD       PNT         123A       INT       A       3'-0"       7'-0"       SCWD       PNT         123A       INT       A       3'-0"       7'-0"       SCWD       PNT         124A       EXT       E       14'-0"       14'-0"       STEEL       GALV         124B       EXT       E       14'-0"       14'-0"       STEEL       GALV         124C       EXT       E       14'-0"       14'-0"       STEEL       GALV         124D       EXT       E       14'-0"       14'-0"       STEEL       GALV         130       INT       A       3'-0"       7'-0"       SCWD       PNT         131       INT       A       3'-0"       7'-0"       SCWD       PNT         134       INT       A       3'-0"       7'-0"       SCWD       PNT         1		INT/EXT	TYPE	WIDTH			FINIS
122A       INT       A       3'-0"       7'-0"       SCWD       PNT         122B       INT       A       3'-0"       7'-0"       SCWD       PNT         123A       INT       A       3'-0"       7'-0"       SCWD       PNT         123A       INT       A       3'-0"       7'-0"       SCWD       PNT         124A       EXT       E       14'-0"       14'-0"       SCWD       PNT         124A       EXT       E       14'-0"       14'-0"       SCWD       PNT         124D       EXT       E       14'-0"       14'-0"       SCWD       PNT         130       INT       A       3'-0"       7'-0"       SCWD       PNT         131       INT       A       3'-0"       7'-0"       SCWD       PNT         134       INT       A       3'-0"       7'-0"       SCWD       PNT         134       INT       A       3'-0"       7'-0"       SCWD       PNT         14'-0"       I       I       I       I       I       I       I         14'-0"       I       I       I       I       I       I       I </td <td>106</td> <td>INT</td> <td>B</td> <td>3' - 0"</td> <td>7' - 0"</td> <td>SCWD</td> <td>PNT</td>	106	INT	B	3' - 0"	7' - 0"	SCWD	PNT
122B       INT       A       3'-0"       7'-0"       SCWD       PNT         123A       INT       A       3'-0"       7'-0"       SCWD       PNT         124A       EXT       E       14'-0"       14'-0"       STEEL       GALV         124B       EXT       E       14'-0"       14'-0"       STEEL       GALV         124C       EXT       E       14'-0"       14'-0"       STEEL       GALV         124D       EXT       E       14'-0"       14'-0"       STEEL       GALV         124D       EXT       E       14'-0"       14'-0"       STEEL       GALV         130       INT       A       3'-0"       7'-0"       SCWD       PNT         131       INT       A       3'-0"       7'-0"       SCWD       PNT         134       INT       A       3'-0"       7'-0"       SCWD       PNT         134       INT       A       3'-0"       7'-0"       SCWD       PNT         14'-0"       I       I       I       IIIIIIIIIIIIIIIIIIIIIIIIIIIIIIIIIIII							
123A       INT       A       3'-0"       7'-0"       SCWD       PNT         124A       EXT       E       14'-0"       14'-0"       STEEL       GALV         124B       EXT       E       14'-0"       14'-0"       STEEL       GALV         124C       EXT       E       14'-0"       14'-0"       STEEL       GALV         124D       EXT       E       14'-0"       14'-0"       STEEL       GALV         124D       EXT       E       14'-0"       14'-0"       STEEL       GALV         130       INT       A       3'-0"       7'-0"       HM       PNT         131       INT       A       3'-0"       7'-0"       SCWD       PNT         134       INT       A       3'-0"       7'-0"       SCWD       PNT         134       INT       A       3'-0"       7'-0"       SCWD       PNT         14'       INT       A       3'-0"       7'-0"       SCWD       PNT							
124A       EXT       E       14'-0"       14'-0"       STEEL       GALV         124B       EXT       E       14'-0"       14'-0"       STEEL       GALV         124C       EXT       E       14'-0"       14'-0"       STEEL       GALV         124C       EXT       E       14'-0"       14'-0"       STEEL       GALV         124D       EXT       E       14'-0"       14'-0"       STEEL       GALV         124D       EXT       E       14'-0"       14'-0"       STEEL       GALV         130       INT       A       3'-0"       7'-0"       HM       PNT         131       INT       A       3'-0"       7'-0"       SCWD       PNT         134       INT       A       3'-0"       7'-0"       SCWD       PNT         14'-0"       SEE SCHED.       2"         5       SEE SCHED.       2"       1       1         1         1         1         1         1         1         1         1         <							
124C       EXT       E       14'-0"       STEEL       GALV         124D       EXT       E       14'-0"       14'-0"       STEEL       GALV         130       INT       A       3'-0"       7'-0"       HM       PNT         131       INT       A       3'-0"       7'-0"       SCWD       PNT         134       INT       A       3'-0"       7'-0"       SCWD       PNT         2" SEE SCHED.         2"       SEE SCHED.       2"         Image: Set the se	124A	EXT	E	14' - 0"	14' - 0"	STEEL	GALV
124D       EXT       E       14'-0"       14'-0"       STEEL       GALV         130       INT       A       3'-0"       7'-0"       HM       PNT         131       INT       A       3'-0"       7'-0"       SCWD       PNT         134       INT       A       3'-0"       7'-0"       SCWD       PNT         2" SEE SCHED.         2"       SEE SCHED.       2"         Image: Set the set of the set	124B	EXT	E	14' - 0"	14' - 0"	STEEL	GALV
130       INT       A       3'-0"       T'-0"       HM       PNT         131       INT       A       3'-0"       7'-0"       SCWD       PNT         134       INT       A       3'-0"       7'-0"       SCWD       PNT         2" SEE SCHED.         2"       SEE SCHED.       2"         Image: Set of the set of	124C	EXT	E	14' - 0"	14' - 0"	STEEL	GALV
131     INT     A     3'-0"     7'-0"     SCWD     PNT       134     INT     A     3'-0"     7'-0"     SCWD     PNT	124D	EXT	E			STEEL	GALV
134     INT     A     3'-0"     7'-0"     SCWD     PNT	130	INT	А				PNT
2" SEE SCHED. 2" SEE SCHED. 2" 1 T T FRAME TYPES							
T T T T T T T T T T T T T T T T T T T	134	INT	A	3' - 0"	7' - 0"	SCWD	PNT
FRAME TYPES							
				(1)			
				0			
				0			-
				0			
				0			
				0			
				0			

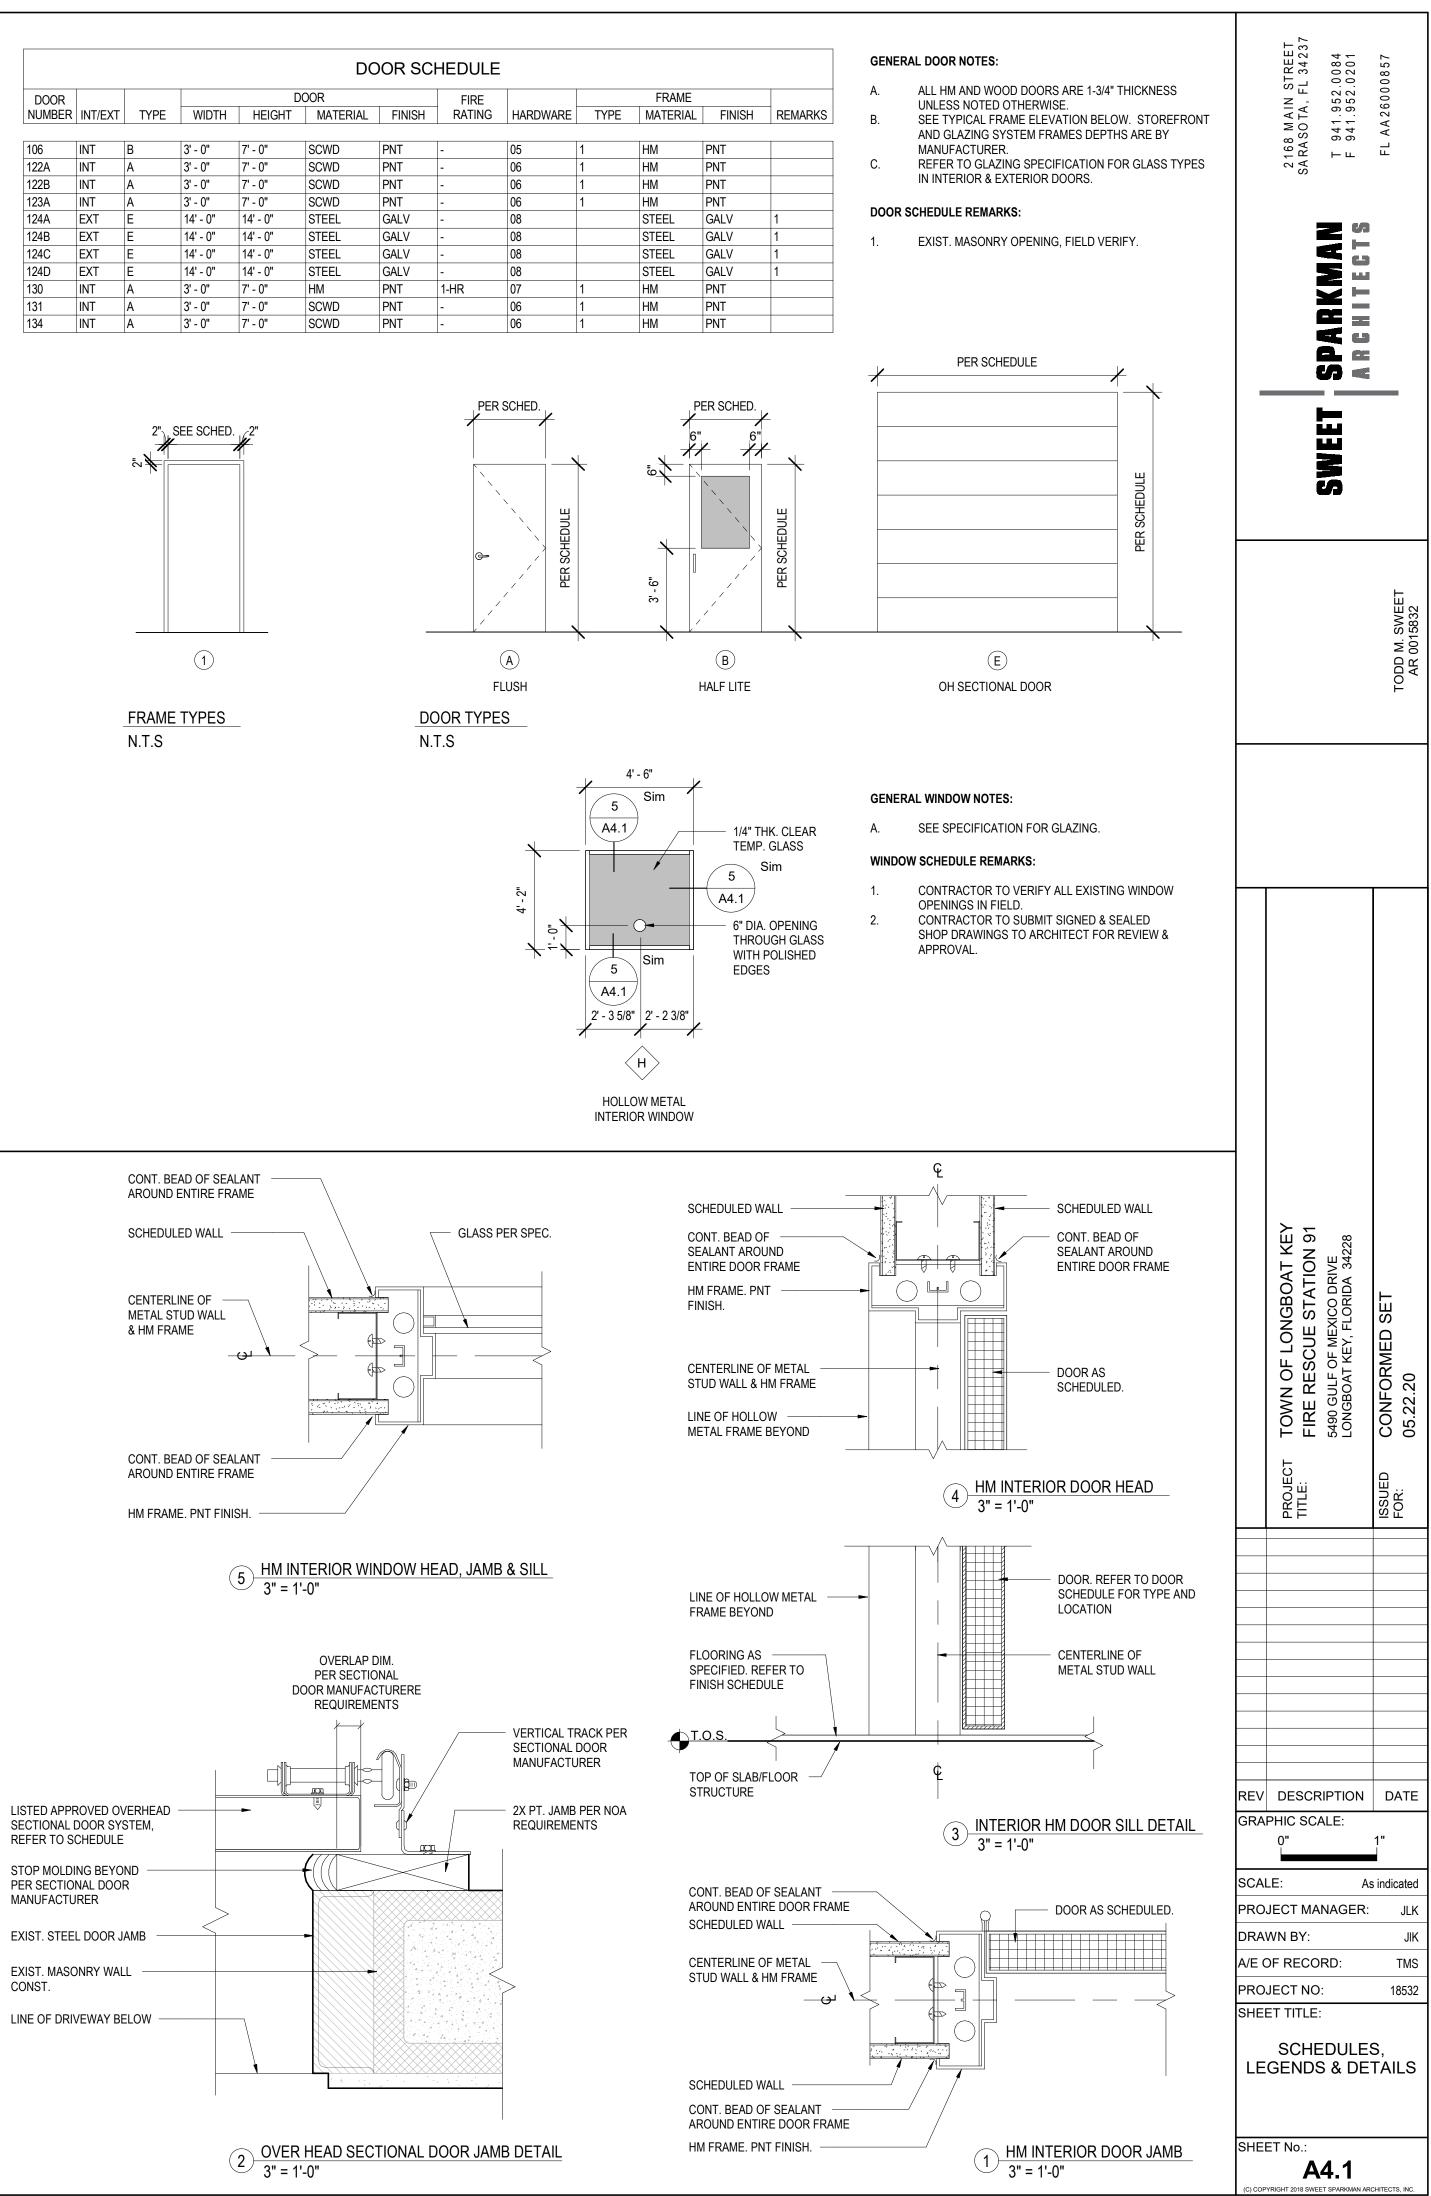



CONST.

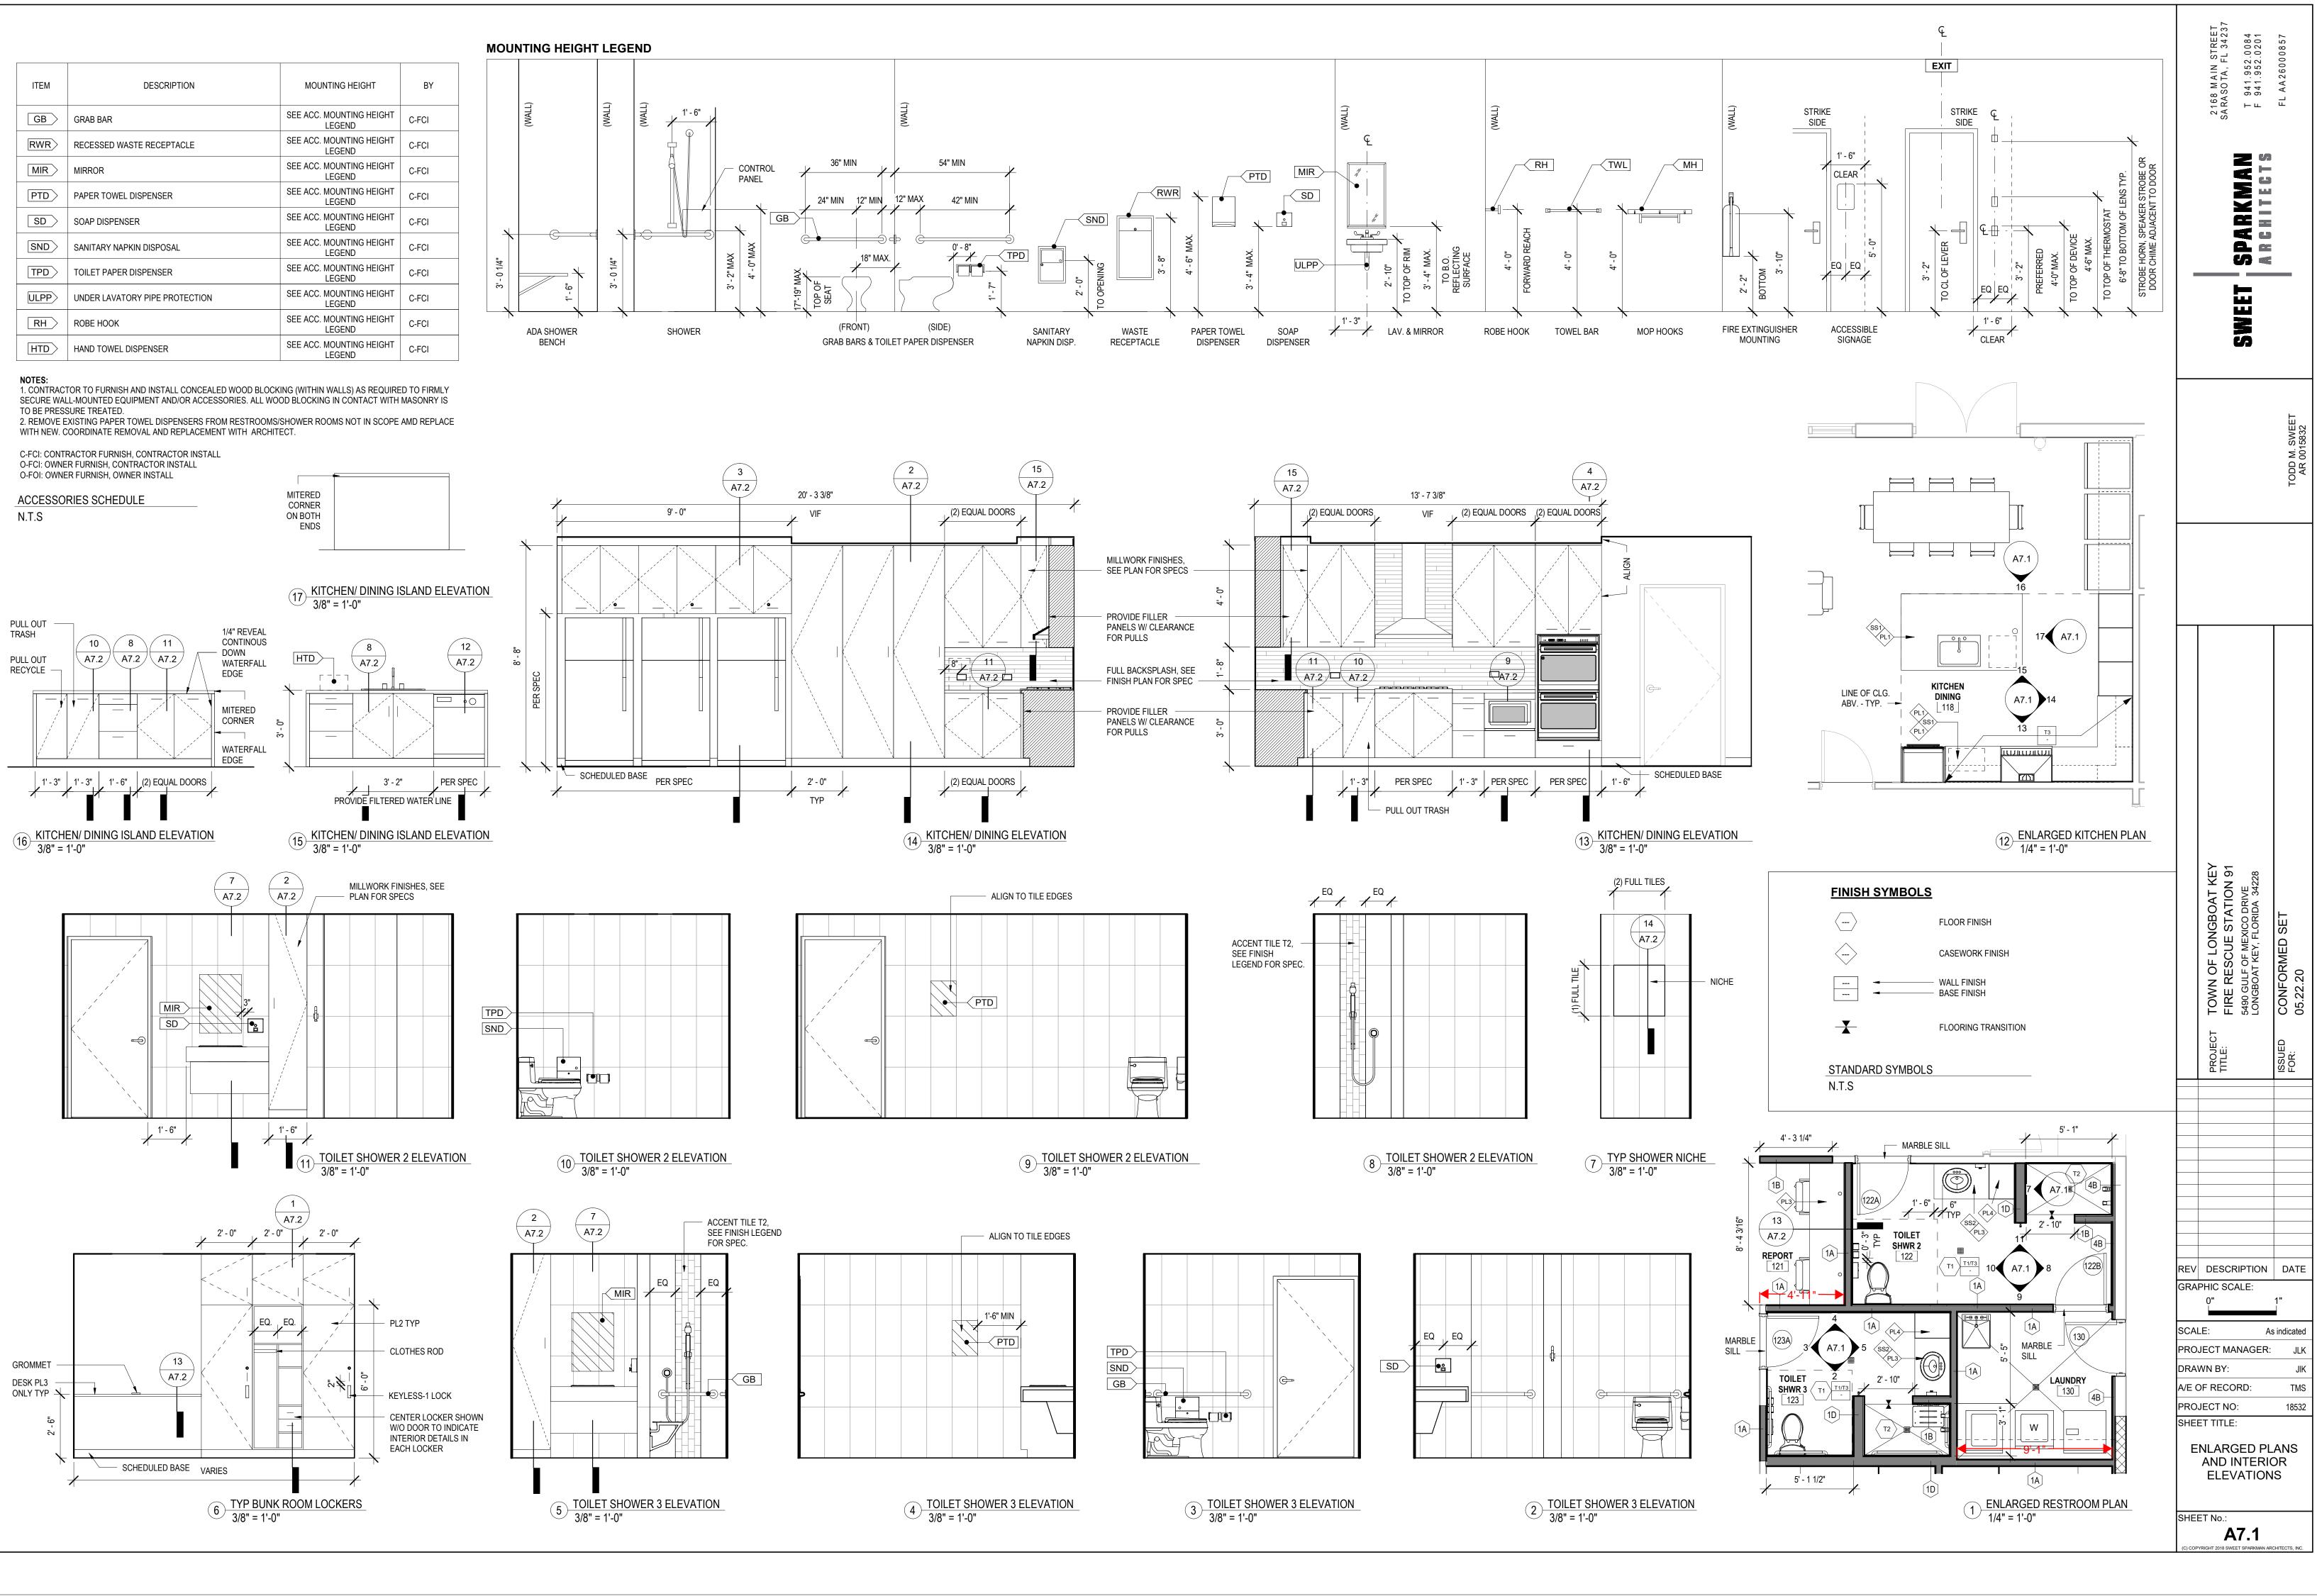



ITEM	DESCRIPTION	MOUNTING HEIGHT	BY
GB	GRAB BAR	SEE ACC. MOUNTING HEIGHT LEGEND	C-FCI
RWR	RECESSED WASTE RECEPTACLE	SEE ACC. MOUNTING HEIGHT LEGEND	C-FCI
MIR	MIRROR	SEE ACC. MOUNTING HEIGHT LEGEND	C-FCI
PTD	PAPER TOWEL DISPENSER	SEE ACC. MOUNTING HEIGHT LEGEND	C-FCI
SD	SOAP DISPENSER	SEE ACC. MOUNTING HEIGHT LEGEND	C-FCI
SND	SANITARY NAPKIN DISPOSAL	SEE ACC. MOUNTING HEIGHT LEGEND	C-FCI
TPD	TOILET PAPER DISPENSER	SEE ACC. MOUNTING HEIGHT LEGEND	C-FCI
ULPP	UNDER LAVATORY PIPE PROTECTION	SEE ACC. MOUNTING HEIGHT LEGEND	C-FCI
RH	ROBE HOOK	SEE ACC. MOUNTING HEIGHT LEGEND	C-FCI
HTD	HAND TOWEL DISPENSER	SEE ACC. MOUNTING HEIGHT LEGEND	C-FCI

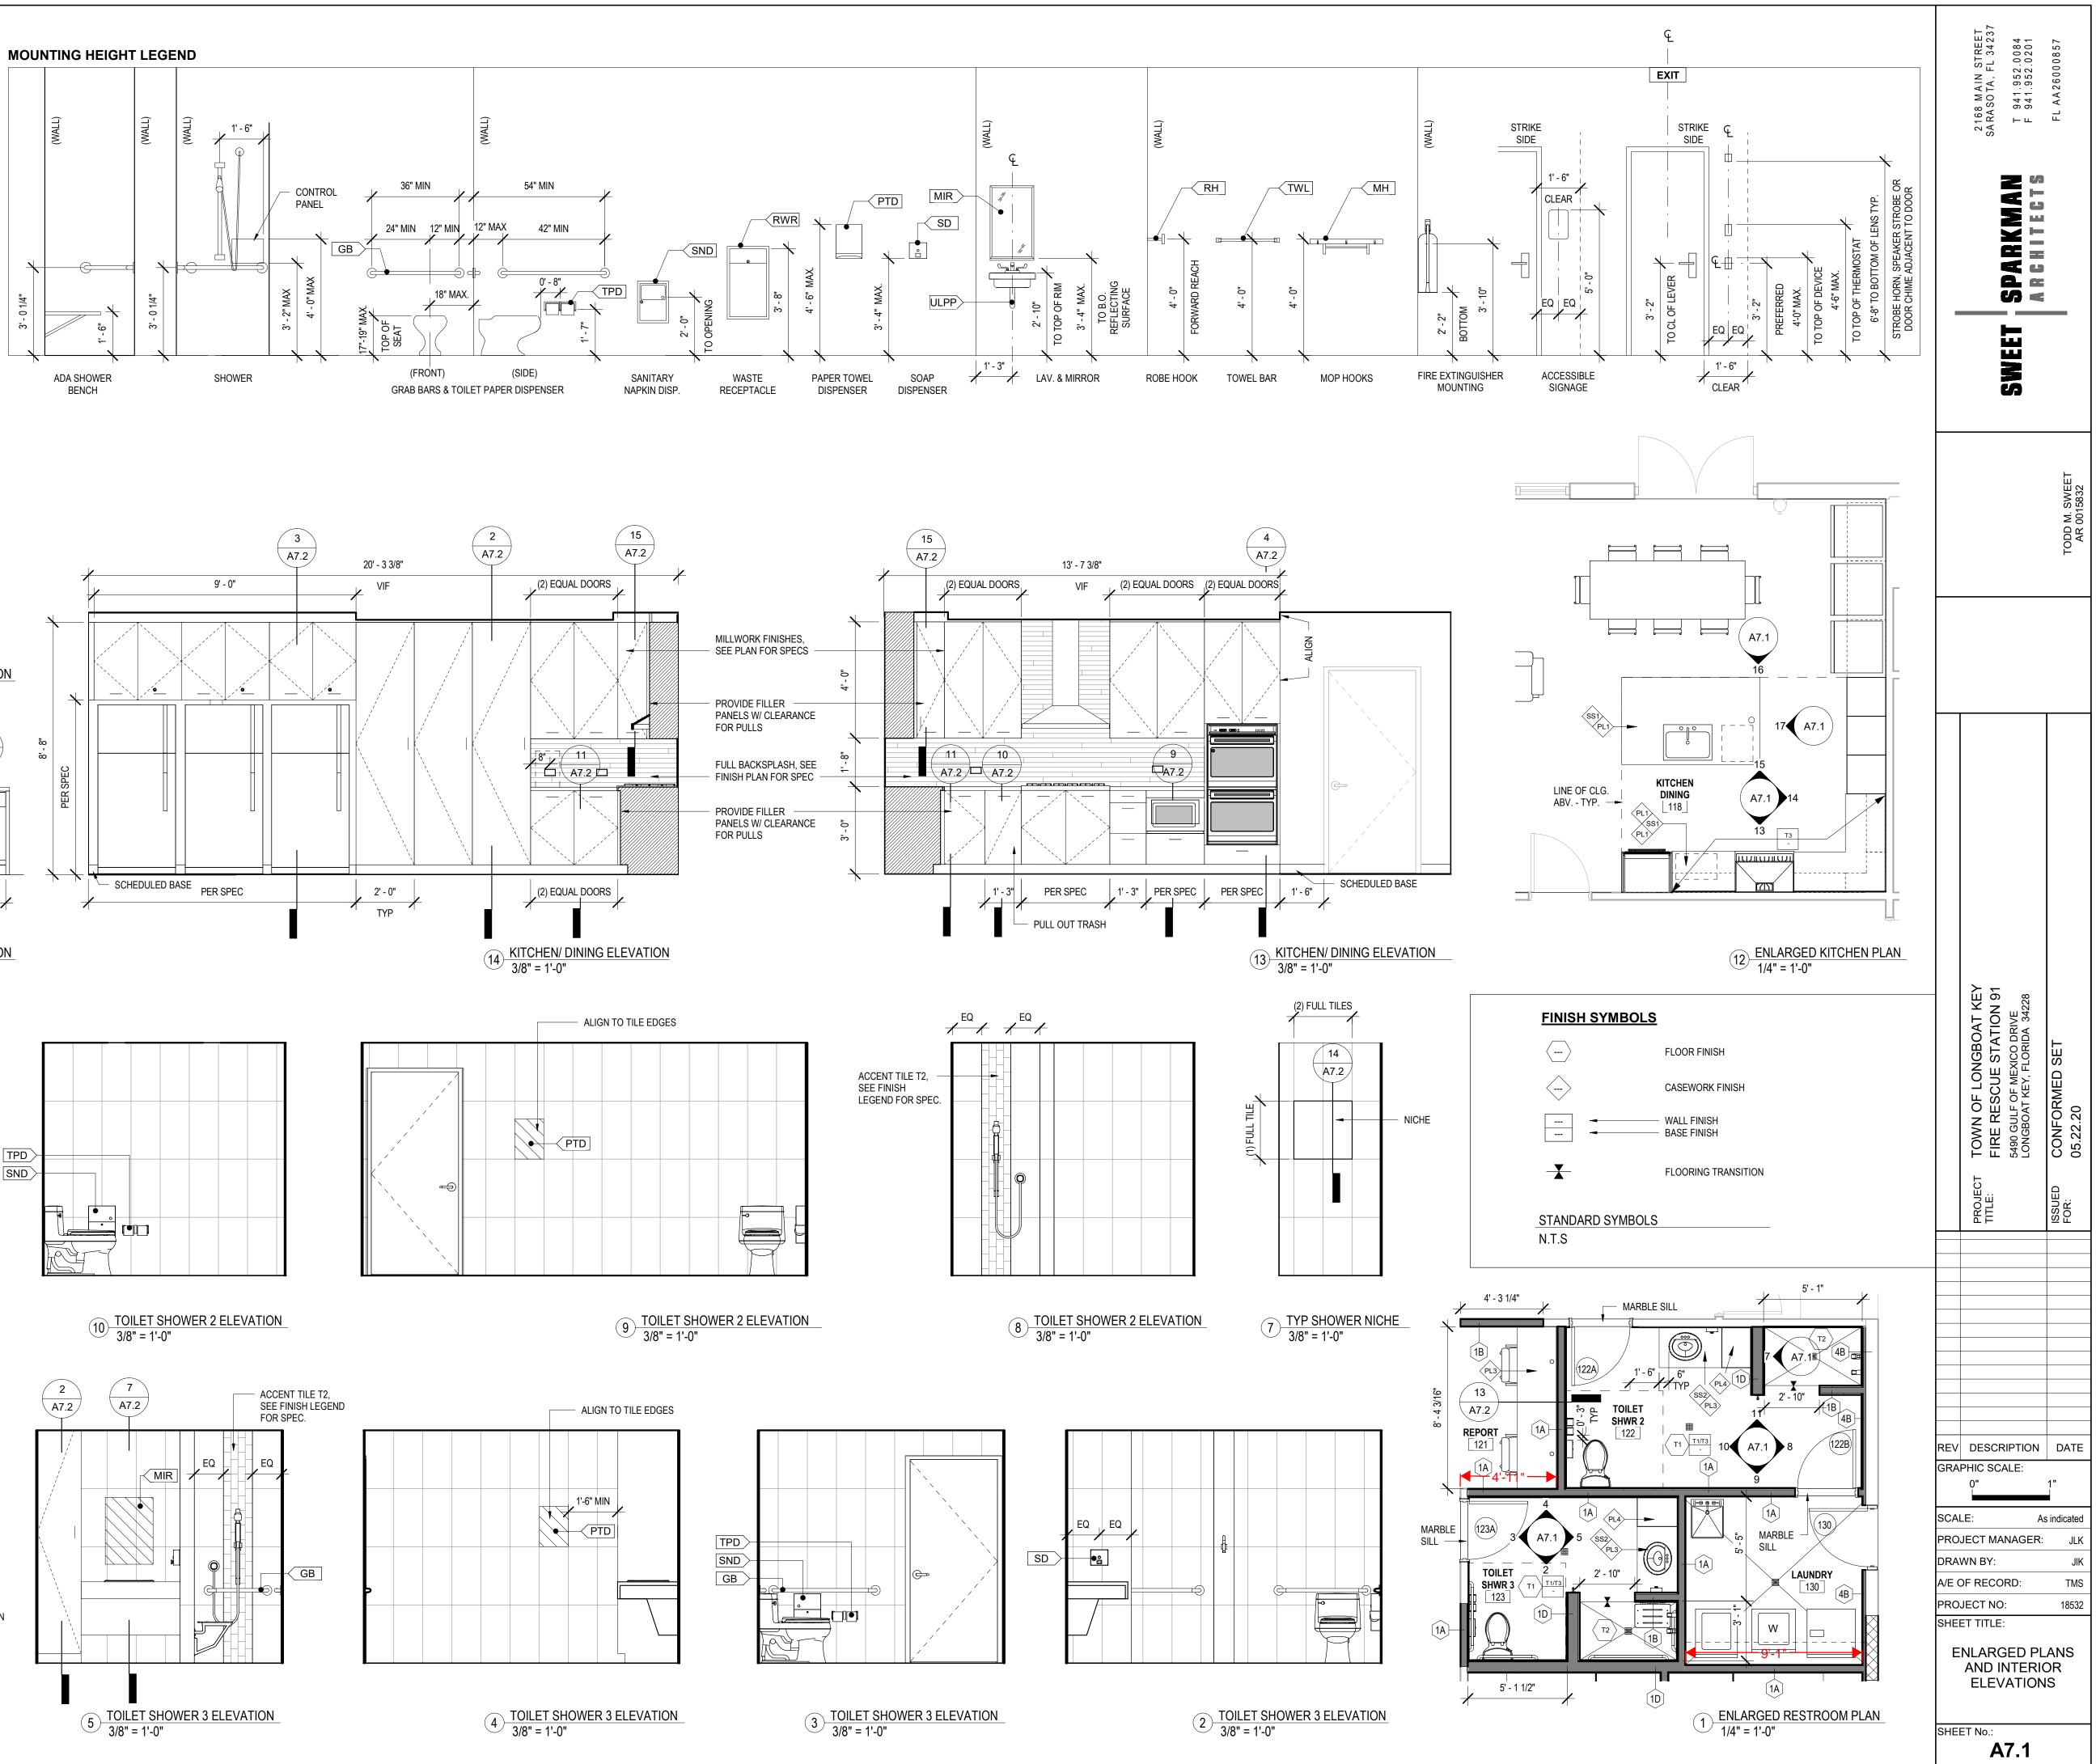


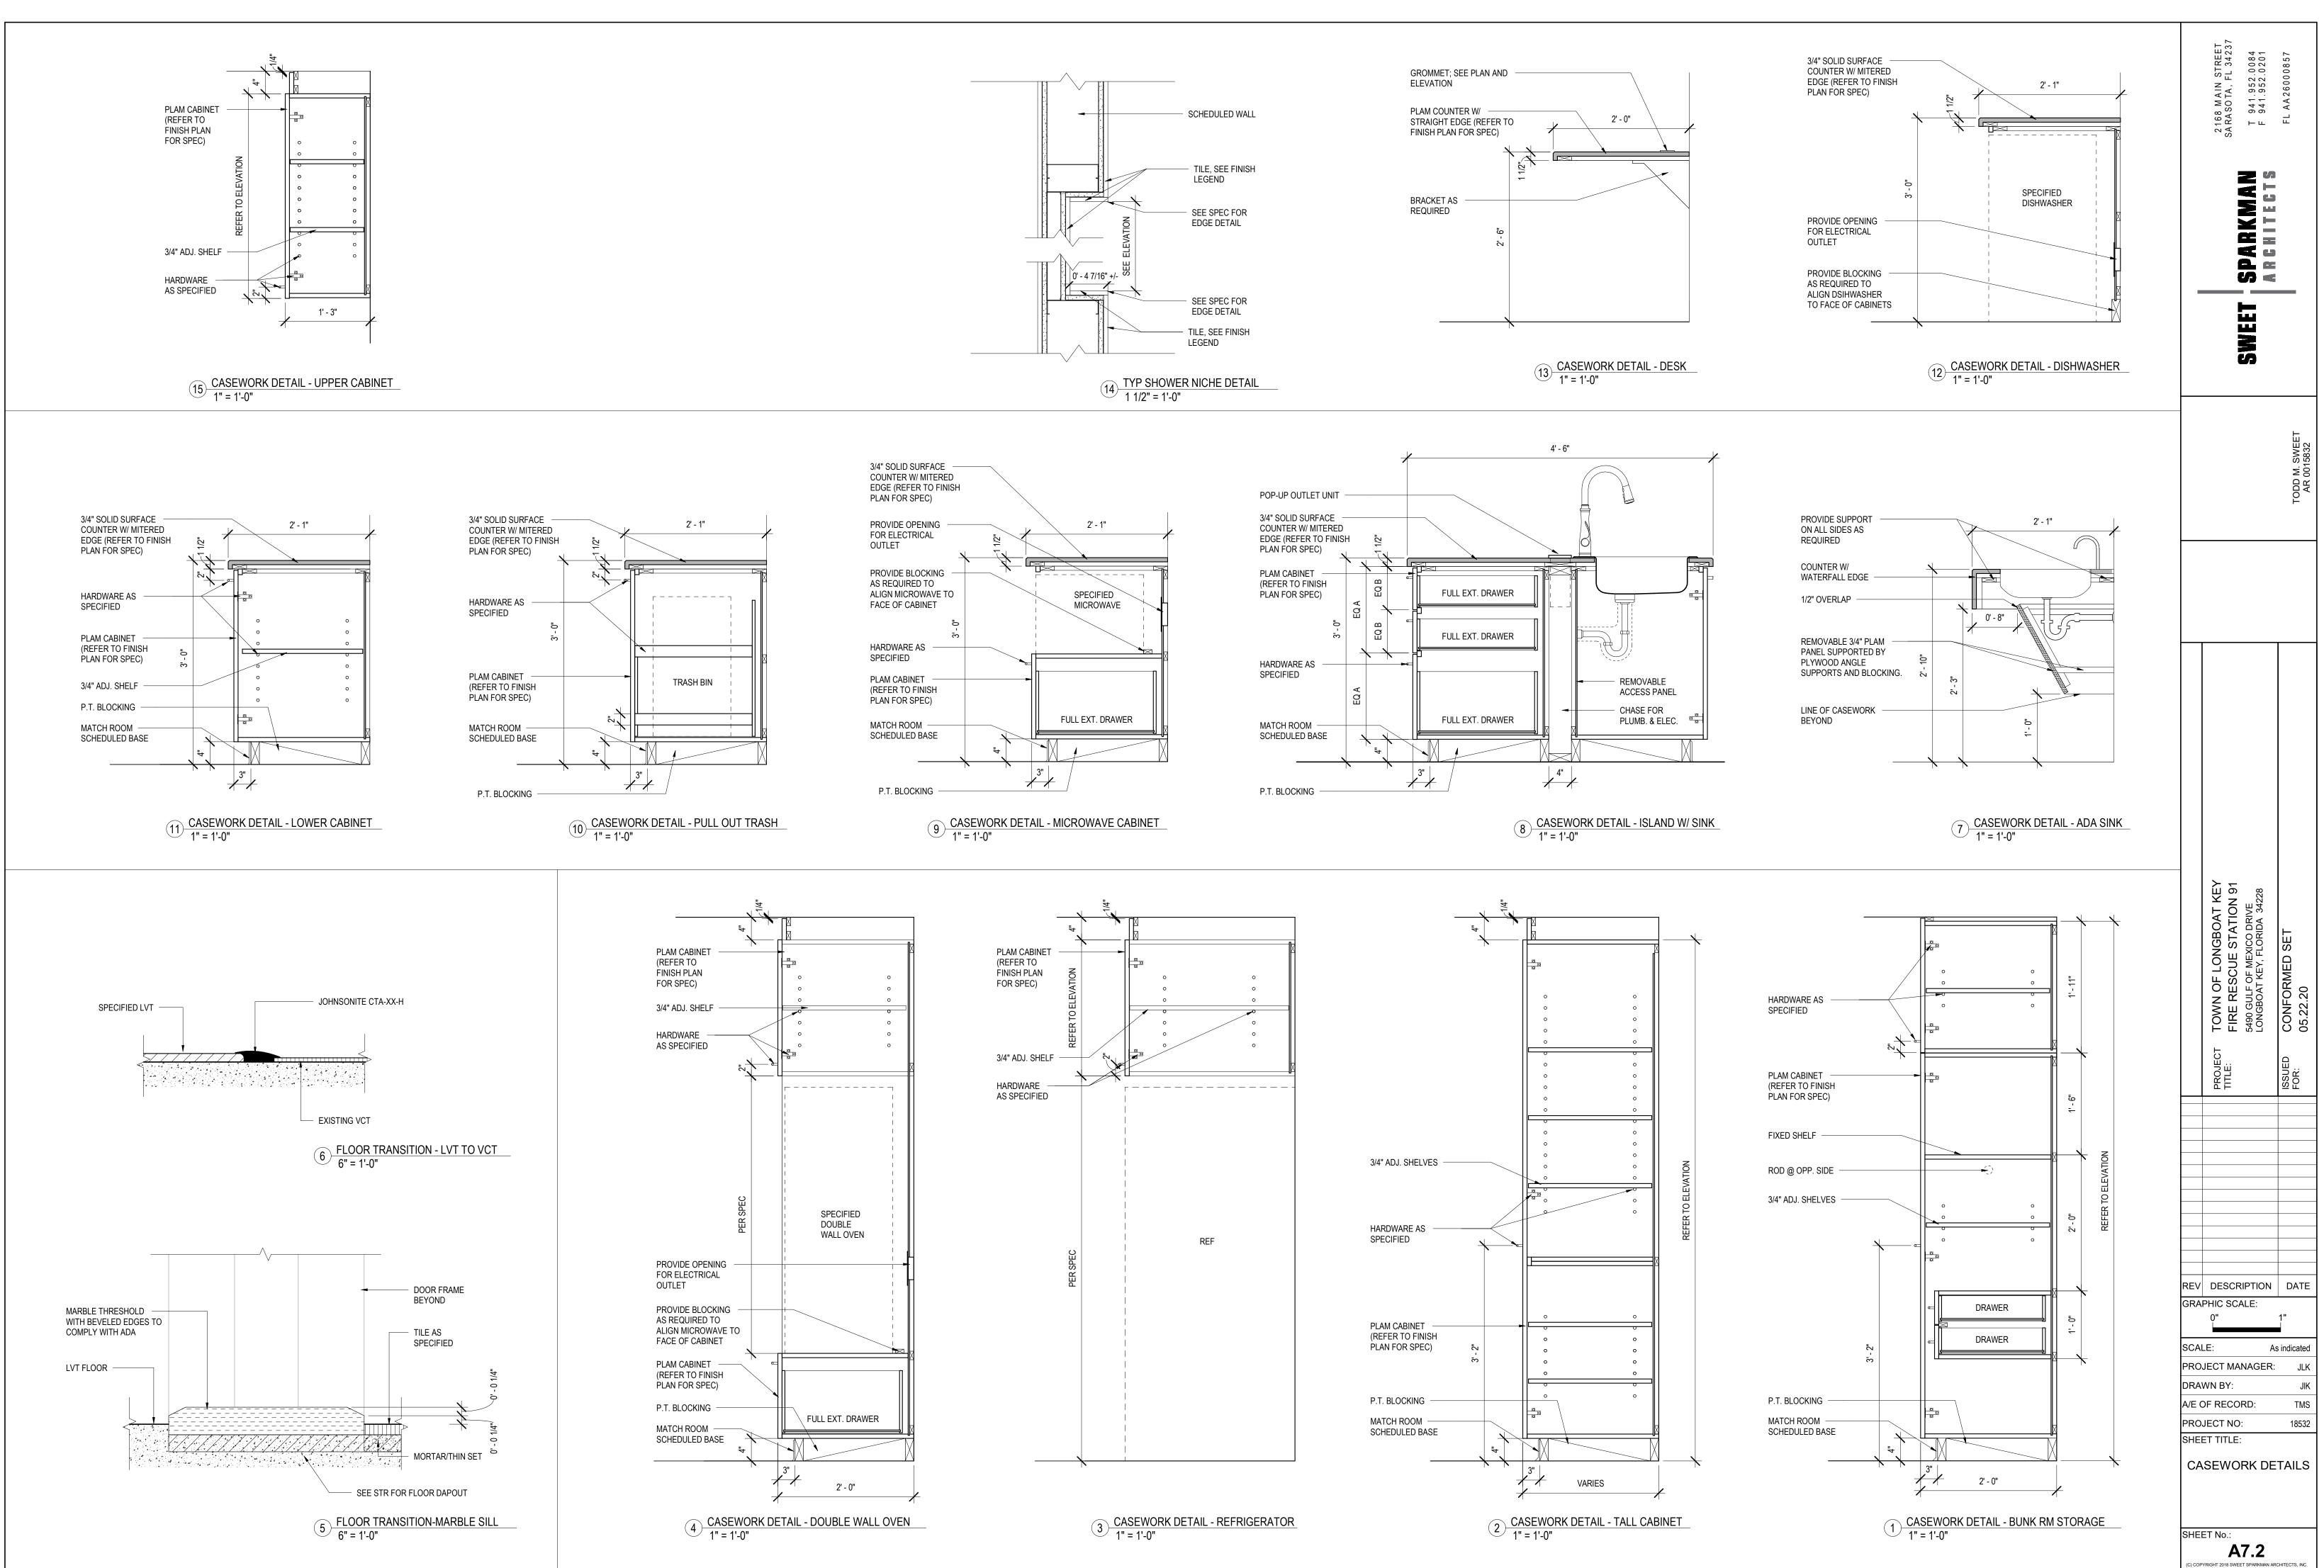

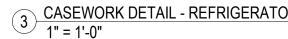

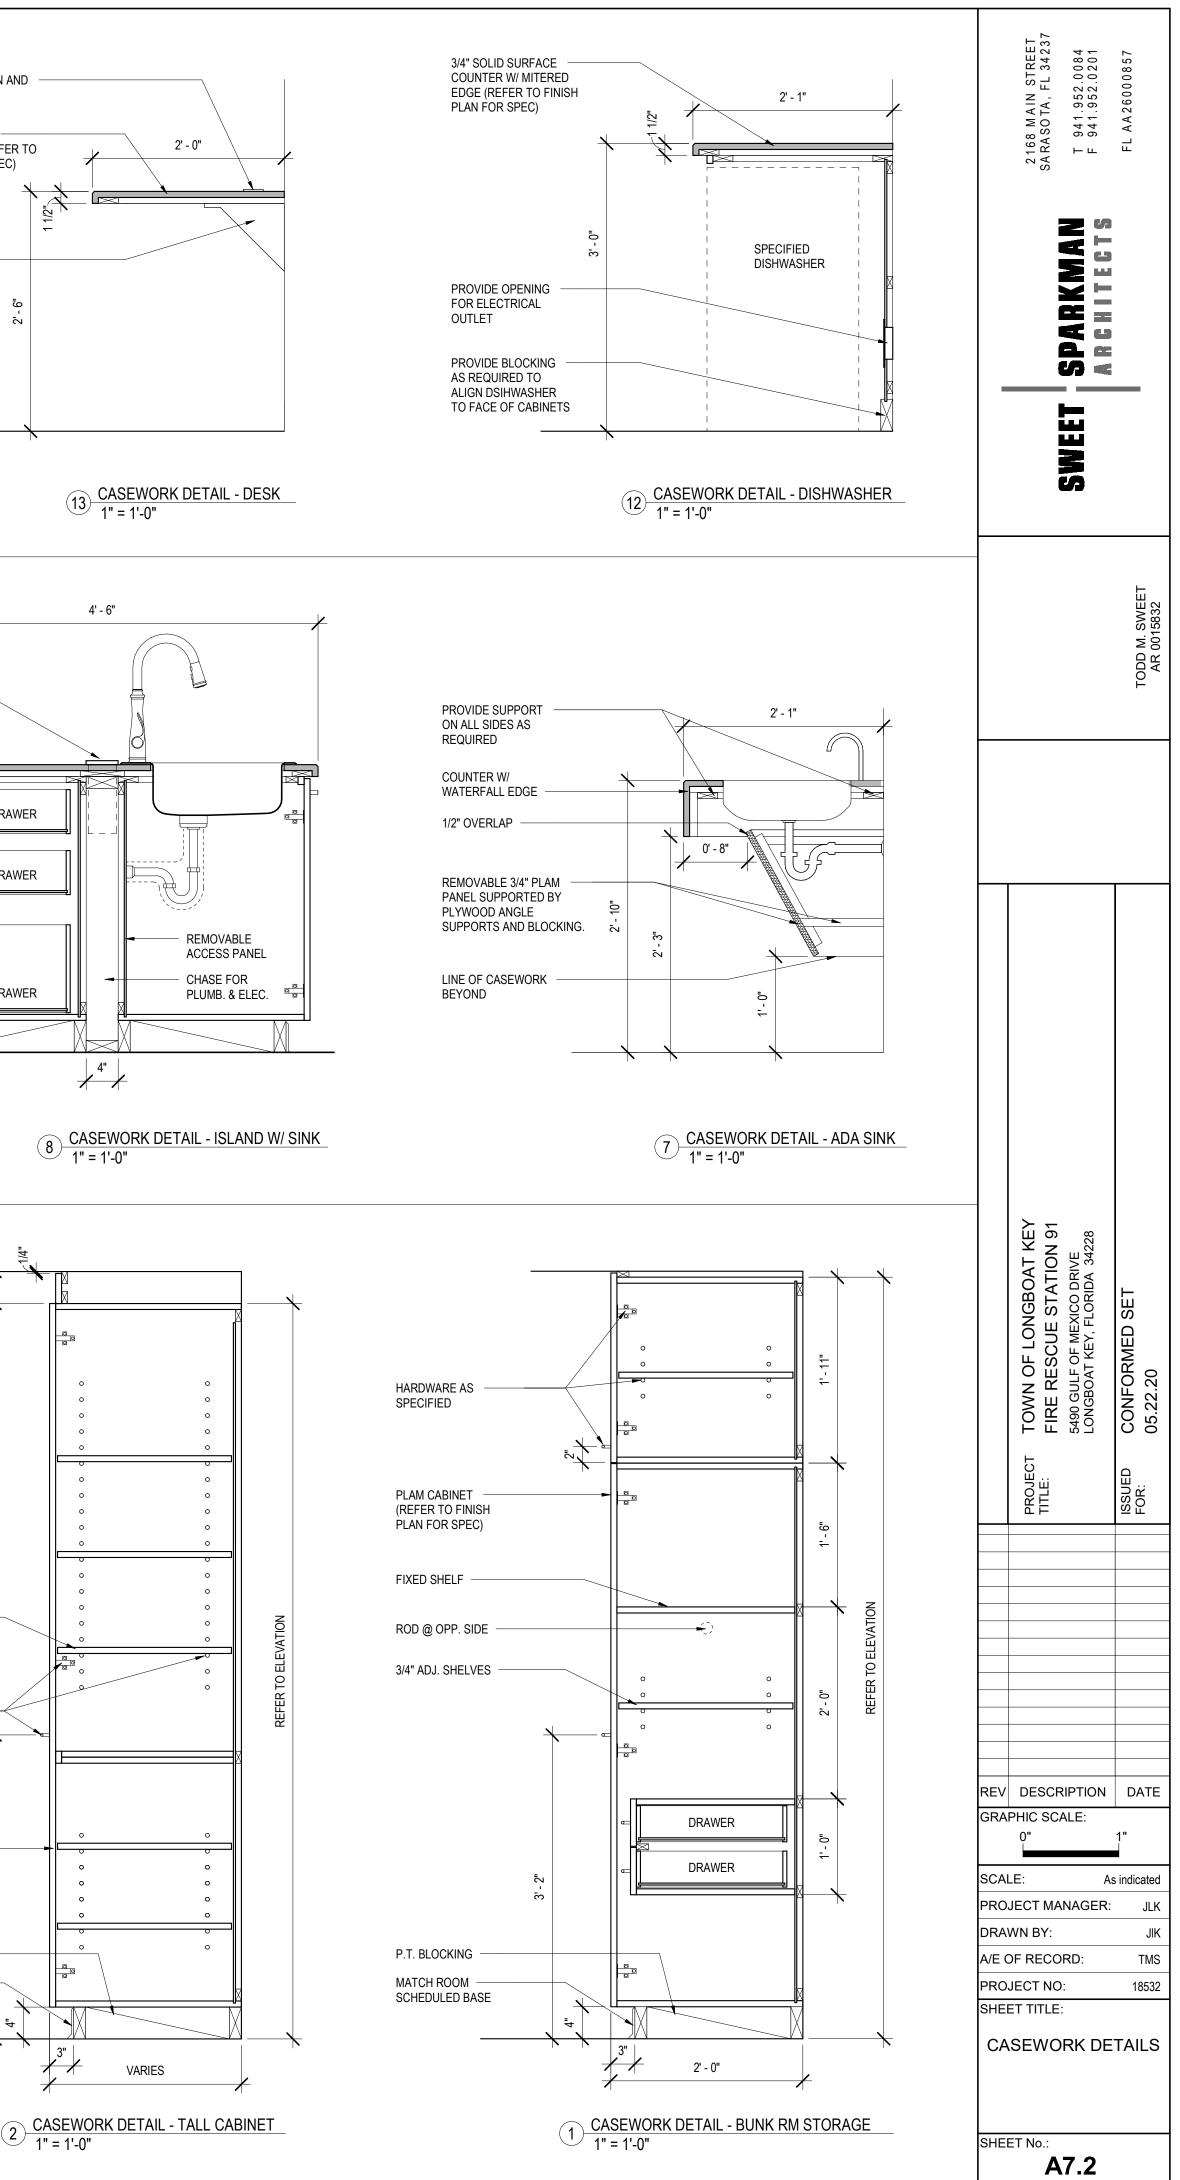

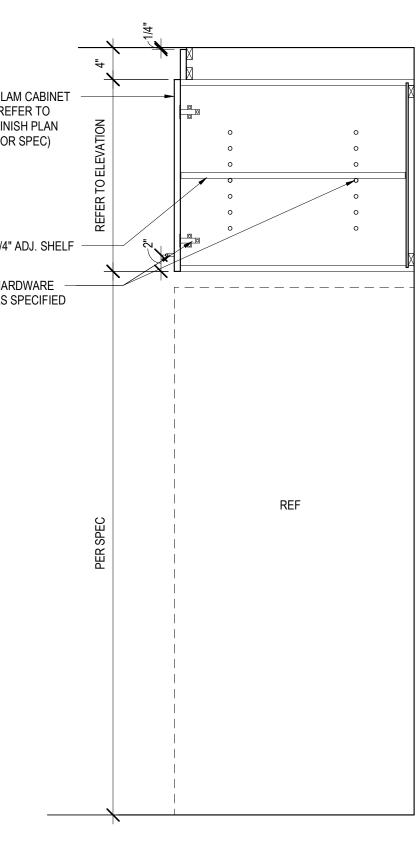

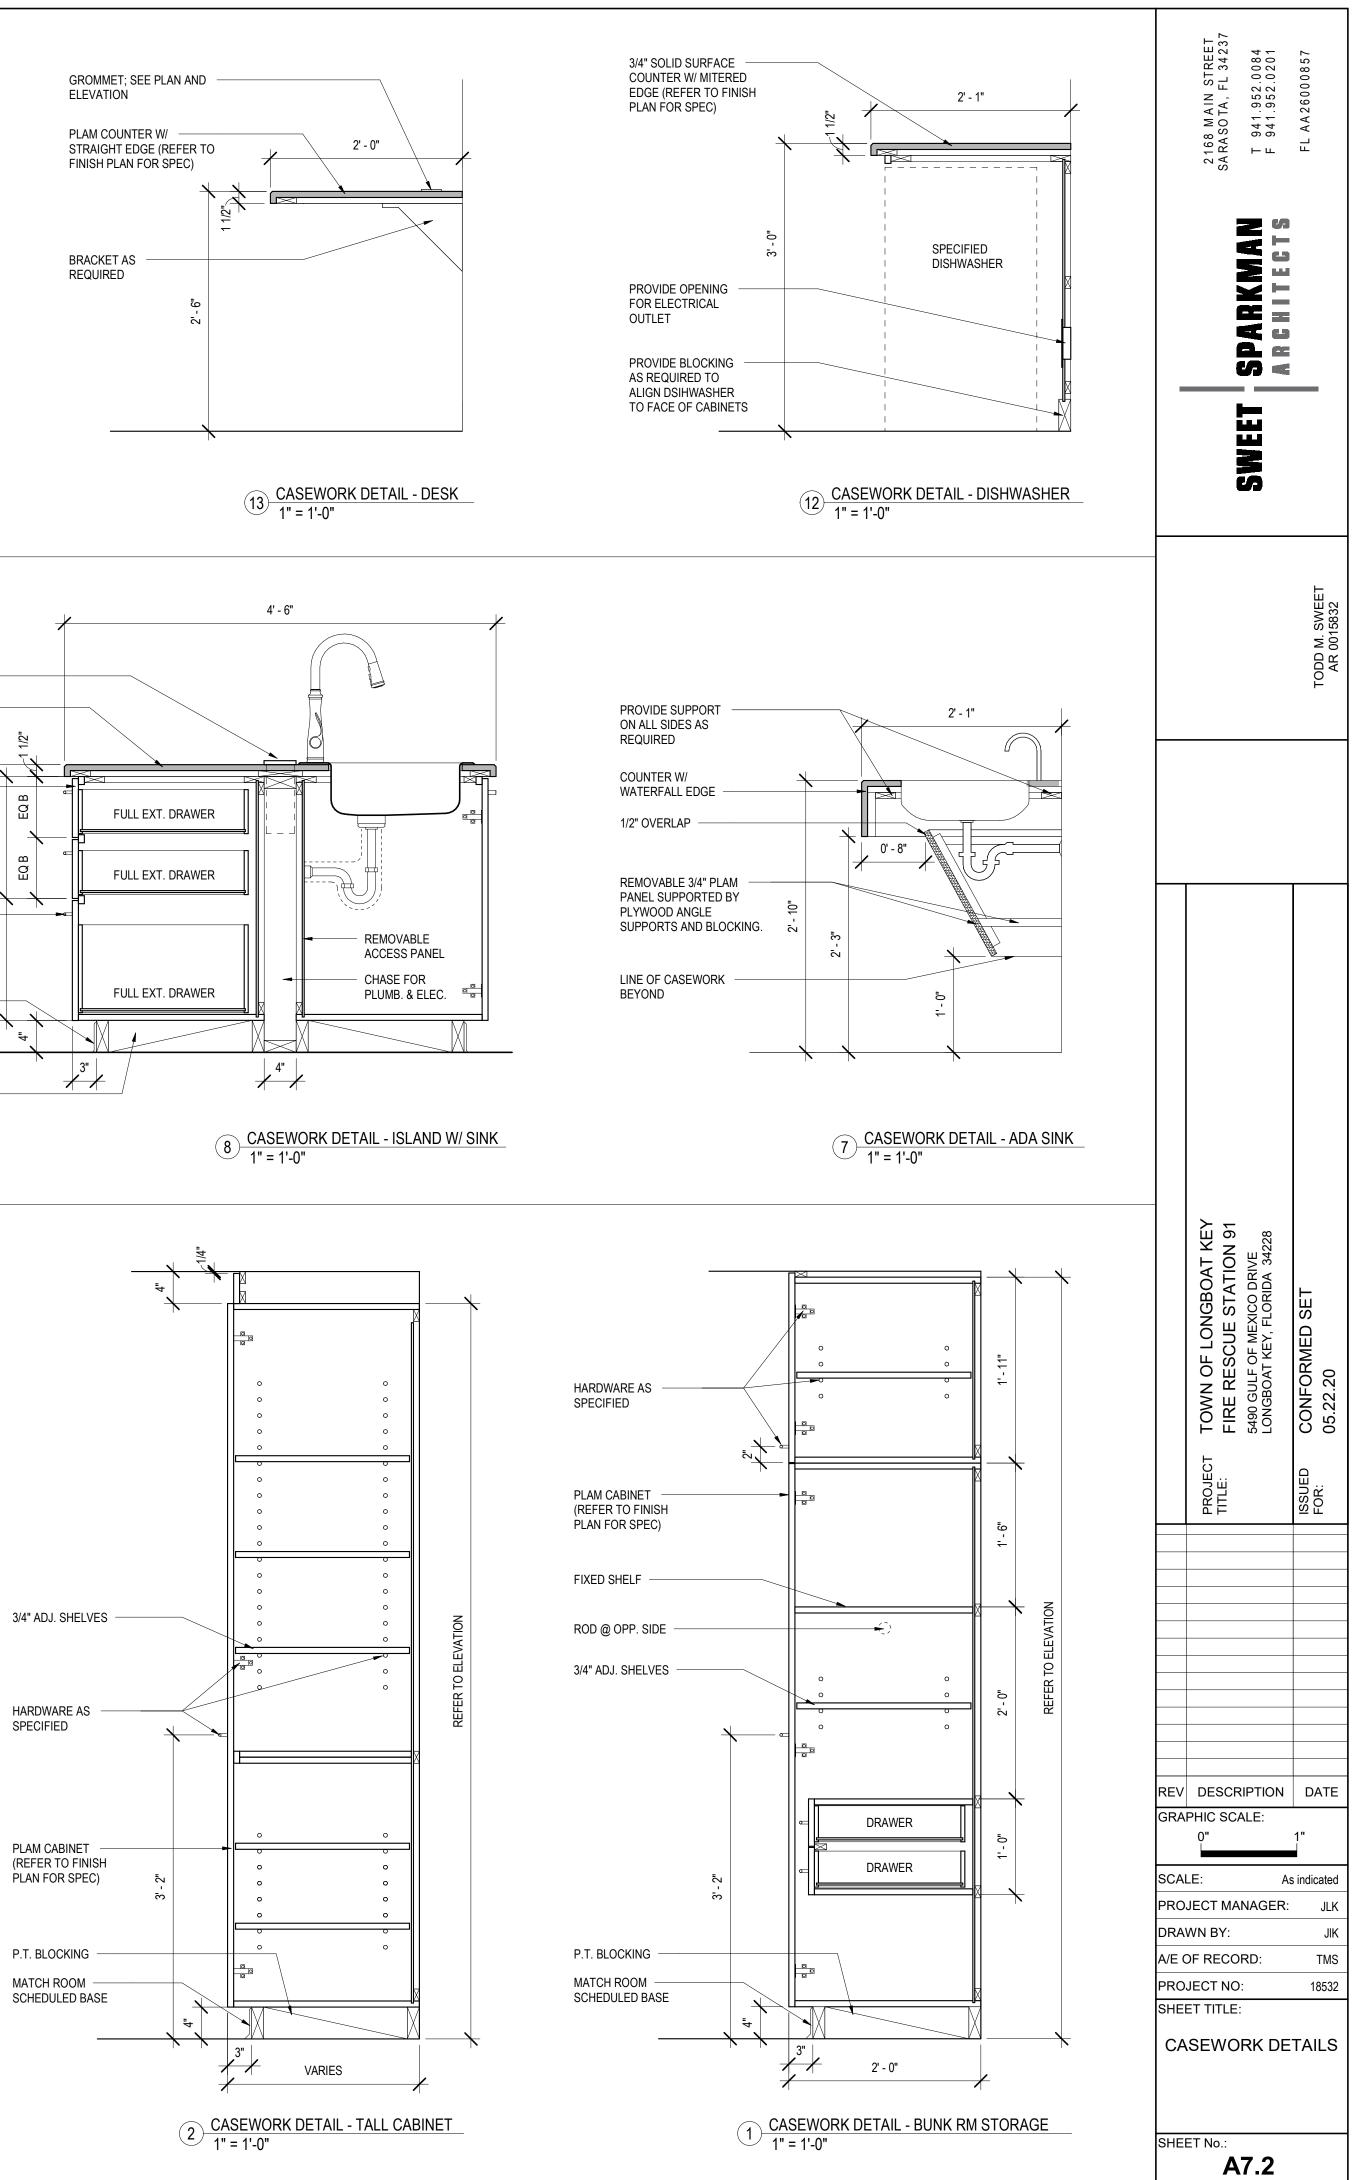

#### STRUCTURAL NOTES

#### GENERAL NOTES:

STRUCTURAL DRAWINGS SHALL BE USED IN CONJUNCTION WITH JOB SPECIFICATIONS AND ARCHITECTURAL, MECHANICAL, ELECTRICAL, PLUMBING, AND SITE DRAWINGS. CONSULT THESE DRAWINGS FOR SLEEVES, DEPRESSIONS, AND OTHER DETAILS NOT SHOWN ON STRUCTURAL DRAWINGS.

ALL DIMENSIONS AND CONDITIONS MUST BE VERIFIED IN THE FIELD. ANY DISCREPANCIES SHALL BE BROUGHT TO THE ATTENTION OF THE ENGINEER BEFORE PROCEEDING WITH THE AFFECTED PART OF THE WORK. DO NOT SCALE DRAWINGS.

THE STRUCTURE IS DESIGNED TO BE SELF SUPPORTING AND STABLE AFTER THE BUILDING IS COMPLETE. IT IS THE CONTRACTOR'S RESPONSIBILITY TO DETERMINE ERECTION PROCEDURES AND SEQUENCE TO INSURE SAFETY OF THE BUILDING AND ITS COMPONENTS DURING ERECTION. THIS INCLUDES THE ADDITION OF NECESSARY SHORING, SHEETING, TEMPORARY BRACING, GUYS OR TIEDOWNS.

ELECTRONIC VERSIONS OF THE STRUCTURAL DRAWINGS ARE THE SOLE, COPYRIGHTED PROPERTY OF SNELL ENGINEERING AND ARE NOT TO BE USED OR TRANSFERRED WITHOUT THE EXPRESS. WRITTEN PERMISSION OF SNELL ENGINEERING.

#### **EXISTING STRUCTURE:**

INFORMATION SHOWN FOR THE EXISTING STRUCTURE ON THESE DRAWINGS WAS TAKEN FROM THE DRAWINGS THAT WERE 

PREPARED FOR:	TOWN OF LONGBOAT KEY
PREPARED BY:	SNELL ENGINEERING CONSULTANTS, INC.
ENTITLED:	NORTH FIRE STATION, LONGBOAT KEY, FL
DATED:	12/7/1995

WORK SHOWN ON THESE PLANS ASSUMES THAT THE ORIGINAL CONSTRUCTION WAS PERFORMED IN ACCORDANCE WITH THE ABOVE INDICATED ORIGINAL DRAWINGS INCLUDING (BUT NOT LIMITED TO) DIMENSIONS, ELEVATIONS, MEMBER SIZES, MATERIALS, DETAILS, ETC. IT SHALL BE THE RESPONSIBILITY OF THE CONTRACTOR TO VERIFY THE CONDITIONS RELATING TO THE EXISTING STRUCTURE AND TO NOTIFY THE ENGINEER IMMEDIATELY OF ANY DISCREPANCIES OR CONFLICTS

#### **EXISTING STRUCTURE LOADING:**

THE GARAGE ADDITION INCREASES THE LATERAL-FORCE STORY SHEAR. THE EXISTING BUILDING CAN RESIST THE ADDITIONAL LATERAL-FORCE STORY SHEAR. THE GARAGE ADDITION INCREASES THE VERTICAL LOADING ON THE EXISTING STRUCTURE. THE ELEMENTS IN THE EXISTING STRUCTURE THAT ARE SUPPORTING THE GARAGE ADDITION TRUSSES CAN RESIST THE ADDITIONAL VERTICAL LOADING.

#### DESIGN LOADS:

THE STRUCTURAL SYSTEM FOR THIS BUILDING HAS BEEN DESIGNED IN ACCORDANCE WITH THE FLORIDA BUILDING CODE 6TH EDITION (2017) AND THE FLORIDA BUILDING CODE-EXISTING 6TH EDITION (2017). THE FOLLOWING SUPERIMPOSED LOADINGS HAVE BEEN UTILIZED:

-

ROOF: LIVE LOAD

DEAD LOAD
DEAD LOAD

- 20 PSF. - 30 PSF. - 7 PSF. (AVAILABLE TO RESIST UPLIFT)

ASCE 7-16 ULTIMATE WIND SPEED ALLOWABLE WIND SPEED EXPOSURE D ENCLOSED STRUCTURE **RISK FACTOR IV** 

165 MPH - 128 MPH

#### SHOP DRAWING REVIEW:

SHOP DRAWINGS WILL BE REVIEWED FOR GENERAL COMPLIANCE WITH THE DESIGN INTENT OF THE CONTRACT DOCUMENTS ONLY. IT SHALL BE THE RESPONSIBILITY OF THE CONTRACTOR TO VERIFY COMPLIANCE WITH THE CONTRACT DOCUMENTS AS TO QUANTITY, LENGTH, ELEVATIONS, DIMENSIONS, ETC.

ALL SHOP DRAWINGS SHALL BE REVIEWED BY THE CONTRACTOR PRIOR TO SUBMITTAL TO THE ARCHITECT/ENGINEER. DRAWINGS SUBMITTED WITHOUT REVIEW NOTATION WILL BE RETURNED UNCHECKED. EVERY EFFORT WILL BE MADE TO RETURN THE SHOP DRAWINGS WITHIN TEN BUSINESS DAYS. IT IS THE CONTRACTOR'S RESPONSIBILITY TO SUBMIT THE SHOP DRAWINGS ALLOWING FOR AN ADEQUATE REVIEW PERIOD.

ONE SET OF PRINTS WILL BE RETAINED BY THE ENGINEER AND ONE BY THE ARCHITECT, THE CONTRACTOR SHALL RECEIVE THE REMAINING PRINTS FOR SUBMITTAL TO THE BUILDING DEPARTMENT AND AS REQUIRED FOR DISTRIBUTION.

IN ALL INSTANCES THE CONTRACT DOCUMENTS WILL GOVERN OVER THE SHOP DRAWINGS UNLESS OTHERWISE SPECIFIED IN A REQUEST FOR INFORMATION (RFI) OR SIMILAR DOCUMENTATION BY THE ENGINEER. EVERY EFFORT WILL BE MADE TO RETURN THE RFIS WITHIN TWO BUSINESS DAYS. SUBMITTALS SHALL CLEARLY IDENTIFY THE SPECIFIC PROJECT, APPLICABLE CODES AND DESIGN CRITERIA, AND DETAILING OF ALL COMPONENTS NECESSARY TO ENSURE PROPER INSTALLATION OF THE COMPONENTS AND SYSTEM.

SHOP DRAWINGS SHOULD BE SUBMITTED FOR ALL COMPONENTS OF THE STRUCTURAL FRAMING SYSTEM, AS REQUIRED BY THE ARCHITECT, AND AS NOTED ELSEWHERE IN THESE NOTES, INCLUDING, BUT NOT LIMITED TO: CONCRETE MIX DESIGNS MASONRY BLOCK MASONRY BLOCK ACCESSORIES

MASONRY REINFORCING CONCRETE REINFORCEMENT PRE-ENGINEERED WOOD TRUSSES PRECAST CONCRETE COMPONENTS ANY ALTERNATE MATERIAL/PRODUCT SUBSTITUTIONS

IT SHALL BE THE CONTRACTOR'S RESPONSIBILITY TO COORDINATE ALL TRADES AND CONSULTANTS. CROSS REFERENCE THEIR DRAWINGS WITH THE OVERALL DESIGN, AND PROVIDE TO EACH A COMPLETE SET OF DRAWINGS AND SUBMITTALS TO INSURE COMPATIBILITY OF CONSTRUCTION PER **DESIGN INTENT** 

#### FOUNDATIONS:

ARE DESIGNED FOR AN ALLOWABLE SOIL BEARING PRESSURE OF 2,000 PSF ON COMPACTED FILL OR NATIVE SOIL. BEFORE CONSTRUCTION COMMENCES, SOIL BEARING CAPACITY SHALL BE VERIFIED BY A SUBSURFACE INVESTIGATION FOR THE NEW GARAGE ADDITION, AS WELL AS FIELD AND LABORATORY TESTS PERFORMED BY A CERTIFIED TESTING LABORATORY, WHOSE REPORT SHALL INCLUDE ANALYSIS AND RECOMMENDATIONS FOR SITE PREPARATION IN ORDER TO BEAR THE FOUNDATION LOADS. ABOVE REPORT SHALL BE SUBMITTED TO THE STRUCTURAL ENGINEER FOR **REVIEW BEFORE FOUNDATION CONSTRUCTION BEGINS.** 

#### **REINFORCING STEEL**

SHALL BE ASTM A615 GRADE 60 DEFORMED BARS, FREE FROM OIL, SCALE AND RUST AND PLACED IN ACCORDANCE WITH THE TYPICAL BENDING DIAGRAM AND PLACING DETAILS OF ACI STANDARDS AND SPECIFICATIONS. SECURE APPROVAL OF SHOP DRAWINGS PRIOR TO COMMENCING FABRICATION.

#### WELDED WIRE FABRIC:

TO CONFORM TO ASTM A-185, FREE FROM OIL, SCALE AND RUST AND PLACED IN ACCORDANCE WITH THE TYPICAL PLACING DETAILS OF ACI STANDARDS AND SPECIFICATIONS. MINIMUM LAP SHALL BE ONE SPACE PLUS TWO INCHES.

#### CONCRETE:

SHALL BE PER AN APPROVED MIX DESIGN PROPORTIONED TO ACHIEVE A STRENGTH AT 28 DAYS AS LISTED BELOW WITH A PLASTIC AND WORKABLE MIX:

3000 PSI FOR FOUNDATIONS AND SLABS ON GRADE 4000 PSI FOR ALL OTHER STRUCTURAL CONCRETE.

CONCRETE SHALL BE PLACED AND CURED ACCORDING TO ALL STANDARDS AND SPECIFICATIONS.

NOTIFY ENGINEER OF RECORD WITHIN 48 HOURS OF ALL CONCRETE POURS VIA EMAIL OR WRITTEN CORRESPONDENCE.

SUBMIT PROPOSED MIX DESIGN WITH RECENT FIELD CYLINDER OR LAB TESTS FOR REVIEW PRIOR TO USE. MIX SHALL BE UNIQUELY IDENTIFIED BY MIX NUMBER OR OTHER POSITIVE IDENTIFICATION. MIX SHALL MEET THE REQUIREMENTS OF ASTM C33 FOR COARSE AGGREGATE. FOR ALL FLATWORK, AT LEAST 75% OF LARGE AGGREGATE SHALL CONSIST OF #57 STONE. CONCRETE SHALL COMPLY WITH ALL THE REQUIREMENTS OF ASTM STANDARD C94 FOR MEASURING, MIXING, TRANSPORTING, ETC. CONCRETE TICKETS SHALL BE TIME STAMPED WHEN CONCRETE IS BATCHED.

GROUT LIFT. RECONSOLIDATION IS NOT REQUIRED FOR SELF-CONSOLIDATING GROUT. THE MAXIMUM TIME ALLOWED FROM THE TIME THE MIXING WATER IS ADDED UNTIL IT IS DEPOSITED IN THE TIME BETWEEN PLACING GROUT LIFTS SHALL NOT EXCEED 1 HOUR. ITS FINAL POSITION SHALL NOT EXCEED ONE AND ONE HALF (1-1/2) HOURS. IF FOR ANY REASON THE MAXIMUM POUR HEIGHT IS 24 FEET. THERE IS A LONGER DELAY THAN THAT STATED ABOVE, THE CONCRETE SHALL BE DISCARDED. IT A GROUT KEY SHALL BE PROVIDED AT THE TOP OF EACH GROUT LIFT AND GROUT POUR. SHALL BE THE RESPONSIBILITY OF THE TESTING LAB TO NOTIFY THE OWNER'S REPRESENTATIVE AND GROUT KEYS SHOULD BE FORMED BY TERMINATING THE GROUT 1-1/2 INCHES BELOW A THE CONTRACTOR OF ANY NONCOMPLIANCE WITH THE ABOVE. ALL SLABS SHALL BE CURED USING A MORTAR JOINT. DISSIPATING CURING COMPOUND MEETING ASTM STANDARD C309 TYPE 1-D AND SHALL HAVE A FUGITIVE DYE. THE COMPOUND SHALL BE PLACED AS SOON AS THE FINISHING IS COMPLETED OR AS MASONRY WALLS MARKED AS "LOAD-BEARING" ARE DESIGNED TO CARRY GRAVITY FLOOR LOADS AND SOON AS THE WATER HAS LEFT THE UNFINISHED CONCRETE. ALL SCUFFED OR BROKEN AREAS IN MUST BE CONSTRUCTED TO SUPPORT THE FLOOR SYSTEM, CONCURRENTLY WITH ALL OTHER LOAD-THE CURING MEMBRANE SHALL BE RECOATED DAILY. CALCIUM CHLORIDES SHALL NOT BE UTILIZED; BEARING CONCRETE AND STEEL COLUMNS. OTHER ADMIXTURES MAY BE USED ONLY WITH THE APPROVAL OF THE ENGINEER.

ALL CONCRETE MIX DESIGNS SHALL INCLUDE A WRITTEN DESCRIPTION INDICATING WHERE EACH PARTICULAR MIX IS TO BE PLACED WITHIN THE STRUCTURE.

GENERAL CONTRACTOR SHALL NOTIFY ENGINEER OF RECORD A MINIMUM OF 48 HOURS PRIOR PLACEMENT OF ANY STRUCTURAL CONCRETE.

ALL CONCRETE DESIGN MIX SUBMITTALS SHALL INCLUDE TESTED, STATISTICAL BACK-UP DATA AS PER CHAPTER 5 OF ACI 318-14.

WATER/CEMENT RATIO FOR CONCRETE AT EXTERIOR BALCONIES SHALL NOT EXCEED 0.40 BY WEIGHT AND HAVE 5,000PSI MINIMUM COMPRESSIVE CAPACITY.

UNLESS NOTED OTHERWISE ON PLANS, THE FOLLOWING CONCRETE CLEAR COVER SHALL BE PROVIDED FOR ALL NON-PRESTRESSED CONCRETE REINFORCEMENT PER ACI 318:

CONCRETE CAST AGAINST EARTH: CONCRETE EXPOSED TO EARTH (FORMED F CONCRETE EXPOSED TO WEATHER:

WHERE NOT EXPOSED TO EARTH OR WEATH SLABS, WALLS, AND JOISTS:

BEAMS AND COLUMNS:

SEE ACI 318 FOR ADDITIONAL REQUIREMENTS AND MORE INFORMATION.

CONCRETE TESTING: AN INDEPENDENT TESTING LABORATORY SHALL PERFORM THE FOLLOWING TESTS ON CAST IN PLACE CONCRETE:

A) ASTM C143 - "STANDARD TEST METHOD FOR SLUMP OF PORTLAND CEMENT CONCRETE." MAXIMUM SLUMP SHALL BE 4-6 INCHES, PRIOR TO ADDING A SUPER PLASTICIZER. B) ASTM C39 - "STANDARD TEST METHOD FOR COMPRESSIVE STRENGTH OF CYLINDRICAL CONCRETE SPECIMENS." A SEPARATE TEST SHALL BE CONDUCTED FOR EACH CLASS, FOR EVERY 50 CUBIC YARDS (OR FRACTION THEREOF), PLACED PER DAY. REQUIRED CYLINDER(S) QUANTITIES AND TEST AGE AS FOLLOWS: 1 AT 7 DAYS

2 AT 28 DAYS

ONE ADDITIONAL RESERVE CYLINDER TO BE TESTED UNDER THE DIRECTION OF THE ENGINEER, IF REQUIRED. IF 28 DAY STRENGTH IS ACHIEVED, THE ADDITIONAL CYLINDER(S) MAY BE DISCARDED.

POUR STRUCTURAL CONCRETE WITHIN THE FOLLOWING TOLERANCES: VARIATION FROM PLUMB: 1/4" IN 10'-0" VARIATION FROM LEVEL IN TOPS OF PILASTERS: 1/8" IN 10'-0" VARIATION FOOTINGS: PLAN DIMENSIONS: +2", - 1/2" THICKNESS: - 0"

#### CHEMICAL ANCHORS:

SHALL BE AN EQUAL TWO PART EPOXY POLYMER INJECTION SYSTEM, SUCH AS SIMPSON SET-XP "STRUCTURAL ANCHORING ADHESIVE". HILTI HIT-HY 150 MAX-SD OR ENGINEER APPROVED SUBSTITUTION, INSTALLED IN ACCORDANCE WITH MANUFACTURERS INSTRUCTIONS. INSTALLERS SHALL BE TRAINED BY THE MANUFACTURER'S REPRESENTATIVE. BRUSH AND BLOW OUT ALL HOLES.

#### MASONRY WALLS:

MASONRY UNITS SHALL MEET ASTM C-90 FOR HOLLOW LOAD BEARING TYPE MASONRY WITH UNIT STRENGTH OF 2000 PSI ON THE NET AREA (F'M = 2000 PSI). MORTAR SHALL BE TYPE "M" OR "S" AND MEET ASTM C-270. GROUT SHALL BE 3000 PSI MINIMUM COMPRESSIVE STRENGTH AND MEET ASTM C-476. PROVIDE HOOKED DOWELS IN FOOTINGS FOR ALL VERTICAL REINFORCING ABOVE. LAP SPLICES 48 BAR DIAMETERS.

BLOCK CELLS AS SHOWN ON PLANS SHALL BE GROUT FILLED WITH VERTICAL REINFORCING BARS. SEE PLAN NOTES FOR BAR SIZE AND SPACING. DOWELS SHALL BE USED TO PROVIDE CONTINUITY INTO THE STRUCTURE ABOVE AND/OR BELOW. UNLESS NOTED OTHERWISE. USE METAL LATH. MORTAR, OR SPECIAL UNITS TO CONFINE CONCRETE AND GROUT TO AREA REQUIRED. CELLS TO BE GROUT FILLED SHALL HAVE VERTICAL ALIGNMENT SUFFICIENT TO MAINTAIN A CLEAR, UNOBSTRUCTED. CONTINUOUS VERTICAL GROUT SPACE.

FACE): HER:	ALL BARS ALL BARS #6 BARS AND GREATER #5 BARS AND SMALLER	- - -	3" 2" 2" 1 1/2"
NEK.	#14 & #18 BARS		1 1/2"
	#11 BARS AND SMALLER		3/4"
	ALL BARS		1 1/2"

PROVIDE 9 GAUGE GALVANIZED HORIZONTAL JOINT REINFORCING (DUR-O-WALL OR ENGINEER APPROVED SUBSTITUTION) AT ALTERNATE BLOCK COURSES, BEGINNING 8" ABOVE FOOTINGS AND FLOOR LEVELS. MASONRY WALLS ABOVE OPENINGS SHALL BE REINFORCED AT THE SAME SPACING AS THE WALL WITH DOWELS HOOKED INTO THE BEAM OR LINTEL ABOVE THE OPENING.

GROUT LIFT: AN INCREMENT OF GROUT HEIGHT WITHIN A TOTAL GROUT POUR. GROUT POUR: THE TOTAL HEIGHT OF MASONRY TO BE GROUTED PRIOR TO ERECTION OF ADDITIONAL MASONRY. A GROUT POUR CONSISTS OF ONE OR MORE GROUT LIFTS. GROUT POURS SHALL SET FOR A MINIMUM OF 4 HOURS BEFORE ANY ADDITIONAL GROUT PLACEMENT

GROUT SHALL HAVE A SLUMP BETWEEN 8 AND 11 INCHES, EXCEPT SELF-CONSOLIDATING GROUT. JOB-SITE PROPORTIONING OF SELF-CONSOLIDATING GROUT IS NOT PERMITTED.

MASONRY GROUTING REQUIREMENTS:

- FIELD-MIXED GROUT SHALL BE PLACED WITHIN 1-1/2 HOURS FROM INTRODUCING WATER INTO THE MIXTURE AND BEFORE INITIAL SET.
- GROUT SLUMP REQUIREMENTS: FOR GROUT SLUMP BETWEEN 8 AND 10 INCHES, THE MAXIMUM GROUT LIFT HEIGHT IS 5
- FEET.
- FOR GROUT SLUMP BETWEEN 10 AND 11 INCHES, THE MAXIMUM GROUT LIFT HEIGHT IS
- 12.67 FEET. FOR SELF-CONSOLIDATING GROUT, THE GROUT LIFT HEIGHT SHALL NOT EXCEED THE GROUT POUR HEIGHT (24 FEET MAX.).

GROUT LIFT HEIGHTS EXCEEDING 5 FEET SHALL MEET THE FOLLOWING REQUIREMENTS:

- MASONRY MORTAR HAS CURED FOR AT LEAST 4 HOURS. GROUT SLUMP IS BETWEEN 10 AND 11 INCHES.
- NO INTERMEDIATE BOND BEAMS ARE PLACED BETWEEN THE TOP AND BOTTOM OF THE
- GROUT LIFT HEIGHT. EACH GROUT LIFT SHALL BE CONSOLIDATED BY MECHANICAL VIBRATION AT THE TIME OF
- PLACEMENT. CONSOLIDATION IS NOT REQUIRED FOR SELF-CONSOLIDATING GROUT.
- EACH GROUT LIFT SHALL BE RECONSOLIDATED BY MECHANICAL VIBRATION AFTER INITIAL WATER LOSS AND SETTLEMENT HAS OCCURRED, AND BEFORE ADDING THE SUBSEQUENT

MASONRY WALLS MARKED AS "INFILL" ARE NOT DESIGNED TO CARRY GRAVITY FLOOR LOADS AND MUST BE CONSTRUCTED AFTER THE FLOOR SYSTEM, WITH ALL LOAD-BEARING COMPONENTS, HAVE BEEN INSTALLED AND THE FLOOR SYSTEM UNSHORED.

AT SILLS OF MASONRY OPENINGS IN LOAD-BEARING MASONRY WALLS, PROVIDE AN 8" KNOCKOUT COURSE, GROUTED SOLID AND REINFORCED WITH 1 #5 CONTINUOUS HORIZONTAL BAR, TYPICAL UNLESS NOTED OTHERWISE ON PLAN OR DETAILS.

#### TIE BEAMS:

BEAMS WITH THE PREFIX "TB" SHALL BE OF CONCRETE POURED AFTER THE BLOCK WALLS BELOW ARE IN PLACE. REINFORCING SHALL BE CONTINUOUS THROUGH TIE BEAMS WITH MINIMUM LAP SPLICES OF 48 BAR DIAMETERS AND BENT BARS AT CORNERS. USE METAL LATH, MORTAR, OR SPECIAL UNITS TO CONFINE CONCRETE TO AREA REQUIRED, IN ACCORDANCE WITH ACI 530.1, SECTION 4.3.3.3 (SOLID METAL OR FELT CAVITY CAPS ARE PROHIBITED).

#### LINTELS:

MASONRY OPENINGS LESS THAN 4 FEET SHALL BE SPANNED WITH AN 8" SPAN RATED PRECAST/PRESTRESSED CONCRETE LINTEL. ALL PRECAST LINTELS SHALL BEAR A MINIMUM OF 8" AT EACH END ON A GROUT FILLED CELL

#### WOOD:

STRUCTURAL WOOD COMPONENTS (BEAMS, JOISTS, RAFTERS, ETC.) SHALL HAVE THE FOLLOWING MINIMUM ALLOWABLE FIBER STRESSES FOR NO. 2 SOUTHERN PINE CONFORMING TO NATIONAL DESIGN SPECIFICATION (NDS) FOR WOOD CONSTRUCTION WITH 2015 NDS SUPPLEMENT, AS FOLLOWS:

BENDING 2X8 FB = 925 P				= 175 PS = 1,000 PS = 925 PS = 800 PS
------------------------	--	--	--	------------------------------------------------

WOOD IN CONTACT WITH CONCRETE OR MASONRY, AND AT OTHER LOCATIONS AS SHOWN ON STRUCTURAL DRAWINGS, SHALL BE PROTECTED OR PRESSURE TREATED IN ACCORDANCE WITH AITC-109. MEMBER SIZES SHOWN ARE NOMINAL UNLESS NOTED OTHERWISE.

ALL NAILS SHOWN ON PLANS ASSUME COMMON WIRE NAILS UNLESS SPECIFICALLY NOTED ON DRAWINGS.

ENGINEERED WOOD TRUSS SYSTEMS SHALL BE DESIGNED BY SUPPLIER'S SPECIALTY ENGINEER TO CONFIGURATION AND LOAD-CARRYING CAPACITY SHOWN ON DRAWINGS AND SPECIFICATIONS. ALL INDIVIDUAL TRUSS MEMBERS, TRUSS PLATE CONNECTIONS, TRUSS-TO-TRUSS CONNECTIONS, COMMON TRUSSES AND GIRDER TRUSSES SHALL BE DESIGNED FOR COMPONENT AND CLADDING WIND LOADING, EXCEPT THOSE TRUSSES EXCEEDING 700 SQUARE FEET IN TRIBUTARY AREA. ALTERNATE TRUSS LAYOUTS ARE ACCEPTABLE ONLY AS A CHANGE ORDER WHICH WILL INCLUDE ENGINEERING CHARGES FOR REDESIGN OF THE STRUCTURE BY THE ENGINEER OF RECORD. SUBMIT SHOP DRAWINGS FOR REVIEW PRIOR TO FABRICATION. SHOP DRAWINGS SHALL SHOW AND SPECIFY ALL CONNECTOR TYPES UTILIZED WITHIN TRUSSES, AS WELL AS CONNECTORS UTILIZED IN ALL OTHER CONNECTIONS AND ATTACHMENTS BETWEEN TRUSSES OR COMPONENTS SUPPLIED AS PART OF THE ENGINEERED TRUSS SYSTEM. AN ERECTION DRAWING SHALL BE INCLUDED, IDENTIFYING ALL TRUSS SYSTEM COMPONENTS, AS WELL AS ALL PERMANENT BRACING REQUIRED FOR TRUSS DESIGN

"FLOOR TRUSSES" AND "4X2 TRUSSES" REFER TO TRUSSES WITH THE TOP AND BOTTOM CHORDS ORIENTED WITH THE STRONG AXIS HORIZONTAL (I.E. ON THE FLAT). "ROOF TRUSSES" AND "2X4 TRUSSES" REFER TO TRUSSES WITH THE TOP AND BOTTOM CHORDS ORIENTED WITH THE STONG AXIS VERTICAL.

ENGINEERED SHOP DRAWINGS SHALL BEAR THE SIGNATURE AND IMPRESSED SEAL OF A FLORIDA REGISTERED PROFESSIONAL ENGINEER AS THE SPECIALTY ENGINEER. PLUMBING, ELECTRICAL, AND MECHANICAL DRAWINGS SHALL BE COORDINATED WITH THE TRUSS LAYOUT TO ENSURE THAT THERE ARE NO CONFLICTS WITH DUCTS, RECESSED FIXTURES, PLUMBING PIPES, TRAPS, HOODS, CEILING STEPS/SLOPES, ETC. TRUSS LAYOUT SHALL BE MODIFIED AND/OR TRUSS CHASES SHALL BE ADDED TO AVOID CONFLICTS. TRUSS SPACING SHALL NOT EXCEED MAXIMUM NOTED IN PLAN NOTES, U.N.O.

ALL CONNECTORS SHALL BE GALVANIZED. CONNECTOR MODEL NUMBERS SHOWN ARE STRONG-TIE CONNECTORS AS MANUFACTURED BY SIMPSON STRONG-TIE CO., 5956 W. LAS POSITAS BLVD., P.O. BOX 10789, PLEASANTON, CA 94588, 800-999-5099, WWW.STRONGTIE.COM. SUBSTITUTIONS ARE ACCEPTABLE WITH THE APPROVAL OF THE STRUCTURAL ENGINEER. UNLESS SHOWN OTHERWISE INSTALL THE *LARGEST* FASTENER SIZE AND *MAXIMUM* NUMBER OF FASTENERS SHOWN IN LATEST SIMPSON CATALOG. WHERE SDS SCREWS ARE SPECIFIED IN THE SIMPSON CATALOG, SDS SCREWS MUST BE USED UNLESS EXPRESSLY SHOWN IN THE DRAWINGS OTHERWISE.

ALL COLUMN BASE AND HOLD-DOWN CONNECTORS (HDU, HTT, LTT, ETC.) FOR STRUCTURAL COMPOSITE LUMBER (PSL, LVL, LSL, ETC.) SHALL BE INSTALLED IN THE WIDE FACE OF THE COLUMN, AND NOT THE NARROW FACE. THE NARROW FACE IS THE SURFACE THAT SHOWS THE VERTICAL THIN EDGES OF THE STRUCTURAL COMPOSITE LUMBER LAYERS.

THE FOLL

DEAD LOAD	0.90
DEAD LOAD + FLOOR LIVE LOAD	1.00
DEAD LOAD + ROOF LIVE LOAD	1.25
DEAD LOAD + WIND LOAD	1.60

THE SUPERIMPOSED DEAD LOAD, AS SPECIFIED IN THE DESIGN LOADS SECTION ABOVE, INCLUDES THE OVERALL WEIGHT OF THE FIRE SPRINKLER SYSTEM PIPES. THE GENERAL CONTRACTOR SHALL PROVIDE THE TRUSS MANUFACTURER WITH THE LOCATIONS OF THE PIPE SUPPORTS AND THE LOADS FROM ALL SPRINKLER LINES GREATER THAN 2" DIAMETER.

~


S

PLYWOOD ROOF, FLOOR, AND WALL SHEATHING ARE DESIGNED AS DIAPHRAGMS AND SHALL COMPLY WITH APPLICABLE PROVISIONS OF CHAPTER 23 OF THE FLORIDA BUILDING CODE AND SHALL BE FASTENED IN ACCORDANCE WITH THE MINIMUM REQUIREMENTS OF TABLES 2306.2.1 OR 2306.3. UNLESS SHOWN OTHERWISE. PLYWOOD SHALL BE INSTALLED WITH THE STRENGTH AXIS OF EACH PANEL PERPENDICULAR TO THE SUPPORTS IN ALL CASES. PLYWOOD ROOF PANELS SHALL BE INSTALLED AS SHOWN IN CASES 1 THROUGH 4 IN TABLE 2306.2.1 (CONT.). BLOCKING SHALL BE PROVIDED BETWEEN ALL WOOD ROOF FRAMING MEMBERS AT ALL RIDGES AND VALLEYS FOR FULL PLYWOOD EDGE SUPPORT.

#### WOOD FRAMING CONNECTORS:

MARK	DESCRIPTION
# &	POUND(S) AND
DIA	DIAMETER
ARCH	ARCHITECTURAL
B OR BOT	BOTTOM
B/ OR B.O.	BOTTOM OF
BP	BASEPLATE
CANT	CANTILEVER
CJ CLR	CONTROL JOINT CLEAR
CONT	CONTINUOUS
EA	EACH
EE	EACH END
EF	EACH FACE
EJ	EXPANSION JOINT
EL	ELEVATION
EMBED	
EOR EOS	(STRUCTURAL) ENGINEER OF RECOP EDGE OF SLAB
EQ	EQUAL
EW	EACH WAY
EXIST	EXISTING
F'C	28 DAY COMPRESSIVE STRENGTH
FFE	FINISHED FLOOR ELEVATION
FRT	FIRE RETARDANT TREATED
FTG	FOOTING
GC GA	GENERAL CONTRACTOR GAUGE
GALV	GAUGE
H OR HORIZ	HORIZONTAL
HSS	HOLLOW STRUCTURAL STEEL
KJ	CONSTRUCTION JOINT
LLH	LONG LEG HORIZONTAL
LLV	LONG LEG VERTICAL
LW MAX	LONG WAY MAXIMUM
MIN	MINIMUM
NAVD	NORTH AMERICAN VERTICAL DATUM
NGVD	NATIONAL GEODETIC VERTICAL DAT
NIC	NOT IN CONTRACT
00	ON CENTER
OH OR OPP. HAND PLF	OPPOSITE HAND POUNDS PER LINEAR FOOT
PROJ	PROJECTION
PSF	POUNDS PER SQUARE FOOT
PSI	POUNDS PER SQUARE INCH
PT	PRESSURE TREATED
REF	REFERENCE
REINF	REINFORCING
REQ'D RTF	REQUIRED RIPPED TO FIT
SIM	SIMILAR
SS	STAINLESS STEEL
STD	STANDARD
SW	SHORT WAY/SHEARWALL
Т	ТОР
T.O. OR T/	TOP OF
THR THRU	THREADED THROUGH
TRANS	TRANSVERSE
TYP	TYPICAL
V OR VERT	VERTICAL
W/	WITH
WD	WOOD
WP	WORKING POINT

941-954-0681	2168 MAIN STREET SARASOTA, FL 34237 T 941.952.0084 F 941.952.0201 FL AA26000857
	SPARKMAN A R C H I T E C T S
	SWEET
	5/19/2020 ENGINEER OF RECORD Cordell S. Van Nostrand FL P.E. # 67580 C.A. # 31580
	TOWN OF LONGBOAT KEY FIRE RESCUE STATION 91 5490 GULF OF MEXICO DRIVE LONGBOAT KEY, FLORIDA 34228 CONFORMED SET 05.22.20
	PROJECT TITLE: TITLE: TITLE: TITLE: FOR: FOR:
	REV DESCRIPTION DATE GRAPHIC SCALE: 0"1" SCALE: As indicated
	PROJECT MANAGER: DRAWN BY: A/E OF RECORD: PROJECT NO: SNELL 19096 SHEET TITLE: STRUCTURAL NOTES
	SHEET NO.: <b>S-1</b> (C) COPYRIGHT 2018 SWEET SPARKMAN ARCHITECTS, INC.

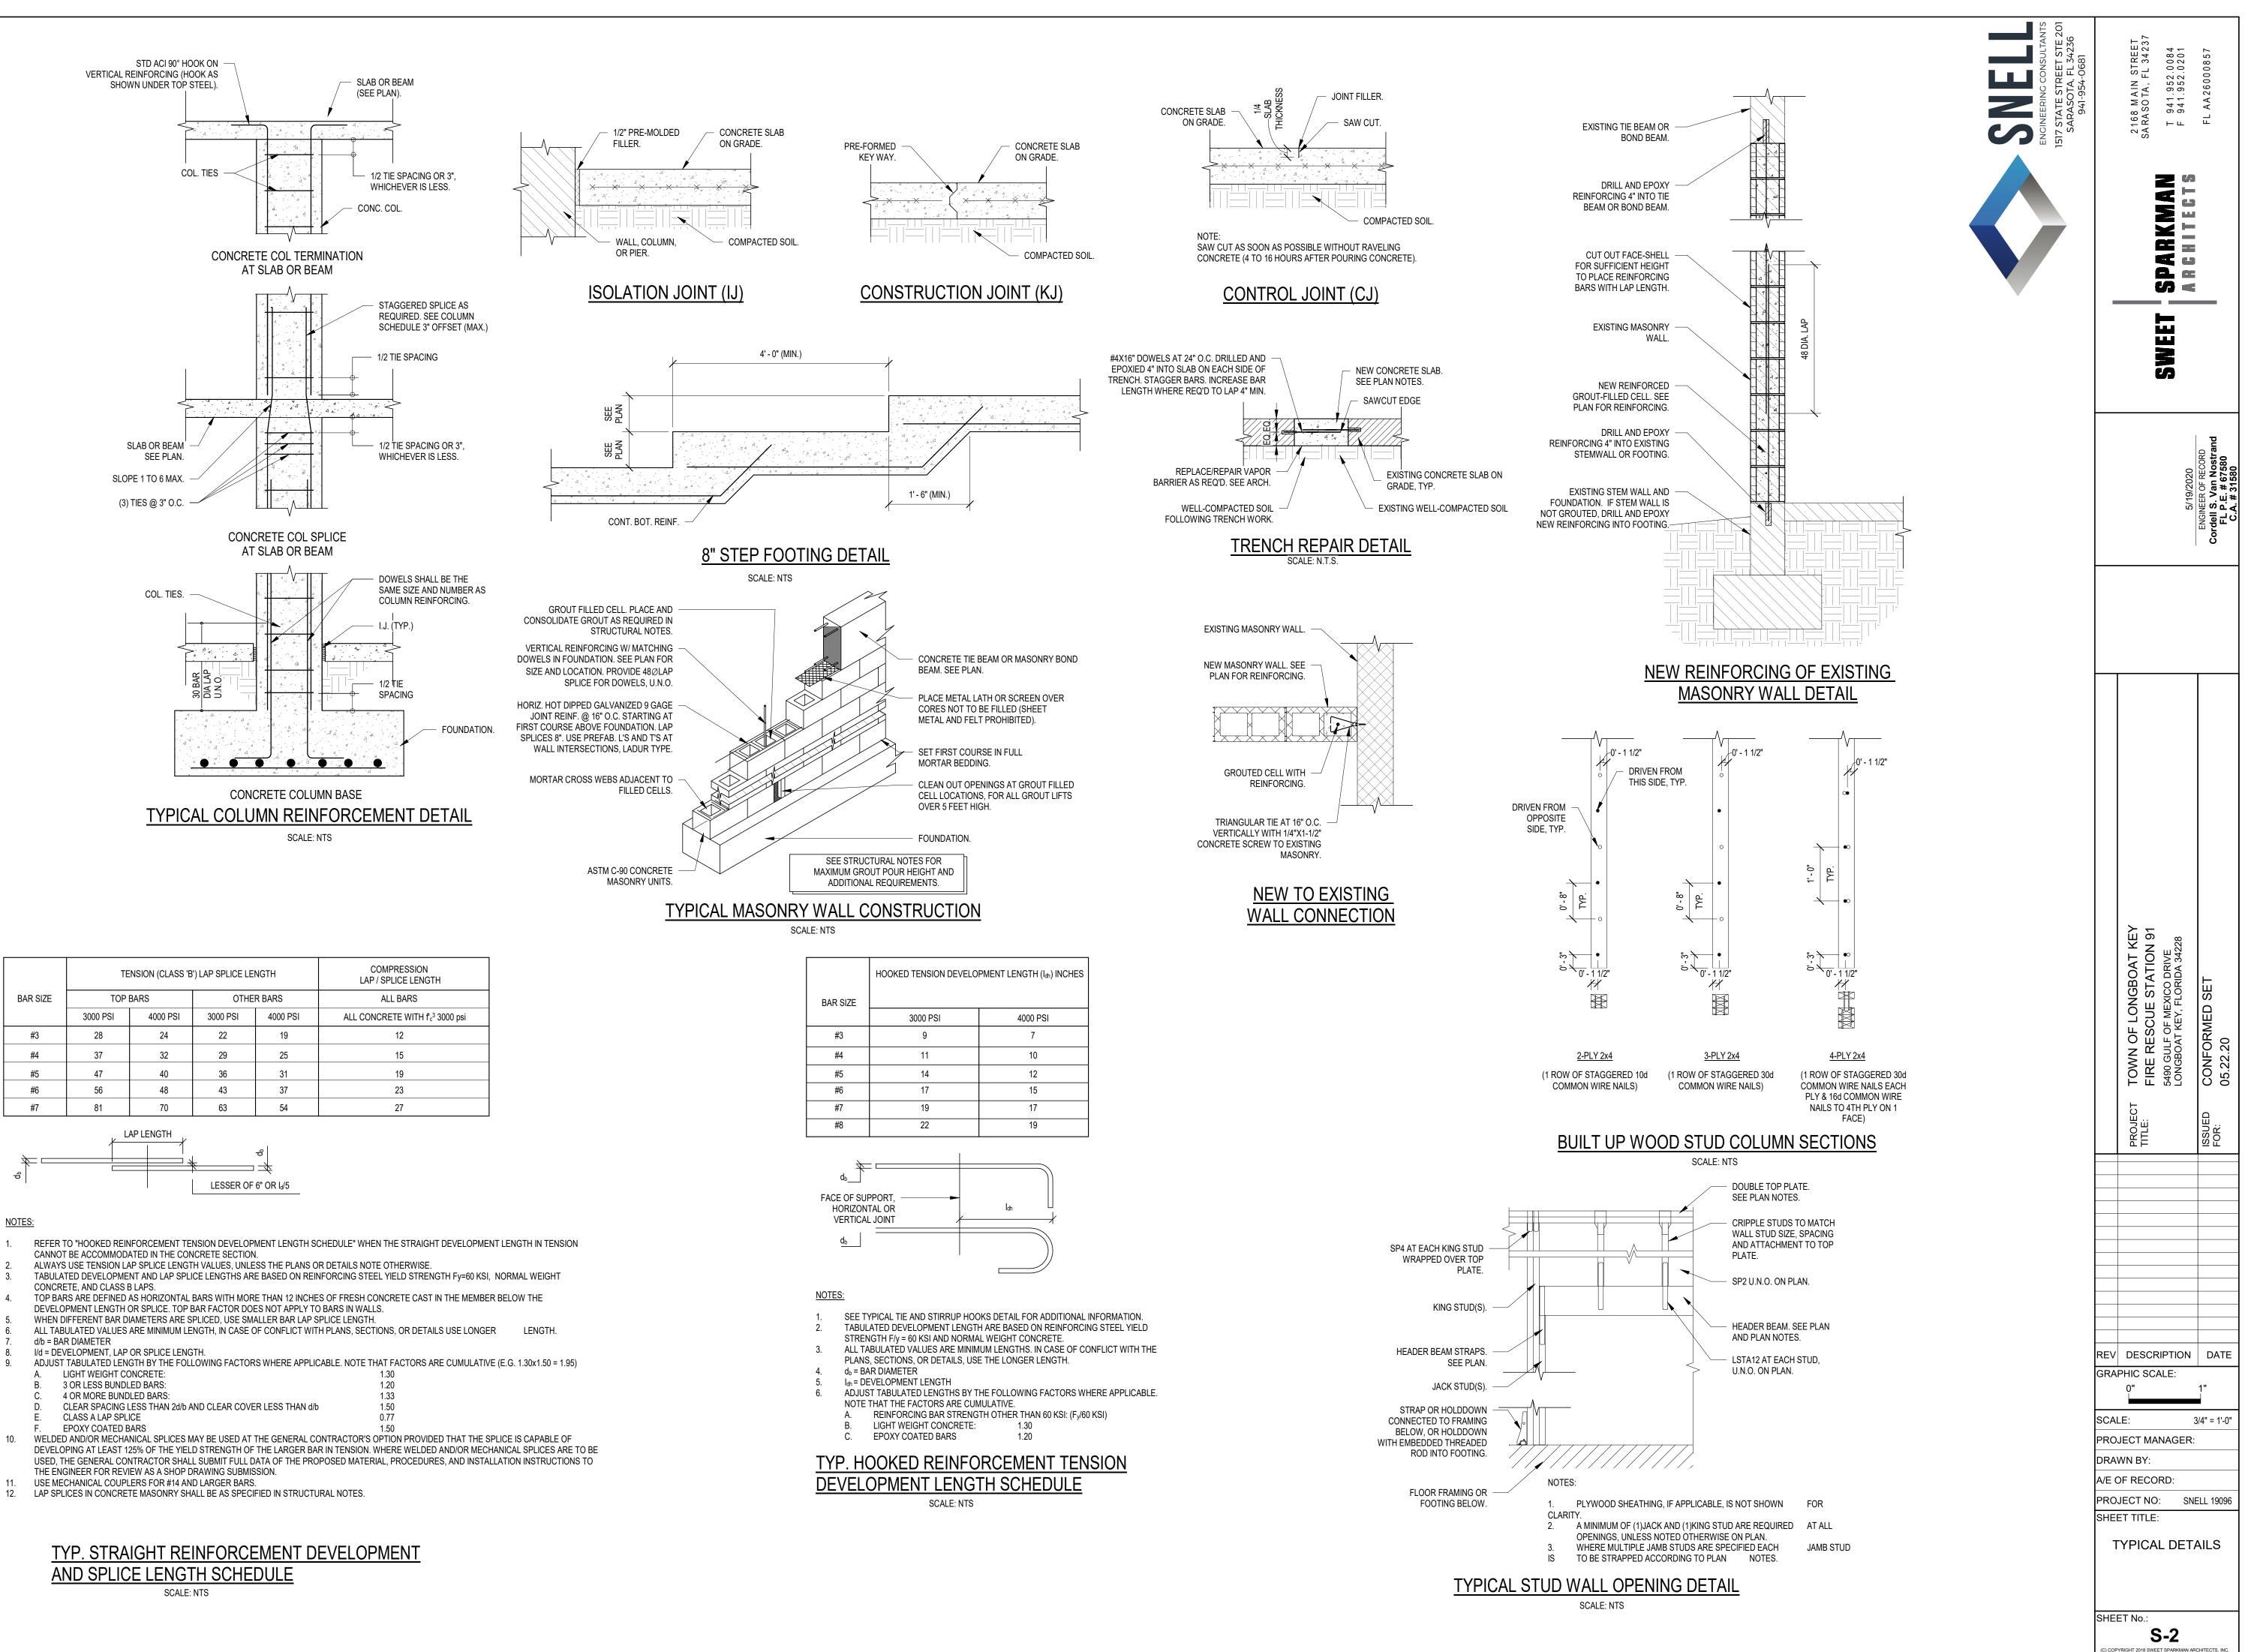

	TENSION (CLASS 'B') LAP SPLICE LENGTH				COMPRESSION LAP / SPLICE LENGTH
BAR SIZE	TOP BARS		OTHER BARS		ALL BARS
	3000 PSI	4000 PSI	3000 PSI	4000 PSI	ALL CONCRETE WITH fc3 3000 psi
#3	28	24	22	19	12
#4	37	32	29	25	15
#5	47	40	36	31	19
#6	56	48	43	37	23
#7	81	70	63	54	27



#### NOTES:

- REFER TO "HOOKED REINFORCEMENT TENSION DEVELOPMENT LENGTH SCHEDULE" WHEN THE STRAIGHT DEVELOPMENT LENGTH IN TENSION 1. CANNOT BE ACCOMMODATED IN THE CONCRETE SECTION.
- ALWAYS USE TENSION LAP SPLICE LENGTH VALUES, UNLESS THE PLANS OR DETAILS NOTE OTHERWISE TABULATED DEVELOPMENT AND LAP SPLICE LENGTHS ARE BASED ON REINFORCING STEEL YIELD STRENGTH Fy=60 KSI, NORMAL WEIGHT
- CONCRETE, AND CLASS B LAPS. TOP BARS ARE DEFINED AS HORIZONTAL BARS WITH MORE THAN 12 INCHES OF FRESH CONCRETE CAST IN THE MEMBER BELOW THE
- DEVELOPMENT LENGTH OR SPLICE. TOP BAR FACTOR DOES NOT APPLY TO BARS IN WALLS.
- ALL TABULATED VALUES ARE MINIMUM LENGTH, IN CASE OF CONFLICT WITH PLANS, SECTIONS, OR DETAILS USE LONGER d/b = BAR DIAMETER
- ADJUST TABULATED LENGTH BY THE FOLLOWING FACTORS WHERE APPLICABLE. NOTE THAT FACTORS ARE CUMULATIVE (E.G. 1.30x1.50 = 1.95) LIGHT WEIGHT CONCRETE:
- 3 OR LESS BUNDLED BARS 4 OR MORE BUNDLED BARS
- CLEAR SPACING LESS THAN 2d/b AND CLEAR COVER LESS THAN d/b
- CLASS A LAP SPLICE
- EPOXY COATED BARS WELDED AND/OR MECHANICAL SPLICES MAY BE USED AT THE GENERAL CONTRACTOR'S OPTION PROVIDED THAT THE SPLICE IS CAPABLE OF 10. DEVELOPING AT LEAST 125% OF THE YIELD STRENGTH OF THE LARGER BAR IN TENSION. WHERE WELDED AND/OR MECHANICAL SPLICES ARE TO BE USED, THE GENERAL CONTRACTOR SHALL SUBMIT FULL DATA OF THE PROPOSED MATERIAL, PROCEDURES, AND INSTALLATION INSTRUCTIONS TO
- USE MECHANICAL COUPLERS FOR #14 AND LARGER BARS. 11.

# AND SPLICE LENGTH SCHEDULE

#### PLAN LEGEND

DETAIL ON S-2.

## INDICATES A NEW OPENING IN AN 8" LOAD BEARING MASONRY WALL. GROUT FILL EACH JAMB BELOW NEW BEARING ANGLE. PROVIDE A NEW FILLED CELL ADJACENT TO THE GROUTED JAMB, WITH 1#5 BAR; SEE NEW REINFORCING OF EXISTING MASONRY WALL

INDICATES AN 8" INFILL MASONRY WALL. PROVIDE ATTACHMENT TO EXISTING MASONRY WALL AS SHOWN IN THE NEW TO EXISTING WALL CONNECTION DETAIL ON S-2.

INDICATES A 2X4 SO. PINE #2 WOOD WALL WITH STUDS AT 16" O.C. MAX. EACH STUD IN WALL TO HAVE AN SP1 TO SINGLE BOTTOM PLATE AND SP2 TO DOUBLE-TOP PLATE. PROVIDE HORIZONTAL BLOCKING AT 4'-0" O.C. MAX. ATTACH BOTTOM PLATE TO SLAB WITH 1/2" Ø SIMPSON TITEN HD AT 24" O.C.


FOUNDATION SCHEDULE - MAIN					
MARK	WIDTH	LENGTH	DEPTH	REINFORCING	REMARKS
F3.0	3' - 0"	CONT. "	1' - 0"	3#5 BOT. CONT.	
TE12	1' - 0"	CONT.	1' - 4"	2#5 BOT. CONT.	


#### FOUNDATION SCHEDULE NOTES:

1. ENSURE TOP OF FOOTINGS ARE SET 12" MIN. BELOW ADJACENT FINISHED GRADE.


#### FOUNDATION PLAN NOTES:


- 1. VERIFY ALL DIMENSIONS AND ELEVATIONS WITH ARCHITECTURAL DRAWINGS. SEE ARCHITECTURAL AND MEP FOR ADDITIONAL INFORMATION.
- 2. SEE ARCHITECTURAL DRAWINGS FOR ALL SLOPES, DROPS AND DRAIN LOCATIONS IN FLOOR SLAB. MAINTAIN 4" MINIMUM SLAB DEPTH. THICKEN SLAB TO 8" WITHIN 4" OF ALL SLAB STEPS; MAINTAIN 4" MINIMUM SLAB DEPTH ELSEWHERE.
- 3. ELEVATIONS SHOWN ARE RELATIVE TO THE INTERIOR GROUND FLOOR SLAB SURFACE SET AT 0'-0" (REF.). TOP OF INTERIOR GROUND FLOOR SLAB IS SET AT 10.3' N.A.V.D.
- 4. TOF INDICATES TOP OF FOOTING ELEVATION. CONTRACTOR IS RESPONSIBLE FOR COORDINATING ALL REQUIRED PLUMBING PENETRATIONS THROUGH STEM-WALLS AND ELEVATIONS. NO PENETRATIONS ARE PERMITTED THROUGH FOOTINGS. FOOTINGS MAY STEP AS SHOWN IN THE TYPICAL DETAIL ON S-2. NOTIFY ENGINEER OF STEP LOCATIONS BEFORE PROCEEDING WITH WORK.
- GROUND FLOOR SHALL BE 4" CONCRETE SLAB-ON-GRADE, U.N.O. REINFORCE W/ 6X6 W1.4XW1.4 W.W.F. 5. AT MID-DEPTH.

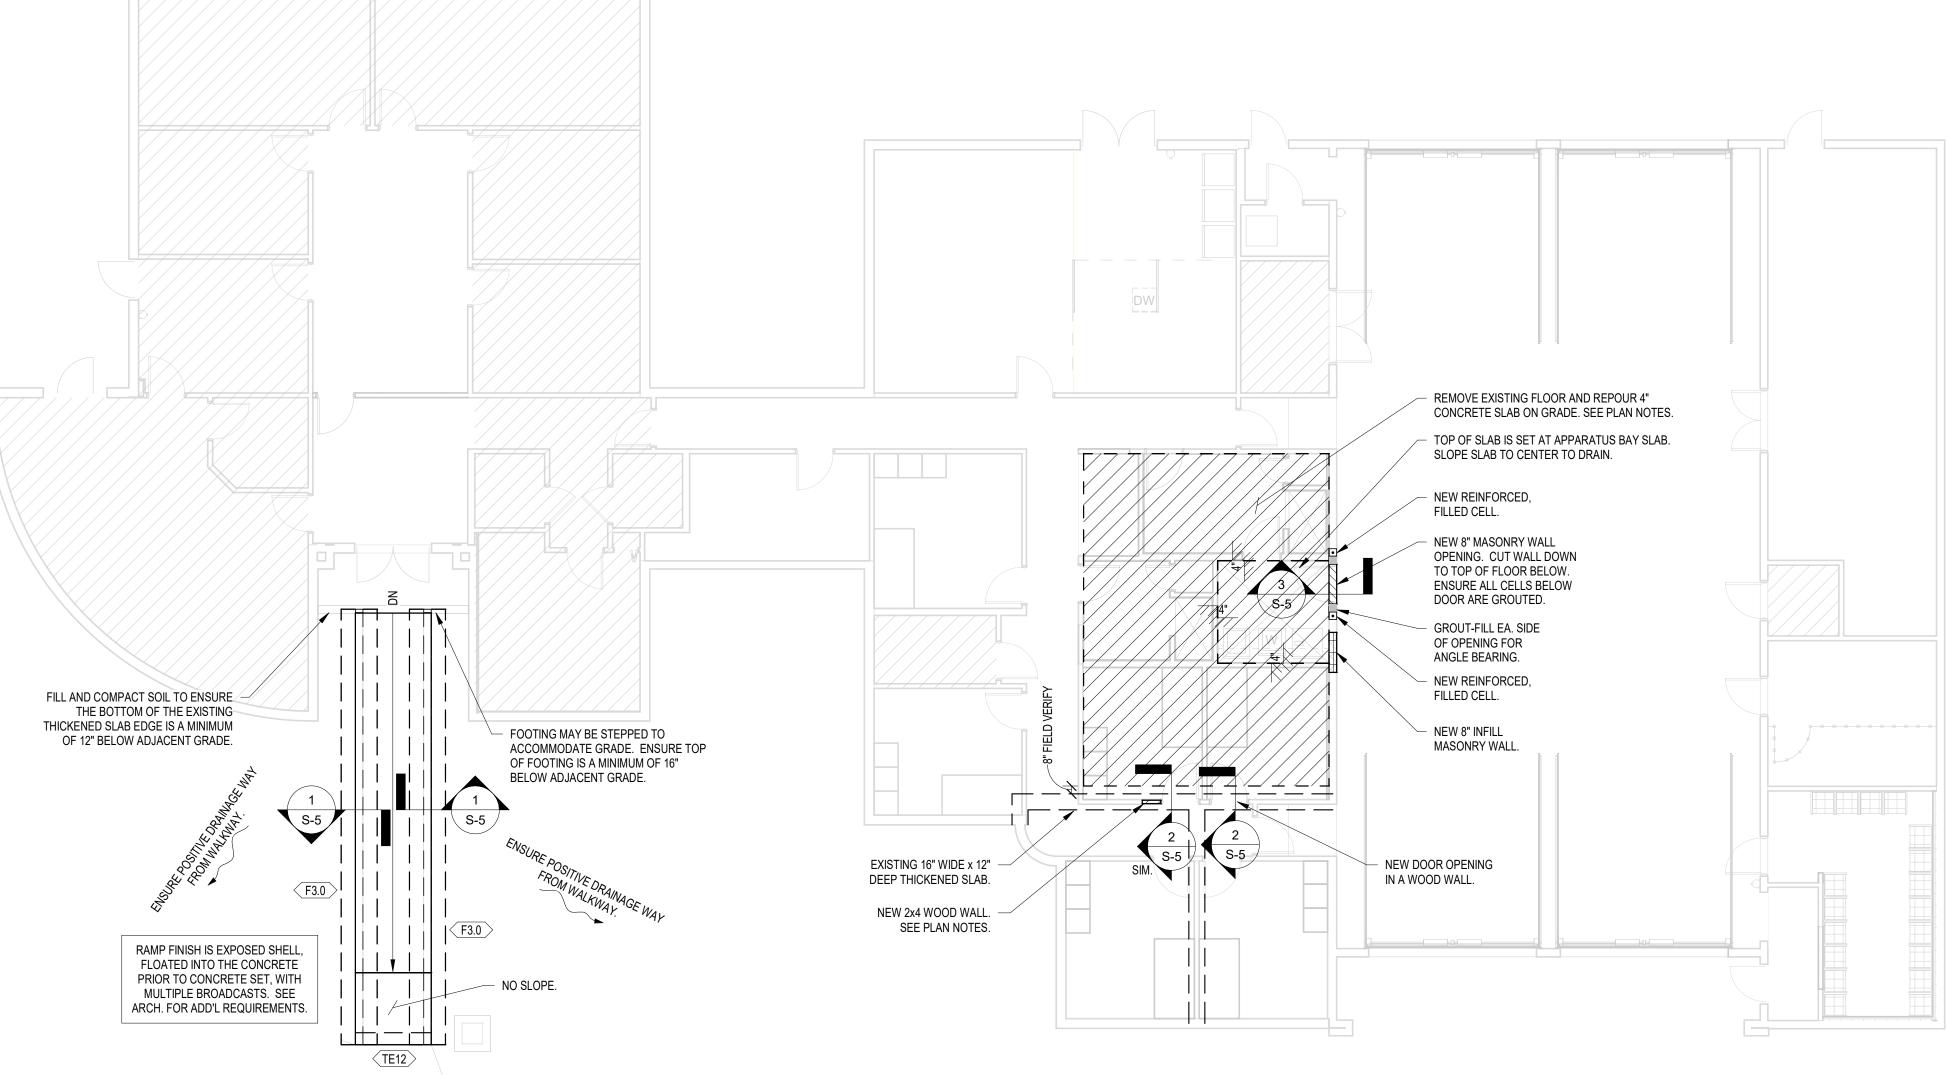

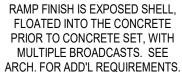



Sarasota, FL 3426	2168 MAIN STREET SARASOTA, FL 34237 T 941.952.0084 F 941.952.0201 FL AA26000857
	F SPARKMAN Architects
	SWEEL
	5/19/2020 ENGINEER OF RECORD Cordell S. Van Nostrand FL P.E. # 67580 C.A. # 31580
	TOWN OF LONGBOAT KEY FIRE RESCUE STATION 91 5490 GULF OF MEXICO DRIVE LONGBOAT KEY, FLORIDA 34228 CONFORMED SET 05.22.20
	PROJECT TITLE: TITLE: FOR: FOR:
	REV DESCRIPTION DATE GRAPHIC SCALE: 0" 1" SCALE: As indicated PROJECT MANAGER: DRAWN BY: A/E OF RECORD: PROJECT NO: SNELL 19096
	SHEET TITLE: FOUNDATION PLAN SHEET No.: SHEET No.: S-3 (C) COPYRIGHT 2018 SWEET SPARKMAN ARCHITECTS, INC.

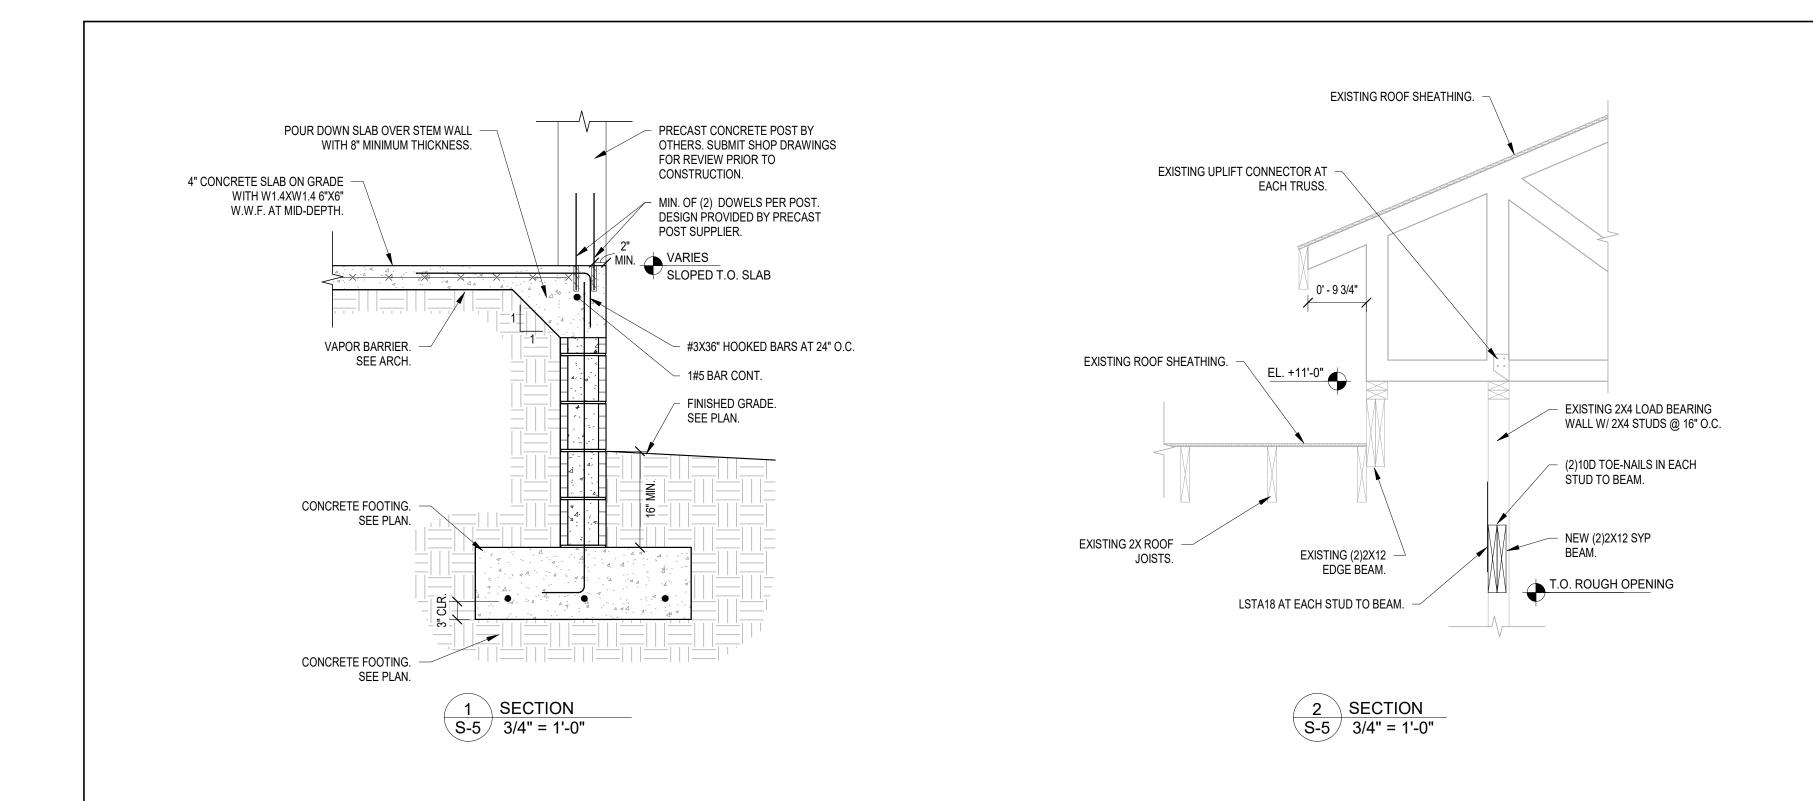

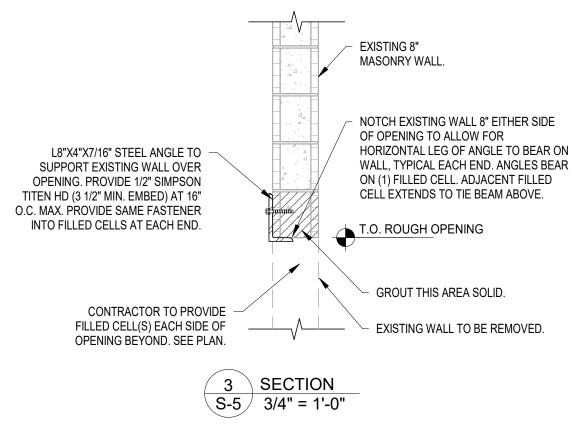


	WIND	LOAD SCHEDULE		
	SCHEDULE (	OF COMPONENTS AND CLAE	DDING LOADS	
ZONE	ZONE DESCRIPTION	TRIBUTARY AREA (SF)	( + PSF)	( - PSF)
		LESS THAN 20	35.0	62.9
1	ROOF INTERIOR ZONE		31.1	54.9
		MORE THAN 100	19.1	39.0
		LESS THAN 20	35.0	86.8
2	ROOF, EDGE ZONE	20 - 100	31.1	78.8
Z		MORE THAN 100	19.1	54.9
	ROOF, OVERHANG,	LESS THAN 20		106.7
	EDGE ZONE	20 - 100		98.7
		MORE THAN 100		90.8
		LESS THAN 20	35.0	86.8
	ROOF, CORNER ZONE		31.1	78.8
3		MORE THAN 100	19.1	54.9
	ROOF, OVERHANG	LESS THAN 20		130.6
	CORNER ZONE	20 - 100	-	106.7
		MORE THAN 100	-	90.8
4		LESS THAN 20	47.0	51.0
4	WALL, INTERIOR ZONE		45.0	49.0
		50 - 100	42.2	46.2
		MORE THAN 100	39.8	45.0
5		LESS THAN 20	47.0	62.9
-	WALL, EDGE ZONE	20 - 50	45.0	58.9
		50 - 100	42.2	52.9
		MORE THAN 100	39.8	49.0
OTE: WIND PRE		SED ON Vasd ASCE 7-16 165 MPH 128 MPH		
RISK CATEGORY =		IV		
EXPOSURE =		D		
ENCLOSURE CLASSIF		ENCLOSED		
	E COEFFICIENT (GCpi) =	±0.18	$\bigwedge$	
a = 2a = 		8 FT 16 FT		

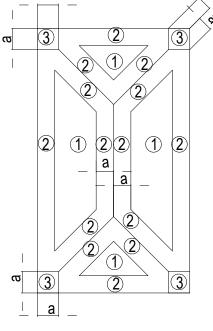

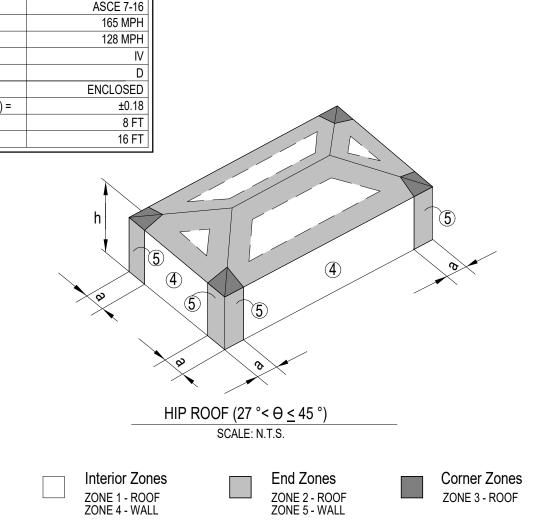

ENCINEERING CONSULTANTS ISIT STATE STREET STE 201 SARASOTA, FL 34236 941-954-0681	2168 MAIN STREET SARASOTA, FL 34237 T 941.952.0084 F 941.952.0201 FL AA26000857 FL AA26000857
	SPARKMAN A R C H I T E C T S
	SWEET
	5/19/2020 ENGINEER OF RECORD Cordell S. Van Nostrand FL P.E. # 67580 C.A. # 31580
	TOWN OF LONGBOAT KEY FIRE RESCUE STATION 91 5490 GULF OF MEXICO DRIVE LONGBOAT KEY, FLORIDA 34228 CONFORMED SET 05.22.20
	PROJECT TITLE: TITLE: ISSUED FOR:
	REV DESCRIPTION DATE GRAPHIC SCALE: 0" 1"
	SCALE: As indicated PROJECT MANAGER: DRAWN BY: A/E OF RECORD: PROJECT NO: SNELL 19096
	SHEET TITLE:
	SHEET NO.: <b>S-5</b> (C) COPYRIGHT 2018 SWEET SPARKMAN ARCHITECTS, INC.

SNE

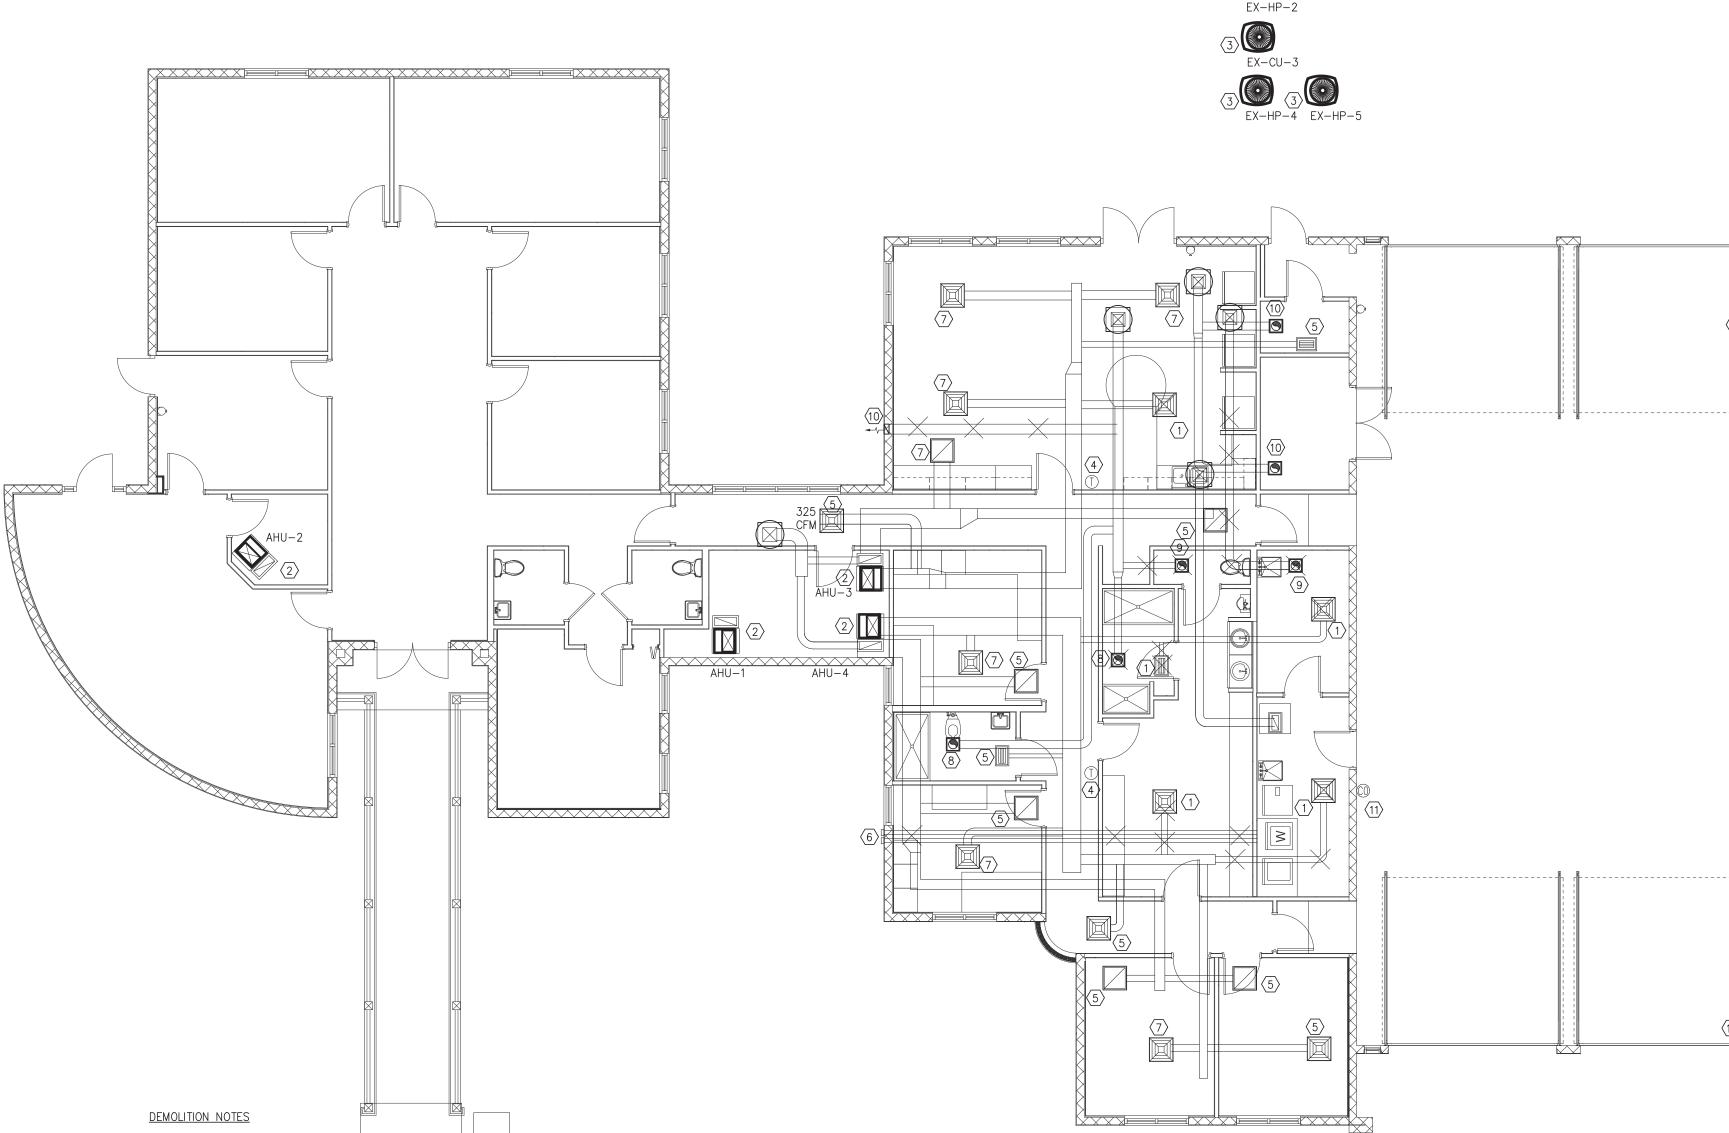

THE DEMOLITION PROCEDURES SHALL PROVIDE FOR SAFE CONDUCT OF THE WORK, PROTECTION OF PERSONNEL, CAREFUL REMOVAL, AND DISPOSAL OF MATERIALS AS INDICATED. THE PROCEDURES ALSO INCLUDE PROTECTION OF PROPERTY TO REMAIN UNDISTURBED, COORDINATION WITH OTHER WORK IN PROGRESS AND TIMELY DISCONNECTION OF UTILITY SERVICES.

EXISTING WORK SHALL NOT BE CUT, DRILLED, ALTERED, REMOVED, OR TEMPORARILY REMOVED FOR THE INSTALLATION REQUIRED TO PERFORM CONSTRUCTION ACTIVITIES OF MECHANICAL AND ELECTRICAL WORK AND OTHER CONSTRUCTION UNDER THE CONTRACT WITHOUT AUTHORIZATION OF THE OWNER. STRUCTURAL MEMBERS OF CONCRETE OR STRUCTURAL STEEL SHALL NOT BE ALTERED WITHOUT AUTHORIZATION OF THE OWNER.

CONDUCT DEMOLITION OPERATIONS AND REMOVE DEBRIS TO ENSURE MINIMUM INTERFERENCE WITH ROADS, STREETS, WALKWAYS, AND OTHER ADJACENT OCCUPIED AND USED FACILITIES.

REMOVE AND LEGALLY DISPOSE OF ITEMS EXCEPT THOSE INDICATED TO BE REINSTALLED, SALVAGED, OR TO REMAIN THE OWNER'S PROPERTY.

EXISTING TO REMAIN: PROTECT CONSTRUCTION INDICATED TO REMAIN AGAINST DAMAGE AND SOILING DURING DEMOLITION. WHEN PERMITTED BY THE ARCHITECT, ITEMS MAY BE REMOVED TO A SUITABLE, PROTECTED STORAGE LOCATION DURING DEMOLITION AND THEN CLEANED AND REINSTALLED IN THEIR ORIGINAL LOCATIONS.

EXCEPT FOR ITEMS OR MATERIALS INDICATED TO BE REUSED, SALVAGED, OR OTHERWISE INDICATED TO REMAIN THE OWNER'S PROPERTY, DEMOLISHED MATERIALS SHALL BECOME THE CONTRACTOR'S PROPERTY AND SHALL BE REMOVED FROM THE SITE WITH FURTHER DISPOSITION AT THE CONTRACTOR'S OPTION. NATIONAL CODES. CONTRACTOR MUST CERTIFY TO OWNER THAT THE MATERIAL HAS BEEN LEGALLY DISPOSED OF IN WRITTEN FORM.

- DEMOLITION NOTES
- $\langle 1 \rangle$  existing air device to be demolished. Items to be demolished include associated ductwork and hangers.

- $\fbox{2}$  existing air handling unit to be demolished and replaced. Refer to NeW A/C schedule on mechanical sheet M2.0.


- $\langle 3 \rangle$  EXISTING CONDENSING UNIT TO BE DEMOLISHED AND REPLACED. REFER TO NEW LOCATIONS INDICATED ON SHEET M1.1.. REFER TO NEW A/C SCHEDULE ON MECHANICAL SHEET M2.0.
- $\langle 4 
  angle$  existing thermostat to remain.
- $\overline{5}$  EXISTING AIR DEVICE TO REMAIN.
- 6 EXISTING DRYER EXHAUST DUCTWORK TO BE ABANDONED, BACKFILLED AND CAPPED AT BOTH


B) EX-HP-1

- ENDS.
- $\langle \overline{7} \rangle$  existing air device to be reused and relocated. Refer to mechanical sheet M1.1 For location.
- 8 EXISTING EXHAUST FAN TO REMAIN.
- $\langle 9 \rangle$  EXISTING EXHAUST FAN TO BE DEMOLISHED.
- 10 existing downflow kitchen hood ductwork to be abandoned, backfilled and capped at both ends.
- (11) EXISTING APPARATUS BAY EXHAUST FANS AND CONTROLS TO REMAIN. CONTRACTOR SHALL PROVIDE ROUTINE MAINTENANCE.
- $\overleftarrow{12}$  existing louver to be demolished. Existing wall to be infilled.
- $\overline{(13)}$  EXISTING PTAC TO BE DEMOLISHED. EXISTING WALL TO BE INFILLED.
- $\langle \overline{14} \rangle$  existing roof mounted exhaust fan to be demolished.

Quest Design Group, Inc.         1859 Northgate Blvd.         1859 Northgate Blvd.         1859 Northgate Blvd.         5arasota, Fl 34234         941.351.9996         www.questdg.com         Cert. of Authorization# Control         Orter and the control of the c	SWEET BRUTCH CHARTER STATE AND THE PRICE MAIN THE SAFETY STANDARDS AS DETERMINED IN THE APPLICABLE BULDING COES AND THE PRICE AND LOCAL ORDERATES AND SPECIFICATIONS COMPANY WITH ACCORDANCE WITH CLARENCE AND LOCAL ORDER OF AN ALL STATEST SWEET STANDARDS AS DETERMINED IN SPACE AND LOCAL ORDER OF AND LOCAL ORDER OF AND SPECIFICATIONS COMPANY SAFETY STANDARDS AS DETERMINED IN SAFETY SAFETY STANDARDS AS DETERMINED IN SAFETY SAFETY SAFE
	PROJECT     TOWN OF LONGBOAT KEY       TITLE:     FIRE RESCUE STATION 91       5490 GULF OF MEXICO DR     5490 GULF OF MEXICO DR       LONGBOAT KEY, FL 34228     Another of the state of
1 MECHANICAL DEMOLITION PLAN 1/8" = 1'-0"	Image: Image

DocuSign Envelope ID: 0F9B90F4-319E-4490-8550-66AF0656301F

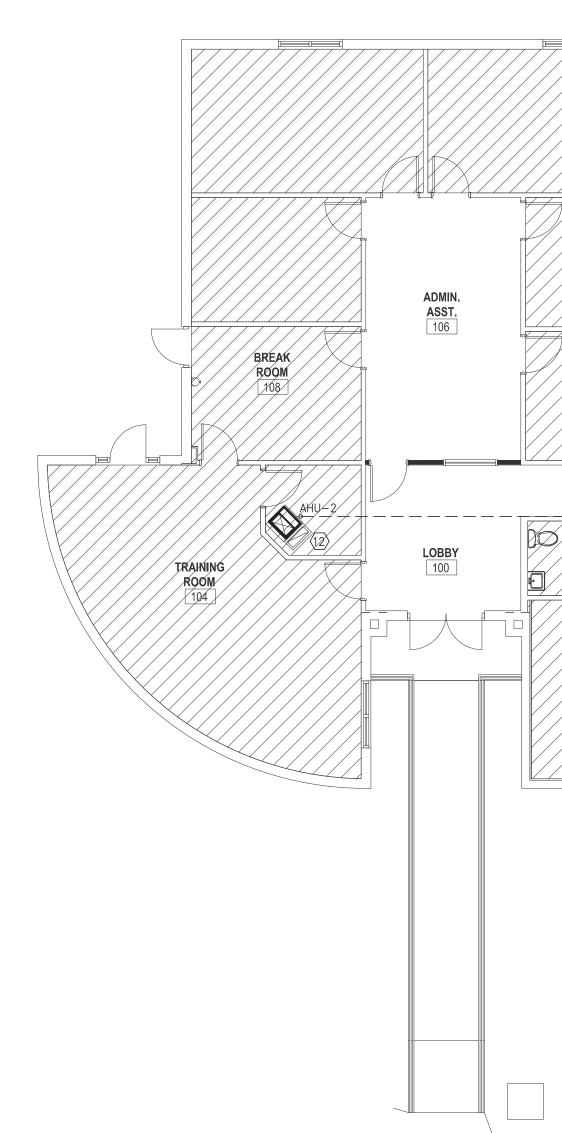

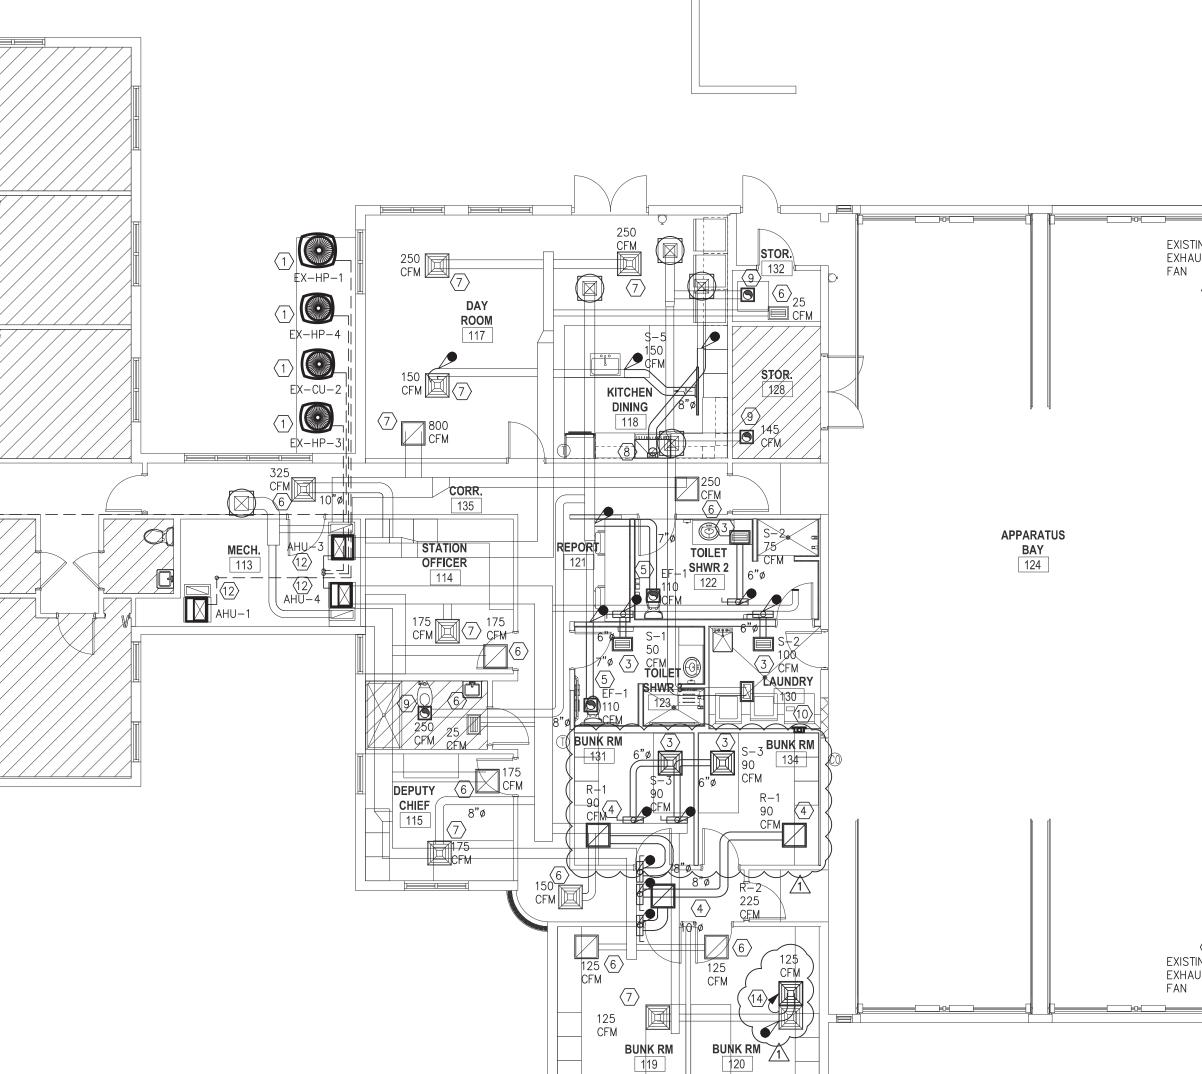

CONSTRUCTION NOTES

 $\langle 9 \rangle$  EXISTING EXHAUST FAN TO REMAIN.

 $\langle 12 \rangle$  EXISTING AIR HANDLING UNIT TO REMAIN.

 $\fbox{1}$  Relocated and New condensers to be secured to New Equipment Racks. Racks as manufactured by rectorseal model wbb500hr or equal.

3 NEW SUPPLY GRILLES. EXTEND AND CONNECT NEW BRANCH DUCT TO EXISTING MAIN. BALANCE PER PLAN REQUIREMENTS.

(4) NEW RETURN GRILLS. EXTEND AND CONNECT NEW BRANCH DUCT TO EXISTING MAIN. BALANCE PER PLAN REQUIREMENTS.

T EXISTING AIR DEVICE TO BE RELOCATED. EXTEND AND CONNECT EXISTING FLEXIBLE DUCT FULL CONNECTION SIZE TO EXISTING GRILLE AS REQUIRED PER THE NEW REFLECTED CEILING PLAN.

8 NEW KITCHEN HOOD EXHAUST TO BE DUCTED TO EXISTING EXHAUST MAIN DUCT TERMINATING AT ROOFCAP. SIZE PER MANUFACTURER REQUIREMENTS.

 $\langle 5 
angle$  New Exhaust fan. Extend and connect new exhaust duct to existing exhaust.

 $\langle 2 \rangle$  REFRIGERANT LINES ROUTED THROUGH BREAK METAL CHASE.

 $\langle 6 \rangle$  EXISTING AIR DEVICE TO REMAIN. BALANCE PER PLAN REQUIREMENTS.

 $\langle 10 
angle$  4" dryer exhaust duct up to roofjack with backdraft damper.


(13) EXTEND AND CONNECT 3/4"¢ CONDENSATE TO RETAINAGE AREA.


(14) EXISTING AIR DEVICE TO BE RELOCATED. EXTEND EXISTING DUCTWORK AS NECESSARY. 1 BALANCE PER PLAN REQUIREMENTS.

 $\langle 11 \rangle$  EXTEND AND CONNECT 3/4"¢ CONDENSATE TO RETAINAGE AREA.


	This set has been digitally signed and sealed by Christopher R. Baker, PE on August 26, 2020 using a Digital Signature. Printed copies of this document are not considered signed and sealed and the SHA authentication code must be verified on any electronic copies.	Construction       Construction       Construction         1859 Northgate Blvd.       1859 Northgate Blvd.         1859 Northgate Blvd.       241.351.9996         241.351.9996       Construction         www.questdg.com       Cart Anthration and Cart Anthrat Anthration and Cart Anthrat Anthration	THE APPLICABLE BUILDING CODES AND THE APPLICABLE MININUM FIRE SAFETY STANDARDS AS UPLIERMINED IN ACCORDANCE WITH CHARTERS 553, AND 533, ELORIDA STATUTES AND LOCAL ORDINANCES.	SWEET 2168 MAIN STREET SARASOTA, FL 34237 SARET 541.952.0084 T 941.952.0084 F 941.952.0201	FL AA26000857
		bocusigned by: Chiedaphen Baken EBA253F3459DAC3 B/26/2020	UNUTRAVIANTIC	C C C C C C C C C C C C C C C C C C C	Christie best is ite ite
Image: Window Strate       Image: Window Strate				PROJECT       TOWN OF LONGBOAT KEY         TITLE:       FIRE RESCUE STATION 91         5490 GULF OF MEXICO DR         LONGBOAT KEY, FL 34228	ISSUED Conformed Set FOR: 05.22.20
			SCA PRC DRA A/E PRC	PHIC SCALE:	08.26.20 DATE 1" 1/8" = 1'-0" CRB MJE CRB 19-522 CAL
	1 MECHANICA 1/8" = 1'-0"	_ PLAN	SHE	ET No.: <b>M1.1</b>	

M1.1 PYRIGHT 2018 SWEET SPARKMAN

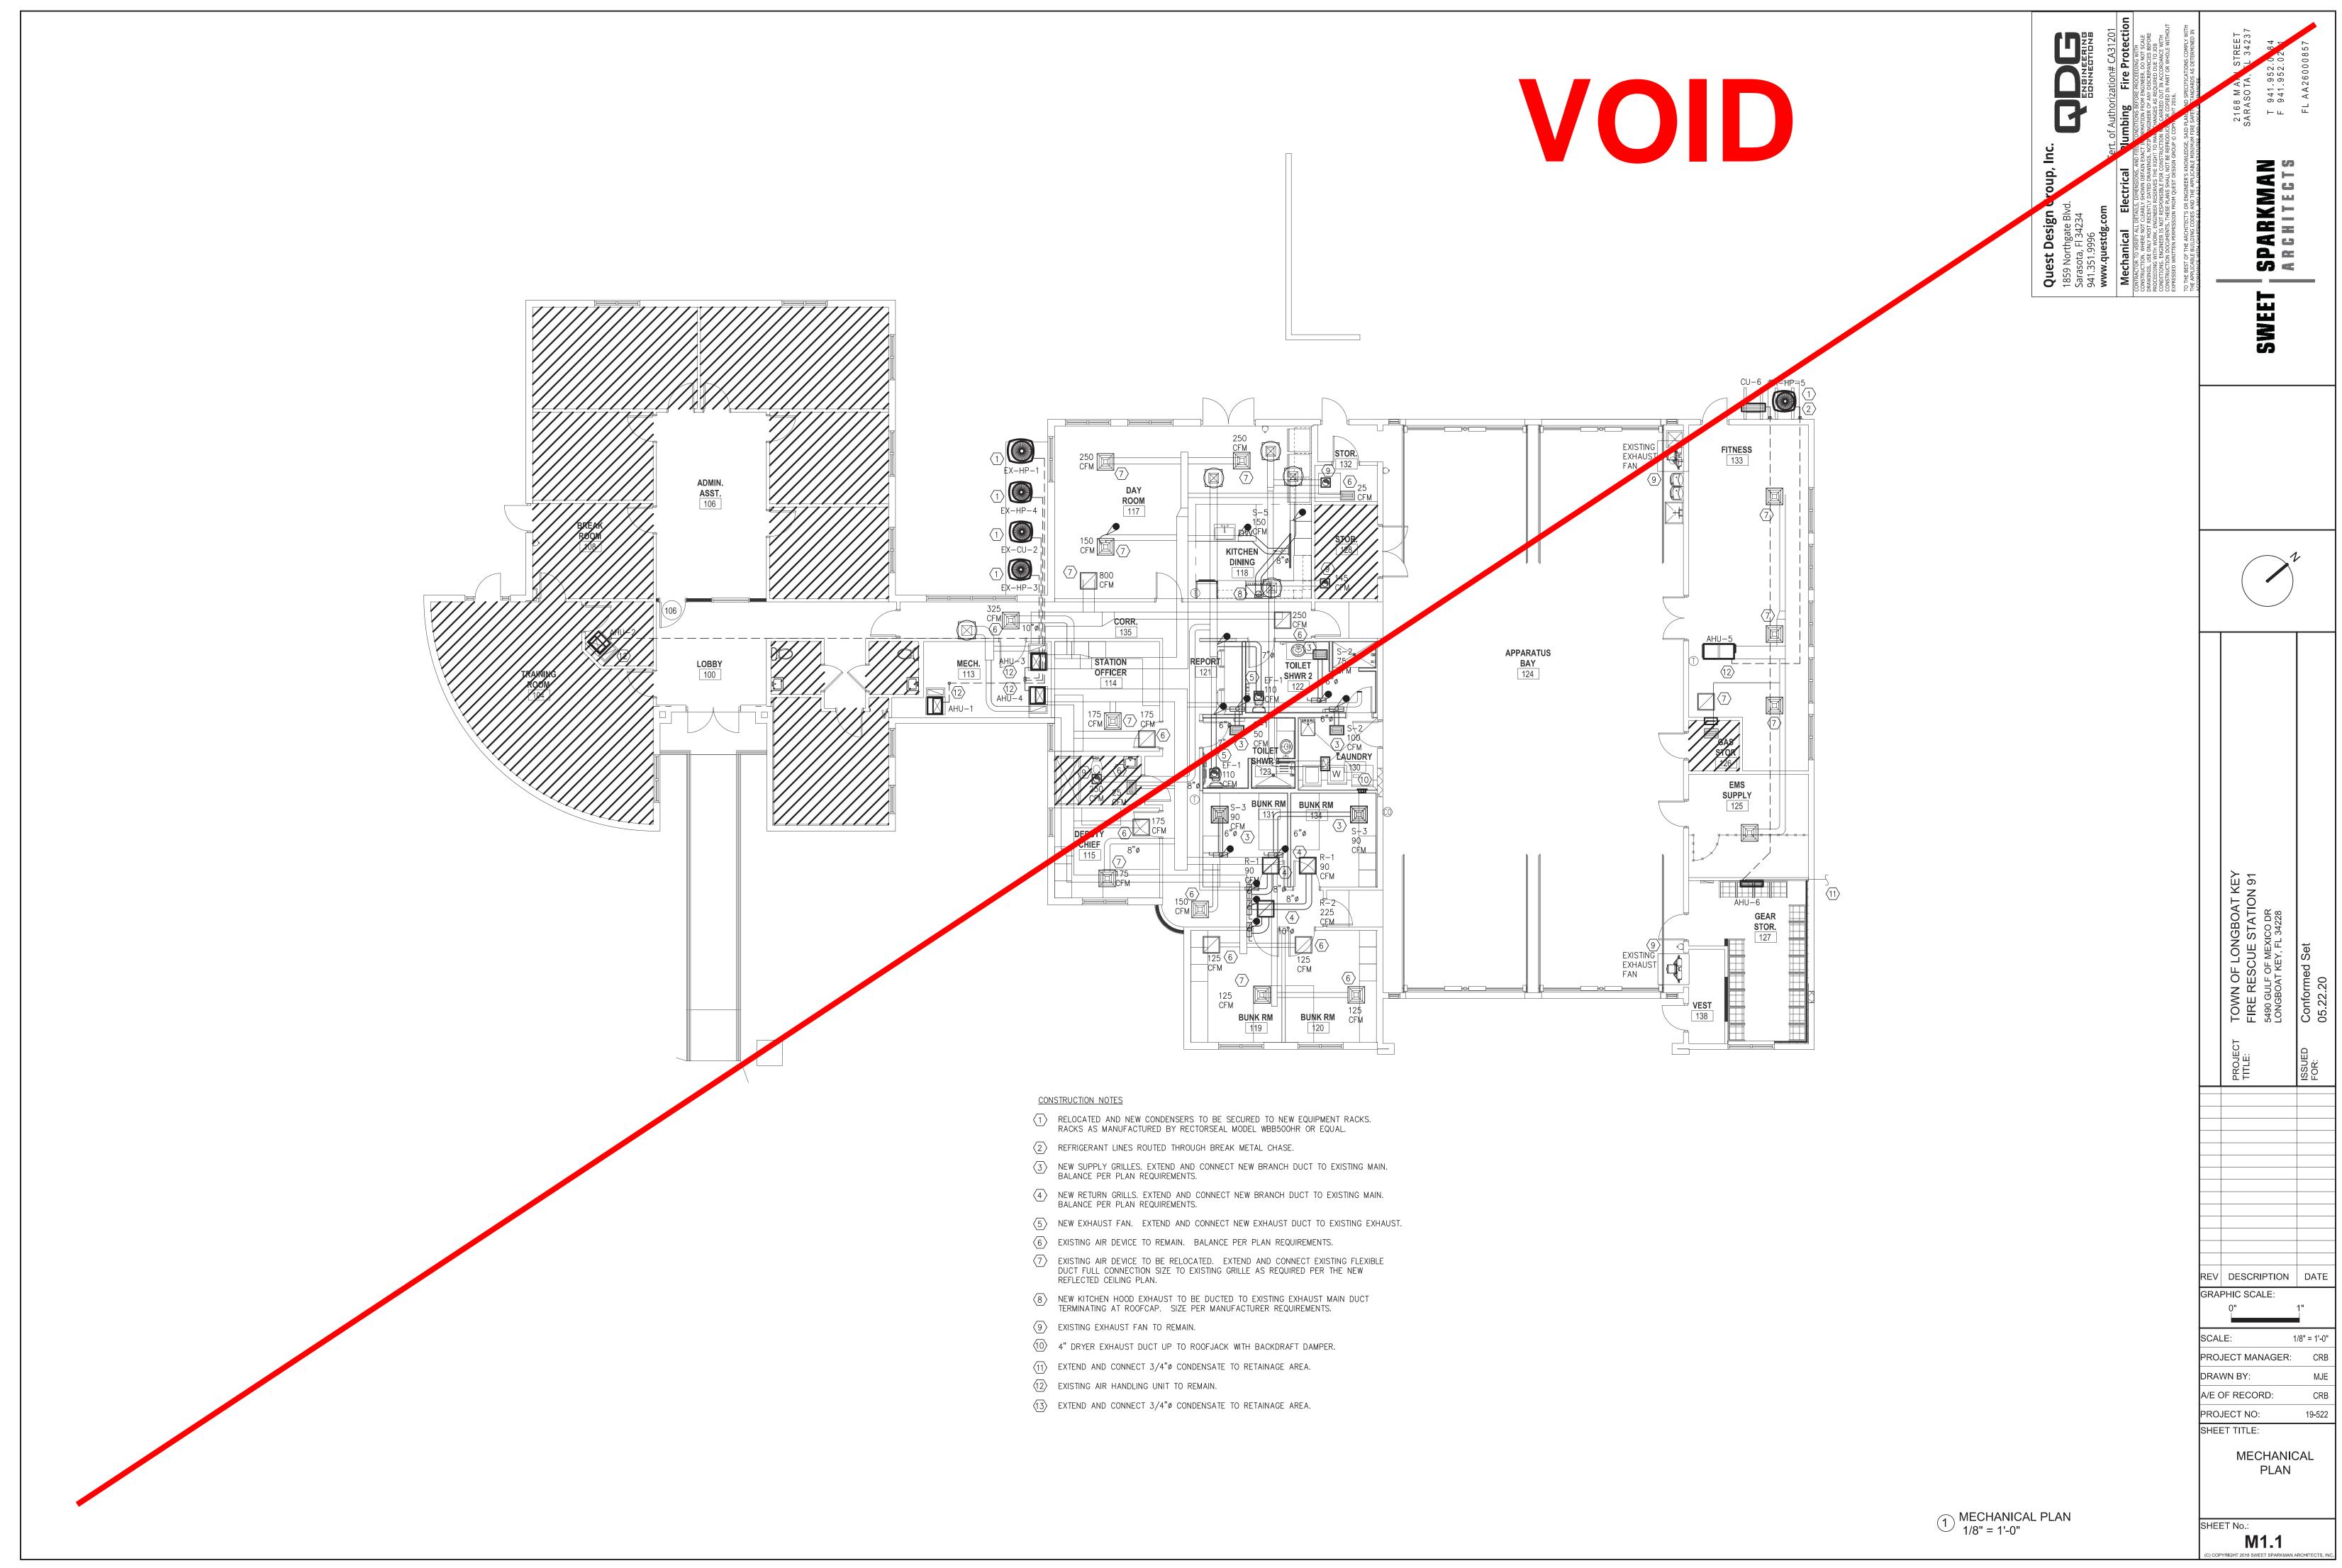


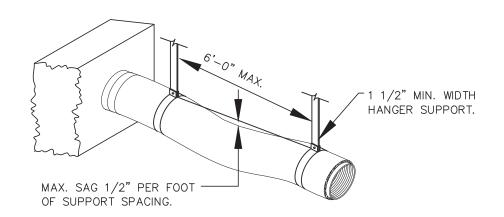


#### FLEXIBLE DUCT HANGER DETAIL SCALE: NONE

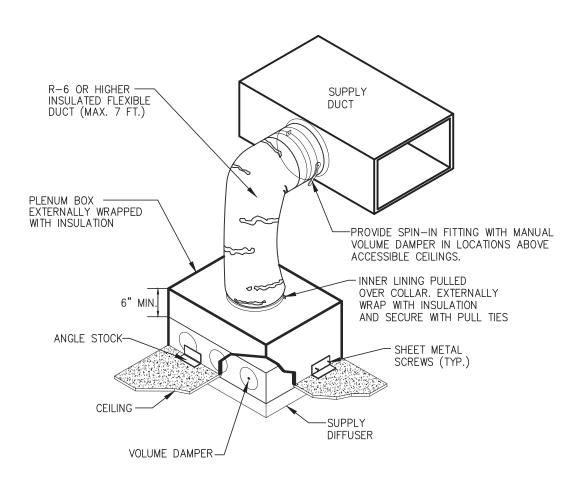


#### DUCTWORK CONNECTION TO SUPPLY DIFFUSER SCALE: NONE

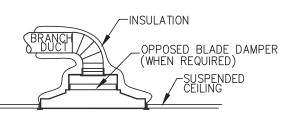

## RETURN GRILLE DETAIL SCALE: NONE

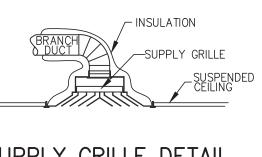

SUPPLY GRILLE DETAIL

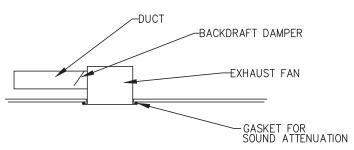

EXHAUST FAN DETAIL SCALE: NONE

	NUT NANYO MODEL MBTUH CEM SEED VOLT (DH HEAT(LIN) AHU FAN NOA ( C (D ENTERING LEAVING EXT. O. A. DEMADICE													
UNIT	MAN'R	MODEL	TOT/SEN.	CFM	SEER	VOLT/PH	HEAT(kw)	AHU FAN HP	MCA / C/B	AIR TEMP.	AIR TEMP.	STATIC	CFM	REMARKS
AHU-1	TRANE	TEM6A0D60		1900		208/1	7.2KW	.75	52/60	80/67	59/57	.5	275	2
AHU-2	TRANE	TEM6AOC36		900		208/1	5.76KW	.5	40/40	80/67	56/56	.25	275	2
AHU-3	TRANE	TEM6A0C36		1150		208/1	5.76KW	.5	40/40	80/67	56/55	.3	100	2
AHU-4	TRANE	TEM6AOC42		1180		208/1	5.76KW	.5	40/40	80/67	56/55	.35	125	2
AHU-5	TRANE	TEM6AOB30		1000		208/1		.33	4/15	80/67	58/57	.25	150	2
HP-1	TRANE	4TWR7060	55,000		15	208/1	52,500		37/60	92				1,2
HP-2	TRANE	4TWR5036	36,000		15	208/1	33,000		18/30	92				1,2
HP-3	TRANE	4TWR5036	36,000		15	208/1	33,000		18/30	92				1,2
HP-4	TRANE	4TWR5042	41,000		15	208/1	38,000		22/35	92				1,2
HP-5	TRANE	4TWR5030	30,000		15.25	208/1	27,800		18/30	92				1,2

#### ACCESSORIES:

## 1. R-410A REFRIGERANT.

	A/C SCHEDULE													
UNIT	MAN'R	MODEL	MBTUH TOT/SEN.	CFM	SEER	VOLT/PH	HEAT(kw)	AHU FAN HP	MCA / C/B	ENTERING AIR TEMP.	LEAVING AIR TEMP.	EXT. STATIC	O. A. CFM	REMARKS
AHU-6	MITSUBISHI	MSZ-GL09NA		300		208/1		.76AMPS	1/15	80/67	59/57			2,3
CU-6	MITSUBISHI	MUZ-GL09NA	9,000		24	208/1	15,900		9/15	92				1,2

ACCESSORIES: 1. R-410A REFRIGERANT.

3. AHU POWERED FROM OUTDOOR CONDENSING UNIT.

FAN SCHEDULE											
SYMBOL       DESCRIPTION       MANUFACTURER       CATALOG #       CFM       EX.S.P.       VOLT/Ø/HZ       AMP/WATTS       FAN_SPEED / SONES       NOTES											
1,2	932/0.3	17	-A110 110 0.15 120/1 17		SP-A110	GREENHECK	CEILING	EF-1			
_								<u>S:</u> PEED CONTROLLER ACKDRAFT DAMPER			

		AIR	DEVICE S	SCHEDULE		
SYMBOL	DESCRIPTION	MANUFACTURER	CATALOG #	C.F.M.	NECK SIZE	REMARKS
S-1	1-WAY	TITUS	250-AA	50	8 X 6	1
S-2	1-WAY	TITUS	250-AA	75–100	12 X 6	1
S-3	4-WAY	TITUS	TDCA-AA	90-130	9 X 9	1
S-4	4-WAY	TITUS	TDCA-AA	220	12 X 12	1
S-5	LINEAR	TITUS	FL-10	180	8"ø	2
R-1	RECTANGULAR	TITUS	350FL	90	10 X 10	1
R-2	RECTANGULAR	TITUS	350FL	225	14 X 14	1

1. OPPOSING BLADE DAMPER

2. CONTRACTOR SHALL COORDINATE WITH DIVISION 26 CONTRACTOR FOR ELECTRICAL REQUIREMENTS.

2. CONTRACTOR SHALL COORDINATE WITH DIVISION 26 CONTRACTOR FOR ELECTRICAL REQUIREMENTS.

2. 4' LONG 1.0" SLOT - 1 SLOT DIFFUSER WITH HIGH THROW PATTERN AND FIELD FABRICATED PLENUM.

(1	MECHANICAL NO	DTES, DE	ETAILS /	AND SCH	HEDULES
U	) MECHANICAL NO SCALE: NONE				

LETTERING SIZE SHALL BE 1" HEIGHT (MINIMUM) AS NEEDED FOR PROPER IDENTIFICATION TEXT FOR EQUIPMENT IDENTIFICATION SIGNS SHALL INCLUDE, UNIT NAME AND NUMBER AS PROVIDED ON THE CONTRACT DRAWINGS (IE: AHU-1, CU-1, HEX-1 ETC.). IF NOT IDENTIFIED BY THE MANUFACTURER, THE CONTRACTOR SHALL PROVIDE A SIGN TO INDICATE THE LOCATION OF FILTER ACCESS ON AHU'S.

 A. RETURN TRANSFER DUCT SHALL BE 1 1/2 TIMES THE CROSS SECTIONAL AREA OF THE SUPPLY DUCT ENTERING THE ROOM.
 B. TRANSFER GRILLES SHALL USE 50 SQUARE INCHES (OF GRILLE AREA) TO 100 CFM (OF SUPPLY AIR) FOR SIZING THROUGH THE WALL TRANSFER GRILLES. C. BOTH A. AND B. SHALL USE UNDERCUT ENTRY DOORS (MIN 1")

25. MECHANICAL EQUIPMENT IDENTIFICATION: PROVIDE ENGRAVED PLASTIC LAMINATE SIGN, PLASTIC EQUIPMENT MARKER, OR STENCILED SIGNS FOR THE FOLLOWING EQUIPMENT AND OPERATIONAL DEVICES, FREE HAND LETTERING SHALL NOT BE ACCEPTED.

A. AIR HANDLERS, CONDENSERS AND SIMILAR MOTOR DRIVEN UNITS

23. EACH CONDITIONED SPACE SHALL BE PROVIDED WITH A MEANS OF RETURNING AIR TO THE AHU AS INDICATED ON THIS PLAN. WHERE NOT SHOWN, ACCEPTABLE METHODS INCLUDE:

24. ALL EQUIPMENT EXTERIOR TO THE BUILDING SHALL BE SECURED TO WITHSTAND 160MPH WINDS.

- 22. THERMOSTATS, HUMIDISTATS AND CO2 SENSORS SHALL BE MOUNTED AT 48" ABOVE THE FLOOR.
- 21. THE VENTILATION RATE PROCEDURE OF FLORIDA BUILDING CODE-MECHANICAL 2017 HAS BEEN USED TO DETERMINE THE AMOUNT OF OUTSIDE AIR FOR THIS SPACE. ANY CHANGE IN SPACE USE, CONTAMINANTS, OR OPERATION MAY REQUIRE A REEVALUATION OF THE DESIGN AND IMPLEMENTATION OF NEEDED CHANGES.

- 19. WORK SHALL INCLUDE TESTING AND BALANCING OF THE HVAC SYSTEM INCLUDING KITCHEN HOOD(S) IF APPLICABLE. THE CONTRACTOR SHALL SUBMIT COPIES OF TEST AND BALANCE REPORTS SHOWING RESULTS OF BALANCING OF AIR QUANTITIES TO PLAN REQUIREMENTS. MAKE ALL ADJUSTMENTS REQUIRED TO PROVIDE ±10% DESIGN AIR FLOW.
- 20. WORK SHALL INCLUDE STARTUP OF ALL SYSTEMS, FURNISHING OF OPERATING AND MAINTENANCE INSTRUCTIONS, WALK THROUGH WITH MAINTENANCE CREW, AND ONE YEAR GUARANTEE, COMMENCING ON DATE OF ACCEPTANCE BY OWNER.

- 17. ALL AIR HANDLERS TO HAVE SLOPED DRAIN PANS. 18. THE HVAC CONTRACTOR IS RESPONSIBLE TO PROVIDE ALL CONDENSATE PIPING. CONDENSATE PIPING SHALL BE CONSTRUCTED OF PVC PIPING.


- 16. THE HVAC CONTRACTOR IS RESPONSIBLE FOR ALL CONTROLS AND CONTROL WIRING. SEE SEQUENCE OF OPERATION.
- 15. THE REFRIGERANT LINES SHALL BE SIZED IN ACCORDANCE WITH THE MANUFACTURER'S INSTALLATION INSTRUCTIONS. REFRIGERANT LINE INSULATION SHALL BE 1" MINIMUM IN UNCONDITIONED ATTIC AREAS. COVER INSULATION AT BUILDING EXTERIOR WITH UV RESISTANT COATING. INSTALL INSULATION SECTIONS WITH COMPRESSION GLUE AT BUTT JOINTS.
- AND AT THE LOCATIONS SHOWN ON THE PLANS. AND REGISTERS OF THE TYPE LOUVERS, ETC. SHALL BE EXTRUDED ALUMINUM WITH BAKED WHITE ENAMEL FINISH. SPONGE RUBBER GASKETS SHALL BE INSTALLED BEHIND FLANGES OF ALL GRILLES, DIFFUSERS AND REGISTERS TO PREVENT LEAKAGE AND STREAKING. ALL GRILLES, DIFFUSERS, REGISTERS, ETC. SHALL BE INSTALLED IN ACCORDANCE WITH FACTORY DETAILS. 12. FACTORY MADE OPPOSED BLADE DAMPERS WITH FRONT ACCESSIBLE OPERATOR AND DUCT RING SHALL BE FURNISHED FOR EACH NEW DIFFUSER. 13. PROVIDE FLEXIBLE CONNECTORS WHERE METAL DUCTWORK CONNECTS TO FANS OR AIR HANDLERS. 14. WHERE IT IS POSSIBLE TO SEE THROUGH DIFFUSERS, GRILLES OR REGISTERS TO DUCTWORK, LIGHT COLORED INSULATION OR PLENUMS, THE INTERIOR DUCTWORK OR PLENUM SHALL BE PAINTED FLAT BLACK.
- 9. MINIMUM INSULATION RESISTANCE FOR DUCTWORK SHALL BE AS FOLLOWS: A. CONDITIONED SPACES – R-4.2 B. UNCONDITIONED SPACES – R-6.0 C. ATTICS – R-8.0 ZES INDICATE "FREE AREA" DIMENSIONS, ALL TAKE-OFFS AND SHALL HAVE VOLUME DAMPERS. PROVIDE SPIN-IN COLLARS WITH 'S AND DAMPERS FOR ALL BRANCH TAKE- OFFS. PROVIDE FOR ALL ELBOWS AND SPLITTERS.
- B. RIGID ROUND DUCTS GALVANIZED SHEET METAL WITH EXTERNAL INSULATION. C. FLEXIBLE ROUND DUCTS – FLEXIBLE, WIRE REINFORCED DUCT WITH EXTERNAL INSULATION WITH VAPOR BARRIER AND FOIL FACED. FLEX MUST BE STRETCHED TO REMOVE ACCORDION EFFECT. FLEX DUCT LENGTH SHALL NOT EXCEED 7' LENGTH. D. EXHAUST AIR DUCT – INSULATED IN UNCONDITIONED SPACES WITH EXTERNAL DUCT WRAP. UP TO 7" FLEXIBLE ALUMINUM, ALL LARGER SHALL BE GALVANIZED SHEET METAL.
- A. RECTANGULAR DUCTS GALVANIZED SHEET METAL WITH EXTERNAL DUCT WRAP. SEE RECTANGULAR DUCT SCHEDULE FOR DUCT GAGE. ALL DUCTS WITH 24 INCH WIDTH OR GREATER SHALL HAVE MECHANICAL FASTENERS AT A MAXIMUM OF 18 INCH CENTERS. DUCTBOARD SUCH AS 'SUPERDUCT' AS MANUFACTURED BY JOHNS MANVILLE, INTERNALLY LINED FIBERBOARD MAY BE SUBMITTED AS AN ALTERNATE. THE DUCTBOARD JOINTS SHALL BE TAPED AND MASTICED.
- 8. ALL DUCTWORK IS TO BE CONSTRUCTED AND INSTALLED IN ACCORDANCE WITH SMACNA MANUALS AND THE FOLLOWING SCHEDULE:
- 7. MINOR DETAILS NOT USUALLY SHOWN OR SPECIFIED, BUT NECESSARY FOR PROPER OPERATION AND CONSISTENT WITH GOOD WORKMANSHIP, SHALL BE INCLUDED IN THE ESTIMATE, THE SAME AS IF SHOWN ON DRAWINGS.
- ARRANGEMENT. THIS MALL BE ( STRUCTURAL TRUSS SPACE AND SHALL BE ( ARRANGEMENT. THE SHOP DRAWING SHALL ORIGINAL CONTRACT DOCUMENT. FINAL DUC WITHOUT ADDITIONAL COST TO THE PROJECT AROUND APPLIANCES TO ELEMENTS OF PERMANENT NCLUDING OTHER INSTALLED EQUIPMENT AND APPLIANCES, SHALL ALLOW INSPECTION, SERVICE, REPAIR OR REPLACEMENT G SUCH ELEMENTS OF PERMANENT CONSTRUCTION
- C CONTRACTOR SHALL GIVE FULL COOPERATION TO OTHER TRADES URNISH IN WRITING TO THE ARCHITECT, ANY INFORMATION TO PERMIT THE WORK OF ALL TRADES TO BE INSTALLED 'LY AND WITH THE LEAST POSSIBLE INTERFERENCE OR DELAY. ND SHALL DRAWINGS INDICATING THE FINAL DUCT ITECT AND ENGINEER PRIOR TO INSTALLIN THIS MAY REQUIRE DUCTWORK ROUTING V IALL BE COORDINATED WITH FINAL STRUCT G SHALL BE OF THE SAME SCALE AS THE NAL DUCT ROUTING SHALL BE PROVIDED TRUCTURA
- S, OBTAIN ALL S AND PAY ALL GOVERNMENT FEES, SALES TAXES AND OTHER COSTS IN STION WITH HIS WORK; FILE ALL NECESSARY APPROVALS OF ALL IMENTAL DEPARTMENTS HAVING JURISDICTION; OBTAIN ALL REQUIRED CATES OF INSPECTION FOR HIS WORK; AND DELIVER TO THE OWNER THE ERTIFICATES BEFORE REQUEST FOR ACCEPTANCE AND FINAL PAYMENT FOR
- D WORK INCLUDED IN THE CONTRACT. DRAWINGS ARE NOT TO BE E DRAWINGS AND DETAILS SHALL BE EXAMINED FOR EXACT LOCATION AND EQUIPMENT. ANYTHING MENTIONED IN THE SPECIFICATION WILL TED AS BEING IN BOTH. ANY CONFLICT SHALL BE IMMEDIATELY THE ATTENTION OF THE OWNER OR ENGINEER BEFORE PROCEEDING RK O PROVIDE A COMPLETE, WORKABLE AND CODE APPROVED AIR EM. ALL WORK SHALL BE DONE IN ACCORDANCE WITH THESE ICATIONS, LOCAL, STATE AND NATIONAL CODES.


HVAC – NOTES



088008

ATUTES AND LOCAL ODDINANCES		2168 MAIN STREET SARASOTA, FL 34237	T 941.952.0084 F 941.952.0201	FL AA26000857
ACCORDANCE WITH CHARTERS EES AND 633 ELORIDA CTATILIES AND LOCAL ORDINANCES			SPARKMAN ARCHITECTS	
			SWEET	
				l
		TOWN OF LONGBOAT KEY FIRE RESCUE STATION 91	5490 GULF OF MEXICO DR LONGBOAT KEY, FL 34228	Conformed Set 05.22.20
		PROJECT TITLE:		ISSUED FOR:
	REV GRAI	DESCR PHIC SCA 0"		DATE
	SCAL PRO	LE: JECT MAI		1/8" = 1'-0" CRB
	<u> </u>	WN BY: DF RECO	RD:	MJE CRB
		JECT NO: ET TITLE:		19-522
		N DET	HANIOTES AILS A HEDUL	, AND
		ET No.: <b>M</b>	2.0	
	(C) COP	TRIGHT 2018 SWE	LCI SPARKMAN	ARCHITECTS, INC

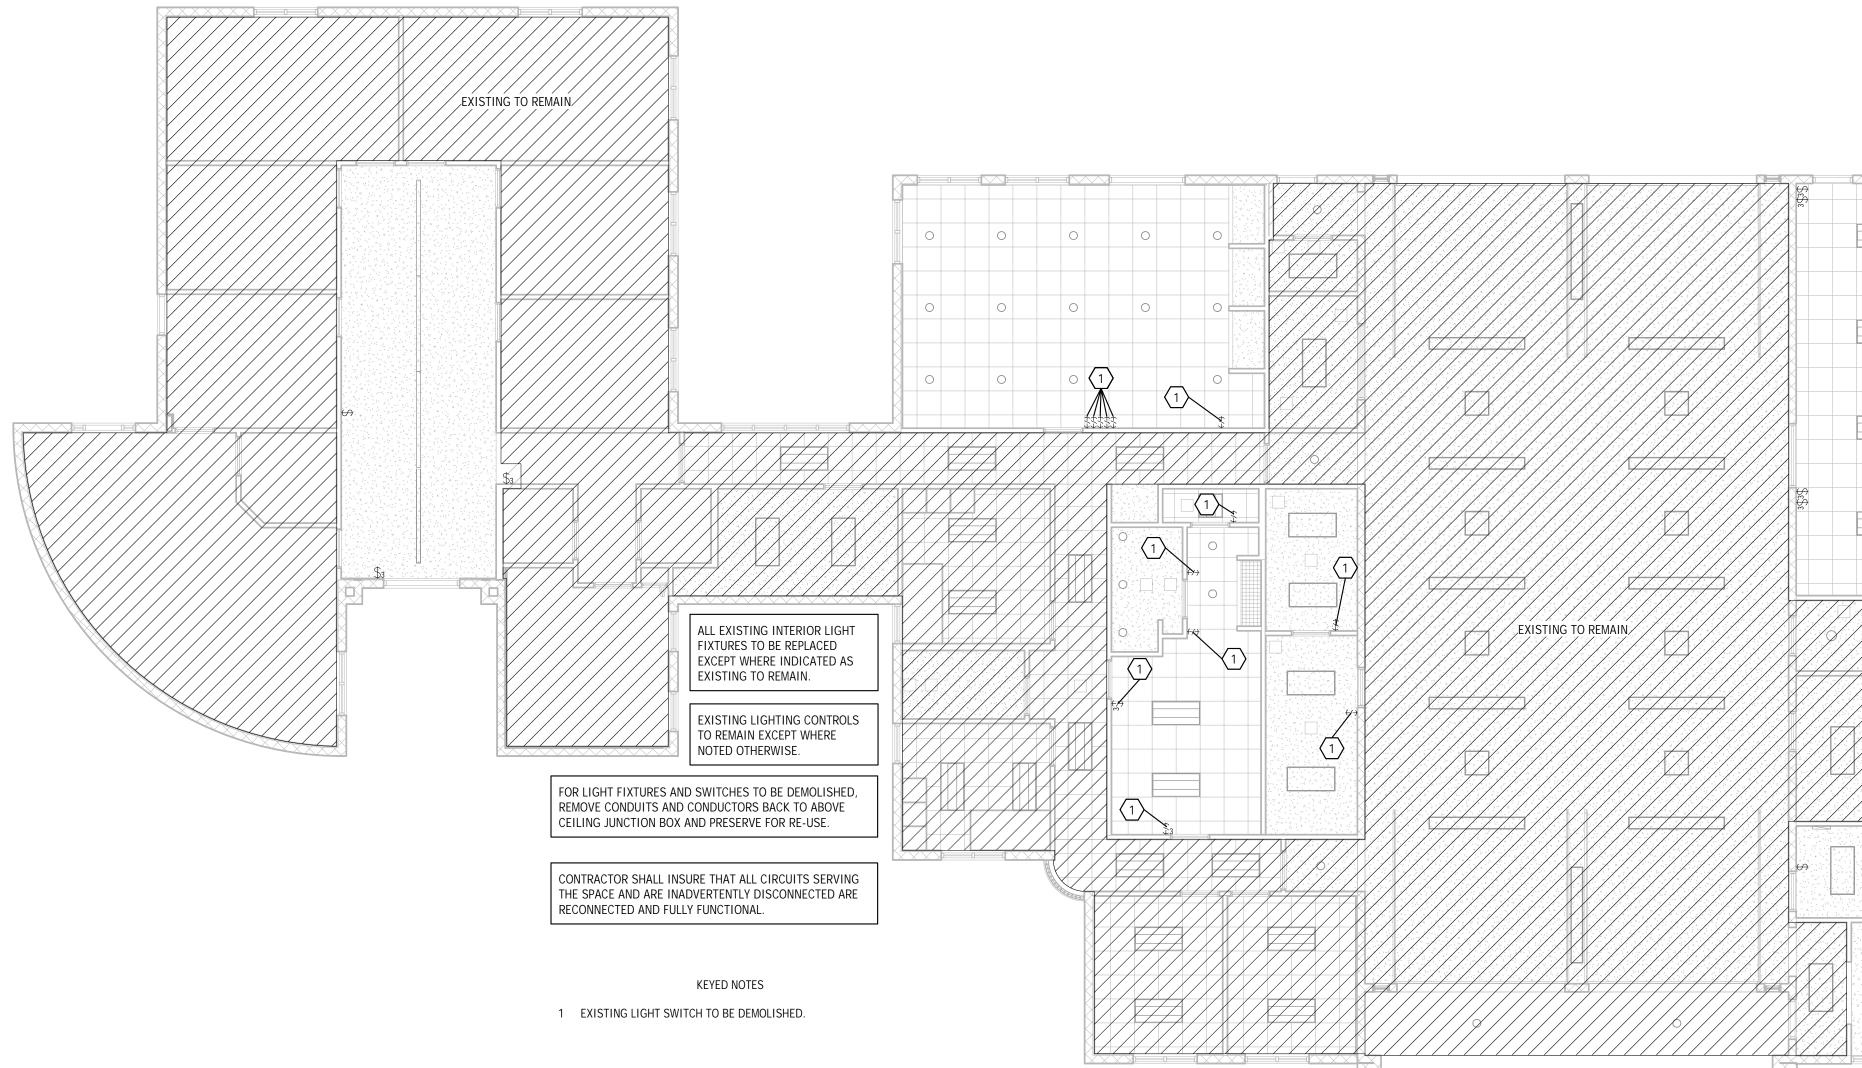

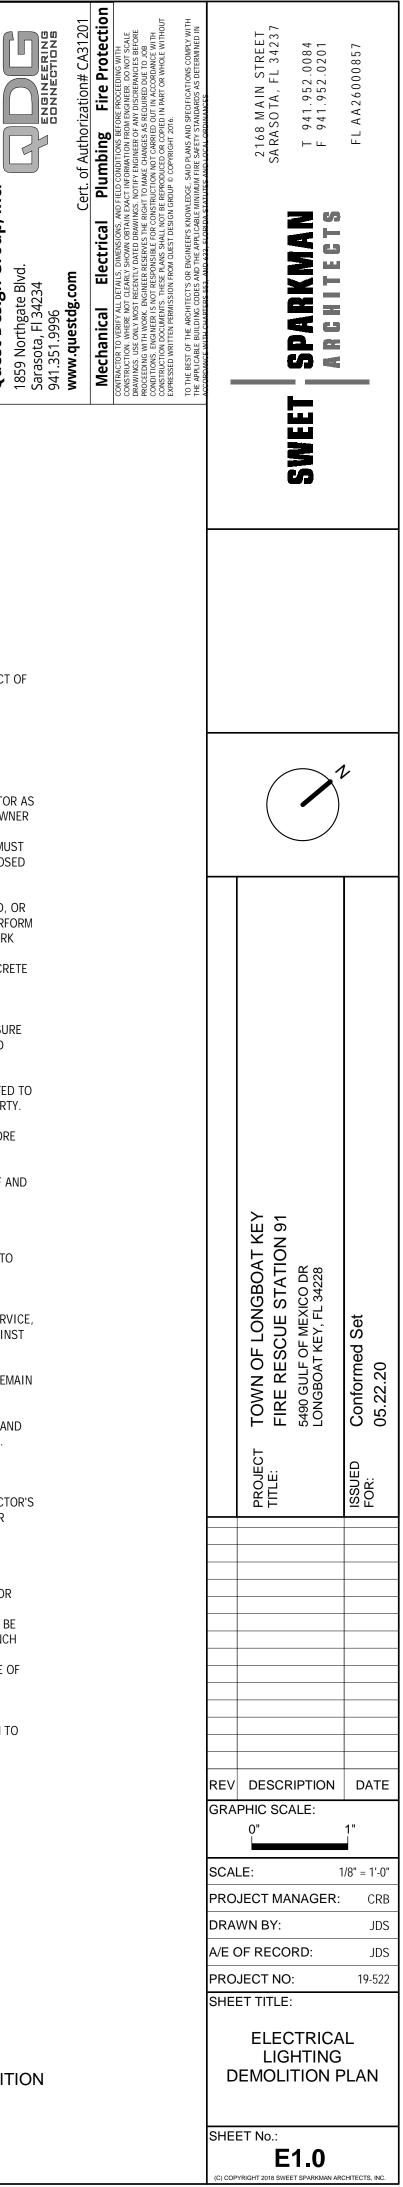

DEMOLITION NOTES

THE DEMOLITION PROCEDURES SHALL PROVIDE FOR SAFE CONDUCT OF THE WORK, PROTECTION OF PERSONNEL, CAREFUL REMOVAL, AND DISPOSAL OF MATERIALS AS INDICATED. THE PROCEDURES ALSO INCLUDE PROTECTION OF PROPERTY TO REMAIN UNDISTURBED, COORDINATION WITH OTHER WORK IN PROGRESS AND TIMELY DISCONNECTION OF UTILITY SERVICES.

lnc

U

EXISTING EQUIPMENT WHICH IS TO BE REMOVED, SHALL REMAIN PROPERTY OF OWNER AND BE STORED OR REMOVED BY CONTRACTOR AS DIRECTED BY OWNER. REMOVE ALL MATERIAL REJECTED BY THE OWNER FROM THE WORK SITE AND DISPOSE OF IN ACCORDANCE WITH APPLICABLE LOCAL, STATE AND NATIONAL CODES. CONTRACTOR MUST CERTIFY TO OWNER THAT THE MATERIAL HAS BEEN LEGALLY DISPOSED OF IN WRITTEN FORM.

EXISTING WORK SHALL NOT BE CUT, DRILLED, ALTERED, REMOVED, OR TEMPORARILY REMOVED FOR THE INSTALLATION REQUIRED TO PERFORM CONSTRUCTION ACTIVITIES OF MECHANICAL AND ELECTRICAL WORK AND OTHER CONSTRUCTION UNDER THE CONTRACT WITHOUT AUTHORIZATION OF THE OWNER. STRUCTURAL MEMBERS OF CONCRETE OR STRUCTURAL STEEL SHALL NOT BE ALTERED WITHOUT AUTHORIZATION OF THE OWNER.

CONDUCT DEMOLITION OPERATIONS AND REMOVE DEBRIS TO ENSURE MINIMUM INTERFERENCE WITH ROADS, STREETS, WALKWAYS, AND OTHER ADJACENT OCCUPIED AND USED FACILITIES.

REMOVE AND LEGALLY DISPOSE OF ITEMS EXCEPT THOSE INDICATED TO BE REINSTALLED, SALVAGED, OR TO REMAIN THE OWNER'S PROPERTY.

COMPLY WITH GOVERNING EPA NOTIFICATION REGULATIONS BEFORE STARTING DEMOLITION. COMPLY WITH HAULING AND DISPOSAL REGULATIONS OF AUTHORITIES HAVING JURISDICTION. LOCATE, IDENTIFY, SHUT OFF, DISCONNECT, AND SEAL OR CAP & LOCK OFF AND TAG ANY/ALL UTILITY SERVICES SERVING STRUCTURES TO BE DEMOLISHED. CONTRACTOR SHALL LOCATE.

PROVIDE TEMPORARY SERVICES DURING THE INTERRUPTION TO EXISTING UTILITIES TO REMAIN, AS ACCEPTABLE TO OWNER AND TO GOVERNING AUTHORITIES. COORDINATE WITH OWNER'S REPRESENTATIVE.


REMOVE AND REINSTALL: REMOVE ITEMS INDICATED - CLEAN, SERVICE, AND OTHERWISE PREPARE FOR REUSE - STORE AND PROTECT AGAINST DAMAGE. REINSTALL ITEMS IN LOCATIONS INDICATED.


EXISTING TO REMAIN: PROTECT CONSTRUCTION INDICATED TO REMAIN AGAINST DAMAGE AND SOILING DURING DEMOLITION. WHEN PERMITTED BY THE ARCHITECT, ITEMS MAY BE REMOVED TO A SUITABLE, PROTECTED STORAGE LOCATION DURING DEMOLITION AND THEN CLEANED AND REINSTALLED IN THEIR ORIGINAL LOCATIONS.

EXCEPT FOR ITEMS OR MATERIALS INDICATED TO BE REUSED, SALVAGED, OR OTHERWISE INDICATED TO REMAIN THE OWNER'S PROPERTY, DEMOLISHED MATERIALS SHALL BECOME THE CONTRACTOR'S PROPERTY AND SHALL BE REMOVED FROM THE SITE WITH FURTHER DISPOSITION AT THE CONTRACTOR'S OPTION.

SCOPE OF WORK

- 1. THE SCOPE OF THIS PROJECT INCLUDES THE DEMOLITION OR REPLACEMENT OF EXISTING AND ADDITION OF NEW LIGHT FIXTURES AND DEVICES AS INDICATED. THE MATERIAL TO BE DEMOLISHED OR RELOCATED INCLUDES ASSOCIATED BRANCH CIRCUITS, CONDUITS, ETC., FOR PORTION OF ELECTRICAL SYSTEM IN PRESENT LOCATION AS IMPLIED BY THE NATURE OF THE WORK TO BE REMOVED OR RELOCATED.
- DEMOLITION SHALL BE PERFORMED IN ACCORDANCE WITH 2. DEMOLITION NOTES, AND ALL NEW WORK SHALL CONFORM TO THE REQUIREMENTS OF DIVISION 26 OF THE BUILDING CONSTRUCTION DOCUMENTS.

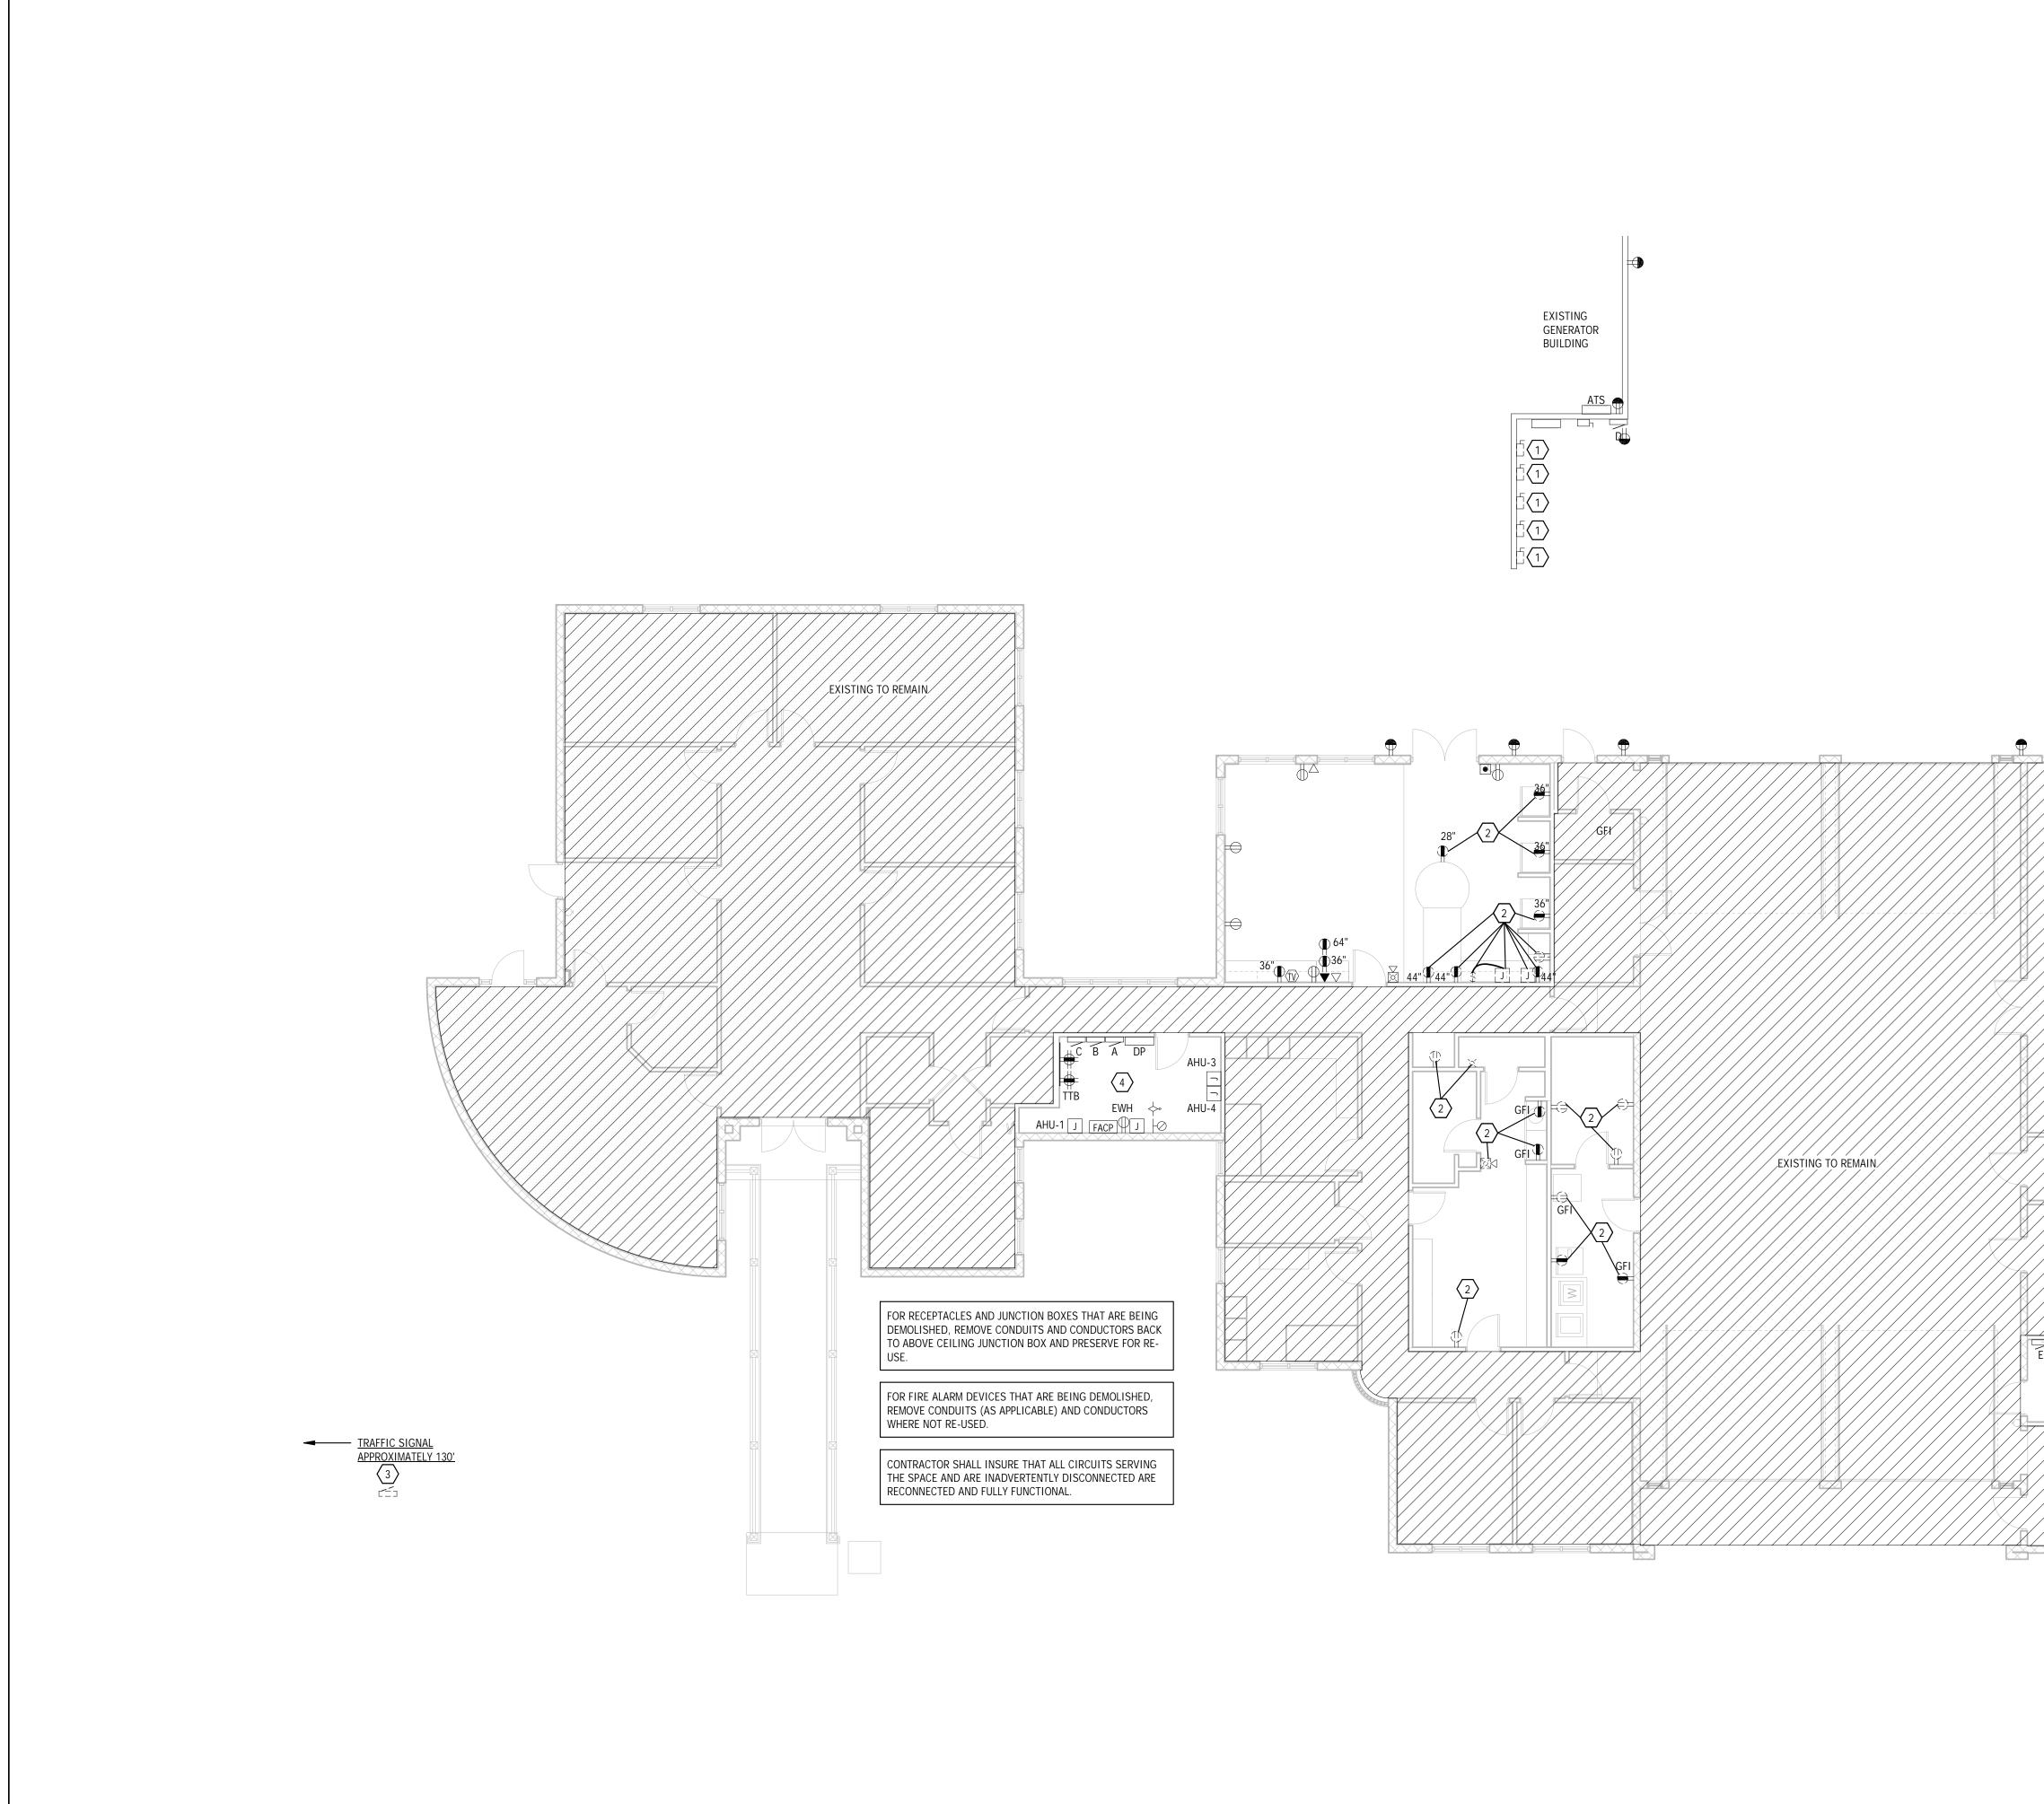


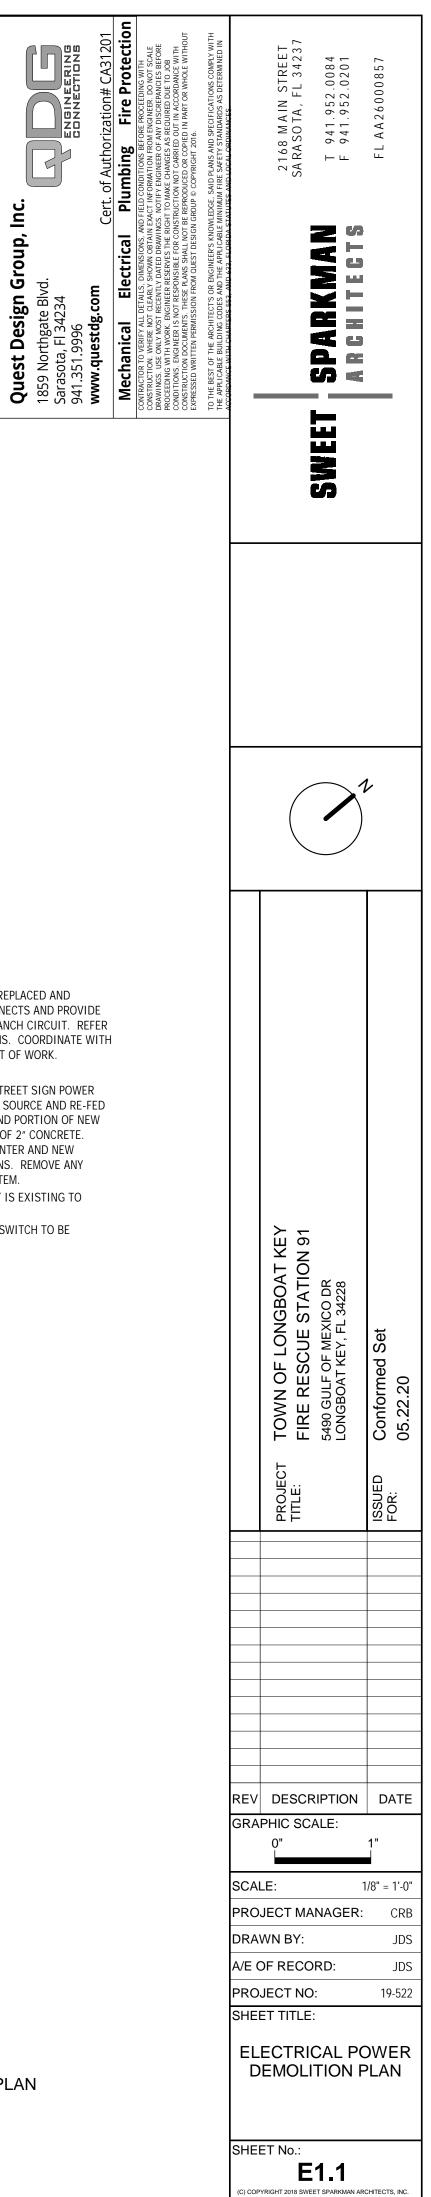



# 

#### KEYED NOTES

- 1 EXISTING MECHANICAL EQUIPMENT TO BE REPLACED AND RELOCATED. DEMOLISH EXISTING DISCONNECTS AND PROVIDE NEW NEMA 3R DISCONNECTS AND NEW BRANCH CIRCUIT. REFER TO SHEET E1.3 INDICATING NEW LOCATIONS. COORDINATE WITH MECHANICAL CONTRACTOR PRIOR TO START OF WORK.
- 2 EXISTING DEVICE TO BE DEMOLISHED.
- 3 EXISTING TRAFFIC SIGNAL/ILLUMINATED STREET SIGN POWER FEED TO BE DICONNECTED FROM EXISTING SOURCE AND RE-FED POWER FROM FIRE STATION. UNDERGROUND PORTION OF NEW FEEDER SHALL BE ENCASED IN A MINIMUM OF 2" CONCRETE. PROVIDE NEW 2-CIRCUIT NEMA 3R LOADCENTER AND NEW PHOTOCELL FOR ILLUMINATED STREET SIGNS. REMOVE ANY UNUSED PORTION OF THE ELECTRICAL SYSTEM.
- 4 ALL ELECTRICAL DISTRIBUTION EQUIPMENT IS EXISTING TO REMAIN.
- 5 EXISTING EXHAUST FAN AND ASSOCIATED SWITCH TO BE DEMOLISHED.

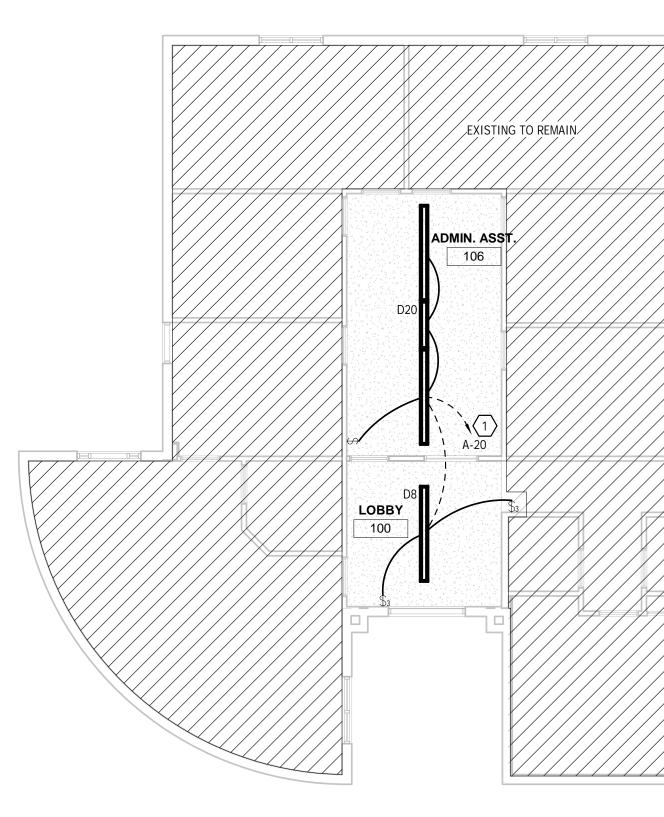

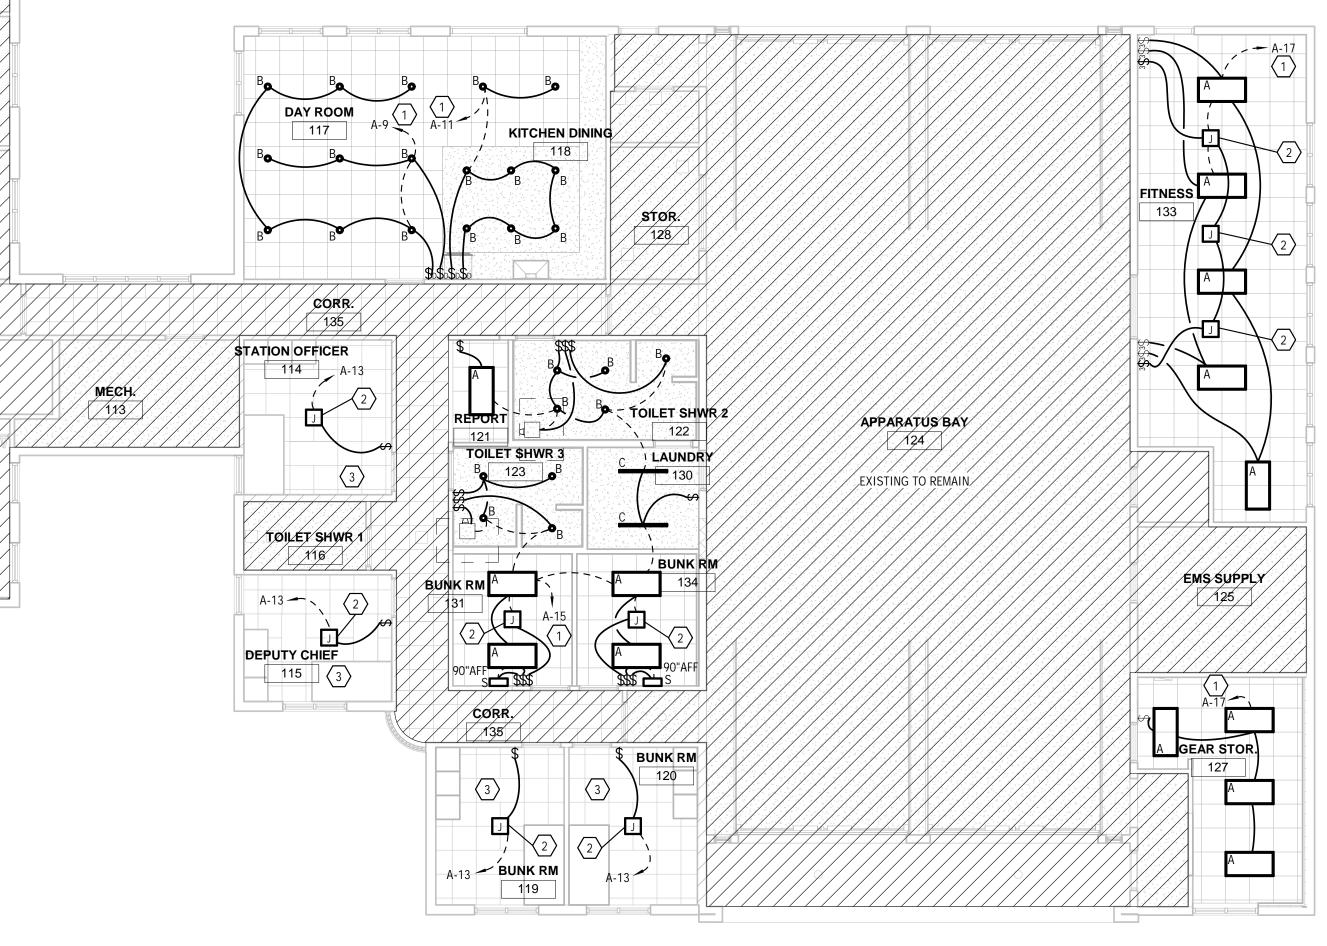


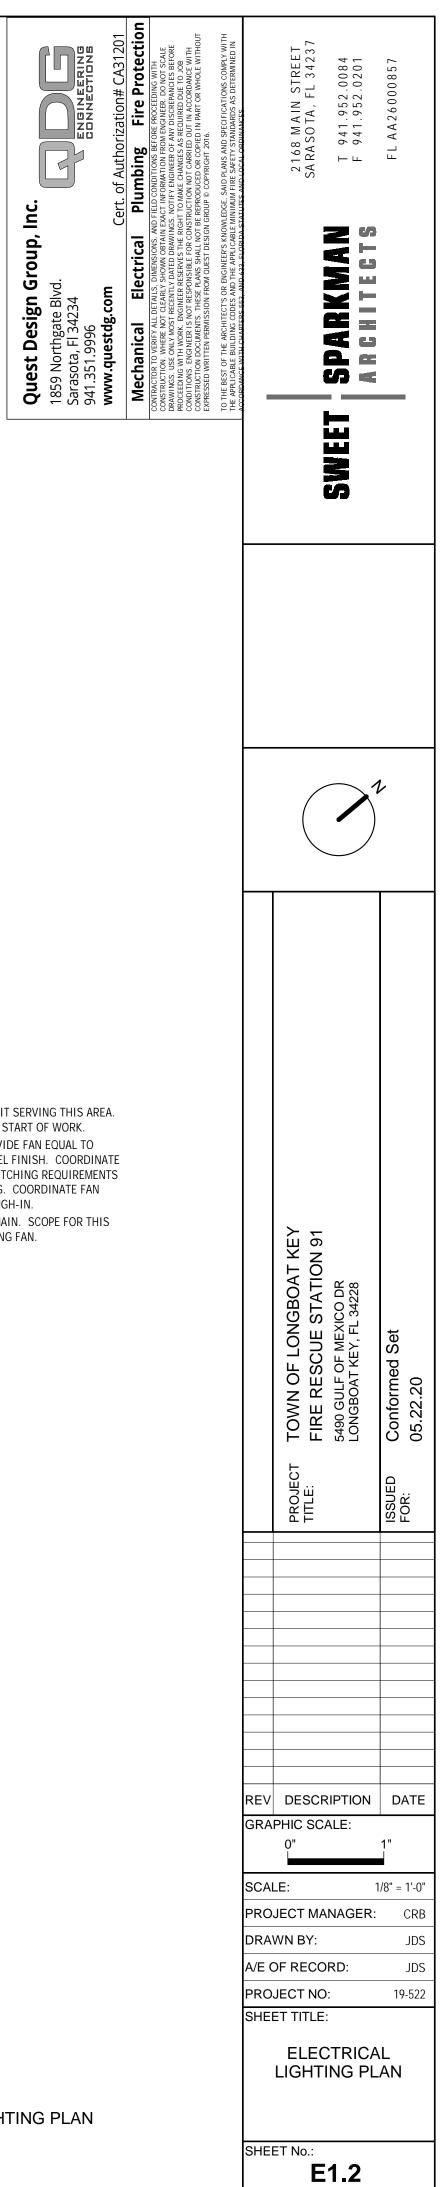


#### KEYED NOTES


- 1 RECONNECT TO EXISTING LIGHTING CIRCUIT SERVING THIS AREA.
- FIELD VERIFY EXISTING CIRCUIT PRIOR TO START OF WORK. 2 PROVIDE FAN RATED JUNCTION BOX. PROVIDE FAN EQUAL TO KICHLER BOWEN 52" WITH BRUSHED NICKEL FINISH. COORDINATE FAN SELECTION WITH ARCHITECT AND SWITCHING REQUIREMENTS WITH MANUFACTURER PRIOR TO ORDERING. COORDINATE FAN LOCATION WITH ARCHITECT PRIOR TO ROUGH-IN.
- 3 EXISTING LIGHTS AND SWITCHING TO REMAIN. SCOPE FOR THIS ROOM ONLY INCLUDES ADDITION OF CEILING FAN.

DocuSign Envelope ID: B68AB92A-F1C8-40C8-B8F1-A70B36D71DD2

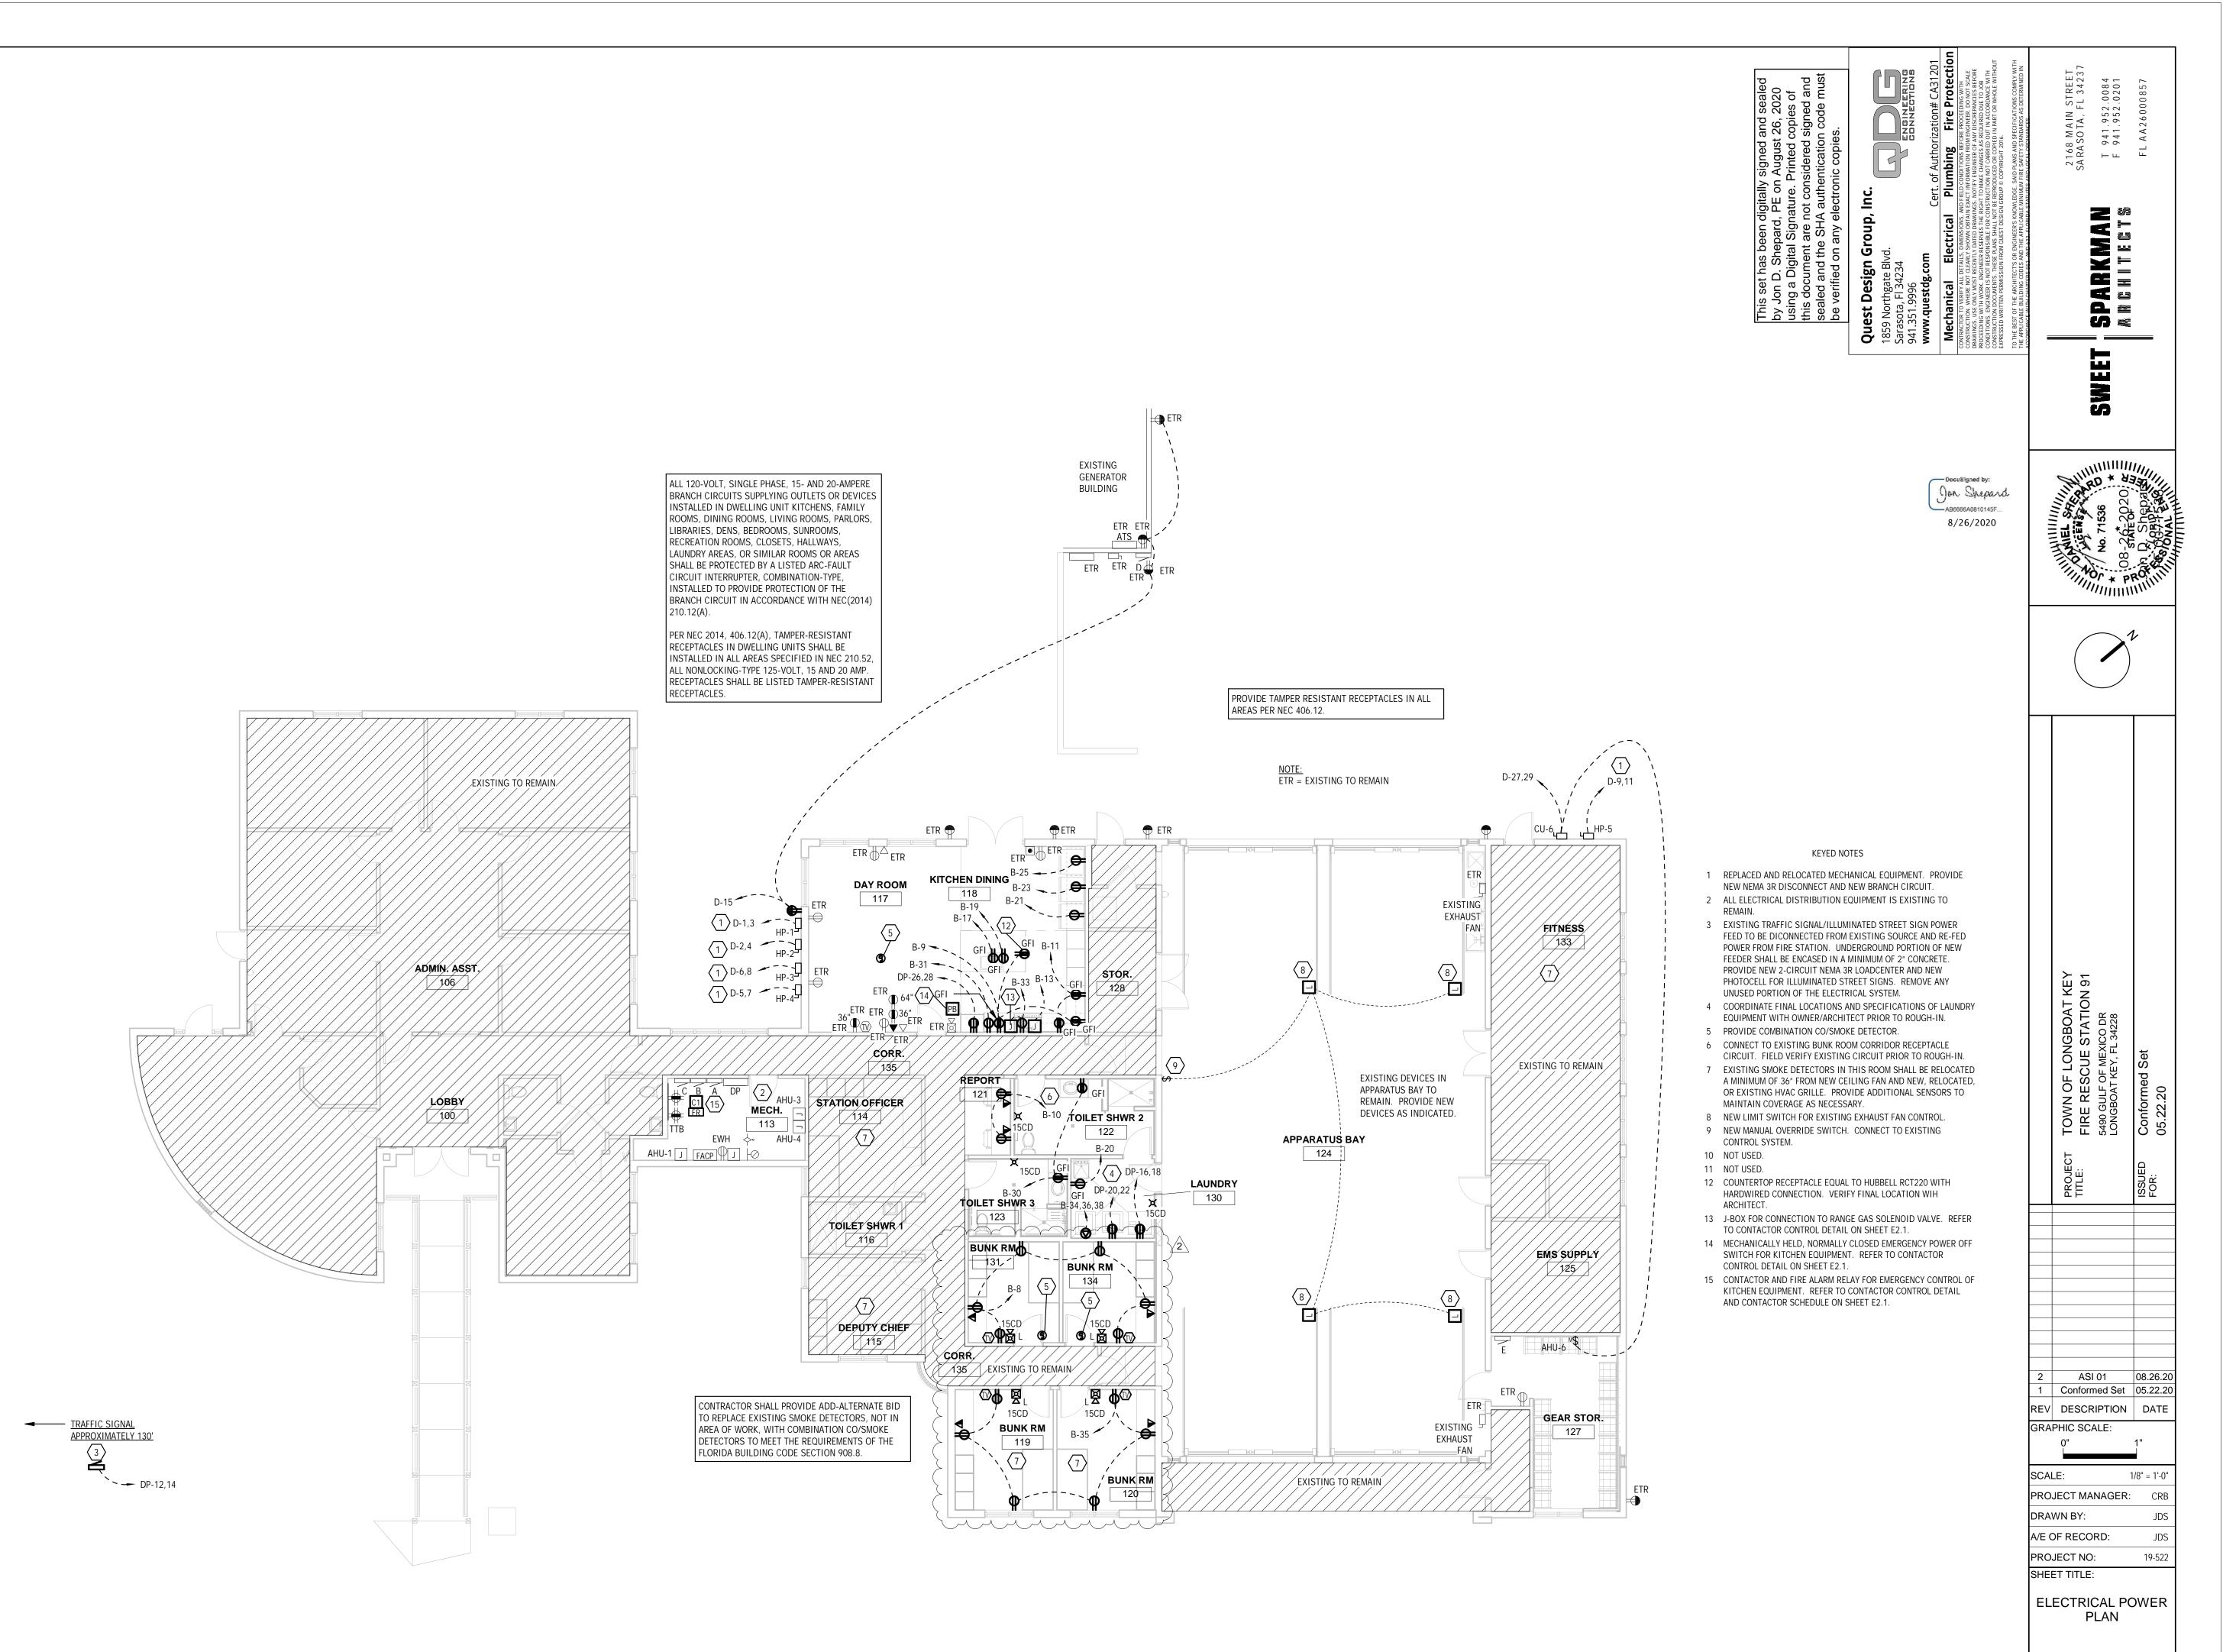

SHEET No.:

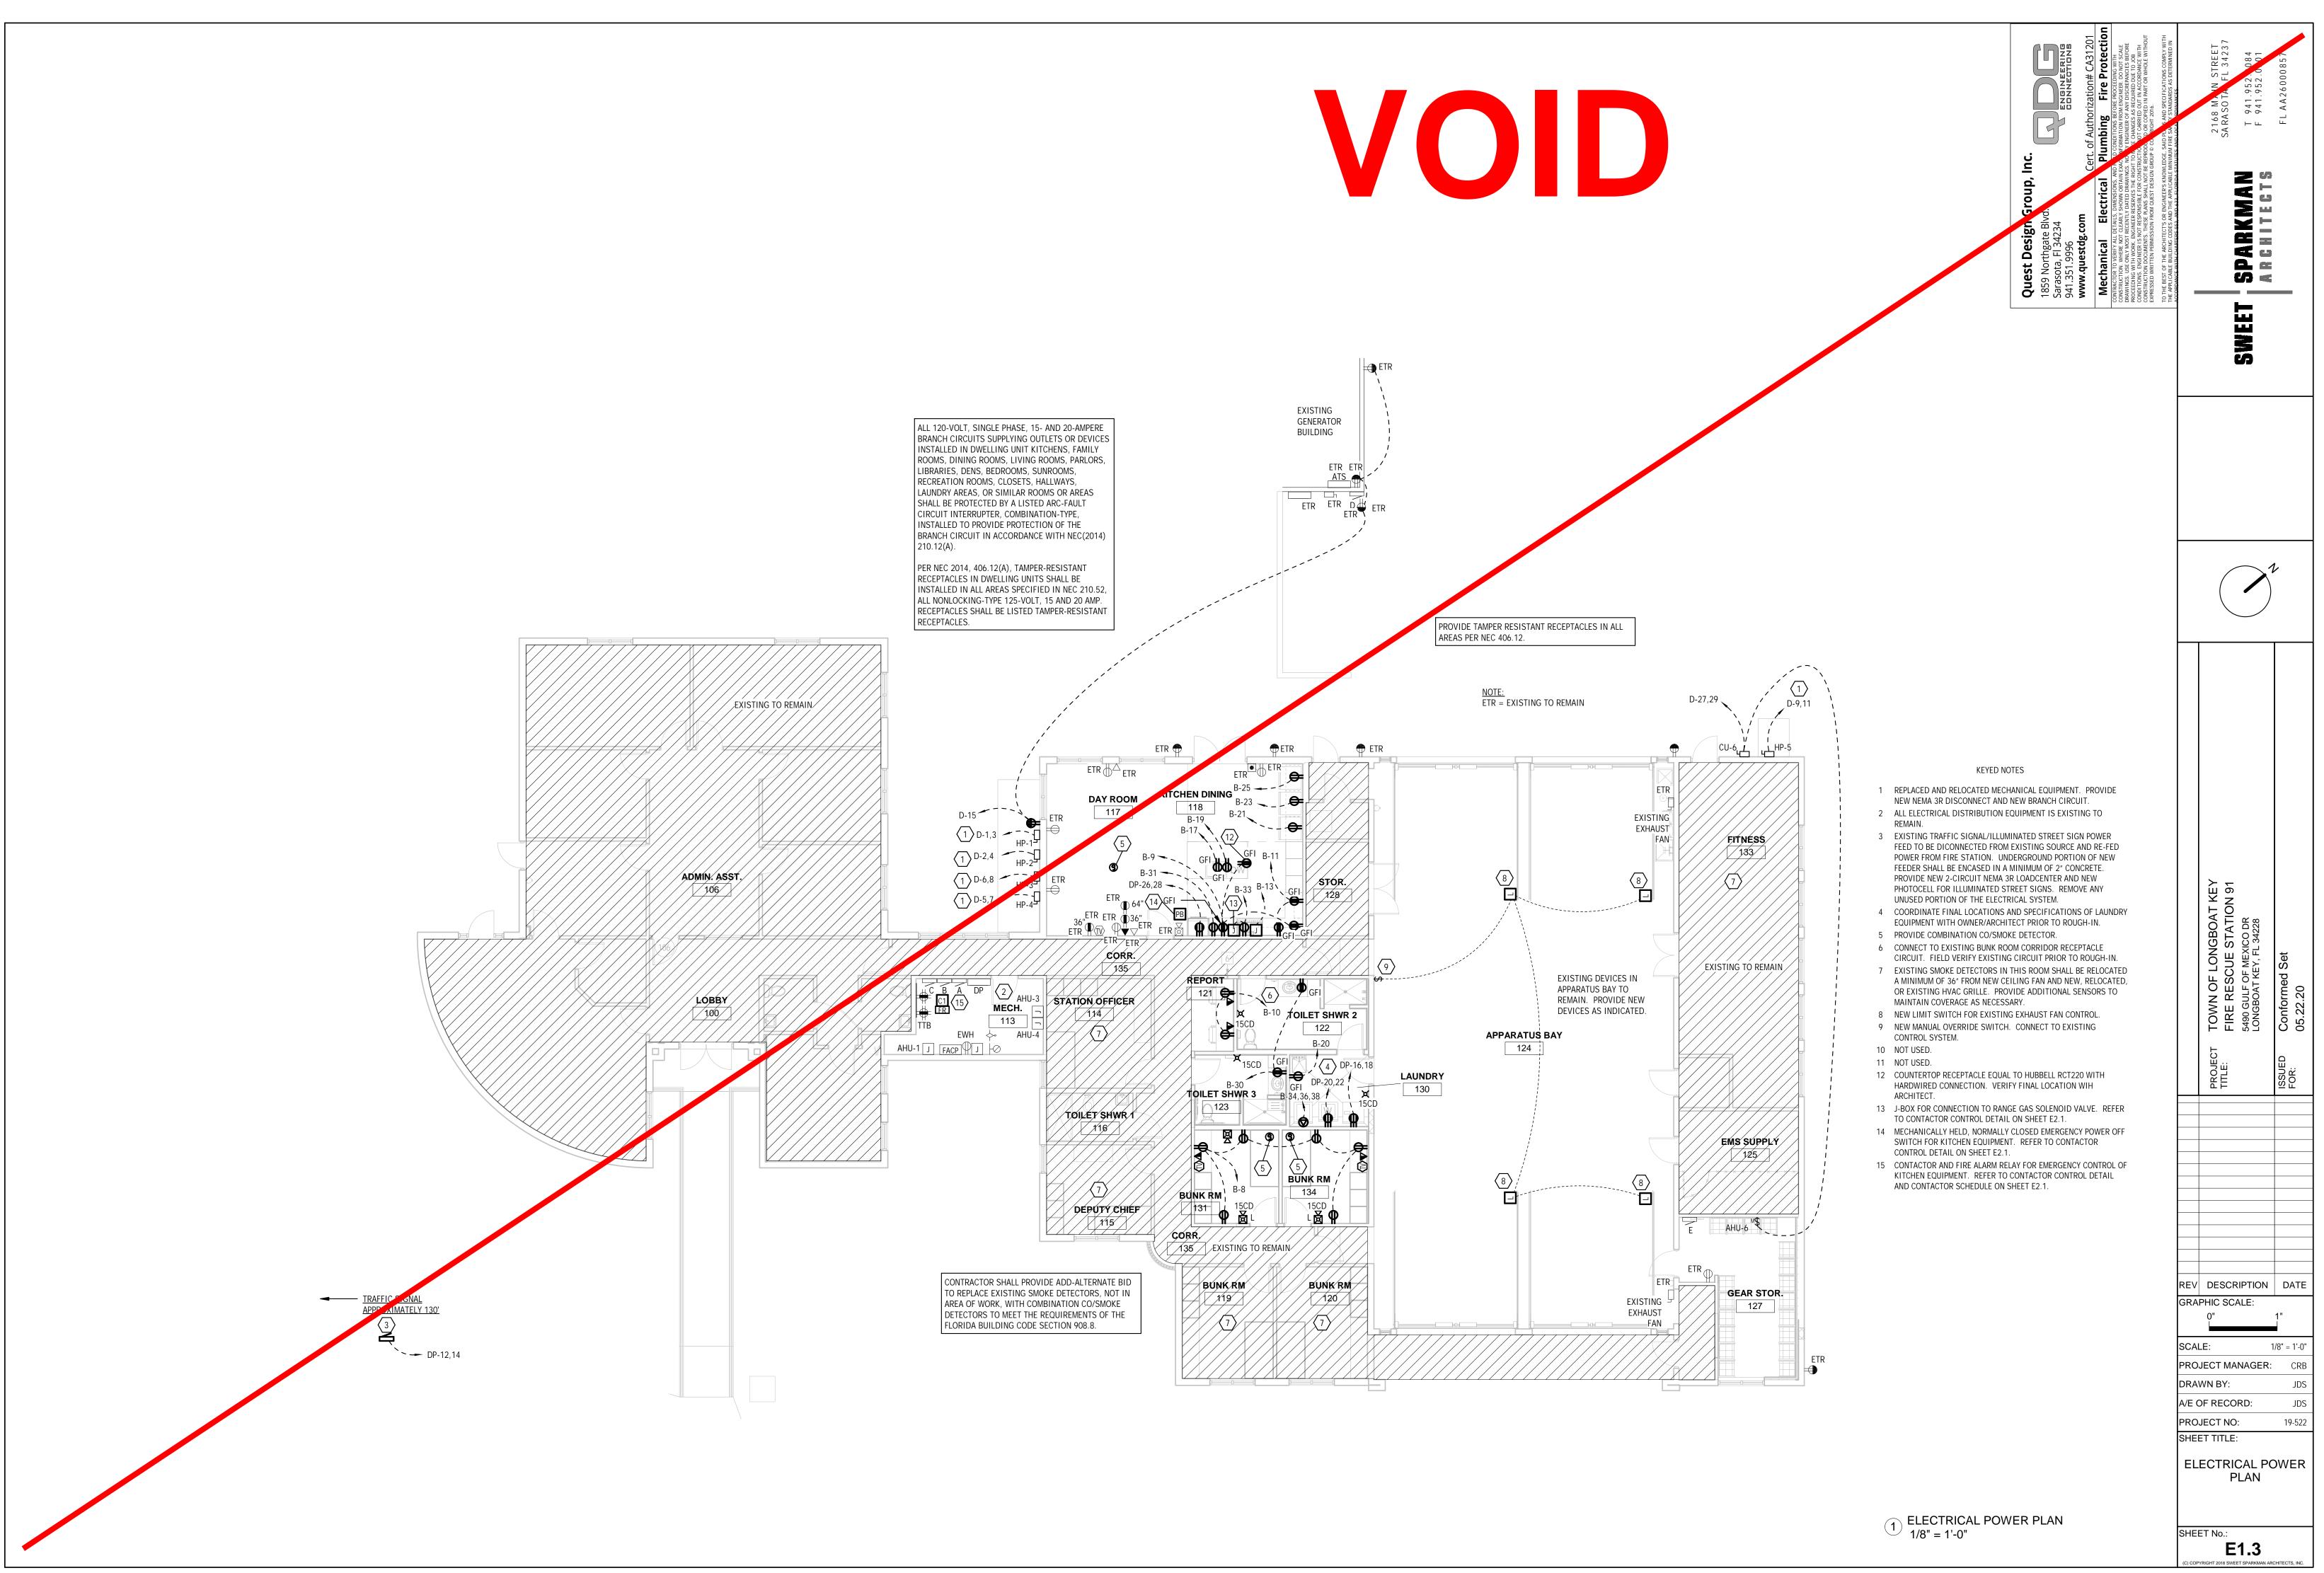

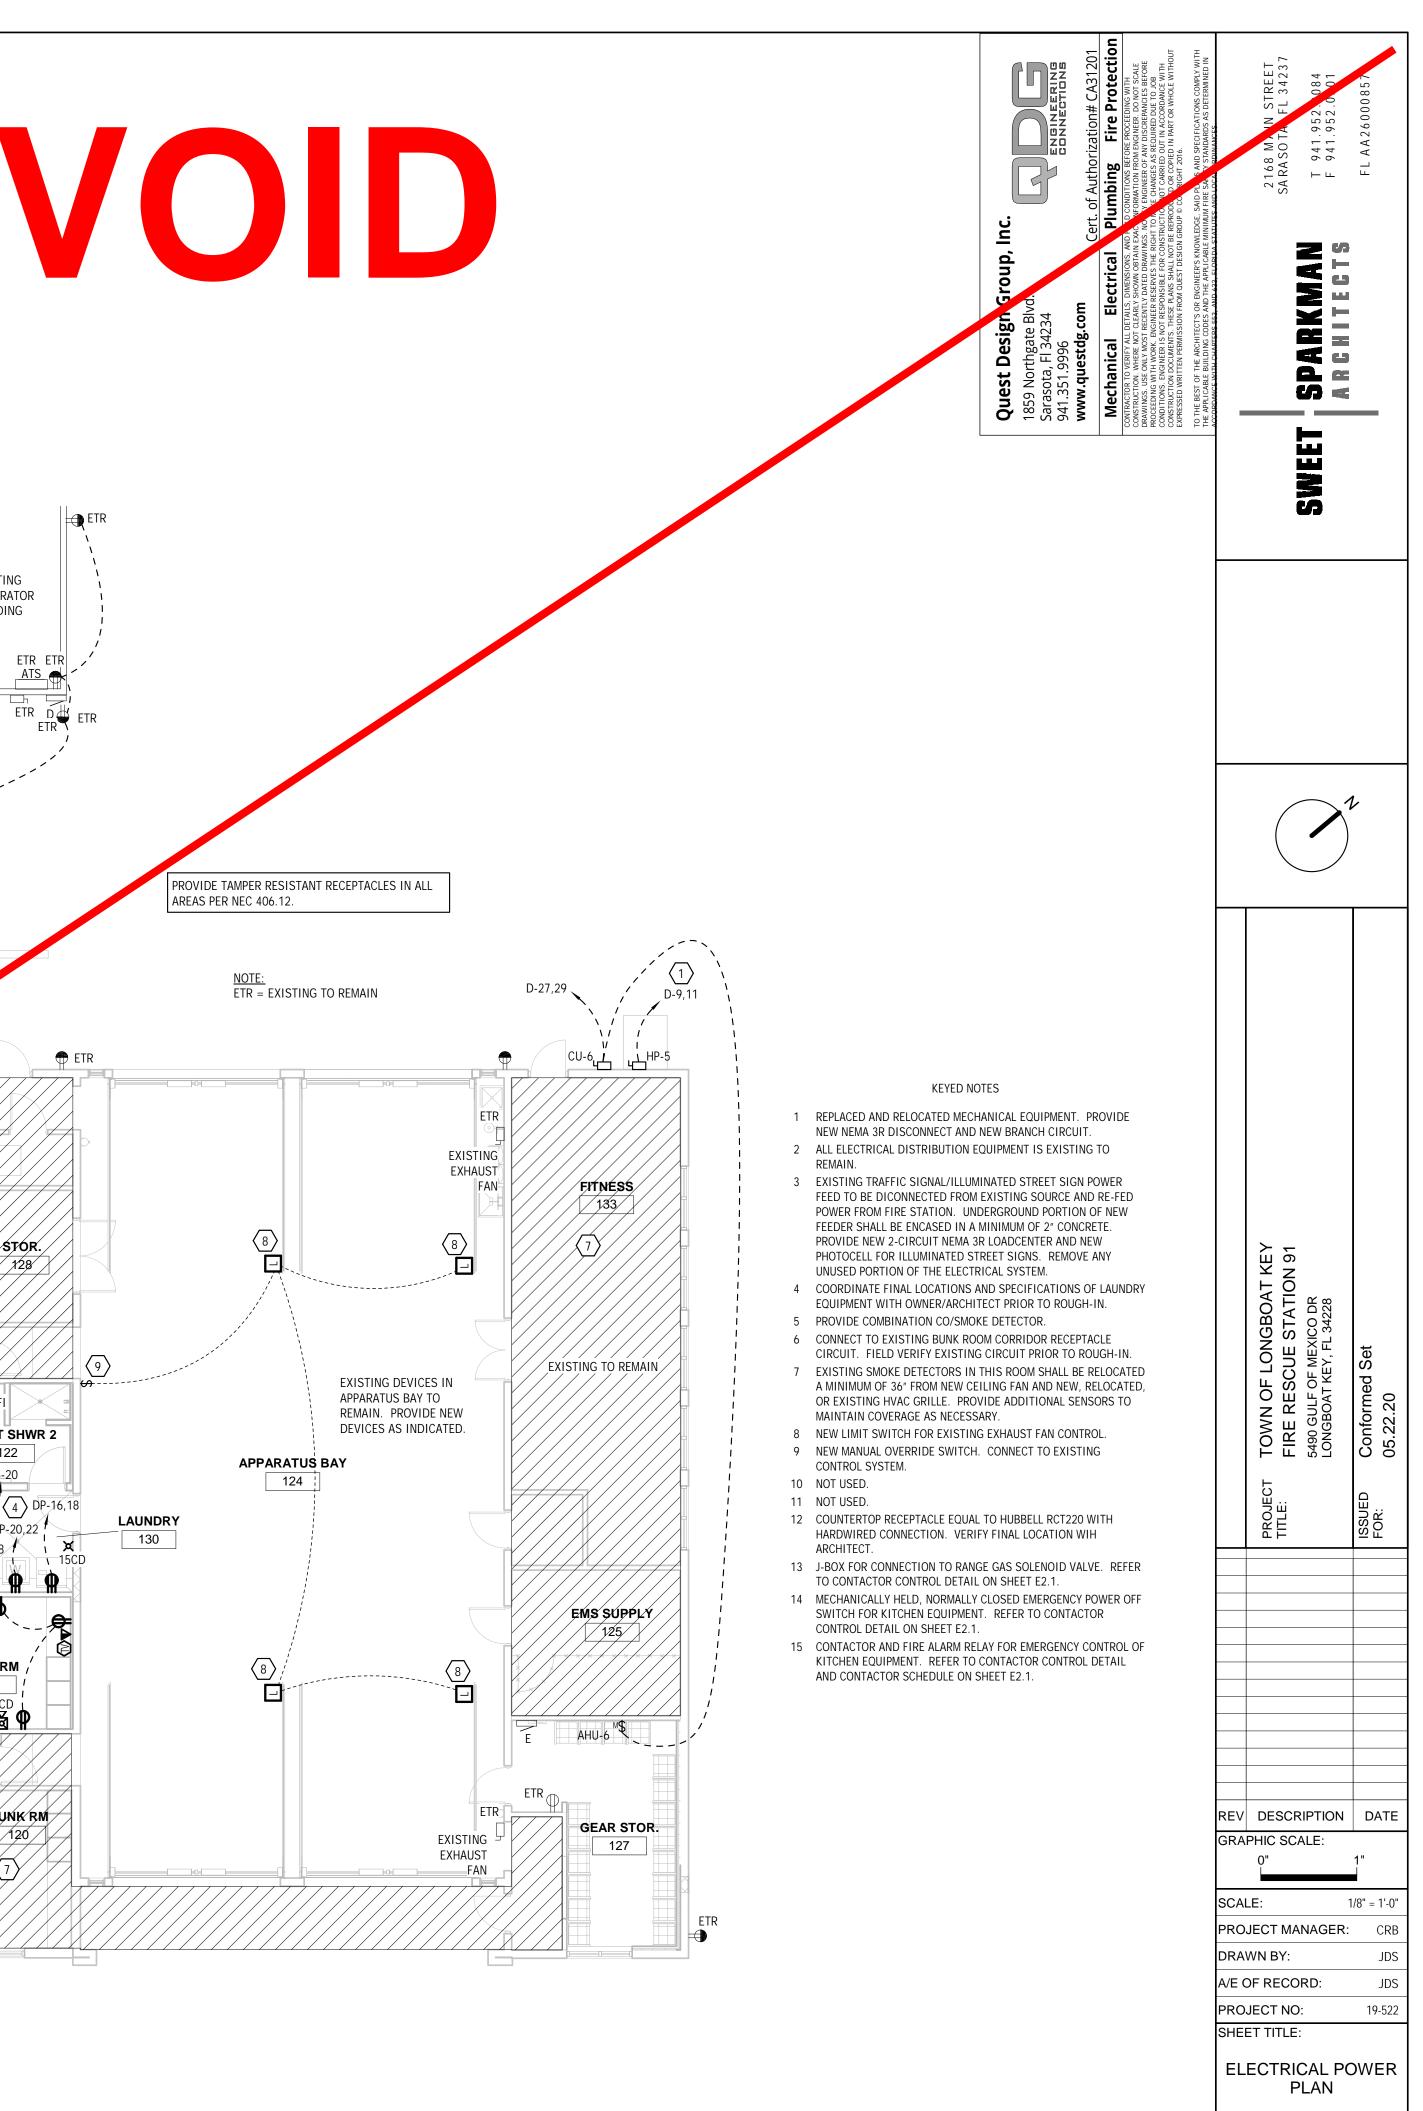

#### **ELECTRICAL IDENTIFICATION NOTES**

#### PRODUCTS AND MATERIALS

ALL LABELS SHALL BE PERMANENT AND MACHINE-PRODUCED. HANDWRITTEN LABELS SHALL NOT BE ACCEPTABLE, UNLESS OTHERWISE INDICATED.

CONDUCTOR/CABLING LABELS: ALL CONDUCTOR/CABLING LABELS SHALL BE CONSTRUCTED OF TRANSPARENT VINYL OR VINYL CLOTH, SELF-LAMINATING TAPE. FLAG-TYPE LABELS SHALL NOT BE ACCEPTABLE. LABELS SHALL BE SIZED TO ACCOMMODATE THAT CIRCUMFERENCE OF THE CONDUCTOR/CABLE.

CONDUCTOR/CABLING IDENTIFICATION TAPE: CONDUCTOR/CABLING IDENTIFICATION TAPE SHALL BE SCOTCH # 35 VINYL ELECTRICAL TAPE, COLORED IN ACCORDANCE WITH THE SYSTEM VOLTAGE AND TYPE OF CONDUCTOR.

NAMEPLATES: NAMEPLATES SHALL BE PHENOLIC, ENGRAVED TYPE. EMBOSSED TAPE SHALL NOT BE ACCEPTABLE. NORMAL SYSTEMS SHALL UTILIZE WHITE LETTERS ON A BLACK BACKGROUND. EMERGENCY SYSTEMS SHALL UTILIZE WHITE LETTERS ON A RED BACKGROUND. LEGALLY-REQUIRED STANDBY SYSTEMS SHALL UTILIZE WHITE LETTERS ON A BLUE BACKGROUND. OPTIONAL STANDBY SYSTEMS SHALL UTILIZE WHITE LETTERS ON A YELLOW BACKGROUND.

ADHESIVE LABELS: ADHESIVE LABELS SHALL NOT BE ACCEPTABLE, EXCEPT FOR THE IDENTIFICATION OF CONDUCTORS/CABLING, DEVICE FACEPLATES, AND JUNCTION BOXES SIZED 8" SQ. OR SMALLER.

#### <u>GENERAL</u>

WHERE MULTIPLE SYSTEM VOLTAGES (E.G. 480/277V, 208/120V, ETC.) ARE UTILIZED IN THE SAME BUILDING, ALL DISCONNECT SWITCHES, JUNCTION BOXES, PANELBOARDS, SWITCHBOARDS, TRANSFORMERS, AND MISCELLANEOUS EQUIPMENT SHALL BE LABELED TO INDICATE THE SYSTEM VOLTAGE, IN ADDITION TO THE REQUIREMENTS LISTED BELOW.

CLEAN ALL MOUNTING SURFACES PRIOR TO AFFIXING LABELS. UTILIZE THE LABEL MANUFACTURER'S RECOMMENDED CLEANING AGENT. INSTALL LABELS NEATLY AND FIRMLY AND IN ACCORDANCE WITH THE LABEL MANUFACTURER'S RECOMMENDATIONS.

AFFIX NAMEPLATES TO EQUIPMENT UTILIZING SCREWS, RIVETS, OR OTHER MATERIALS APPROVED BY THE MANUFACTURER.

PROVIDE A PLACARD AT EACH SERVICE DISCONNECT WITH THE WORDS "SERVICE DISCONNECT." LOCATE ABOVE THE MAIN DISCONNECT SWITCH OR CIRCUIT BREAKER.

JUNCTION BOX AND PULL BOX IDENTIFICATION JUNCTION BOXES AND PULL BOXES SHALL BE IDENTIFIED UTILIZING SPRAY-PAINTED COVERS AS FOLLOWS: SECONDARY POWER - 480Y/277V BROWN SECONDARY POWER - 208Y/120V, 240/120V WHITE EMERGENCY SYSTEM - LIFE SAFETY BRANCH (NEC 700) - 480Y/277V BROWN/RED EMERGENCY SYSTEM - LIFE SAFETY BRANCH (NEC 700) - 208Y/120V WHITE/RED BROWN/BLUE LEGALLY REQUIRED STANDBY SYSTEM (NEC 701) - 480Y/277V LEGALLY REQUIRED STANDBY SYSTEM (NEC 701) - 208Y/120V WHITE/BLUE OPTIONAL STANDBY SYSTEM (NEC 702) - 480Y/277V BROWN/YELLOW OPTIONAL STANDBY SYSTEM (NEC 702) - 208Y/120V WHITE/YELLOW FIRF ALARM RFD TEMPERATURE CONTROL GREEN

DOOR CONTROL AND DOOR MONITORING SYSTEM SOUND AND INTERCOM SYSTEMS VIDEO SURVEILLANCE SYSTEM/MATV DATA

BOXES AND PULL BOXES FOR POWER CONDUCTORS SHALL BE LABELED WITH CIRCUIT NUMBERS AND SOURCE PANELBOARD DESIGNATIONS. JUNCTION BOXES AND PULL BOXES FOR OTHER SYSTEMS SHALL BE IDENTIFIED IN ACCORDANCE WITH THE SHOP DRAWINGS FOR THEIR RESPECTIVE SYSTEMS.

ORANGE

YELLOW

BLUE JUNCTION

GRAY

EXPOSED JUNCTION BOXES EXCEEDING A SIZE OF 8" SQ. SHALL BE IDENTIFIED WITH PHENOLIC, ENGRAVED PLACARDS. LETTERING HEIGHT SHALL BE A MINIMUM OF 1/2". IDENTIFY THE SYSTEM SOURCE(S) AND LOAD(S) SFRVFD.

EXPOSED JUNCTION BOXES 8" SQ. AND SMALLER SHALL BE IDENTIFIED WITH ADHESIVE LABELS.

JUNCTION BOXES INSTALLED ABOVE AN ACCESSIBLE CEILING SHALL BE PERMITTED TO BE IDENTIFIED VIA PERMANENT MARKER. LETTERING SHALL BE NEAT AND LEGIBLE.

#### COMMUNICATIONS CONDUIT LABELING

ALL CONDUITS INSTALLED BETWEEN ELECTRICAL AND/OR INFORMATION TECHNOLOGY (I.T.) ROOMS SHALL BE LABELED IN ACCORDANCE WITH ANSI/TIA/EIA-606. BOTH TERMINATION POINTS OF THE CONDUITS SHALL BE IDENTIFIED.

ALL LABELS SHALL BE MACHINE-PRODUCED. HANDWRITTEN LABELS SHALL NOT BE ACCEPTABLE.

THE LABEL SHALL INDICATE THE LOCATION OF THE TERMINATION POINT OF THE CONDUIT AND A UNIQUE IDENTIFICATION NUMBER.

#### POWER AND LOW-VOLTAGE CONDUCTOR/CABLE IDENTIFICATION

PROVIDE CONDUCTOR/CABLE LABELS ON EACH CONDUCTOR IN PANELBOARD GUTTERS, JUNCTION BOXES, PULL BOXES. AND OUTLET BOXES AT LOAD CONNECTIONS. IDENTIFY THE BRANCH CIRCUIT OR FEEDER NUMBER FOR ALL POWER AND LIGHTING BRANCH CIRCUITS. FOR LOW-VOLTAGE SYSTEMS, INDICATE THE WIRE NUMBER IN ACCORDANCE WITH SHOP DRAWINGS.

ALL CONDUCTORS/CABLING SHALL BE LABELED WITHIN 2 TO 4 INCHES OF TERMINATION. EACH END OF A CONDUCTOR/CABLE SHALL BE LABELED IMMEDIATELY UPON TERMINATION.

#### WIRING DEVICE IDENTIFICATION

WALL SWITCHES, RECEPTACLES, OCCUPANCY SENSORS, DEVICE PLATES, BOX COVERS, POKE-THROUGH FITTINGS, ACCESS FLOOR BOXES, PHOTOCELLS, AND TIME CLOCKS SHALL BE IDENTIFIED WITH CIRCUIT NUMBERS AND SOURCE. IN EXPOSED SPACES, IDENTIFICATION SHALL BE MADE INSIDE OF DEVICE COVERS. USE MACHINE-PRODUCED ADHESIVE LABELS OR PERMANENT MARKER. HANDWRITTEN LABELS SHALL BE NEAT AND LEGIBLE.

NAMEPLATES FOR ELECTRICAL EQUIPMENT PROVIDE NAMEPLATES OF THE MINIMUM LETTER HEIGHT AS LISTED BELOW.

DISTRIBUTION PANELBOARDS, SUBPANELS, AND SWITCHBOARDS: 1 INCH NAME PLATE MIN. IDENTIFY THE SYSTEM VOLTAGE, SOURCE, AND LOCATION OF THE SOURCE. FOR 240V/3PH SYSTEMS: PROVIDE PANELBOARD IDENTIFICATION AS REQUIRED BY 2014 NEC SECTION 408.3; PANELS SHALL BE MARKED "CAUTION B PHASE HAS 208 VOLTS TO GROUND" WITH PHENOLIC ENGRAVED LABEL.

ENCLOSED CIRCUIT BREAKERS AND DISCONNECT SWITCHES: 1/2 INCH NAME PLATE MIN. IDENTIFY THE SOURCE CIRCUIT, LOAD SERVED, AND LOCATION.

TRANSFORMERS: 1 INCH NAME PLATE MIN. IDENTIFY PRIMARY AND SECONDARY VOLTAGES, PRIMARY SOURCE AND LOCATION, SECONDARY LOAD AND LOCATION.

PANELBOARD/SWITCHBOARD DIRECTORIES SHALL BE TYPEWRITTEN AND COVERED WITH CLEAR PLASTIC WITH METAL FRAMING.

#### ELECTRICAL COMMISIONING

#### SCOPE: FUNCTIONAL TESTING PRIOR TO PASSING FINAL INSPECTION, THE REGISTERE

- FOLLOWING EMERGENCY CONDITIONS: 1. ALL MODES AS DESCRIBED IN THE SEQUENCE OF OPERATION OR MANU
- INSTRUCTIONS REDUNDANT OR AUTOMATIC BACK-UP MODE
- PERFORMANCE OF LIGHTING OVERRIDE

- THE GENERAL CONTRACTOR SHALL: INCORPORATE COMMISSIONING ACTIVITIES INTO THE CONSTRUCTION
- FACILITATE COOPERATION OF SUB-CONTRACTORS IN COMMISSIONING
- PROVIDE SUB-CONTRACTOR ASSISTANCE IN OPERATING EQUIPMENT TO
- INSURE EQUIPMENT START-UP IS COMPLETE PRIOR TO BEGINNING THE WORK WITH SUB-CONTRACTORS IN DEVELOPING A TRAINING SCHEDUL
- THE OWNER.
- VERIFY THE PRE-FUNCTIONAL CHECKLISTS ARE COMPLETED PRIOR TO SY VERIFY THE EQUIPMENT START-UP AND CONTROLS VERIFICATIONS ARE
- INSURE RESOLUTION OF NON-COMPLIANT AND DEFICIENT CONSTRUCT BY THE COMMISSIONING TEAM.
- 9. ASSIST IN WARRANTY REVIEW OF SYSTEM AND EQUIPMENT PERFORMAN THE SUB-CONTRACTORS SHALL:
- PREPARE OWNER TRAINING PLAN FOR INSTALLED EQUIPMENT AND CONT PROVIDE NECESSARY PERSONNEL TO ASSIST THE ELECTRICAL TESTING
- AS DESCRIBED LATER IN THIS SPECIFICATION. PREPARE AND SCHEDULE EQUIPMENT START-UP WITH THE GENERAL COM
- TESTING AGENT. 4. EXECUTE ALL REQUIRED EQUIPMENT AND SYSTEM TESTING AS MANDAT CODE, PROJECT PLANS AND SPECIFICATIONS.
- ENSURE INSTALLATION WORK IS COMPLETE AND IN COMPLIANCE WITH READY FOR FUNCTION PERFORMANCE TESTING.
- PROVIDE CERTIFIED AND CALIBRATED INSTRUMENTATION REQUIRED TO SYSTEM AND EQUIPMENT PERFORMANCE DURING THE FUNCTIONAL PERF
- PREPARE CLOSEOUT DOCUMENTS INCLUDING BUT NOT LIMITED TO: 7
  - a. AS-BUILT DRAWINGS WARRANTIES.
  - OPERATIONAL AND MAINTENANCE MANUALS FOR INSTALLED EQU DELIVERY OF ANY SPARE PARTS REQUIRED BY THE PROJECT SPEC

- AN OPERATION AND MAINTENANCE MANUAL SHALL BE PROVIDED AND INCLUDE 1. SUBMITTAL DATA STATING EQUIPMENT SIZE AND SELECTED OPTIONS FOR
- REQUIRING MAINTENANCE. 2. MANUFACTURER'S OPERATION MANUALS AND MAINTENANCE MANUALS F REQUIRING MAINTENANCE, EXCEPT EQUIPMENT NOT FURNISHED AS PAR ROUTINE MAINTENANCE ACTIONS SHALL BE CLEARLY IDENTIFIED.

- RESULTS OF FUNCTIONAL PERFORMANCE TESTS. DISPOSITION OF DEFICIENCIES FOUND DURING TESTING, INCLUDING DE
- MEASURES USED OR PROPOSED. FUNCTIONAL PERFORMANCE TEST PROCEDURES USED DURING THE COM
- INCLUDING MEASURABLE CRITERIA FOR TEST ACCEPTANCE, PROVIDED
- CONTROLS FOR AUTOMATIC LIGHTING SYSTEMS SHALL COMPLY AS FOLLOWS: TESTING SHALL ENSURE THAT CONTROL HARDWARE AND SOFTWARE A PROGRAMMED AND IN PROPER WORKING CONDITION IN ACCORDANCE
- DOCUMENTS AND MANUFACTURER'S INSTALLATION INSTRUCTIONS. AN APPROVED THIRD PARTY INDEPENDENT FROM THE DESIGN OR CONS SHALL BE RESPONSIBLE FOR THE FUNCTIONAL TESTING AND SHALL PRO OWNER, REGISTERED DESIGN PROFESSIONAL AND CODE OFFICIAL CER LIGHTING CONTROLS MEET THE PROVISIONS OF SECTION C405. WHER SWITCHES, PROGRAMMABLE SCHEDULE CONTROLS, PHOTOSENSORS OF
- INSTALLED, THE FOLLOWING PROCEDURES SHALL BE PERFORMED: a. CONFIRM THAT THE PLACEMENT, SENSITIVITY AND TIME-OUT AD. SENSORS YIELD ACCEPTABLE PERFORMANCE AS PER FBC-C408.3
- CONFIRM THAT THE TIME SWITCHES AND PROGRAMMABLE SCHE PROGRAMMED TO TURN THE LIGHTS OFF AS PER THE OWNER SC CONFIRM THAT THE PLACEMENT AND SENSITIVITY ADJUSTMENTS
- REDUCE ELECTRIC LIGHT BASED ON THE AMOUNT OF USABLE DA SPECIFIED AND PER C408.3.


#### ELECTRICAL NOTES AND SPECIFICATIONS:

ELECTRICAL COMMISIONING	ELECTRICAL NOTES AND SPECIFICATIONS:
BUILDING COMMISSIONING GENERAL REQUIREMENTS: THE 2017 FLORIDA BUILDING CODE - "ENERGY CONSERVATION" PROVIDES THE REQUIREMENTS FOR COMMERCIAL BUILDING EFFICIENCY. THE CODE DEFINES THE ENERGY EFFICIENCY REQUIREMENTS FOR THE ELECTRICAL POWER AND LIGHTING SYSTEM, TOTAL BUILDING PERFORMANCE, AND COMMISSIONING. THIS CODE CHAPTER REQUIRES A CERTAIN SET OF ACTIVITIES AND PROCESSES TO BE ADMINISTERED AND DOCUMENTED	1. DRAWINGS ARE DIAGRAMMATIC AND INDICATE THE GENERAL ARRANGEMENT OF SYSTEMS AND WORK INCLUDED IN THE CONTRACT. DRAWINGS ARE NOT TO BE SCALED. THE DRAWINGS AND DETAILS WILL BE EXAMINED FOR EXACT LOCATION OF FIXTURES AND EQUIPMENT. ANYTHING MENTIONED IN THE SPECIFICATION AND NOT SHOWN ON THE DRAWINGS, OR SHOWN ON THE DRAWINGS BUT NOT IN THE SPECIFICATIONS WILL BE INTERPRETED AS BEING IN BOTH. CONFLICTS WILL BE IMMEDIATELY BROUGHT TO THE ATTENTION OF THE OWNER OR ENGINEER BEFORE PROCEEDING WITH THE WORK.
IN ACCORDANCE WITH DEFINED STANDARDS. THIS SPECIFICATION IS THE OWNER'S MEANS OF VERIFYING THAT THE PLANNING, DESIGN, CONSTRUCTION AND OPERATION OF ELECTRICAL SYSTEMS ACHIEVE THEIR GOALS AND DELIVER A HIGH QUALITY BUILDING WITH MAXIMUM ASSET VALUES.	<ol> <li>THE ELECTRICAL CONTRACTOR TO FURNISH ALL EQUIPMENT, MATERIAL, LABOR, ETC. NECESSARY TO PROVIDE A COMPLETE, WORKABLE AND CODE APPROVED ELECTRICAL POWER DISTRIBUTION SYSTEM. ALL WORK TO BE DONE IN ACCORDANCE WITH THESE PLANS AND SPECIFICATIONS, LOCAL, STATE AND NATIONAL CODES.</li> </ol>
COMMISSIONING OF THE BUILDING ELECTRICAL POWER AND LIGHTING SYSTEMS AS PER SECTION 408 SHALL BE AS DEFINED HEREIN. PRIOR TO PASSING THE FINAL ELECTRICAL INSPECTION, THE CONTRACTOR SHALL PROVIDE EVIDENCE OF SYSTEM COMMISSIONING AND COMPLETION IN ACCORDANCE WITH THE PROVISIONS OF THIS SECTION CERTIFYING THAT THE INSTALLED LIGHTING CONTROLS MEET THE DOCUMENTED PERFORMANCE CRITERIA OF SECTION C405 AND SUBMIT TO THE REGISTERED DESIGN PROFESSIONAL (ENGINEER OF RECORD) FOR APPROVAL, AND TO THE BUILDING OWNER WITHIN 90 DAYS FROM THE DATE OF RECEIPT OF THE CERTIFICATION OF OCCUPANCY.	3. THE ELECTRICAL CONTRACTOR WILL GIVE ALL NECESSARY NOTICES, OBTAIN ALL PERMITS AND PAY ALL GOVERNMENT FEES, SALES TAXES AND OTHER COSTS IN CONNECTION WITH HIS WORK, FILE ALL NECESSARY APPROVALS OF ALL GOVERNMENTAL DEPARTMENTS HAVING JURISDICTION, OBTAIN ALL REQUIRED CERTIFICATES OF INSPECTION FOR HIS WORK, AND DELIVER TO THE GENERAL CONTRACTOR THE SAME CERTIFICATES BEFORE REQUEST FOR ACCEPTANCE AND FINAL PAYMENT FOR THE WORK.
ELECTRICAL SYSTEMS TO BE COMMISSIONED INCLUDE: ALL AUTOMATIC CONTROLS FOR INTERIOR AND EXTERIOR LIGHTING/ELECTRICAL SYSTEMS SHALL BE SUBJECT TO THESE REQUIREMENTS.	4. THE ELECTRICAL CONTRACTOR (E.C.) WILL GIVE FULL COOPERATION TO OTHER TRADES AND WILL FURNISH IN WRITING TO THE GENERAL CONTRACTOR, ANY INFORMATION NECESSARY TO PERMIT THE WORK OF ALL TRADES TO BE INSTALLED SATISFACTORILY AND WITH THE LEAST POSSIBLE INTERFERENCE OR DELAY. THE E.C. MUST COORDINATE ALL CONDUIT RUNS AND EQUIPMENT MOUNTING LOCATIONS WITH OTHER TRADES PRIOR TO ROUGH-IN.
SCOPE: FUNCTIONAL TESTING PRIOR TO PASSING FINAL INSPECTION, THE REGISTERED DESIGN PROFESSIONAL SHALL PROVIDE EVIDENCE THAT THE LIGHTING CONTROL SYSTEMS HAVE BEEN TESTED TO ENSURE THAT CONTROL AND SOFTWARE ARE CALIBRATED, ADJUSTED, PROGRAMMED AND IN PROPER WORKING CONDITION IN ACCORDANCE	5. THE ELECTRICAL CONTRACTOR TO PROVIDE AND INSTALL ALL ELECTRICAL DEVICES AS SHOWN, VERIFYING ALL MOUNTING HEIGHTS AND EXACT LOCATIONS OF ALL WALL-MOUNTED ELECTRICAL DEVICES WITH GENERAL CONTRACTOR PRIOR TO ROUGH-IN. IN THE EVENT OF A CODE CONFLICT, THE CONTRACTOR WILL NOTIFY THE ARCHITECT/ENGINEER PRIOR TO COMMENCING THE WORK.
WITH THE CONSTRUCTION DOCUMENTS AND MANUFACTURE'S INSTRUCTIONS. FUNCTIONAL TESTING SHALL BE IN ACCORDANCE WITH SECTIONS C408.3.1.1 THRU C408.3.1.3 FOR THE APPLICABLE CONTROL TYPE. THE PROJECT GENERAL CONTRACTOR SHALL HIRE A FIRM QUALIFIED IN THE TESTING OF LIGHTING AND	6. ALL SPARE CONDUITS TO BE INSTALLED FOR FUTURE USE WILL BE CAPPED WITH PULL WIRE INSTALLED. UNDERGROUND SPARE CONDUITS WILL BE STUBBED UP 12" A.F.F. WHERE INDICATED AND CAPPED WITH PULL WIRE. ALL CAPPED CONDUIT WILL BE LABELED WITH ITS PURPOSE.
ELECTRICAL SYSTEM PERFORMANCE FUNCTIONALITY OF THE SYSTEMS LISTED IN THIS SPECIFICATION. THE TESTING FIRM SHALL DETERMINE THE EXTENT AND SCOPE OF THE SYSTEMS REQUIRING COMMISSIONING NEEDED ON A PROJECT BASIS. ALL TEST DATA SHALL BE PROVIDED TO THE REGISTERED DESIGN PROFESSIONAL FOR FINAL REVIEW AND	7. THE ELECTRICAL CONTRACTOR WILL PROVIDE A COMPLETE GROUNDING SYSTEM PER APPLICABLE SECTIONS OF THE N.E.C. BOND SERVICE ENTRANCE GROUND TO BUILDING STEEL, METAL WATER MAINS, MADE ELECTRODES, ETC. AS NECESSARY.
APPROVAL PRIOR TO THE FINAL INSPECTION AND WALK THROUGH OF THE ARCHITECTURAL AND/OR ENGINEERING TEAM. A FUNCTIONAL PERFORMANCE TEST SHALL BE CONDUCTED TO DEMONSTRATE THE INSTALLATION AND	8. ALL ELECTRICAL DISTRIBUTION EQUIPMENT TO HAVE ONLY COPPER BUSING. ALL EXTERIOR ELECTRICAL EQUIPMENT TO BE RAIN-PROOF TYPE NEMA 3R. ALL DISCONNECTS TO BE GENERAL DUTY TYPE. ALL EXTERIOR DISCONNECTS TO BE RAIN-PROOF TYPE NEMA 3R. ALL CIRCUIT BREAKERS TO BE 20A MINIMUM OR AS SHOWN ON THE PANEL SCHEDULES.
OPERATION OF COMPONENTS, SYSTEMS, AND SYSTEM-TO-SYSTEM INTERFACING RELATIONSHIPS IN ACCORDANCE WITH APPROVED PLANS AND SPECIFICATIONS SUCH THAT OPERATION, FUNCTION, AND MAINTENANCE SERVICEABILITY FOR EACH OF THE COMMISSIONED SYSTEMS IS CONFIRMED. TESTING SHALL INCLUDE ALL MODES AND SEQUENCE OF OPERATION, INCLUDING UNDER FULL-LOAD, PART-LOAD AND THE FOLLOWING EMERGENCY CONDITIONS: 1. ALL MODES AS DESCRIBED IN THE SEQUENCE OF OPERATION OR MANUFACTURES OPERATING	9. ALL DISCONNECTS SHALL BE HEAVY DUTY TYPE AND INSTALLED AS REQUIRED FOR CONDENSING AND AIR HANDLING UNITS, EXHAUST FANS, KITCHEN EQUIPMENT, WATER HEATERS, ETC. SUPPLIED BY MECHANICAL, PLUMBING AND FOOD SERVICE CONTRACTOR(S). SUPPLY AND INSTALL ALL REQUIRED CONDUIT AND DEVICE BOXES FOR HVAC TEMPERATURE CONTROLS.
<ul> <li>INSTRUCTIONS</li> <li>2. REDUNDANT OR AUTOMATIC BACK-UP MODE</li> <li>3. PERFORMANCE OF LIGHTING OVERRIDE</li> <li>4. MODE OF OPERATION UPON A LOSS OF POWER AND RESTORATION OF POWER.</li> <li>THE GENERAL CONTRACTOR SHALL:</li> <li>1. INCORPORATE COMMISSIONING ACTIVITIES INTO THE CONSTRUCTION SCHEDULE.</li> <li>2. FACILITATE COOPERATION OF SUB-CONTRACTORS IN COMMISSIONING WORK.</li> </ul>	10. ELECTRICAL CONTRACTOR TO SUPPLY ALL REQUIRED DISCONNECTS AND WIRE ALL EXHAUST FANS, AIR HANDLER UNITS, CONDENSING UNITS, SMOKE DAMPERS, ETC. PROVIDED BY THE MECHANICAL E.C. WILL VERIFY NAMEPLATE RATINGS OF ALL MECHANICAL EQUIPMENT PRIOR TO ROUGH-IN. E.C. TO PROVIDE DISCONNECTS AND CIRCUIT BREAKERS PER NAMEPLATE RATING. THE E.C. SHALL PROVIDE ALL HARDWARE(CONTROL RELAYS, LOW VOLTAGE TRANSFORMER POWER SUPPLIES, & ENCLOSURES) FOR THE PROPER OPERATION OF MECH. UNITS, EXHAUST FANS & SMOKE DAMPERS PER THE "SEQUENCE OF OPERATIONS" AS DETAILED ON THE MECHANICAL PLANS. THE E.C. WILL NOTIFY THE ARCHITECT/ENGINEER OF ANY CHANGES REQUIRED TO CIRCUITING PRIOR TO COMMENCING THE WORK.
<ol> <li>PROVIDE SUB-CONTRACTOR ASSISTANCE IN OPERATING EQUIPMENT TO BE COMMISSIONED.</li> <li>INSURE EQUIPMENT START-UP IS COMPLETE PRIOR TO BEGINNING THE COMMISSIONING PROCESS.</li> <li>WORK WITH SUB-CONTRACTORS IN DEVELOPING A TRAINING SCHEDULE AND PLAN FOR APPROVAL BY THE OWNER.</li> <li>VERIFY THE PRE-FUNCTIONAL CHECKLISTS ARE COMPLETED PRIOR TO SYSTEM TESTING.</li> <li>VERIFY THE EQUIPMENT START-UP AND CONTROLS VERIFICATIONS ARE COMPLETE.</li> <li>INSURE RESOLUTION OF NON-COMPLIANT AND DEFICIENT CONSTRUCTION RELATED ITEMS IDENTIFIED BY THE COMMISSIONING TEAM.</li> <li>ASSIST IN WARRANTY REVIEW OF SYSTEM AND EQUIPMENT PERFORMANCE.</li> </ol>	11. ALL INTERIOR POWER/LIGHTING CIRCUITS TO BE 2-#12, 1-#12 G. IN MINIMUM 1/2" C. W/MAXIMUM 30% FILL, UNLESS SHOWN OTHERWISE ON THE PLANS. INTERIOR HOME RUNS TO BE A MINIMUM OF 3/4" C. W/MAXIMUM 40% FILL. ALL EXTERIOR LIGHTING CIRCUITS TO BE A MINIMUM OF 2-#10 W/#10G TO THE FIRST JUNCTION BOX OR LIGHT FIXTURE AND 2-#12 W/#10G TO THE REMAINING FIXTURES OR AS INDICATED ON PLANS. ALL UNDERGROUND CONDUIT TO BE A MINIMUM OF 1". TYPE MC CABLE HAVING STRANDED COPPER CONDUCTORS SHALL BE ACCEPTABLE FOR BRANCH CIRCUITS IN CONDITIONED SPACES ONLY. ALL FEEDER CONDUCTORS SHALL BE COPPER WITH TYPE THHN INSULATION. TYPE XHHW- 2 OR THWN-2 SHALL BE USED FOR CONDUCTORS INSTALLED IN WET AND DAMP LOCATIONS. SPECIFIC EQUIPMENT CIRCUITS (HVAC, PUMPS, WATER HEATERS, ETC.) SHALL BE AS REQUIRED PER NAMEPLATE RATING(S).
<ol> <li>PREPARE OWNER TRAINING PLAN FOR INSTALLED EQUIPMENT AND CONTROLS.</li> <li>PROVIDE NECESSARY PERSONNEL TO ASSIST THE ELECTRICAL TESTING AGENT IN HIS RESPONSIBILITIES AS DESCRIBED LATER IN THIS SPECIFICATION.</li> <li>PREPARE AND SCHEDULE EQUIPMENT START-UP WITH THE GENERAL CONTRACTOR AND ELECTRICAL TESTING AGENT.</li> </ol>	12. THE ELECTRICAL CONTRACTOR SHALL PROPERLY AND PERMANENTLY IDENTIFY ALL BOXES, ENCLOSURES, ETC. FOR EMERGENCY CIRCUITS IN ACCORDANCE WITH NEC 700.10. LABEL ALL PANEL CIRCUITS TO IDENTIFY UNIT EQUIPMENT CONNECTED IN ACCORDANCE WITH NEC 700.12(F).
<ol> <li>EXECUTE ALL REQUIRED EQUIPMENT AND SYSTEM TESTING AS MANDATED BY 2017 FLORIDA BUILDING CODE, PROJECT PLANS AND SPECIFICATIONS.</li> <li>ENSURE INSTALLATION WORK IS COMPLETE AND IN COMPLIANCE WITH THE CONTRACT DOCUMENTS AND READY FOR FUNCTION PERFORMANCE TESTING.</li> <li>PROVIDE CERTIFIED AND CALIBRATED INSTRUMENTATION REQUIRED TO TAKE MEASUREMENTS OF SYSTEM AND EQUIPMENT PERFORMANCE DURING THE FUNCTIONAL PERFORMANCE TESTING.</li> </ol>	13. ELECTRICAL CONTRACTOR WILL CONTACT LOCAL ELECTRICAL UTILITY AND COORDINATE EXACT LOCATION OF ELECTRICAL SERVICE SOURCE. THE CONTRACTOR SHALL COORDINATE SHORT CIRCUIT RATING (A.I.C.) WITH UTILITY PRIOR TO BID AND PROVIDE THE APPROPRIATE SHORT CIRCUIT RATINGS FOR ALL ELECTRICAL EQUIPMENT. COORDINATE USE OF HAND HOLE / UTILITY POLE / PAD MOUNT TRANSFORMER PRIOR TO BID AND/OR ROUGH-IN.
<ul> <li>7. PREPARE CLOSEOUT DOCUMENTS INCLUDING BUT NOT LIMITED TO:</li> <li>a. AS-BUILT DRAWINGS</li> <li>b. WARRANTIES.</li> <li>c. OPERATIONAL AND MAINTENANCE MANUALS FOR INSTALLED EQUIPMENT.</li> </ul>	14. MINOR DETAILS, NOT USUALLY SHOWN OR SPECIFIED, BUT NECESSARY FOR PROPER OPERATION AND CONSISTENT WITH GOOD WORKMANSHIP, WILL BE INCLUDED IN THE ESTIMATE, THE SAME AS IF SHOWN ON DRAWINGS.
d. DELIVERY OF ANY SPARE PARTS REQUIRED BY THE PROJECT SPECIFICATION. THE CODE OFFICIAL SHALL BE PERMITTED TO REQUIRE THAT A COPY OF THE FINAL COMMISSIONING REPORT BE MADE AVAILABLE FOR HIS/HER REVIEW.	15. PROVIDE CONDUIT STUBS, BACK BOXES AND PULL STRINGS ETC. FOR ALL LOW VOLTAGE SYSTEMS PROVIDED BY OTHERS TO DEVICES LOCATED IN ALL SPACES. PROVIDE SEPARATE PERMITS FOR ALL LOW VOLTAGE SYSTEMS.
CONSTRUCTION DOCUMENTS SHALL INCLUDE THE LOCATION ON EACH PIECE OF EQUIPMENT.	16. ALL MATERIALS FURNISHED AND ALL WORK INSTALLED UNDER THIS SECTION SHALL COMPLY WITH THE FOLLOWING:
<ul> <li>AN OPERATION AND MAINTENANCE MANUAL SHALL BE PROVIDED AND INCLUDE ALL OF THE FOLLOWING:</li> <li>SUBMITTAL DATA STATING EQUIPMENT SIZE AND SELECTED OPTIONS FOR EACH PIECE OF EQUIPMENT REQUIRING MAINTENANCE.</li> <li>MANUFACTURER'S OPERATION MANUALS AND MAINTENANCE MANUALS FOR EACH PIECE OF EQUIPMENT REQUIRING MAINTENANCE, EXCEPT EQUIPMENT NOT FURNISHED AS PART OF THE PROJECT. REQUIRED ROUTINE MAINTENANCE ACTIONS SHALL BE CLEARLY IDENTIFIED.</li> </ul>	<ul> <li>LIFE SAFETY CODE NFPA 101-2015</li> <li>APPLICABLE NFPA FIRE CODES</li> <li>APPLICABLE STATE AND LOCAL CODES</li> <li>NATIONAL BUREAU OF FIRE UNDERWRITERS</li> <li>ACCESSIBILITY FOR THE HANDICAPPED ANSI A117</li> <li>AMERICANS WITH DISABILITIES ACT ACCESSIBILITY GUIDELINES</li> <li>FLORIDA DEPARTMENT OF COMMUNITY AFFAIRS ACCESSIBILITY REQUIREMENTS MANUAL</li> </ul>
<ul> <li>A REPORT OF TEST PROCEDURES AND RESULTS IDENTIFIED AS "FINAL COMMISSIONING REPORT" SHALL BE DELIVERED TO THE BUILDING OWNER AND SHALL INCLUDE:</li> <li>1. RESULTS OF FUNCTIONAL PERFORMANCE TESTS.</li> <li>2. DISPOSITION OF DEFICIENCIES FOUND DURING TESTING, INCLUDING DETAILS OF CORRECTIVE MEASURES USED OR PROPOSED.</li> <li>3. FUNCTIONAL PERFORMANCE TEST PROCEDURES USED DURING THE COMMISSIONING PROCESS INCLUDING MEASURABLE CRITERIA FOR TEST ACCEPTANCE, PROVIDED HEREIN FOR REPEATABILITY.</li> </ul>	<ul> <li>NATIONAL ELECTRICAL CODE NFPA 70-2014</li> <li>THE SERVING UTILITY COMPANIES</li> <li>FLORIDA BUILDING CODE 2017, SIXTH EDITION</li> <li>FLORIDA BUILDING CODE - ENERGY CONSERVATION 2017</li> <li>FLORIDA BUILDING CODE - MECHANICAL 2017</li> <li>FLORIDA BUILDING CODE - PLUMBING 2017</li> </ul>
CONTROLS FOR AUTOMATIC LIGHTING SYSTEMS SHALL COMPLY AS FOLLOWS: 1. TESTING SHALL ENSURE THAT CONTROL HARDWARE AND SOFTWARE ARE CALIBRATED, ADJUSTED, PROGRAMMED AND IN PROPER WORKING CONDITION IN ACCORDANCE WITH THE CONSTRUCTION	17. ALL ELECTRICAL SYSTEM COMPONENTS AND INSTALLATIONS SHALL BE WARRANTED TO BE FREE OF DEFECTS (MATERIALS AND LABOR) FOR A PERIOD OF NOT LESS THAN ONE (1) YEAR FROM RECEIPT OF CERTIFICATE OF OCCUPANCY. THE CONTRACTOR SHALL PROVIDE FOR OWNER'S OPTION A MAINTENANCE CONTRACT AND/OR AN EXTENDED WARRANTY
<ul> <li>DOCUMENTS AND MANUFACTURER'S INSTALLATION INSTRUCTIONS.</li> <li>AN APPROVED THIRD PARTY INDEPENDENT FROM THE DESIGN OR CONSTRUCTION OF THE PROJECT SHALL BE RESPONSIBLE FOR THE FUNCTIONAL TESTING AND SHALL PROVIDE DOCUMENTATION TO THE OWNER, REGISTERED DESIGN PROFESSIONAL AND CODE OFFICIAL CERTIFYING THAT THE INSTALLED LIGHTING CONTROLS MEET THE PROVISIONS OF SECTION C405. WHERE OCCUPANT SENSORS, TIME SWITCHES, PROGRAMMABLE SCHEDULE CONTROLS, PHOTOSENSORS OR DAYLIGHTING CONTROLS ARE INSTALLED, THE FOLLOWING PROCEDURES SHALL BE PERFORMED:         <ul> <li>a. CONFIRM THAT THE PLACEMENT, SENSITIVITY AND TIME-OUT ADJUSTMENTS FOR OCCUPANT SENSORS YIELD ACCEPTABLE PERFORMANCE AS PER FBC-C408.3.</li> <li>b. CONFIRM THAT THE TIME SWITCHES AND PROGRAMMABLE SCHEDULE CONTROLS ARE</li> </ul> </li> </ul>	18. CONTRACTOR TO PROVIDE MANUFACTURER CERTIFICATION, WITH SHOP DRAWING SUBMITTALS, THAT POLE ASSEMBLY WITH SPECIFIED HEADS AND ALL SPECIFIED OPTIONS MEETS WIND LOAD REQUIREMENTS PER 2017 FLORIDA BUILDING CODE FIGURE 1609.3. ELECTRICAL CONTRACTOR TO SUBMIT MANUFACTURER RECOMMENDED CHANGES FOR A CODE COMPLYING INSTALLATION TO OWNER/ENGINEER FOR APPROVAL. ADDITIONALLY, CONTRACTOR SHALL PROVIDE CERTIFICATION THAT POLE MOUNTING METHOD; I.E., DIRECT BURY/ANCHOR BASE MEETS THE ABOVE REQUIREMENTS. POLE MOUNTING CERTIFICATION SHALL BE SIGNED AND SEALED BY A PROFESSIONAL ENGINEER REGISTERED IN THE STATE OF FLORIDA.
<ul> <li>PROGRAMMED TO TURN THE LIGHTS OFF AS PER THE OWNER SCHEDULE AND FBC-C408.3.1.2.</li> <li>CONFIRM THAT THE PLACEMENT AND SENSITIVITY ADJUSTMENTS FOR PHOTOSENSOR CONTROLS REDUCE ELECTRIC LIGHT BASED ON THE AMOUNT OF USABLE DAYLIGHT IN THE SPACE AS SPECIFIED AND PER C408.3.</li> </ul>	19. ELEVATOR SIZE IS BASED ON A XX HORSEPOWER MOTOR. ELECTRICAL CONTRACTOR WILL VERIFY WITH ELEVATOR MANUFACTURER FOR EXACT SIZE OF ELEVATOR PRIOR TO BID. E.C. TO PROVIDE CIRCUIT BREAKER AND DISCONNECT SIZES RECOMMENDED BY ELEVATOR SHOP DRAWINGS. THE ELEVATOR CIRCUIT BREAKER WILL BE SHUNT-TRIP. E.C. WILL NOTIFY ARCHITECT/ENGINEER OF MOTOR SIZE CHANGES PRIOR TO COMMENCING THE WORK.
	20. PROVIDE LIGHTNING PROTECTION IN ACCORDANCE WITH SPECIFICATION SECTION 264114. LIGHTNING SYSTEM GROUND SYSTEM SHALL BE BONDED TO THE BUILDING GROUNDING ELECTRODE SYSTEM IN ACCORDANCE WITH NEC 250.106.


21. ELECTRICAL CONTRACTOR TO PROVIDE AS-BUILT DOCUMENTS, OPERATION MANUALS, MAINTENANCE MANUALS TO THE OWNER WITHIN 30 DAYS OF ACCEPTANCE OF SYSTEMS AS PER FBC C405.6.4.2.

SYMBOL	DESCRIPTION
\$	SINGLE POLE SWITCH, MOUNT 48" AFF U.O.N.
<b>\$</b> 3, <b>\$</b> 4	THREE-WAY/FOUR-WAY SWITCH RESPECTIVEL
\$M	MOTOR-RATED SWITCH, SINGLE/DOUBLE POLE
\$D	SLIDE DIMMER W/PRESET ON/OFF SWITCH, MA
\$т \$oc	SPRINGWOUND TIMER SWITCH, INTERMATIC "
	WALL SWITCH OCCUPANCY SENSOR (DUAL), LI WALL SWITCH OCCUPANCY SENSOR 3-WAY (D
\$0C4	WALL SWITCH OCCUPANCY SENSOR 4-WAY (D
\$vc	WALL SWITCH VACANCY SENSOR (DUAL), LEG
<b>\$</b> VC3	WALL SWITCH VACANCY SENSOR 3-WAY (DUA
<b>\$</b> VC4	WALL SWITCH VACANCY SENSOR 4-WAY (DUA
\$ _{DV}	WALL SWITCH DIMMING VACANCY SENSOR (D
ОС1 \$к	CEILING MOUNT OCCUPANCY SENSOR (120-27
\$⊂	KEY SWITCH, MOUNT 48" AFF U.O.N. COMBINATION FAN SPEED CONTROL & FAN LIC
φ	SIMPLEX RECEPTACLE, MOUNT 18'' AFF U.O.N.
Ф	DUPLEX RECEPTACLE, MOUNT 18" AFF U.O.N.
φ	DUPLEX RECEPTACLE, MOUNT 42" AFF (48" AFF
<u> </u>	SWITCHED SPLIT-WIRE DUPLEX RECEPTACLE, I
₩	FLOOR MOUNTED DUPLEX RECEPTACLE. REFER
	FLOOR MOUNTED SWITCHED SPLIT-WIRE DUPL QUADRAPLEX RECEPTACLE, MOUNT 18" AFF U.
	QUADRAPLEX RECEPTACLE, MOUNT 42" AFF U.
	SWITCHED SPLIT-WIRE QUADRAPLEX RECEPTA
	FLOOR MOUNTED QUADRAPLEX RECEPTACLE. F
	FLOOR MOUNTED SWITCHED SPLIT-WIRE QUAI
	1Ø, 208/240-VOLT RECEPTACLE, MOUNT 18" A
	SPECIAL PURPOSE RECEPTACLE, MOUNT 18" A
•	BUILDING EXTERIOR/ROOF-MOUNTED WEATHE BACK-BOX WITH DIE-CAST, WEATHERPROOF II
₩	EITHER AT THE RECEPTACLE OR FROM THE CIR
DOD.	GREATER THAN 200', UTILIZE GFCI RECEPTACL
	RECEPTACLE CONTROL RELAY TELEPHONE OUTLET - MOUNT 18" AFF U.O.N.,
▼ ▼	DATA OUTLET - MOUNT 18" AFF U.O.N., 4" SQ.
	TELECOM OUTLET(DATA/TELEPHONE) - MOUNT
▼	PROVIDE PULLSTRING.
	FLOOR/CEILING-MOUNTED TELECOM OUTLET.
	CABLE TELEVISION OUTLET - MOUNT 18" AFF L TTB (TELEPHONE TERMINAL BOARD) MARINE P
TTB	4" CONDUITS TO PROPERTY LINE. COORDINAT
J	BAR WITH INSULATED STAND-OFFS. JUNCTION BOX(4"X4"X2"), MOUNT 18" AFF U.C
LC	LIGHTING CONTROLLER
TC	TIMECLOCK WITH INTEGRAL MANUAL OVERRID
PTD	POWER TRANSFER DEVICE/RELAY.
	STEM AND SWIVEL MOUNT PHOTOCELL USE IN ELECTRICAL PANELBOARD (SURFACE OR FLUSH
	ENCLOSED CIRCUIT BREAKER. PROVIDE WEAT
5	HP RATED SWITCH AS DISC. PROVIDE WEATHE
函	HP RATED COMBINATION MOTOR STARTER DIS
	HP RATED MOTOR STARTER. PROVIDE WP ENC
	TRANSFORMER
	HOMERUN TO PANEL NOTED (DASHED LINE INI SWITCHLEG (SOLID LINE) INDICATING A GROU
	LOW-VOLTAGE (DOUBLE-DASHED LINE)
AFF/AFG	ABOVE FINISHED FLOOR / ABOVE FINISHED G
AHJ	AUTHORITY HAVING JURISDICTION
AHU	AIR HANDLING UNIT
CU	
EF	
GFI	GROUND FAULT INTERRUPTER EXISTING TO REMAIN.
EIR	ELECTRIC WATER COOLER
EWH	ELECTRIC WATER HEATER
LC	LOCKING COVER
NIC	NOT IN CONTRACT
NL	
TR	
UON	UNLESS OTHERWISE NOTED
441	SINGLE/MULTI-STATION, NON-SYSTEM TYPE, F
SS ®	BATTERY BACKUP. ACTIVATION SHALL SOUND UNIT. MAINTAIN A MINIMUM DISTANCE OF 3'-0
<b>*</b>	PADDLE FAN BLADES, AND 10'-0" FROM ALL W.
	EMERGENCY GENERATOR SHUTOFF PUSH-BUTT EXIT SIGN - FACES AS REQUIRED - WITH BATT
	EXIT SIGN - FACES AS REQUIRED - WITH BATT EXIT SIGN W/DIRECTION ARROW - FACES AS F
364.	EMERGENCY LIGHT FIXTURE WITH BATTERY BA
EM	LIGHTING CONTROL PANEL THAT CONTROLS T
EM	
	EMERGENCY LIGHT REMOTE HEAD.
	EMERGENCY LIGHT REMOTE HEAD. "X"= HP" Y"= PHASE
	"X"= HP" Y"= PHASE
<b>Δ</b> (x) _Y <u>NOTES:</u> 1. ELEC	
NOTES: 1. ELECT ROUG 2. ALL R	"X"= HP" Y"= PHASE


					1				
				ation# CA31201 Fire Protection	TH SCALE BEFORE IOB E WITH E WITHOUT	NED IN	ET	-237 	7
	ELECTRICAL LEGEND			EGTIO h# CA3 Prot	EDING WITH C. DO NOT S EPANCIES BI DUE TO JO CORDANCE OR WHOLE	AS DETERMINED IN	I STREE	FL 34 2.008 2.020	600085
L	DESCRIPTION SINGLE POLE SWITCH, MOUNT 48" AFF U.O.N.			Authorization# bing Fire P	ORE PROCE M ENGINEEI ANY DISCRI S REQUIREC OUT IN AC 16.	I SPECIFICA FANDARDS ,	MAIN	SOTA, 41.95	A A 2 6 1
Ļ	THREE-WAY/FOUR-WAY SWITCH RESPECTIVELY, MOUNT 48" AFF U.O.N.		R	Autho <b>bing</b>	ITIONS BEF ATION FRO GINEER OF CHANGES A: DT CARRIEC OR COPI VRIGHT 20	PLANS AND E SAFETY ST LOCAL OPD	2168 M	SARAS T9 F9	Ц Ч
	MOTOR-RATED SWITCH, SINGLE/DOUBLE POLE AS INDICATED ON PLANS SLIDE DIMMER W/PRESET ON/OFF SWITCH, MATCH DIMMER RATING WITH ASSOCIATED LOAD, MOUNT 48" AFF U.O.N.		<u> </u>	Cert. of Autho <b>Plumbing</b>	TIELD COND CT INFORM NOTIFY EN TO MAKE C TO MAKE C TO MAKE C TO MAKE C TO MAKE C TO MAKE C	EUGE, SAID PI NIMUM FIRE S TUTES AND L			
	SPRINGWOUND TIMER SWITCH, INTERMATIC "F"-SERIES, MOUNT 48" AFF U.O.N.		p, In		DNS, AND F BTAIN EXA RAWINGS. THE RIGHT THE RIGHT CONSTR DESIGN GR	S KNOWLE ICABLE MIN OPLDA STAT			
3	WALL SWITCH OCCUPANCY SENSOR (DUAL), LEGRAND "RW3U600" (24'W X 25'L), MOUNT 48" AFF U.O.N. WALL SWITCH OCCUPANCY SENSOR 3-WAY (DUAL), LEGRAND "RW3U600" (24'W X 25'L), MOUNT 48" AFF U.O.N.		<b>Group</b> , d.	m Electrica	, DIMENSIC Y BATED D Y DATED D RESERVES ONSIBLE FI ONSIBLE FI OM QUEST	D THE APPL			
4	WALL SWITCH OCCUPANCY SENSOR 4-WAY (DUAL), LEGRAND "RW3U600" (24'W X 25'L), MOUNT 48" AFF U.O.N.		Design ( rthgate Blv , Fl 34234	g.com	LL DETAILS OT CLEARL' ST RECENTL ENGINEER S NOT RESP S NOT RESP TS. THESE IISSION FR	CODES OK CODES AN EPS 553 A		RK	
3	WALL SWITCH VACANCY SENSOR (DUAL), LEGRAND "RW3U600" (24'W X 25'L), MOUNT 48" AFF U.O.N. WALL SWITCH VACANCY SENSOR 3-WAY (DUAL), LEGRAND "RW3U600" (24'W X 25'L), MOUNT 48" AFF U.O.N.		t Des orthga a, FI 3,	.9996 uestd anical	R TO VERIFY A ION. WHERE N USE ONLY MOS 3 WITH WORK. 5. ENGINEER IS 10N DOCUMEN WRITTEN PERN	E BUILDING		<b>PA</b>	
4	WALL SWITCH VACANCY SENSOR 4-WAY (DUAL), LEGRAND "RW3U600" (24'W X 25'L), MOUNT 48" AFF U.O.N.		Quest Design GI 1859 Northgate Blvd. Sarasota, Fl 34234	941.351.9996 www.questdg.com Mechanical El	CONTRACTOR T CONSTRUCTION DRAWINGS. USI PROCEEDING W CONDITIONS. E CONSTRUCTION EXPRESSED WR	IO THE BEST OF THE APPLICABLE ACCORDANCE W		<u> </u>	
	WALL SWITCH DIMMING VACANCY SENSOR (DUAL), LEGRAND "DW-311", MOUNT 48" AFF U.O.N. CEILING MOUNT OCCUPANCY SENSOR (120-277V), LEGRAND "DT-355" (360 DEG 25'W), MOUNT 8' AFF U.O.N.				CON CON CON CON CON CON	HT HT		5	
	KEY SWITCH, MOUNT 48" AFF U.O.N.								
	COMBINATION FAN SPEED CONTROL & FAN LIGHT SWITCH, MOUNT 48" U.O.N. SIMPLEX RECEPTACLE, MOUNT 18'' AFF U.O.N.							SW	
	DUPLEX RECEPTACLE, MOUNT 18" AFF U.O.N.								
	DUPLEX RECEPTACLE, MOUNT 42" AFF (48" AFF IN TOILETS/UTILITY CLOSETS) U.O.N. SWITCHED SPLIT-WIRE DUPLEX RECEPTACLE, MOUNT 18" AFF U.O.N.								
	FLOOR MOUNTED DUPLEX RECEPTACLE. REFER TO PLANS FOR SIZE & CONFIGURATION. FLOOR MOUNTED SWITCHED SPLIT-WIRE DUPLEX RECEPTACLE. REFER TO PLANS FOR SIZE & CONFIGURATION.								
	QUADRAPLEX RECEPTACLE, MOUNT 18" AFF U.O.N.								
	QUADRAPLEX RECEPTACLE, MOUNT 42" AFF U.O.N. SWITCHED SPLIT-WIRE QUADRAPLEX RECEPTACLE, MOUNT 18" AFF U.O.N.								
	FLOOR MOUNTED QUADRAPLEX RECEPTACLE. REFER TO PLANS FOR SIZE & CONFIGURATION.								
	FLOOR MOUNTED SWITCHED SPLIT-WIRE QUADRAPLEX RECEPTACLE. REFER TO PLANS FOR SIZE & CONFIGURATION. 1Ø, 208/240-VOLT RECEPTACLE, MOUNT 18" AFF U.O.N.								
	SPECIAL PURPOSE RECEPTACLE, MOUNT 18" AFF U.O.N.								
	BUILDING EXTERIOR/ROOF-MOUNTED WEATHER-RESISTANT DUPLEX RECEPTACLE, MOUNT 18" AFF U.O.N. DEVICE SHALL INCLUDE WEATHERPROOF BACK-BOX WITH DIE-CAST, WEATHERPROOF IN-USE LOCKING COVER - INTERMATIC WP3110MXD. RECEPTACLE SHALL BE G.F.I. PROTECTED								
	EITHER AT THE RECEPTACLE OR FROM THE CIRCUIT BREAKER IN THE PANELBOARD SERVING CKT. IF TOTAL BRANCH CIRCUIT ONE-WAY LENGTH IS GREATER THAN 200', UTILIZE GFCI RECEPTACLES IN PLACE OF GFCI BREAKER (PER MANUFACTURER RECOMMENDATIONS).								
	RECEPTACLE CONTROL RELAY						T		<u> </u>
	TELEPHONE OUTLET - MOUNT 18" AFF U.O.N., 4" SQ. J-BOX w/1-GANG PLASTER RING, 1"C TO ACCESSIBLE CEILING. PROVIDE PULLSTRING. DATA OUTLET - MOUNT 18" AFF U.O.N., 4" SQ. J-BOX w/1-GANG PLASTER RING, 1"C TO ACCESSIBLE CEILING. PROVIDE PULLSTRING.								
	TELECOM OUTLET(DATA/TELEPHONE) - MOUNT 18" AFF U.O.N., 4" SQ. J-BOX w/1-GANG PLASTER RING, 1"C TO ACCESSIBLE CEILING. PROVIDE PULLSTRING.								
)	FLOOR/CEILING-MOUNTED TELECOM OUTLET. REFER TO PLANS FOR BOX TYPE, CONDUIT SIZE/QUANTITY & CONFIGURATION.								
	CABLE TELEVISION OUTLET - MOUNT 18" AFF U.O.N., 4" SQ. J-BOX w/1-GANG PLASTER RING, 1"C TO ACCESS. CLG. PROVIDE PULLSTRING. TTB (TELEPHONE TERMINAL BOARD) MARINE PLYWOOD BACKBOARD 3/4"x4'x4' PAINTED W/FIRE RETARDANT GRAY PAINT. PROVIDE (2)								
<u>TB</u>	4" CONDUITS TO PROPERTY LINE. COORDINATE FINAL CONDUIT SIZES AND LOCATIONS W/UTILITY. PROVIDE SOLID COPPER GROUND BAR WITH INSULATED STAND-OFFS.								
	JUNCTION BOX(4"X4"X2"), MOUNT 18" AFF U.O.N.								
	LIGHTING CONTROLLER TIMECLOCK WITH INTEGRAL MANUAL OVERRIDE USE INTERMATIC ET90000 SERIES OR EQUAL.								
	POWER TRANSFER DEVICE/RELAY.								
	STEM AND SWIVEL MOUNT PHOTOCELL USE INTERMATIC SERIES K4221C FOR 120V AND K4223C FOR 277V OR EQUAL. ELECTRICAL PANELBOARD (SURFACE OR FLUSH-MOUNTED AS SHOWN). REFER TO SCHEDULES/RISER FOR INFO.						Ε	91	
	ENCLOSED CIRCUIT BREAKER. PROVIDE WEATHERPROOF ENCLOSURE FOR EXTERIOR APPLICATIONS. VERIFY SIZE W/EQUIP. NAMEPLATE RATING. HP RATED SWITCH AS DISC. PROVIDE WEATHERPROOF ENCLOSURE FOR EXTERIOR APPLICATIONS. VERIFY SIZE W/EQUIP. NAMEPLATE RATING.							NO	
	HP RATED COMBINATION MOTOR STARTER DISC. PROVIDE WP ENCLOSURE FOR EXT. APPS. VERIFY SIZE W/EQUIP. NAMEPLATE RATING.						ONGB0/	SCUE STATION OF MEXICO DR - KEY, FL 34228	
	HP RATED MOTOR STARTER. PROVIDE WP ENCLOSURE FOR EXT. APPS. VERIFY SIZE W/EQUIP. NAMEPLATE RATING. TRANSFORMER						ONO	CUE S F MEXIG <ey, fl<="" td=""><td>Set</td></ey,>	Set
<b>`</b>	HOMERUN TO PANEL NOTED (DASHED LINE INDICATES CIRCUIT)						I OF I	RESC ULF OF SOAT KE	rmed .20
• 、	SWITCHLEG (SOLID LINE) INDICATING A GROUP OF LIGHTS OPERATED BY A COMMON SWITCH LOW-VOLTAGE (DOUBLE-DASHED LINE)						TOWN	FIRE RES 5490 GULF O LONGBOAT I	5 July
 G	ABOVE FINISHED FLOOR / ABOVE FINISHED GRADE AUTHORITY HAVING JURISDICTION						F	щų	Col 05.
	AUTHORITY HAVING JURISDICTION AIR HANDLING UNIT						PROJECT	Ш	SUED R:
	CONDENSING UNIT EXHAUST FAN						PR 1		ISSUE FOR:
	GROUND FAULT INTERRUPTER						<u> </u>		
	EXISTING TO REMAIN. ELECTRIC WATER COOLER						<u> </u>		
	ELECTRIC WATER HEATER						<u> </u>		
	LOCKING COVER NOT IN CONTRACT						+		
	NIGHT LIGHT						+		
	TAMPER RESISTANT UNLESS OTHERWISE NOTED						+		
	WEATHER PROOF SINGLE/MULTI-STATION, NON-SYSTEM TYPE, RESIDENTIAL STYLE, LINE-POWERED, COMBINATION CARBON MONOXIDE/SMOKE DETECTOR WITH					RE/	/	SCRIPTION	DATE
S	SINGLE/MULTI-STATION, NON-SYSTEM TYPE, RESIDENTIAL STYLE, LINE-POWERED, COMBINATION CARBON MONOXIDE/SMOKE DETECTOR WITH BATTERY BACKUP. ACTIVATION SHALL SOUND ALL DEVICES WITHIN EACH UNIT. CONNECT TO NEAREST ARC-FAULT PROTECTED CIRCUIT WITHIN UNIT. MAINTAIN A MINIMUM DISTANCE OF 3'-0" FROM ALL CEILING-MOUNTED HVAC SUPPLY/RETURN REGISTERS, 3'-0" FROM THE OUTER EDGE OF							SCALE:	DATE
	PADDLE FAN BLADES, AND 10'-0" FROM ALL WALL-MOUNTED HVAC SUPPLY/RETURN REGISTERS. EMERGENCY GENERATOR SHUTOFF PUSH-BUTTON								
	EXIT SIGN - FACES AS REQUIRED - WITH BATTERY BACKUP					SCA			1/8" = 1'-0"
	EXIT SIGN W/DIRECTION ARROW - FACES AS REQUIRED - WITH BATTERY BACKUP EMERGENCY LIGHT FIXTURE WITH BATTERY BACKUP (CONNECT TO LINE SIDE OF NEAREST SWITCH SERVING THAT AREA OR ON THE LINE SIDE OF						OJECT	MANAGER:	CRB JDS
	LIGHTING CONTROL PANEL THAT CONTROLS THE LIGHTING CIRCUIT IN THAT AREA).							CORD:	JDS
	EMERGENCY LIGHT REMOTE HEAD. "X"= HP" Y"= PHASE								19-522
y S:									OTES
ROUG	RICAL CONTRACTOR SHALL VERIFY EXACT LOCATIONS & MOUNTING HEIGHTS OF ALL ELECTRICAL DEVICES WITH OWNER/ARCHITECT BEFORE H-IN. MOUNTING HEIGHTS ARE MEASURED TO CENTER OF BOX.							ID LEGEN	
ALL SY	CEPTACLES & SWITCHES SHALL BE ARCH/DECORA TYPE WITH MATCHING FACE PLATES. COOR. FINAL COLOR WITH ARCH. PRIOR TO ORDERING MBOLS AND ABBREVIATIONS DO NOT NECESSARILY APPEAR ON THIS PROJECT. FACTURERS SHOWN IN THIS LEGEND ARE "BASIS OF DESIGN" AND "OR EQUAL" DEVICES MAY BE SUBMITTED FOR APPROVAL.								
	ASTONENS SHOWN IN THIS LEGEND AND DASIS OF DESIGN AND ON EQUAL DEVICES MAT DE SUDMITTED FUR APPROVAL.	ĺ				SHE	ET No	).:	

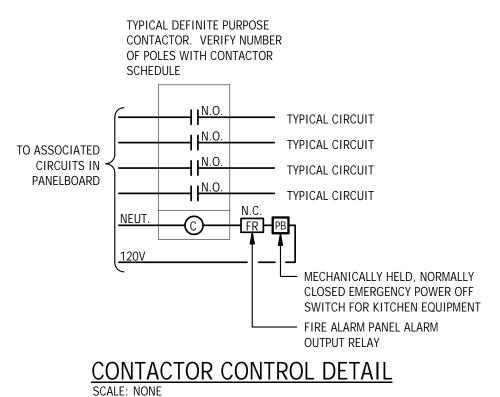


"(	"C1" CONTACTOR CONTROL SCHEDULE											
POLE DESIGNATION	AREAS CONTROLLED	CONTROL TYPE	CIRCUIT BREAKERS									
#1	RANGE POWER AND GAS SOLENOID VALVE	F/A RELAY/POWER OFF SWITCH	B-33									
#2	OVEN	F/A RELAY/POWER OFF SWITCH	DP-26,28									
#3	MICROWAVE	F/A RELAY/POWER OFF SWITCH	B-31									
#4	KITCHEN COUNTER RECEPTACLE	F/A RELAY/POWER OFF SWITCH	B-9									
#5	KITCHEN COUNTER RECEPTACLE	F/A RELAY/POWER OFF SWITCH	B-11									
#6	DISPOSAL	F/A RELAY/POWER OFF SWITCH	B-17									
#7	SPACE											
#8	SPACE											

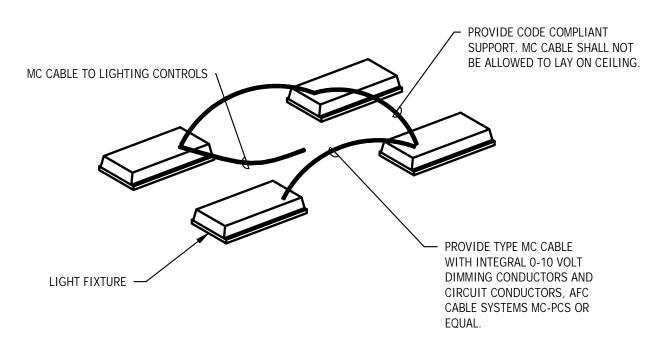

#### TYPICAL RECESSED LIGHTING FIXTURE WIRING TAP DETAIL SCALE: NONE

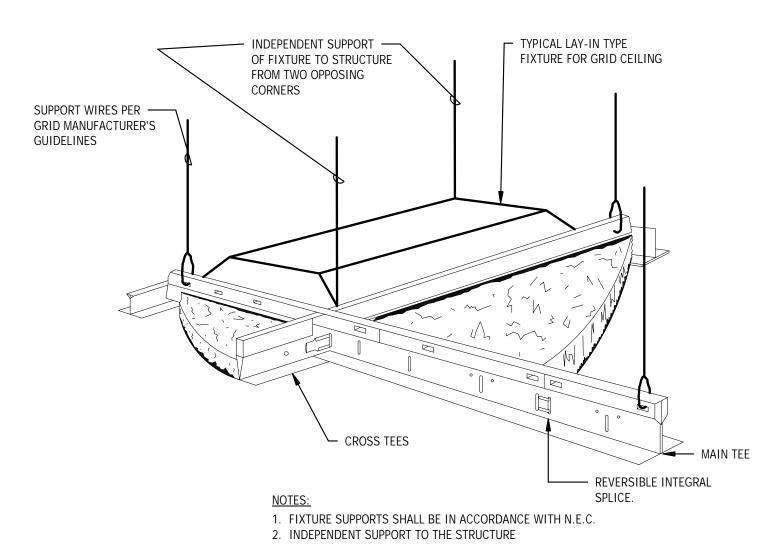

LUMINAIRE MOUNTING - ACOUSTICAL TILE CEILING SCALE: NONE

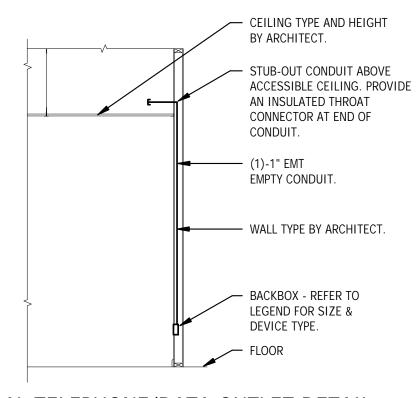


TYPICAL TELEPHONE/DATA OUTLET DETAIL SCALE: NONE

		(1)(2) L
LTR	MANUFACTURER	CATALOG NUMBER
А	LITHONIA	2GTL 4 48L GZ10 LP840
В	JUNO	LDN6 40/15 LO6AR LSS MVOLT
С	LITHONIA	ZL1N L48 5000LM FST MVOLT 80CRI WH
D8	LITHONIA	GRD LLP 8FT MSL8 80CRI 4 ID1000LMF 80/20 MIN10 ZT 12 F2/24A C110
D20	LITHONIA	GRD LLP 20FT MSL8 80CRI 4 ID1000LMF 80/20 MIN10 ZT 12 F2/24A C110
S	LEVITON	STPE-3000K-FO

(1) SUBSTITUTIONS WILL NOT BE PERMITTED WITHOUT APPROVAL FROM THE ENGINEER, FOURTEEN (14) DAYS PRIOR TO BID DATE. ② VERIFY LIGHTING FIXTURE COLOR/FINISH WITH ARCHITECT PRIOR TO ORDERING.


OTHER APPROVED MEANS.


TYPICAL.

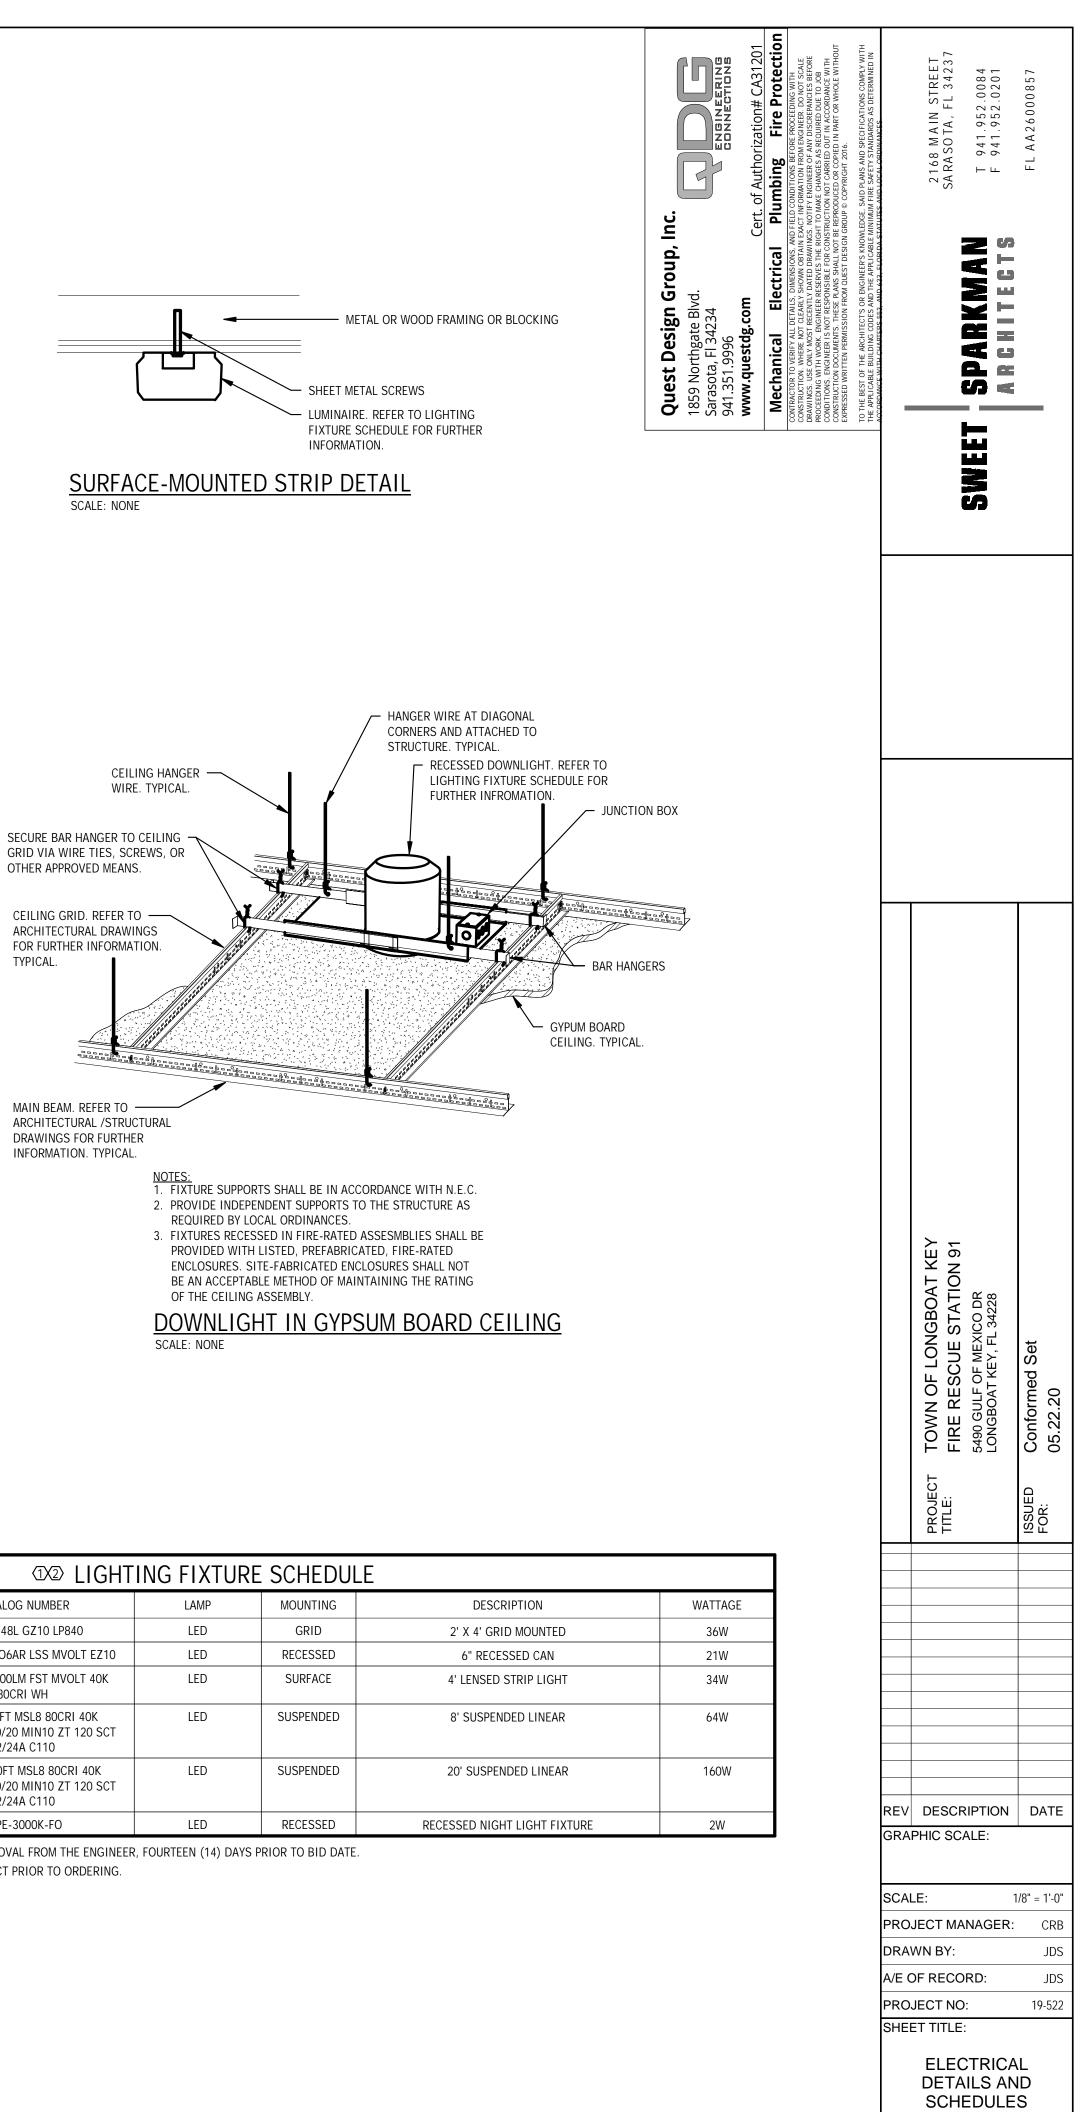

SHEET No.:

E2.1

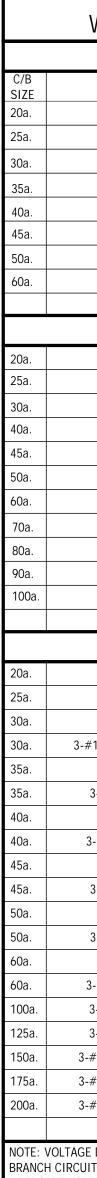

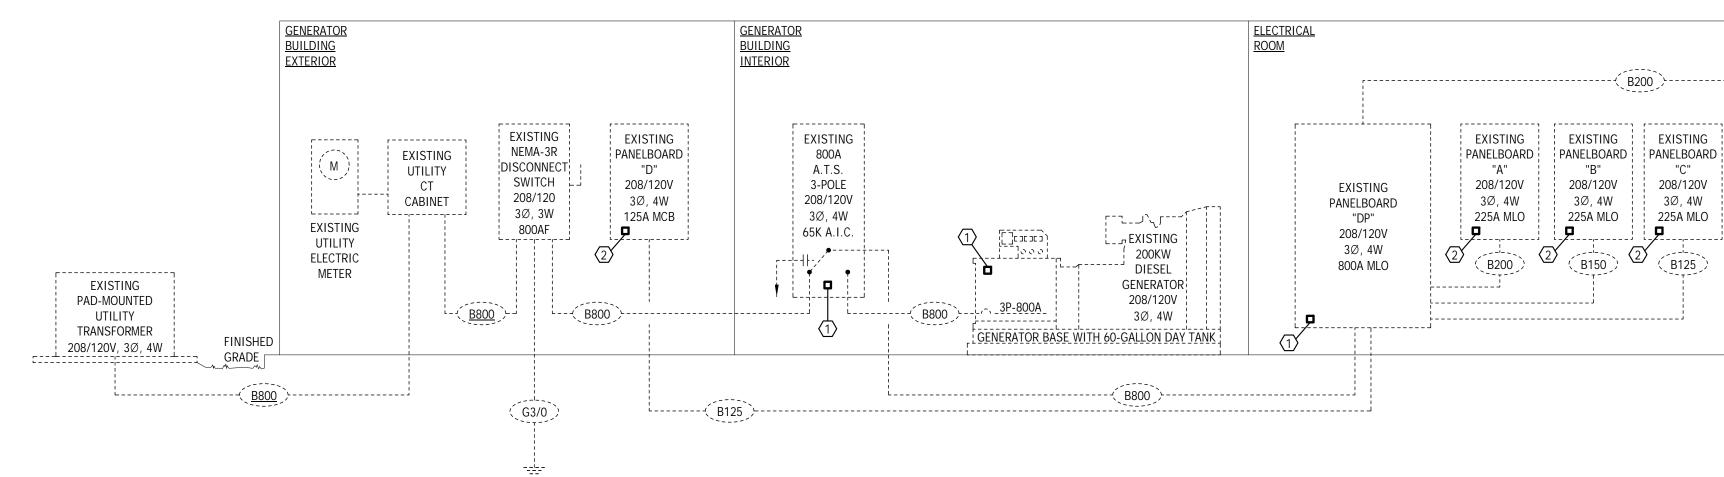

#### BRANCH CIRCUIT WIRING SCHEDULE SINGLE POLE (1P) CONDUIT REMARKS WIRE 2-#12, 1-#12G. 3/4" 1Ø,2W 2-#10, 1-#10G. 3/4" 1Ø,2W 3/4" 1Ø,2W 2-#10, 1-#10G. 3/4" 1Ø,2W 2-#8, 1-#10G. 3/4" 1Ø,2W 2-#8, 1-#10G. 3/4" 1Ø,2W 2-#8, 1-#10G. 3/4" 1Ø,2W 2-#8, 1-#10G. 3/4" 1Ø,2W 2-#6, 1-#10G. TWO POLE (2P) 2-#12, 1-#12G. 3/4" 1Ø,2W 2-#10, 1-#10G. 3/4" 1Ø,2W 2-#10, 1-#10G. 3/4" 1Ø,2W 2-#8, 1-#10G. 1" 1Ø,2W 2-#8, 1-#10G. 1" 1Ø,2W 1" 1Ø,2W 2-#8, 1-#10G. 2-#6, 1-#10G. 1Ø,2W 1" 1 1/4" 1Ø,2W 2-#4, 1-#8G. 1Ø,2W 1 1/4" 2-#4, 1-#8G. 1 1/4" | 1Ø,2W 2-#3, 1-#8G. 1 1/4" 1Ø,2W 2-#3, 1-#8G. THREE POLE (3P) 3-#12, 1-#12G. 3/4" 3Ø, 3W 3/4" 3Ø, 3W 3-#10, 1-#10G. 3/4" 3Ø, 3W 3-#10, 1-#10G. 3/4" 3Ø, 4W 3-#10, 1-#10N, 1-#10G. 3-#8, 1-#10G. 1" 3Ø, 3W 3-#8, 1-#8, 1-#10G. 1" 3Ø, 4W 1" 3Ø, 3W 3-#8, 1-#10G. 1" 3Ø, 4W 3-#8, 1-#8N, 1-#10G. 1" 3Ø, 3W 3-#8, 1-#10G. 1" 3Ø, 4W 3-#8, 1-#8N, 1-10G. 3-#8, 1-#10G. 1" 3Ø, 3W 1" 3Ø, 4W 3-#8, 1-#8N, 1-10G. 1" 3Ø, 3W 3-#6, 1-#10G. 1 1/4" 3Ø, 4W 3-#6, 1-#6N, 1-#10G. 1 1/2" 3Ø, 4W 3-#3, 1-#3N, 1-#8G. 3-#1, 1-#1N, 1-#6G. 2" 3Ø, 4W 2" 3Ø, 4W 3-#1/0, 1-#1/0N, 1-#6G. 2' 3Ø, 4W 3-#2/0, 1-#2/0N, 1-#6G. 3-#3/0, 1-#3/0N, 1-#6G. 2 1/2" 3Ø, 4W

NOTE: VOLTAGE DROP: THE CONDUCTORS FOR FEEDERS AND BRANCH CIRCUITS COMBINED SHALL BE SIZED FOR A MAXIMUM OF 5 PERCENT VOLTAGE DROP TOTAL, IN ACCORDANCE WITH THE FBC, SECTION C405.6.3. CALCULATIONS SHALL BE COMPLETED BY THE ELECTRICAL CONTRACTOR BASED ON ACTUAL FIELD INSTALLATIONS AND DISTANCES PRIOR TO ROUGH-IN.

	BRAI	NCH CIF	RCUIT	WIRI	NG SCHEDULE				
	SINGLE POLE (1P	)		THREE POLE (3P)					
C/B SIZE	WIRE	CONDUIT	REMARKS		WIRE	CONDUIT	REMARKS		
20a.	2-#12, 1-#12G.	3/4"	1Ø,2W	20a.	3-#12, 1-#12G.	3/4"	3Ø, 3W		
25a.	2-#10, 1-#10G.	3/4"	1Ø,2W	25a.	3-#10, 1-#10G.	3/4"	3Ø, 3W		
30a.	2-#10, 1-#10G.	3/4"	1Ø,2W	30a.	3-#10, 1-#10G.	3/4"	3Ø, 3W		
35a.	2-#8, 1-#10G.	3/4"	1Ø,2W	30a.	3-#10, 1-#10N, 1-#10G.	3/4"	3Ø, 4W		
40a.	2-#8, 1-#10G.	3/4"	1Ø,2W	35a.	3-#8, 1-#10G.	1"	3Ø, 3W		
45a.	2-#8, 1-#10G.	3/4"	1Ø,2W	35a.	3-#8, 1-#8, 1-#10G.	1"	3Ø, 4W		
50a.	2-#8, 1-#10G.	3/4"	1Ø,2W	40a.	3-#8, 1-#10G.	1"	3Ø, 3W		
60a.	2-#6, 1-#10G.	3/4"	1Ø,2W	40a.	3-#8, 1-#8N, 1-#10G.	1"	3Ø, 4W		
				45a.	3-#8, 1-#10G.	1"	3Ø, 3W		
	TWO POLE (2P)			45a.	3-#8, 1-#8N, 1-10G.	1"	3Ø, 4W		
20a.	2-#12, 1-#12G.	3/4"	1Ø,2W	50a.	3-#8, 1-#10G.	1"	3Ø, 3W		
25a.	2-#10, 1-#10G.	3/4"	1Ø,2W	50a.	3-#8, 1-#8N, 1-10G.	1"	3Ø, 4W		
30a.	2-#10, 1-#10G.	3/4"	1Ø,2W	60a.	3-#6, 1-#10G.	1"	3Ø, 3W		
40a.	2-#8, 1-#10G.	1"	1Ø,2W	60a.	3-#6, 1-#6N, 1-#10G.	1 1/4"	3Ø, 4W		
45a.	2-#8, 1-#10G.	1"	1Ø,2W	100a.	3-#3, 1-#3N, 1-#8G.	1 1/2"	3Ø, 4W		
50a.	2-#8, 1-#10G.	1"	1Ø,2W	125a.	3-#1, 1-#1N, 1-#6G.	2"	3Ø, 4W		
60a.	2-#6, 1-#10G.	1"	1Ø,2W	150a.	3-#1/0, 1-#1/0N, 1-#6G.	2"	3Ø, 4W		
70a.	2-#4, 1-#8G.	1 1/4"	1Ø,2W	175a.	3-#2/0, 1-#2/0N, 1-#6G.	2'	3Ø, 4W		
80a.	2-#4, 1-#8G.	1 1/4"	1Ø,2W	200a.	3-#3/0, 1-#3/0N, 1-#6G.	2 1/2"	3Ø, 4W		
90a.	2-#3, 1-#8G.	1 1/4"	1Ø,2W	1	VOLTAGE DROP: THE CONDUCTORS				
100a.	2-#3, 1-#8G.	1 1/4"	1Ø,2W	5 PERC SECTIO ELECTR	H CIRCUITS COMBINED SHALL BE SI ENT VOLTAGE DROP TOTAL, IN ACCO IN C405.6.3. CALCULATIONS SHALL I RICAL CONTRACTOR BASED ON ACTU LATIONS AND DISTANCES PRIOR TO	ORDANCE WITH BE COMPLETED AL FIELD	I THE FBC,		

3/4" X 10'-0" GROUND ROD EXISTING ELECTRICAL RISER DIAGRAM

ALL ELECTRICAL DISTRIBUTION EQUIPMENT IS EXISTING TO REMAIN

1859 Northgate Blvd. Sarasota, Fl 34234 941.351.9996 www.questdg.com Cert. of Authorization# CA31201 Mechanical Electrical Plumbing Fire Protection Contractor to VERTY ALL DETAILS, DIMENSIONS, AND FIELD CONDITIONS BEFORE PROJECTION CONTRACTOR TO VERTY ALL DETAILS, DIMENSIONS, AND FIELD CONDITIONS BEFORE PROJECTION CONTRACTOR WHER NOT CEARLY SHOW DBTAIL PLANDING FIRE Protection CONTRACTOR WHER NOT CEARLY SHOW DBTAIL PLANDING FIRE PROJECTION DO NOT SALE RAWINGS, USE ONLY MORE CHARGES IN OFFICE TO MORE CHARGES IN CONDITIONS. IN THE KIGNIERD. ON ON T CARLE CONDITIONS. INCLUSIONS, AND FIELD CONDITIONS BEFORE RAWINGS, USE ONLY MORE RECEIVED TO MARE CHARGES BEFORE CONDITIONS. INCLUSIONS, AND FIELD CONDITIONS BEFORE CONDITIONS. THESE REPRODUCED OR COPIED IN PART OR WHOLE WITHUT CONSTRUCTION DOCUMENT. THESE MARES SHERE FOR CONDITIONS ERFORE CONDITIONS. THESE REPRODUCED OR COPIED IN PART OR WHOLE WITHUT CONSTRUCTION DOCUMENT. THESE MARES SHERE FOR CONDITIONS ENTRED ON IN ACCORDANCE WITH CONSTRUCTION DOCUMENT. THESE MARES SHERE FOR CONSTRUCTION NOT CARRIED ON IN ACCORDANCE WITH CONSTRUCTION DOCUMENT. THESE RAMES SHERE FOR CONSTRUCTION NOT CARRIED ON IN ACCORDANCE WITH CONSTRUCTION DOCUMENT. THESE REPRODUCED OR COPIED IN PART OR WHOLE WITHOUT EXPRESSED WRITTEN PREMISSION FROM OURST DESIGN GROUP O COPIED IN PART OR WHOLE WITHOUT EXPRESSED WRITTEN PREMISSION FROM OURST DESIGN GROUP O COPIED IN PART OR WHOLE WITHOUT EXPRESSED WRITTEN PREMISSION FROM OURST DESIGN GROUP O COPIED IN PART OR WHOLE WITHOUT EXPRESSED WRITTEN PREMISSION FROM OURST DESIGN GROUP O COPIED IN PART OR WHOLE WITHOUT	TO THE BEST OF THE ARCHITECT'S OR ENGINEER'S KNOWLEDGE, SAID PLANS AND SPECIFICATIONS COMPLY WITH THE APPLICABLE BUILDING CODES AND THE APPLICABLE MINIMMM FIRE SAFETY STANDARDS AS DETERMINED IN ACCORDANCE WITH CHARTERS SE2, AND 433, FLORDAN STATUTES AND LOCUL ORDINANCES	ET SPARKMAN BRGHITEGTS FLAA26000857
ROUND L)		SWEET
IN 3"C. 4G. IN 3"C. 4G. IN 3 1/2"C. 43G. IN 3 1/2"C. 43G IN 4"C. 70, #2G. H IN 2 1/2"C.		
250MCM, #2G. H IN 3"C. 250MCM, #1G. H IN 3"C. 200MCM, #1/0G. H IN 3 1/2"C. 200MCM, #1/0G. H IN 4"C. 200MCM, #2/0G. H IN 3 1/2"C. 250MCM, #3/0G. H IN 3 1/2"C.		
00MCM, #4/0G. H IN 3 1/2"C. 00MCM, #250MCM G. H IN 3 1/2"C. 00MCM, #350MCM G. H IN 4"C. 00MCM, #350MCM G. H IN 4"C. 00MCM, #400MCM G. H IN 4"C.		
OG IN 1"C. FOR MOTOR THREE PHASE (Q'D). ED FOR A MAXIMUM GY CONSERVATION, ON ACTUAL FIELD VN-2. ALLOWABLE		TOWN OF LONGBOAT KEY FIRE RESCUE STATION 91 5490 GULF OF MEXICO DR LONGBOAT KEY, FL 34228 LONGBOAT KEY, FL 34228 Conformed Set 05.22.20
		PROJECT T TITLE: TITLE: TITLE: FOR: FOR: FOR:
TECTION "PQM200" (OR TECTION "PQC100" (OR		Image: Constraint of the sector of the se
		REV       DESCRIPTION       DATE         GRAPHIC SCALE:       JB         SCALE:       1/8" = 1'-0"         PROJECT MANAGER:       CRB         DRAWN BY:       JDS         A/E OF RECORD:       JDS         PROJECT NO:       19-522         SHEET TITLE:       ELECTRICAL RISER AND CALCULATIONS

SHEET No .:


E2.2

	COPP	ER CONDL	ICTOR	AND	CONDI	JIT SC	HEDU	LE
O.C.P.D.** AMPERE RATING	SYMBOL*	4 WIRE WITH GR (3P W/ NEUTRAL)			O.C.P.D.** AMPERE RATING	SYMBOL*	-	WITH GROUND NEUTRAL)
20A	B20	4-#12, #12G. IN	V 3/4"C.		225A	B225	4-#4/0	), #4G. IN 3"C.
25A	B25	4-#10, #10G. IN	V 3/4"C.		250A	B250	4-#250	DMCM, #4G. IN 3"C.
30A	B30	4-#10, #10G. IN	V 3/4"C.		300A	B300	4-#350	DMCM, #4G. IN 3 1/2"C.
35A	B35	4-#8, #10G. IN	1"C.		350A	B350	4-#400	DMCM, #3G. IN 3 1/2"C.
40A	B40	4-#8, #10G. IN	1"C.		400A	B400	4-#500	DMCM, #3G IN 4"C.
45A	B45	4-#8, #10G. IN	1"C.		450A	B450	2 SETS	5: 4-#4/0, #2G. EACH IN 2 1/2"C.
50A	B50	4-#8, #10G. IN	1"C.		500A	B500	2 SETS	EACH IN 3"C.
60A	B60	4-#6, #10G. IN	1 1/4"C.		600A	B600	2 SETS	EACH IN 3"C.
70A	B70	4-#4, #8G. IN 1	1/4"C.		700A	B700	2 SETS	EACH IN 3 1/2"C.
80A	B80	4-#4, #8G. IN 1	1/4"C.		800A	B800	2 SETS	<ul> <li>A-#500MCM, #1/0G.</li> <li>EACH IN 4"C.</li> </ul>
90A	B90	4-#3, #8G. IN 1	1/2"C.		1000A	B1000	3 SETS	EACH IN 3 1/2"C.
100A	B100	4-#3, #8G. IN 1	1/2"C.		1200A	B1200	4 SETS	EACH IN 3 1/2"C.
110A	B110	4-#2, #6G. IN 1	1/2"C.		1600A	B1600	5 SETS	EACH IN 3 1/2"C.
125A	B125	4-#1, #6G. IN 2	"C.		2000A	B2000	6 SETS	
150A	B150	4-#1/0, #6G. IN	I 2"C.		2200A	B2200	6 SETS	6: 4-#500MCM, #350MCM G. EACH IN 4"C.
175A	B175	4-#2/0, #6G. IN	I 2 1/2"C.		2500A	B2500	7 SETS	6: 4-#500MCM, #350MCM G. EACH IN 4"C.
200A	B200	4-#3/0, #6G. IN	l 2 1/2"C.		3000A	B3000	8 SETS	6: 4-#500MCM, #400MCM G. EACH IN 4"C.
G1/0	1-#1/0 G I	N 1"C.	G2/0	1-#2/0	G IN 1"C.	(	G3/0	1-#3/0 G IN 1"C.
LOAD. ** OVER <u>NOTES:</u> 1. FO CII 2. VO OF	CURRENT PR R SINGLE PH RCUITS, INCI LTAGE DROP 5 PERCENT	OTECTIVE DEVICE IASE CIRCUITS, INC REASE WIRE ONE SI P: THE CONDUCTORS VOLTAGE DROP TOT	REASE WIRE ZE FOR EACI S FOR FEEDE AL, IN ACCC	ONE SIZE H 200' OF RS AND B IRDANCE V	E FOR EACH 1 CIRCUIT LEN RANCH CIRC VITH THE FLO	100' OF CIRC IGTH. (ADJU UITS COMBI DRIDA BUILL	UIT LENGT ST CONDU NED SHALI DING CODE	NEUTRAL FOR MOTOR TH. FOR THREE PHASE IT AS REQ'D). BE SIZED FOR A MAXIMUM - ENERGY CONSERVATION, R BASED ON ACTUAL FIELD
INS 3. AL	STALLATIONS	S AND DISTANCES P	RIOR TO RO	UGH-IN. RS TO BE	90° C CONDI			OR THWN-2. ALLOWABLE
4. AL		ORS SHALL BE COPPI	ER WITH TYP	e thhn in	ISULATION U	INLESS OTH	ERWISE NC	)TED

U

Ď St

ð

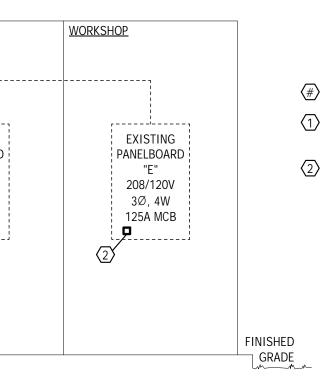


(#) KEYED NOTES - ELECTRICAL RISER DIAGRAM:

1 PROVIDE NEW SURGE PROTECTIVE DEVICE: PQ PROTEC APPROVED EQUAL)

PROVIDE NEW SURGE PROTECTIVE DEVICE: PQ PROTEC APPROVED EQUAL)

	Panelboard: DP												Pane
	Location: MECH. 113 Supply From: Mounting: SURFACE					Volts: 120/208 Phases: 3 Wires: 4	Wye				A.I.C. Rating: 65000 Mains Type: MLO Mains Rating: 800 A		
	Enclosure: NEMA 1					Wiies. 4					MCB Rating: N/A		
Not	es:												Notes:
<b>СКТ</b> 1	Load Name WATER HEATER	Trip 50 A	Pole 3	5.00	<b>A</b>	В		C	Pole 2	Trip 50 A	Load Name SPARE	СКТ 2	CKT L 1 PARKING LOT EA
3 5						5.00 0.00	5.00	0.00			 SPACE	4	3 5 PARKING LOT WE
7 9	AHU-3 	40 A 	2	3.33	4.33	3.33 4.33			2	60 A 	AHU-1 	8 10	7 9 LTGDAYROOM
11 13	AHU-2 	40 A 	2	3.33	1.00		3.33	1.00	2	35 A 	TRAFFIC SIGNAL POWER	12 14	11 LTGDAYROOM 13 LTGCORR./QUAF
15 17	SPARE 	25 A 	2			0.00 2.20	0.00	2.20	2	30 A 	CLOTHES DRYER 	16 18	15 LTGLOCKER/LAU 17 LTGFITNESS/ST
19 21	OVEN 	25 A 	2	1.50	1.35	1.50 1.35			2	20 A 	COMMERCIAL WASHER	20 22	19 LTGTRAINING/AI 21 INC LTGTRNG/AI
23 25	SPACE			0.00	4.00		0.00	0.00	 2	 50 A	SPACE OVEN	24 26	23 SPARE 25 SPARE
27 29	" PANEL A	 200 A				0.00 4.00	14.60	10.15	 3	 200 A	 PANEL E	28 30	27 AIR COMPRESSO 29
31 33				12.03	8.77	14.89 10.55	14.00	10.13				32 34	31 33 SPACE
35	PANEL B	 150 A	3	7.04	0.70	14.69 10.55	9.77	10.40	3	125 A	PANEL D	36	35 "
37 39				7.21	9.73	11.14 7.63					 	38 40	37     "       39     "
43	PANEL C	125 A 	3	7.30	0.00		6.96	0.00	3	30 A 	SURGE PROTECTIVE DEVICE	42	41 "
45			 I Load:		3.87	5.58 0.00 71.49		8.41	 kVA			46	Legend:
Lea	end:	Total	Amps:	580	0.92	602.74	528	8.45	AMPS				
													Load Classification
<b>Loa</b> HVA	d Classification	С	onnect 4958	ed Load	De	emand Factor 100.00%		t <b>ed Dema</b> 588 VA	nd		Panel Totals		Lighting Motor
Ligh Mote	ling		2047	3 VA		125.00% 100.00%	25	591 VA 137 VA			Total Conn. Load: 203.77 kVA Total Est. Demand: 183.64 kVA		Power
Pow	er		5283	1 VA		100.00%	52	831 VA 248 VA			Total Conn.:         565.62 A           Total Est. Demand:         509.75 A		
	eptacle puter		6049 250			58.27% 100.00%		248 VA 50 VA					Notes:
	95:										I		
													Pane
	Panelboard: C Location: MECH. 113 Supply From: DP Mounting: SURFACE Enclosure: NEMA 1					Volts: 120/208 Phases: 3 Wires: 4	Wye			r	A.I.C. Rating: 22000 Mains Type: MLO Mains Rating: 225 A MCB Rating: N/A		
Not	Panelboard: C Location: MECH. 113 Supply From: DP Mounting: SURFACE Enclosure: NEMA 1					Phases: 3	Wye			r	Mains Type: MLO Mains Rating: 225 A		
Not	Panelboard: C Location: MECH. 113 Supply From: DP Mounting: SURFACE Enclosure: NEMA 1					Phases: 3	Wye			r	Mains Type: MLO Mains Rating: 225 A		Notes:
	Panelboard: C Location: MECH. 113 Supply From: DP Mounting: SURFACE Enclosure: NEMA 1	<b>Trip</b> 20 A	<b>Pole</b> 1	0.72	A 0.72	Phases: 3		C	Pole 1	Trip	Mains Type: MLO Mains Rating: 225 A		Notes: CKT L 1 HP-1 3
СКТ 1 3	Panelboard: C Location: MECH. 113 Supply From: DP Mounting: SURFACE Enclosure: NEMA 1 SS: Load Name IG COMP RECEPS-CHIEFS RECEPS-FIRE CHIEF	20 A 20 A	-			Phases: 3 Wires: 4				<b>Trip</b> 20 A 20 A	Mains Type: MLO Mains Rating: 225 A MCB Rating: N/A Load Name IG COMP RECEPS-TRAINING RECEPS-AUTO SPEC/FM	2 4	Notes: CKT L 1 HP-1 3 5 HP-4 7
<b>CK1</b> 1 3 5 7	Location:       MECH. 113         Supply From:       DP         Mounting:       SURFACE         Enclosure:       NEMA 1         es:       IG COMP RECEPS-CHIEFS         RECEPS-FIRE CHIEF       RECEPS-FIRE CHIEFS         IG COMP RECEPS-OFFICES       IG COMP RECEPS-OFFICES	20 A 20 A 20 A 20 A	1 1 1 1			Phases: 3         Wires: 4		C 0.54	1 1 1 1	<b>Trip</b> 20 A 20 A 20 A 20 A	Mains Type: MLO Mains Rating: 225 A MCB Rating: N/A IG COMP RECEPS-TRAINING RECEPS-AUTO SPEC/FM DAY ROOM UNDERCOUNTER RECEPS-TREATMENT	2 4 6 8	Notes: CKT L 1 HP-1 3 5 HP-4 7 9 HP-5 11
<b>CKT</b> 1 3 5 7 9 11	Location:       MECH. 113         Supply From:       DP         Mounting:       SURFACE         Enclosure:       NEMA 1         ess:       NEMA 1	20 A 20 A 20 A 20 A 20 A 20 A 20 A	1 1 1 1 1 1 1	0.72	0.72	Phases: 3 Wires: 4			1 1 1 1 1 1 1	<b>Trip</b> 20 A 20 A 20 A 20 A 20 A 20 A	Mains Type: MLO Mains Rating: 225 A MCB Rating: N/A IG COMP RECEPS-TRAINING RECEPS-AUTO SPEC/FM DAY ROOM UNDERCOUNTER RECEPS-TREATMENT RECEPS-TREATMENT IG COMP RECEPS-TREAT/SOQ	2 4 6 8 10 12	Notes:           CKT         L           1         HP-1           3            5         HP-4           7            9         HP-5           11            13         SPARE           15         RECEPS-GENERA
<b>CK1</b> 1 3 5 7 9 11 13 15	Location:       MECH. 113         Supply From:       DP         Mounting:       SURFACE         Enclosure:       NEMA 1         es:       NEMA 1         b:       Supply From:         IG COMP RECEPS-CHIEFS       RECEPS-FIRE CHIEF         RECEPS-DEP CHIEFS       IG COMP RECEPS-OFFICES         TELEPHONE BACKBOARD       RECEPS-ADMIN ASST/FM         IG COMP RECEPS-ADMIN ASST       COPIER	20 A 20 A 20 A 20 A 20 A 20 A 20 A 20 A	1 1 1 1 1 1 1 1 1 1 1	0.72	0.72	Phases: 3         Wires: 4	0.90	0.54	1 1 1 1 1 1 1 1 1	<b>Trip</b> 20 A 20 A 20 A 20 A 20 A 20 A 20 A 20 A	Mains Type: MLO Mains Rating: 225 A MCB Rating: N/A IG COMP RECEPS-TRAINING RECEPS-AUTO SPEC/FM DAY ROOM UNDERCOUNTER RECEPS-TREATMENT RECEPS-TREATMENT IG COMP RECEPS-TREAT/SOQ RECEPS-SOQ RECEPS-SOQ RECEPS-TRAINING	2 4 6 8 10 12 14 16	Notes:           CKT         L           1         HP-1           3            5         HP-4           7            9         HP-5           11            13         SPARE           15         RECEPS-GENERA           17         GENERATOR BAT           19         GENERATOR BLO
<b>CK1</b> 1 3 5 7 9 11 13 15 17 19	Location:       MECH. 113         Supply From:       DP         Mounting:       SURFACE         Enclosure:       NEMA 1         es:       IG COMP RECEPS-CHIEFS         RECEPS-FIRE CHIEF       RECEPS-FIRE CHIEFS         IG COMP RECEPS-OFFICES       IG COMP RECEPS-OFFICES         TELEPHONE BACKBOARD       RECEPS-ADMIN ASST/FM         IG COMP RECEPS-ADMIN ASST       COPIER         RECEPS-DAY ROOM       RECEPS-DAY ROOM	20 A 20 A 20 A 20 A 20 A 20 A 20 A 20 A	1 1 1 1 1 1 1 1 1 1 1 1	0.72	0.72	Phases: 3         Wires: 4         Wires: 4         0.90         0.90         0.90         0.90         0.90         0.90         0.90         0.90         0.90         0.90         0.90         0.90         10.90         10.90         1.26         0.90         1.26         0.90	0.90	0.54	1 1 1 1 1 1 1 1 1 1 1	<b>Trip</b> 20 A	Mains Type: MLO Mains Rating: 225 A MCB Rating: N/A IG COMP RECEPS-TRAINING RECEPS-AUTO SPEC/FM DAY ROOM UNDERCOUNTER RECEPS-TREATMENT IG COMP RECEPS-TREAT/SOQ RECEPS-SOQ RECEPS-SOQ RECEPS-DCQ RECEPS-DCQ RECEPS-BUNK ROOMS	2 4 6 8 10 12 14 16 18 20	Notes:           CKT         L           1         HP-1           3            5         HP-4           7            9         HP-5           11            13         SPARE           15         RECEPS-GENERA           17         GENERATOR BAT           19         GENERATOR BLO
3 5 7 9 11 13 15 17 19 21 23	Location:       MECH. 113         Supply From:       DP         Mounting:       SURFACE         Enclosure:       NEMA 1         SS:       IG COMP RECEPS-CHIEFS         RECEPS-FIRE CHIEF       RECEPS-FIRE CHIEFS         IG COMP RECEPS-OFFICES       IG COMP RECEPS-OFFICES         TELEPHONE BACKBOARD       RECEPS-ADMIN ASST/FM         IG COMP RECEPS-ADMIN ASST       COPIER         RECEPS-DAY ROOM       RECEPS-DAY ROOM         PA SYSTEM       IG-ADMIN. ASST. RADIO	20 A 20 A 20 A 20 A 20 A 20 A 20 A 20 A	1 1 1 1 1 1 1 1 1 1 1 1 1 1 1	0.72	0.72	Phases: 3         Wires: 4         Series: 4         0.90         0.90         9         9         9         9         9         9         9         9	0.90	0.54	1 1 1 1 1 1 1 1 1 1 1 1 1	<b>Trip</b> 20 A 20 A 20 A 20 A 20 A 20 A 20 A 20 A	Mains Type:       MLO         Mains Rating:       225 A         MCB Rating:       N/A         MCB Rating:       N/A         IG COMP RECEPS.TRAINING         RECEPS-AUTO SPEC/FM         DAY ROOM UNDERCOUNTER         RECEPS-TREATMENT         IG COMP RECEPS-TREATMENT         IG COMP RECEPS-TREAT/SOQ         RECEPS-SOQ         RECEPS-SOQ         RECEPS-DCQ         RECEPS-BUNK ROOMS         RECEPS-BUNK ROOMS         CHARGERS	2 4 6 8 10 12 14 16 18 20 22 24	Notes:           CKT         L           1         HP-1           3            5         HP-4           7            9         HP-5           11            13         SPARE           15         RECEPS-GENERA           17         GENERATOR BAT           19         GENERATOR BLO           21         OUTBUILDING LIG           23         EXISTING LOAD
<b>CK1</b> 1 3 5 7 9 11 13 15 17 19 21 23 25 27	Location:       MECH. 113         Supply From:       DP         Mounting:       SURFACE         Enclosure:       NEMA 1         String       NEMA 1         String       SURFACE         Enclosure:       NEMA 1         String       SURFACE         IG COMP RECEPS-CHIEFS       SURFACE         IG COMP RECEPS-OFFICES       SURFACE         TELEPHONE BACKBOARD       SURFACE         RECEPS-DAY ROOM       SURFACE         IG-ADMIN ASST. RADIO       SURFACE         IG-ADMIN. ASST. RADIO       SURFACE         SPARE       SURFACE	20 A 20 A 20 A 20 A 20 A 20 A 20 A 20 A	1 1 1 1 1 1 1 1 1 1 1 1 1 1	0.72	0.72	Phases: 3         Wires: 4         Wires: 4         0.90         0.90         0.90         0.90         0.90         0.90         0.90         0.90         0.90         0.90         0.90         0.90         10.90         10.90         1.26         0.90         1.26         0.90	0.90	0.54	1 1 1 1 1 1 1 1 1 1 1 1	<b>Trip</b> 20 A 20 A 20 A 20 A 20 A 20 A 20 A 20 A	Mains Type:       MLO         Mains Rating:       225 A         MCB Rating:       N/A         MCB Rating:       N/A         IG COMP RECEPS.TRAINING         RECEPS-AUTO SPEC/FM         DAY ROOM UNDERCOUNTER         RECEPS-TREATMENT         IG COMP RECEPS-TREATMENT         IG COMP RECEPS-TREAT/SOQ         RECEPS-SOQ         RECEPS-SOQ         RECEPS-BUNK ROOMS         CHARGERS         IG-DAY RM TABLE RADIO         RECEPS-SOQ	2 4 6 8 10 12 14 16 18 20 22 24 24 26 28	Notes: CKT L 1 HP-1 3 5 HP-4 7 9 HP-5 11 13 SPARE 15 RECEPS-GENERA 17 GENERATOR BAT 19 GENERATOR BLO 21 OUTBUILDING LIG 23 EXISTING LOAD 25 BATTERY CHARG
<b>CK1</b> 1 3 5 7 9 11 13 15 17 19 21 23 25 27 29	Location:       MECH. 113         Supply From:       DP         Mounting:       SURFACE         Enclosure:       NEMA 1         String       NEMA 1         String       Supply From:         IG COMP RECEPS-CHIEFS       RECEPS-FIRE CHIEF         RECEPS-FIRE CHIEF       IG COMP RECEPS-OFFICES         IG COMP RECEPS-OFFICES       TELEPHONE BACKBOARD         RECEPS-ADMIN ASST/FM       IG COMP RECEPS-ADMIN ASST         IG COMP RECEPS-ADMIN ASST       COPIER         RECEPS-DAY ROOM       RECEPS-DAY ROOM         PA SYSTEM       IG-ADMIN. ASST. RADIO         IG-ADMIN. ASST. RADIO       FACP	20 A 20 A 20 A 20 A 20 A 20 A 20 A 20 A	1 1 1 1 1 1 1 1 1 1 1 1 1 1 1 1 1	0.72	0.72	Phases: 3         Wires: 4         Wires: 4         0.90         0.90         9.90         9.90         9.90         9.90         9.90         9.90         9.90	0.90	0.54	1 1 1 1 1 1 1 1 1 1 1 1 1 1 1	<b>Trip</b> 20 A 20 A 20 A 20 A 20 A 20 A 20 A 20 A	Mains Type:       MLO         Mains Rating:       225 A         MCB Rating:       N/A         MCB Rating:       N/A         IG COMP RECEPS.TRAINING         RECEPS-AUTO SPEC/FM         DAY ROOM UNDERCOUNTER         RECEPS-TREATMENT         IG COMP RECEPS-TREATMENT         IG COMP RECEPS-TREATMENT         IG COMP RECEPS-TREAT/SOQ         RECEPS-SOQ         RECEPS-SOQ         RECEPS-DCQ         RECEPS-BUNK ROOMS         CHARGERS         IG-DAY RM TABLE RADIO	2 4 6 8 10 12 14 16 18 20 22 24 24 26	Notes: CKT L 1 HP-1 3 5 HP-4 7 9 HP-5 11 13 SPARE 15 RECEPS-GENERA 17 GENERATOR BAT 19 GENERATOR BLO 21 OUTBUILDING LIG 23 EXISTING LOAD 25 BATTERY CHARG 27 CU-6/AHU-6 29
<b>CK1</b> 1 3 5 7 9 11 13 15 17 19 21 23 25 27 29 31 33	Location:       MECH. 113         Supply From:       DP         Mounting:       SURFACE         Enclosure:       NEMA 1         String       NEMA 1         String       SURFACE         Enclosure:       NEMA 1         String       SURFACE         IG COMP RECEPS-CHIEFS       SURFACE         IG COMP RECEPS-OFFICES       SURFACE         TELEPHONE BACKBOARD       SURFACE         RECEPS-DAY ROOM       SURFACE         IG-ADMIN ASST. RADIO       SURFACE         IG-ADMIN. ASST. RADIO       SURFACE         SPARE       SURFACE	20 A 20 A 20 A 20 A 20 A 20 A 20 A 20 A	1 1 1 1 1 1 1 1 1 1 1 1 1 1 1 1 1 1 1	0.72	0.72	Phases: 3         Wires: 4         Wires: 4         0.90         0.90         9.90         9.90         9.90         9.90         9.90         9.90         9.90	0.90	0.54	1 1 1 1 1 1 1 1 1 1 1 1 1 1 1 1 1	<b>Trip</b> 20 A	Mains Type:       MLO         Mains Rating:       225 A         MCB Rating:       N/A         MCB Rating:       N/A         IG COMP RECEPS.TRAINING         RECEPS-AUTO SPEC/FM         DAY ROOM UNDERCOUNTER         RECEPS-TREATMENT         IG COMP RECEPS-TREAT/SOQ         RECEPS-SOQ         RECEPS-SOQ         RECEPS-DCQ         RECEPS-BUNK ROOMS         CHARGERS         IG-DAY RM TABLE RADIO         RECEPS-SOQ         SPARE	2 4 6 8 10 12 14 16 18 20 22 24 24 26 28 30 32 34	Notes: CKT L 1 HP-1 3 5 HP-4 7 9 HP-5 11 13 SPARE 15 RECEPS-GENERA 17 GENERATOR BAT 19 GENERATOR BAD 21 OUTBUILDING LIG 23 EXISTING LOAD 25 BATTERY CHARG 27 CU-6/AHU-6
CKI           1           3           5           7           9           11           13           15           17           19           21           23           25           27           29           31           33           35           37	Location:       MECH. 113         Supply From:       DP         Mounting:       SURFACE         Enclosure:       NEMA 1         ss:       NEMA 1         ss:       IG COMP RECEPS-CHIEFS         RECEPS-FIRE CHIEF       RECEPS-DEP CHIEFS         IG COMP RECEPS-OFFICES       IELEPHONE BACKBOARD         RECEPS-ADMIN ASST/FM       IG COMP RECEPS-ADMIN ASST         IG COMP RECEPS-ADMIN ASST/FM       IG COMP RECEPS-ADMIN ASST         COPIER       RECEPS-DAY ROOM         RECEPS-DAY ROOM       PA SYSTEM         IG-ADMIN. ASST. RADIO       FACP         SPARE       SPACE         "       "	20 A 20 A 20 A 20 A 20 A 20 A 20 A 20 A	1 1 1 1 1 1 1 1 1 1 1 1 1 1 1 1 1 1 1	0.72	0.72	Phases: 3         Wires: 4         Wires: 4         0.00         0.90         0.90         0.90         0.90         0.50         0.50         0.00         0.00         0.00         0.00           0.00	0.90	0.54	1 1 1 1 1 1 1 1 1 1 1 1 1 1 1 1 1 1 1	<b>Trip</b> 20 A	Mains Type:       MLO         Mains Rating:       225 A         MCB Rating:       N/A         MCB Rating:       N/A         IG COMP RECEPS.TRAINING         RECEPS-AUTO SPEC/FM         DAY ROOM UNDERCOUNTER         RECEPS-TREATMENT         IG COMP RECEPS-TREAT/SOQ         RECEPS-SOQ         RECEPS-SOQ         RECEPS-DCQ         RECEPS-BUNK ROOMS         CHARGERS         IG-DAY RM TABLE RADIO         RECEPS-SOQ         SPARE	2 4 6 8 10 12 14 16 18 20 22 24 24 26 28 30 32 34 36 38	Notes: CKT L 1 HP-1 3 5 HP-4 7 9 HP-5 11 13 SPARE 15 RECEPS-GENERA 17 GENERATOR BAT 19 GENERATOR BAT 19 GENERATOR BLO 21 OUTBUILDING LIG 23 EXISTING LOAD 25 BATTERY CHARGI 27 CU-6/AHU-6 29 Legend: Load Classification
<b>CKI</b> 1 3 5 7 9 11 13 15 17 19 21 23 25 27 29 31 33 35	Location:       MECH. 113         Supply From:       DP         Mounting:       SURFACE         Enclosure:       NEMA 1         ss:       NEMA 1         ss:       IG COMP RECEPS-CHIEFS         RECEPS-FIRE CHIEF       RECEPS-DEP CHIEFS         IG COMP RECEPS-OFFICES       IELEPHONE BACKBOARD         RECEPS-ADMIN ASST/FM       IG COMP RECEPS-ADMIN ASST         IG COMP RECEPS-ADMIN ASST/FM       IG COMP RECEPS-ADMIN ASST         COPIER       RECEPS-DAY ROOM         RECEPS-DAY ROOM       PA SYSTEM         IG-ADMIN. ASST. RADIO       FACP         SPARE       SPACE         "       "	20 A 20 A 20 A 20 A 20 A 20 A 20 A 20 A	1         1         1         1         1         1         1         1         1         1         1         1         1         1         1         1         1         1	0.72	0.72 0.54 0.90 0.90 0.90 0.70 0.70 0.00	Phases: 3         Wires: 4         Wires: 4         0.00         0.90         0.90         9         9         9         9         9         9         9         9         9         9         9         9         9         9         9	0.90 0.90 0.90 0.90 0.36 0.36 0.70 0.70 0.00	0.54 0.36 0.72 0.72 1.10 0.00 0.00	1 1 1 1 1 1 1 1 1 1 1 1 1 1	<b>Trip</b> 20 A	Mains Type: MLO Mains Rating: 225 A MCB Rating: N/A	2 4 6 8 10 12 14 16 18 20 22 24 24 26 28 30 32 34 36	Notes: CKT L 1 HP-1 3 5 HP-4 7 9 HP-5 11 13 SPARE 15 RECEPS-GENERA 17 GENERATOR BAT 19 GENERATOR BLO 21 OUTBUILDING LIG 23 EXISTING LOAD 25 BATTERY CHARGI 27 CU-6/AHU-6 29 Legend: Load Classification HVAC Lighting
CKI         1         3         5         7         9         113         15         17         19         21         23         25         27         29         31         33         35         37         39         41	Location:       MECH. 113         Supply From:       DP         Mounting:       SURFACE         Enclosure:       NEMA 1	20 A 20 A 20 A 20 A 20 A 20 A 20 A 20 A	1 1 1 1 1 1 1 1 1 1 1 1 1 1 1 1 1 1 1	0.72 0.72 0.36 0.90 0.90 0.50 0.00 0.00	0.72 0.54 0.90 0.90 0.90 0.70 0.70	Phases: 3         Wires: 4         Wires: 4         0.00         0.90         0.90         0.90         0.90         0.50         0.50         0.00         0.00         0.00         0.00	0.90 0.90 0.90 0.36 0.70 0.00 0.00 0.00	0.54	1 1 1 1 1 1 1 1 1 1 1 1 1 1 1 1 1 1 1	<b>Trip</b> 20 A	Mains Type: MLO Mains Rating: 225 A MCB Rating: N/A	2 4 6 8 10 12 14 16 18 20 22 24 24 26 28 30 32 34 34 36 38 40	Notes: CKT L 1 HP-1 3 5 HP-4 7 9 HP-5 11 13 SPARE 15 RECEPS-GENERA 17 GENERATOR BAT 19 GENERATOR BAT 19 GENERATOR BLO 21 OUTBUILDING LIG 23 EXISTING LOAD 25 BATTERY CHARG 27 CU-6/AHU-6 29 Legend: Load Classification HVAC Lighting Motor Power
CK1 1 3 5 7 9 11 13 15 17 19 21 23 25 27 29 31 33 5 37 39 41	Location:       MECH. 113         Supply From:       DP         Mounting:       SURFACE         Enclosure:       NEMA 1         ss:       NEMA 1         ss:       IG COMP RECEPS-CHIEFS         RECEPS-FIRE CHIEF       RECEPS-DEP CHIEFS         IG COMP RECEPS-OFFICES       IELEPHONE BACKBOARD         RECEPS-ADMIN ASST/FM       IG COMP RECEPS-ADMIN ASST         IG COMP RECEPS-ADMIN ASST/FM       IG COMP RECEPS-ADMIN ASST         COPIER       RECEPS-DAY ROOM         RECEPS-DAY ROOM       PA SYSTEM         IG-ADMIN. ASST. RADIO       FACP         SPARE       SPACE         "       "	20 A 20 A 20 A 20 A 20 A 20 A 20 A 20 A	1 1 1 1 1 1 1 1 1 1 1 1 1 1 1 1 1 1 1	0.72 0.72 0.36 0.90 0.90 0.50 0.00 0.00	0.72 0.54 0.90 0.90 0.90 0.90 0.70 0.70 0.00 0.00	Phases: 3         Wires: 4         Wires: 4         0.00         0.90         0.90         9         9         9         9         9         9         9         9         9         9         9         9         9	0.90 0.90 0.90 0.36 0.70 0.00 0.00 0.00	0.54 0.36 0.72 0.72 1.10 0.00 0.00 0.00 0.00 58	1 1 1 1 1 1 1 1 1 1 1 1 1 1 1 1 1 1 1	<b>Trip</b> 20 A	Mains Type: MLO Mains Rating: 225 A MCB Rating: N/A	2 4 6 8 10 12 14 16 18 20 22 24 24 26 28 30 32 34 34 36 38 40	CKT         Lu           1         HP-1           3            5         HP-4           7            9         HP-5           11            13         SPARE           15         RECEPS-GENERA           17         GENERATOR BAT           19         GENERATOR BLO           21         OUTBUILDING LIG           23         EXISTING LOAD           25         BATTERY CHARGI           27         CU-6/AHU-6           29            Legend:
CKT 1 3 5 7 9 11 13 15 17 19 21 23 27 29 31 33 35 37 39 41 Leg	Panelboard: C         Location: MECH. 113         Supply From: DP         Mounting: SURFACE         Enclosure: NEMA 1	20 A 20 A 20 A 20 A 20 A 20 A 20 A 20 A	1 1 1 1 1 1 1 1 1 1 1 1 1 1 1 1 1 1 1	0.72 0.72 0.36 0.90 0.90 0.50 0.00 0.00 0.00 6. 59	0.72 0.54 0.90 0.90 0.90 0.70 0.70 0.70 0.00 0.00	Phases: 3         Wires: 4         Wires: 4         0.90         0.90         9         9         9         9         9         9         9         9         9         9         9         9         9	0.90 0.90 0.90 0.36 0.70 0.70 0.70 0.00 0.00 0.00 5. 46	0.54 0.36 0.36 0.72 0.72 1.10 0.00 0.00 58 550	1 1 1 1 1 1 1 1 1 1 1 1 1 1	<b>Trip</b> 20 A	Mains Type: MLO Mains Rating: 225 A MCB Rating: N/A	2 4 6 8 10 12 14 16 18 20 22 24 24 26 28 30 32 34 34 36 38 40	Notes: CKT L 1 HP-1 3 5 HP-4 7 9 HP-5 11 13 SPARE 15 RECEPS-GENERA 17 GENERATOR BAT 19 GENERATOR BAT 19 GENERATOR BLO 21 OUTBUILDING LIG 23 EXISTING LOAD 25 BATTERY CHARGI 27 CU-6/AHU-6 29 Legend: Load Classification HVAC Lighting Motor Power
CKT 1 3 5 7 9 11 13 15 17 19 21 23 25 27 29 31 33 35 37 39 41 Leg	Panelboard: C         Location: MECH. 113         Supply From: DP         Mounting: SURFACE         Enclosure: NEMA 1	20 A 20 A 20 A 20 A 20 A 20 A 20 A 20 A	1 1 1 1 1 1 1 1 1 1 1 1 1 1	0.72 0.72 0.36 0.90 0.90 0.50 0.00 0.00 0.00 6. 59	0.72 0.54 0.90 0.90 0.90 0.70 0.70 0.70 0.00 0.00	Phases: 3         Wires: 4         Wires: 4         0.90         0.90         9         9         9         9         9         9         9         9         9         9         9         9         9	0.90 0.90 0.90 0.36 0.70 0.70 0.70 0.00 0.00 0.00 5. 46	0.54 0.36 0.36 0.72 1.10 0.00 0.00 58 50	1 1 1 1 1 1 1 1 1 1 1 1 1 1	<b>Trip</b> 20 A	Mains Type: MLO Mains Rating: 225 A MCB Rating: N/A MCB Rating: N/A IG COMP RECEPS-TRAINING RECEPS-AUTO SPEC/FM DAY ROOM UNDERCOUNTER RECEPS-TREATMENT RECEPS-TREATMENT IG COMP RECEPS-TREAT/SOQ RECEPS-SOQ RECEPS-SOQ RECEPS-BUNK ROOMS RECEPS-BUNK ROOMS CHARGERS IG-DAY RM TABLE RADIO RECEPS-SOQ SPARE SPACE "	2 4 6 8 10 12 14 16 18 20 22 24 24 26 28 30 32 34 34 36 38 40	Notes:         1       HP-1         3          5       HP-4         7          9       HP-5         11          13       SPARE         15       RECEPS-GENERA         17       GENERATOR BAT         19       GENERATOR BLO         21       OUTBUILDING LIG         23       EXISTING LOAD         25       BATTERY CHARGI         27       CU-6/AHU-6         29          Legend:         Legend:         Load Classification         HVAC       Lighting         Motor       Power         Receptacle
CKT 1 3 5 7 9 11 13 15 17 19 21 23 27 29 31 33 35 37 39 41 Leg	Panelboard: C         Location: MECH. 113         Supply From: DP         Mounting: SURFACE         Enclosure: NEMA 1	20 A 20 A 20 A 20 A 20 A 20 A 20 A 20 A	1 1 1 1 1 1 1 1 1 1 1 1 1 1 1 1 1 1 1	0.72 0.72 0.36 0.90 0.90 0.50 0.00 0.00 0.00 6. 59	0.72 0.54 0.90 0.90 0.90 0.70 0.70 0.70 0.00 0.00	Phases: 3         Wires: 4         Wires: 4         0.90         0.90         9         9         9         9         9         9         9         9         9         9         9         9         9	0.90 0.90 0.90 0.36 0.70 0.70 0.70 0.00 0.00 0.00 5. 46	0.54 0.36 0.36 0.72 0.72 1.10 0.00 0.00 58 550	1 1 1 1 1 1 1 1 1 1 1 1 1 1	<b>Trip</b> 20 A	Mains Type: MLO Vains Rating: 225 A MCB Rating: N/A MCB Rating: N/A IG COMP RECEPS-TRAINING RECEPS-AUTO SPEC/FM DAY ROOM UNDERCOUNTER RECEPS-TREATMENT RECEPS-TREATMENT IG COMP RECEPS-TREAT/SOQ RECEPS-SOQ RECEPS-SOQ RECEPS-BUNK ROOMS RECEPS-BUNK ROOMS CHARGERS IG-DAY RM TABLE RADIO RECEPS-SOQ SPARE SPACE " Total Conn. Load: 19.84 kVA Total Conn. 14.92 kVA Total Conn. 14.92 kVA	2 4 6 8 10 12 14 16 18 20 22 24 24 26 28 30 32 34 34 36 38 40	Notes:         1       HP-1         3          5       HP-4         7          9       HP-5         11          13       SPARE         15       RECEPS-GENERA         17       GENERATOR BAT         19       GENERATOR BLO         21       OUTBUILDING LIG         23       EXISTING LOAD         25       BATTERY CHARGI         27       CU-6/AHU-6         29          Legend:         Legend:         Load Classification         HVAC       Lighting         Motor       Power         Receptacle
CKT 1 3 5 7 9 11 13 15 17 19 21 23 25 27 29 31 33 35 37 39 41 Leg	Panelboard: C         Location: MECH. 113         Supply From: DP         Mounting: SURFACE         Enclosure: NEMA 1	20 A 20 A 20 A 20 A 20 A 20 A 20 A 20 A	1 1 1 1 1 1 1 1 1 1 1 1 1 1 1 1 1 1 1	0.72 0.72 0.36 0.90 0.90 0.50 0.00 0.00 0.00 6. 59	0.72 0.54 0.90 0.90 0.90 0.70 0.70 0.70 0.00 0.00	Phases: 3         Wires: 4         Wires: 4         0.90         0.90         9         9         9         9         9         9         9         9         9         9         9         9         9	0.90 0.90 0.90 0.36 0.70 0.70 0.70 0.00 0.00 0.00 5. 46	0.54 0.36 0.36 0.72 0.72 1.10 0.00 0.00 58 550	1 1 1 1 1 1 1 1 1 1 1 1 1 1	<b>Trip</b> 20 A	Mains Type: MLO Mains Rating: 225 A MCB Rating: N/A MCB Rating: N/A IG COMP RECEPS-TRAINING RECEPS-AUTO SPEC/FM DAY ROOM UNDERCOUNTER RECEPS-TREATMENT RECEPS-TREATMENT IG COMP RECEPS-TREAT/SOQ RECEPS-SOQ RECEPS-SOQ RECEPS-BUNK ROOMS RECEPS-BUNK ROOMS CHARGERS IG-DAY RM TABLE RADIO RECEPS-SOQ SPARE SPACE " " SURGE PROTECTIVE DEVICE   Total Conn. Load: 19.84 kVA Total Est. Demand: 14.92 kVA	2 4 6 8 10 12 14 16 18 20 22 24 24 26 28 30 32 34 34 36 38 40	Notes: CKT L 1 HP-1 3 5 HP-4 7 9 HP-5 11 13 SPARE 15 RECEPS-GENERA 17 GENERATOR BAT 19 GENERATOR BLO 21 OUTBUILDING LIG 23 EXISTING LOAD 25 BATTERY CHARG 27 CU-6/AHU-6 29 Legend: Load Classification HVAC Lighting Motor Power Receptacle
CKI 1 3 5 7 9 11 13 15 17 19 21 23 27 29 31 33 35 37 39 41 Leg	Panelboard: C Location: MECH. 113 Supply From: DP Mounting: SURFACE Enclosure: NEMA 1 SS:	20 A 20 A 20 A 20 A 20 A 20 A 20 A 20 A	1 1 1 1 1 1 1 1 1 1 1 1 1 1 1 1 1 1 1	0.72 0.72 0.36 0.90 0.90 0.50 0.00 0.00 0.00 6. 59	0.72 0.54 0.90 0.90 0.90 0.70 0.70 0.70 0.00 0.00	Phases: 3         Wires: 4         Wires: 4         0.90         0.90         9         9         9         9         9         9         9         9         9         9         9         9         9	0.90 0.90 0.90 0.36 0.70 0.70 0.70 0.00 0.00 0.00 5. 46	0.54 0.36 0.36 0.72 0.72 1.10 0.00 0.00 58 550	1 1 1 1 1 1 1 1 1 1 1 1 1 1	<b>Trip</b> 20 A	Mains Type: MLO Vains Rating: 225 A MCB Rating: N/A MCB Rating: N/A IG COMP RECEPS-TRAINING RECEPS-AUTO SPEC/FM DAY ROOM UNDERCOUNTER RECEPS-TREATMENT RECEPS-TREATMENT IG COMP RECEPS-TREAT/SOQ RECEPS-SOQ RECEPS-SOQ RECEPS-BUNK ROOMS RECEPS-BUNK ROOMS CHARGERS IG-DAY RM TABLE RADIO RECEPS-SOQ SPARE SPACE " Total Conn. Load: 19.84 kVA Total Conn. 14.92 kVA Total Conn. 14.92 kVA	2 4 6 8 10 12 14 16 18 20 22 24 24 26 28 30 32 34 34 36 38 40	Notes: CKT L 1 HP-1 3 5 HP-4 7 9 HP-5 11 13 SPARE 15 RECEPS-GENERA 17 GENERATOR BLO 21 OUTBUILDING LIG 23 EXISTING LOAD 25 BATTERY CHARG 27 CU-6/AHU-6 29 Legend: Load Classification HVAC Lighting Motor Power Receptacle
CKI         1         3         5         7         9         113         15         17         19         21         23         25         27         29         31         33         35         37         39         41         Leg	Panelboard: C Location: MECH. 113 Supply From: DP Mounting: SURFACE Enclosure: NEMA 1 SS:	20 A 20 A 20 A 20 A 20 A 20 A 20 A 20 A	1 1 1 1 1 1 1 1 1 1 1 1 1 1 1 1 1 1 1	0.72 0.72 0.36 0.90 0.90 0.50 0.00 0.00 0.00 6. 59	0.72 0.54 0.90 0.90 0.90 0.70 0.70 0.70 0.00 0.00	Phases: 3         Wires: 4         Wires: 4         0.90         0.90         9         9         9         9         9         9         9         9         9         9         9         9         9	0.90 0.90 0.90 0.36 0.70 0.70 0.70 0.00 0.00 0.00 5. 46	0.54 0.36 0.36 0.72 0.72 1.10 0.00 0.00 58 550	1 1 1 1 1 1 1 1 1 1 1 1 1 1	<b>Trip</b> 20 A	Mains Type: MLO Vains Rating: 225 A MCB Rating: N/A MCB Rating: N/A IG COMP RECEPS-TRAINING RECEPS-AUTO SPEC/FM DAY ROOM UNDERCOUNTER RECEPS-TREATMENT RECEPS-TREATMENT IG COMP RECEPS-TREAT/SOQ RECEPS-SOQ RECEPS-SOQ RECEPS-BUNK ROOMS RECEPS-BUNK ROOMS CHARGERS IG-DAY RM TABLE RADIO RECEPS-SOQ SPARE SPACE " Total Conn. Load: 19.84 kVA Total Conn. 14.92 kVA Total Conn. 14.92 kVA	2 4 6 8 10 12 14 16 18 20 22 24 24 26 28 30 32 34 34 36 38 40	Notes: CKT L 1 HP-1 3 5 HP-4 7 9 HP-5 11 13 SPARE 15 RECEPS-GENERA 17 GENERATOR BLO 21 OUTBUILDING LIG 23 EXISTING LOAD 25 BATTERY CHARG 27 CU-6/AHU-6 29 Legend: Load Classification HVAC Lighting Motor Power Receptacle
2KI         1         3         5         7         9         113         15         17         19         21         23         25         27         29         313         335         377         39         41	Panelboard: C Location: MECH. 113 Supply From: DP Mounting: SURFACE Enclosure: NEMA 1 SS:	20 A 20 A 20 A 20 A 20 A 20 A 20 A 20 A	1 1 1 1 1 1 1 1 1 1 1 1 1 1 1 1 1 1 1	0.72 0.72 0.36 0.90 0.90 0.50 0.00 0.00 0.00 6. 59	0.72 0.54 0.90 0.90 0.90 0.70 0.70 0.70 0.00 0.00	Phases: 3         Wires: 4         Wires: 4         0.90         0.90         9         9         9         9         9         9         9         9         9         9         9         9         9	0.90 0.90 0.90 0.36 0.70 0.70 0.70 0.00 0.00 0.00 5. 46	0.54 0.36 0.36 0.72 0.72 1.10 0.00 0.00 58 550	1 1 1 1 1 1 1 1 1 1 1 1 1 1	<b>Trip</b> 20 A	Mains Type: MLO Vains Rating: 225 A MCB Rating: N/A MCB Rating: N/A IG COMP RECEPS-TRAINING RECEPS-AUTO SPEC/FM DAY ROOM UNDERCOUNTER RECEPS-TREATMENT RECEPS-TREATMENT IG COMP RECEPS-TREAT/SOQ RECEPS-SOQ RECEPS-SOQ RECEPS-BUNK ROOMS RECEPS-BUNK ROOMS CHARGERS IG-DAY RM TABLE RADIO RECEPS-SOQ SPARE SPACE " Total Conn. Load: 19.84 kVA Total Conn. 14.92 kVA Total Conn. 14.92 kVA	2 4 6 8 10 12 14 16 18 20 22 24 24 26 28 30 32 34 34 36 38 40	Notes:         1       HP-1         3          5       HP-4         7          9       HP-5         11          13       SPARE         15       RECEPS-GENERA         17       GENERATOR BAC         21       OUTBUILDING LIG         23       EXISTING LOAD         25       BATTERY CHARG         27       CU-6/AHU-6         29          Legend:         Load Classification         HVAC       Lighting         Motor       Power         Receptacle

anelboard: A Location: MECH. 113 Supply From: DP Mounting: SURFACE Enclosure: NEMA 1	Volts: 120/208 Wye Phases: 3 Wires: 4	A.I.C. Rating: 22000 Mains Type: MLO Mains Rating: 225 A MCB Rating: N/A	Panelpoard: B Location: MECH.113 Subprotection: MECH.113 Subprotection: MECH.113 Notes: More statistics: NEAP 1 Notes: More statistics: NEAP 1 More statistics: NEA	2168 MAIN STREET SARASOTA, FL 34237 SARASOTA, FL 34237 T 941.952.0084 F 941.952.0201 FL AA26000857
Load Name LOT EAST LOT WEST ROOM ROOM R./QUARTERS KER/LAUNDRY ESS/STORAGE NING/ADMIN. IRNG/ADMIN/TREAT PRESSOR	0.96         4.00         0.19         0.71           20 A         1         0.19         0.71         0.17           20 A         1         1.83         1.32         0.17           20 A         1         1.83         1.32         0.97         1.92           20 A         1         1.83         1.32         0.97         1.92           20 A         1         0.97         1.92         0.82           20 A         1         1.09         0.97         1.92           20 A         1         1.40         1.09         0.82           20 A         1         1.40         1.09         0.82           20 A         1         0.00         0.50         0.82           20 A         1         0.00         0.50         0.00           40 A         3         2.10         3.33         0.00             2.10         0.00	C         Pole         Trip         Load Name           2         20 A         LTGAPRONS           4              5         4.00         2         50 A         RANGE           4              6         4.00         2         50 A         RANGE           6               7         0.00         1         20 A         LTGBUILDING EXTERIOR           7         0.00         1         20 A         SPARE           1         20 A         LTGAPP. BAY FLUOR.            1         20 A         LTGAPP. BAY M.H.            2         1.92         1         20 A         LTGADMIN. ASST.           1         1         20 A         ELECTRIC EYE           1         20 A         LTGADMIN.            1         20 A         ELECTRIC EYE           2         40 A         AHU-4           3         3.33                   0         0.000	CKT       Load Name       Trip       Pole       A       B       C       Pole       Trip       Load Name       CKT         2       1       IRRIGATION WELL PUMP       20 A       3       1.32       0.36       Image: Comparison of the com	SWEET SWEET SWEET SWEET
tion	Connected Load         Demand Factor         Estim           6656 VA         100.00%         2           19785 VA         125.00%         2           6400 VA         100.00%         2	nated Demand       Panel Totals         6656 VA	Total Amps:         84.65         60.08         96.07         AMPS           Legend:	
Load Name GENERATOR BLDG. OR BATTERY CHARGER OR BLOCK HEATER DING LIGHTS LOAD CHARGER -6	1.83       1.50	C       Pole       Trip       Load Name         2       30 A       HP-2         3       1.50       2       30 A       HP-3         3       1.50       2       30 A       HP-3         4            5       0       1       20 A       RECEPS/LTGVEHICLE STOR.         0       0.12       1       20 A       LIGHTING-GENERATOR RM.         0       0.12       1       20 A       GEN. FUEL TANK PUMP         1       20 A       GEN. FUEL TANK PUMP       1         2       0       0.54       1       20 A         3       1       20 A       GARAGE RECEPTACLES         0       0.54       1       20 A       GARAGE RECEPTACLES         0       0.00         SPACE         1       20 A       SURGE PROTECTIVE DEVICE          0       0.00            1       30 A       SURGE PROTECTIVE DEVICE          1             1 <td< td=""><td>CKT         Load Name         Trip         Pole         I          B         C         Pole         Trip         Pole         C         Pole</td><td>PROJECT       TOWN OF LONGBOAT KEY         TITLE:       FIRE RESCUE STATION 91         5490 GULF OF MEXICO DR       5490 GULF OF MEXICO DR         LONGBOAT KEY, FL 34228       ISSUED         ISSUED       Conformed Set         FOR:       05.22.20</td></td<>	CKT         Load Name         Trip         Pole         I          B         C         Pole         Trip         Pole         C         Pole	PROJECT       TOWN OF LONGBOAT KEY         TITLE:       FIRE RESCUE STATION 91         5490 GULF OF MEXICO DR       5490 GULF OF MEXICO DR         LONGBOAT KEY, FL 34228       ISSUED         ISSUED       Conformed Set         FOR:       05.22.20
tion	20301 VA         100.00%         2           688 VA         125.00%         2           500 VA         100.00%         2           1500 VA         100.00%         2	nated DemandPanel Totals20301 VA860 VATotal Conn. Load:27.77 kVA500 VATotal Est. Demand:27.94 kVA1500 VATotal Conn.:77.08 A4780 VATotal Est. Demand:77.56 A	41       *       -       -       0.00       0.00       -       -       SPACE 40 SHUNT-TRIP       42         Image: State of the state of th	ASI 01 08.26.20 Conformed Set 05.22.20 Addendum 01 03.24.20 DESCRIPTION DATE
			DP A B D E SHEL	LE: 1/8" = 1'-0" DJECT MANAGER: CRB WN BY: JDS OF RECORD: JDS DJECT NO: 19-522 ET TITLE: ELECTRICAL PANELBOARD SCHEDULES ET No.: E2.3 PVYIGHT 2018 SWEET SPARKMAN ARCHITECTS, INC.

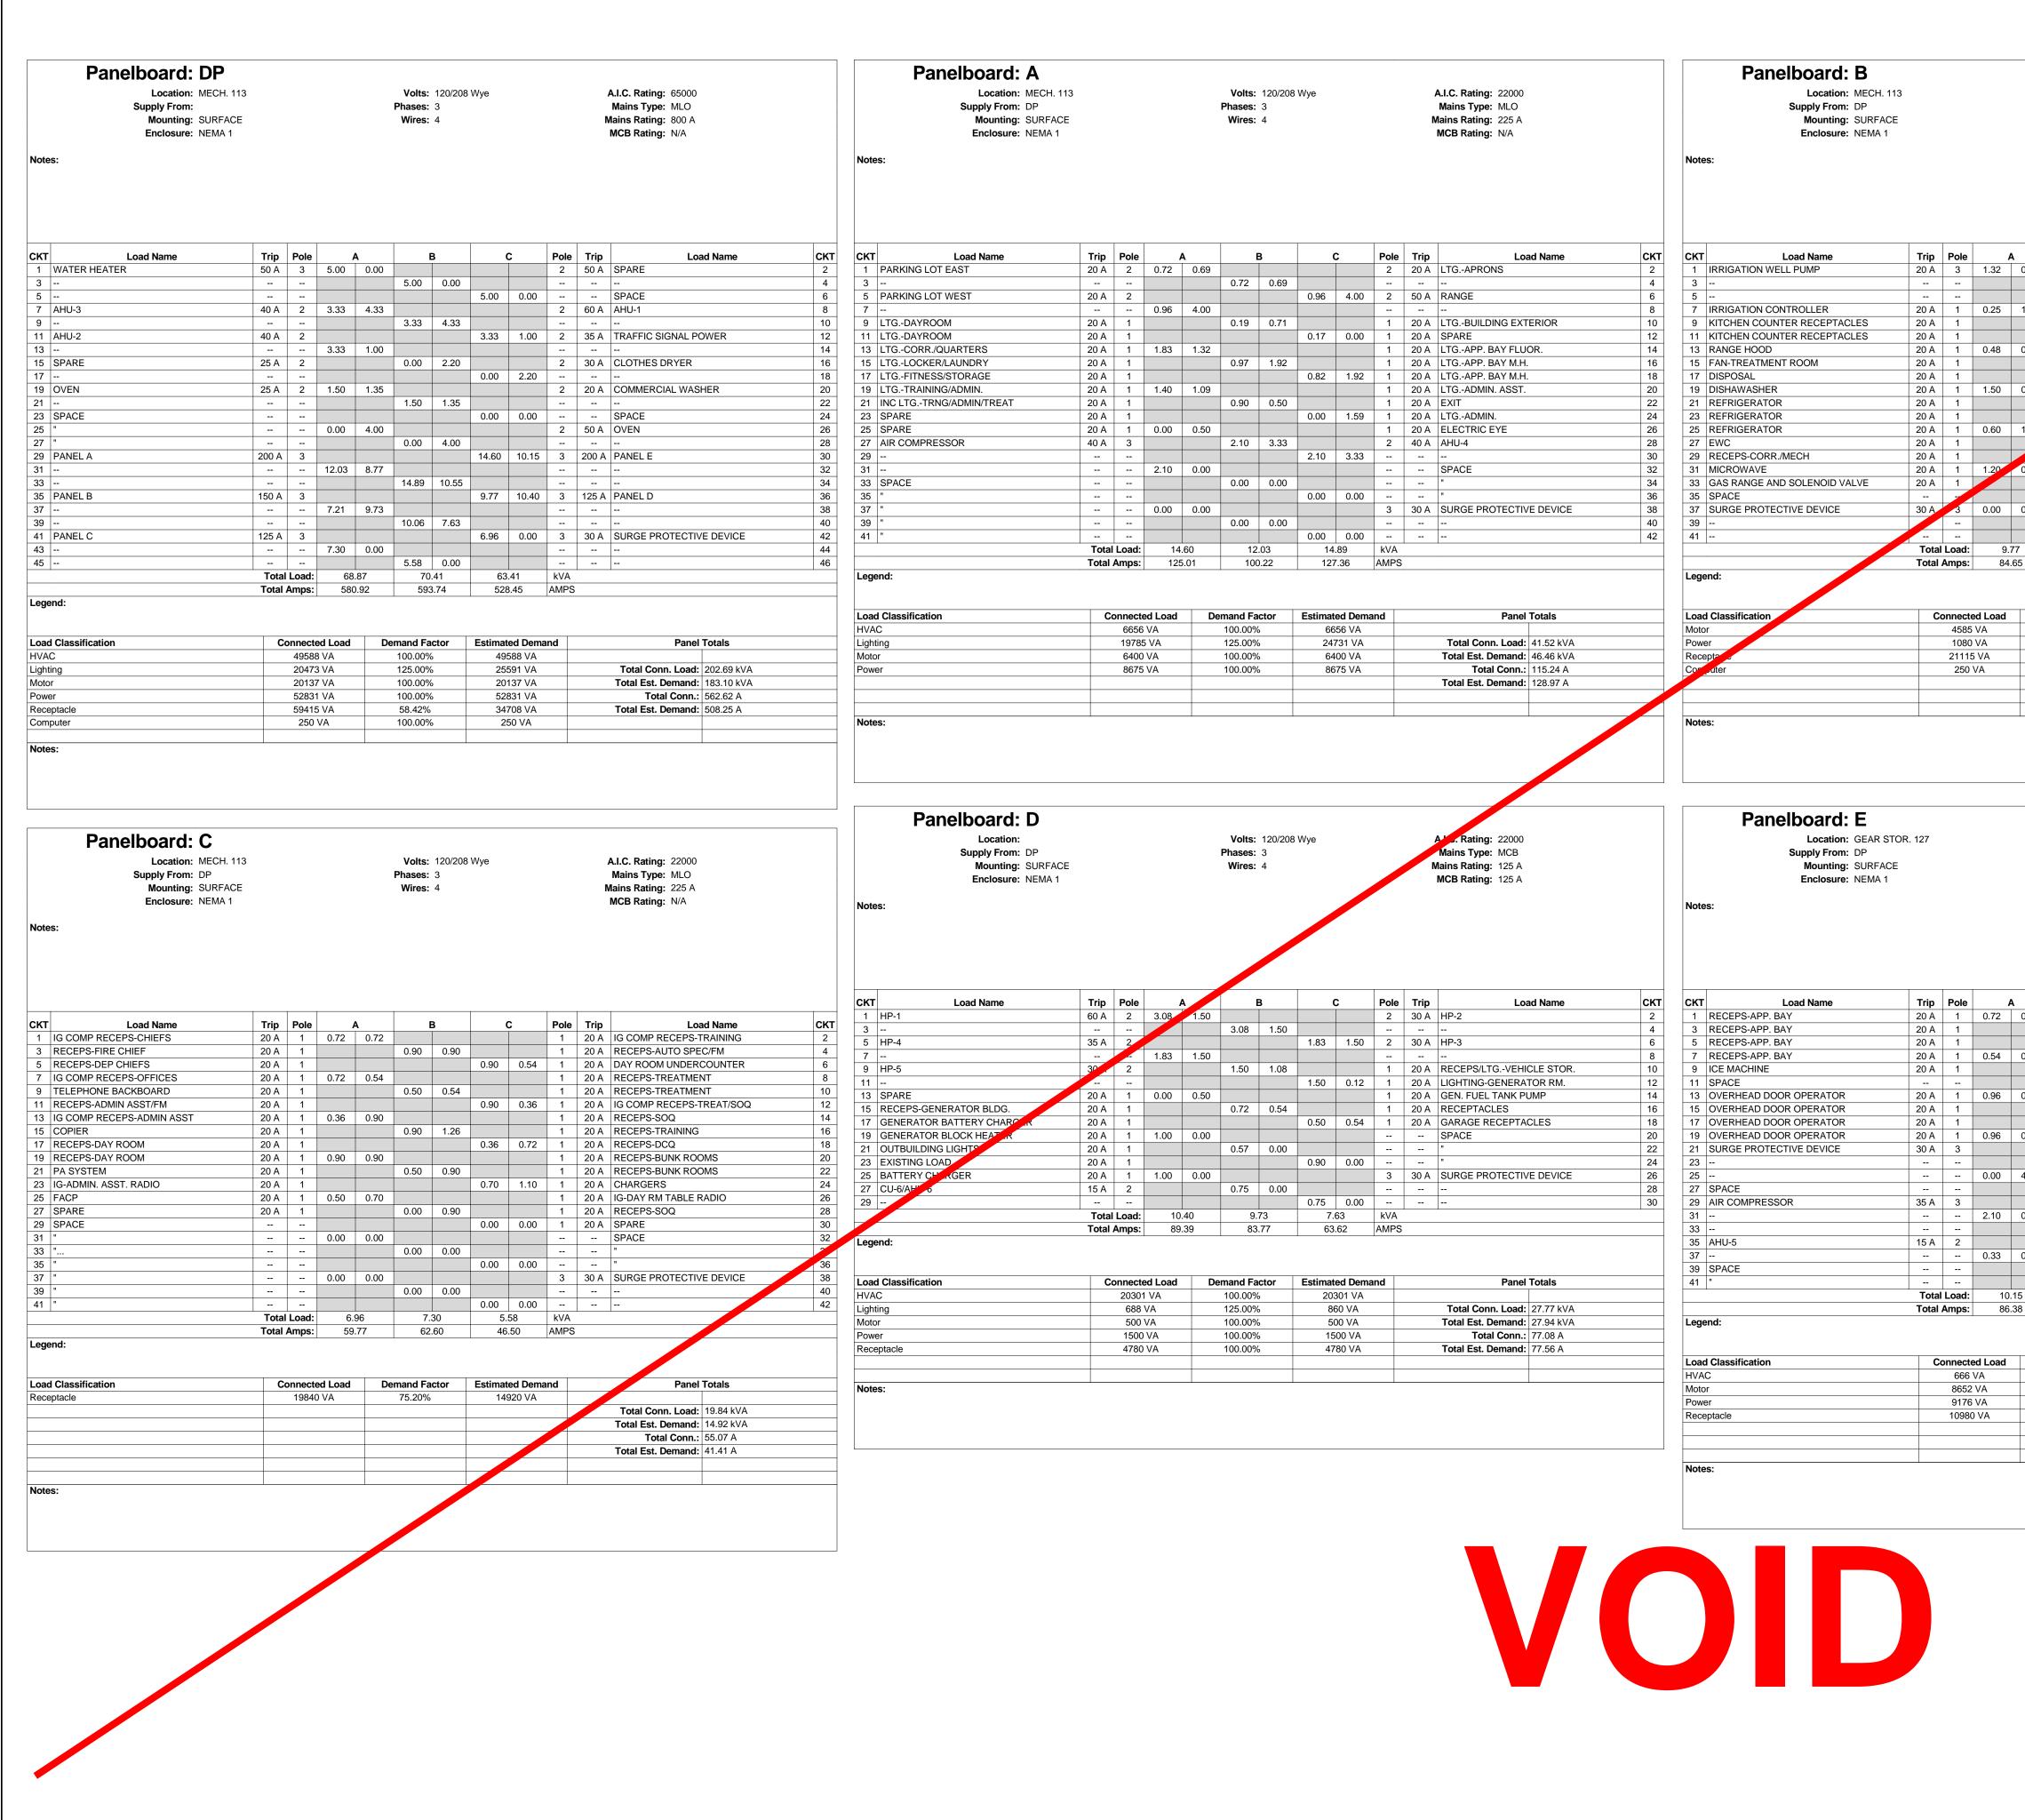



No.         No. <th></th>	
Diameter         Diameter         Provide State Provide Provi	
No.         No.         Personal Table         Solution         Solution <th< td=""><td></td></th<>	
No.         No. <td></td>	
No         DE 4         1         DA         MECREPACIENT         PP           200         0.00         1         20.0         0.00         1         20.0         0.00         0.00         Vefte:         120         0         0         0<	
Note:         Pack:         Pack: <th< td=""><td></td></th<>	
1/23         10.06         KVA           00.00         87.07         AMPS            Demand Factor         Estimated Demand         Paral         Total Cont            00.00%         4980 VA         Total Cont         Total Cont             00.00%         4980 VA         Total Cont         Total Cont              00.00%         4980 VA         Total Cont         Total Cont               00.00%         4980 VA         Total Ext. Demand         201 VA         Total Ext. Demand              00.00%         200 VA         Total Ext. Demand         201 VA         Total Ext. Demand              00.00%         200 VA         Total Ext. Demand         201 VA	
100.00%       485 VA       Test Con. Lost: 77.03 VA         73.00%       100.00%       250 VA       Test Eta Denset: 71.03 VA         73.00%       250 VA       Test Eta Denset: 71.03 VA         100.00%       200 VA       Test Eta Denset: 71.03 VA         Planses: 3       Malies Type: 94.00         Malies Type: 94.00       Malies Type: 94.00         100.00       0.02       1       20.0         100.00       0.02       1       20.0       597.05         100.00       0.00       4.00       20.00       597.05       20         100.00       0.00       4.00       2.00       20.00       20.00       20.00         100.00       0.00       4.00       2.00       20.00       20.00       20.00         100.00       0.00       4.00       2.00       20.00 <td></td>	
Phases: 3       Main Type: MLO         Wires: 4       Main Sating: S2 A         MCB Rating: N/A       MCB Rating: N/A         D       B       C       Pole       Trip       Load Name       CKT         0.0       0       0.72       0.36       1       20.4       CoRD RELAPP. BAY       4         0       0       0.72       0.36       1       20.4       CoRD RELAPP. BAY       6         1       20.72       0.4       1       20.4       CoRD RELAPP. BAY       6         1       20.00       0.36       1       20.4       CoRD RELAPP. BAY       6         1       20.01       CoRD RECEPS-WORKSHOP       16       7       7       </th <th></th>	
B         C         Pole         Trip         Load Name         CKT           00         -         -         -         SPACE         2           00         0.54         0.36         1         20A         CORD REL-APP. BAY         4           0.00         0.72         0.36         1         20A         CORD REL-APP. BAY         6           0.00         0.72         0.36         1         20A         RECEPS-FITNESS         10           0.44         0.54         0.54         1         20A         RECEPS-FITNESS         10           0.54         0.56         0.56         1         20A         RECEPS-WORKSHOP         16           0.40         0.40         0.56         1.20         RECEPS-WORKSHOP         18           0.00         0.00         0.00         2.00         2.00         PORTABLE WELDER         22           4.00         0.00         0.00         2.00         7         -         -         22           4.00         0.00         2.00         7         -         -         -         23           0.00         0.00         -         -         -         -         24	
1.00         SPACE       8         1.20       0.72        1       20A       RECEPS-FITNESS       10         1.84        1       20A       RECEPS-FITNESS       12         1.84        1       20A       RECEPS-FITNESS       12         0.86       0.56       0.56       1       20A       RECEPS-WORKSHOP       16         0.00       0.00         *       PACE       20         0.00       0.00         *       22         0.00       0.00         *       22         0.00       0.00         *       22         0.00       0.00         *       22         0.00       0.00         *       32         1.00       0.00         *       32         1.00       1.18       0.04       APP. BAY EXHAUST FAN       34         1.00       1.18       1       20A       APP. BAY EXHAUST FAN       38         1.00       0.00       0.00	228
0.00       0.01       0.01       1       20A       RECEPS-IMRESS       12         6.4       0.02       1       20A       RECEPS-WORKSHOP       16         0.00       0.06       0.06       1       20A       RECEPS-WORKSHOP       18         0.00       0.00       0.00       -       -       -       SPACE       20         0.00       0.00       0.00       -       -       -       -       22         0.00       0.00       -       -       -       -       22         0.00       0.00       -       -       -       -       22         0.00       0.00       -       -       -       -       20         0.00       0.00       -       -       -       22       20         0.00       0.00       -       -       -       26       26         0.00       0.00       -       -       -       32       27       30         0.00       0.00       -       -       SPACE       38       36         0.00       0.00       -       SPACE       38       38       -         0.00       0	; FL 342 et
Image:	AT KEY ned S
Image: Probability         0.00         4.00         2         50.4         PORTABLE WELDER         24           00         0.00         0.00         1           26           0         0.00         0.00         0.00         0.00          SPACE         28           0         0.00         2.10         0.00           30           0.0         0.00         0.00            32           2.10         1.18         0.20         APP. BAY EXHAUST FAN         34           0.00         1.18         1         20.0         APP. BAY EXHAUST FAN         36           0.00         1.18         1         20.0         APP. BAY EXHAUST FAN         36           0.00         1.18         0.00         -         -         SPACE         38           0.00         1.05         KVA         -         -         SPACE 40 SHUNT-TRIP         42           73.10         89.68         AMPS         -         -         -         -           100.00%         666 VA         -         -         -         -           100.00%         8652 V	Conformed Set
0.00       0.00         SPACE       28         00       2.10       0.00         *       30         00       -         *       30         00       -       -        *       30         2.10       1.18       2.0 A       APP. BAY EXHAUST FAN       34         0       -         SPACE       38         0.00       1.18       1       2.0 A       APP. BAY EXHAUST FAN       36         0.00       1.18       1       2.0 A       APP. BAY EXHAUST FAN       36         0.00       1.18       1       2.0 A       APP. BAY EXHAUST FAN       36         0.00       1.18       1       2.0 A       FUEL SYSTEM       40         1.18       0.00       0.00        SPACE       38         0.00       1.00       8.68       AMPS       42         73.10       89.68       AMPS	Ч  ŏ b
1.10       1.10       ISSUED FOR:
0.00       1.18       1       20 A       FUEL SYSTEM       40         0.00       0.00         SPACE 40 SHUNT-TRIP       42         73.10       89.68       AMPS        SPACE 40 SHUNT-TRIP       42         73.10       89.68       AMPS        SPACE 40 SHUNT-TRIP       10         0       73.10       89.68       AMPS           0	
73.10       89.68       AMPS         73.10       89.68       AMPS         100.00%       Estimated Demand       Panel Totals         100.00%       666 VA       Image: Comparison of the compar	
100.00%       666 VA       Image: Constant of the second s	
100.00%       8652 VA       Total Conn. Load:       29.47 kVA         100.00%       9176 VA       Total Est. Demand:       28.98 kVA         95.54%       10490 VA       Total Conn.:       81.81 A         00.00%       Total Est. Demand:       80.45 A         00.00%       0       0       0         00.00%       0       0       0         00.00%       0       0       0         00.00%       0       0       0         00.00%       0       0       0         00.00%       0       0       0         00.00%       0       0       0         00.00%       0       0       0         00.00%       0       0       0         00.00%       0       0       0         00.00%       0       0       0         00.00%       0       0       0         00.00%       0       0       0         00.00%       0       0       0         00.00%       0       0       0         00.00%       0       0       0         00.00%       0       0       0      0	
Total Est. Demand:         80.45 A           Image: Constraint of the state o	
REV DESCRIP	
GRAPHIC SCAL	::
SCALE:	1/8" = 1'-
PROJECT MANA DRAWN BY:	GER: CF
A/E OF RECORD	JI
PROJECT NO: SHEET TITLE:	): J[
ELECT	r: J[ 19-5
DP A B SCHED	19-5

D


SHEET No .: E2.3


	LOW VOLTAGE LEGEND
SYMBOL	DESCRIPTION
AFF/AFG	ABOVE FINISHED FLOOR / ABOVE FINISHED GRADE
AHJ	AUTHORITY HAVING JURISDICTION
ETR	EXISTING TO REMAIN.
NIC	NOT IN CONTRACT
TR	TAMPER RESISTANT
UON	UNLESS OTHERWISE NOTED
WP	WEATHER PROOF
NAC	
SLC	SIGNALING LINE CIRCUIT CLASS B (ADDRESSABLE LOOP)
SLC (A)	SIGNALING LINE CIRCUIT CLASS A (ADDRESSABLE LOOP) INITIATING DEVICE CIRCUIT (CONVENTIONAL LOOP)
IDC CD	CANDELA RATING
W	WALL MOUNTED DEVICE
C	CEILING MOUNTED DEVICE
Ŭ.	CCTV CAMERA, CEILING-MOUNTED "C" OR WALL-MOUNTED "W" AS INDICATED
SC	SECURITY CONTACT DOOR/WINDOW ECT.
ML	MAGNETIC LOCK
DSL	DOOR STRIKE LOCK
PR	PROX READER
PDR	PROX READER LIGHTED EXIT PUSH BUTTON FOR DOOR RELEASE.
РВ	PANIC BUTTON
R	SECURITY SYSTEM RELAY
KP	SECURITY SYSTEM KEYPAD
DR	EXIT PUSH BUTTON FOR DOOR RELEASE.
Ġ	HANDICAP EXIT PUSH PLATE DOOR OPENER.
5	SIREN
	SECURITY SYSTEM MOTION DETECTOR
	MOTION DETECTOR FOR DOOR RELEASE
SEC	SECURITY CONTROL PANEL.
	TELEPHONE OUTLET - MOUNT 18" AFF U.O.N., 4" SQ. J-BOX w/1-GANG PLASTER RING, 1"C TO ACCESSIBLE CEILING. PROVIDE PULLSTRING.
	DATA OUTLET - MOUNT 18" AFF U.O.N., 4" SQ. J-BOX w/1-GANG PLASTER RING, 1"C TO ACCESSIBLE CEILING. PROVIDE PULLSTRING.
$\mathbf{\nabla}$	TELECOM OUTLET(DATA/TELEPHONE) - MOUNT 18" AFF U.O.N., 4" SQ. J-BOX w/1-GANG PLASTER RING, 1"C TO ACCESSIBLE CEILING. PROVIDE PULLSTRING.
	FLOOR/CEILING-MOUNTED TELECOM OUTLET. REFER TO PLANS FOR BOX TYPE, CONDUIT SIZE/QUANTITY & CONFIGURATION.
	HDMI CABLE OUTLET, PROVIDE 4" SQ. J-BOX w/1-GANG PLASTER RING AND COVER PLATE.
	CABLE TELEVISION OUTLET - MOUNT 18" AFF U.O.N., 4" SQ. J-BOX w/1-GANG PLASTER RING, 1"C TO ACCESS. CLG. PROVIDE PULLSTRING.
TTB	TTB (TELEPHONE TERMINAL BOARD) MARINE PLYWOOD BACKBOARD 3/4"x4'x4' PAINTED W/FIRE RETARDANT GRAY PAINT. PROVIDE (2)4" CONDUITS TO PROPERTY LINE. COORDINATE FINAL CONDUIT SIZES AND LOCATIONS W/UTILITY. PROVIDE SOLID COPPER GROUND BAR WITH
	INSULATED STAND-OFFS.
J	JUNCTION BOX
0	FIRE ALARM PULL STATION, MOUNT 48" AFF U.O.N.
0	HEAT DETECTOR (THERMAL DETECTOR)
®	SYSTEM TYPE, ADDRESSABLE SMOKE DETECTOR FOR FIRE ALARM &/OR SMOKE CONTROL. MAINTAIN A MINIMUM DISTANCE OF 3'-0" FROM ALL CEILING-MOUNTED HVAC SUPPLY/RETURN REGISTERS.
	PHOTOELECTRIC TYPE SMOKE DETECTOR MOUNTED IN HVAC DUCT FOR MECHANICAL UNIT SHUT DOWN AND/OR SMOKE DAMPER
	OPERATION, COORDINATE FINAL LOCATION AND QUANTITY WITH MECHANICAL PLANS AND MECHANICAL CONTRACTOR.
RTS	DUCT DETECTOR REMOTE TEST SWITCH.
	ELECTRIC HORN, MOUNT 90" A.F.F. OR 6" BELOW THE CEILING, WHICHEVER IS LOWER.
	LOW FREQUENCY ALARM APPLIANCE, 520 HZ MOUNT BETWEEN 80" AND 96" AFF.
لظ _د	COMBINATION LOW FREQUENCY/STROBE ALARM APPLIANCE, 520 HZ MOUNT AS PER ADA REQUIREMENTS.
×	STROBE LIGHT, MOUNT BETWEEN 80" AND 96" AFF. FINAL MOUNTING HEIGHT W/ARCH.
X	COMBINATION FIRE ALARM HORN/STROBE, MOUNT BETWEEN 80" AND 96" AFF. COORDINATE FINAL MOUNTING HEIGHT WITH ARCHITECT.
8	STROBE LIGHT, CEILING MOUNT.
8	COMBINATION FIRE ALARM HORN/STROBE, CEILING MOUNT.
	VOICE EVACUATION SPEAKER, MOUNT 90" A.F.F. OR 6" BELOW THE CEILING, WHICHEVER IS LOWER. CONTRACTOR SHALL ADJUST TAPS IN
	FIELD FOR AUDIBILITY/INTELLIGIBILITY. VOICE EVACUATION SPEAKER/STROBE MOUNT 90" A.F.F. OR 6" BELOW THE CEILING, WHICHEVER IS LOWER. CONTRACTOR SHALL ADJUST
⊠ _∨	TAPS IN THE FIELD FOR AUDIBILITY/INTELLIGIBILITY.
8	VOICE EVACUATION SPEAKER, CEILING MOUNT, CONTRACTOR SHALL ADJUST TAPS IN FIELD FOR AUDIBILITY/INTELLIGIBILITY.
<u>ک</u>	VOICE EVACUATION SPEAKER/STROBE CEILING MOUNT, CONTRACTOR SHALL ADJUST TAPS IN THE
<u>ଞ୍</u> ଧ	FIELD FOR AUDIBILITY/INTELLIGIBILITY.
	DOOR HOLDER FLOW SWITCH
 ♀	FLOW SWITCH TAMPER SWITCH
 田	FIRE ALARM MONITORING MODULE.
	FIRE ALARM MONITORING MODULE. FIRE ALARM CONTROL RELAY. LOCATE WITHIN 3'-0" OF CONTROLLED EQUIPMENT.
ER	FIRE ALARM CONTROL RELAT. LOCATE WITHIN 5-0 OF CONTROLLED EQUIPMENT. FIRE ALARM LINE ISOLATION MODULE, USED IN CLASS A CIRCUITS ONLY.
ER. LIM	TIRE ALARM LINE ISOLATION MODULE, USED IN GLASS A GIRGUITS ONLT.
	SURGE PROTECTION DEVICE, INCLUDE GROUNDING AS PER MANUFACTURERS INSTRUCTIONS.
LIM	
LIM SPD	SURGE PROTECTION DEVICE, INCLUDE GROUNDING AS PER MANUFACTURERS INSTRUCTIONS.
EIM SPD TS	SURGE PROTECTION DEVICE, INCLUDE GROUNDING AS PER MANUFACTURERS INSTRUCTIONS. FIRE ALARM TELEPHONE STATION.
EIM SPD TS FACP	SURGE PROTECTION DEVICE, INCLUDE GROUNDING AS PER MANUFACTURERS INSTRUCTIONS. FIRE ALARM TELEPHONE STATION. FIRE ALARM CONTROL PANEL.
EIM SPD TS FACP BPS	SURGE PROTECTION DEVICE, INCLUDE GROUNDING AS PER MANUFACTURERS INSTRUCTIONS.         FIRE ALARM TELEPHONE STATION.         FIRE ALARM CONTROL PANEL.         FIRE ALARM BOOSTER POWER SUPPLY.
EIM SPD TS FACP BPS FACS	SURGE PROTECTION DEVICE, INCLUDE GROUNDING AS PER MANUFACTURERS INSTRUCTIONS.         FIRE ALARM TELEPHONE STATION.         FIRE ALARM CONTROL PANEL.         FIRE ALARM BOOSTER POWER SUPPLY.         FIRE ALARM COMMAND SYSTEM.
EIM SPD TS FACP BPS FACS AMP	SURGE PROTECTION DEVICE, INCLUDE GROUNDING AS PER MANUFACTURERS INSTRUCTIONS.         FIRE ALARM TELEPHONE STATION.         FIRE ALARM CONTROL PANEL.         FIRE ALARM BOOSTER POWER SUPPLY.         FIRE ALARM COMMAND SYSTEM.         VOICE EVAC AMPLIFIER PANEL.
ELIM SPD TS FACP BPS FACS AMP ANN	SURGE PROTECTION DEVICE, INCLUDE GROUNDING AS PER MANUFACTURERS INSTRUCTIONS.         FIRE ALARM TELEPHONE STATION.         FIRE ALARM CONTROL PANEL.         FIRE ALARM BOOSTER POWER SUPPLY.         FIRE ALARM COMMAND SYSTEM.         VOICE EVAC AMPLIFIER PANEL.         FIRE ALARM ANNUNCIATOR. PROVIDE FLUSH MOUNTING TRIM FOR DEVICE RECESS MOUNTING.
LIM SPD TS FACP BPS FACS AMP ANN DACT	SURGE PROTECTION DEVICE, INCLUDE GROUNDING AS PER MANUFACTURERS INSTRUCTIONS.         FIRE ALARM TELEPHONE STATION.         FIRE ALARM CONTROL PANEL.         FIRE ALARM BOOSTER POWER SUPPLY.         FIRE ALARM COMMAND SYSTEM.         VOICE EVAC AMPLIFIER PANEL.         FIRE ALARM ANNUNCIATOR. PROVIDE FLUSH MOUNTING TRIM FOR DEVICE RECESS MOUNTING.         DIGITAL ALARM COMMUNICATION TRANSMITTER
LIM SPD TS FACP BPS FACS AMP ANN DACT FATC	SURGE PROTECTION DEVICE, INCLUDE GROUNDING AS PER MANUFACTURERS INSTRUCTIONS.         FIRE ALARM TELEPHONE STATION.         FIRE ALARM CONTROL PANEL.         FIRE ALARM BOOSTER POWER SUPPLY.         FIRE ALARM COMMAND SYSTEM.         VOICE EVAC AMPLIFIER PANEL.         FIRE ALARM ANNUNCIATOR. PROVIDE FLUSH MOUNTING TRIM FOR DEVICE RECESS MOUNTING.         DIGITAL ALARM COMMUNICATION TRANSMITTER         FIRE ALARM TERMINAL CABINET.
LIM SPD TS FACP BPS FACS AMP ANN DACT FATC KNOX E.O.L	SURGE PROTECTION DEVICE, INCLUDE GROUNDING AS PER MANUFACTURERS INSTRUCTIONS.         FIRE ALARM TELEPHONE STATION.         FIRE ALARM CONTROL PANEL.         FIRE ALARM BOOSTER POWER SUPPLY.         FIRE ALARM COMMAND SYSTEM.         VOICE EVAC AMPLIFIER PANEL.         FIRE ALARM ANNUNCIATOR. PROVIDE FLUSH MOUNTING TRIM FOR DEVICE RECESS MOUNTING.         DIGITAL ALARM COMMUNICATION TRANSMITTER         FIRE ALARM TERMINAL CABINET.         KNOX BOX
EIM SPD TS FACP BPS FACS AMP ANN DACT FATC FATC KNOX	SURGE PROTECTION DEVICE, INCLUDE GROUNDING AS PER MANUFACTURERS INSTRUCTIONS.         FIRE ALARM TELEPHONE STATION.         FIRE ALARM CONTROL PANEL.         FIRE ALARM BOOSTER POWER SUPPLY.         FIRE ALARM COMMAND SYSTEM.         VOICE EVAC AMPLIFIER PANEL.         FIRE ALARM ANNUNCIATOR. PROVIDE FLUSH MOUNTING TRIM FOR DEVICE RECESS MOUNTING.         DIGITAL ALARM COMMUNICATION TRANSMITTER         FIRE ALARM TERMINAL CABINET.         KNOX BOX         END-OF-LINE RESISTOR.
EIM SPD TS FACP BPS FACS AMP ANN DACT FATC KNOX E.O.L ARP	SURGE PROTECTION DEVICE, INCLUDE GROUNDING AS PER MANUFACTURERS INSTRUCTIONS.         FIRE ALARM TELEPHONE STATION.         FIRE ALARM CONTROL PANEL.         FIRE ALARM BOOSTER POWER SUPPLY.         FIRE ALARM COMMAND SYSTEM.         VOICE EVAC AMPLIFIER PANEL.         FIRE ALARM ANNUNCIATOR. PROVIDE FLUSH MOUNTING TRIM FOR DEVICE RECESS MOUNTING.         DIGITAL ALARM COMMUNICATION TRANSMITTER         FIRE ALARM TERMINAL CABINET.         KNOX BOX         END-OF-LINE RESISTOR.         AREA OF RESCUE POWER SUPPLY.
EIM SPD TS FACP BPS FACS AMP ANN DACT FATC FATC KNOX E.O.L ARP ARP	SURGE PROTECTION DEVICE, INCLUDE GROUNDING AS PER MANUFACTURERS INSTRUCTIONS.         FIRE ALARM TELEPHONE STATION.         FIRE ALARM CONTROL PANEL.         FIRE ALARM BOOSTER POWER SUPPLY.         FIRE ALARM COMMAND SYSTEM.         VOICE EVAC AMPLIFIER PANEL.         FIRE ALARM ANNUNCIATOR. PROVIDE FLUSH MOUNTING TRIM FOR DEVICE RECESS MOUNTING.         DIGITAL ALARM COMMUNICATION TRANSMITTER         FIRE ALARM TERMINAL CABINET.         KNOX BOX         END-OF-LINE RESISTOR.         AREA OF RESCUE POWER SUPPLY.

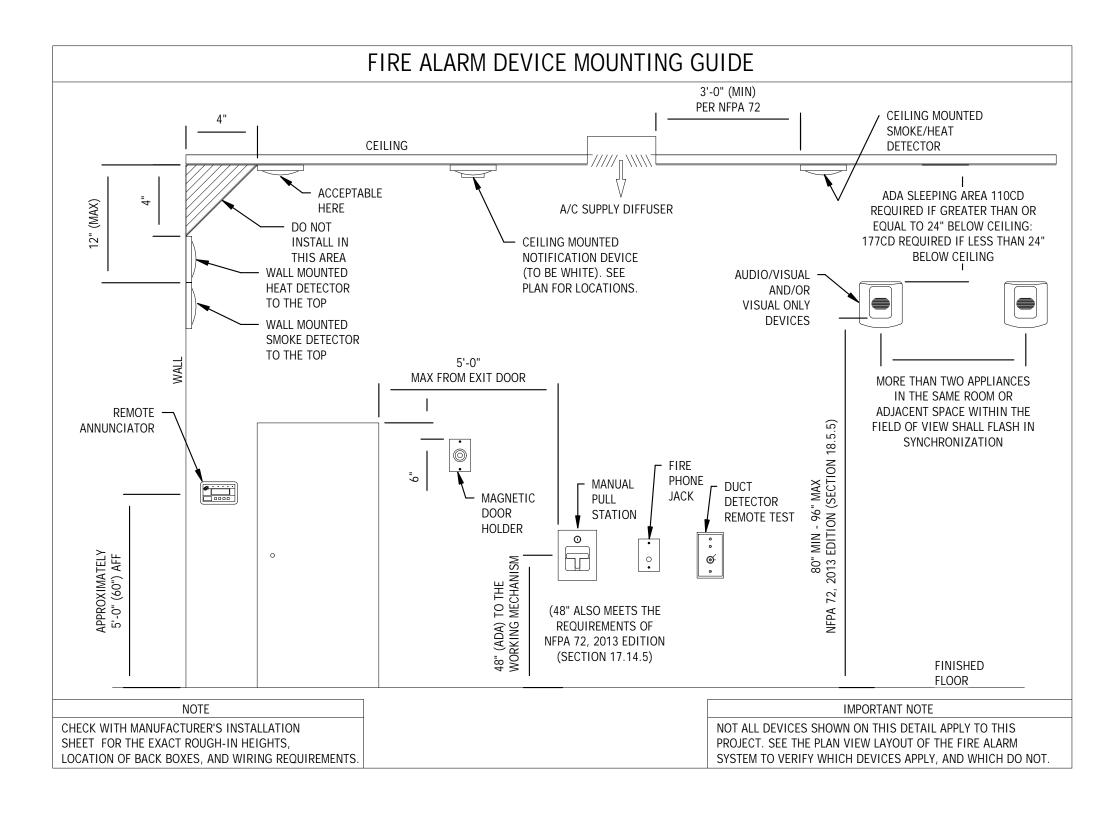

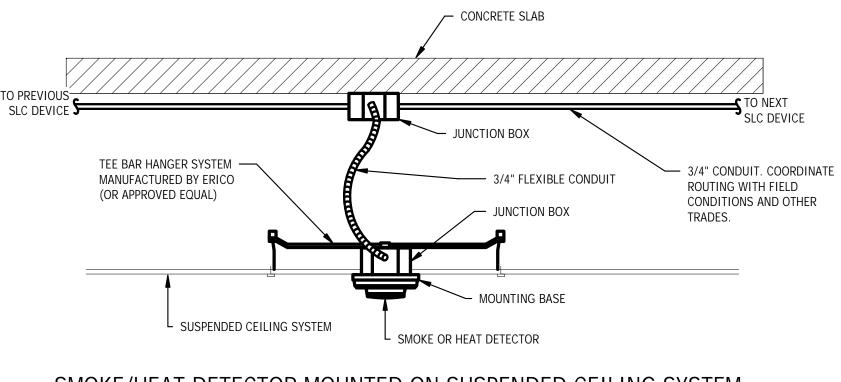

SCALE: NONE

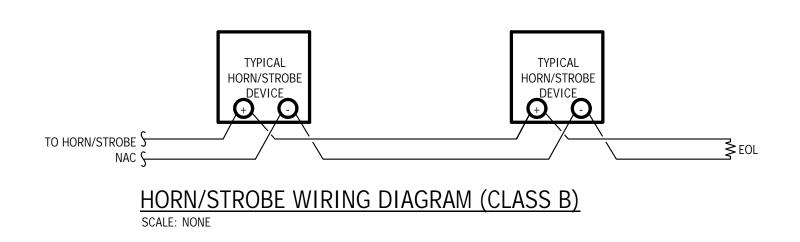

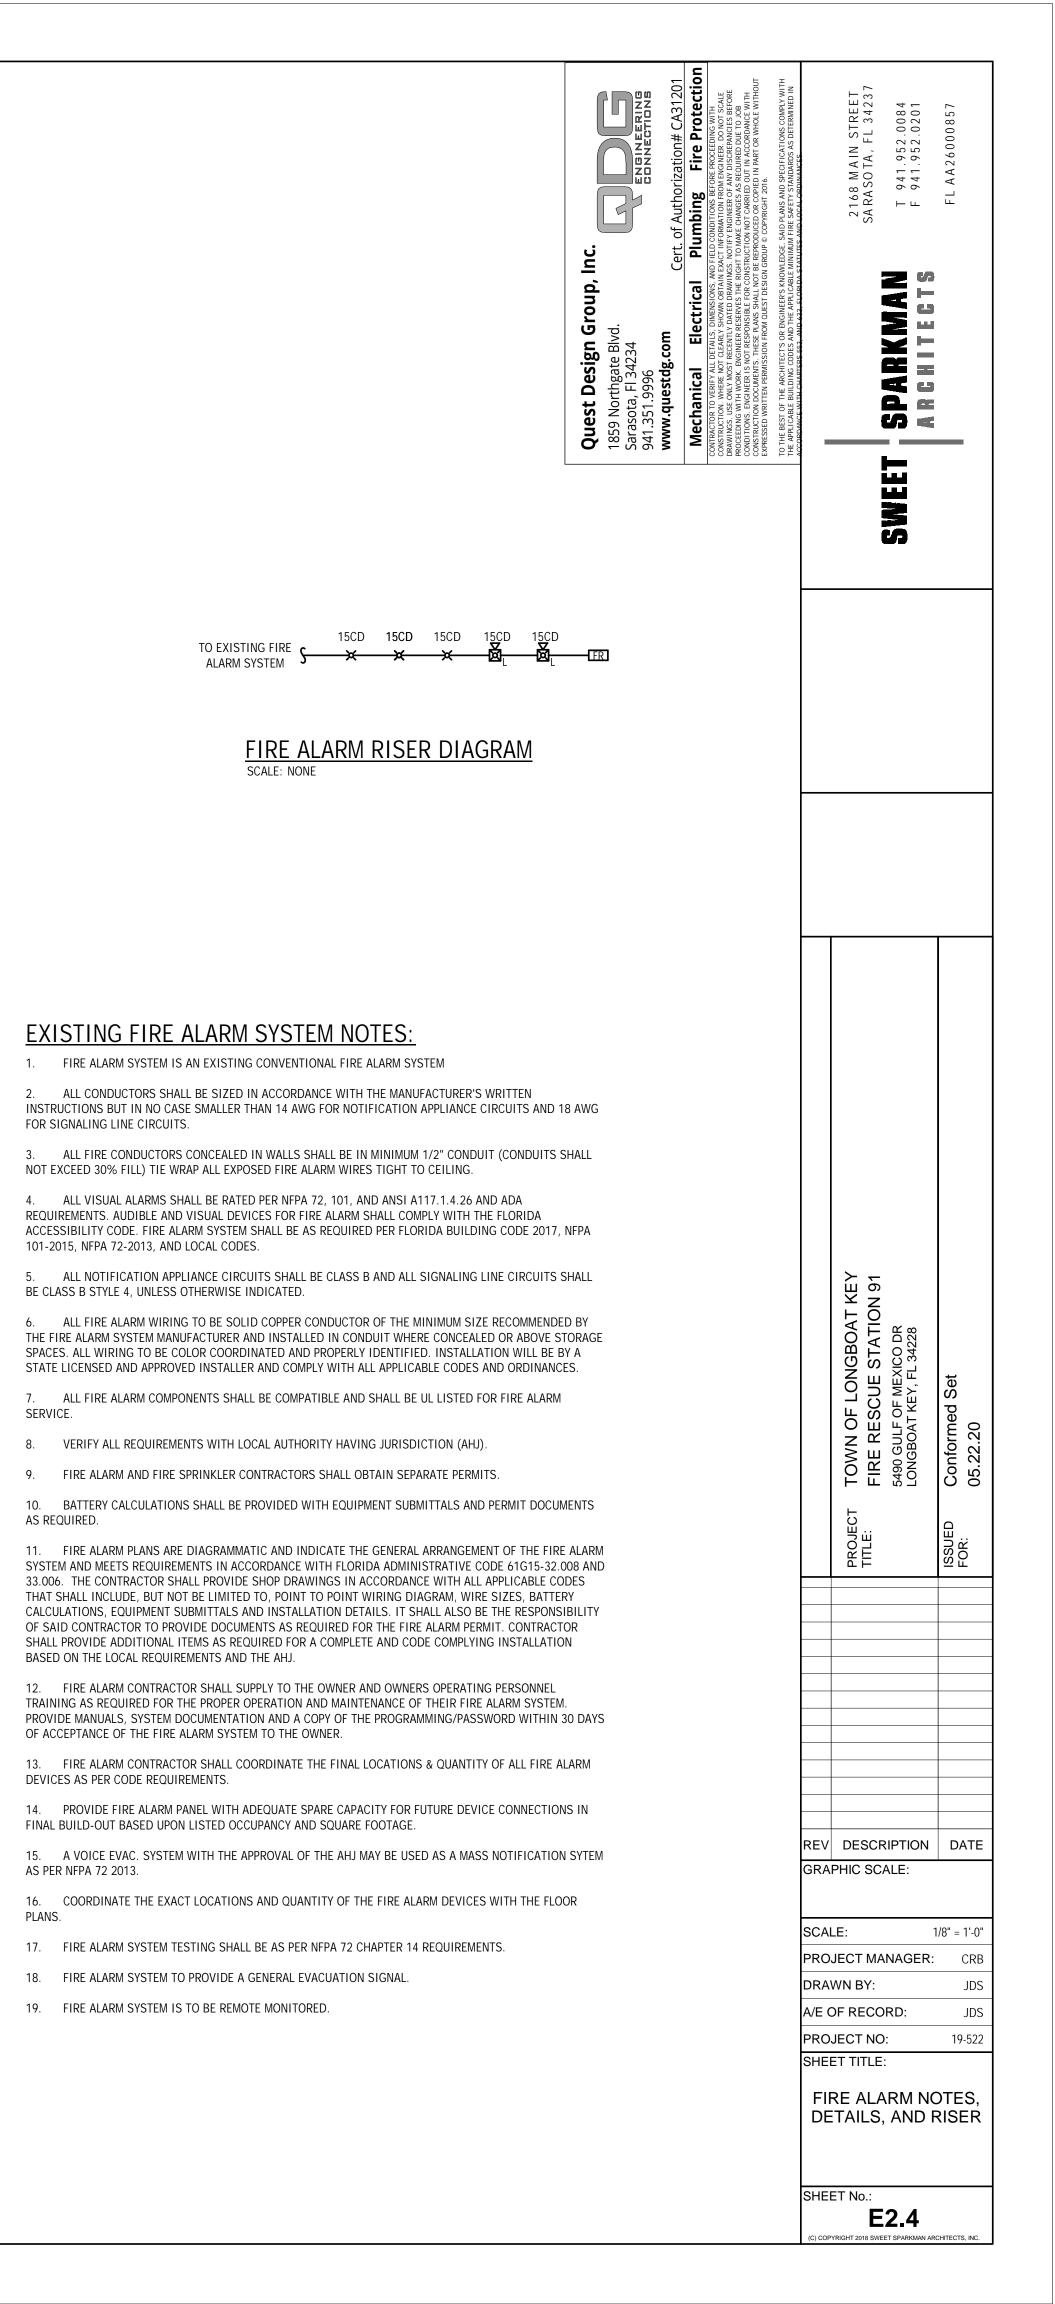

#### DEMOLITION NOTES

THE DEMOLITION PROCEDURES SHALL PROVIDE FOR SAFE CONDUCT OF THE WORK, PROTECTION OF PERSONNEL, CAREFUL REMOVAL, AND DISPOSAL OF MATERIALS AS INDICATED. THE PROCEDURES ALSO INCLUDE PROTECTION OF PROPERTY TO REMAIN UNDISTURBED. COORDINATION WITH OTHER WORK IN PROGRESS AND TIMELY DISCONNECTION OF UTILITY SERVICES.

EXISTING WORK SHALL NOT BE CUT, DRILLED, ALTERED, REMOVED, OR TEMPORARILY REMOVED FOR THE INSTALLATINO REQUIRED TO PERFORM CONSTRUCTION ACTIVITIES OF MECHANICAL AND ELECTRICAL WORK AND OTHER CONSTRUCTION UNDER THE CONTRACT WITHOUT AUTHORIZATION OF THE OWNER. STRUCTURAL MEMBERS OF CONCRETE OR STRUCTURAL STEEL SHALL NOT BE ALTERED WITHOUT AUTHORIZATION OF THE OWNER.

CONDUCT DEMOLITION OPERATIONS AND REMOVE DEBRIS TO ENSURE MINIMUM INTERFERENCE WITH ROAD, STREETS, WALKWAYS, AND OTHER ADJACENT OCCUPIED AND USED FACILITIES.

REMOVE AND LEGALLY DISPOSE OF ITEMS EXCEPT THOSE INDICATED TO BE REINSTALLED, SALVAGED, OR TO REMAIN THE OWNER'S PROPERTY.

COMPLY WITH GOVERNING EPA NOTIFICATION REGULATIONS BEFORE STARTING DEMOLITION. COMPLY WITH HAULING AND DISPOSAL REGULATIONS OF AUTHORITIES HAVING JURISDICTION.

PROVIDE TEMPORARY SERVICES DURING THE INTERRUPTION TO EXISTING UTILITIES TO REMAIN, AS ACCEPTABLE TO OWNER AND TO GOVERNING AUTHORITIES. COORDINATE WITH OWNER'S REPRESENTATIVE.


REMOVE AND REINSTALL: REMOVE ITEMS INDICATED - CLEAN, SERVICE, AND OTHERWISE PREPARE FOR REUSE - STORE AND PROTECT AGAINS DAMAGE. REINSTALL ITEMS IN LOCATIONS INDICATED.

EXISTING TO REMAIN: PROTECT CONSTRUCTION INDICATED TO REMAIN AGAINST DAMAGE AND SOILING DURING DEMOLITION. WHEN PERMITTED BY THE ARCHITECT, ITEMS MAY BE REMOVED TO A SUITABLE, PROTECTED STORAGE LOCATION DURING DEMOLITION AND THEN CLEANED AND REINSTALLED IN THEIR ORIGINAL LOCATIONS.


EXCEPT FOR ITEMS OR MATERIALS INDICATED TO BE REUSED, SALVAGED, OR OTHERWISE INDICATED TO REMAIN THE OWNER'S PROPERTY, DEMOLISHED MATERIALS SHALL BECOME THE CONTRACTOR'S PROPERTY AND SHALL BE REMOVED FROM THE SITE WITH FURTHER DISPOSITION AT THE CONTRACTOR'S OPTION


#### SCOPE FO WORK - PLUMBING

- 1. CONTRACTOR SHALL PROVIDE DEMOLITION IN ACCORDANCE WITH ARCHITECTURAL DRAWINGS.
- 2. THE SCOPE OF THIS PROJECT INCLUDES THE DEMOLITION OF EXISTING, AND THE ADDITION OF NEW PLUMBING FIXTURES AS INDCATED. THE MATERIAL TO BE DEMOLISHED INCLUDES ASSOCIATED PIPING, VALVES, FITTINGS, HANGERS, AND SUPPORTS, FOR PORTION OF PLUMBING SYSTEM IN PRESENT LOCATION AS IMPLIED BY THE NATURE OF THE WORK TO BE REMOVED.
- 3. A COMPLETE DOMESTIC WATER AND SANITARY SEWER PRESSURE TEST WILL BE WITHIN THE SCOPE OF THIS PROJECT. THE PRESSURE TEST SHALL BE CONDUCTED AS INDICATED BY THE REQUIREMENTS OF THE PLUMBING GENERAL NOTES ON SHEET P-1.2
- 4. SAW CUTTING AND PATCHING SHALL BE INCLUDED IN THE SCOPE OF THIS PROJECT, TO ALLOW FOR THE CONNECTION OF UNDERGROUND SERVICES TO NEW OR RELOCATED FIXTURES, AS INDICATED.

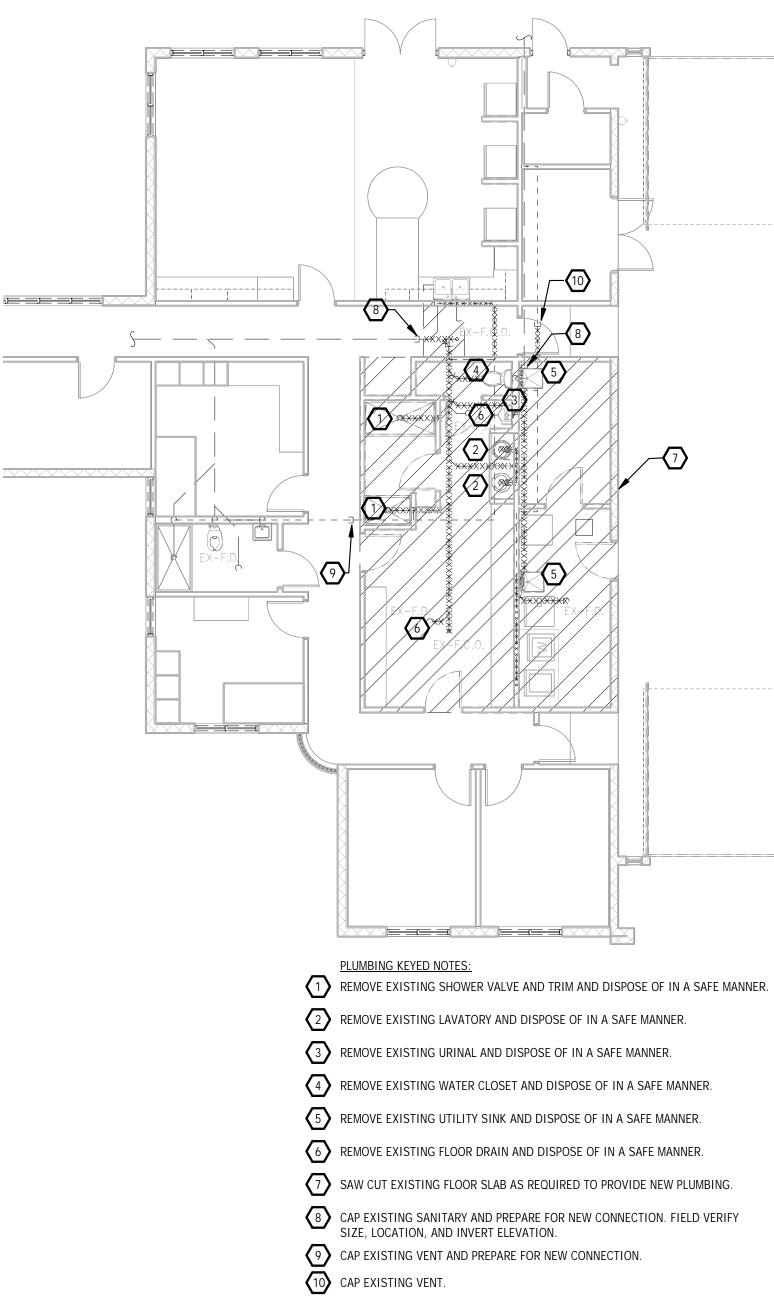


 $\sim$ 

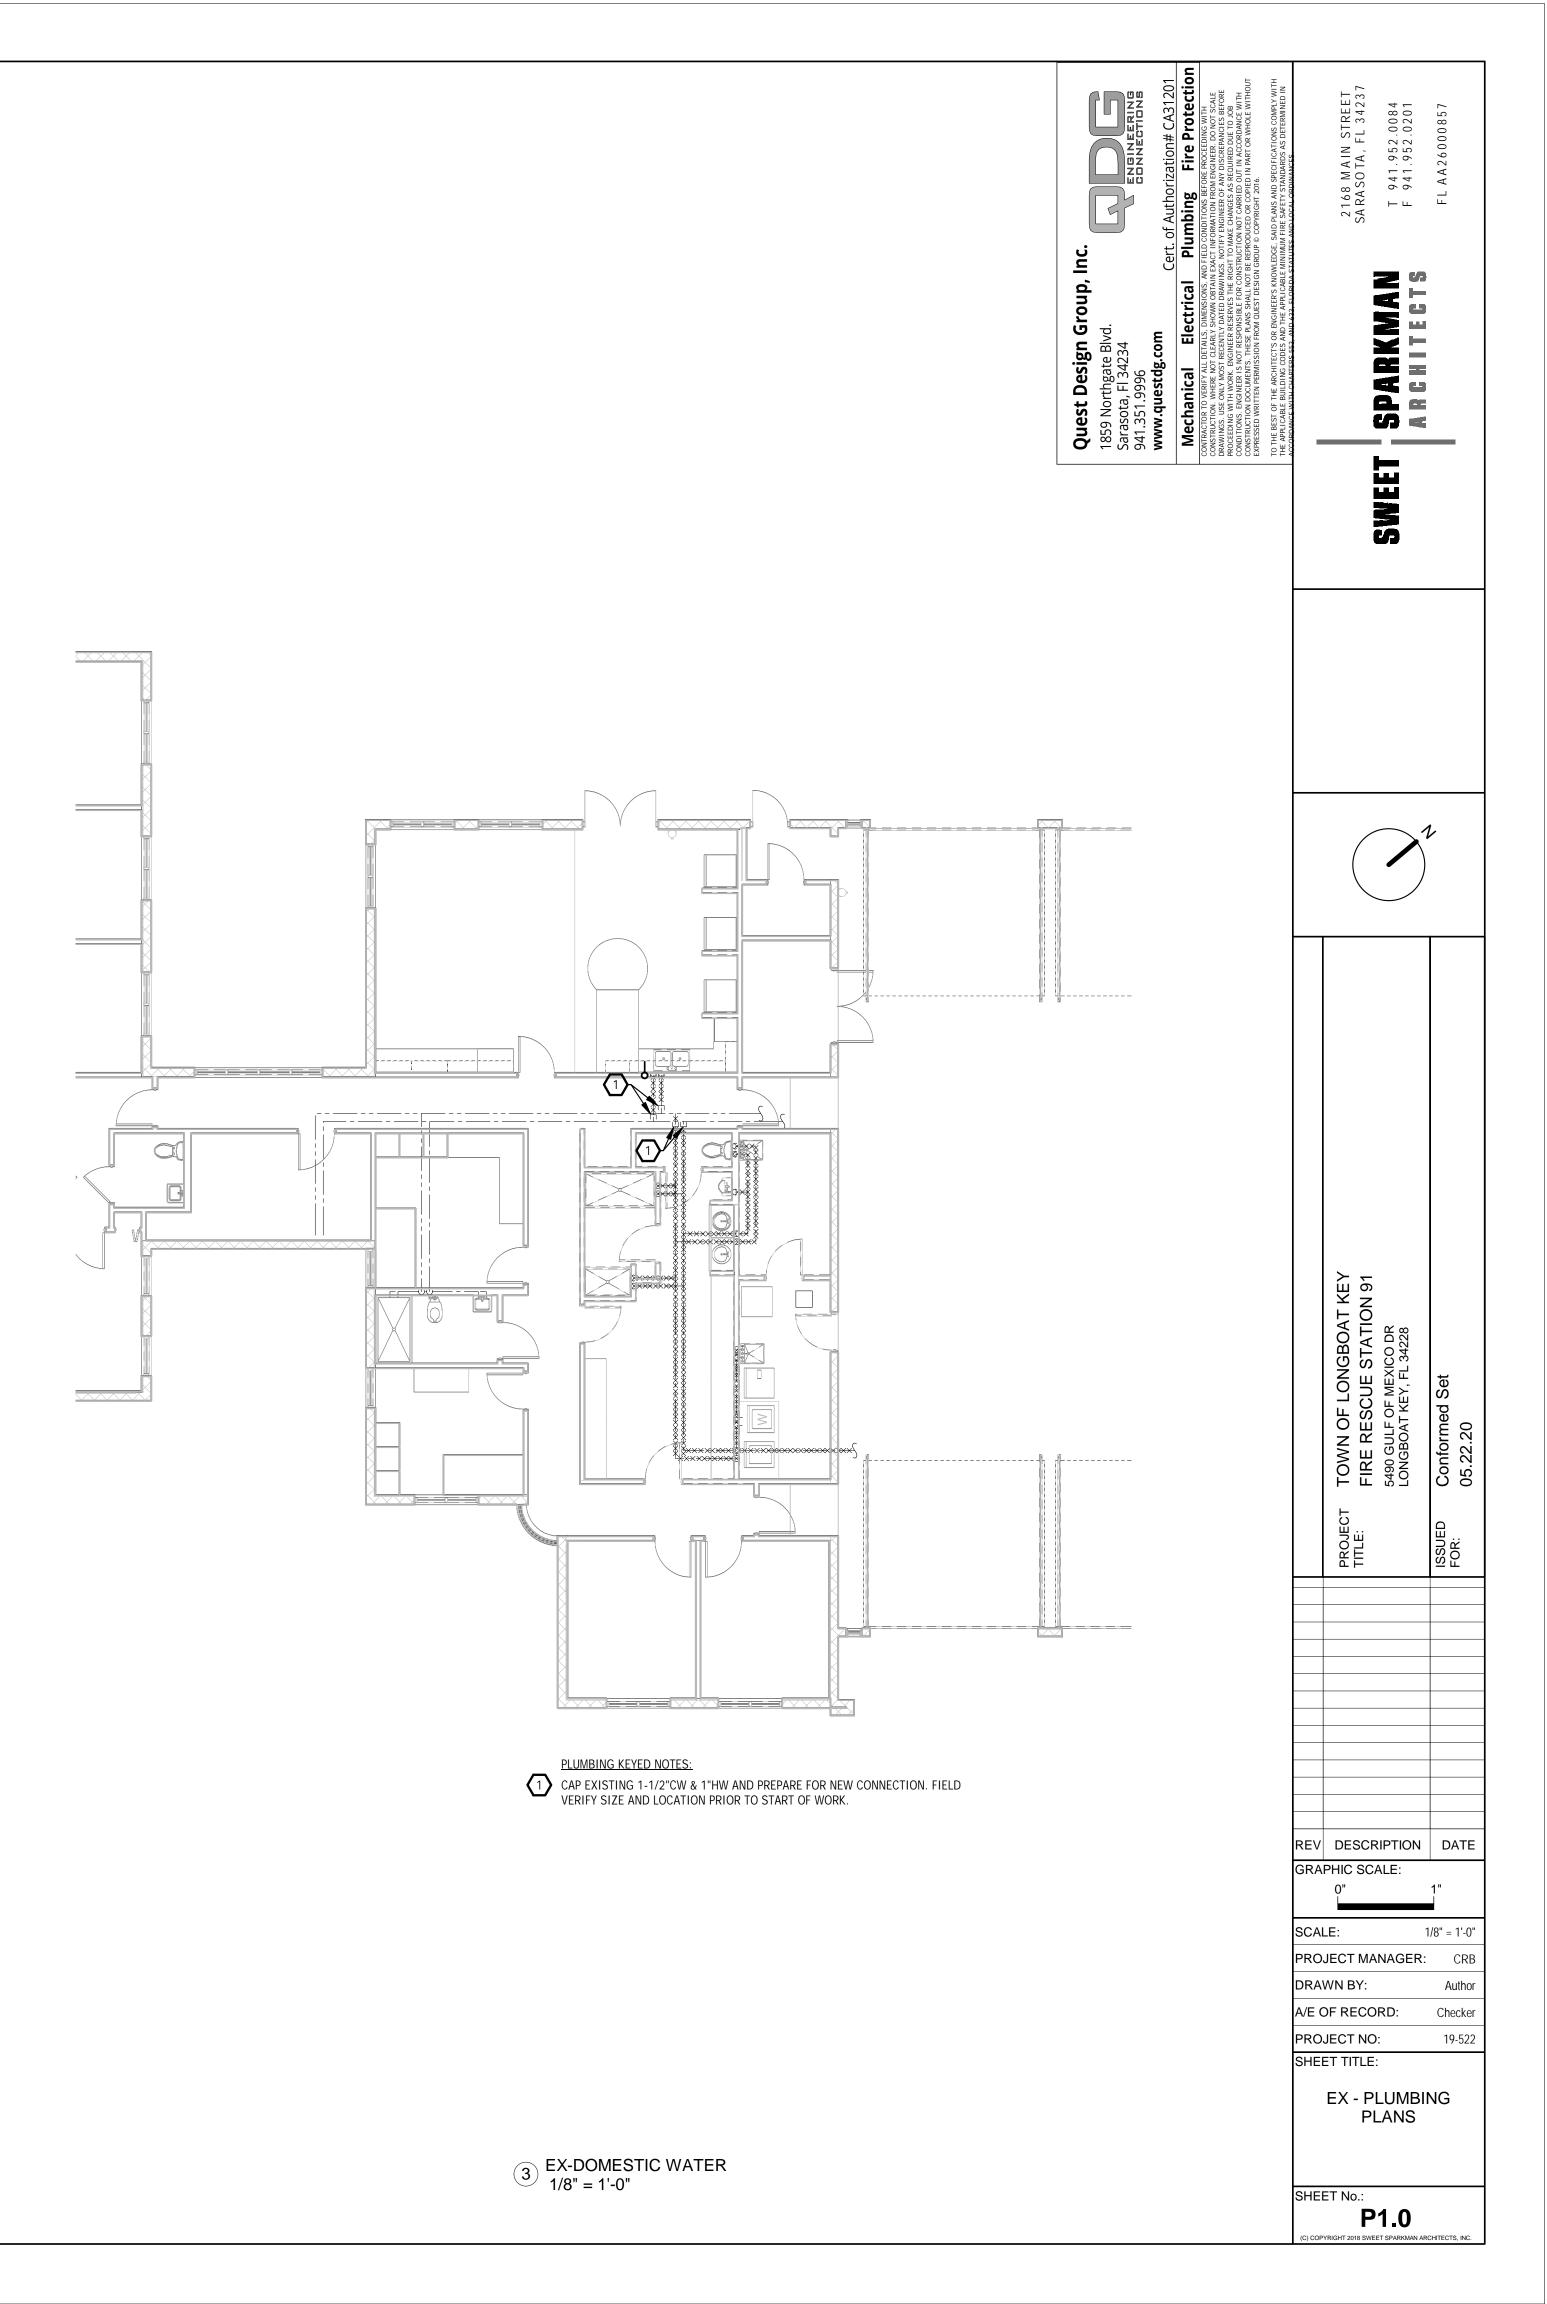

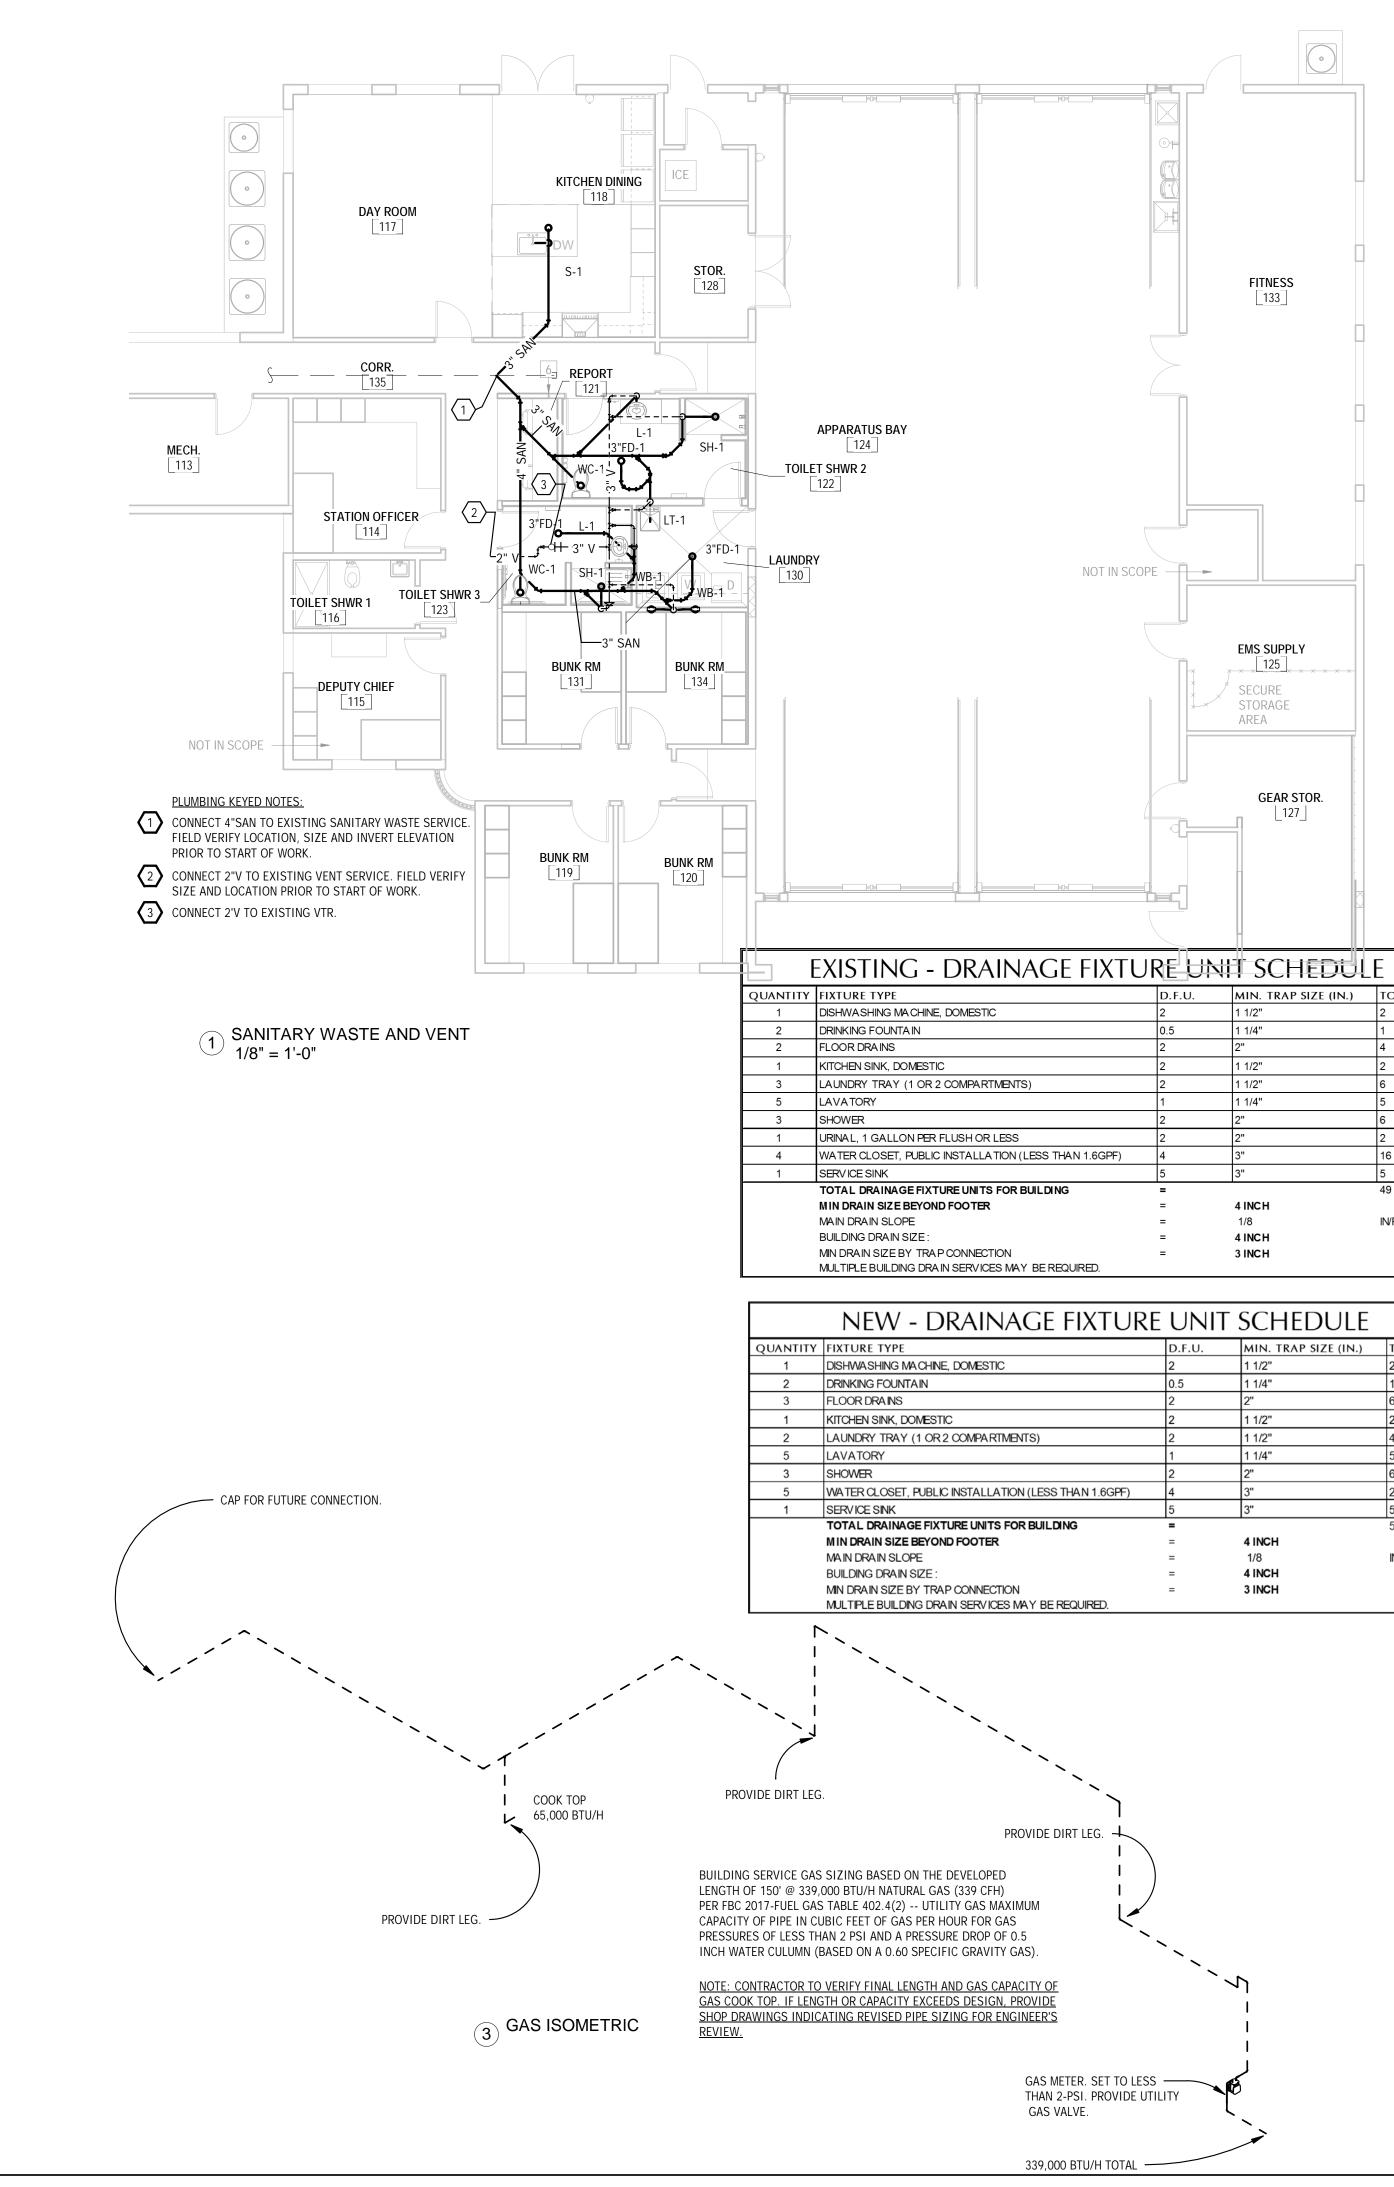

	D.F.U.	MIN. TRAP SIZE (IN.)	TOTAL DFU.
	2	1 1/2"	2
	0.5	1 1/4"	1
	2	2"	4
	2	1 1/2"	2
	2	1 1/2"	6
	1	1 1/4"	5
	2	2"	6
	2	2"	2
THAN 1.6GPF)	4	3"	16
	5	3"	5
NG	=		49
	=	4 INCH	
	=	1/8	IN/FT
	=	4 INCH	
	=	3 INCH	
EQUIRED.			

FIXTUR	e unit	<b>SCHEDULE</b>	
	D.F.U.	MIN. TRAP SIZE (IN.)	TOTAL DFU.
	2	1 1/2"	2
	0.5	1 1/4"	1
	2	2"	6
	2	1 1/2"	2
	2	1 1/2"	4
	1	1 1/4"	5
	2	2"	6
6 THAN 1.6GPF)	4	3"	20
	5	3"	5
DING	=	•	51
	=	4 INCH	
	=	1/8	IN/FT
	=	4 INCH	
	=	3 INCH	
REQUIRED.			

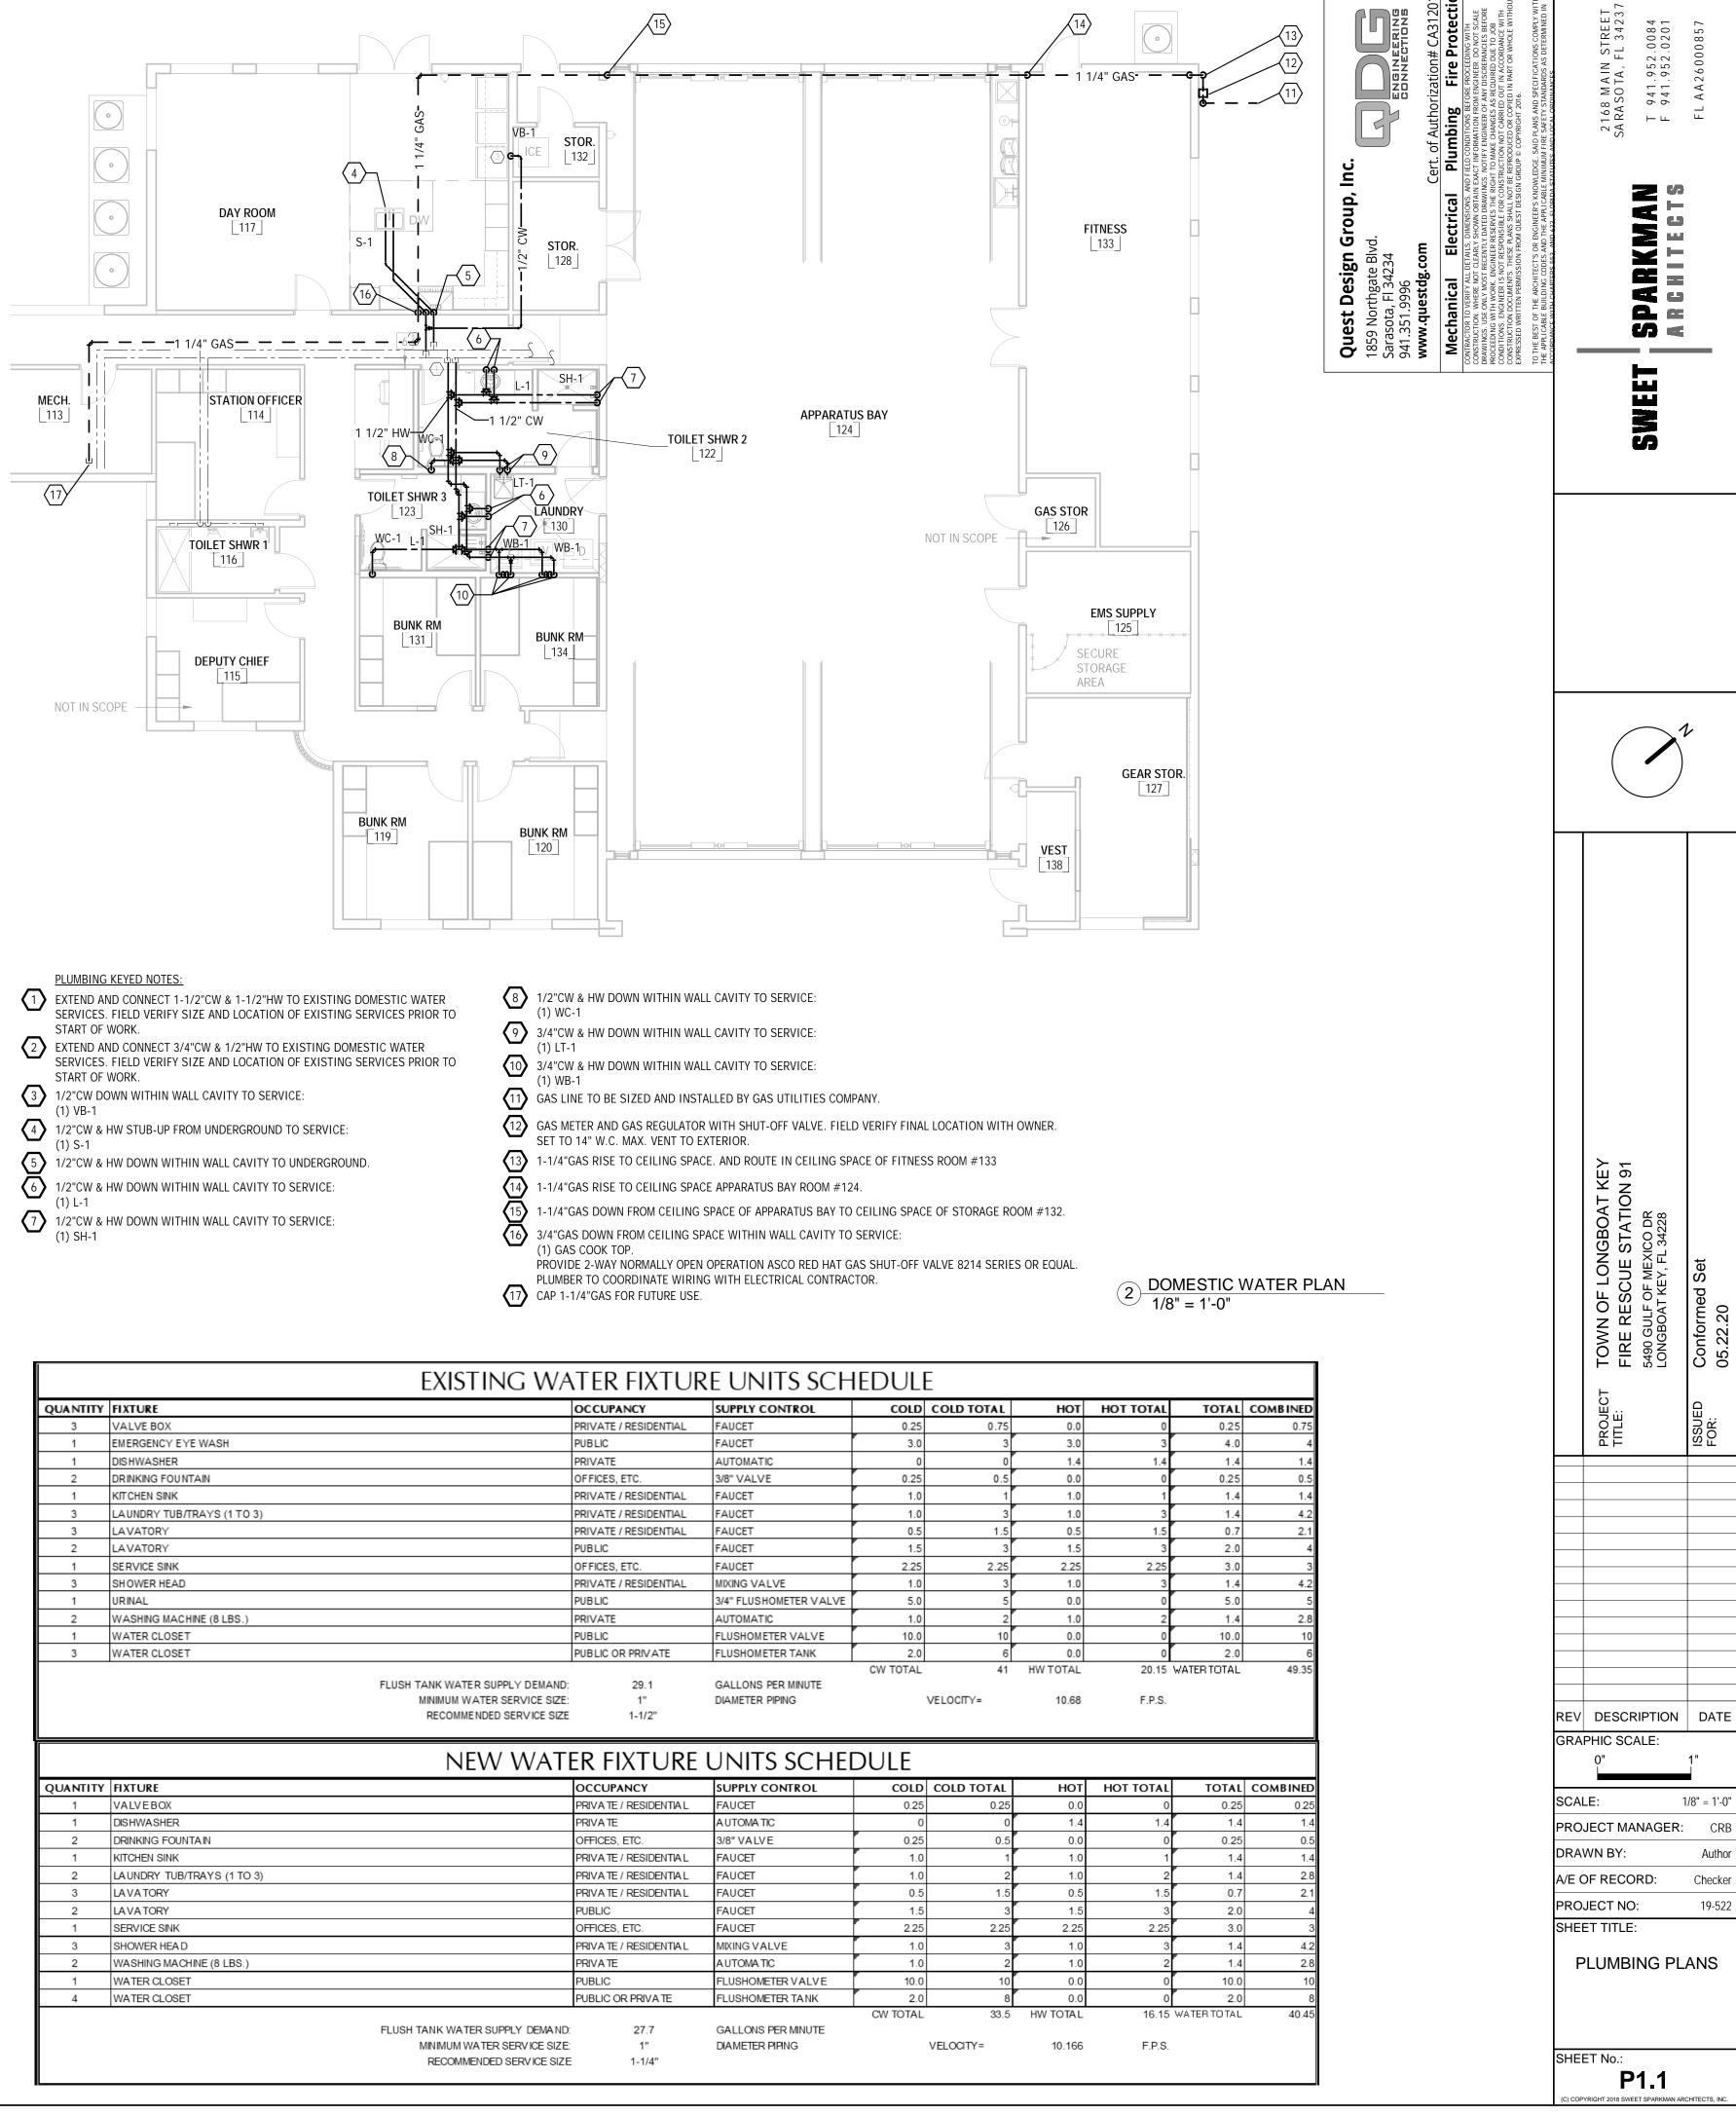

8	1/2"CW & HW DOWN WITHIN WALL CAVITY TO S (1) WC-1
9	3/4"CW & HW DOWN WITHIN WALL CAVITY TO 5 (1) LT-1
	3/4"CW & HW DOWN WITHIN WALL CAVITY TO S (1) WB-1
	GAS LINE TO BE SIZED AND INSTALLED BY GAS
12	GAS METER AND GAS REGULATOR WITH SHUT-O SET TO 14" W.C. MAX. VENT TO EXTERIOR.
(13)	1-1/4"GAS RISE TO CEILING SPACE. AND ROUTI
14	1-1/4"GAS RISE TO CEILING SPACE APPARATUS
(15)	1-1/4"GAS DOWN FROM CEILING SPACE OF APP
16	3/4"GAS DOWN FROM CEILING SPACE WITHIN V (1) GAS COOK TOP.
	PROVIDE 2-WAY NORMALLY OPEN OPERATION A

		existing Wa	TER FIXTUR	E UNIT
QUANTITY	FIXTURE		OCCUPANCY	SUPPLY CON
3	VALVE BOX		PRIVATE / RESIDENTIAL	FAUCET
1	EMERGENCY EYE WASH		PUBLIC	FAUCET
1	DISHWASHER		PRIVATE	AUTOMATIC
2	DRINKING FOUNTAIN		OFFICES, ETC.	3/8" VALVE
1	KITCHEN SINK		PRIVATE / RESIDENTIAL	FAUCET
3	LAUNDRY TUB/TRAYS (1 TO 3)		PRIVATE / RESIDENTIAL	FAUCET
3	LAVATORY		PRIVATE / RESIDENTIAL	FAUCET
2	LAVATORY		PUBLIC	FAUCET
1	SERVICE SINK		OFFICES, ETC.	FAUCET
3	SHOWER HEAD		PRIVATE / RESIDENTIAL	MIXING VALV
1	URINAL		PUBLIC	3/4" FLUSHON
2	WASHING MACHINE (8 LBS.)		PRIVATE	AUTOMATIC
1	WATER CLOSET		PUBLIC	FLUSHOMETE
3	WATER CLOSET		PUBLIC OR PRIVATE	FLUSHOMETE
	FLUSH T	ANK WATER SUPPLY DEMAND:	29.1	GALLONS PE

		NEW WATI	ER FIXTURE	UNITS
QUANTITY	FIXTURE		OCCUPANCY	SUPPLY CON
1	VALVEBOX		PRIVATE / RESIDENTIAL	FAUCET
1	DISHWASHER		PRIVATE	A UTOMA TIC
2	DRINKING FOUNTAIN		OFFICES, ETC.	3/8" VALVE
1	KITCHEN SINK		PRIVATE / RESIDENTIAL	FAUCET
2	LAUNDRY TUB/TRAYS (1 TO 3)		PRIVATE / RESIDENTIAL	FAUCET
3	LAVATORY		PRIVATE / RESIDENTIAL	FAUCET
2	LAVATORY		PUBLIC	FAUCET
1	SERVICE SINK		OFFICES, ETC.	FAUCET
3	SHOWER HEAD		PRIVATE / RESIDENTIAL	MIXING VALVE
2	WASHING MACHINE (8 LBS.)		PRIVA TE	A UTOMA TIC
1	WATER CLOSET		PUBLIC	FLUSHOMETE
4	WATER CLOSET		PUBLIC OR PRIVATE	FLUSHOMETE
				-
		FLUSH TANK WATER SUPPLY DEMAND:	27.7	GALLONS PER
		MINIMUM WATER SERVICE SIZE:	1"	DIAMETER PIP
		RECOMMENDED SERVICE SIZE	1-1/4"	

#### PLUMBING SPECIFICATIONS

#### 1. GENERAL

CONTRACT. DRAWINGS ARE NOT TO BE SCALED. THE ARCHITECTURAL DRAWINGS AND DETAILS SHALL BE EXAMINED ALL APPURTENANCES AS REQUIRED TO ACHIEVE THE OPERATING CONDITIONS AS SHOWN AND SPECIFIED AND FOR EXACT LOCATION OF FIXTURES AND EQUIPMENT. ANY CONFLICT SHALL BE IMMEDIATELY BROUGHT TO THE ATTENTION OF THE ARCHITECT OR ENGINEER BEFORE PROCEEDING WITH THE WORK. PLUMBING CONTRACTOR SHALL SPECIFICATIONS OR IN THE SPECIFICATIONS BUT NOT ON THE DRAWINGS ARE INTENDED TO BE IN BOTH. FURNISH ALL EQUIPMENT, MATERIAL, LABOR, ETC. NECESSARY TO PROVIDE A COMPLETE, WORKABLE AND CODE APPROVED PLUMBING SYSTEM. PLUMBING CONTRACTOR SHALL GIVE ALL NECESSARY NOTICES, OBTAIN ALL PERMITS AND PAY ALL GOVERNMENT FEES, SALES TAXES AND OTHER COSTS IN CONNECTION WITH HIS WORK; FILE ALL NECESSARY APPROVALS OF ALL GOVERNMENTAL DEPARTMENTS HAVING JURISDICTION; OBTAIN ALL REQUIRED CERTIFICATES OF INSPECTION FOR HIS WORK; AND DELIVER TO THE ARCHITECT THE SAME CERTIFICATES BEFORE REQUEST FOR ACCEPTANCE AND FINAL PAYMENT FOR THE WORK. PLUMBING CONTRACTOR SHALL COORDINATE REQUEST FOR ACCEPTANCE AND FINAL PAYMENT FOR THE WORK. PLUMBING CONTRACTOR SHALL COORDINATE CLEARANCES.

#### 2. SHOP DRAWINGS

THE SUBCONTRACTOR SHALL SUBMIT, TO THE ARCHITECT, SIX (6) COPIES OF DETAILED SHOP DRAWINGS OF ALL EQUIPMENT AND ALL MATERIAL REQUIRED TO COMPLETE THE PROJECT. MATERIALS OR PRODUCTS SPECIFIED HEREIN AND/OR INDICATED ON DRAWINGS BY TRADE NAME, MANUFACTURER'S NAME, OR CATALOG NUMBER SHALL BE PROVIDED AS SPECIFIED. SUBMITTALS ARE REQUIRED FOR ALL MATERIAL AND EQUIPMENT WHICH THE CONTRACTOR PROPOSES TO FURNISH. SHOP DRAWINGS MUST BE REVIEWED BY THE ARCHITECT PRIOR TO ORDERING AND INSTALLING EQUIPMENT. DATA SHALL BE COMPILED IN A BOUND, BROCHURE FORM AND ALL SUBMITTED AT ONE TIMF.

SHOP DRAWINGS OR CUT SHEETS REQUIRED INCLUDE, PLUMBING FIXTURES AND WATER HEATERS. ALL WORK SHALL BE DONE IN ACCORDANCE WITH THESE PLANS, SPECIFICATIONS, LOCAL, STATE AND, NATIONAL CODES.

#### 3. PRODUCTS

PROVIDE FACTORY FABRICATED FIXTURES OF TYPE, STYLE, AND MATERIAL INDICATED ON THE PLANS. FOR EACH FIXTURE PROVIDE FIXTURE MANUFACTURER'S STANDARD TRIM, CARRIERS, SEATS, AND VALVES AS RECOMMENDED BY 7. THE PLUMBING CONTRACTOR SHALL COORDINATE WITH ALL TRADES FOR PIPE ROUTING AND INSTALLATION THE MANUFACTURER. ALL FIXTURES AND TRIMS OF THE SAME TYPE SHALL BE FURNISHED BY A SINGLE MANUFACTURER. WHERE TYPE IS NOT OTHERWISE INDICATED, PROVIDE FIXTURES COMPLYING WITH GOVERNING REGULATIONS. PROVIDE MANUFACTURER'S STANDARD EXPOSED FIXTURE BOLT CAPS FINISHED TO MATCH FIXTURE FINISH. UNLESS OTHERWISE NOTED, VALVES AND SPECIALTY ITEMS ARE TO BE RATED AT 125 PSIG. DEVICES AND VALVES 2-1/2" AND SMALLER ARE TO HAVE SOLDERED OR SCREWED CONNECTIONS AND THOSE 3" AND LARGER ARE TO HAVE FLANGED CONNECTIONS. GATE VALVES TO BE NIBCO MODEL #T-113 OR #S-113 ALL BRONZE. FIXTURES ARE TO BE OF "1ST QUALITY". ALL EXPOSED METAL PARTS OF FIXTURES SHALL BE POLISHED CHROME.

#### 4. MISCELLANEOUS

PROVIDE MANUAL SHUTOFF VALVES AND CONNECTING STEM PIPES TO PERMIT SERVICING OF PLUMBING FIXTURES WITHOUT SHUT-DOWN OF SUPPLY PIPING SYSTEM. PROVIDE REMOVABLE P-TRAPS WHERE DRAINS ARE INDICATED FOR DIRECT CONNECTION TO DRAINAGE SYSTEM. PROVIDE AERATORS OF TYPES APPROVED BY HEALTH DEPARTMENT HAVING JURISDICTION. PROVIDE DIELECTRIC UNIONS OR FITTINGS WHENEVER FERROUS AND NON-FERROUS PIPES ARE JOINED. PROVIDE AIR CHAMBERS/WATER HAMMER ARRESTORS ON HOT AND COLD WATER LINES AS REQUIRED. AIR CHAMBERS SHALL BE FULL LINE SIZE IN DIAMETER AND EQUIVALENT TO 20 PIPE DIAMETERS, BUT NOT LESS THAN 12" IN LENGTH. PROVIDE ACCESS DOORS WHERE NECESSARY TO SERVICE SEALS, VALVES, TRAPS, CLEAN OUTS, AIR CHAMBERS/WATER HAMMER ARRESTORS, ETC. EXACT FLOOR DRAIN LOCATION SHALL BE COORDINATED WITH ARCHITECT PRIOR TO ROUGH-IN.

#### 5. WORKING DRAWINGS

THE CONTRACTOR SHALL KEEP ACCURATE RECORDS OF ACTUAL CONSTRUCTION INCLUDING DEVICE LOCATIONS IF DIFFERENT FROM THE PLANS. WORKING DRAWINGS SHALL BE KEPT AT THE JOB SITE AND MADE AVAILABLE TO THE ENGINEER OR AUTHORITY HAVING JURISDICTION UPON REQUEST. THE CONTRACTOR SHALL PROVIDE THE OWNER WITH A REPRODUCIBLE SET OF PLANS OF THE COMPLETE PLUMBING SYSTEMS AS INSTALLED (AS-BUILT DRAWINGS). THE SCALE ON THESE AS-BUILT DRAWINGS SHALL BE NO SMALLER THAN THE SCALE USED ON THE ORIGINAL PLANS. AS-BUILT DRAWINGS SHALL BE PROFESSIONALLY DRAWN USING GOOD DRAFTING TECHNIQUES OR AUTOCAD. UPON COMPLETION OF THE JOB, THE CONTRACTOR SHALL SUPPLY ACAD QUALITY

AS-BUILT DRAWINGS SHOWING ANY DEVIATION FROM THE ORIGINAL DRAWINGS. THESE DRAWINGS SHALL INDICATE DIMENSIONS OF BURIED UTILITY LINES FROM BUILDING WALLS.

#### 6. TESTING

FINAL TESTS SHALL BE MADE ONLY AFTER THE ARCHITECT IS SATISFIED THAT ALL WORK HAS BEEN COMPLETED INCLUDING REVIEW FOR DAMAGE TO FINISH. REMOVE CRACKED OR DENTED UNITS. ALL PIPING INSTALLED ON THE 14. OFFER REMOVED MATERIAL TO THE OWNER. REMOVE ALL MATERIAL REJECTED BY THE OWNER FROM THE PROJECT UNLESS SPECIFICALLY SHOWN OTHERWISE SHALL BE HYDRAULICALLY TESTED AS SPECIFIED HEREIN. THE PLUMBING CONTRACTOR SHALL PROVIDE ALL EQUIPMENT REQUIRED TO MAKE THE TESTS SPECIFIED AS FOLLOWS:

- A. DURATION OF TESTS: ALL TESTS SHALL APPLY FULL TEST PRESSURE TO THE PIPING FOR A MINIMUM OF 24 HOURS OR AS REQUIRED BY CODE. B. PRESSURE OF TESTS: WATER PIPING SHALL BE HYDRO-TESTED AT 150% OF THE NORMAL WORKING
- PRESSURE (100 PSI MINIMUM). TEST SANITARY WASTE AND VENT PIPING BY A 10' WATER COLUMN FOR TWENTY FOUR (24) HOURS OR AS REQUIRED BY THE BUILDING DEPARTMENT.
- C. INABILITY TO HOLD PRESSURE: WHEN THE TEST PRESSURE HAS FALLEN OVER 5% DURING THE 24 HOURS TEST PERIOD, THE POINT OF LEAKAGE SHALL BE FOUND, REPAIRED AND THE TEST REPEATED. THIS PROCEDURE SHALL BE FOLLOWED UNTIL THE PIPING SYSTEM HAS BEEN PROVEN TIGHT.

AFTER THE TESTS ARE COMPLETED AND BEFORE THE SYSTEM IS PUT IN OPERATION THE ENTIRE WATER PIPE SYSTEM SHALL BE FILLED WITH A SOLUTION CONTAINING NOT LESS THAN 50 PARTS PER MILLION OF AVAILABLE CHLORINE AND ALLOWED TO STAND 6 HOURS BEFORE FLUSHING. DURING THIS PERIOD A PRESSURE OF NOT LESS THAN 40 PSI SHALL BE MAINTAINED ON THE SYSTEM AND ALL VALVES SHALL BE OPENED AND CLOSED SEVERAL TIMES. AFTER DISINFECTING, A SAMPLE SHALL BE DRAWN AND TESTED BY THE LOCAL HEALTH DEPARTMENT AND A LETTER CERTIFYING THE ADEQUACY OF THE WATER FOR HUMAN CONSUMPTION SHALL BE SENT TO THE ENGINEER FOR APPROVAL. SHOULD THE SAMPLE NOT PASS THE HEALTH DEPARTMENT TEST, THEN THE SYSTEM SHALL BE DRAINED AND DISINFECTED UNTIL THE WATER PASSES INSPECTION BY THE HEALTH DEPARTMENT.

#### 7. FINAL ACCEPTANCE

AFTER TESTING A FINAL REVIEW SHALL BE MADE BY THE ARCHITECT AND OTHER AUTHORIZED PERSONS WITH THE PLUMBING CONTRACTOR. FINAL ACCEPTANCE OF THE PROJECT SHALL NOT PREJUDICE THE OWNER'S RIGHT TO REQUIRE REPLACEMENT AND/OR REPAIR OF ANY DEFECTIVE WORK OR MATERIALS.

#### 8. WARRANTY

ALL PARTS, MATERIAL, EQUIPMENT AND LABOR FURNISHED UNDER THIS SECTION OF THE SPECIFICATIONS SHALL BEAR A ONE (1) YEAR WARRANTY FROM DATE OF FINAL ACCEPTANCE. ALL WORK PERFORMED UNDER THIS WARRANTY SHALL BE AT NO COST TO THE OWNER, THE PLUMBING CONTRACTOR SHALL PROVIDE ALL OF THE ABOVE WARRANTY REQUIREMENTS IN A WRITTEN STATEMENT ALONG WITH EQUIPMENT MANUFACTURER'S WARRANTIES.

#### 9. ERRORS AND OMISSIONS

ANY AND ALL OBVIOUS ERRORS AND/OR OMISSIONS IN THE PLANS, SPECIFICATIONS, AND CONTRACT DOCUMENTS SHALL BE CALLED TO THE ATTENTION OF THE ARCHITECT OR ENGINEER AT LEAST FOURTEEN (14) DAYS PRIOR TO THE BID DATE. IF PROPER NOTIFICATION IS NOT RECEIVED, NO ADDITIONS TO THE CONTRACT AMOUNT WILL BE AUTHORIZED FOR THIS WORK. IN THE EVENT THERE IS A CONFLICT IN THE PLANS AND MORE THAN ONE SYSTEM IS AUTHORIZED FOR THIS WORK. IN THE EVENT THERE IS A CONFLICT IN THE PLANS AND MORE THAN ONE SYSTEM IS DESCRIBED, SPECIFIED OR OTHERWISE INDICATED, THE OWNER RESERVES THE RIGHT TO SELECT WHICH SYSTEM SHALL BE INSTALLED. IN THE EVENT A SYSTEM IS IDENTIFIED BY DESCRIPTION OR PERFORMANCE ONLY, THE CONTRACTOR SHALL PROVIDE SHOP DRAWINGS WITH PRODUCT SUBMITTALS INDICATING THE COMPLETE WORKING ARRANGEMENT OF THE PROPOSED INSTALLATION FOR REVIEW BY THE OWNER. THE OWNER RESERVES THE RIGHT TO REJECT ANY AND ALL COMPONENTS OR OPERATING SEQUENCES. END OF PLUMBING SPECIFICATIONS

#### PLUMBING GENERAL NOTES:

1. DRAWINGS ARE DIAGRAMMATIC AND INDICATE THE GENERAL ARRANGEMENT OF SYSTEMS AND WORK INCLUDED IN THE CONTRACT. DRAWINGS ARE NOT TO BE SCALED. THE ARCHITECTURAL DRAWINGS AND DRAWINGS ARE DIAGRAMMATIC AND INDICATE THE GENERAL ARRANGEMENT OF SYSTEMS AND WORK INCLUDED IN THE DETAILS SHALL BE EXAMINED FOR EXACT LOCATION OF FIXTURES AND EQUIPMENT. SYSTEMS SHALL INCLUDE SHALL RESULT IN A SUPERIOR INSTALLATION. INFORMATION CONTAINED ON THE DRAWINGS BUT NOT IN THE MINOR DETAILS NOT USUALLY SHOWN OR SPECIFIED BUT NECESSARY FOR PROPER OPERATION AND CONSISTENT WITH GOOD WORKMANSHIP WILL BE INCLUDED IN THE ESTIMATE, THE SAME AS IF SHOWN ON THE DRAWINGS. ANY CONFLICT SHALL BE IMMEDIATELY BROUGHT TO THE ATTENTION OF THE ARCHITECT OR ENGINEER BEFORE PROCEEDING WITH THE WORK.

> 2. THE PLUMBING CONTRACTOR SHALL FURNISH ALL EQUIPMENT, MATERIAL, LABOR, ETC. NECESSARY TO PROVIDE A COMPLETE, WORKABLE AND CODE APPROVED PLUMBING SYSTEM. ALL WORK SHALL BE DONE IN ACCORDANCE WITH THESE PLANS AND SPECIFICATIONS, LOCAL, STATE AND NATIONAL CODES.

3. THE PLUMBING CONTRACTOR SHALL GIVE ALL NECESSARY NOTICES, OBTAIN ALL PERMITS AND PAY ALL GOVERNMENT FEES, SALES TAXES AND OTHER COSTS IN CONNECTION WITH HIS WORK; FILE ALL NECESSARY APPROVALS OF ALL GOVERNMENTAL DEPARTMENTS HAVING JURISDICTION; OBTAIN ALL REQUIRED CERTIFICATES OF INSPECTION FOR HIS WORK; AND DELIVER TO THE ARCHITECT THE SAME CERTIFICATES BEFORE REQUEST FOR ACCEPTANCE AND FINAL PAYMENT FOR THE WORK.

4. ALL WORK SHALL BE GUARANTEED, BOTH MATERIAL AND INSTALLATION, FOR A PERIOD OF ONE YEAR FROM ACCEPTANCE BY OWNER.

5. FURNISH SIX (6) COPIES OF SHOP DRAWINGS OF EQUIPMENT OR FIXTURES FOR APPROVAL PRIOR TO PURCHASING.

6. CONTRACTOR SHALL KEEP A RECORD OF THE LOCATIONS OF ALL CONCEALED WORK AND UPON COMPLETION OF THE JOB, SHALL SUPPLY ACAD QUALITY AS-BUILT DRAWINGS SHOWING ANY DEVIATION FROM THE ORIGINAL DRAWINGS. THESE DRAWINGS SHALL INDICATE DIMENSIONS OF BURIED UTILITY LINES FROM BUILDING WALLS.

OF EQUIPMENT AND SYSTEMS TO PROVIDE FOR REQUIRED CLEARANCES.

8. ALL OPENINGS THROUGH FIRE RATED WALLS OR FLOORS SHALL BE SEALED WITH A U.L. LISTED PENETRATION AND SHALL MAINTAIN THE FIRE RATED INTEGRITY OF THE WALL OR FLOOR. THE CONTRACTOR SHALL VERIFY FIRE RATINGS WITH ARCHITECTURAL DRAWINGS PRIOR TO INSTALLATION.

9. PIPE PASSING THROUGH PIT WALLS, BUILDING WALLS, AND BUILDING FLOORS BELOW GRADE SHALL BE PROVIDED WITH SLEEVES OF STANDARD WEIGHT GALVANIZED STEEL PIPE. THE ANNULAR SPACES BETWEEN PIPE AND SLEEVES SHALL BE SEALED WITH LINK SEAL HYDROSTATIC PIPE WALL SEAL. SLEEVES SHALL BE SIZED AS FOLLOWS:

3" PIPE - 6" ID SLEEVE	
4" PIPE - 8" ID SLEEVE	
5" PIPE - 10" ID SLEEVE	
3" PIPE - 12" ID SLEEVE	
10" PIPE - 12" ID SLEEVE	

10. BREAKAGE AND CORROSION: PIPES PASSING UNDER OR THROUGH WALLS SHALL BE PROTECTED FROM BREAKAGE. PIPES PASSING THROUGH CONCRETE OR CINDER WALLS AND FLOORS OR OTHER CORROSIVE MATERIAL SHALL BE PROTECTED AGAINST EXTERNAL CORROSION BY A PROTECTIVE SHEATHING OR WRAPPING OR OTHER MEANS THAT WILL WITHSTAND ANY REACTION FROM LIME AND ACID OF CONCRETE, CINDER OR OTHER CORROSIVE MATERIAL. SHEATHING OR WRAPPING SHALL ALLOW FOR EXPANSION AND CONTRACTION OF PIPING TO PREVENT ANY RUBBING ACTION. MINIMUM WALL THICKNESS OF MATERIAL IS TO BE 0.025 INCH.

11. PROVIDE WALL CARRIERS FOR ALL WALL HUNG PLUMBING FIXTURES. ALL WALL HUNG PLUMBING FIXTURES SHALL BE CAPABLE OF SUPPORTING A 250 POUND VERTICAL LOAD.

12. THE PLUMBING CONTRACTOR SHALL VERIFY SIZE AND LOCATION OF ALL EXISTING SERVICES PRIOR TO COMMENCING WITH THE WORK.

13. CONTRACTOR SHALL EXTEND AS NECESSARY AND CONNECT BUILDING DRAIN AND POTABLE WATER LINES TO EXISTING SERVICE LINES AT LOCATION ON SITE OR IN BUILDING AS REQUIRED. VERIFY EXACT LOCATION AND INVERT ELEVATION OF SERVICE CONNECTIONS PRIOR TO CONSTRUCTION. CONTRACTOR SHALL NOTIFY ENGINEER IMMEDIATELY IF THE DISTANCE TO SITE SERVICES EXCEED TEN (10) LINEAR FEET FROM THE BUII DING.

WORK SITE AND DISPOSE OF IN ACCORDANCE WITH APPLICABLE LOCAL, STATE AND NATIONAL CODES. CONTRACTOR MUST CERTIFY TO OWNER THAT THE MATERIAL HAS BEEN LEGALLY DISPOSED OF.

#### POTABLE WATER PIPING:

16. ABOVE GROUND WATER PIPING SHALL BE TYPE "L" COPPER WITH WROUGHT COPPER FITTINGS AND 95-5 SOLDERED JOINTS.

17. INTERIOR ABOVE AND BELOW GROUND WATER PIPING SHALL BE (CPVC) CHLORINATE POLYVINYL CHLORIDE PLASTIC PIPE AND TUBING (ASTM D-2846) FLOWGUARD OR EQUIVALENT WITH APPROVED CPVC SOLVENT WELDED FITTINGS. CPVC WATER PIPING SHALL NOT BE RUN IN RETURN AIR PLENUM OR FIRE RATED ASSEMBLIES UNLESS ALLOWED BY LOCAL JURISDICTION.

18. EXTERIOR BUILDING SERVICE SHALL BE SCHEDULE 40 PVC (ASTM D-1785) WITH APPROVED PVC SOLVENT WELDED FITTINGS.

19. INTERIOR ABOVE AND BELOW GRADE HIGH TEMPERATURE HOT WATER (140°F OR GREATER) PIPING SHALL BE TYPE "L" HARD DRAWN COPPER TUBE WITH COPPER FITTINGS AND 95-5 SOLDERED JOINTS. 21. THE BACKFLOW PREVENTOR AND THE WATER METER ARE EXISTING TO REMAIN.

23. PROVIDE WATER HAMMER ARRESTORS ON HOT AND COLD WATER LINES ON ALL QUICK CLOSING DEVICES PER CHAPTER 6 OF FLORIDA BUILDING CODE PLUMBING.

24. PROVIDE VACUUM BREAKERS AS REQUIRED BY CODE.

25. TEST ALL WATER PIPING AT 100 PSIG FOR TWENTY-FOUR (24) HOURS OR AS REQUIRED BY CODE.

26. STERILIZE ALL WATER PIPING IN ACCORDANCE WITH HEALTH DEPARTMENT REGULATIONS AND AMERICAN WATER WORKS SPECIFICATIONS.

27. SUPPORT ALL WATER PIPING WITH PIPE HANGERS BY GRINNELL OR EQUAL. 28. PROVIDE RISER CLAMPS AT EACH FLOOR FOR ALL VERTICAL PIPING INCLUDING SANITARY DRAINS, VENTS, AND WATER LINES. INSTALL RISERS SO AS TO ALLOW VERTICAL MOVEMENT OF PIPING, ANCHORING PIPES AT THE BASE OF ALL RISERS.

29. PROVIDE ACCESS DOORS WHERE NECESSARY TO SERVICE SEALS, VALVES, TRAPS, CLEAN-OUTS, AIR CHAMBERS/WATER HAMMER ARRESTORS, ETC. ALL ACCESS DOORS IN TOILET ROOMS SHALL BE STAINLESS STEEL

30. PROVIDE DIELECTRIC UNIONS OR FITTINGS WHENEVER FERROUS AND NON-FERROUS PIPES ARE JOINED. 31. INSULATE HOT WATER PIPING WITH 1 INCH ARMSTRONG AP ARMAFLEX UP TO AND INCLUDING 1 1/4-INCH

32. INSULATE HOT WATER PIPING OVER 1 1/4-INCH WITH 1 INCH THICK FIBERGLASS PIPE COVERING FINISHED WITH WHITE MASTIC. FITTINGS SHALL BE INSULATED WITH MITERED PIPE COVERING FINISHED WITH WHITE MASTIC OR PVC FITTING COVERS.

33. HANDICAPPED LAVATORIES: INSULATE WATER SUPPLIES AND WASTE PIPING REQUIRING ADA CONFORMANCE, WITH LAV-GUARD KITS, BY TRUEBRO OR EQUAL

DIAMETER. SECURE WITH ADHESIVE.

34. THIS SYSTEM WAS DESIGNED TO 50 PSI STATIC PRESSURE WITH RESIDUAL PRESSURE OF 20 PSI AT 1000 GPM FROM THE NEAREST FIRE HYDRANT. THESE CONDITIONS SHALL BE VERIFIED BY THE PLUMBING CONTRACTOR PRIOR TO PROCEEDING WITH THE INSTALLATION. NOTIFY THE ENGINEER IMMEDIATELY IF FLOW AND PRESSURES OBTAINED ARE BELOW THOSE CONTAINED IN THIS PARAGRAPH.

SANITARY WASTE AND VENT PIPING

36. SANITARY WASTE AND VENT PIPING SHALL BE SCHEDULE 40 PVC (ASTM D-2665) WITH APPROVED PVC SOLVENT WELDED FITTINGS. COMPLY WITH 2017 FLORIDA BUILDING CODE. PVC PIPING SHALL NOT BE RUN IN RETURN AIR PLENUM OR FIRE RATED ASSEMBLIES.

37. SANITARY WASTE AND VENT PIPING SHALL BE SERVICE WEIGHT CAST IRON, NO-HUB WITH STAINLESS STEEL CLAMPS AND SHIELDS WITH NEOPRENE SEALING SLEEVES.

38. ALL SOIL AND WASTE PIPING, 2-1/2" AND SMALLER, SHALL BE SLOPED AT 1/4" PER FOOT. LARGER WASTE PIPING SHALL BE SLOPED AT 1/8" PER FOOT.

39. TEST SANITARY WASTE AND VENT PIPING BY A 10' WATER COLUMN FOR TWENTY-FOUR (24) HOURS OR AS REQUIRED BY THE BUILDING DEPARTMENT.

42. FLOOR DRAINS TO HAVE 4-INCH DEEP SEAL TRAPS. EXACT DRAIN LOCATION SHALL BE COORDINATED WITH ARCHITECT PRIOR TO ROUGH IN.

43. FLOOR SINKS TO HAVE 4-INCH DEEP SEAL TRAPS. EXACT DRAIN LOCATION SHALL BE COORDINATED WITH ARCHITECT PRIOR TO ROUGH IN.

44. PROVIDE TRAP PRIMERS FOR ALL FLOOR DRAINS AND HUB DRAINS THAT ARE NOT CONTINUOUSLY WASHED BY AN APPLIANCE OR FIXTURE.

<u>MISCELLANEOUS</u>

78. THE POOL SUPPLIER SHALL ONLY USE CARTRIDGE FILTERS. BACKWASH TYPE FILTERS ARE NOT ALLOWED. 79. POOL WATER SHALL BE DECHLORINATED PRIOR TO DISCHARGE INTO THE MAIN POOL DRAIN. CONTRACT THE

LOCAL POOL SUPPLY COMPANY FOR MEANS AND METHODS OF THE DECHLORINATION PROCESS. 80. TRASH CHUTES:

81. PLUMBING CONTRACTOR SHALL PROVIDE A 3/4 INCH WATER LINE TO TRASH CHUTE FOR CONNECTION TO TRASH FLUSHING SPRAY HEAD ABOVE HIGHEST INTAKE. PLUMBING CONTRACTOR SHALL COORDINATE WITH OWNER AND TRASH CHUTE INSTALLER FOR ALL PLUMBING SERVICES REQUIRED FOR TRASH CHUTE OPERATION.

82. PROVIDE AND INSTALL SHUT OFF VALVES AND SECTIONAL VALVES AS REQUIRED BY APPLICABLE FLORIDA BUILDING CODES AND PLUMBING SPECIFICATION SECTIONS.

83. PIPE ROUTING IS SHOWN DIAGRAMMATICALLY AND DOES NOT SHOW ALL OFFSETS, DROPS, AND RISES OF RUNS. THE CONTRACTOR SHALL ALLOW IN HIS PRICE FOR ROUTING OF PIPE TO AVOID OBSTRUCTIONS. COORDINATION WITH UTILITY SERVICES, INCLUDING THOSE OF OTHER TRADES IS REQUIRED. MAINTAIN HEADROOM AND SPACE LOCATIONS.

84. INSTALL WORK AS TO BE READILY ACCESSIBLE FOR OPERATION, MAINTENANCE, AND REPAIR. MINOR DEVIATIONS FROM DRAWINGS MAY BE MADE TO ACCOMPLISH THIS, BUT CHANGES WHICH INVOLVE EXTRA COST SHALL NOT BE MADE WITHOUT APPROVAL.

85. ALL MATERIALS AND EQUIPMENT TO BE NEW UNLESS OTHERWISE NOTED AND SHALL BE IN ACCORDANCE WITH BUILDING STANDARDS. ALL MATERIALS AND EQUIPMENT ON SITE SHALL BE PROPERLY STORED SUCH THAT IT IS PROTECTED FROM DAMAGE AND EXPOSURE.

86. THE FINAL ACCEPTANCE WILL BE MADE AFTER THE CONTRACTOR HAS ADJUSTED HIS EQUIPMENT, TESTED THE VARIOUS SYSTEMS, DEMONSTRATED THAT IT FULFILLS THE REQUIREMENTS OF THE DRAWINGS AND SPECIFICATIONS, HAS FURNISHED ALL THE REQUIRED CERTIFICATIONS OF INSPECTION AND APPROVAL, AND SUBMITTED ALL THE NECESSARY CLOSE-OUT DOCUMENTS.

87. UPON COMPLETION AND ACCEPTANCE OF WORK, CONTRACTOR SHALL FURNISH WRITTEN INSTRUCTIONS AND EQUIPMENT MANUALS AND DEMONSTRATE TO THE OWNER THE PROPER OPERATION AND MAINTENANCE OF ALL EQUIPMENT AND APPARATUS FURNISHED UNDER THIS CONTRACT. THESE INSTRUCTIONS SHALL BE TYPED ON 8-1/2 IN. X 11 IN. PAPER AND BOUND IN THREE RING BINDERS WITH CLEAR ACETATE COVERS. CONTRACTOR SHALL GIVE THREE COPIES OF THE INSTRUCTIONS TO THE OWNER AND ONE COPY TO THE ENGINEER. THE INSTRUCTION BOOKLET SHALL BEAR THE NAME, ADDRESS, AND TELEPHONE NUMBER OF THE GENERAL CONTRACTOR, PLUMBING CONTRACTOR, ARCHITECT, AND ENGINEER. REPRODUCIBLE "AS-BUILT" DRAWINGS SHALL BE PROVIDED INDICATING THE AS INSTALLED CONDITIONS OF THE WORK. "AS-BUILT" DRAWINGS SHALL BE PROVIDED TO THE ARCHITECT AFTER COMPLETION OF THE INSTALLATION.

88. ALL VALVES AND SPECIALTY ITEMS MAY NOT BE SHOWN IN EVERY INSTANCE ON THE DRAWINGS, BUT ARE TO BE PROVIDED WHETHER SHOWN OR NOT WHEN NECESSARY FOR PROPER OPERATION AND MAINTENANCE OF THE SYSTEM.

UNLESS OTHERWISE NOTED, VALVES AND SPECIALTY ITEMS ARE TO BE RATED AT 125 PSIG. DEVICES AND VALVES 2-1/2" AND SMALLER ARE TO HAVE SOLDERED OR SCREWED CONNECTION AND 3" AND LARGER ARE TO HAVE FLANGED CONNECTIONS.

REFER TO SPECIFICATIONS FOR APPROVED VALVE MANUFACTURERS.

89. CONCEAL ALL PIPING IN BUILDING CONSTRUCTION OR UNDERGROUND. INSTALL SUCH PIPING IN TIME SO AS NOT TO CAUSE DELAY TO WORK OF OTHER TRADES AND TO ALLOW AMPLE TIME FOR TESTS AND APPROVAL; DO NOT COVER BEFORE APPROVAL IS OBTAINED.

90. KEEP FIXTURE BRANCHES CONCEALED TO POINTS ABOVE FLOOR CLOSE TO FIXTURES; EXPOSE ONLY AS MUCH AS NECESSARY FOR FINAL CONNECTIONS.

91. WHERE FURRED SPACES ARE INDICATED, KEEP PIPES AS CLOSE TO STRUCTURAL MEMBERS AS POSSIBLE SO AS TO REQUIRE MINIMUM FURRINGS.

92. THE PLUMBING CONTRACTOR SHALL PROVIDE ESCUTCHEONS AT EACH POINT WHERE AN UNINSULATED PIPE, CONDUIT, OR TUBING PASSES THROUGH A FINISHED SURFACE. ESCUTCHEONS WILL NOT GENERALLY BE REQUIRED FOR INSULATED PIPE AND CONDUIT OR TUBING PASSING THROUGH EQUIPMENT ROOM WALLS UNLESS, IN THE OPINION OF THE ENGINEER, THE INSTALLATION OF SUCH PIPE, CONDUIT, OR TUBING HAS NOT BEEN INSTALLED IN A NEAT AND ACCEPTABLE. ESCUTCHEONS SHALL BE CONSTRUCTED OF CHROME -PLATED BRASS UNLESS SPECIFICALLY APPROVED OTHERWISE BY THE ARCHITECT. EACH ESCUTCHEON SHALL FIT FLUSH WITH THE WALL OR FLOOR AND SHALL FIT SNUGLY AROUND THE PIPE.

WATER HAMMER ARRESTOR

WITH (THREADED

FIXTURE SIZE

12-32 3/4"

61-113 1 1/4"

114-154 1 1/2"

1-11

33-60

155-330

1. PROVIDE A WATER HAMMER ARRESTOR ON EACH HOT

IS AN UNOBSTRUCTED SHOCK PATH TO THE ARRESTOR.

3. ARRESTORS SHOULD ALWAYS BE PLACED AS NEAR TO

2. ARRESTORS SHOULD ALWAYS BE INSTALLED SO THAT THERE

BRANCH LINE

DROP TO PLUMBING

FIXTURES —

NOTES:

MAIN

WATER AND COLD WATER DROP.

THE SOURCE OF SHOCK AS POSSIBLE.

CONNECTION)

EQUAL TO SIOUX CHIEF MODEL

PPP SIZING CHART

UNITS (THREAD) NUMBER

1"

2"

1/2"

PΔRT

652-A


653-B


654-C

655-D

656-E

657-F

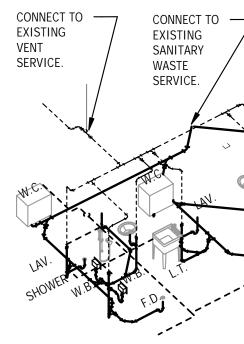

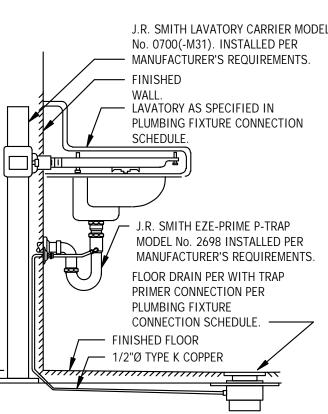

PIPING ARRANGEMENT SHOWN IS SCHEMATIC. ADJUST TO SUIT FIELD CONDITIONS. MAKE TRAP PRIMING PIPE SAME SIZE AS EZE-PRIME FITTINGS. FOLLOW MANUFACTURER'S INSTRUCTIONS FOR INSTALLATION PROCEDURE. TRAP PRIMER CONNECTION FROM COUNTERTOP MOUNTED SINK OR LAVATORY IS SIMILAR. VERIFY PROPER OPERATION WHEN INSTALLED.

LAVATORY CARRIER AND

FLOOR DRAIN TRAP PRIMER DETAIL

WATER HAMMER ARRESTOR DETAIL



CONNECT EXISTING GANITARY VASTE SERVICE.	TO SHOWLE B		Quest Design Group, Inc.		Cert. of Authorization# CA31201           Mechanical         Electrical         Plumbing         Fire         Protection           Contractor to Verify All Defense on Structure Conditions         Fire Protection         Contractor To Verify All Defense on Structure	WHERE NOT CLEARLY DNLY MOST RECENTL H WORK. ENGINEERI H WORK. ENGINEERI SINEERIS NOT RESP COUMENTS. THESE FOR PERMISSION FRO THE ARCHITECT'S OR HE ARCHITECT'S OR	THE APPLICABLE BUILDING CODES AND THE APPLICABLE MINIMUM FIRE SAFETY STANDARDS AS DETERMINED IN ACCORDANCE WITH CHARTERS 553, AND 433, ELORIDA STATUTES AND LOCAL ORDIMANCES.	2168 MAIN STREET SARASOTA, FL 3423730 Children31 Children32 Children31 Children31 Children32 Children31 Children31 Children31 Children32 Children31 Children32 Children32 Children32 Children33 Children34 Children34 Children35 Children35 Children36 Children37 Children3	
	CONNECT TO EXISTING CW & HW SERVICES. UN UN UN SINCE SHOWER W.B. UN SHOWER			J.B.				SWEET	
	PLUMBING FIXTURE & CONNECTION SCHED	ULE				]			2
MARK	FIXTURE, MODEL #, DESCRIPTION	WASTE	1	GH-IN CW	HW	-			
FD-1	FLOOR DRAIN, ZURN MODEL #Z415-S: 6"X6" SQUARE STRAINER WITH SECURED HEEL PROOF MEDIUM DUTY GRATE. ARCHITECT TO SELECT STRAINER FINISH. PROVIDE TRAP SEAL DEVICE EQUAL TO ZURN MODEL #Z1072.	3"	2"						
L-1	LAVATORY, UNDERCOUNTER MOUNTED, AMERICAN STANDARD "OVALYN" MODEL #9482.000: 19- 1/4" X 15-3/4" BARRIER FREE WITH REAR OVERFLOW AND SINGLE CENTER FAUCET HOLE. FAUCET, KRAUS MODEL #KBF-1401 SPOT FREE STAINLESS STEEL FINISH. PROVIDE OFFSET GRID DRAIN, TRU-BRO LAVGUARD INSULATION, P-TRAP, STOPS AND SUPPLIES.	2"	2"	1/2"	1/2"				
S-1	SINGLE COMPARTMENT UNDERMOUNT STAINLESS STEEL SINK, KRAUS PRO MODEL #KHU100-30 STAINLESS STEEL 18" X 30" X 10" DEEP. 16 GAUGE T304 STAINLESS STEEL WITH STAIN FINISH, BASKET MODEL #BST-1. PROVIDE MOEN "GENTA" MODEL #7882SRS SINGLE-HANDLE PULL-DOWN SPRAYER KITCHEN FAUCET. IN-SINK ERATOR BADGER 5 MODEL OR EQUAL, 1/2-HP FOOD WASTE DISPOSER WITH DISHWASHER CONNECTION. PROVIDE MOEN MODEL #3942SRS SOAP DISPENSER.	2"	2"	1/2"	1/2"				
SH-1	SHOWER SYSTEM - BARRIER FREE, AMERICAN STANDARD "SPECTRA VERSA" MODEL #9038834 AND PRESSURE BALANCING SHOWER VALVE MODEL #RU101SS WITH SCREWDRIVER STOPS AND "STUDIO S COLLECTION" MODEL #T105.500.002 VALVE ONLY TRIM KIT WITH LEVER HANDLE. 1.5 GPM HAND HELD SHOWER WITH WALL HOOK, 60" HOSE, WALL SUPPLY ELBOW, AND VACUUM BREAKER. DRAIN: ZURN MODEL Z415-S WITH 6"X6" SQUARE STRAINER, ARCHITECT TO SELECT STRAINER FINISH.	2"	2"	1/2"	1/2"				
VB-1	VALVE BOX WATER TITE MODEL #9701 QUATER TURN BALL, LEAD FREE BRASS, PROVIDE WITH WALL BOX, FRAME, VALVE AND WATER HAMMER ARRESTER.			1/2"				КЕ	
WB-1 WC-1	CLOTHES WASHER BOX OATEY MODEL #38970 OFFSET DRAIN WITH 1/4" TURN MIP VALVE AND MOUNTED WATER HAMMER ARRESTOR, SNAP-ON FACEPLATE FRAME. 2"DRAIN. PROVIDE P-TRAP. WATER CLOSET, FLOOR MOUNTED FLUSH TANK - BARRIER FREE, KOHLER "HIGHLINE	2"	2"	3/4"	3/4"			LONGBOAT KEY UE STATION 91 MEXICO DR EY, FL 34228	it.
	CLASSIC COMFORT HEIGHT" MODEL #K-3658: TWO-PIECE ELONGATED BOWL, 12-INCH ROUGH-IN, 16-1/2" RIM HEIGHT, AND 1.28 GALLON FLUSH. TOILET SEAT, KOHLER MODEL #K-4664 WITH COVER. CP STOP AND SUPPLY.			172					Conformed Set 05.22.20
NOTES:	<ol> <li>INSTALL ALL EQUIPMENT PER MANUFACTURER'S INSTRUCTIONS AND DIAGRAMS.</li> <li>ADA ACCESSIBLE WATER CLOSETS SHALL BE INSTALLED WITH FLUSHING CONTROLS LOCATI FLOOR SPACE WITH RESTROOOM(S) OR STALL(S).</li> <li>ALL FIXTURES SHALL MEET ADA AND LOCAL CODES.</li> <li>INSTALL BACKING AND SUPPORTS AS REQUIRED TO PROPERLY ANCHOR ALL FIXTURES AND A 5. PLUMBING FIXTURE SUPPORTS AND CARRIERS SHALL BE EQUAL TO ZURN, WATTS, JOSAM, V</li> <li>SUPPLY PIPING AND FITTING FOR ALL FIXTURES SHALL BE INSTALLED SO AS TO PREVENT BA 7. ALL FIXTURES SHALL BE PROVIDED WITH ACCESSIBLE SHUT OFF VALVES AT COLD AND HOT 8. PROVIDE INSULATION FOR ALL PIPING IN EXTERIOR WALLS.</li> <li>ALL PLUMBING FIXTURES SHALL BE COORDINATED AND APPROVED BY ARCHITECT PRIOR TO 10. PLUMBING FIXTURES SHALL BE COORDINATED AND APPROVED BY ARCHITECT PRIOR TO 11. PROVIDE BRASS CRAFT OR EQUAL SUPPLY STOPS ON ALL NON-FLUSH VALVE FIXTURES.</li> <li>PROVIDE FLOOR DRAIN AND ROOF DRAIN STRAINERS WITH FREE SPACE AREA PER CURREN MANUFACTURER'S INSTRUCTIONS.</li> <li>HOT WATER TO ALL LAVATORIES AND HAND SINKS SHALL NOT EXCEED 110 DEGREES.</li> <li>COORDINATE ADA HEIGHT REQUIREMENTS WITH ARCHITECT DRAWINGS.</li> <li>ALL LAVATORIES, HAND SINKS, BATH AND SHOWER VALVES SHALL BE PROVIDED WITH APP DEVICE AND PRESSURE BALANCE.</li> <li>PROVIDE CHROME PLATED SUPPLIES ON ALL LAVATORIES AND SINKS WHICH ARE EXPOSED CONCEALED FROM VIEW MAY BE TYPE "L" SOFT DRAWN COPPER. "PX" AND POLYBUTHYLENE 17. PROVIDE PVC TRAPS ON ALL FIXTURES CONCEALED FROM VIEW REQUIRING P-TRAPS. THIN TRAPS ARE NOT APPROVED.</li> </ol>	ACCESSC VADE ANI ACKFLOW WATER F PURCHA ENGINEEI IT BUILDI PROVED A D TO VIEV	NRIES. D J.R. SM PIPING C SE. R. NG CODI AUTOMAT	nith. ONNECTI E AND FIC SAFE  NTRACTC /ED.	ONS. TY WATEI DR'S OPT	R MIXING ION SUPPLIE	S	PROJECT TOWN ( TITLE: FIRE RE 5490 GULL	POR: 05.2
		TRAP PRI	PRIMER		NE		SCA PRC DRA A/E PRC	APHIC SCALE: 0" ALE: DJECT MANAGER AWN BY: OF RECORD: DJECT NO:	DATE DATE 1" 1/8" = 1'-0" CRB JDS JDS 19-522
	FLOOR WITH TRAP P SCALE: NONE			<u>TAIL</u>			F	ET TITLE: PLUMBING NO AND DETAI ET No.: <b>P1.2</b>	

	Ρ	1	_

#### PIPING NOTES

1. ALL ABOVE GROUND PIPING LESS THAN 11/2" SHALL BE SCHEDULE 40 BLACK WITH CAST THREADED FITTINGS. 2. ALL ABOVE GROUND PIPING 2" AND LARGER SHALL BE SCHEDULE 10 BLACK STEEL WITH VICTAULIC FITTINGS.

HANGER SPACING TABLE MAXIMUM DISTANCE BETWEEN HANGERS IN ACCORDANCE TO NFPA 13 TABLE 9.2.2.1									
PIPE SIZE	1"	1¼"	1½"	2"	21⁄2"	3"	4"	6"	8"
STEEL PIPE EXCEPT THREADED LIGHTWALL	12'-0"	12'-0"	15'-0"	15'-0"	15'-0"	15'-0"	15-0"	15'-0"	15'-0"
THREADED LIGHTWALL	12'-0"	12'-0"	12'-0"	12'-0"	12'-0"	12'-0"			
CPVC	6'-0"	6'-0"	6'-0"	6'-0"	6'-0"				


WHERE THE MAXIMUM STATIC OR FLOWING PRESSURE, WHICHEVER IS GREATER AT THE SPRINKLER, APPLIED OTHER THAN THROUGH THE FIRE DEPARTMENT CONNECTION, EXCEEDS 100 PSI AND A BRANCH LINE ABOVE A CEILING SUPPLIES SPRINKLERS IN A PENDENT POSITION BELOW THE CEILING, THE CUMULATIVE HORIZONTAL LENGTH OF AN UNSUPPORTED ARMOVER TO A SPRINKLER OR SPRINKLER DROP SHALL NOT EXCEED 12" FOR STEEL PIPE AND 6" FOR COPPER OR CPVC TUBE.

	FIRE PROTECTION LEGEND								
ABV.	DESCRIPTION	SYMBOL	ABV.	DESCRIPTION					
AFF	ABOVE FINISH FLOOR			FIRE SPRINKLER BRANCH LINE					
AP	ACCESS PANEL			EXISTING FIRE SPRINKLER BRANCH LINE					
CPVC	CHLORINATED POLYVINYL CHLORIDE			FIRE SPRINKLER MAIN LINE					
DN	DOWN			EXISTING FIRE SPRINKLER MAIN LINE					
EXIST	EXISTING			EXISTING PUBLIC WATER MAIN					
°F	DEGREE FAHRENHEIT	• • • •		UNDER GROUND FIRE WATER MAIN LINE					
GPH	GALLONS PER HOUR	$\langle \# \rangle$		HYDRAULIC CALCULATION NODE POINT					
GPM	GALLONS PER MINUTE	$\otimes$		MAIN SYSTEM RISER (PLAN VIEW)					
КW	KILOWATT			O. S. & Y GATE VALVE WITH TAMPER SWITCH					
LBS	POUNDS	Ð		SWING CHECK VALVE					
NC	NORMALLY CLOSED			TEST AND DRAIN WITH GAUGE					
NO	NORMALLY OPEN			PIPE RISE OR DROP					
OD	OUTSIDE DIAMETER	Ə		PIPE RISE OR DROP (ELBOW)					
PRV	PRESSURE REDUCING VALVE			BRANCH - BOTTOM CONNECTION					
PSI	POUNDS PER SQUARE INCH	U		BRANCH - TOP CONNECTION					
PVC	POLYVINYL CHLORIDE PIPE								
SF	SQUARE FEET								
U.G.	UNDER GROUND		MBOLS AN TO THIS P	ND ABBREVIATIONS DO NOT NECESSARILY PROJECT					
VEL	VELOCITY								
NIC	NOT IN CONTRACT								


#### SPRINKLER HEAD LEGEND

		0110								
SYM	NAME	METAL	TEMP	K	NPT	ORIF	MFG.	MODEL#	ESCUT	CONN.
$\bigcirc$	CONCEALED PENDENT	WHITE	155	5.60	1/2"		түсо	RFII	CONCEALED	Thread
()	HIGH TEMPERATURE PENDENT	CHROME	286	5.60	1/2"		тусо	TY-FRB	RECESSED	Thread
$\bigcirc$	UPRIGHT	BRASS	155	5.60	1/2"		тусо	TY-FRB	RECESSED	Thread
۲	DRY PENDENT	CHROME	135	5.60	1"		түсо	DS-1	RECESSED	Thread
	SIDEWALL	BRASS	200	5.60	1/2"	1/2"	тусо	DS-1	NONE	Thread
$\bigcirc$	EXISTING PENDENT									

*PROVIDE INTERMEDIATE TEMPERATURE RATING SPRINKLER HEADS IN UNCONDITIONED SPACES PER NFPA 13 REQUIREMENTS.

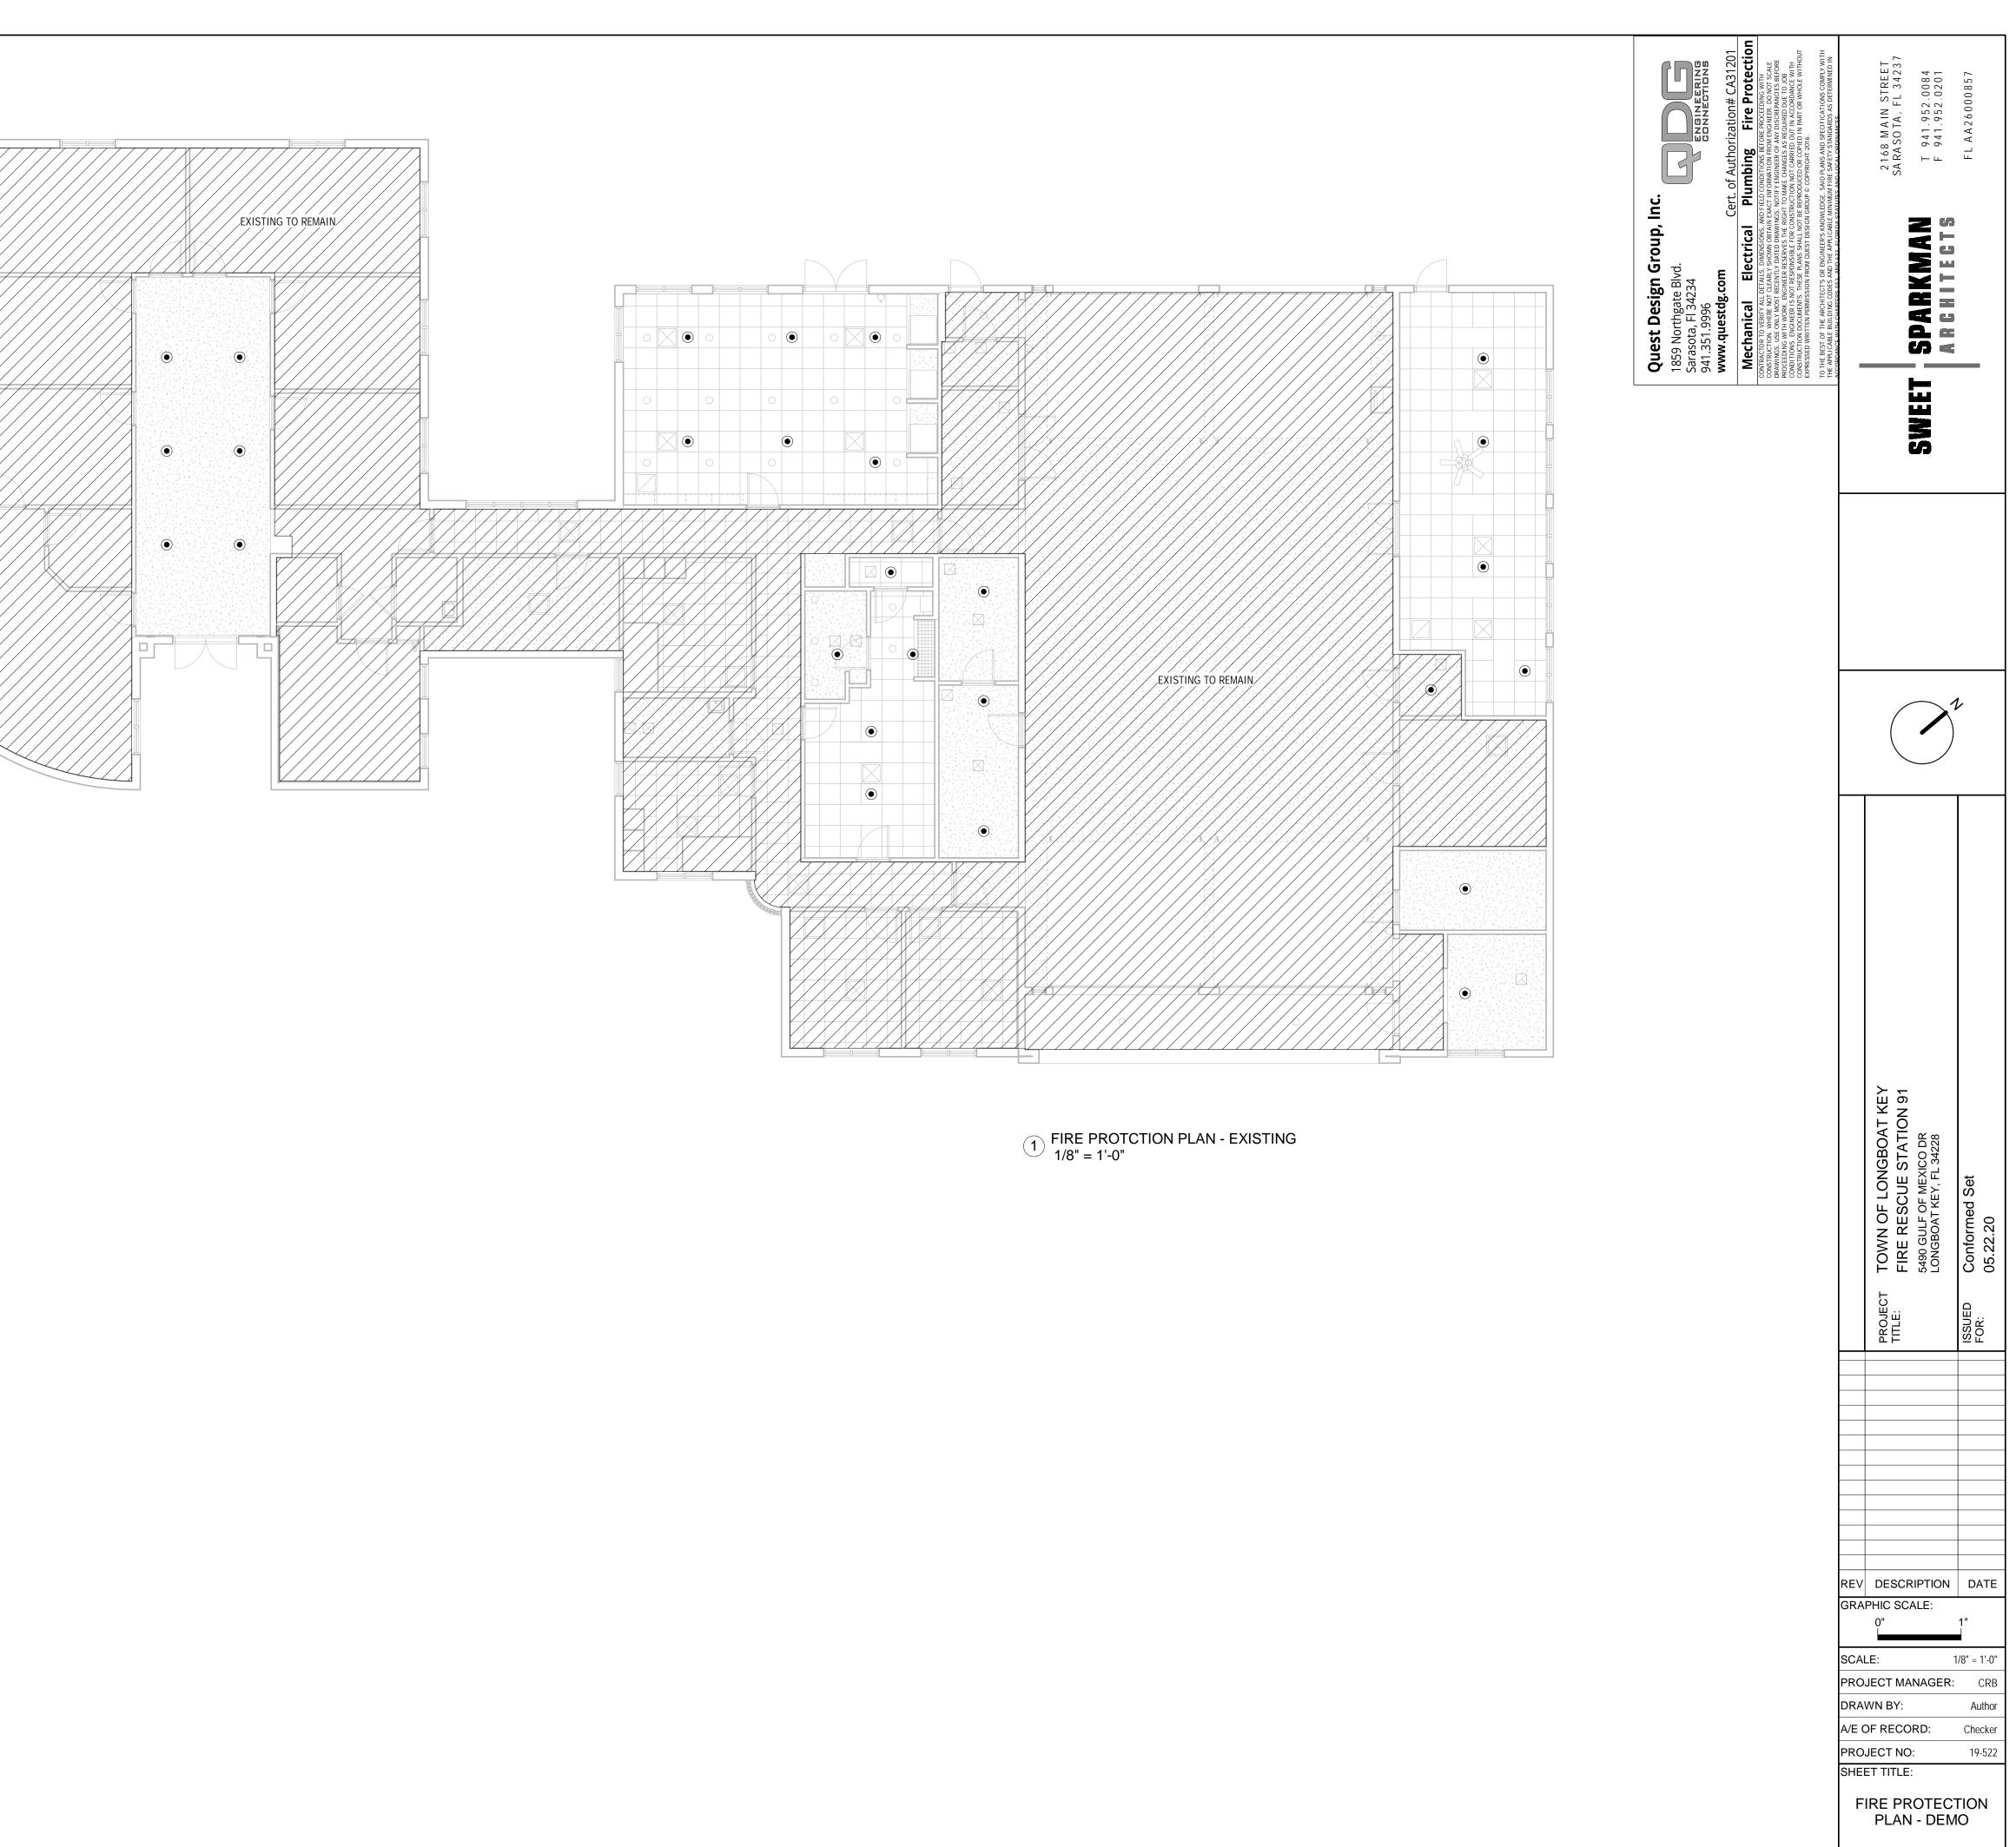

SHEET No .: FP1.0

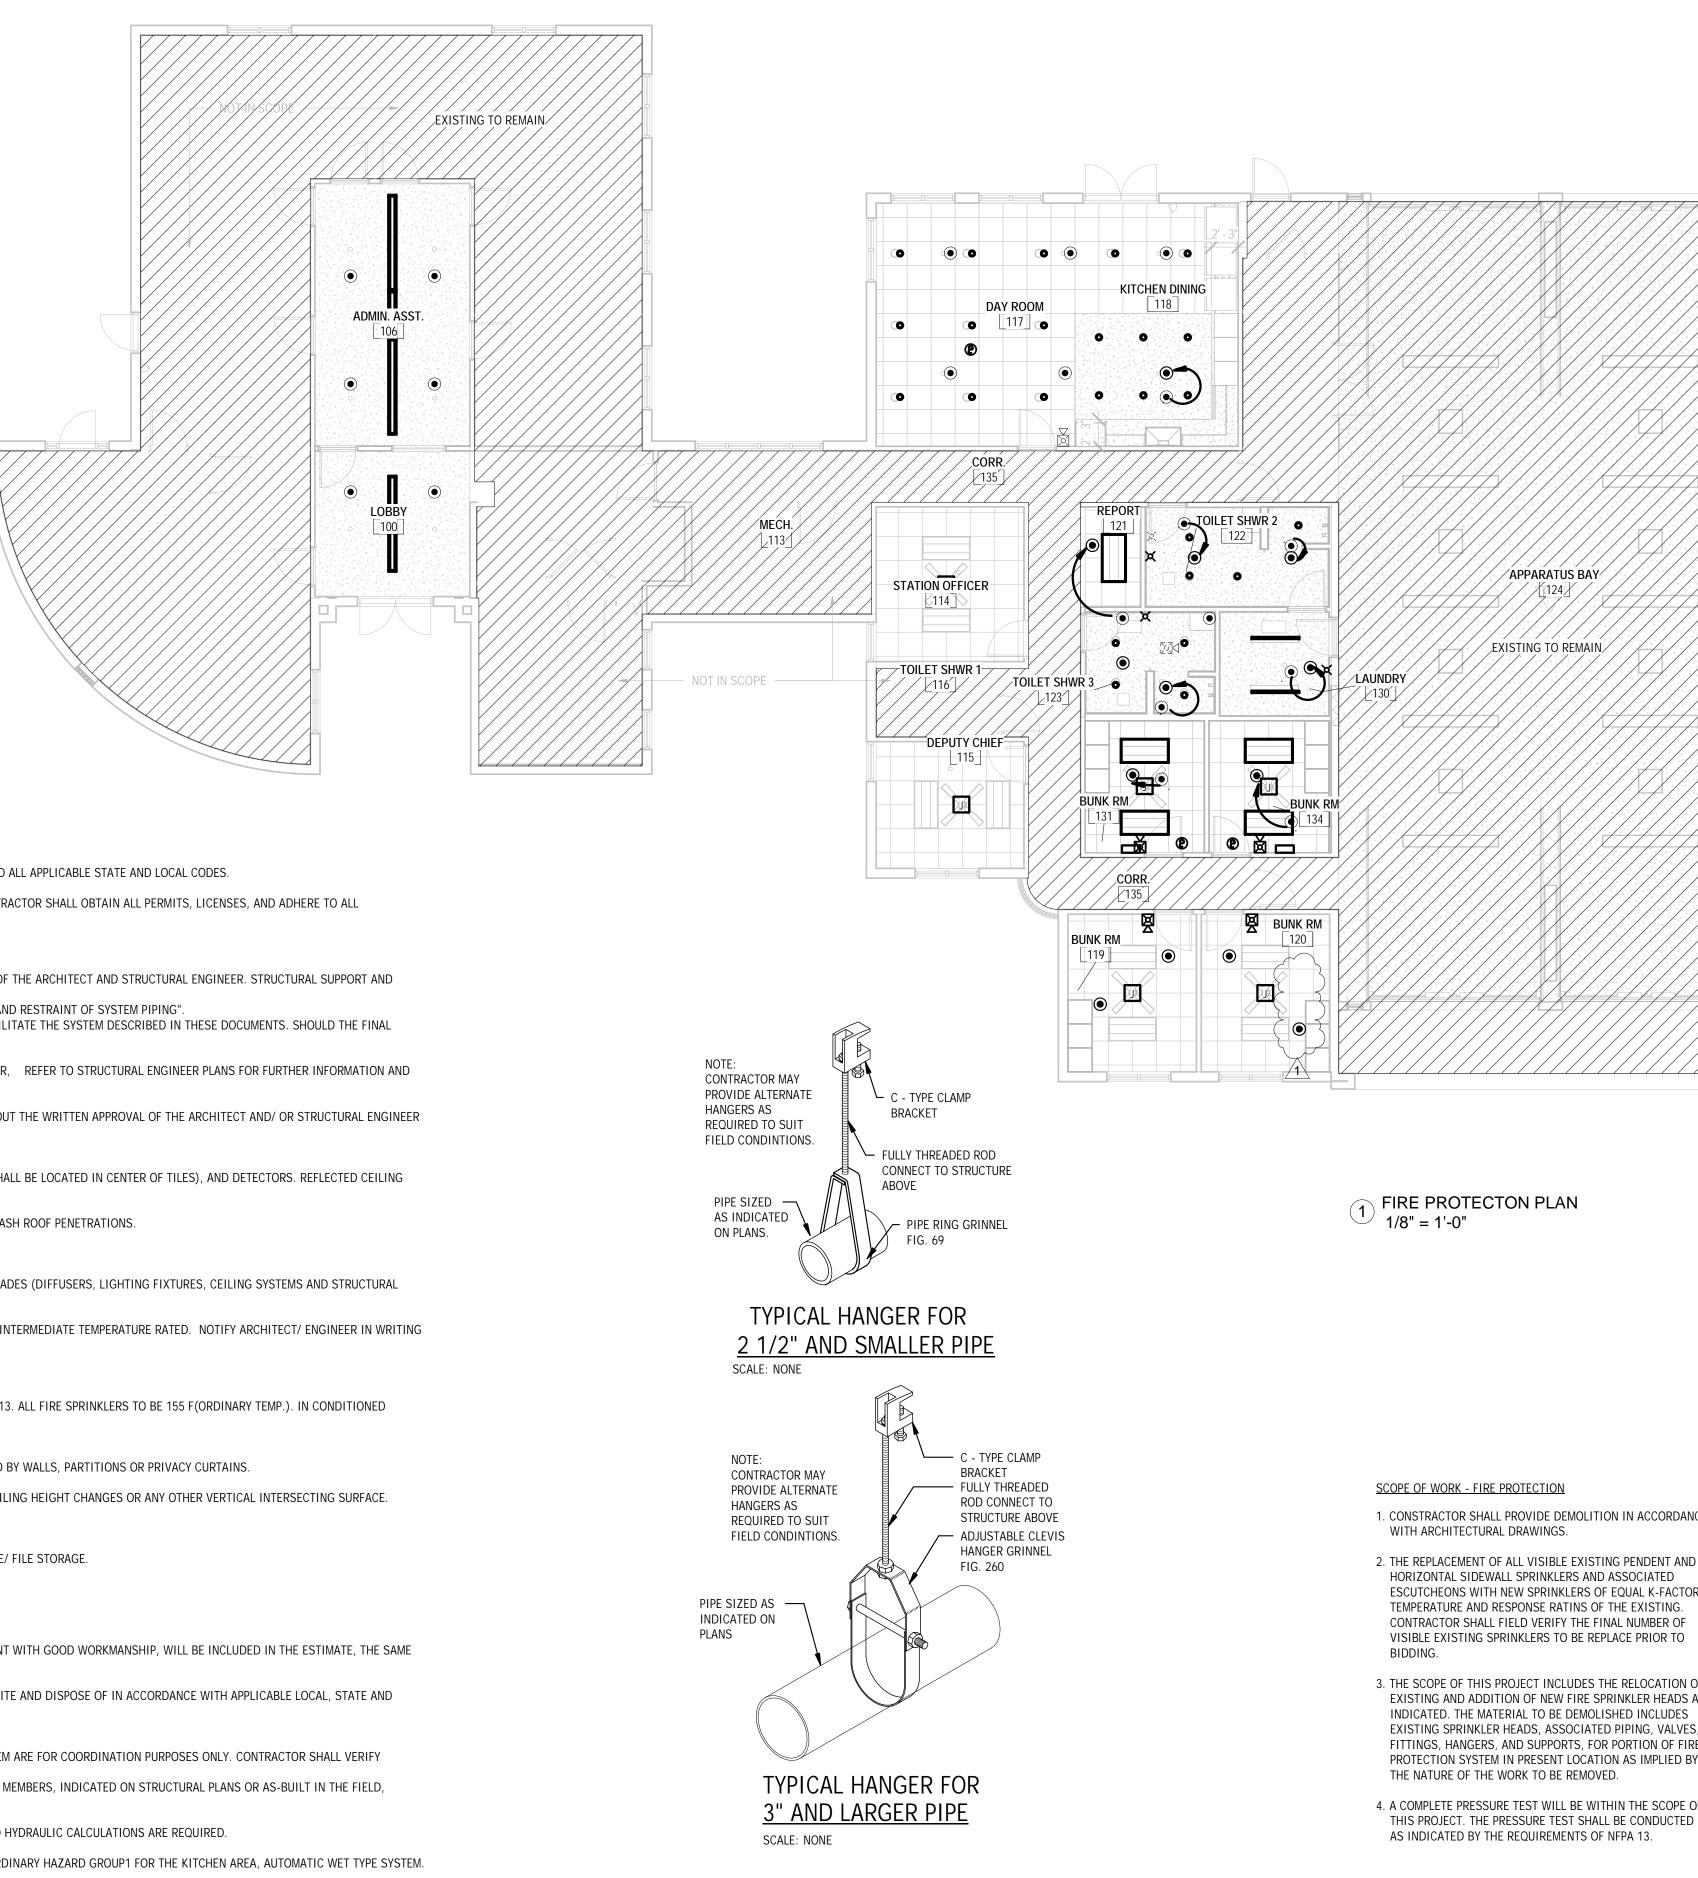

#### FIRE SPRINKLER NOTES


- 1. ALL THESE NOTES MAY NOT APPLY.
- 2. FIRE PROTECTION SYSTEM TO COMPLY WITH N.F.P.A. 13 (2013 EDITION), LOCAL FIRE MARSHALL STANDARDS AND ALL APPLICABLE STATE AND LOCAL CODES.
- 3. FIRE SPRINKLER CONTRACTOR SHALL OBTAIN SEPARATE PERMIT FROM ANY OTHER TRADE. FIRE SPRINKLER CONTRACTOR SHALL OBTAIN ALL PERMITS, LICENSES, AND ADHERE TO ALL GOVERNMENT REQUIREMENTS.
- 4. OBTAIN FINAL INSPECTION AND APPROVAL BY LOCAL FIRE MARSHALL, BUILDING DEPARTMENT, AND ARCHITECT.
- 5. CUTTING OF STRUCTURAL AND/OR ARCHITECTURAL MEMBERS TO BE DONE ONLY WITH THE WRITTEN APPROVAL OF THE ARCHITECT AND STRUCTURAL ENGINEER. STRUCTURAL SUPPORT AND STRUCTURAL OPENING:
  - A. PIPING STRUCTURAL SUPPORT SHALL BE IN ACCORDANCE WITH NFPA 13 CH. 9 "HANGING, BRACING, AND RESTRAINT OF SYSTEM PIPING".
     B. IT IS NOT ANTICIPATED THAT ANY ENGINEERED STRUCTURAL OPENINGS ARE TO BE REQUIRED TO FACILITATE THE SYSTEM DESCRIBED IN THESE DOCUMENTS. SHOULD THE FINAL SYSTEM LAYOUT DOCUMENTS REQUIRE ANY ENGINEERED OPENINGS THEY SHALL BE COORDINATED
  - THROUGH THE ARCHITECT AT THAT TIME. C. PIPING STRUCTURAL SUPPORT AND OPENINGS HAVE BEEN COORDINATED WITH STRUCTURAL ENGINEER, REFER TO STRUCTURAL ENGINEER PLANS FOR FURTHER INFORMATION AND

INSTRUCTIONS.

- 6. THE EXISTING STRUCTURE SHALL NOT BE CUT, DRILLED, ALTERED, REMOVED, OR TEMPORARILY REMOVED WITHOUT THE WRITTEN APPROVAL OF THE ARCHITECT AND/ OR STRUCTURAL ENGINEER FOR THE INSTALLATION REQUIRED TO PERFORM CONSTRUCTION ACTIVITIES OF MECHANICAL, PLUMBING, AND ELECTRICAL WORK, AND OTHER CONSTRUCTION UNDER THE CONTRACT.
- 7. REFER TO ARCHITECTURAL REFLECTED CEILING PLAN FOR CEILING DESCRIPTIONS AND HEIGHTS (SPRINKLERS SHALL BE LOCATED IN CENTER OF TILES), AND DETECTORS. REFLECTED CEILING PLANS SHALL DICTATE LOCATIONS UNLESS OTHERWISE PROHIBITED BY N.F.P.A. 13.
- 8. FIRE STOP ALL PENETRATIONS OF SMOKE/FIRE WALLS, CEILINGS, FLOORS, ROOFS, ETC., FLASH AND COUNTERFLASH ROOF PENETRATIONS.
- 9. PROVIDE ACCESS PANELS TO VALVES ABOVE NON-ACCESSIBLE CEILINGS AND CHASES.
- 10. SPRINKLER LOCATIONS ARE TO BE COORDINATED WITH ARCHITECT'S. REFLECTED CEILING PLANS AND OTHER TRADES (DIFFUSERS, LIGHTING FIXTURES, CEILING SYSTEMS AND STRUCTURAL SYSTEM).
- 11. SPRINKLERS THAT ARE WITHIN 24" OF ANY MECHANICAL GRILLE OR WITHIN 6" OF ANY LIGHT FIXTURE SHALL BE INTERMEDIATE TEMPERATURE RATED. NOTIFY ARCHITECT/ ENGINEER IN WRITING OF ANY DISCREPANCIES.
- 12. METHODS OF HANGING PIPES, HEADERS AND BRANCHES SHALL BE IN ACCORDANCE WITH N.F.P.A. 13.
- 13. AUTOMATIC SPRINKLER TEMPERATURE RATINGS WITH FUSIBLE ELEMENTS TO BE IN ACCORDANCE WITH N.F.P.A. 13. ALL FIRE SPRINKLERS TO BE 155 F(ORDINARY TEMP.). IN CONDITIONED AREAS. 200 F (INTERMEDIATE TEMP.). IN NON-CONDITIONED AREAS AND SHALL BE IN ACCORDANCE WITH NFPA 13 CHAPTER 8 "INSTALLATION REQUIREMENT" 8.3.2.5
- 14. SPRINKLERS SHALL COVER THE ENTIRE AREA OF THE ROOM INCLUDING ALCOVES. SPRAY SHALL NOT BE BLOCKED BY WALLS, PARTITIONS OR PRIVACY CURTAINS.
- 15. ALL SPRINKLERS MOUNTED IN CEILING SHALL BE LOCATED A MINIMUM OF 4-INCHES AWAY FROM ANY WALLS, CEILING HEIGHT CHANGES OR ANY OTHER VERTICAL INTERSECTING SURFACE.
- 16. PIPE SHALL BE REAMED AND CLEANED BEFORE ASSEMBLY.
- 17. MAINTAIN A MINIMUM OF 18-INCHES FROM THE BOTTOM OF THE SPRINKLER DEFLECTOR TO THE TOP OF STORAGE/ FILE STORAGE.
- 18. PROVIDE SPRINKLER SYSTEM(S) WITH FLUSHING CONNECTION(S).
- 19. PROVIDE SPRINKLERS ABOVE AND BELOW EXPOSED DUCTWORK 4-FEET OR WIDER.
- 20. MINOR DETAILS, NOT USUALLY SHOWN OR SPECIFIED, BUT NECESSARY FOR PROPER OPERATION AND CONSISTENT WITH GOOD WORKMANSHIP, WILL BE INCLUDED IN THE ESTIMATE, THE SAME AS IF SHOWN ON DRAWINGS.
- 21. OFFER REMOVED MATERIAL TO THE OWNER. REMOVE ALL MATERIAL REJECTED BY THE OWNER FROM THE WORK SITE AND DISPOSE OF IN ACCORDANCE WITH APPLICABLE LOCAL, STATE AND NATIONAL CODES. CONTRACTOR MUST CERTIFY TO OWNER THAT THE MATERIAL HAS BEEN LEGALLY DISPOSED OF.
- 22. ALL SPRINKLERS INDICATED ON DRAWINGS PREPARED BY ENGINEER OF RECORD FOR THE FIRE SPRINKLER SYSTEM ARE FOR COORDINATION PURPOSES ONLY. CONTRACTOR SHALL VERIFY COVERAGE AND ADD SPRINKLERS AS REQUIRED. CONTRACTOR SHALL PROVIDE FULL SPRINKLER PROTECTION IN ATTICS CONSTRUCTED WITH COMBUSTIBLE MATERIALS WHERE ROOF PLYWOOD OR STRUCTURAL MEMBERS, INDICATED ON STRUCTURAL PLANS OR AS-BUILT IN THE FIELD, OBSTRUCT SPRINKLER SPRAY PATTERNS.
- 23. THIS IS A MODIFICATION TO AN EXISTING FIRE SPRINKLER SYSTEM. THIS AREA IS NOT THE HMD THEREFORE NO HYDRAULIC CALCULATIONS ARE REQUIRED.
- 24. THIS TENANT COMPLETION HAS BEEN DESIGNED FOR A LIGHT HAZARD OCCUPANCY FOR DINNING AREAS AND ORDINARY HAZARD GROUP1 FOR THE KITCHEN AREA, AUTOMATIC WET TYPE SYSTEM. THE MINIMUM DENSITY SHALL BE 0.10 FOR DINNING AREA AND 0.15 FOR KITCHEN AND SPRINKLER SPACING SHALL BE AS DESCRIBED BY NFPA 13 FOR LIGHT AND ORDINARY HAZARD OCCUPANCIES.

	This set has been digitally signed and sealed by Jon D. Shepard, PE on August 26, 2020 using a Digital Signature. Printed copies of this document are not considered signed and sealed and the SHA authentication code must be verified on any electronic copies.	Quest Design Group, Inc.         1859 Northgate Blvd.         Sarasota, Fl 34234         941.351.9996         www.questdg.com         Cert. of Authorization# Carlon         Parance Blvd.         Sarasota, Fl 34234         941.351.9996         www.questdg.com         Cert. of Authorization# Carlon         Merchan         Cert. of Authorization# Carlon         Cert. of Authorization# Carlon         Contractor Nueter Autoris Reform Paranton Kenon Carlon         Contractor Nueter Autoris Reform Non Carlon Stretter Non Non Stretter Non Stretter Non Stretter Non Stretter Non Non Stretter Non Stretter Non Stretter Non Non Streter Non Non Stretter Non Non Stretter Non Non Non Non Non Non Non		SWEET       2168 MAIN STREET         SWEET       2168 MAIN STREET         SMEET       2168 MAIN STREET         SMEET       52ARKMAN         T       941.952.0084         Sme@intro.ex       F         SMEET       941.952.0201	FL AA26000857
		boursigned by: Jan Sheard Abboocdaubititiss B/26/2020		No. 71536	TONAL Sheps
EMS SUPPLY [125]	NOT IN SCOPE			PROJECT TOWN OF LONGBOAT KEY TITLE: FIRE RESCUE STATION 91 5490 GULF OF MEXICO DR LONGBOAT KEY, FL 34228	ISSUED Conformed Set FOR: 05.22.20
NCE D DR, OF AS S, RE BY OF			GRAI SCAI PRO DRAV A/E C PRO SHEE		Author Checker 19-522

FP1.1

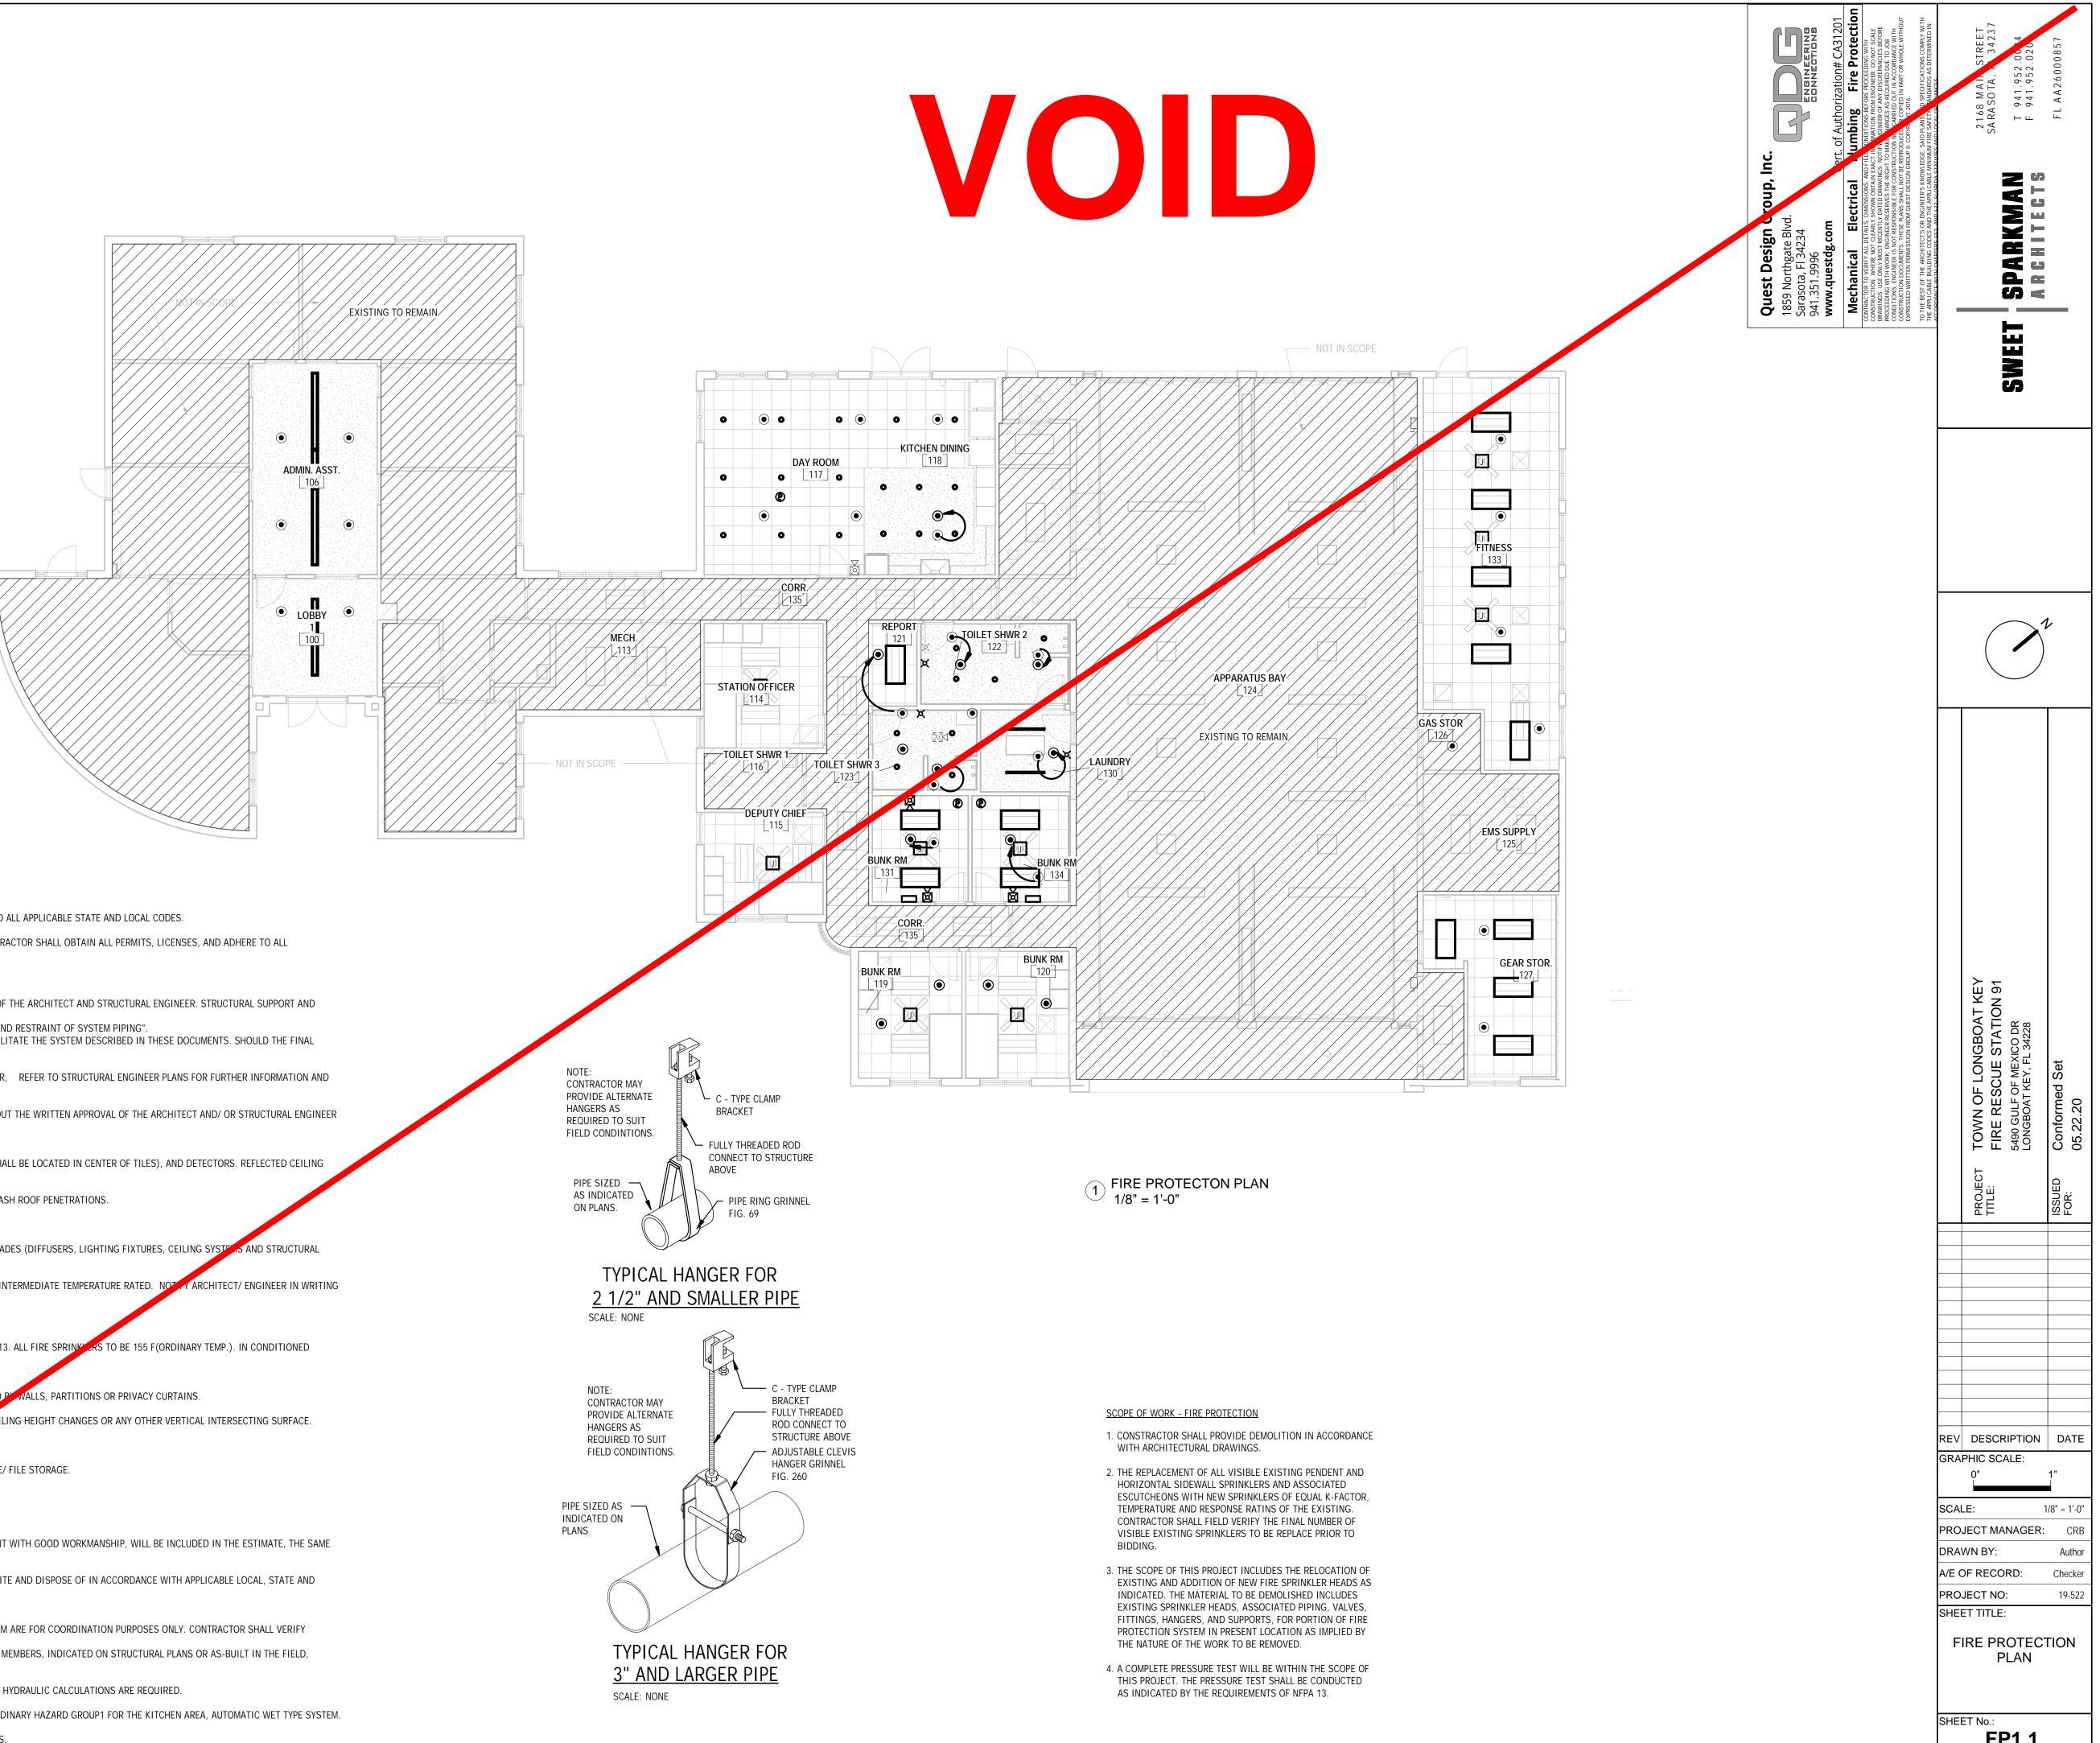


#### FIRE SPRINKLER NOTES

#### 1. ALL THESE NOTES MAY NOT APPLY.

- FIRE PROTECTION SYSTEM TO COMPLY WITH N.F.P.A. 13 (2013 EDITION), LOCAL FIRE MARSHALL STANDARDS AND ALL APPLICABLE STATE AND LOCAL CODES
- FIRE SPRINKLER CONTRACTOR SHALL OBTAIN SEPARATE PERMIT FROM ANY OTHER TRADE. FIRE SPRINKLER CONTRACTOR SHALL OBTAIN ALL PERMITS, LICENSES, AND ADHERE TO ALL 3. GOVERNMENT REQUIREMENTS.
- 4. OBTAIN FINAL INSPECTION AND APPROVAL BY LOCAL FIRE MARSHALL, BUILDING DEPARTMENT, AND ARCHITECT.
- 5. CUTTING OF STRUCTURAL AND/OR ARCHITECTURAL MEMBERS TO BE DONE ONLY WITH THE WRITTEN APPROVAL OF THE ARCHITECT AND STRUCTURAL ENGINEER. STRUCTURAL SUPPORT AND STRUCTURAL OPENING:
  - A. PIPING STRUCTURAL SUPPORT SHALL BE IN ACCORDANCE WITH NFPA 13 CH. 9 "HANGING, BRACING, AND RESTRAINT OF SYSTEM PIPING". B. IT IS NOT ANTICIPATED THAT ANY ENGINEERED STRUCTURAL OPENINGS ARE TO BE REQUIRED TO FACILITATE THE SYSTEM DESCRIBED IN THESE DOCUMENTS. SHOULD THE FINAL SYSTEM LAYOUT DOCUMENTS REQUIRE ANY ENGINEERED OPENINGS THEY SHALL BE COORDINATED THROUGH THE ARCHITECT AT THAT TIME.
  - C. PIPING STRUCTURAL SUPPORT AND OPENINGS HAVE BEEN COORDINATED WITH STRUCTURAL ENGINEER, REFER TO STRUCTURAL ENGINEER PLANS FOR FURTHER INFORMATION AND

INSTRUCTIONS.

- 6. THE EXISTING STRUCTURE SHALL NOT BE CUT, DRILLED, ALTERED, REMOVED, OR TEMPORARILY REMOVED WITHOUT THE WRITTEN APPROVAL OF THE ARCHITECT AND/ OR STRUCTURAL ENGINEER FOR THE INSTALLATION REQUIRED TO PERFORM CONSTRUCTION ACTIVITIES OF MECHANICAL, PLUMBING, AND ELECTRICAL WORK, AND OTHER CONSTRUCTION UNDER THE CONTRACT.
- REFER TO ARCHITECTURAL REFLECTED CEILING PLAN FOR CEILING DESCRIPTIONS AND HEIGHTS (SPRINKLERS SHALL BE LOCATED IN CENTER OF TILES), AND DETECTORS. REFLECTED CEILING PLANS SHALL DICTATE LOCATIONS UNLESS OTHERWISE PROHIBITED BY N.F.P.A. 13.
- 8. FIRE STOP ALL PENETRATIONS OF SMOKE/FIRE WALLS, CEILINGS, FLOORS, ROOFS, ETC., FLASH AND COUNTERFLASH ROOF PENETRATIONS.
- 9. PROVIDE ACCESS PANELS TO VALVES ABOVE NON-ACCESSIBLE CEILINGS AND CHASES.
- 10. SPRINKLER LOCATIONS ARE TO BE COORDINATED WITH ARCHITECT'S. REFLECTED CEILING PLANS AND OTHER TRADES (DIFFUSERS, LIGHTING FIXTURES, CEILING SYSTERS AND STRUCTURAL SYSTEM).
- 11. SPRINKLERS THAT ARE WITHIN 24" OF ANY MECHANICAL GRILLE OR WITHIN 6" OF ANY LIGHT FIXTURE SHALL BE INTERMEDIATE TEMPERATURE RATED. NOT A ARCHITECT/ ENGINEER IN WRITING OF ANY DISCREPANCIES.
- 12. METHODS OF HANGING PIPES, HEADERS AND BRANCHES SHALL BE IN ACCORDANCE WITH N.F.P.A. 13.
- 13. AUTOMATIC SPRINKLER TEMPERATURE RATINGS WITH FUSIBLE ELEMENTS TO BE IN ACCORDANCE WITH N.F.P.A. 13. ALL FIRE SPRINKLER TEMPERATURE RATINGS WITH FUSIBLE ELEMENTS TO BE IN ACCORDANCE WITH N.F.P.A. 13. ALL FIRE SPRINKLER TEMPERATURE RATINGS WITH FUSIBLE ELEMENTS TO BE IN ACCORDANCE WITH N.F.P.A. 13. ALL FIRE SPRINKLER TEMPERATURE RATINGS WITH FUSIBLE ELEMENTS TO BE IN ACCORDANCE WITH N.F.P.A. 13. ALL FIRE SPRINKLER TEMPERATURE RATINGS WITH FUSIBLE ELEMENTS TO BE IN ACCORDANCE WITH N.F.P.A. 13. ALL FIRE SPRINKLER TEMPERATURE RATINGS WITH FUSIBLE ELEMENTS TO BE IN ACCORDANCE WITH N.F.P.A. 13. ALL FIRE SPRINKLER TEMPERATURE RATINGS WITH FUSIBLE ELEMENTS TO BE IN ACCORDANCE WITH N.F.P.A. 13. ALL FIRE SPRINKLER TEMPERATURE RATINGS WITH FUSIBLE ELEMENTS TO BE IN ACCORDANCE WITH N.F.P.A. 13. ALL FIRE SPRINKLER TO BE 155 F(ORDINARY TEMP.). IN CONDITIONED AREAS. 200 F (INTERMEDIATE TEMP.). IN NON-CONDITIONED AREAS AND SHALL BE IN ACCORDANCE WITH NFPA 13 CHAPTER 8 "INSTALLATION REQUIREMENT" - 8.3.2.5
- 14. SPRINKLERS SHALL COVER THE ENTIRE AREA OF THE ROOM INCLUDING ALCOVES. SPRAY SHALL NOT BE BLOCKED PWALLS, PARTITIONS OR PRIVACY CURTAINS.
- 15. ALL SPRINKLERS MOUNTED IN CEILING SHALL BE LOCATED A MINIMUM OF 4-INCHES AWAY FROM ANY WALL, CEILING HEIGHT CHANGES OR ANY OTHER VERTICAL INTERSECTING SURFACE.
- 16. PIPE SHALL BE REAMED AND CLEANED BEFORE ASSEMBLY.
- 17. MAINTAIN A MINIMUM OF 18-INCHES FROM THE BOTTOM OF THE SPRINKLER DEFLECTOR 7. THE TOP OF STORAGE/ FILE STORAGE.
- 18. PROVIDE SPRINKLER SYSTEM(S) WITH FLUSHING CONNECTION(S).
- 19. PROVIDE SPRINKLERS ABOVE AND BELOW EXPOSED DUCTWORK 4-FEET R WIDER.
- 20. MINOR DETAILS, NOT USUALLY SHOWN OR SPECIFIED, BUT NFC SARY FOR PROPER OPERATION AND CONSISTENT WITH GOOD WORKMANSHIP, WILL BE INCLUDED IN THE ESTIMATE, THE SAME AS IF SHOWN ON DRAWINGS.
- 21. OFFER REMOVED MATERIAL TO THE OWNER. REMOVE ALL MATERIAL REJECTED BY THE OWNER FROM THE WORK SITE AND DISPOSE OF IN ACCORDANCE WITH APPLICABLE LOCAL, STATE AND NATIONAL CODES. CONTRACTOR MUST CERTIFIE TO OWNER THAT THE MATERIAL HAS BEEN LEGALLY DISPOSED OF.
- 22. ALL SPRINKLERS INDICATED ON RAWINGS PREPARED BY ENGINEER OF RECORD FOR THE FIRE SPRINKLER SYSTEM ARE FOR COORDINATION PURPOSES ONLY. CONTRACTOR SHALL VERIFY COVERAGE AND ADD SPRING ARS AS REQUIRED. CONTRACTOR SHALL PROVIDE FULL SPRINKLER PROTECTION IN ATTICE JONSTRUCTED WITH COMBUSTIBLE MATERIALS WHERE ROOF PLYWOOD OR STRUCTURAL MEMBERS, INDICATED ON STRUCTURAL PLANS OR AS-BUILT IN THE FIELD, OBSTRUCT SPRINKLAR SPRAY PATTERNS.
- 23. THIS IS A LODIFICATION TO AN EXISTING FIRE SPRINKLER SYSTEM. THIS AREA IS NOT THE HMD THEREFORE NO HYDRAULIC CALCULATIONS ARE REQUIRED.
- S TENANT COMPLETION HAS BEEN DESIGNED FOR A LIGHT HAZARD OCCUPANCY FOR DINNING AREAS AND ORDINARY HAZARD GROUP1 FOR THE KITCHEN AREA, AUTOMATIC WET TYPE SYSTEM. THE MINIMUM DENSITY SHALL BE 0.10 FOR DINNING AREA AND 0.15 FOR KITCHEN AND SPRINKLER SPACING SHALL BE AS DESCRIBED BY NFPA 13 FOR LIGHT AND ORDINARY HAZARD OCCUPANCIES.

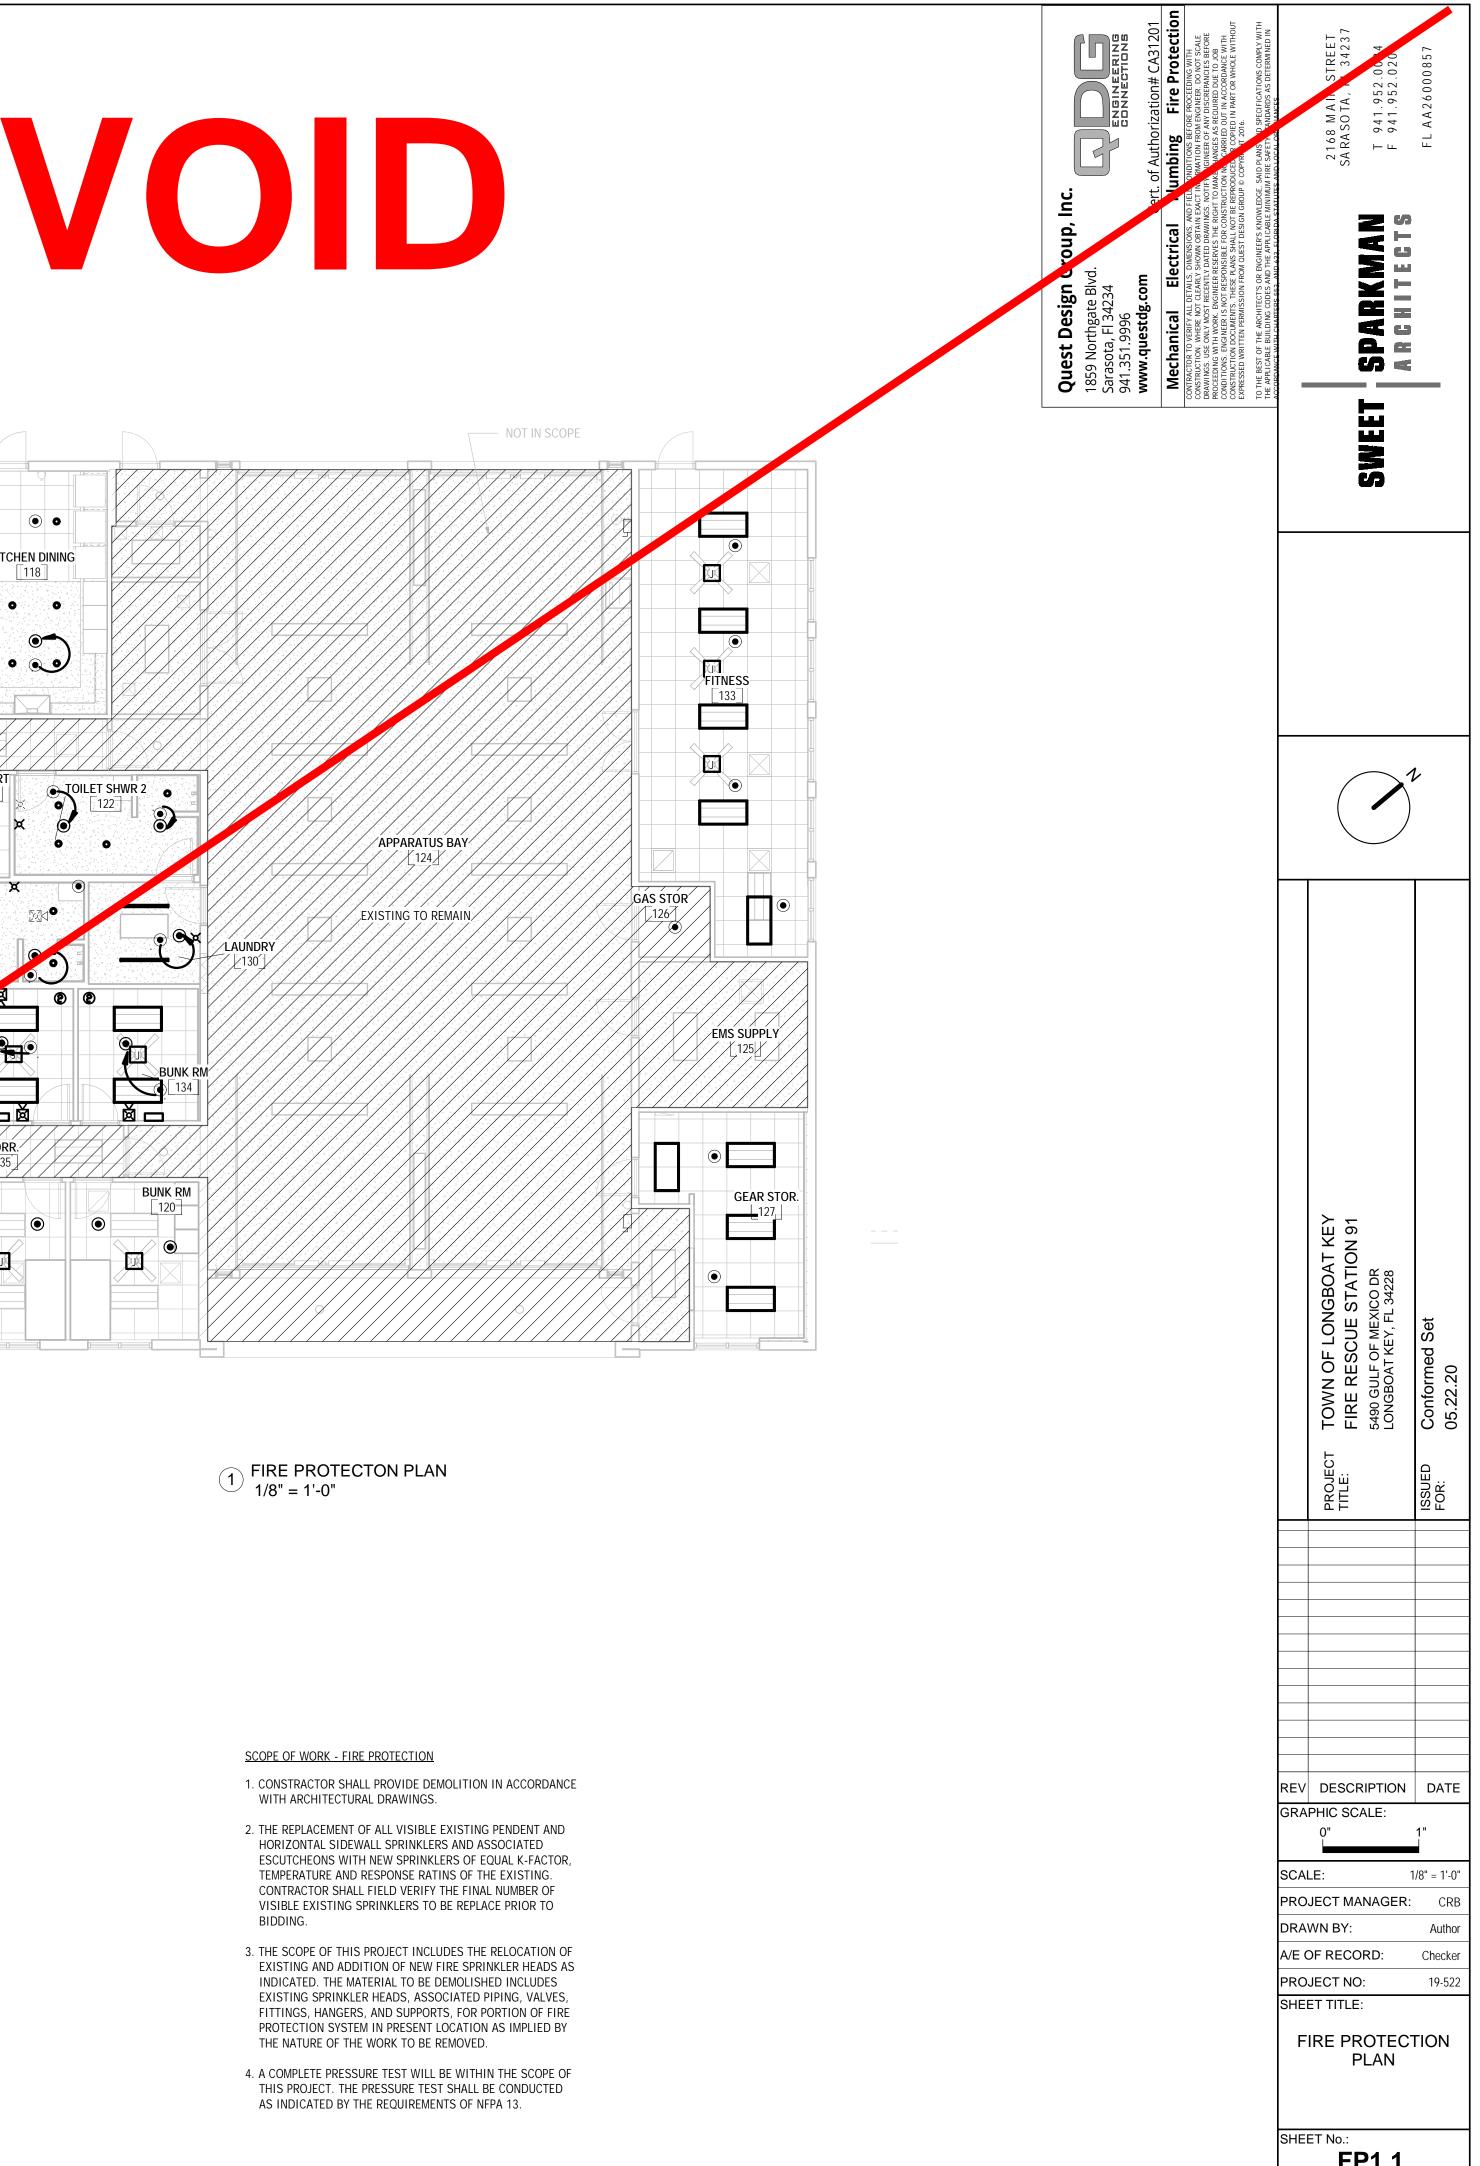

FP1.1