


1"=40'

LEGEND

TRAVEL LANES/TURN LANES/
GORE AREA MILLING
& RESURFACING (3 1/2")

SIDE STREET/SHOULDER
MILLING & RESURFACING
(1 1/2")

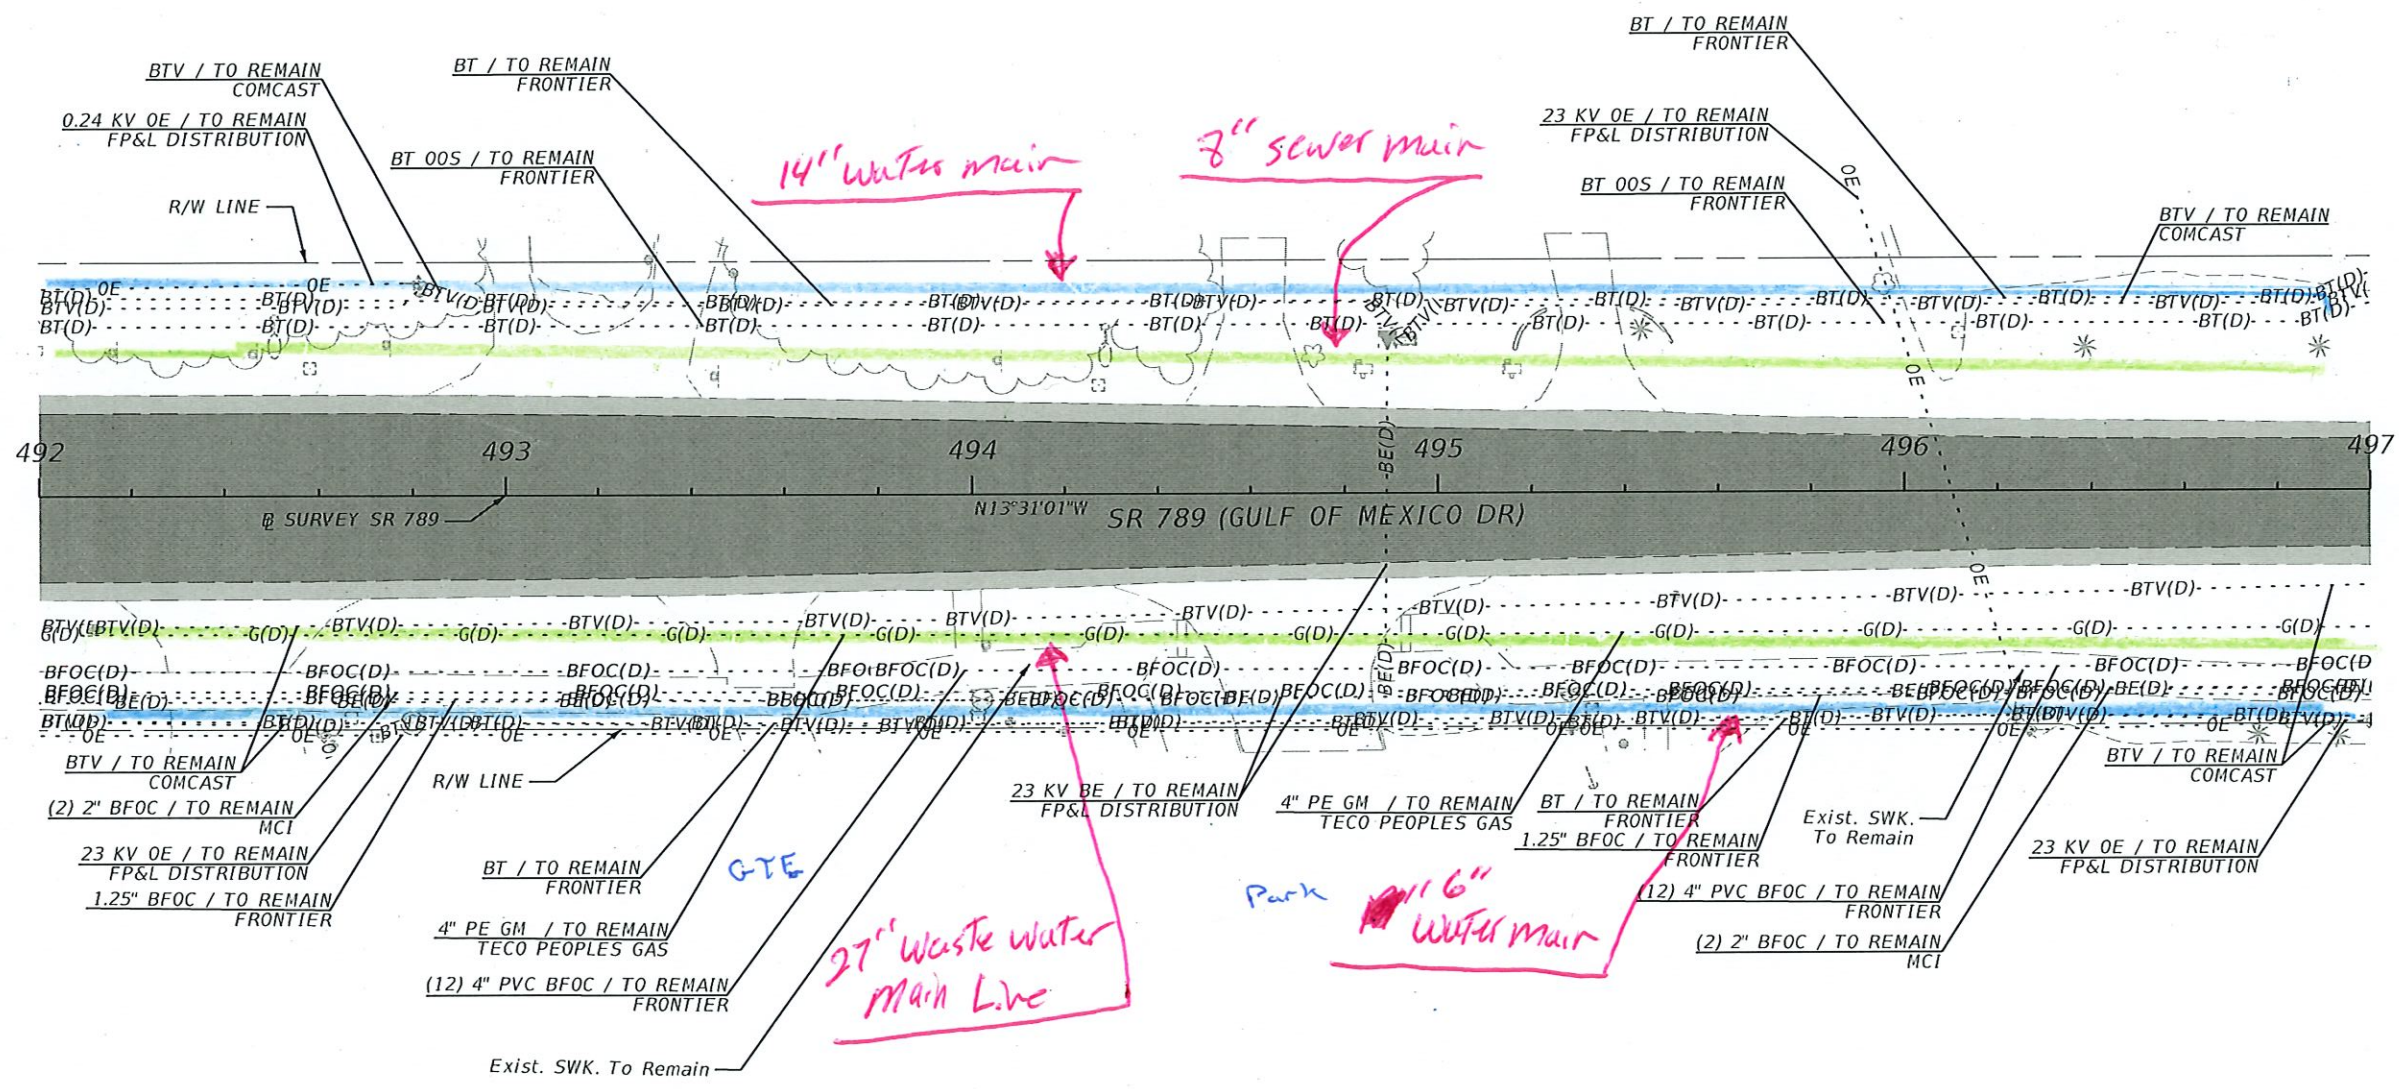

REVISIONS				ENGINEER OF RECORD	STATE OF FLORIDA DEPARTMENT OF TRANSPORTATION			ROADWAY PLAN (47)	SHEET NO. 82
DATE	DESCRIPTION	DATE	DESCRIPTION		ROAD NO.	COUNTY	FINANCIAL PROJECT ID		
					SR 789	SARASOTA	451013-1-52-01		


MEGAN LERNER, P.E.
LICENSE NUMBER: 72217
GARRETT ENGINEERING GROUP, INC.
120 10TH AVENUE NORTH
SAINT PETERSBURG, FL 33701

THE OFFICIAL RECORD OF THIS SHEET IS THE ELECTRONIC FILE DIGITALLY SIGNED AND SEALED UNDER RULE 61G15-23.004, F.A.C.


1"=40'

LEGEND

- TRAVEL LANES/TURN LANES/
GORE AREA MILLING
& RESURFACING (3 1/2')
- SIDE STREET/SHOULDER
MILLING & RESURFACING
(1 1/2')

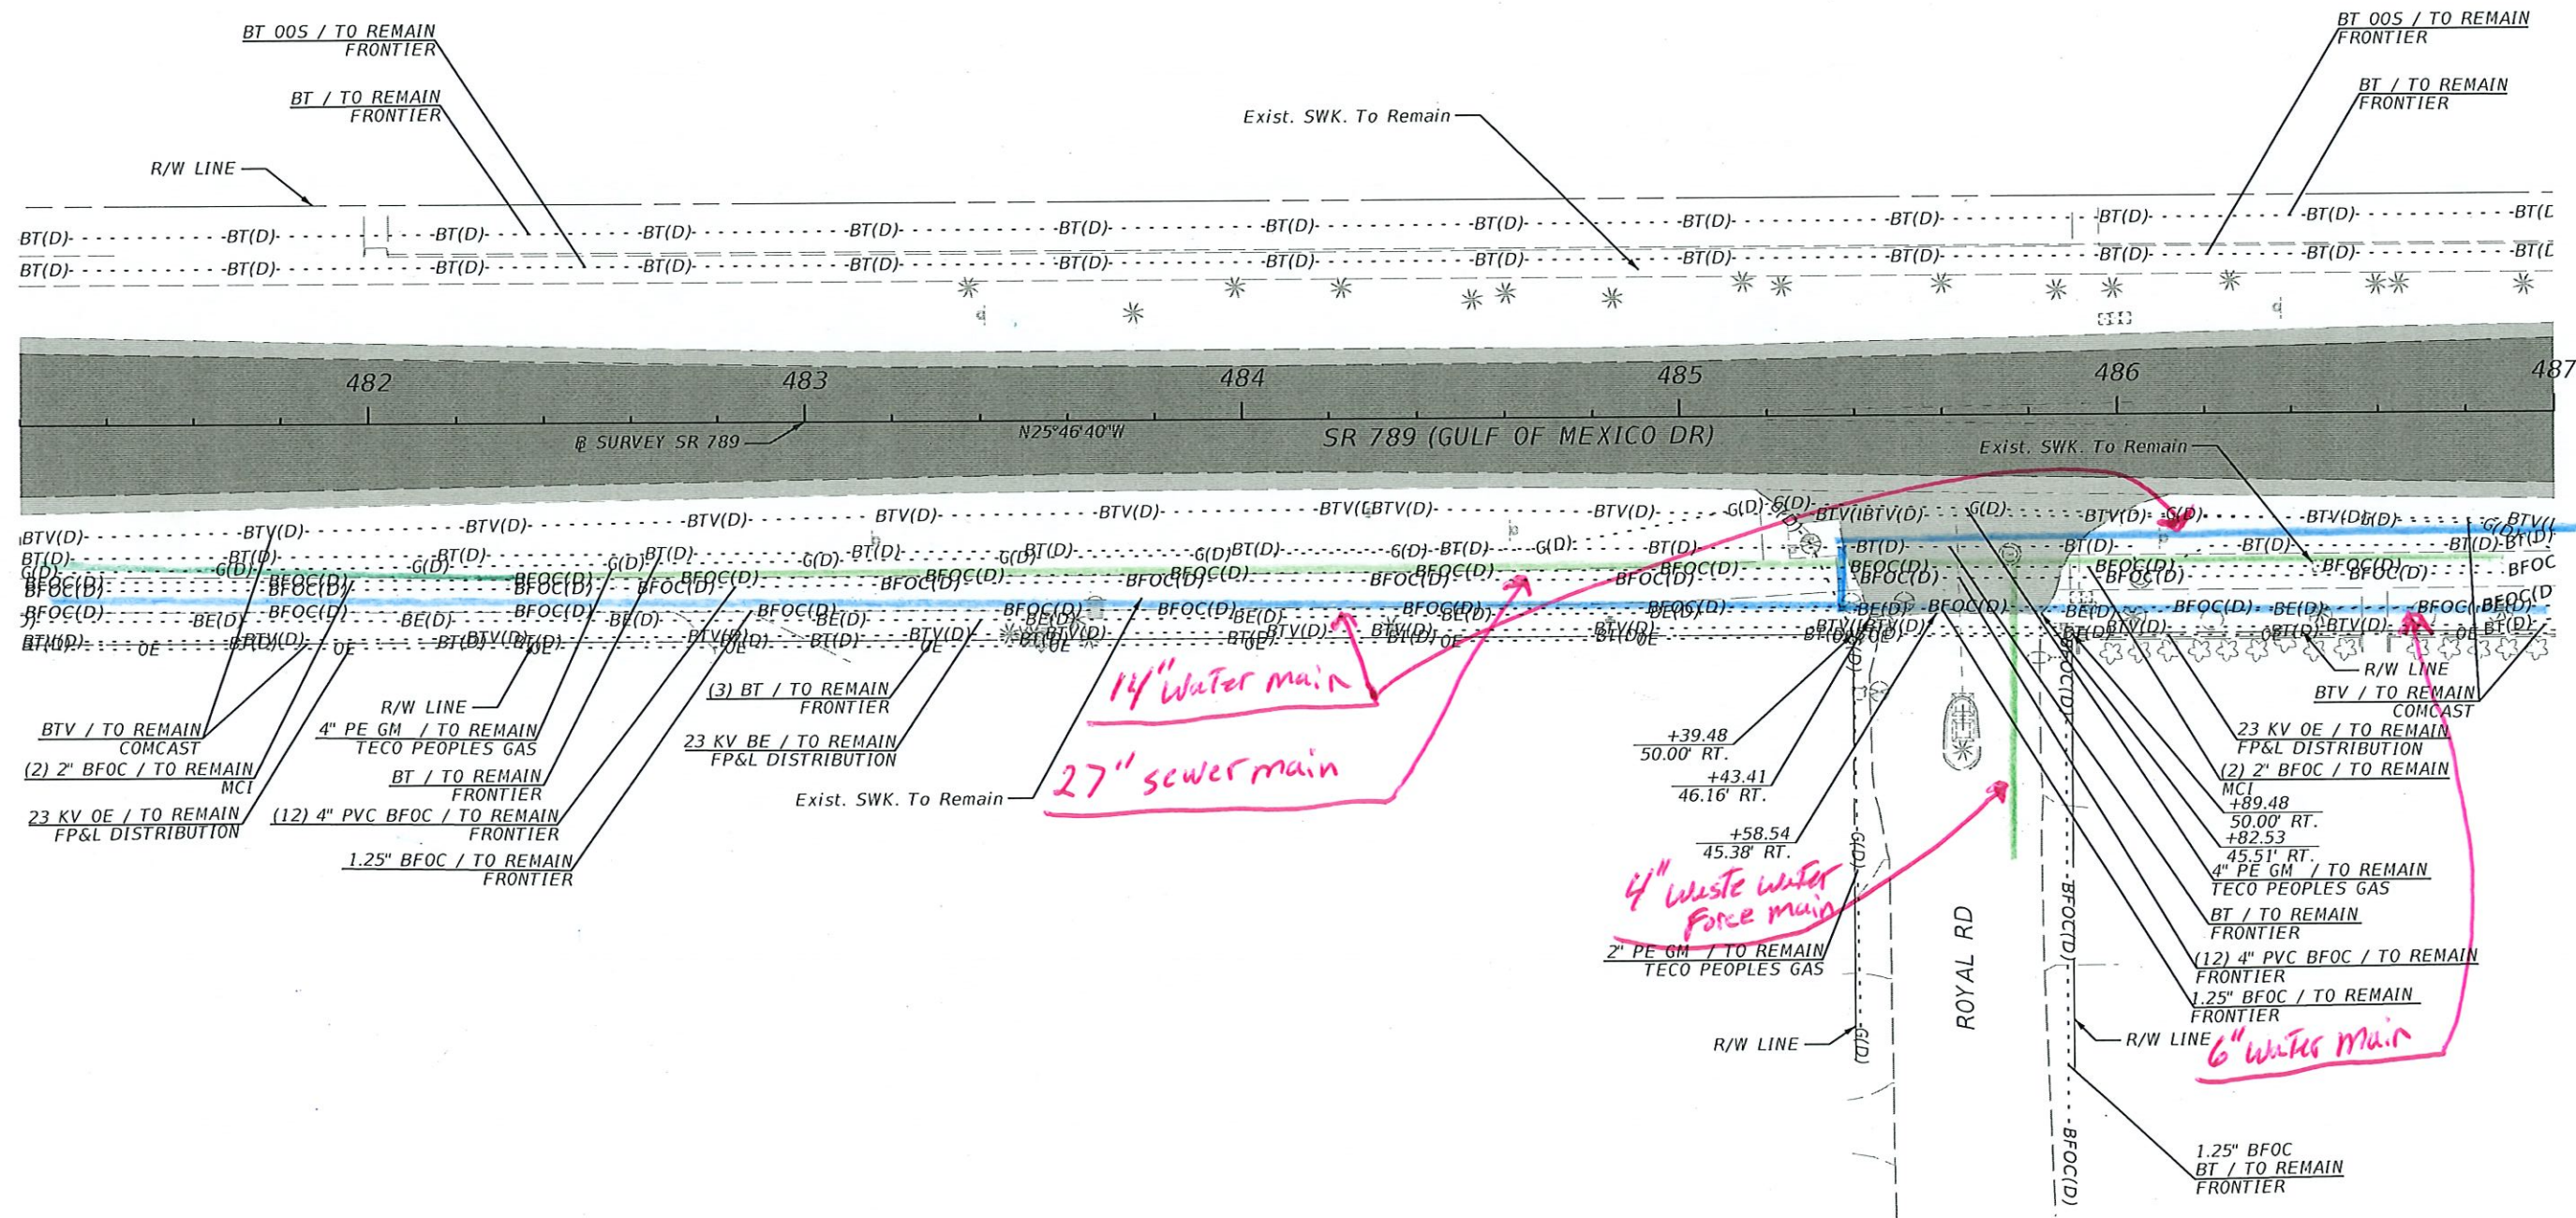


REVISIONS				ENGINEER OF RECORD		STATE OF FLORIDA DEPARTMENT OF TRANSPORTATION		ROADWAY PLAN (45)	SHEET NO. 80
DATE	DESCRIPTION	DATE	DESCRIPTION	MEGAN LERNER, P.E. LICENSE NUMBER: 72217 GARRETT ENGINEERING GROUP, INC. 120 10TH AVENUE NORTH SAINT PETERSBURG, FL 33701		ROAD NO.	COUNTY	FINANCIAL PROJECT ID	
						SR 789	SARASOTA	451013-1-52-01	

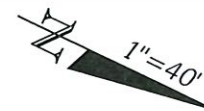

LEGEND

- TRAVEL LANES/TURN LANES/
GORE AREA MILLING
& RESURFACING (3 1/2")
- SIDE STREET/SHOULDER
MILLING & RESURFACING
(1 1/2")

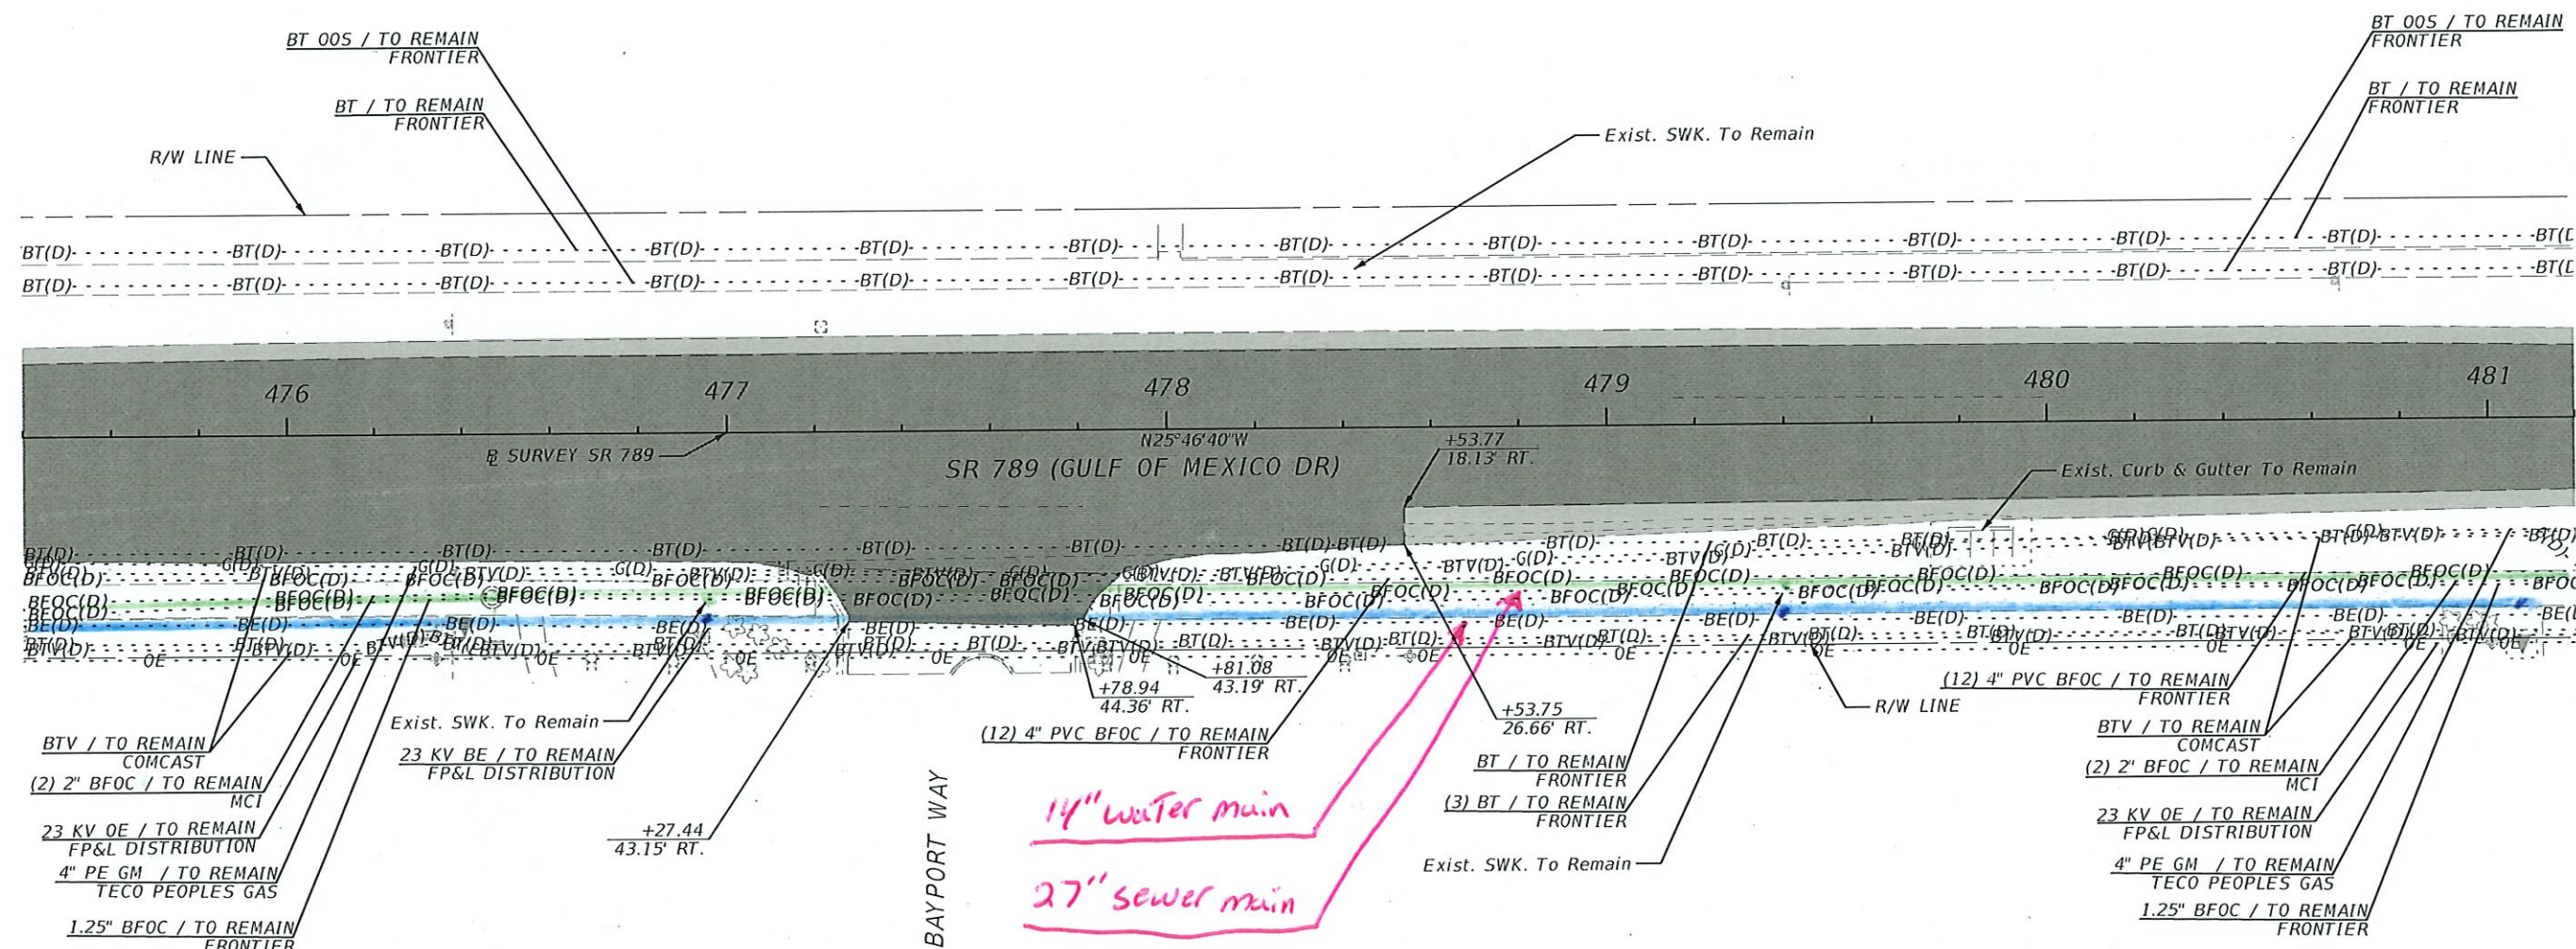


REVISIONS				ENGINEER OF RECORD		STATE OF FLORIDA DEPARTMENT OF TRANSPORTATION			ROADWAY PLAN (44)	SHEET NO. 79
DATE	DESCRIPTION	DATE	DESCRIPTION	MEGAN LERNER, P.E. LICENSE NUMBER: 72217 GARRETT ENGINEERING GROUP, INC. 120 10TH AVENUE NORTH SAINT PETERSBURG, FL 33701		ROAD NO.	COUNTY	FINANCIAL PROJECT ID		
						SR 789	SARASOTA	451013-1-52-01		

1"=40'

LEGEND


- TRAVEL LANES/TURN LANES/
GORE AREA MILLING
& RESURFACING (3 1/2")
- SIDE STREET/SHOULDER
MILLING & RESURFACING
(1 1/2")

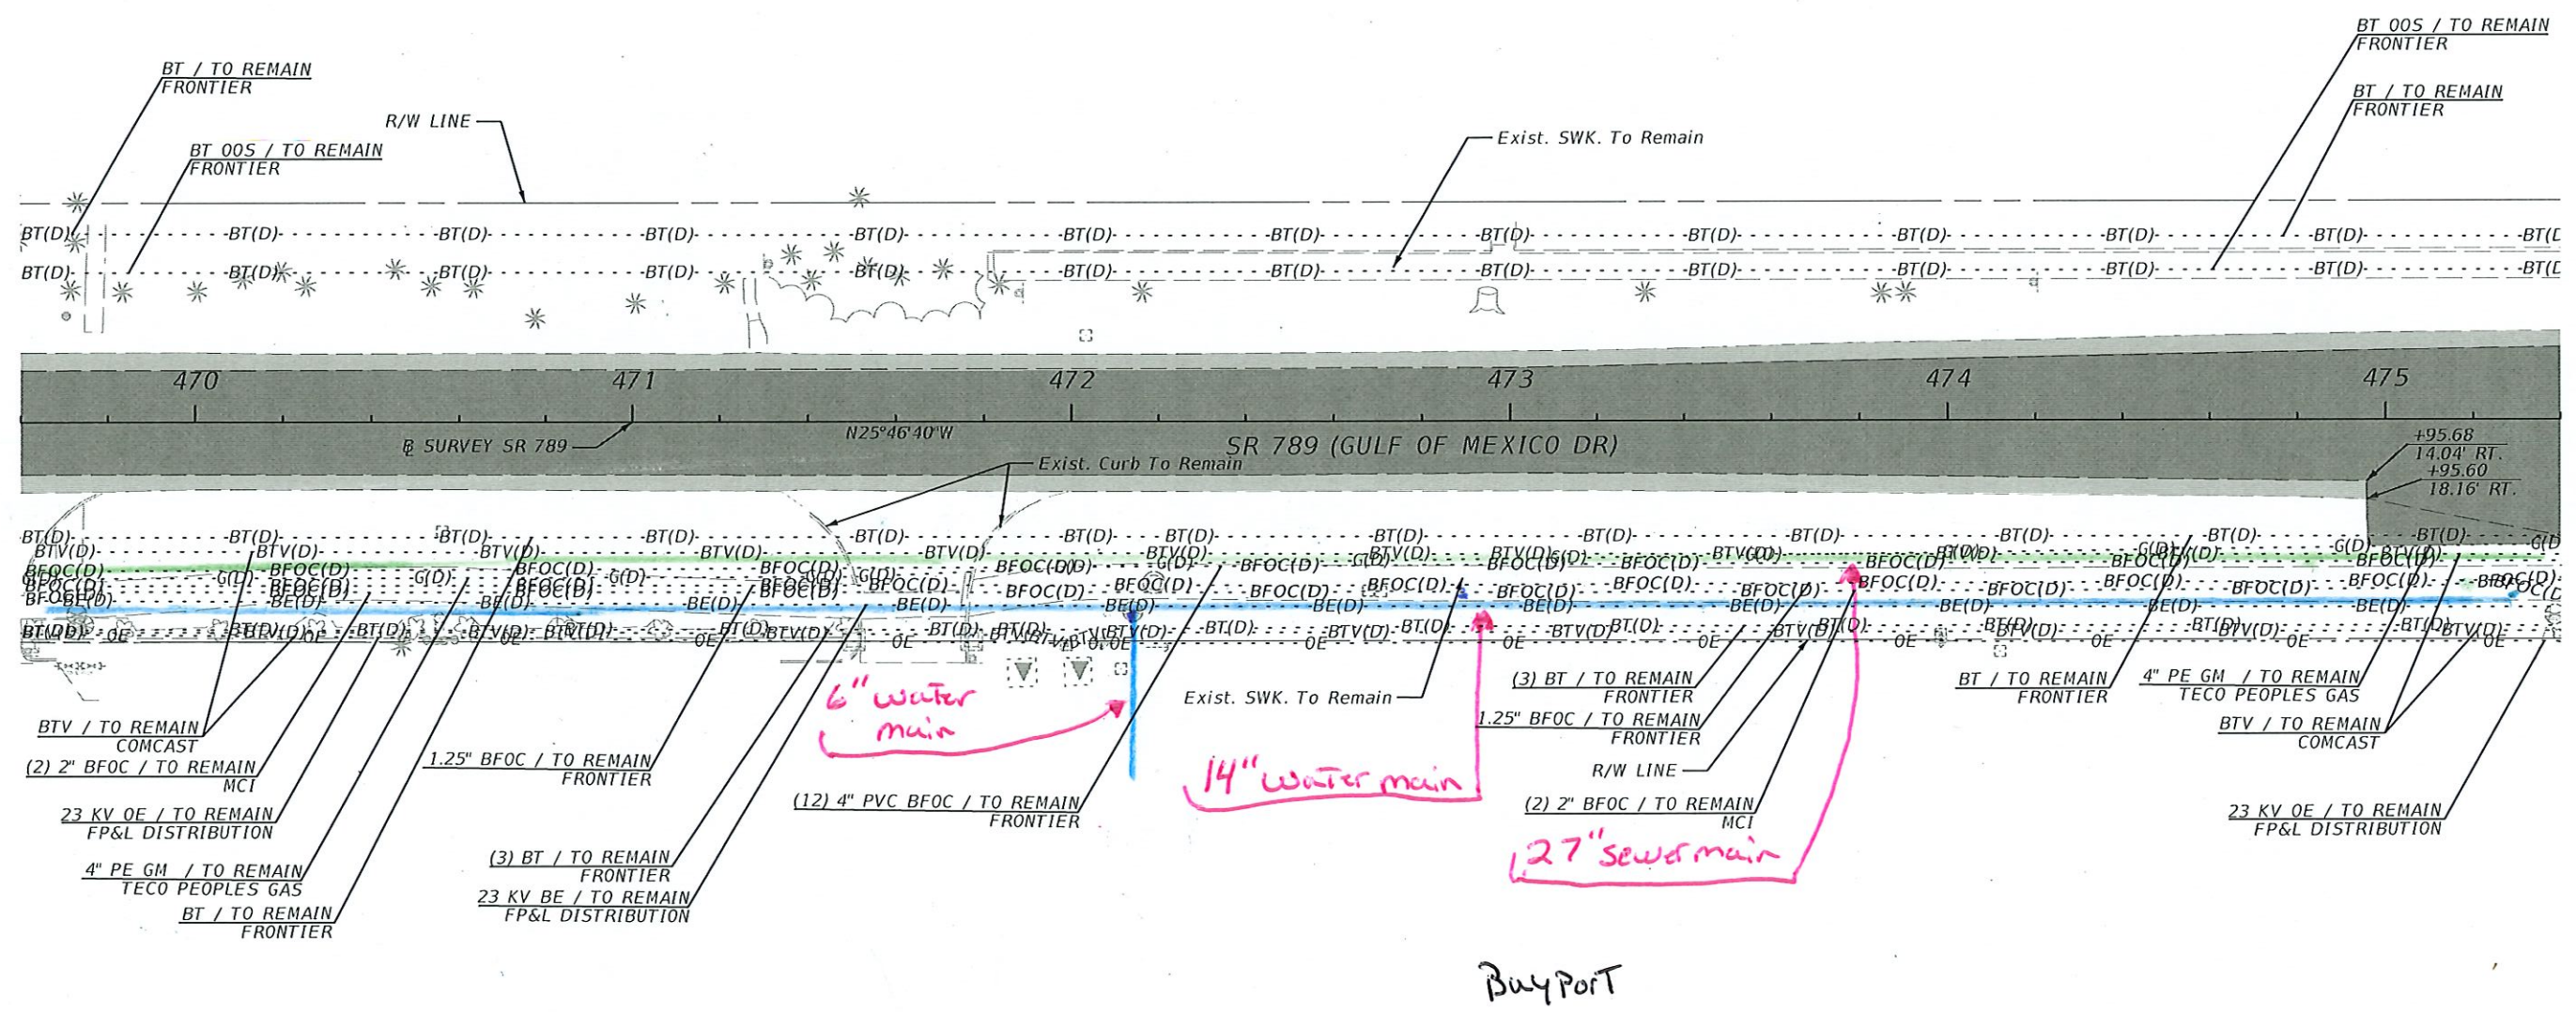

REVISIONS				ENGINEER OF RECORD	STATE OF FLORIDA DEPARTMENT OF TRANSPORTATION			ROADWAY PLAN (43)	SHEET NO. 78
DATE	DESCRIPTION	DATE	DESCRIPTION		ROAD NO.	COUNTY	FINANCIAL PROJECT ID		
					SR 789	SARASOTA	451013-1-52-01		

MEGAN LERNER, P.E.
LICENSE NUMBER: 72217
GARRETT ENGINEERING GROUP, INC.
120 10TH AVENUE NORTH
SAINT PETERSBURG, FL 33701

THE OFFICIAL RECORD OF THIS SHEET IS THE ELECTRONIC FILE DIGITALLY SIGNED AND SEALED UNDER RULE 61G15-23.004, F.A.C.

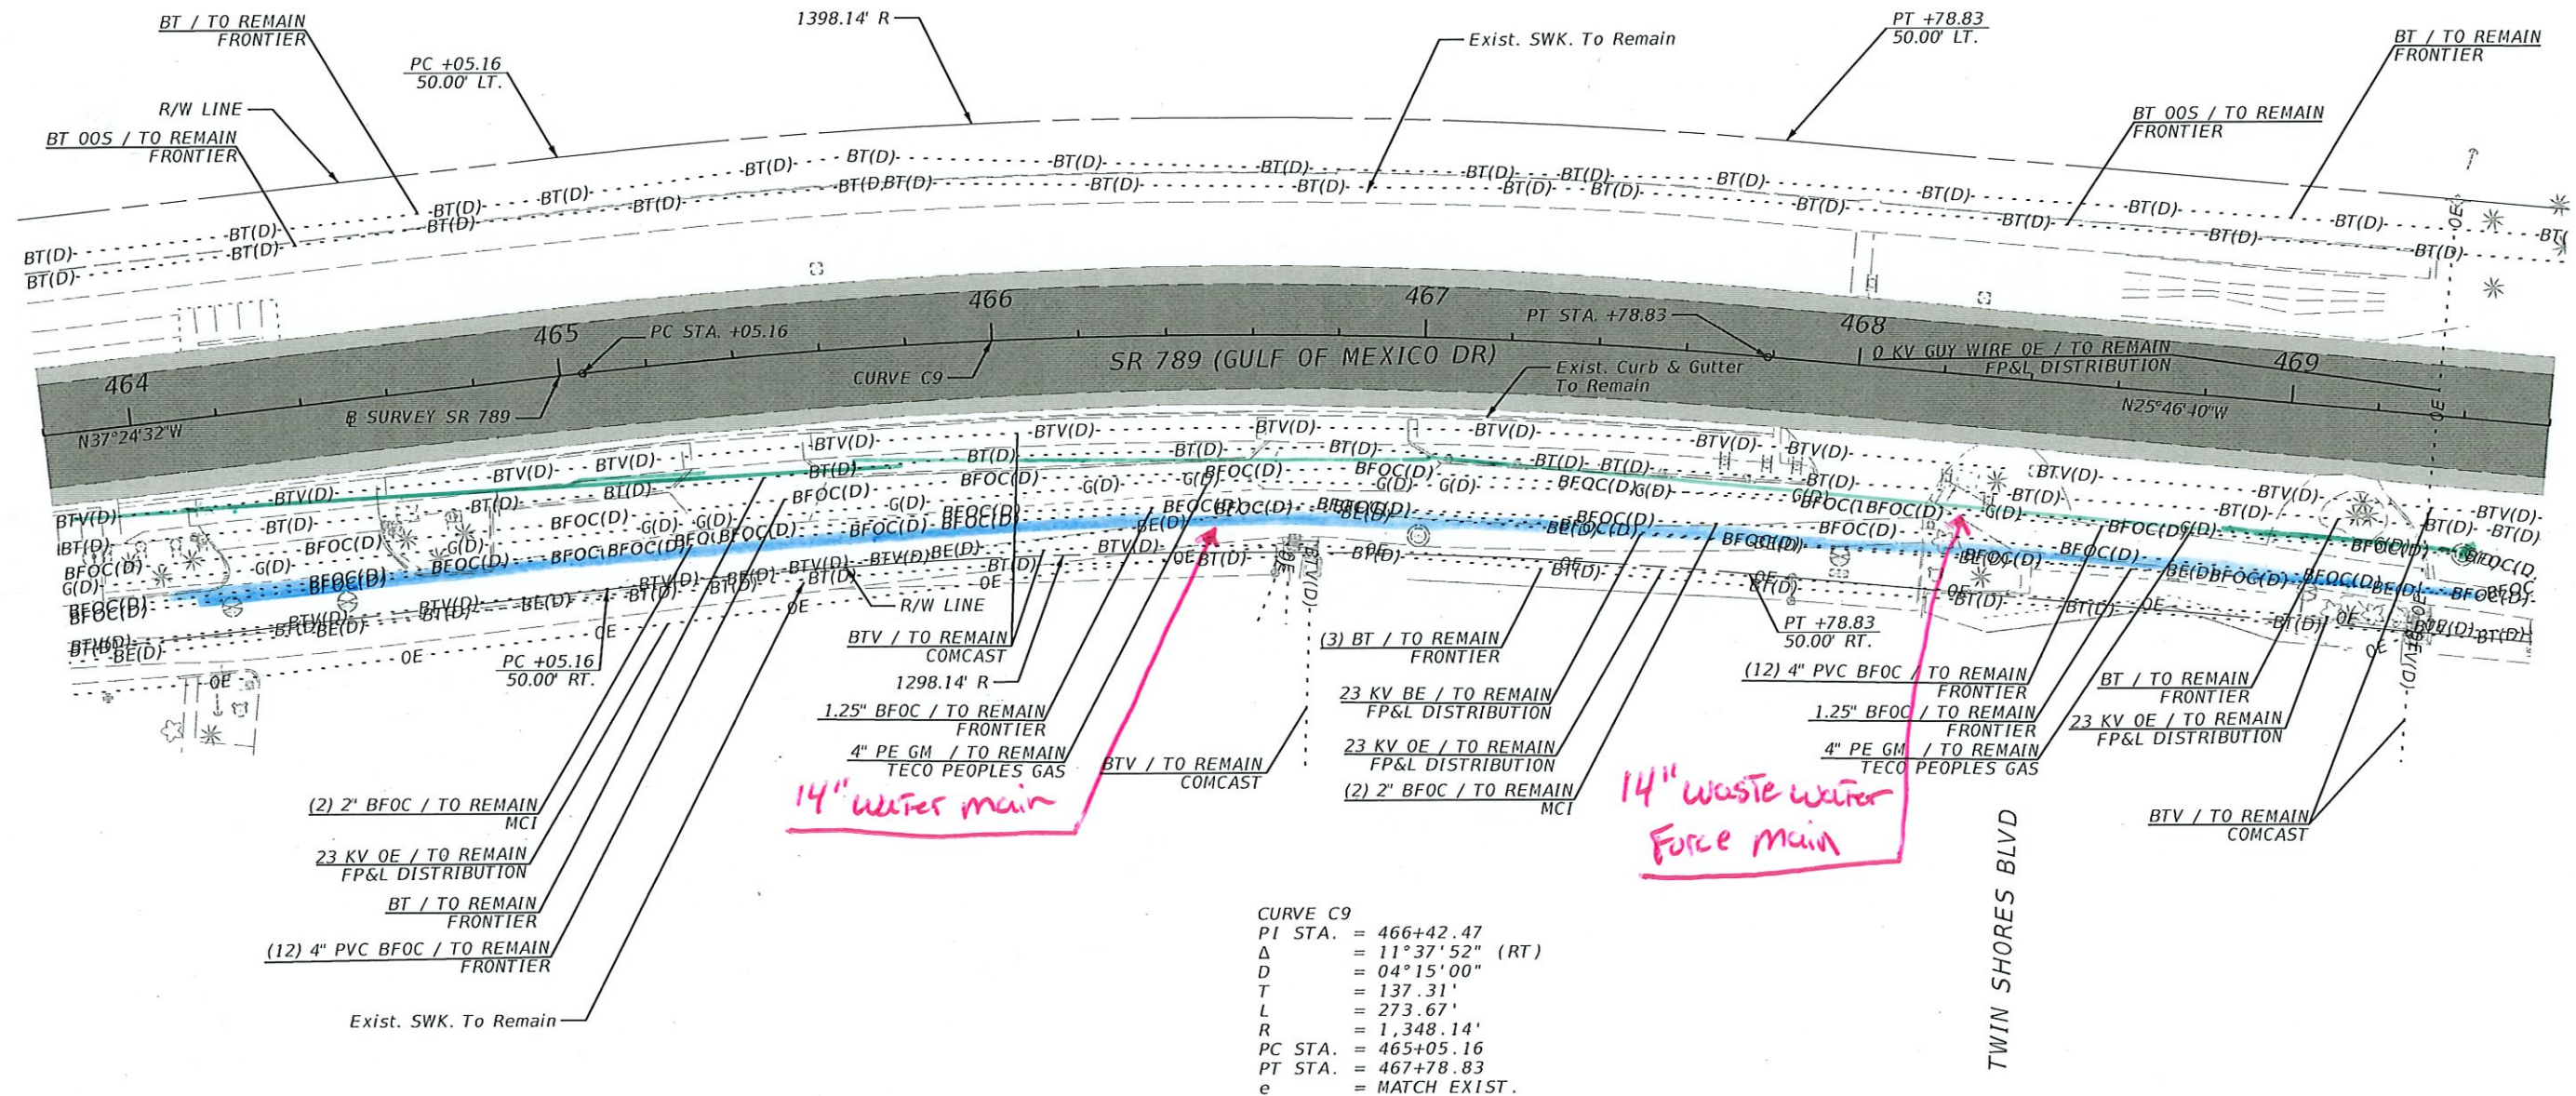


REVISIONS				ENGINEER OF RECORD	STATE OF FLORIDA DEPARTMENT OF TRANSPORTATION			ROADWAY PLAN (42)	SHEET NO.
DATE	DESCRIPTION	DATE	DESCRIPTION	MEGAN LERNER, P.E. LICENSE NUMBER: 72217 GARRETT ENGINEERING GROUP, INC. 120 10TH AVENUE NORTH SAINT PETERSBURG, FL 33701	ROAD NO.	COUNTY	FINANCIAL PROJECT ID		77
					SR 789	SARASOTA	451013-1-52-01		




LEGEND

- TRAVEL LANES/TURN LANES/
GORE AREA MILLING
& RESURFACING (3 1/2')
- SIDE STREET/SHOULDER
MILLING & RESURFACING
(1 1/2')

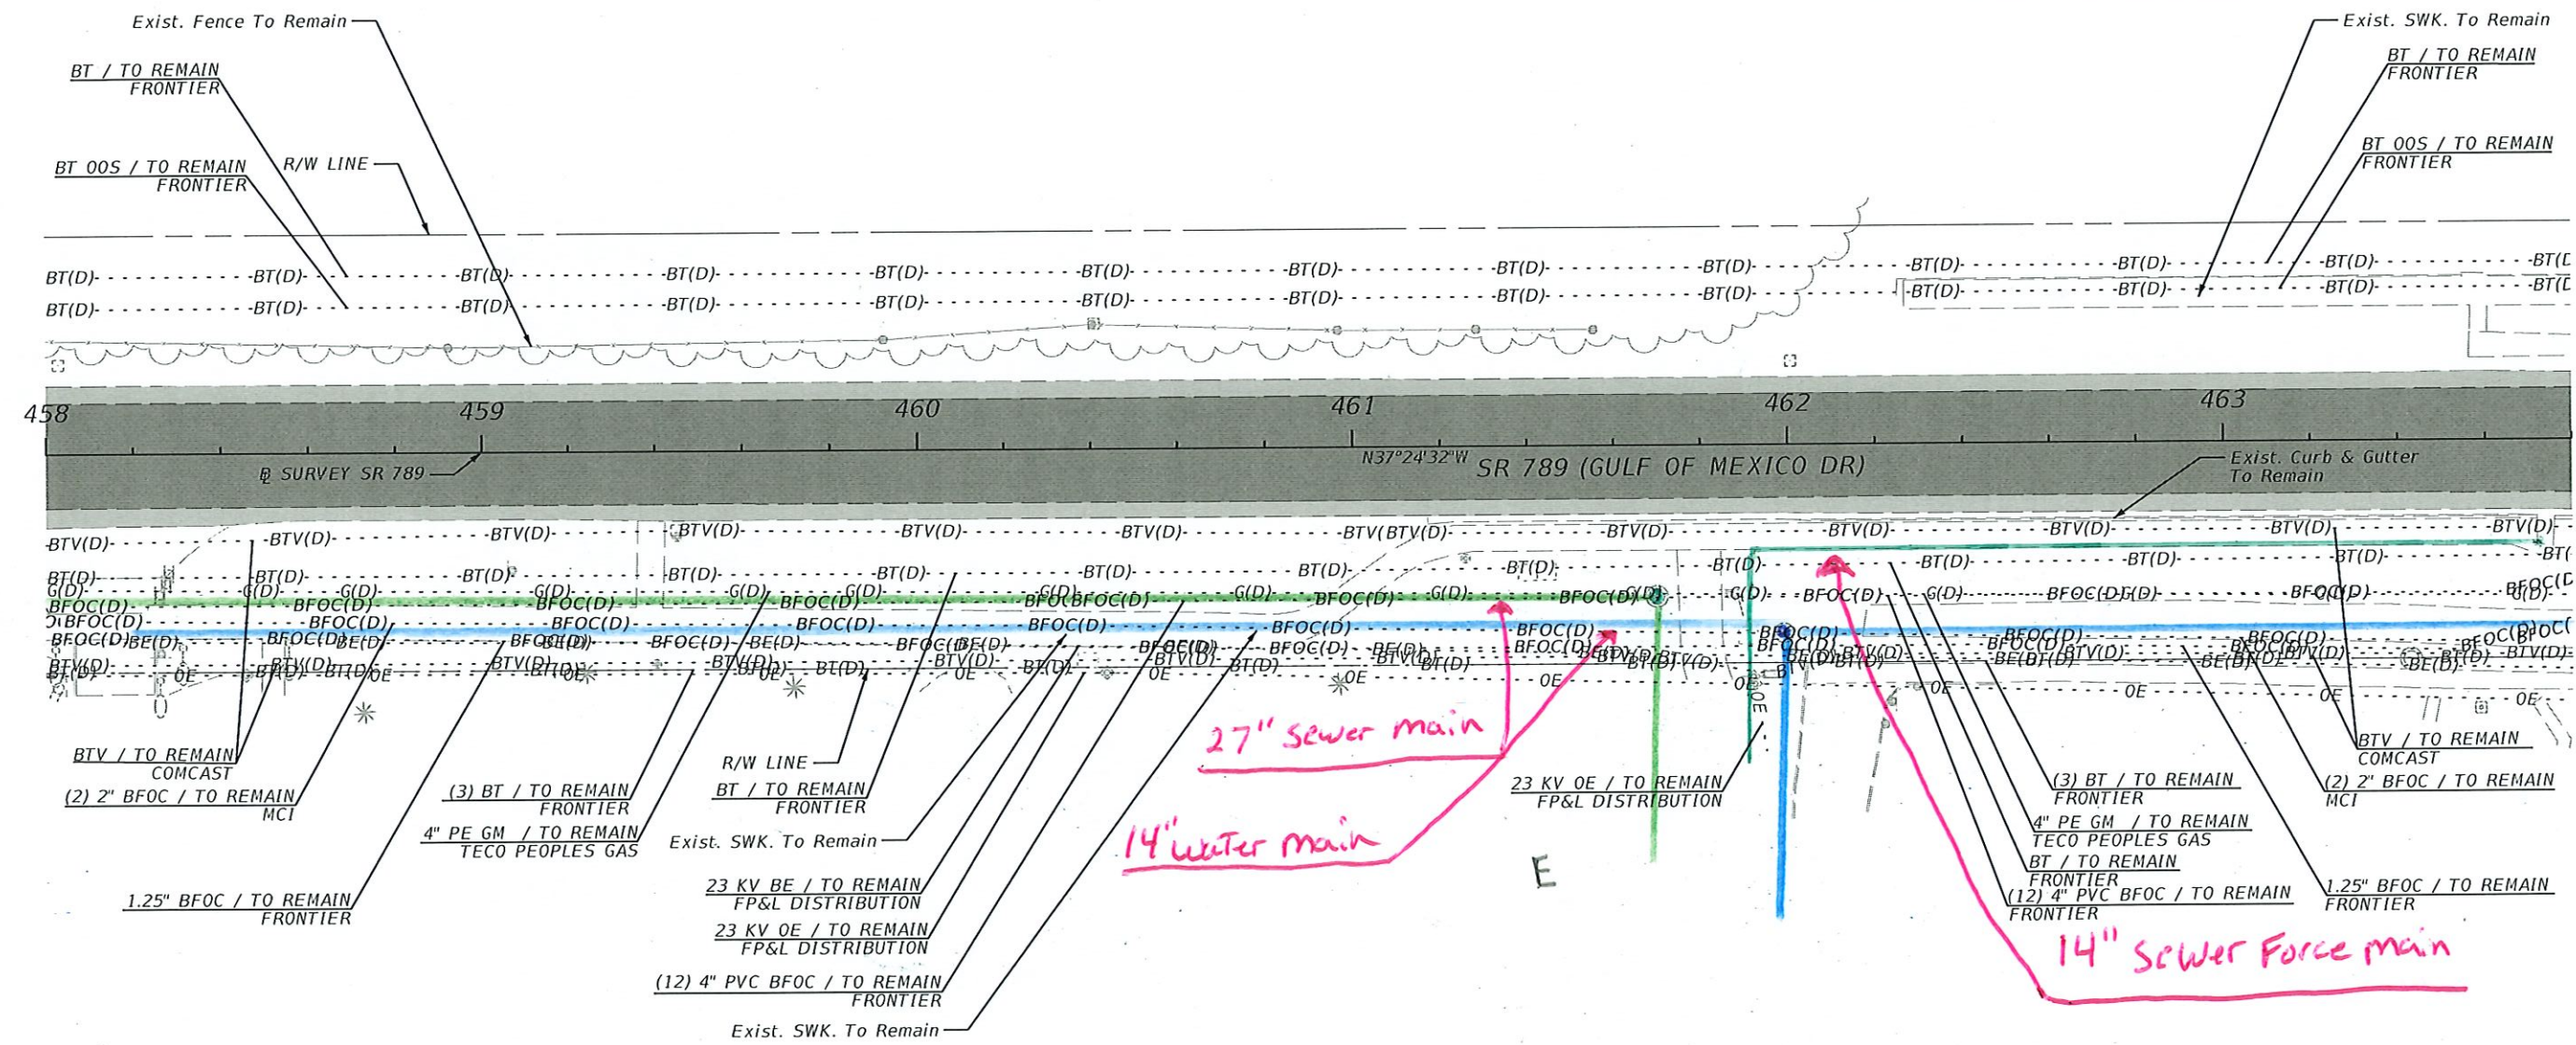


REVISIONS				ENGINEER OF RECORD		STATE OF FLORIDA DEPARTMENT OF TRANSPORTATION		ROADWAY PLAN (41)	SHEET NO. 76
DATE	DESCRIPTION	DATE	DESCRIPTION	MEGAN LERNER, P.E. LICENSE NUMBER: 72217 GARRETT ENGINEERING GROUP, INC. 120 10TH AVENUE NORTH SAINT PETERSBURG, FL 33701		ROAD NO.	COUNTY		
						SR 789	SARASOTA	FINANCIAL PROJECT ID 451013-1-52-01	

THE OFFICIAL RECORD OF THIS SHEET IS THE ELECTRONIC FILE DIGITALLY SIGNED AND SEALED UNDER RULE 61G15-23.004, F.A.C.

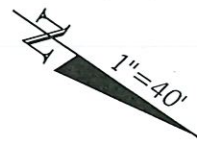

LEGEND


- TRAVEL LANES/TURN LANES/
GORE AREA MILLING
& RESURFACING (3 1/2")
- SIDE STREET/SHOULDER
MILLING & RESURFACING
(1 1/2")

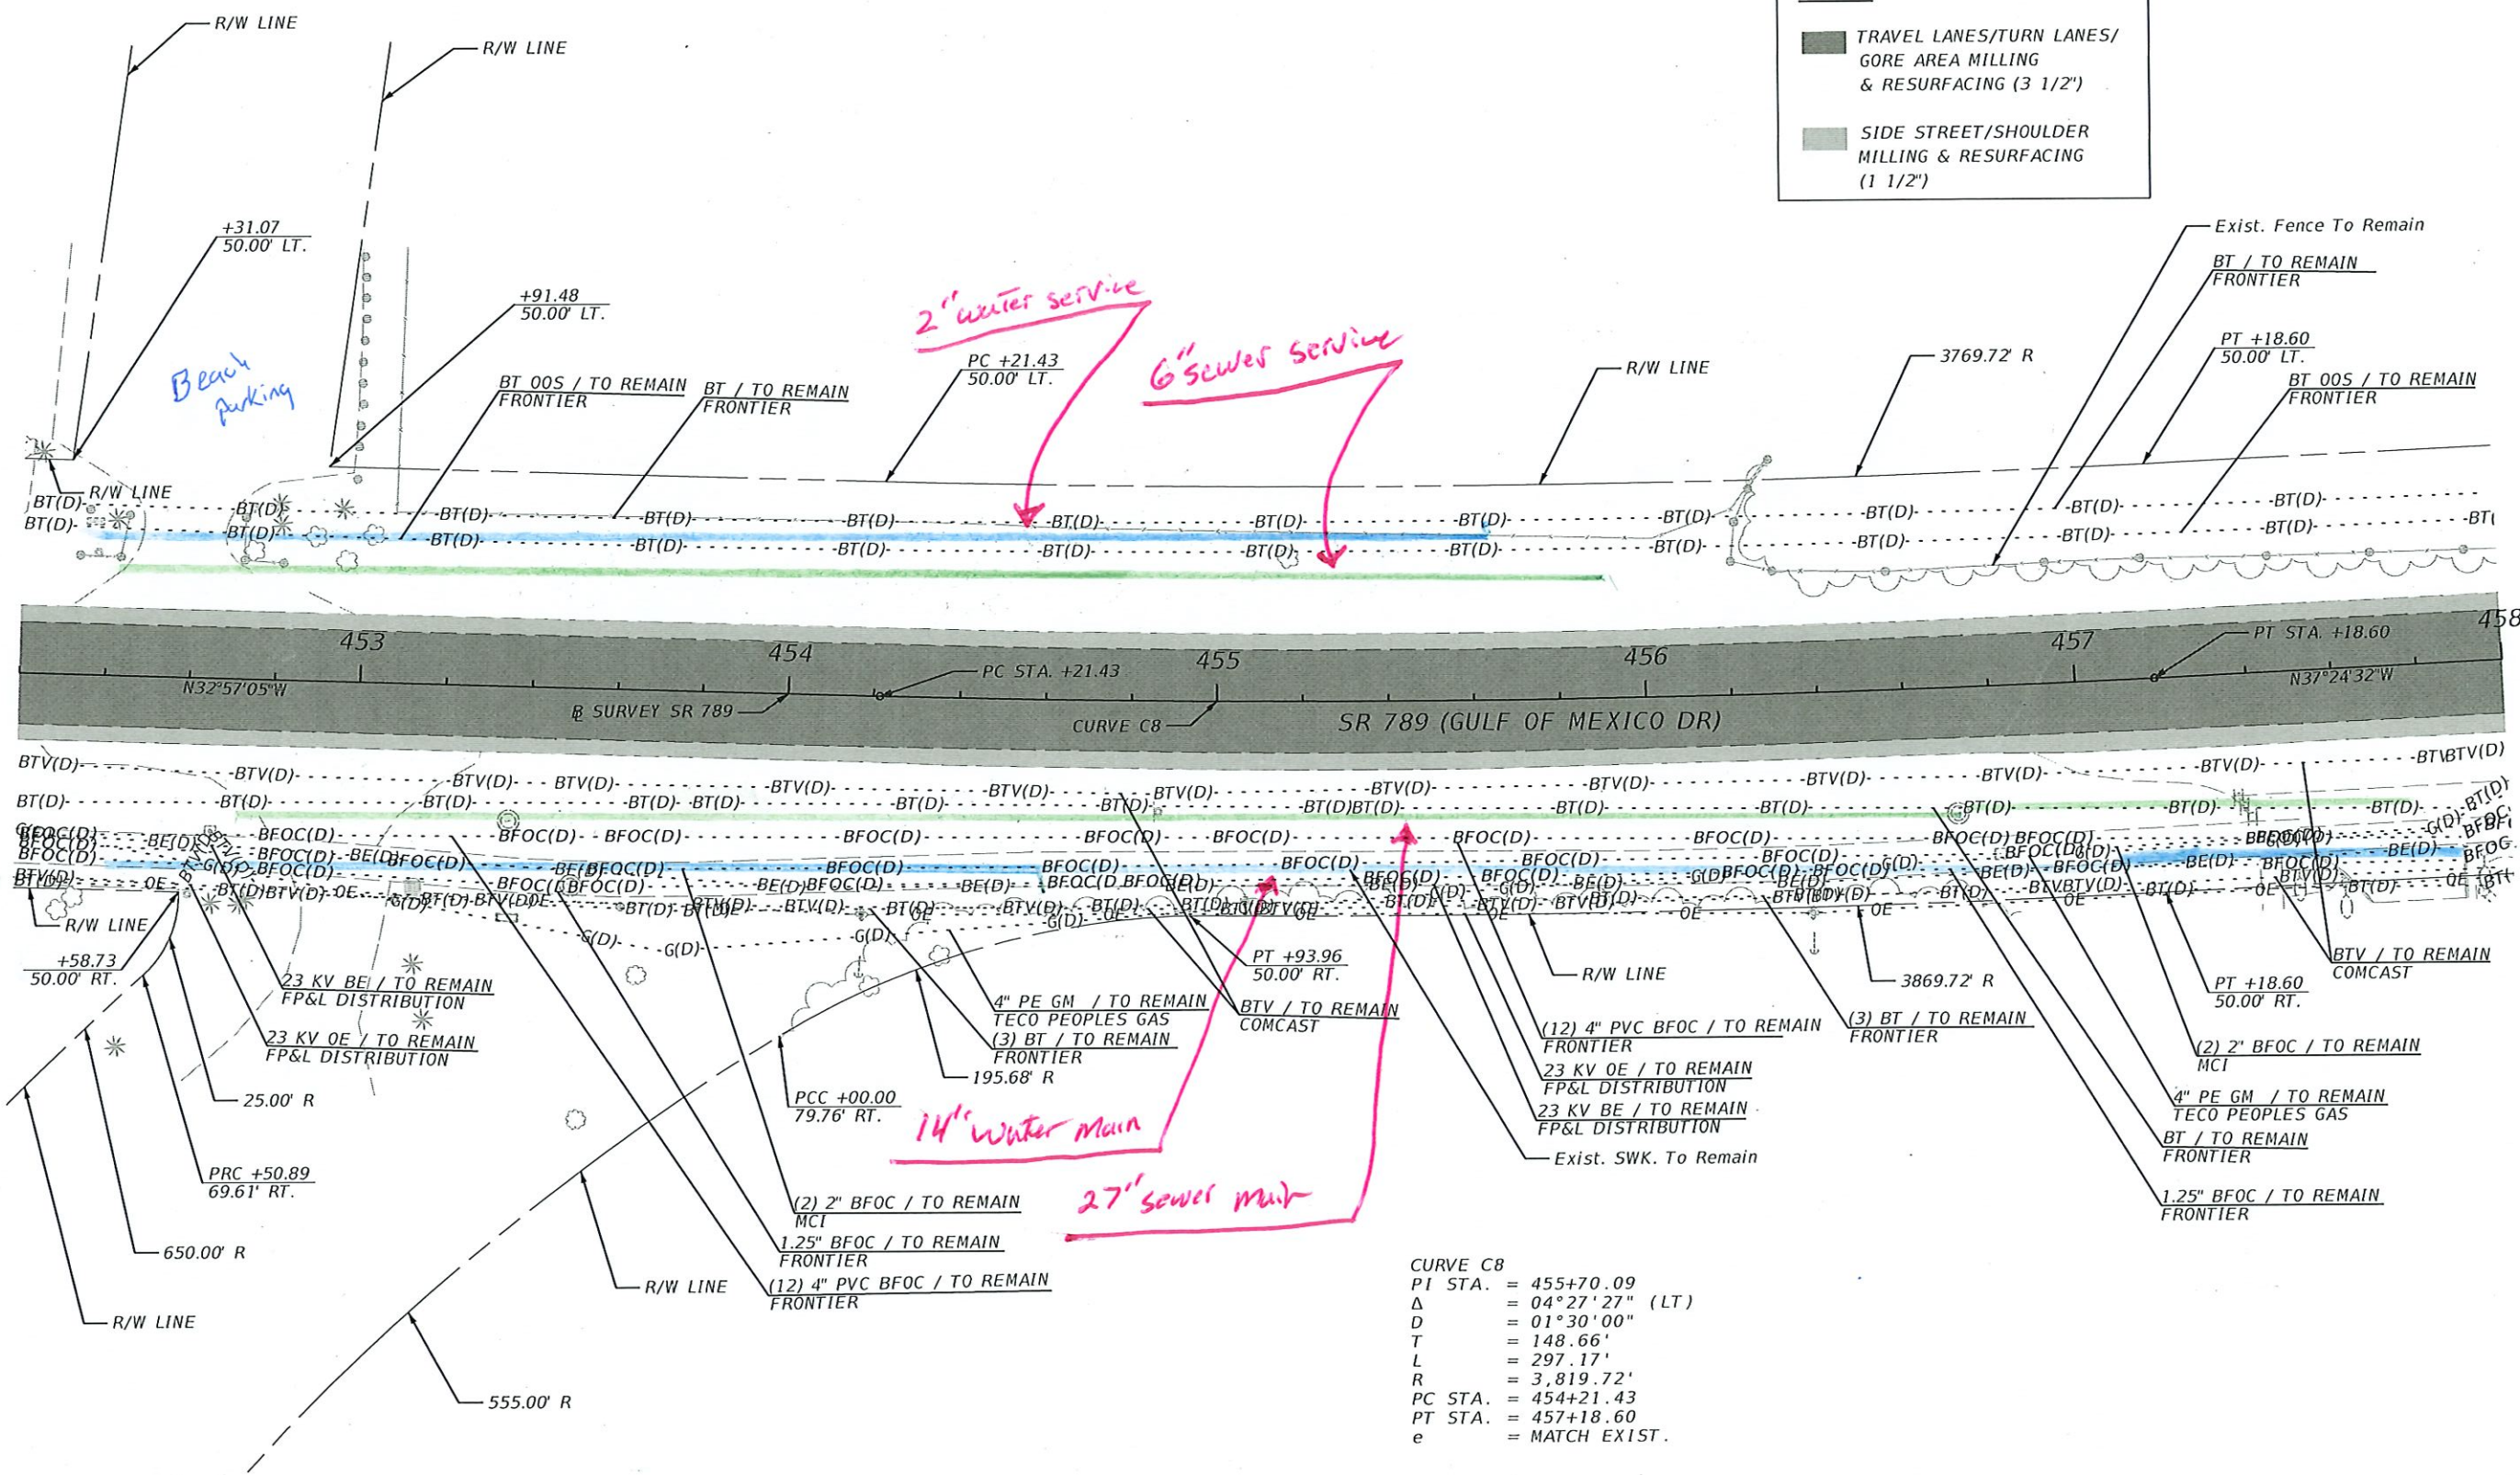

CURVE C8
PI STA. = 455+70.09
 Δ = 04°27'27" (LT)
D = 01°30'00"
T = 148.66'
L = 297.17'
R = 3,819.72'
PC STA. = 454+21.43
PT STA. = 457+18.60
e = MATCH EXIST.


REVISIONS				ENGINEER OF RECORD			STATE OF FLORIDA DEPARTMENT OF TRANSPORTATION			ROADWAY PLAN (40)	SHEET NO. 75
DATE	DESCRIPTION	DATE	DESCRIPTION	MEGAN LERNER, P.E. LICENSE NUMBER: 72217 GARRETT ENGINEERING GROUP, INC. 120 10TH AVENUE NORTH SAINT PETERSBURG, FL 33701			ROAD NO.	COUNTY	FINANCIAL PROJECT ID		
							SR 789	SARASOTA	451013-1-52-01		

THE OFFICIAL RECORD OF THIS SHEET IS THE ELECTRONIC FILE DIGITALLY SIGNED AND SEALED UNDER RULE 61G15-23.004, F.A.C.

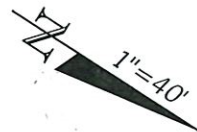


LEGEND

- TRAVEL LANES/TURN LANES/
GORE AREA MILLING
& RESURFACING (3 1/2")
- SIDE STREET/SHOULDER
MILLING & RESURFACING
(1 1/2")

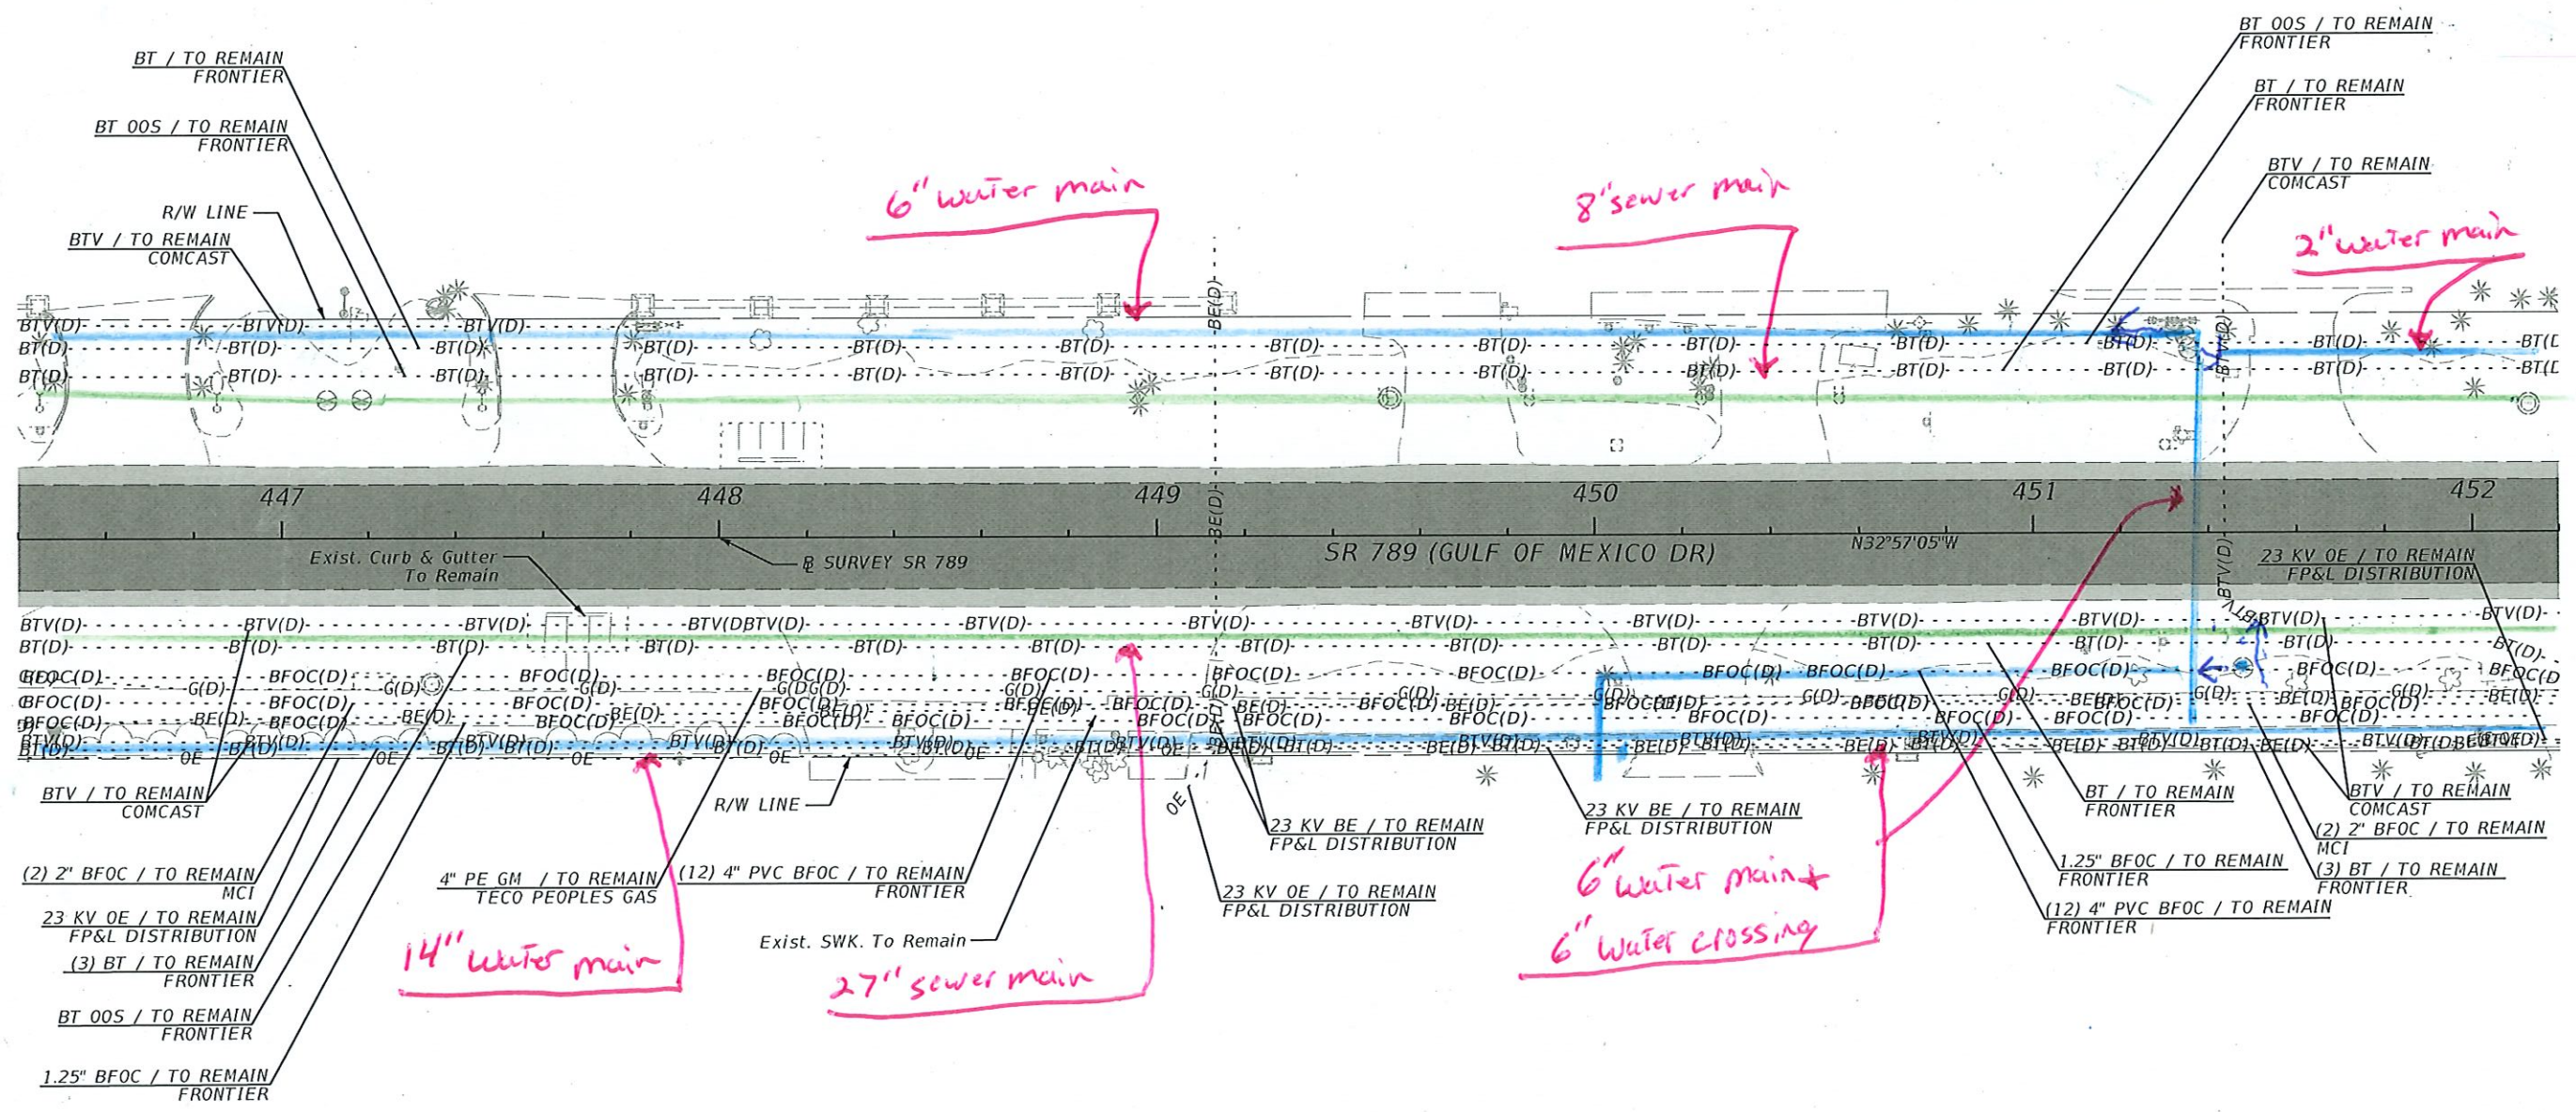

REVISIONS				ENGINEER OF RECORD		STATE OF FLORIDA DEPARTMENT OF TRANSPORTATION		ROADWAY PLAN (39)	SHEET NO. 74
DATE	DESCRIPTION	DATE	DESCRIPTION	MEGAN LERNER, P.E. LICENSE NUMBER: 72217 GARRETT ENGINEERING GROUP, INC. 120 10TH AVENUE NORTH SAINT PETERSBURG, FL 33701		ROAD NO.	COUNTY		
						SR 789	SARASOTA	451013-1-52-01	

THE OFFICIAL RECORD OF THIS SHEET IS THE ELECTRONIC FILE DIGITALLY SIGNED AND SEALED UNDER RULE 61G15-23.004, F.A.C.

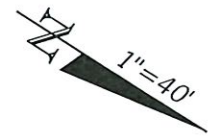

LEGEND

- TRAVEL LANES/TURN LANES/
GORE AREA MILLING
& RESURFACING (3 1/2")
- SIDE STREET/SHOULDER
MILLING & RESURFACING
(1 1/2")


6" waste water
Force main crossing

6" water main

8" sewer main


14" water main

27" sewer main

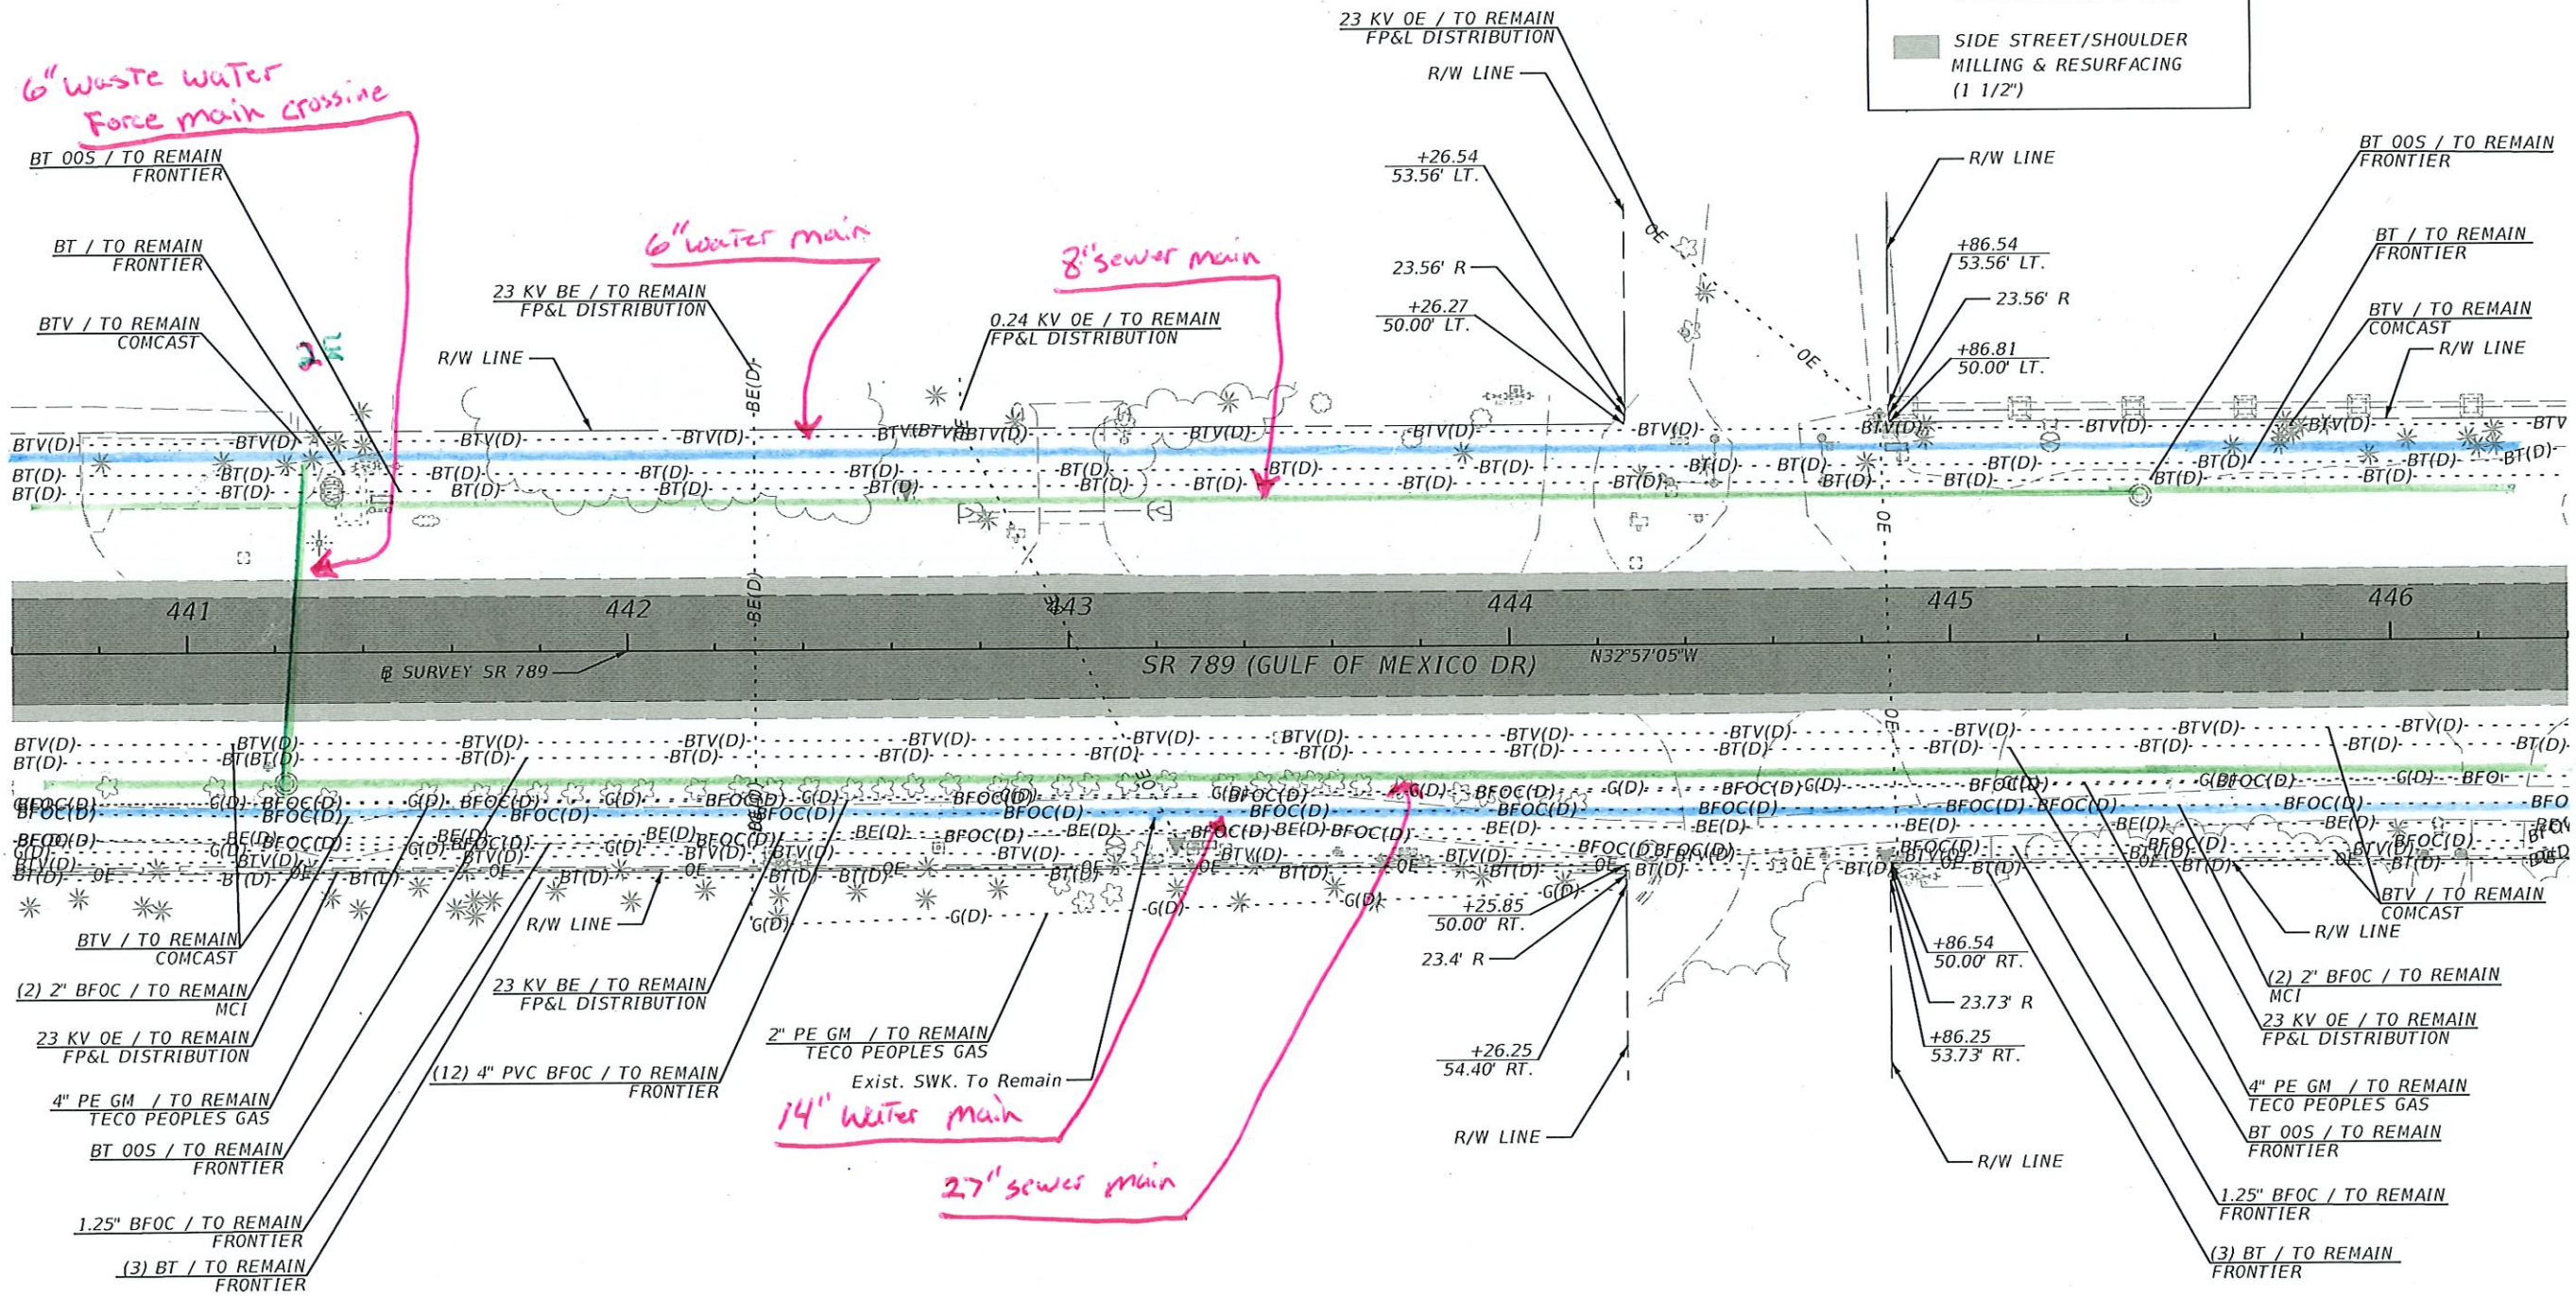


REVISIONS				ENGINEER OF RECORD	STATE OF FLORIDA DEPARTMENT OF TRANSPORTATION			SHEET NO.
DATE	DESCRIPTION	DATE	DESCRIPTION		ROAD NO.	COUNTY	FINANCIAL PROJECT ID	
				MEGAN LERNER, P.E. LICENSE NUMBER: 72217 GARRETT ENGINEERING GROUP, INC. 120 10TH AVENUE NORTH SAINT PETERSBURG, FL 33701	SR 789	SARASOTA	451013-1-52-01	73

THE OFFICIAL RECORD OF THIS SHEET IS THE ELECTRONIC FILE DIGITALLY SIGNED AND SEALED UNDER RULE 61G15-23.004, F.A.C.

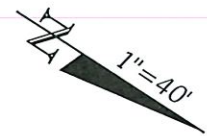


LEGEND

- TRAVEL LANES/TURN LANES/
GORE AREA MILLING
& RESURFACING (3 1/2")
- SIDE STREET/SHOULDER
MILLING & RESURFACING
(1 1/2")

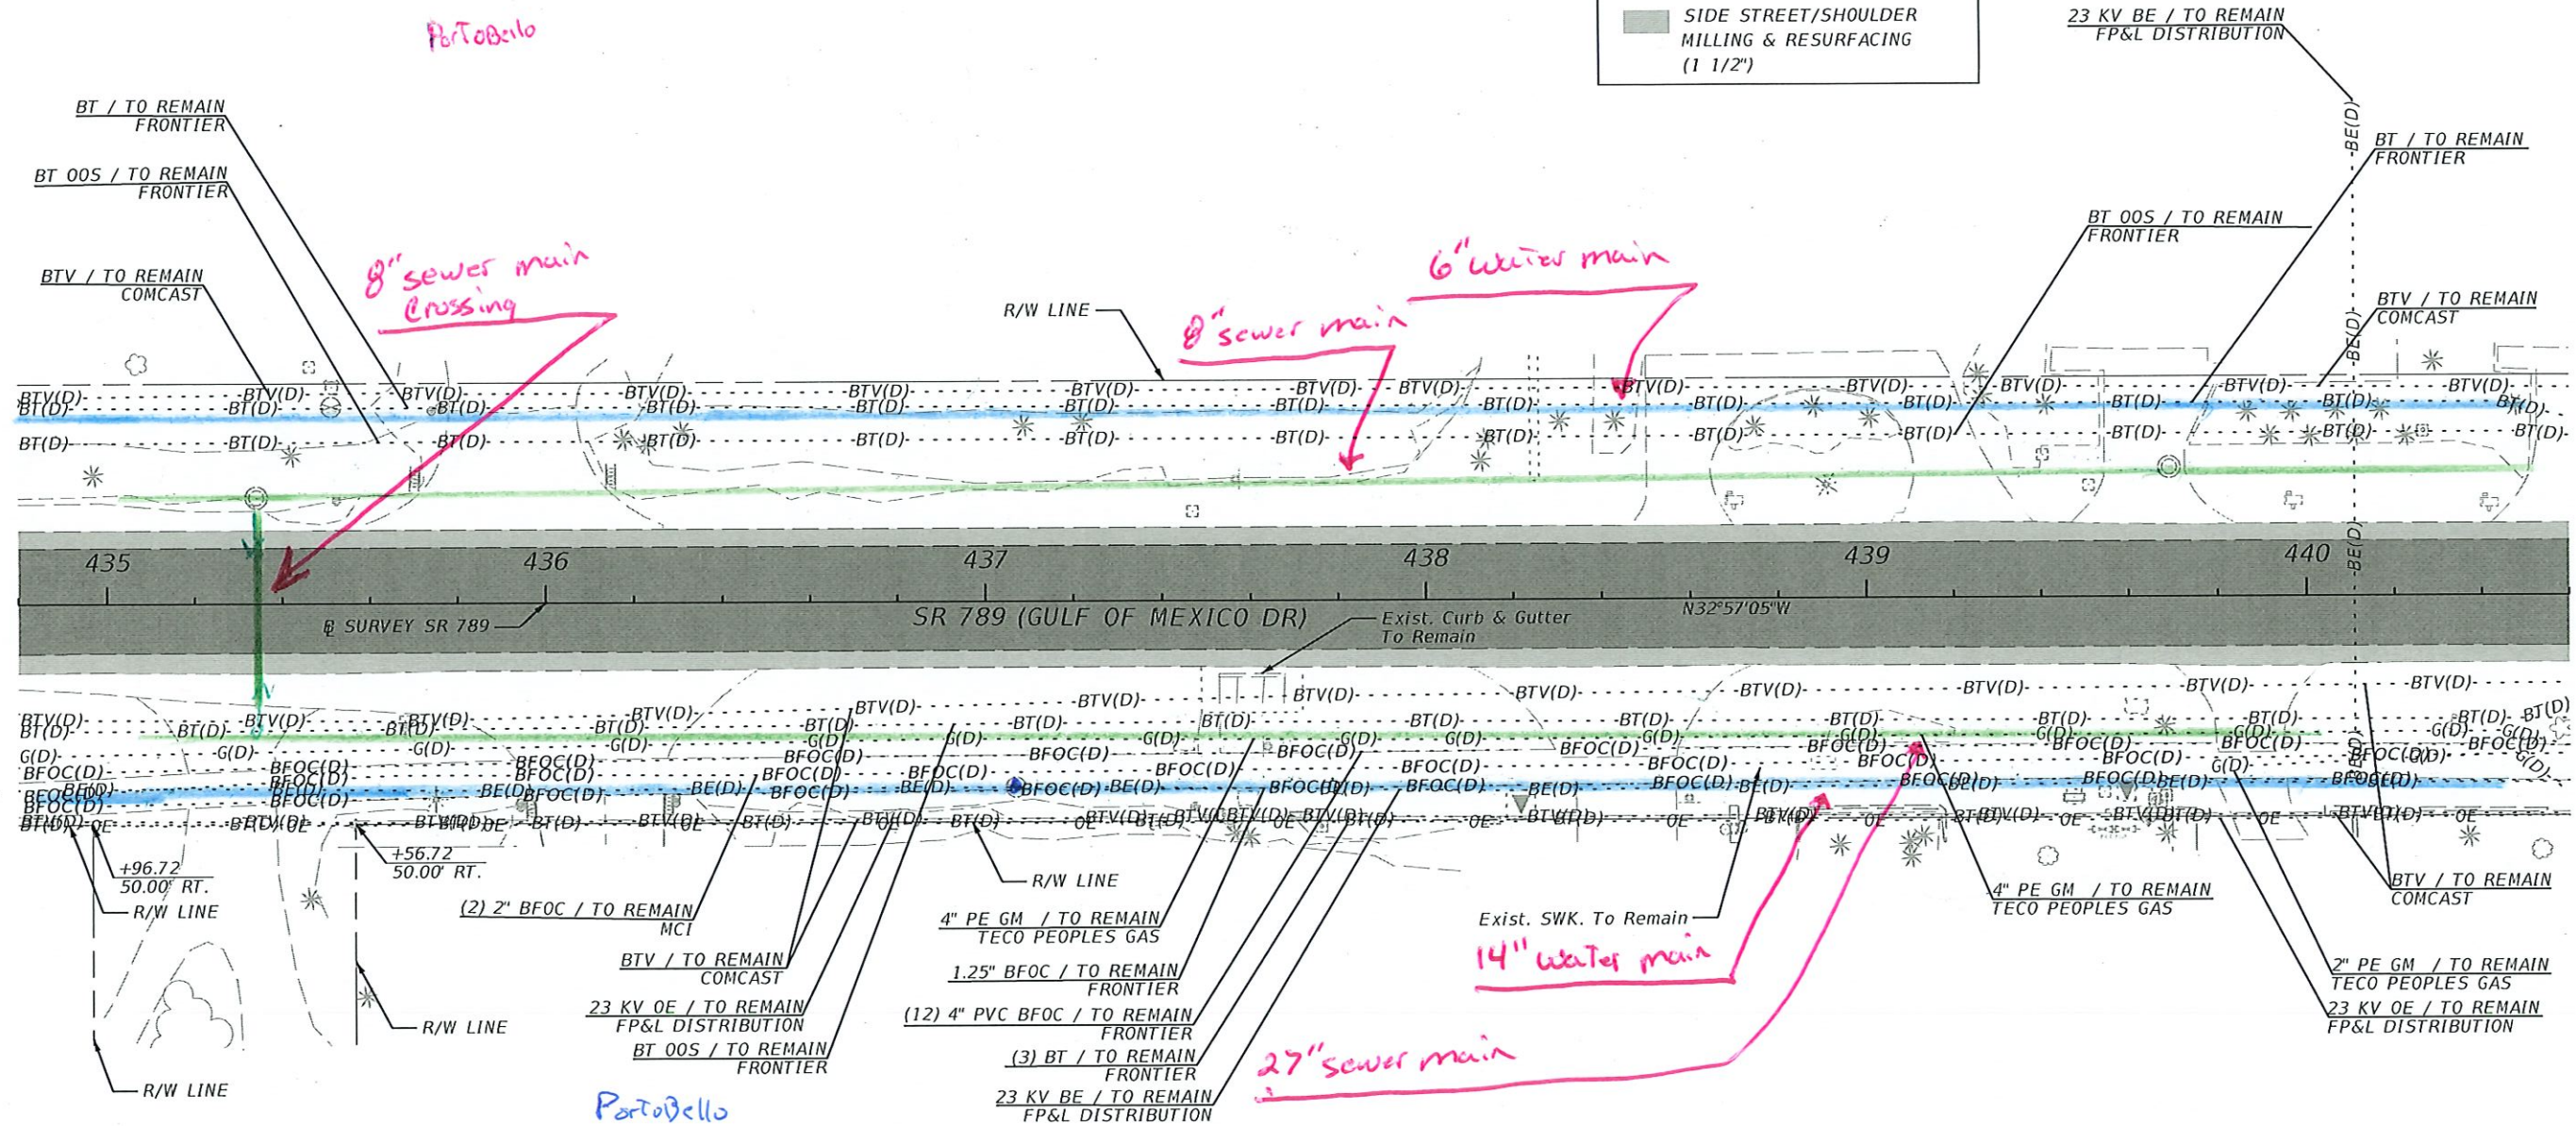


REVISIONS				ENGINEER OF RECORD		STATE OF FLORIDA DEPARTMENT OF TRANSPORTATION			ROADWAY PLAN (37)	SHEET NO. 72
DATE	DESCRIPTION	DATE	DESCRIPTION	MEGAN LERNER, P.E. LICENSE NUMBER: 72217 GARRETT ENGINEERING GROUP, INC. 120 10TH AVENUE NORTH SAINT PETERSBURG, FL 33701		ROAD NO.	COUNTY	FINANCIAL PROJECT ID		
						SR 789	SARASOTA	451013-1-52-01		

THE OFFICIAL RECORD OF THIS SHEET IS THE ELECTRONIC FILE DIGITALLY SIGNED AND SEALED UNDER RULE 61G15-23.004, F.A.C.

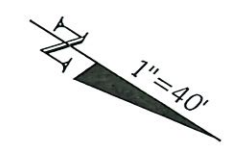

LEGEND


- TRAVEL LANES/TURN LANES/
GORE AREA MILLING
& RESURFACING (3 1/2")
- SIDE STREET/SHOULDER
MILLING & RESURFACING
(1 1/2")

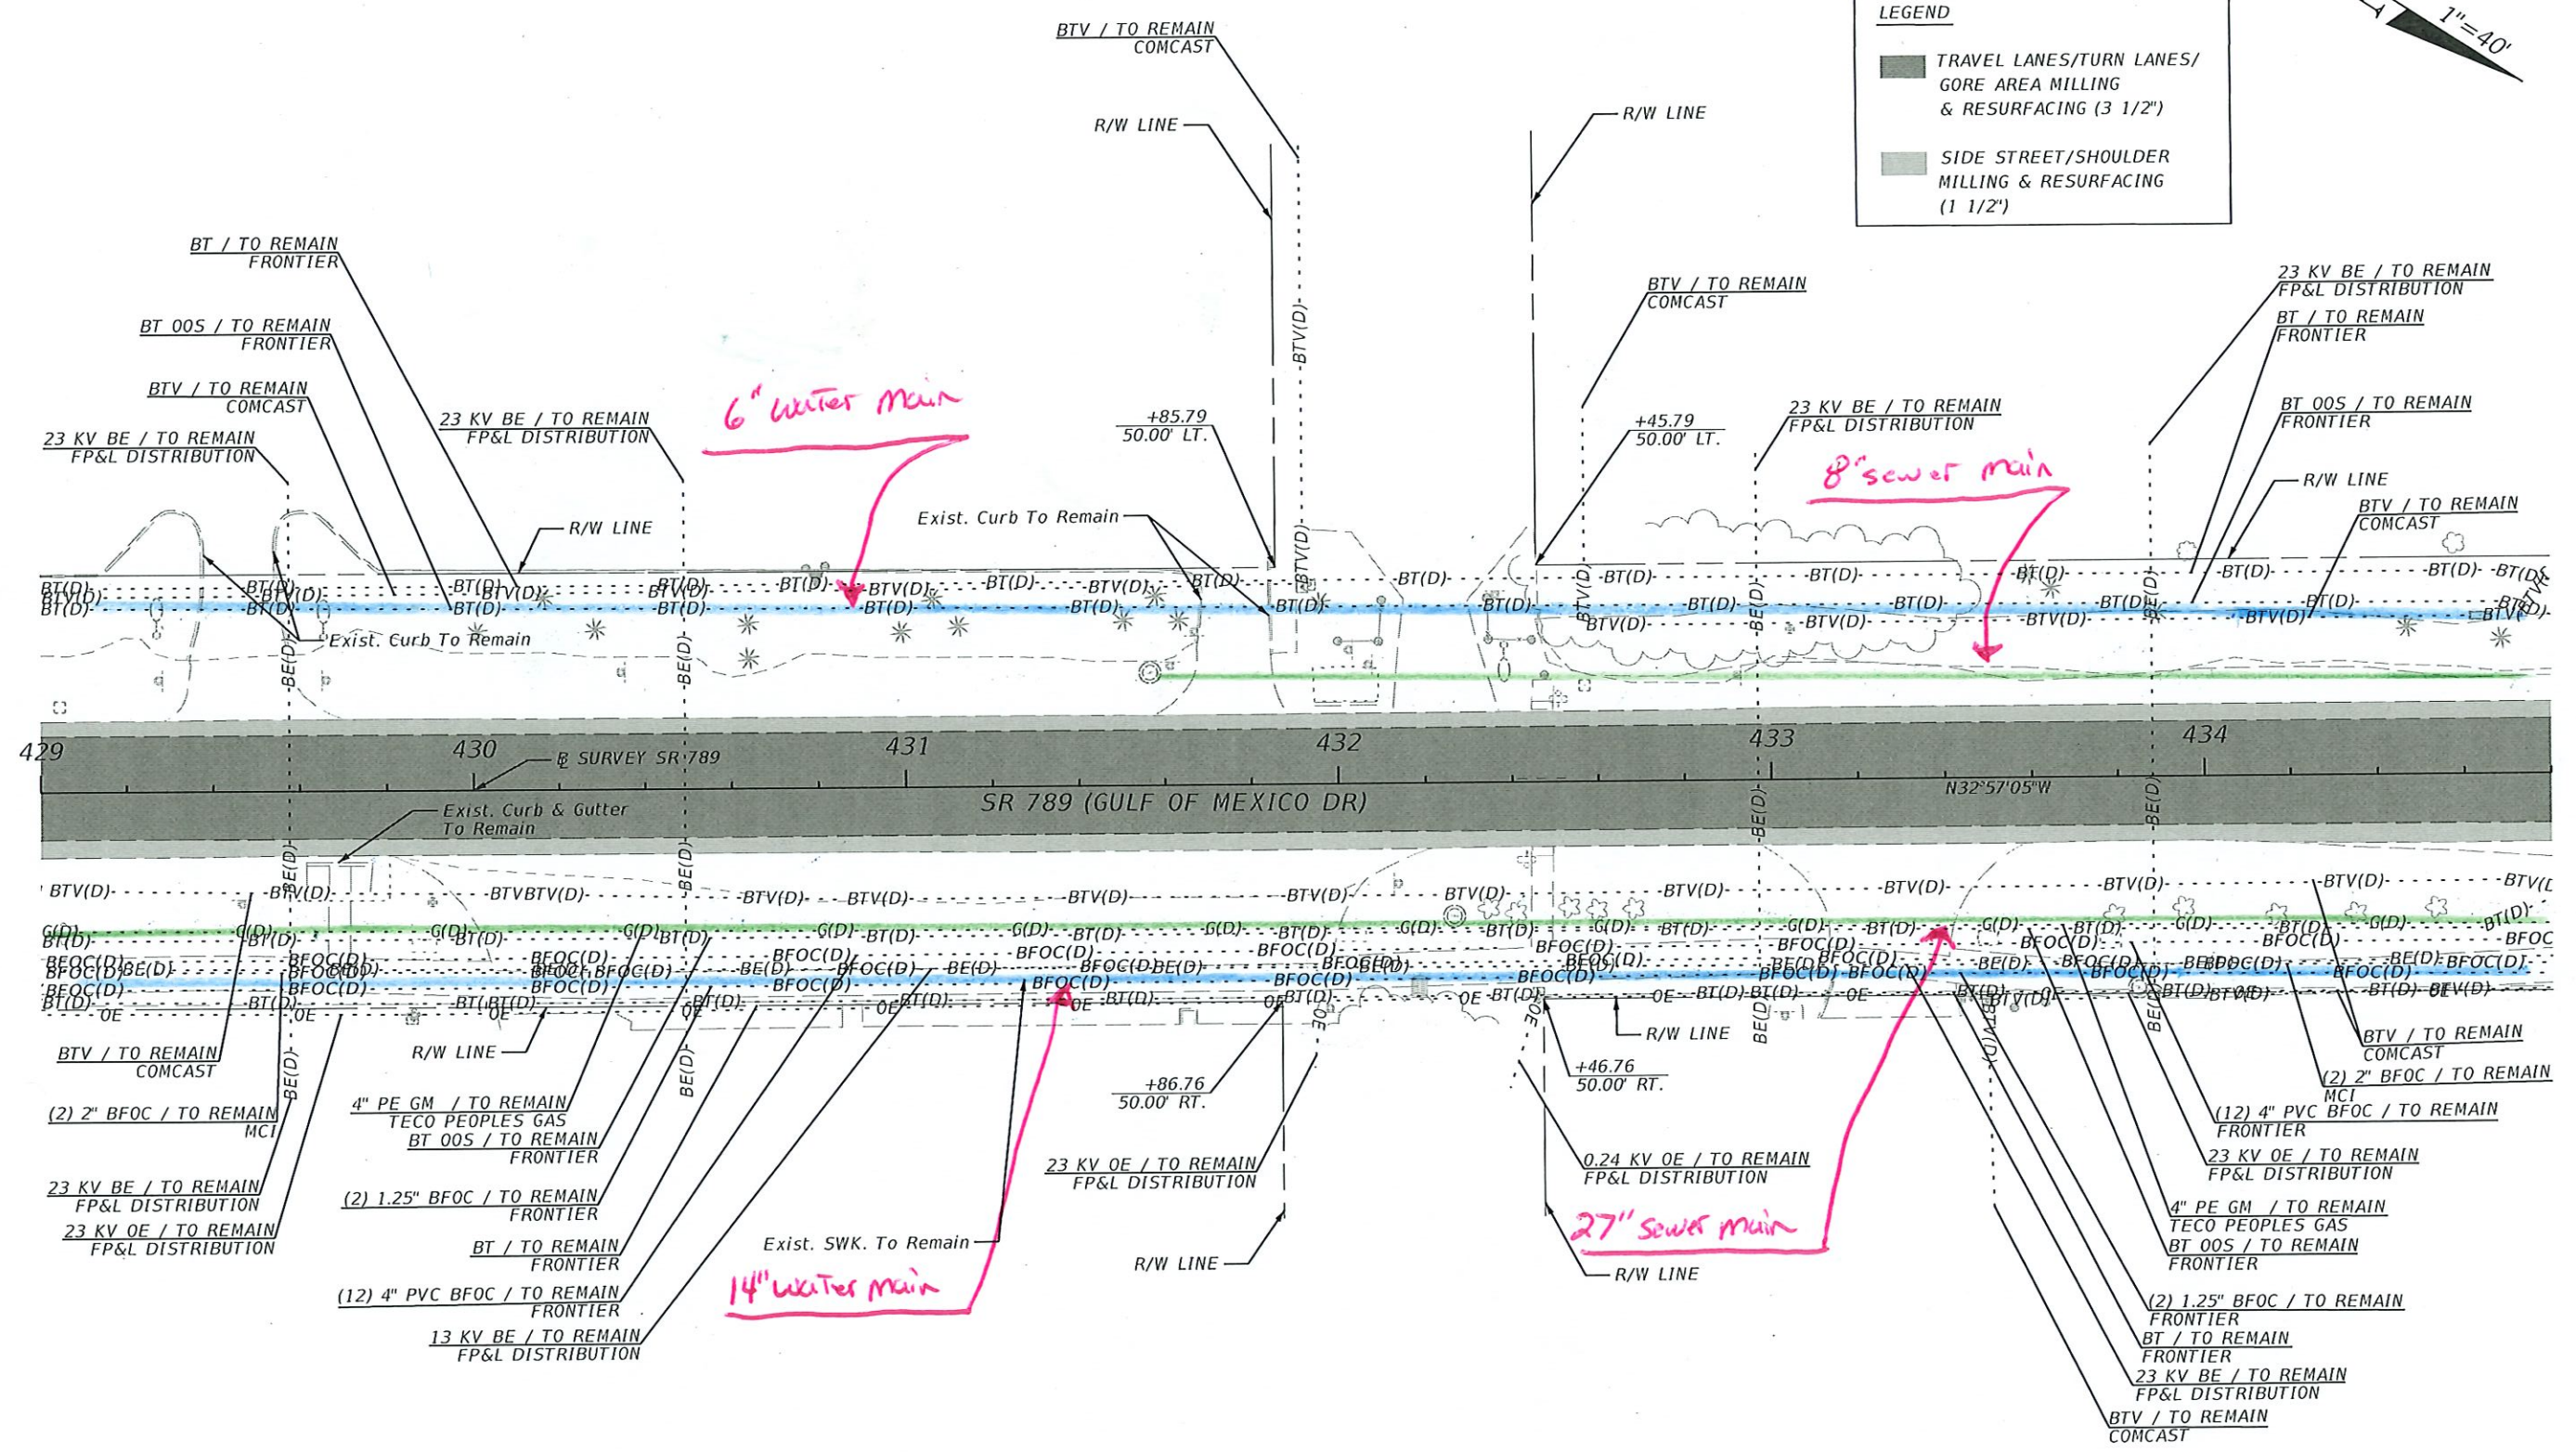

REVISIONS				ENGINEER OF RECORD		STATE OF FLORIDA DEPARTMENT OF TRANSPORTATION			ROADWAY PLAN (36)	SHEET NO. 71
DATE	DESCRIPTION	DATE	DESCRIPTION	MEGAN LERNER, P.E. LICENSE NUMBER: 72217 GARRETT ENGINEERING GROUP, INC. 120 10TH AVENUE NORTH SAINT PETERSBURG, FL 33701		ROAD NO.	COUNTY	FINANCIAL PROJECT ID		
						SR 789	SARASOTA	451013-1-52-01		


C:\Users\Garrett Team Dropbox\GEG Projects\SR 789 from Longboat Club to Manatee CL\45101315201\Roadway\PLAINRD01.dgn : BLSR789 - PLAN-35 (SHEET)
93 8/14/2025 1:43:39 PM

THE OFFICIAL RECORD OF THIS SHEET IS THE ELECTRONIC FILE DIGITALLY SIGNED AND SEALED UNDER RULE 61G15-23.004, F.A.C.

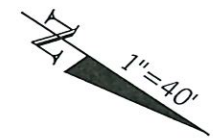

LEGEND


- TRAVEL LANES/TURN LANES/
GORE AREA MILLING
& RESURFACING (3 1/2")
- SIDE STREET/SHOULDER
MILLING & RESURFACING
(1 1/2")

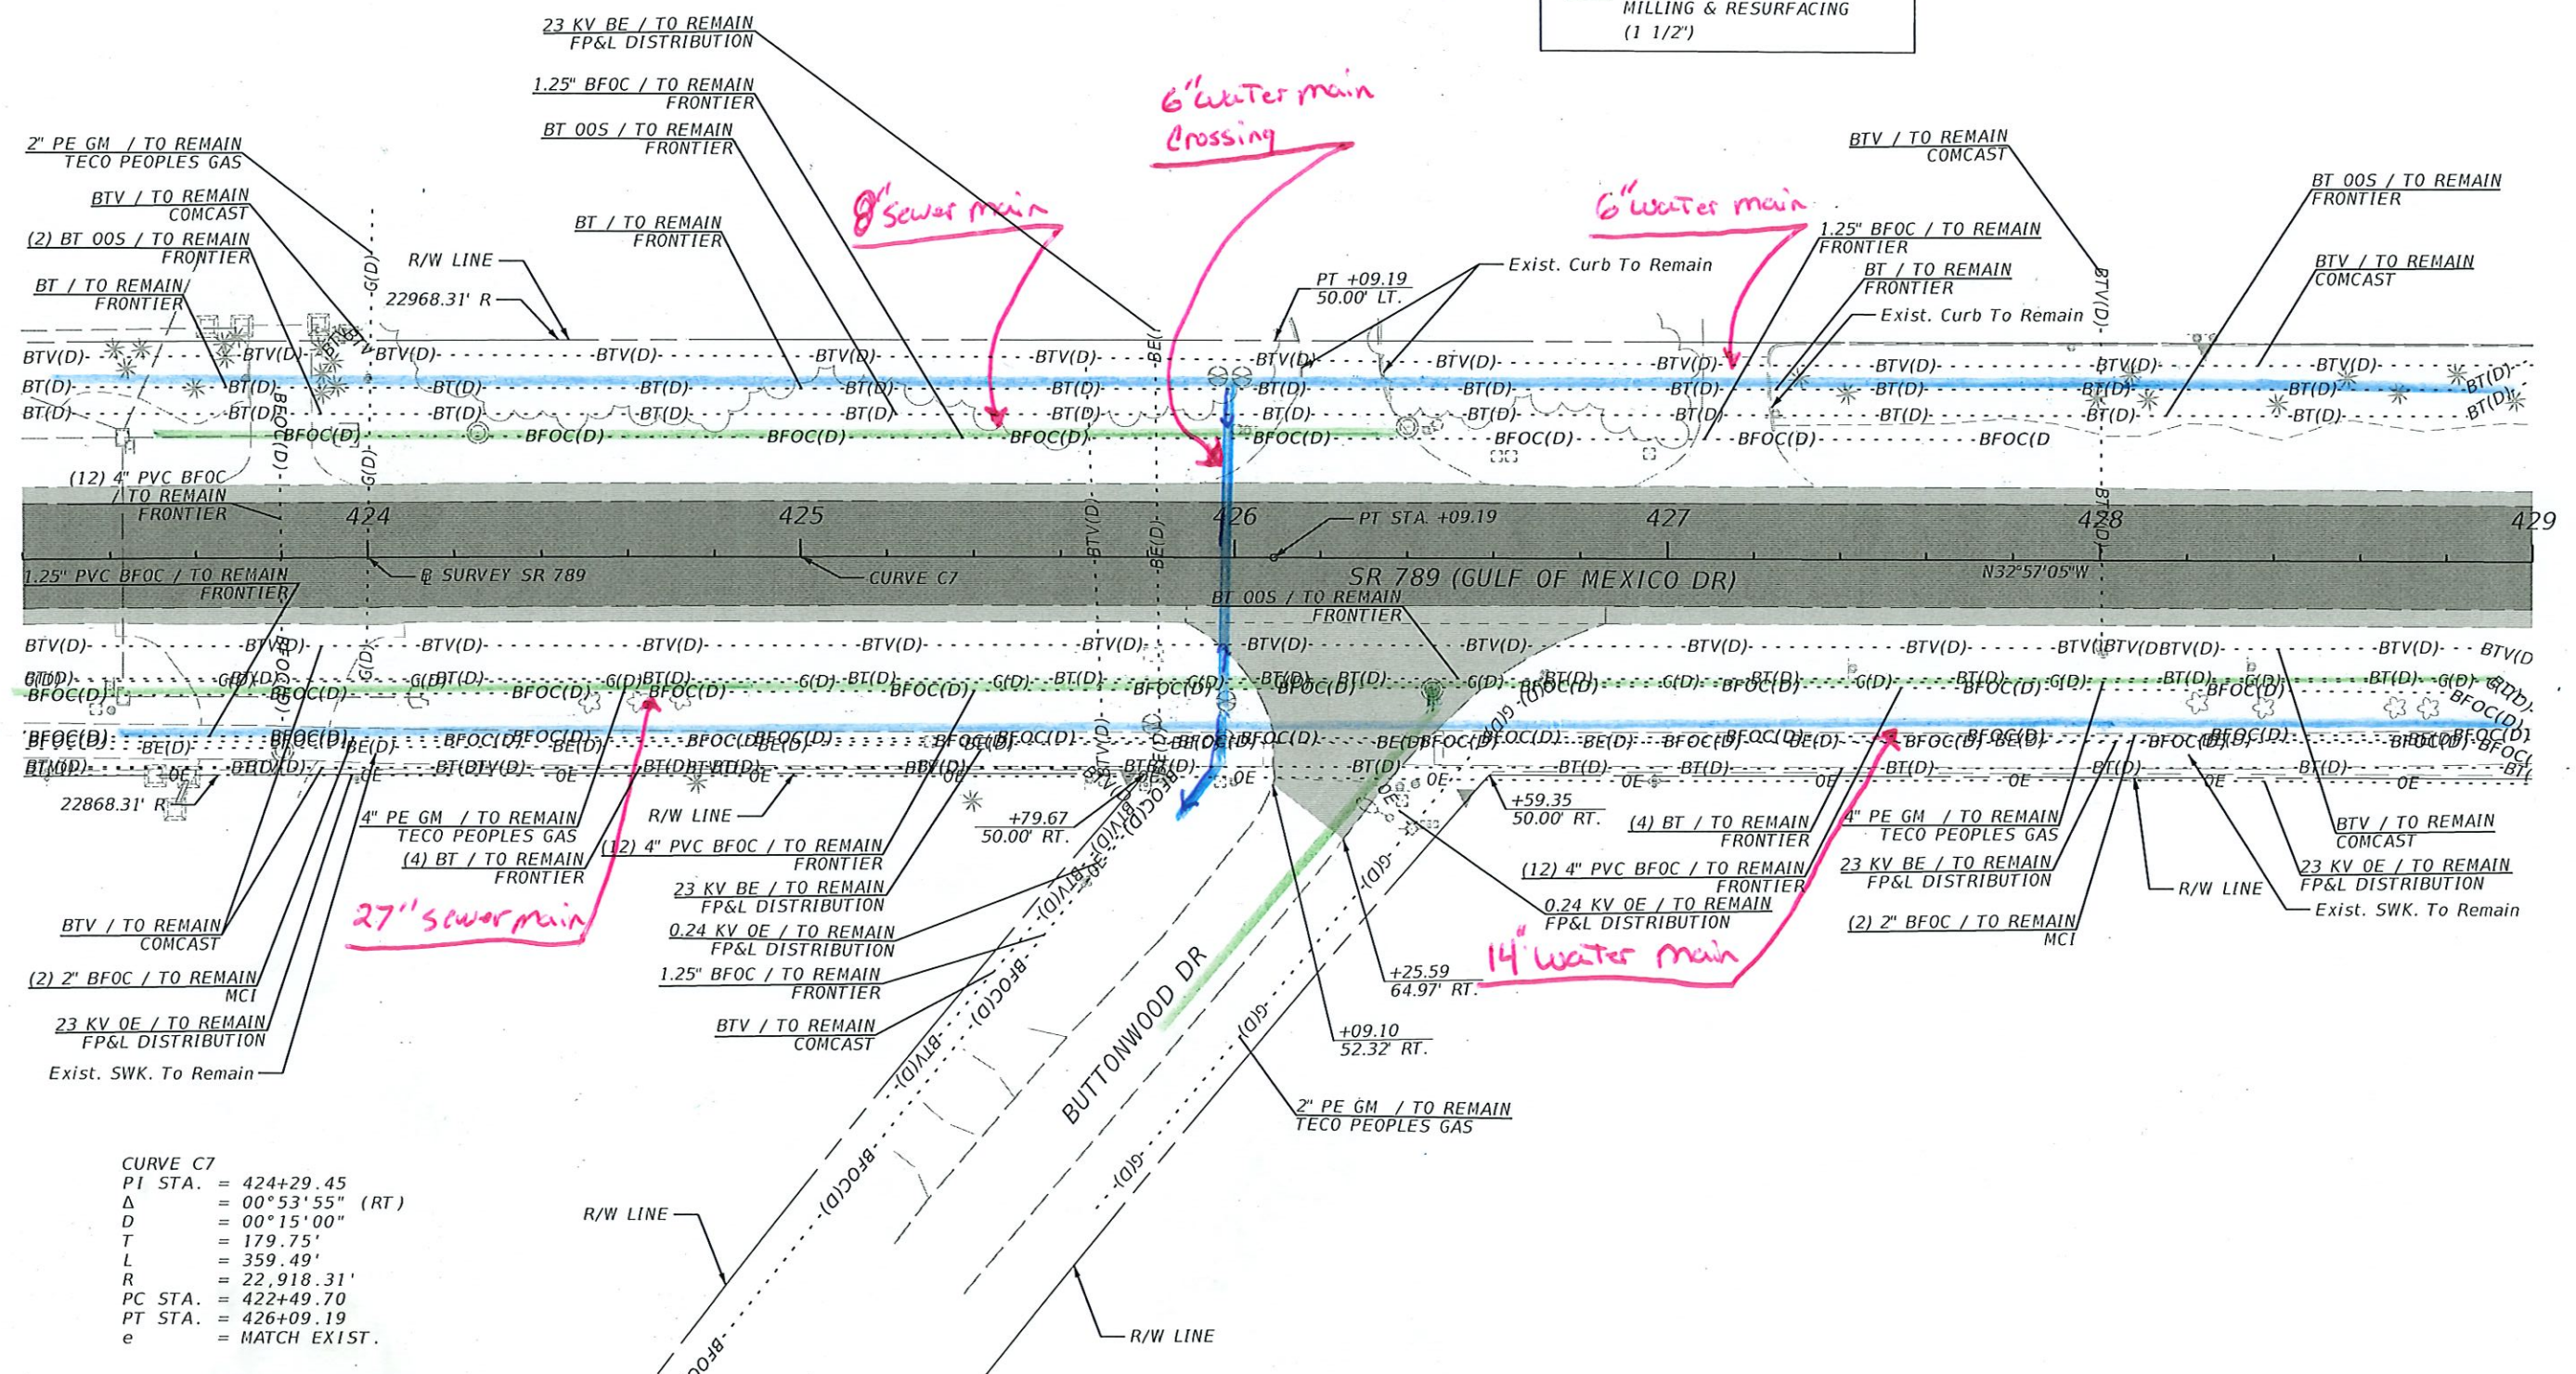

CURVE C7
PI STA. = 424+29.45
Δ = 00°53'55" (RT)
D = 00°15'00"
T = 179.75'
L = 359.49'
R = 22,918.31'
PC STA. = 422+49.70
PT STA. = 426+09.19
e = MATCH EXIST.


REVISIONS				ENGINEER OF RECORD			STATE OF FLORIDA DEPARTMENT OF TRANSPORTATION			ROADWAY PLAN (35)	SHEET NO. 70
DATE	DESCRIPTION	DATE	DESCRIPTION	MEGAN LERNER, P.E. LICENSE NUMBER: 72217 GARRETT ENGINEERING GROUP, INC. 120 10TH AVENUE NORTH SAINT PETERSBURG, FL 33701			ROAD NO.	COUNTY	FINANCIAL PROJECT ID		
							SR 789	SARASOTA	451013-1-52-01		

THE OFFICIAL RECORD OF THIS SHEET IS THE ELECTRONIC FILE DIGITALLY SIGNED AND SEALED UNDER RULE 61G15-23.004, F.A.C.

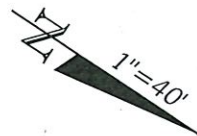


LEGEND

- TRAVEL LANES/TURN LANES/
GORE AREA MILLING
& RESURFACING (3 1/2")
- SIDE STREET/SHOULDER
MILLING & RESURFACING
(1 1/2")

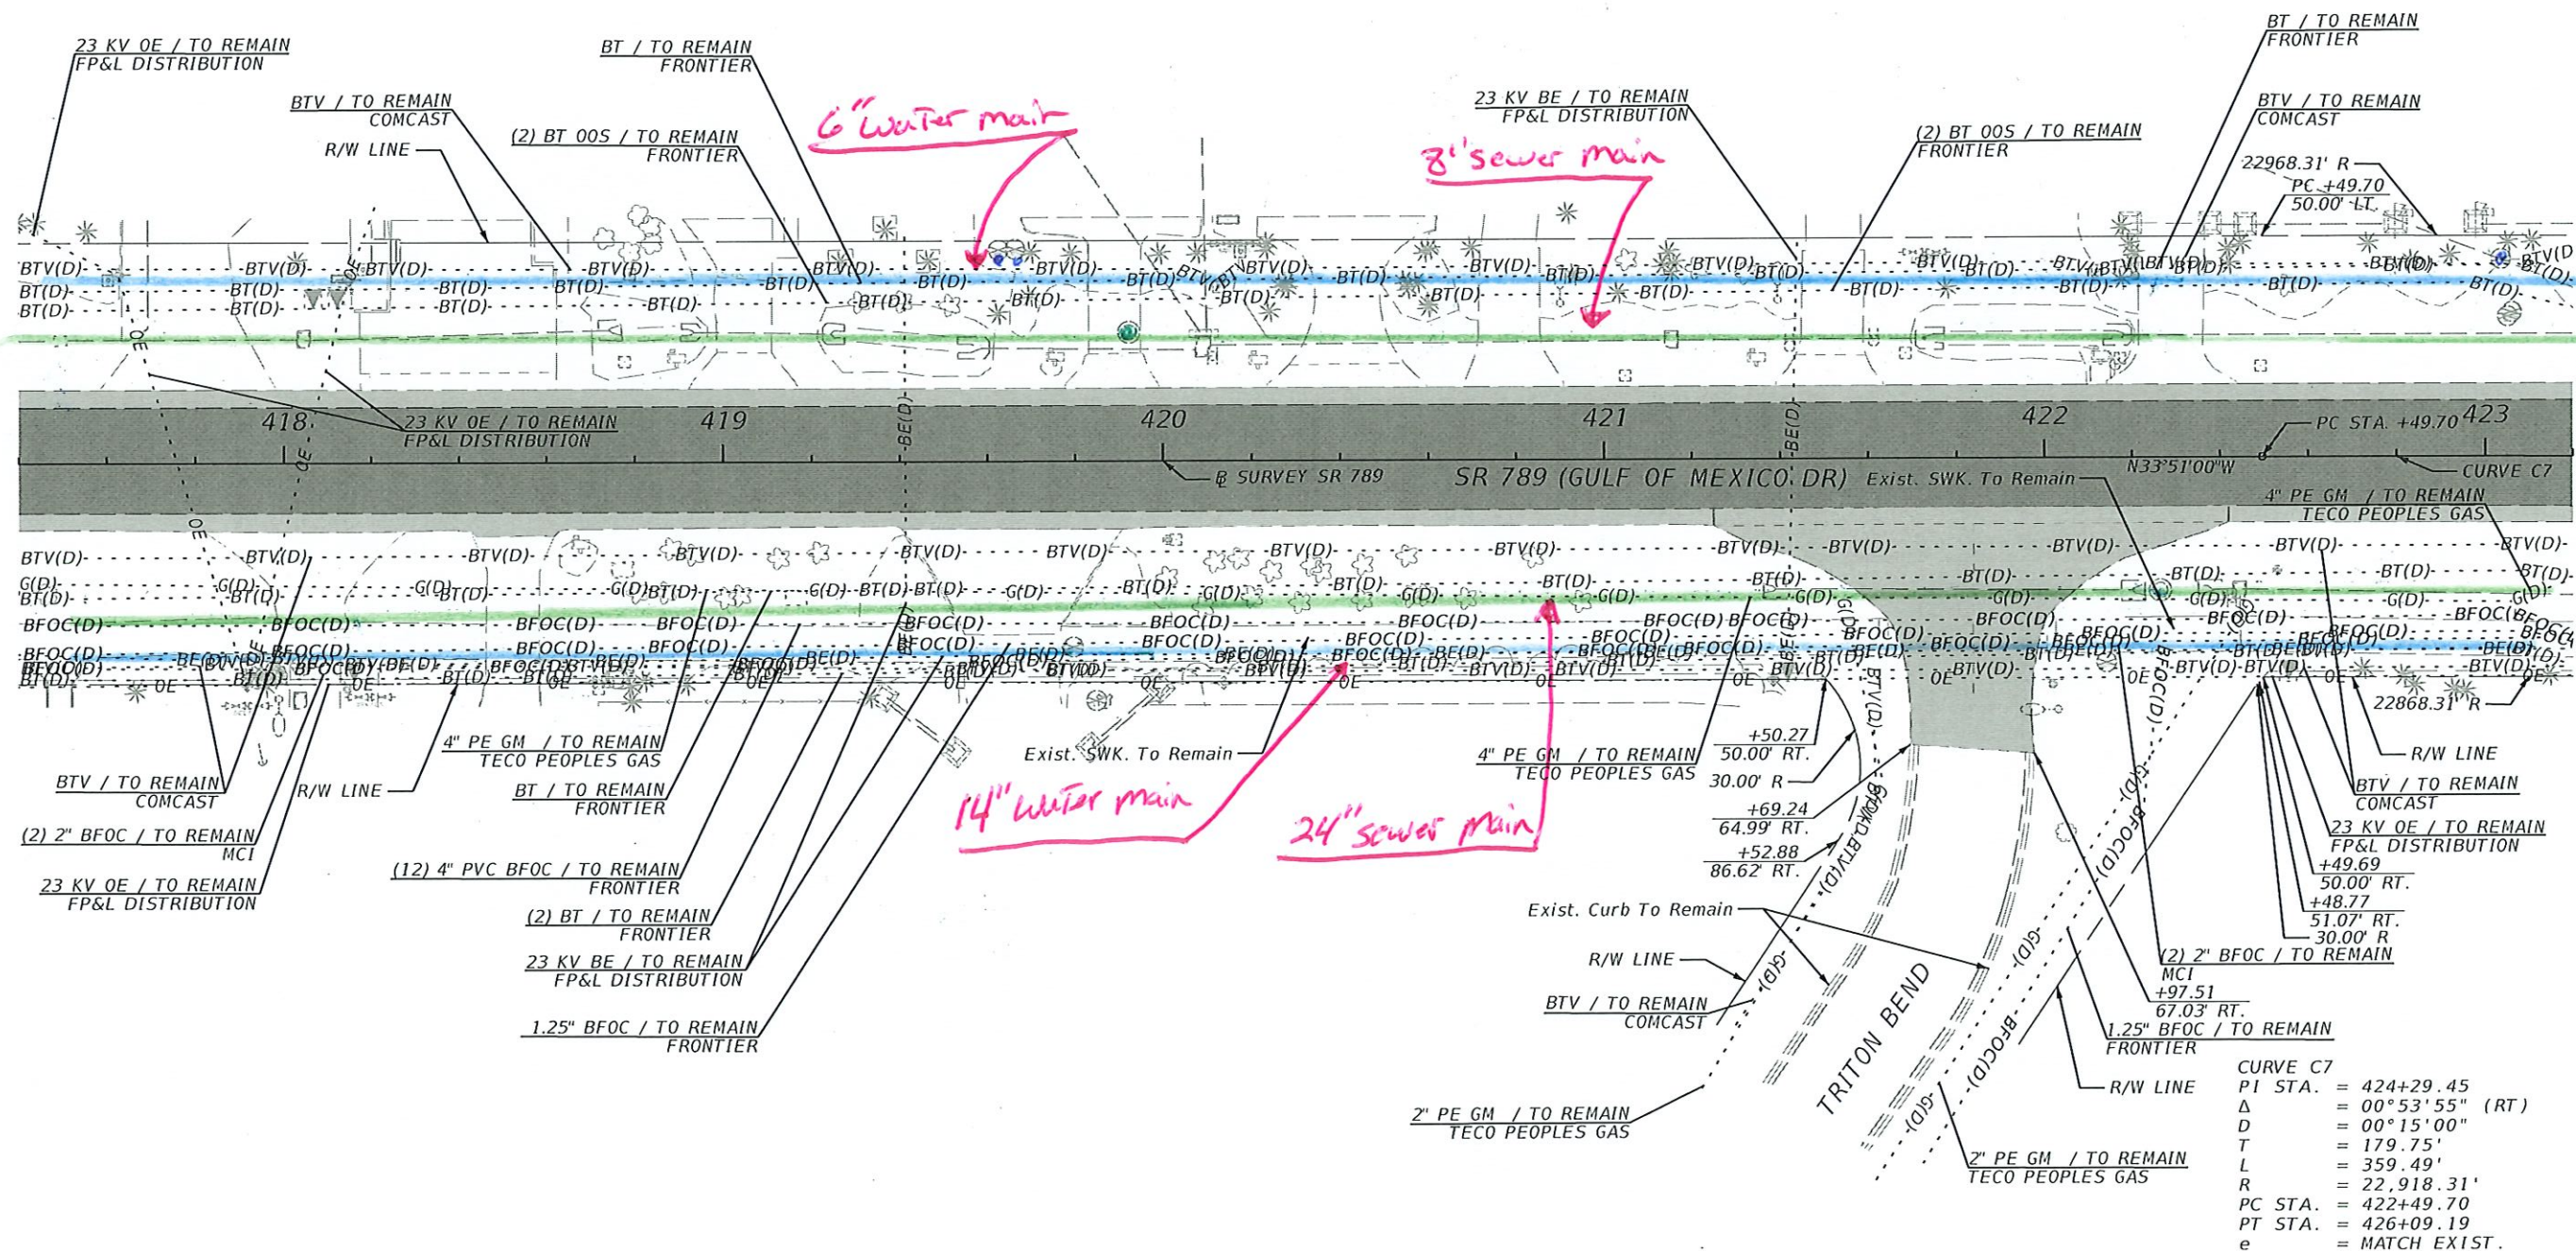


REVISIONS				ENGINEER OF RECORD	STATE OF FLORIDA DEPARTMENT OF TRANSPORTATION			ROADWAY PLAN (34)	SHEET NO.
DATE	DESCRIPTION	DATE	DESCRIPTION	MEGAN LERNER, P.E LICENSE NUMBER: 72217 GARRETT ENGINEERING GROUP, INC. 120 10TH AVENUE NORTH SAINT PETERSBURG, FL 33701	ROAD NO.	COUNTY	FINANCIAL PROJECT ID		69
					SR 789	SARASOTA	451013-1-52-01		

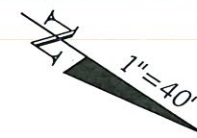


LEGEND

- TRAVEL LANES/TURN LANES/
GORE AREA MILLING
& RESURFACING (3 1/2')
- SIDE STREET/SHOULDER
MILLING & RESURFACING
(1 1/2')

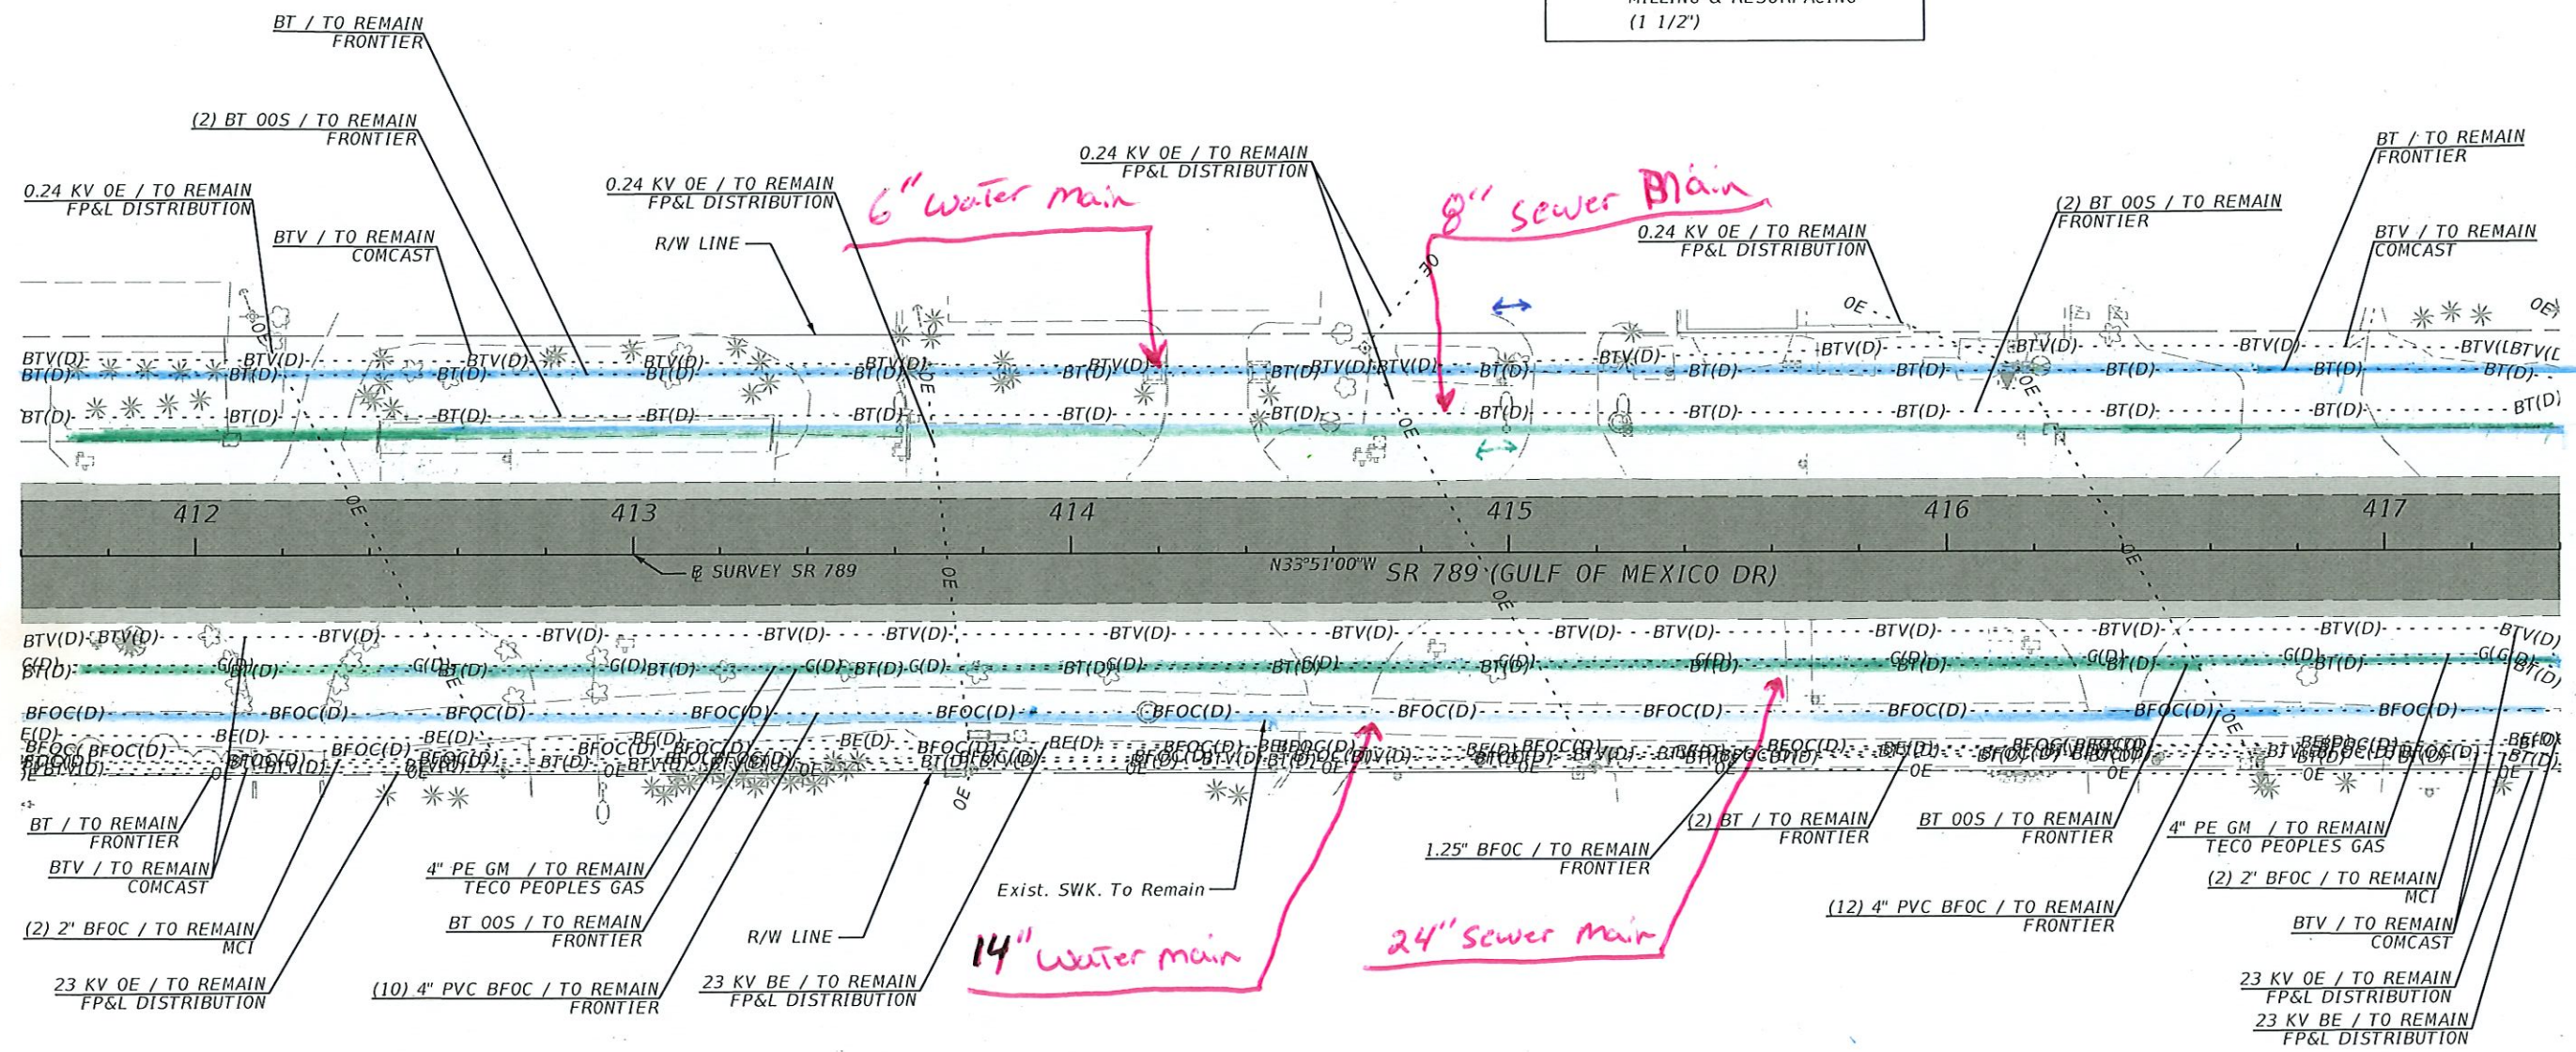


REVISIONS				ENGINEER OF RECORD	STATE OF FLORIDA			ROADWAY PLAN (33)	SHEET NO.
DATE	DESCRIPTION	DATE	DESCRIPTION		DEPARTMENT OF TRANSPORTATION				
					ROAD NO.	COUNTY	FINANCIAL PROJECT ID		
				MEGAN LERNER, P.E. LICENSE NUMBER: 72217 GARRETT ENGINEERING GROUP, INC. 120 10TH AVENUE NORTH SAINT PETERSBURG, FL 33701	SR 789	SARASOTA	451013-1-52-01		68

THE OFFICIAL RECORD OF THIS SHEET IS THE ELECTRONIC FILE DIGITALLY SIGNED AND SEALED UNDER RULE 61G15-23.004, F.A.C.

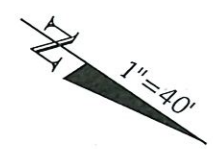

LEGEND

- TRAVEL LANES/TURN LANES/
GORE AREA MILLING
& RESURFACING (3 1/2")
- SIDE STREET/SHOULDER
MILLING & RESURFACING
(1 1/2")

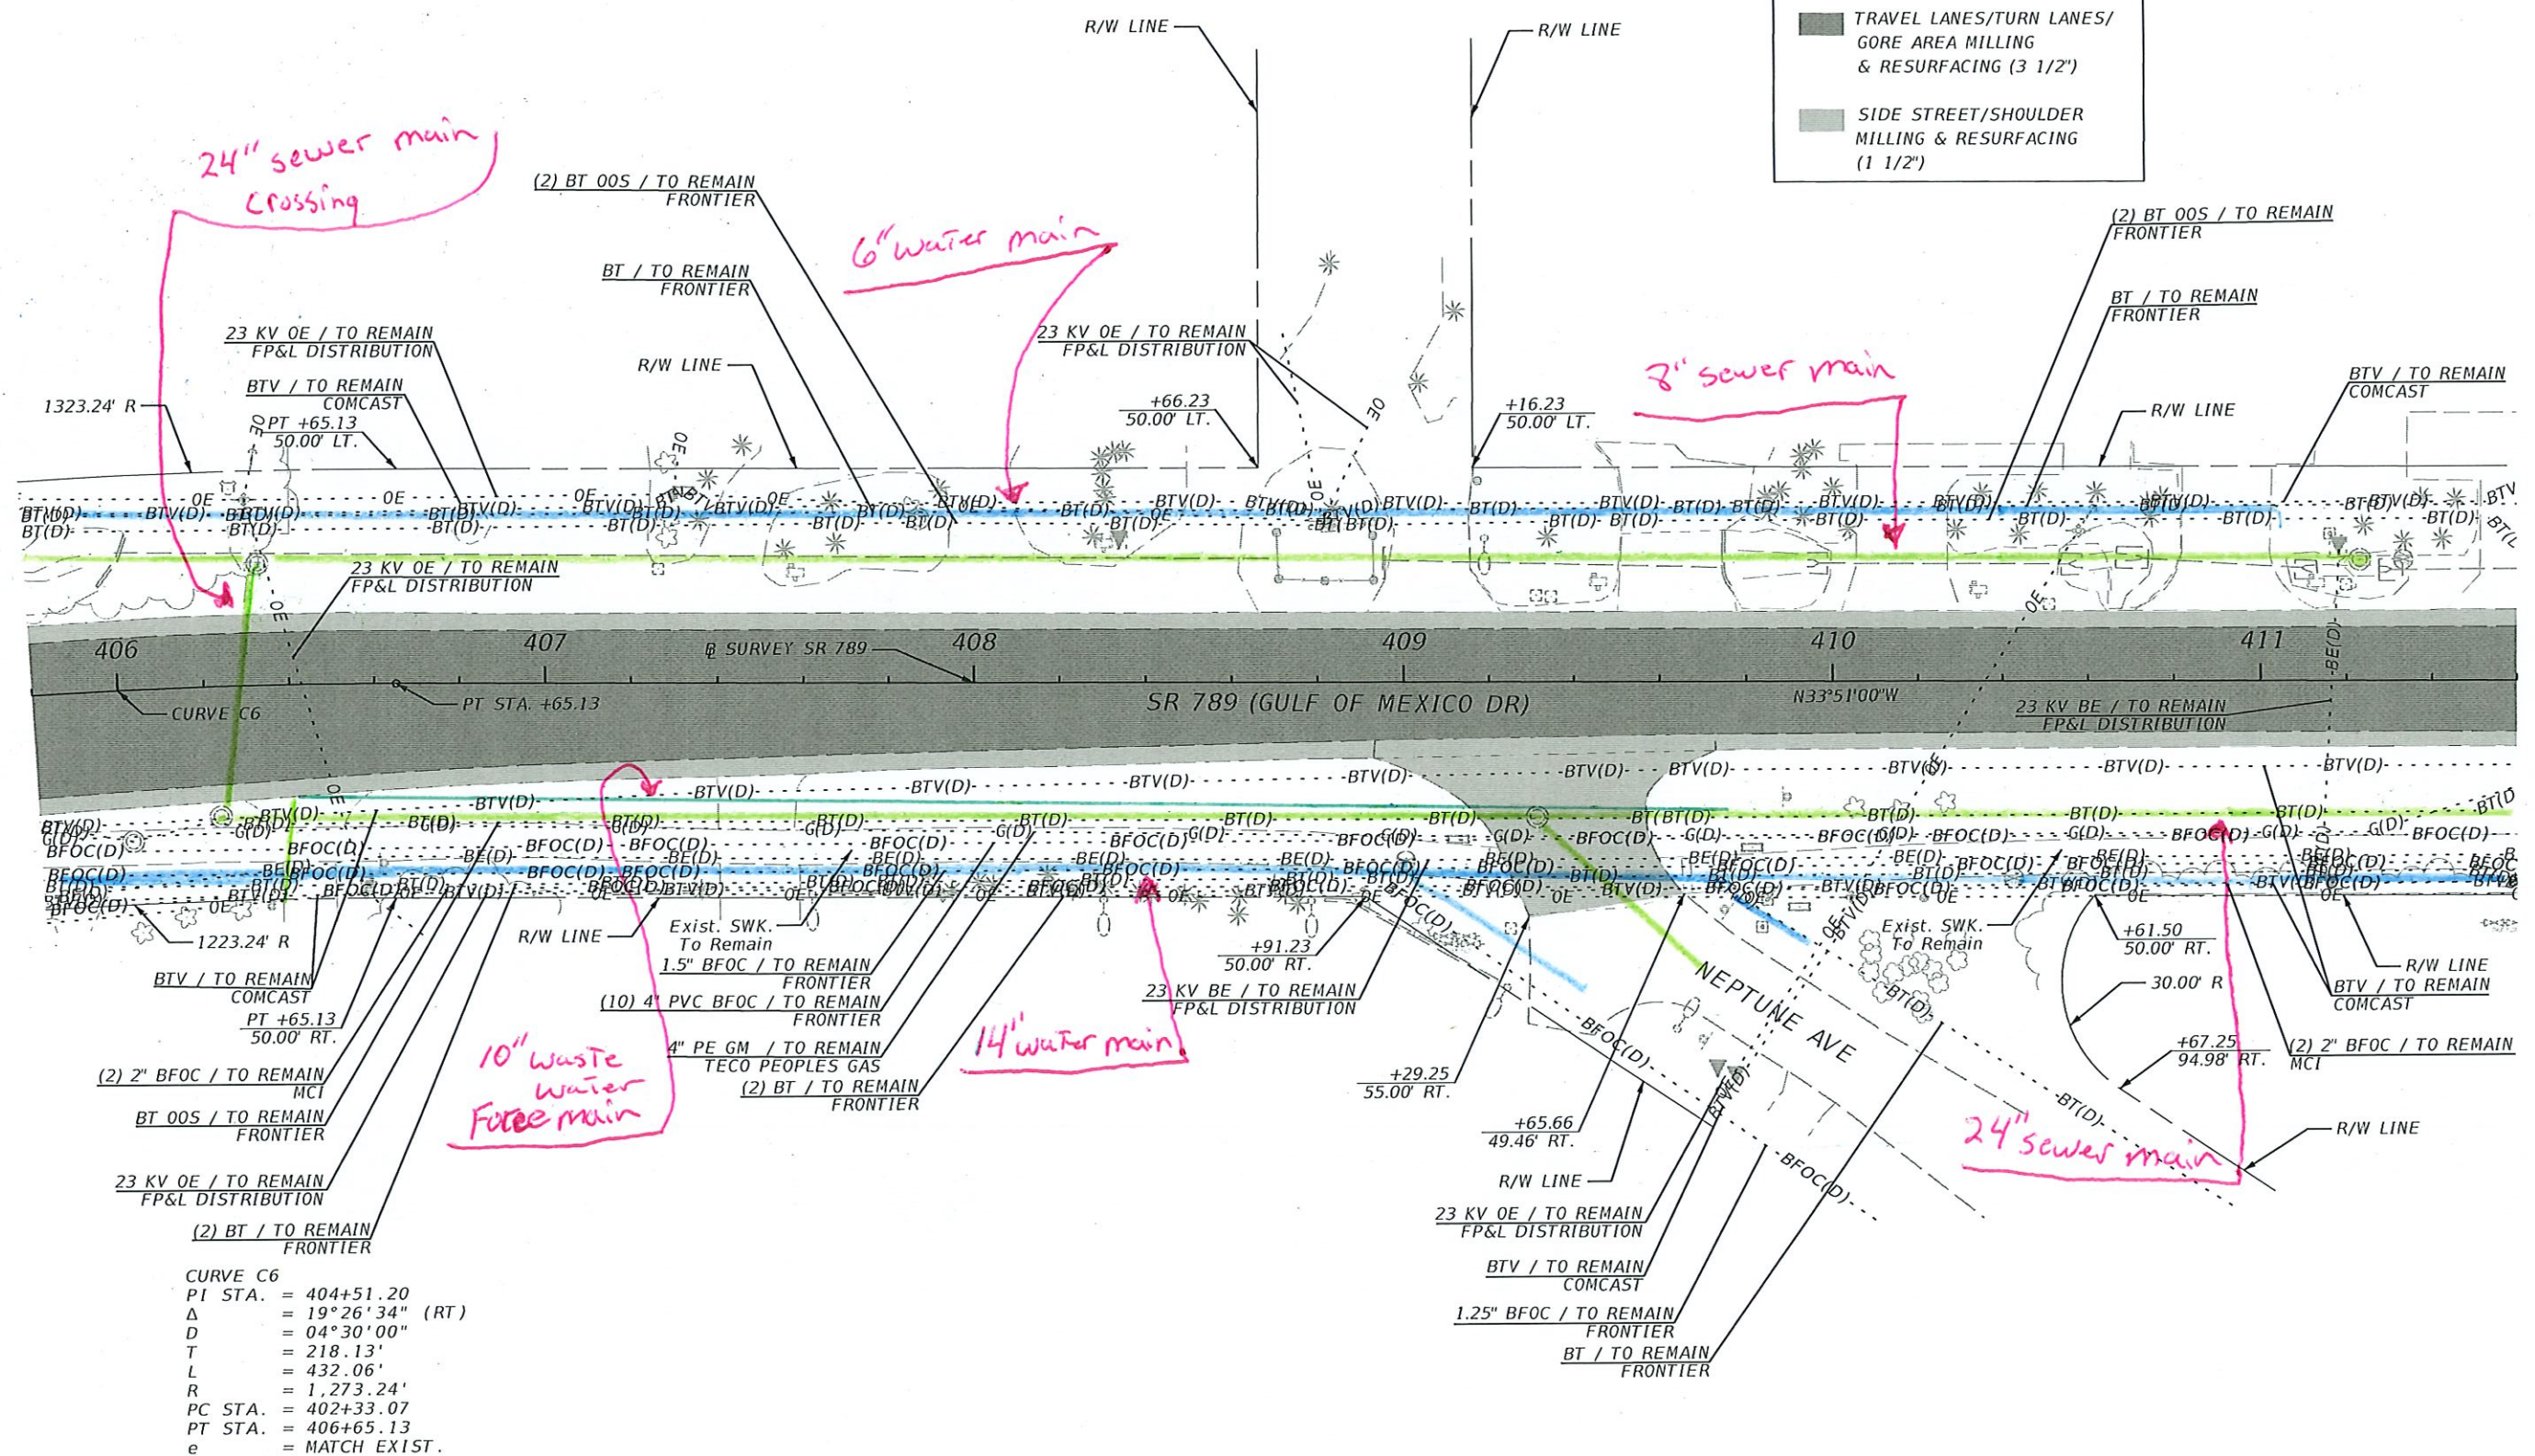


CURVE C6
PI STA. = 404+51.20
Δ = 19°26'34" (RT)
D = 04°30'00"
T = 218.13'
L = 432.06'
R = 1,273.24'
PC STA. = 402+33.07
PT STA. = 406+65.13
e = MATCH EXIST.

REVISIONS				ENGINEER OF RECORD	STATE OF FLORIDA DEPARTMENT OF TRANSPORTATION			SHEET NO. 67
DATE	DESCRIPTION	DATE	DESCRIPTION		ROAD NO.	COUNTY	FINANCIAL PROJECT ID	
					SR 789	SARASOTA	451013-1-52-01	

MEGAN LERNER, P.E.
LICENSE NUMBER: 72217
GARRETT ENGINEERING GROUP, INC.
120 10TH AVENUE NORTH
SAINT PETERSBURG, FL 33701

ROADWAY PLAN (32)



THE OFFICIAL RECORD OF THIS SHEET IS THE ELECTRONIC FILE DIGITALLY SIGNED AND SEALED UNDER RULE 61G15-23.004, F.A.C.

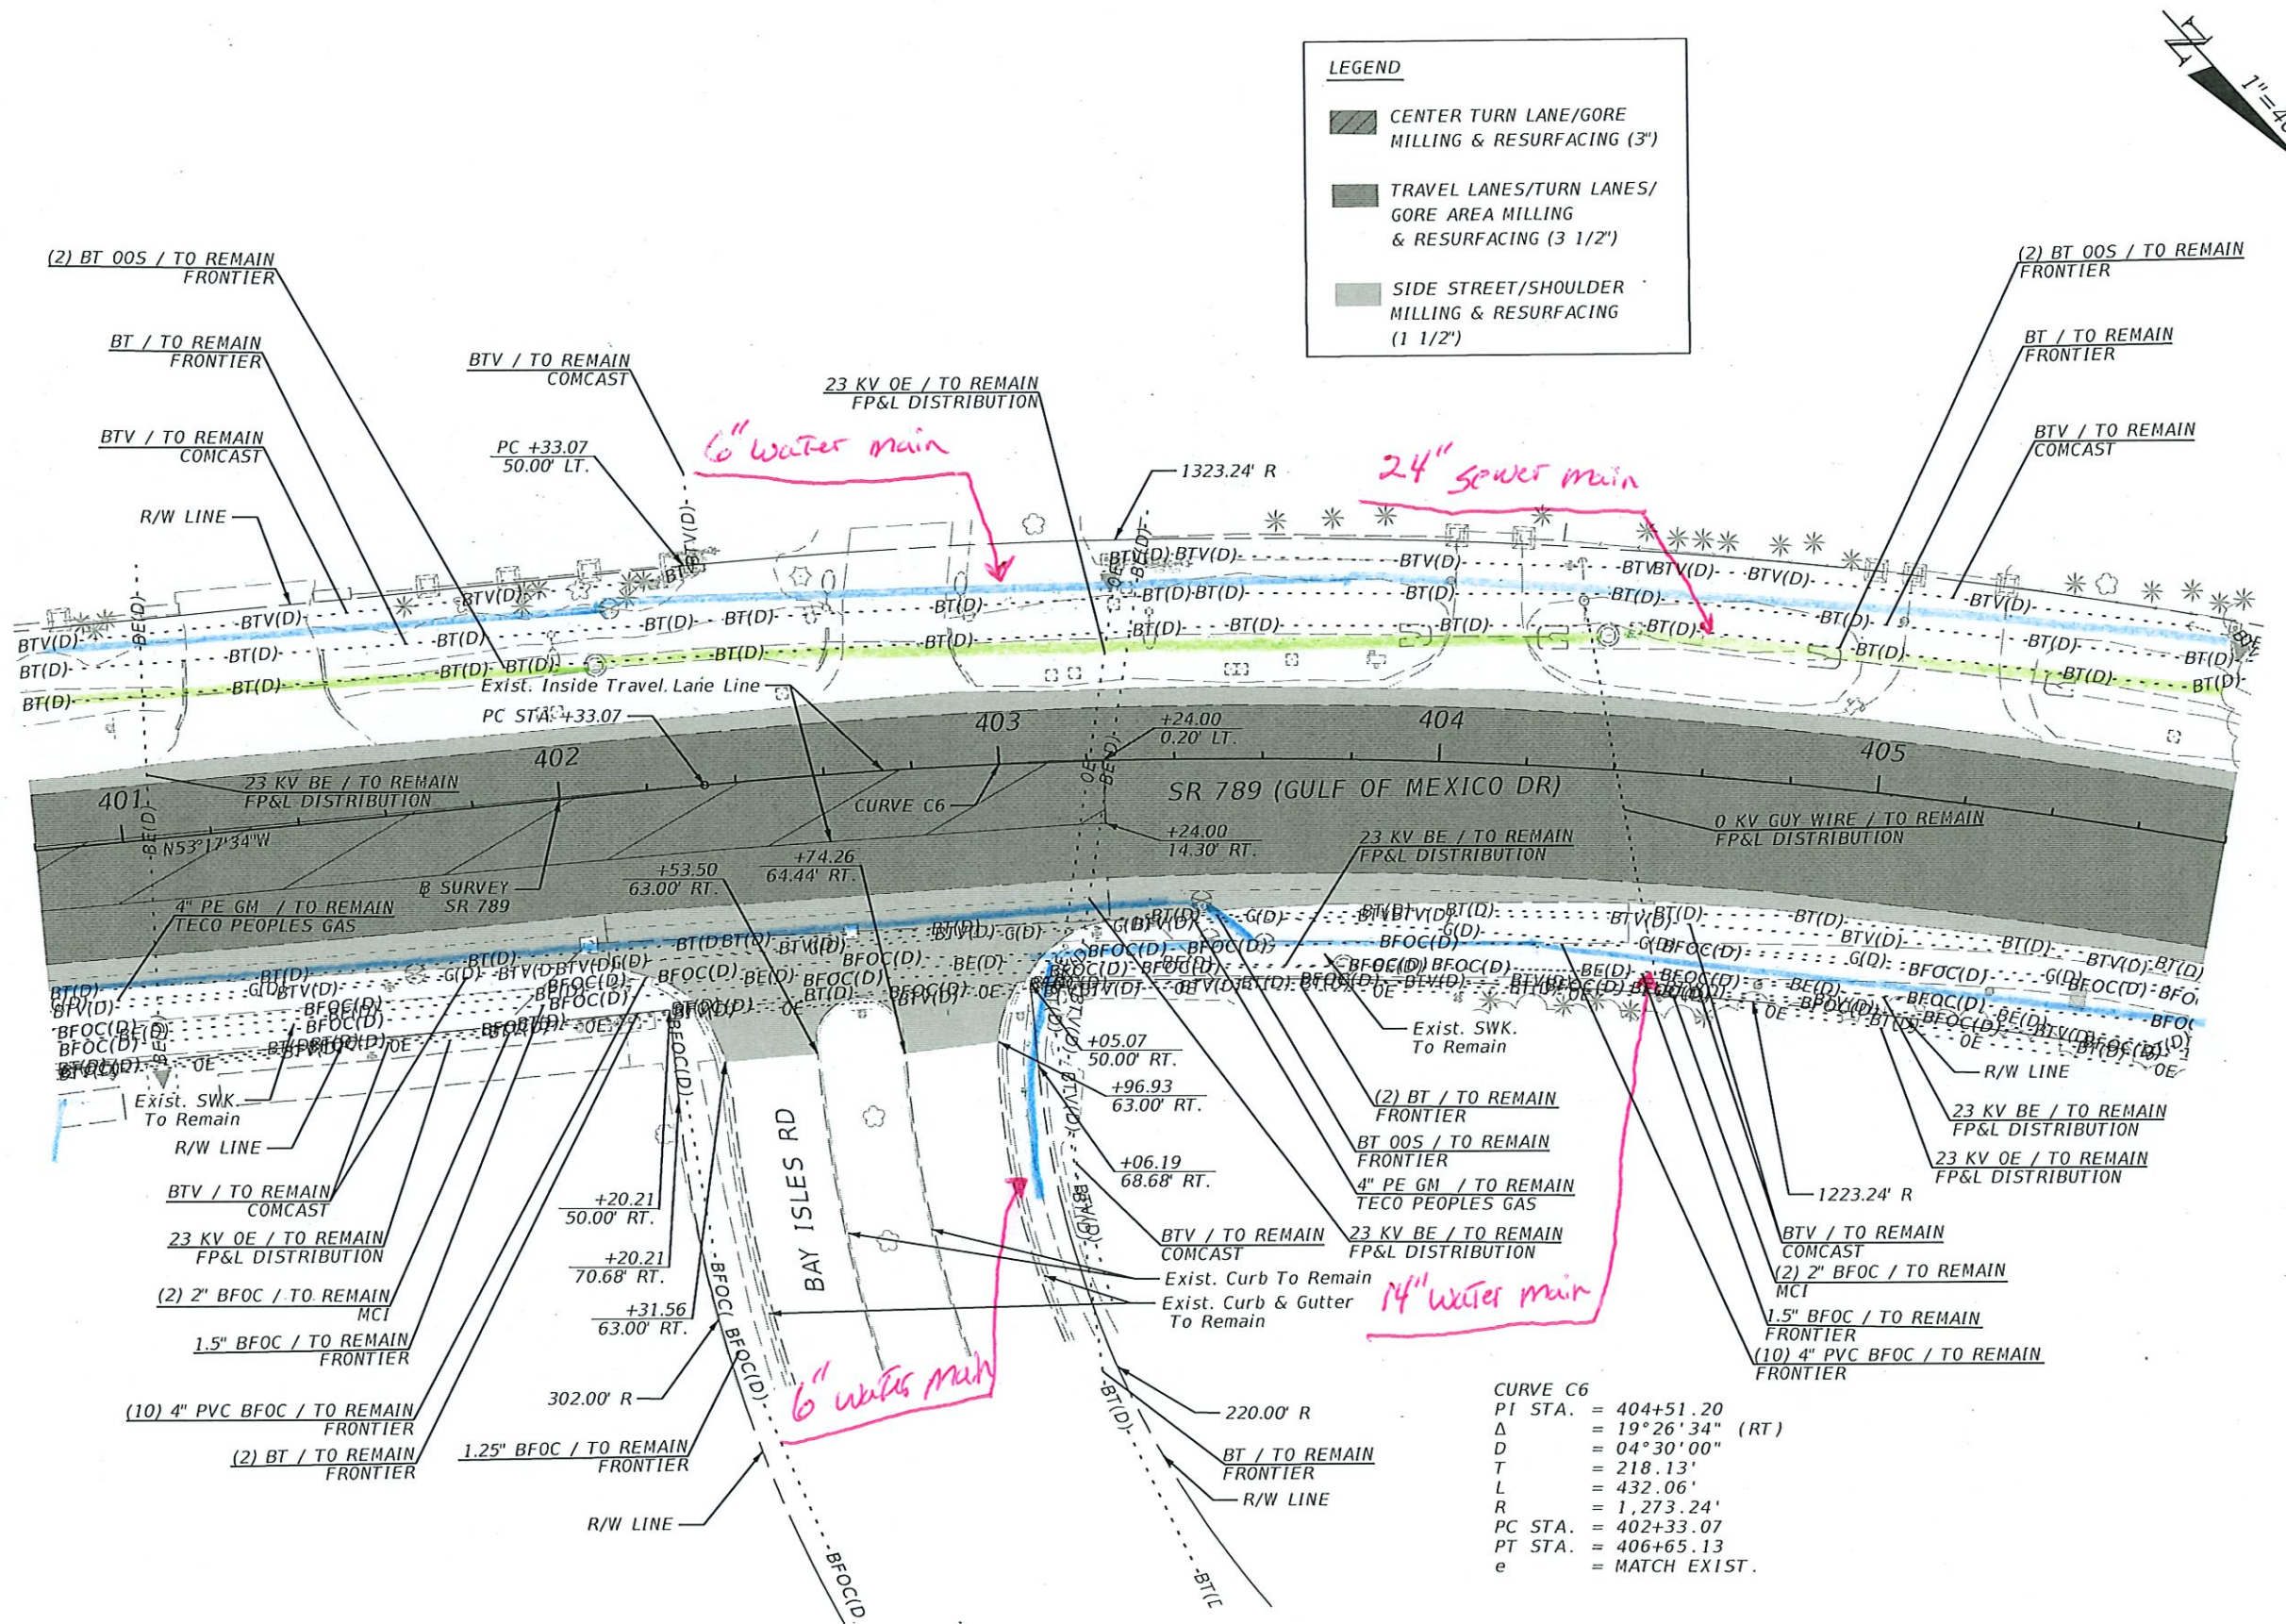

REVISIONS				ENGINEER OF RECORD			STATE OF FLORIDA DEPARTMENT OF TRANSPORTATION			ROADWAY PLAN (31)	SHEET NO. 66
DATE	DESCRIPTION	DATE	DESCRIPTION	MEGAN LERNER, P.E. LICENSE NUMBER: 72217 GARRETT ENGINEERING GROUP, INC. 120 10TH AVENUE NORTH SAINT PETERSBURG, FL 33701			ROAD NO.	COUNTY	FINANCIAL PROJECT ID		
							SR 789	SARASOTA	451013-1-52-01		


LEGEND

- CENTER TURN LANE/GORE
MILLING & RESURFACING (3")
- TRAVEL LANES/TURN LANES/
GORE AREA MILLING
& RESURFACING (3 1/2")
- SIDE STREET/SHOULDER
MILLING & RESURFACING
(1 1/2")

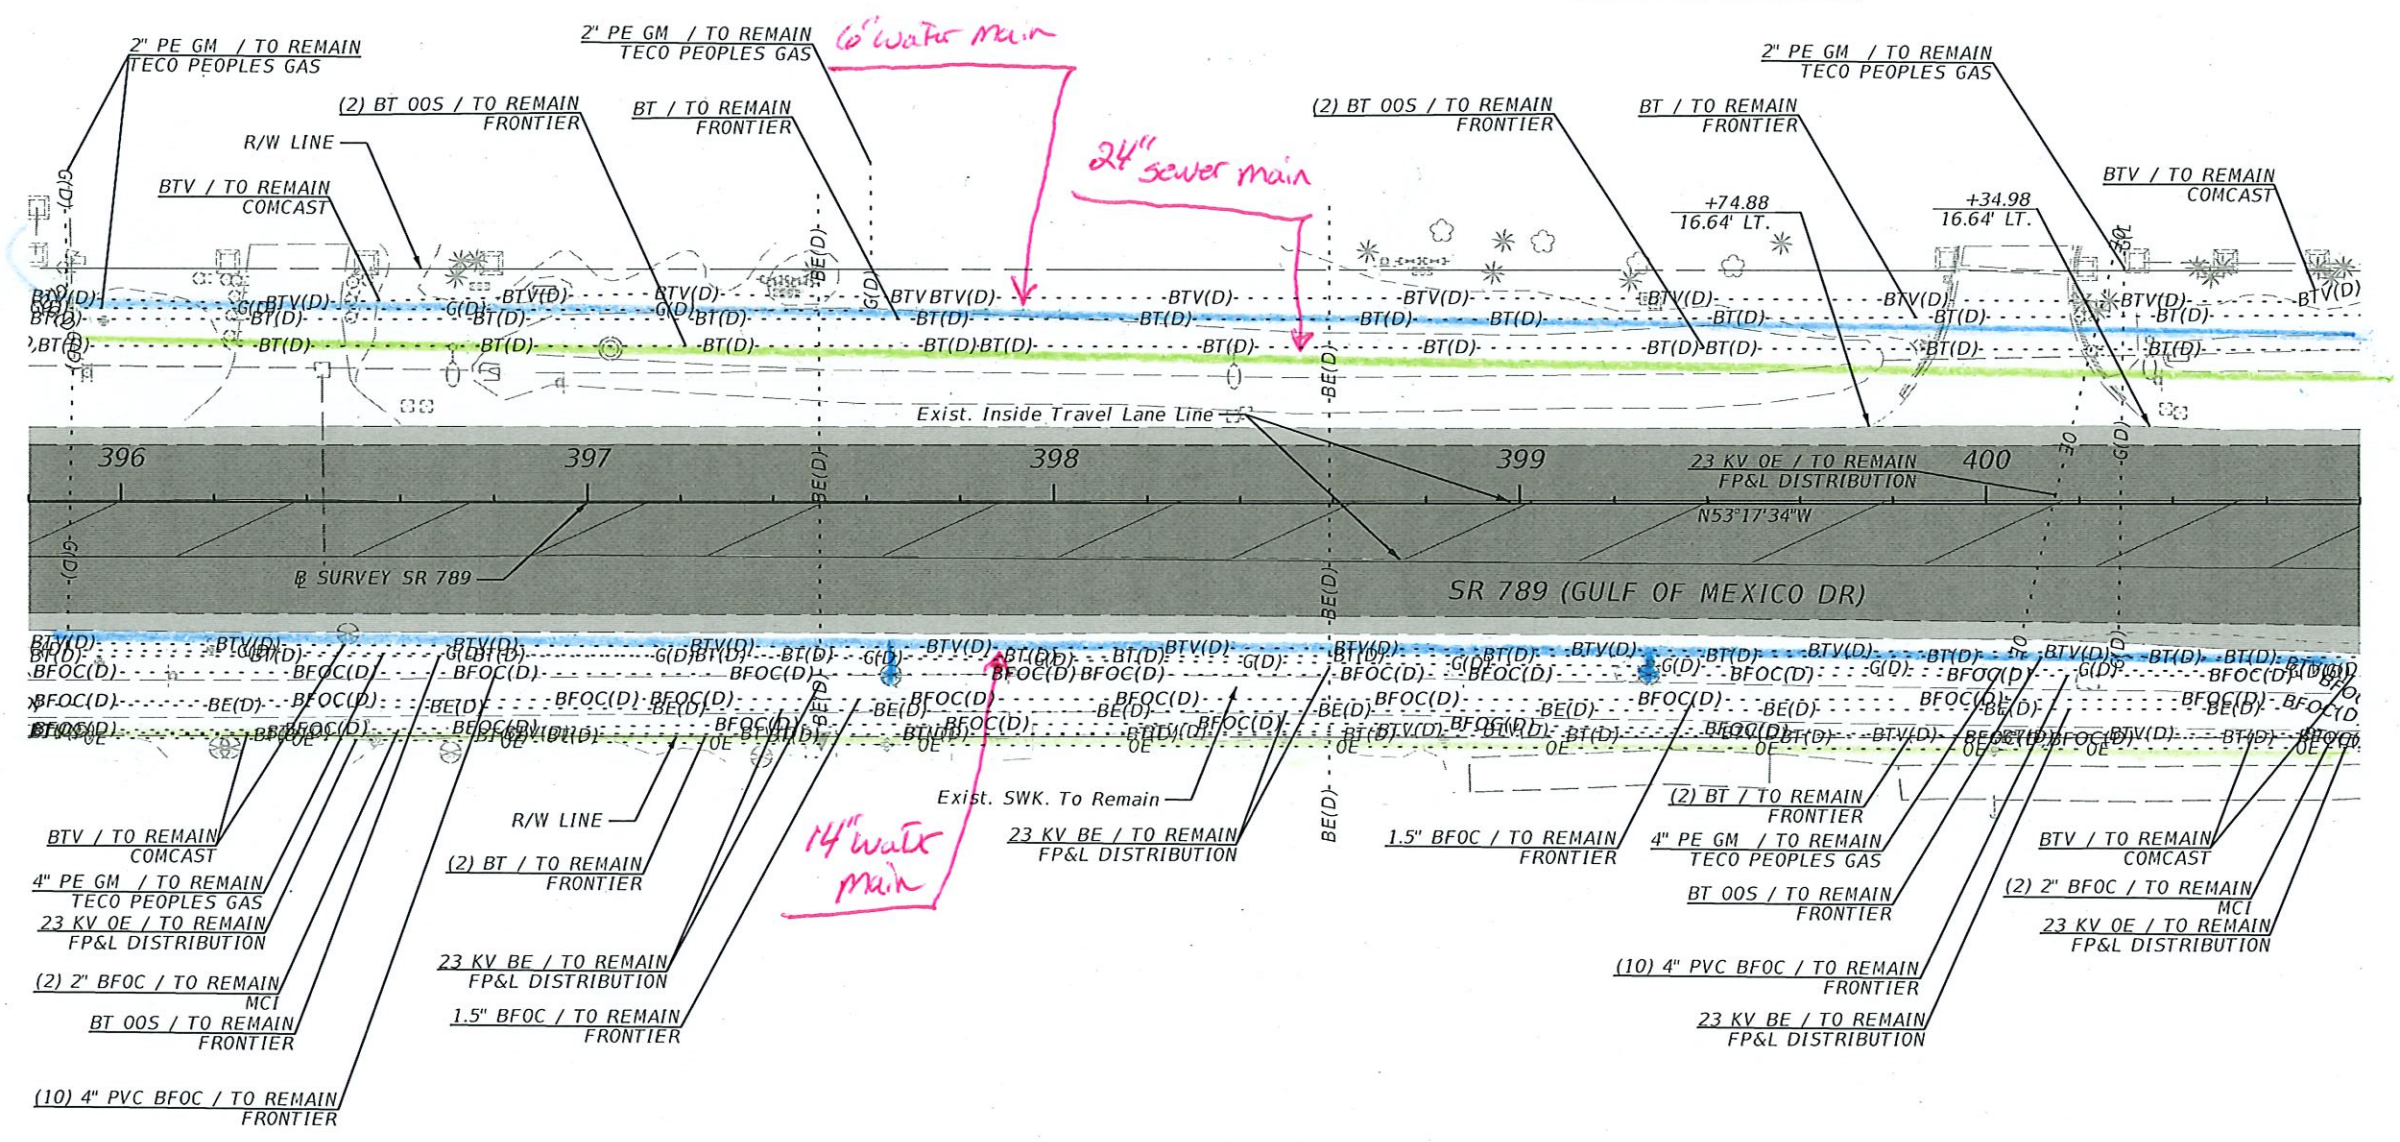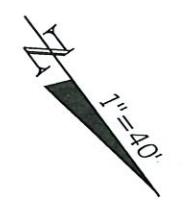


REVISIONS				ENGINEER OF RECORD			STATE OF FLORIDA DEPARTMENT OF TRANSPORTATION			ROADWAY PLAN (30)	SHEET NO. 65
DATE	DESCRIPTION	DATE	DESCRIPTION	MEGAN LERNER, P.E. LICENSE NUMBER: 72217 GARRETT ENGINEERING GROUP, INC. 120 10TH AVENUE NORTH SAINT PETERSBURG, FL 33701			ROAD NO.	COUNTY	FINANCIAL PROJECT ID		
							SR 789	SARASOTA	451013-1-52-01		

THE OFFICIAL RECORD OF THIS SHEET IS THE ELECTRONIC FILE DIGITALLY SIGNED AND SEALED UNDER RULE 61G15-23.004, F.A.C.

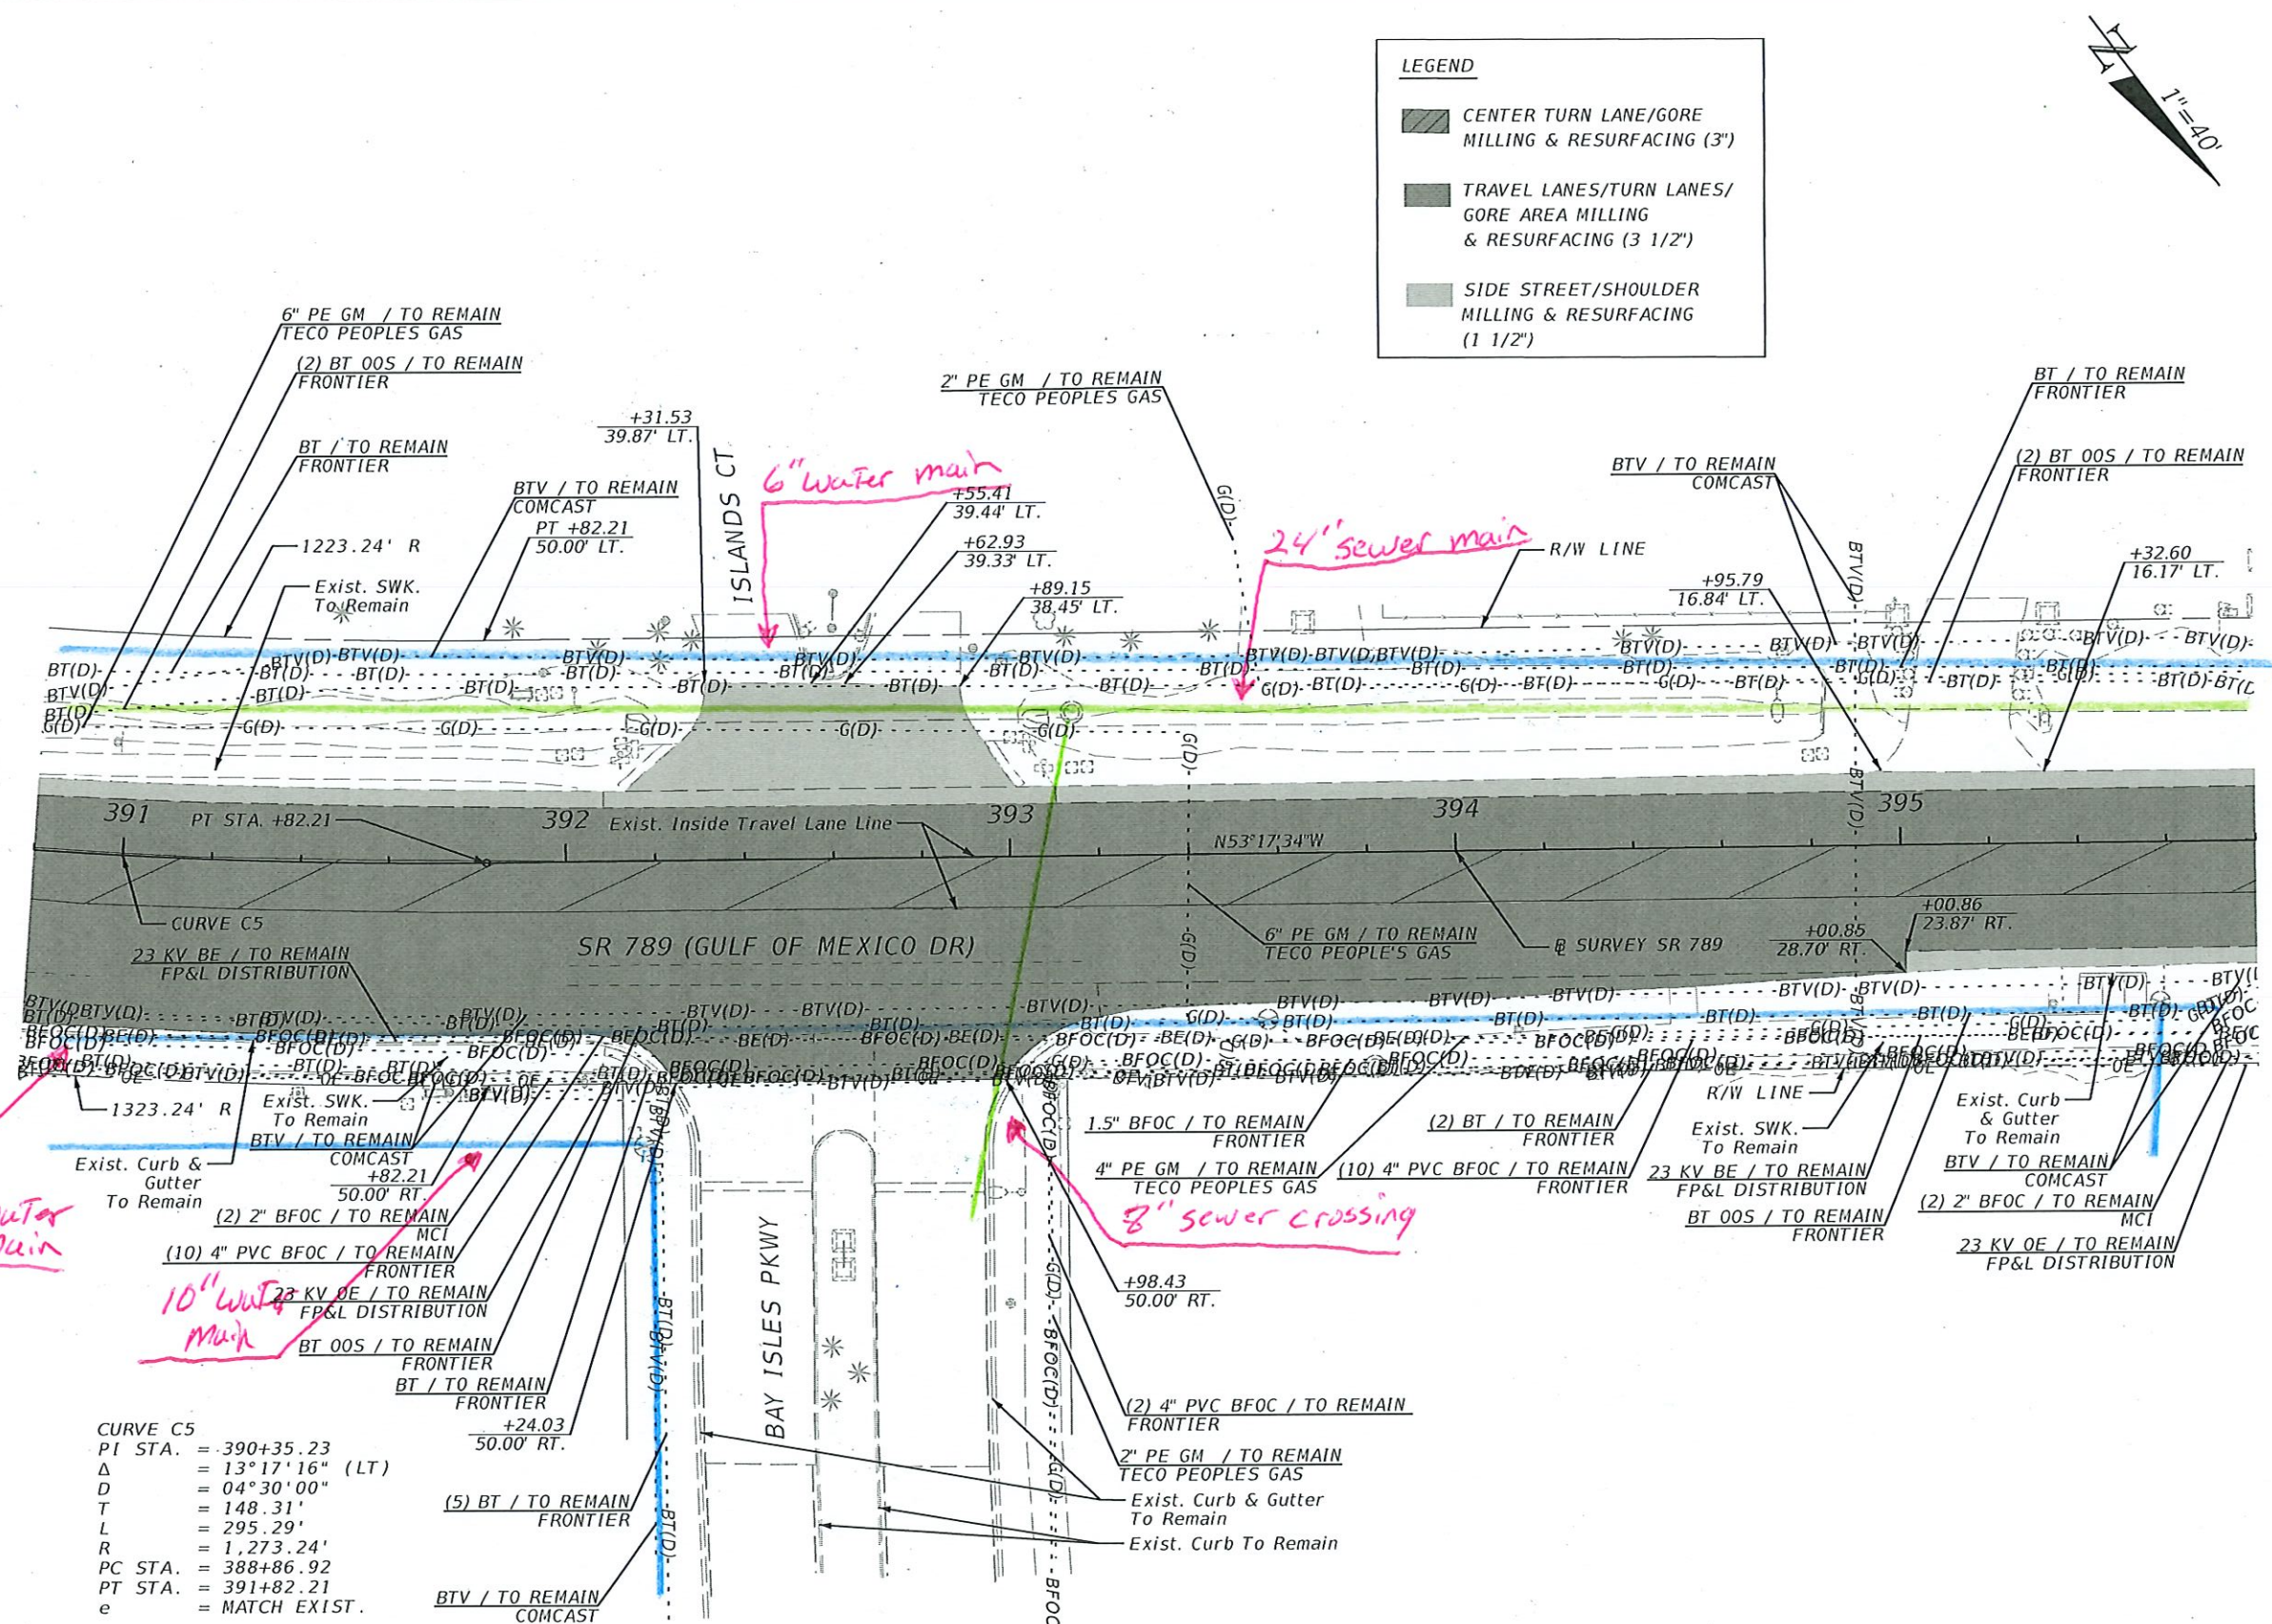


REVISIONS				ENGINEER OF RECORD	STATE OF FLORIDA DEPARTMENT OF TRANSPORTATION			ROADWAY PLAN (29)	SHEET NO.
DATE	DESCRIPTION	DATE	DESCRIPTION	MEGAN LERNER, P.E. LICENSE NUMBER: 72217 GARRETT ENGINEERING GROUP, INC. 120 10TH AVENUE NORTH SAINT PETERSBURG, FL 33701	ROAD NO.	COUNTY	FINANCIAL PROJECT ID		64
					SR 789	SARASOTA	451013-1-52-01		

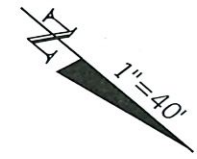


LEGEND

- CENTER TURN LANE/GORE
MILLING & RESURFACING (3")
- TRAVEL LANES/TURN LANES/
GORE AREA MILLING
& RESURFACING (3 1/2")
- SIDE STREET/SHOULDER
MILLING & RESURFACING
(1 1/2")

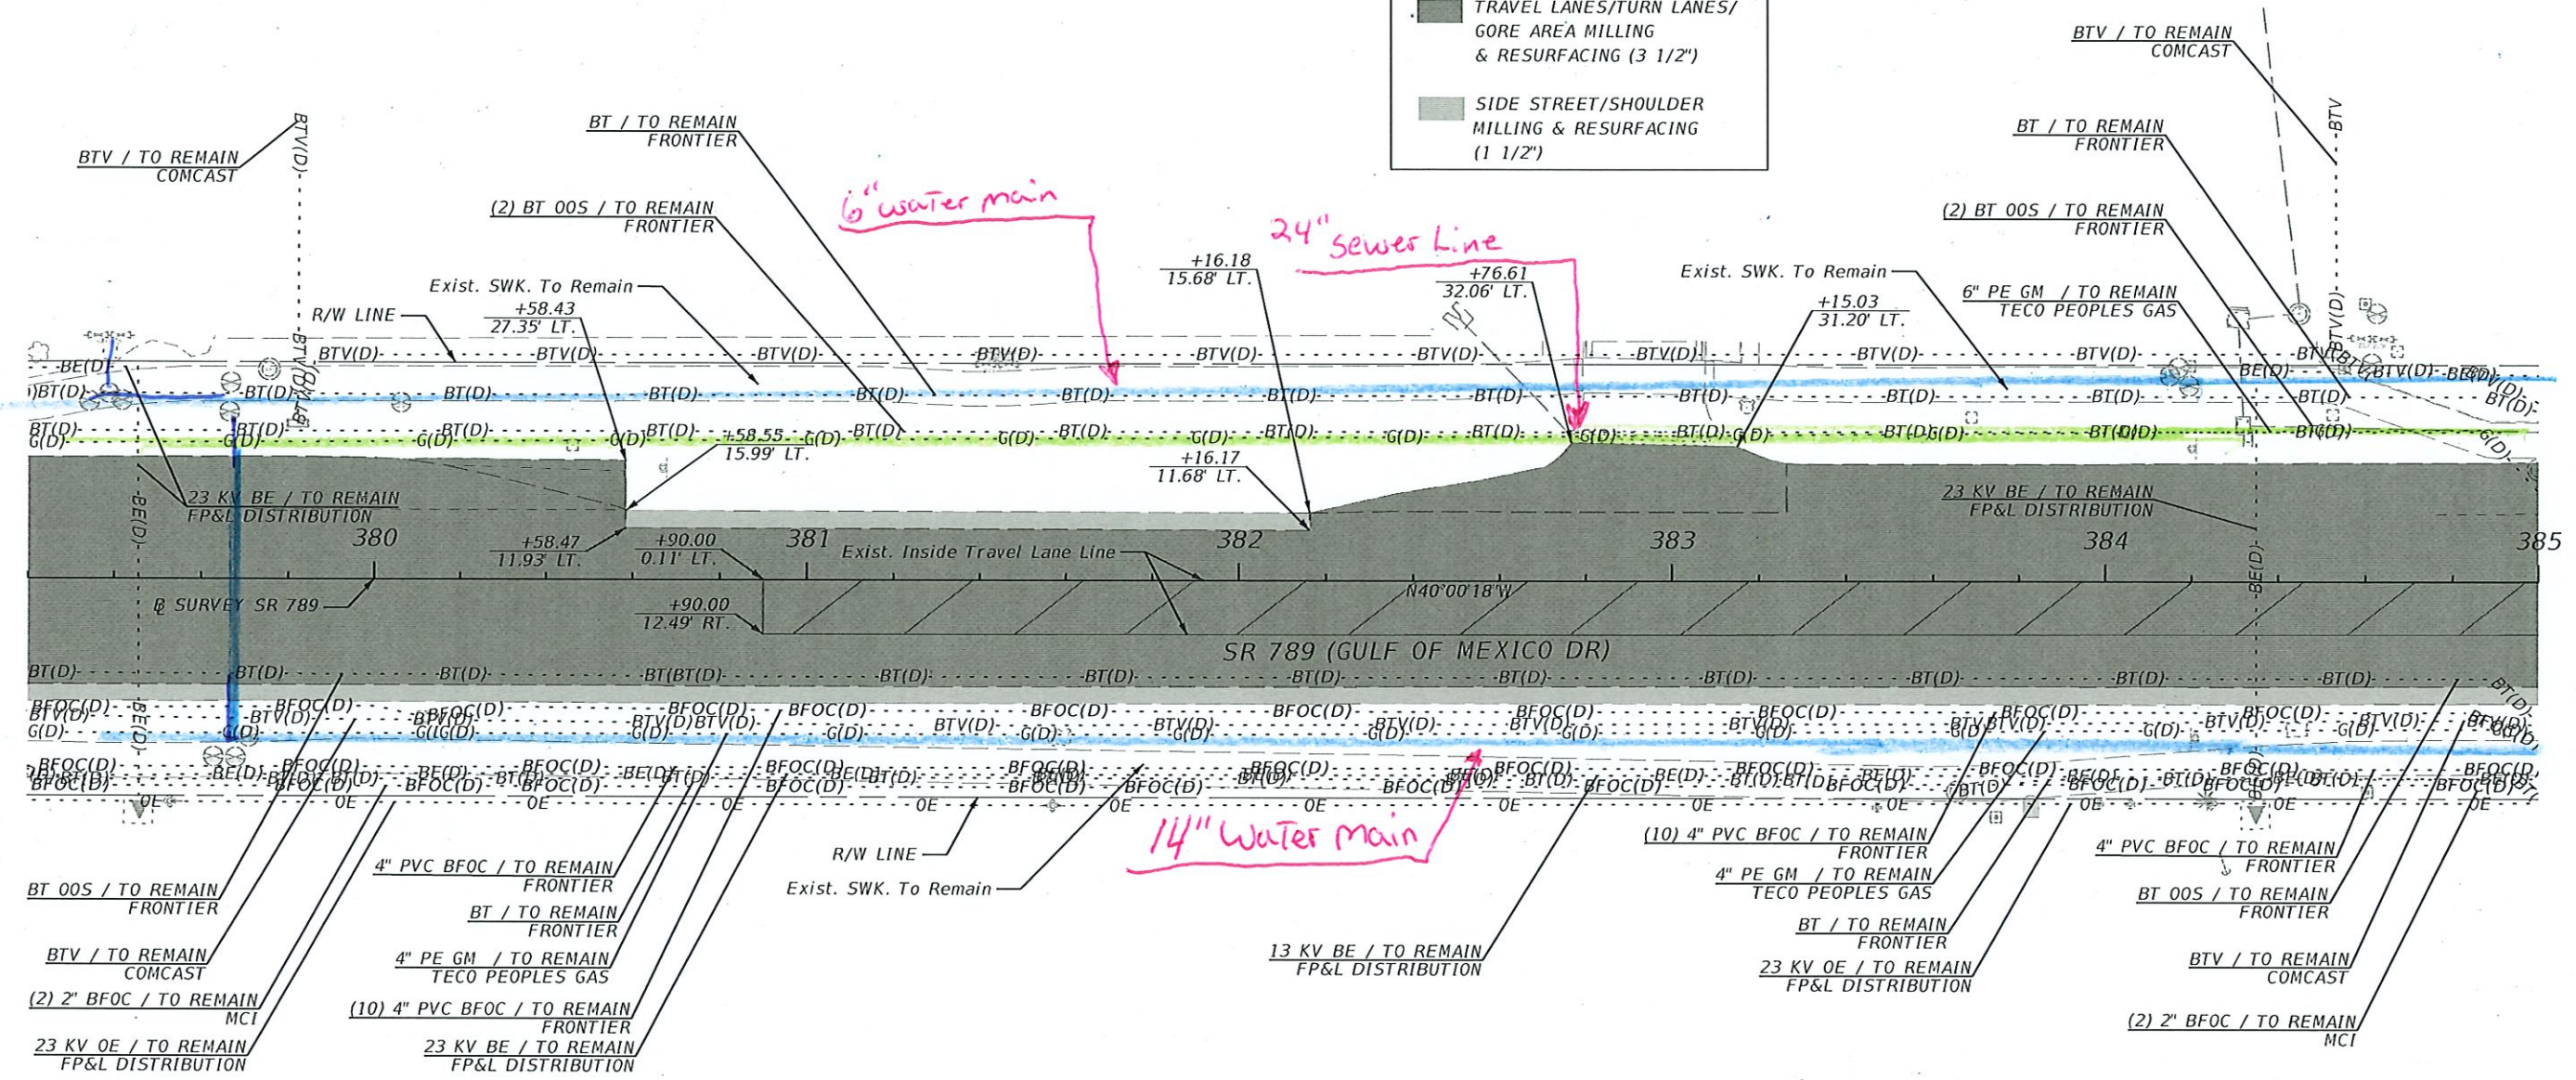


REVISIONS				ENGINEER OF RECORD	STATE OF FLORIDA DEPARTMENT OF TRANSPORTATION			ROADWAY PLAN (27)	SHEET NO.
DATE	DESCRIPTION	DATE	DESCRIPTION	MEGAN LERNER, P.E LICENSE NUMBER: 72217 GARRETT ENGINEERING GROUP, INC. 120 10TH AVENUE NORTH SAINT PETERSBURG, FL 33701	ROAD NO.	COUNTY	FINANCIAL PROJECT ID		62
					SR 789	SARASOTA	451013-1-52-01		

THE OFFICIAL RECORD OF THIS SHEET IS THE ELECTRONIC FILE DIGITALLY SIGNED AND SEALED UNDER RULE 61G15-23.004, F.A.C.

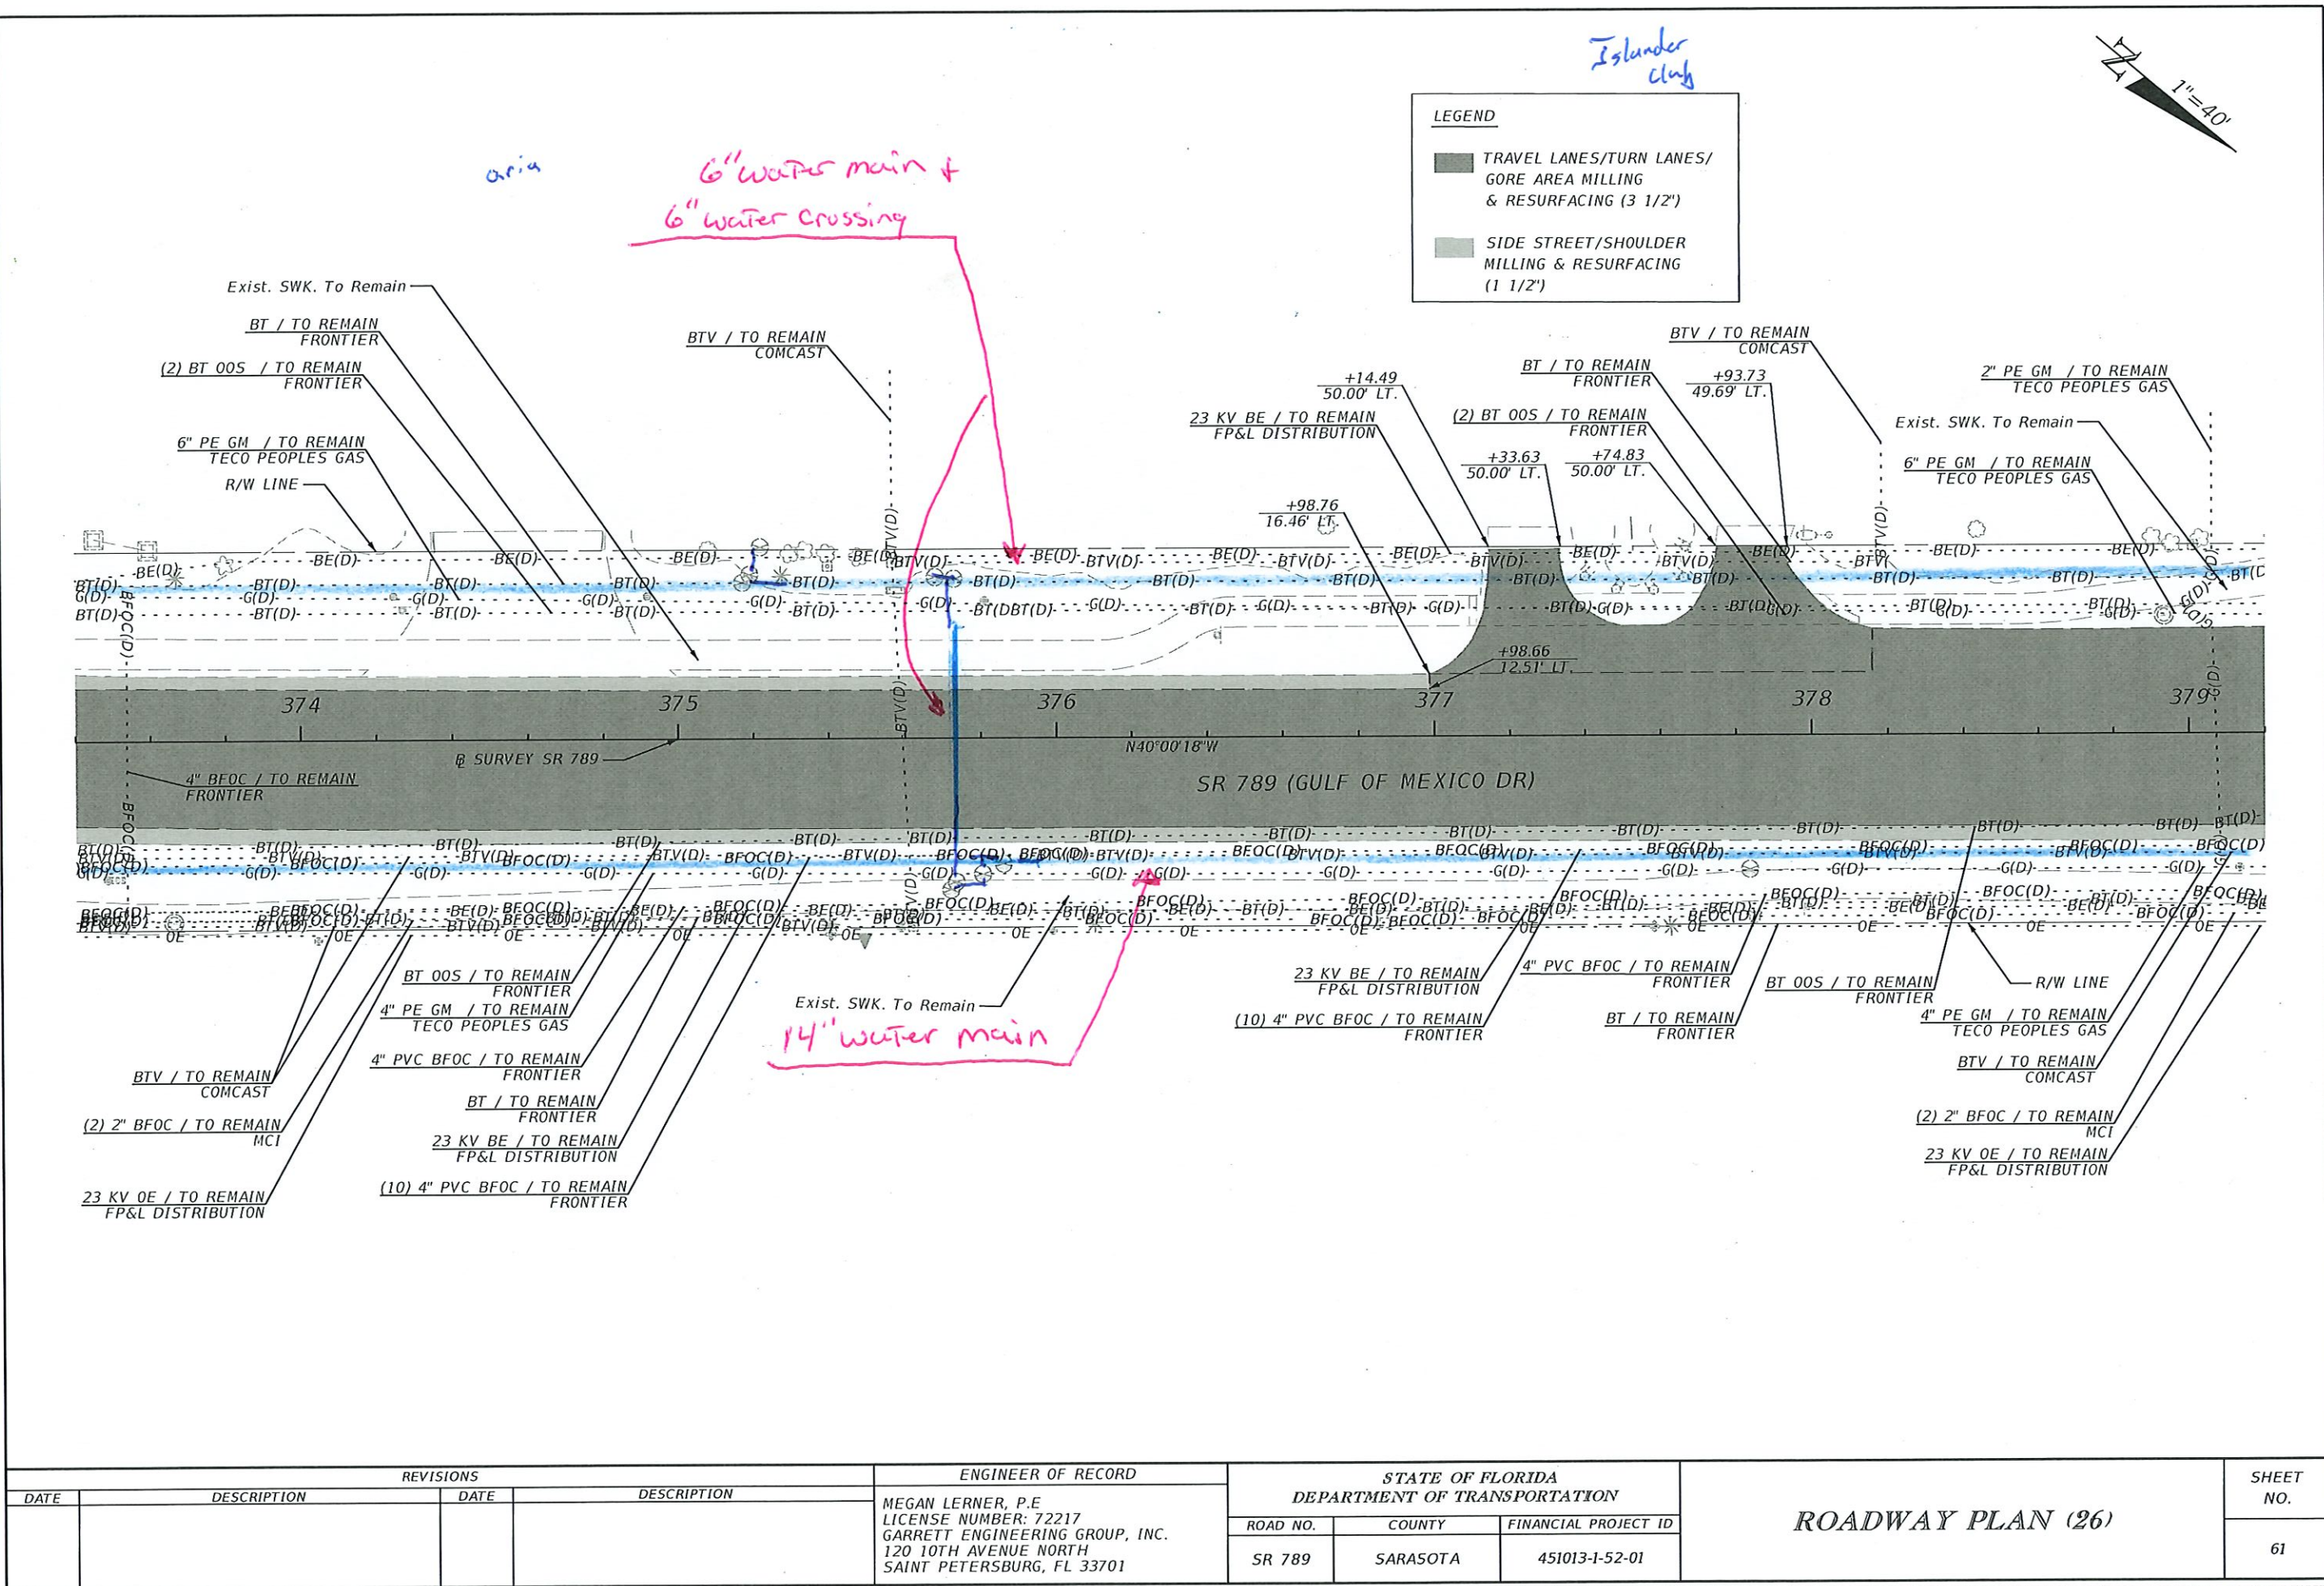

REVISIONS				ENGINEER OF RECORD		STATE OF FLORIDA DEPARTMENT OF TRANSPORTATION		ROADWAY PLAN (26)	SHEET NO. 61
DATE	DESCRIPTION	DATE	DESCRIPTION	MEGAN LERNER, P.E. LICENSE NUMBER: 72217 GARRETT ENGINEERING GROUP, INC. 120 10TH AVENUE NORTH SAINT PETERSBURG, FL 33701		ROAD NO.	COUNTY		
						SR 789	SARASOTA	451013-1-52-01	

THE OFFICIAL RECORD OF THIS SHEET IS THE ELECTRONIC FILE DIGITALLY SIGNED AND SEALED UNDER RULE 61G15-23.004, F.A.C.

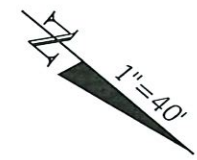


LEGEND

- TRAVEL LANES/TURN LANES/
GORE AREA MILLING
& RESURFACING (3 1/2")
- SIDE STREET/SHOULDER
MILLING & RESURFACING
(1 1/2")

Villa DE


6" water main
21" sewer main

14" water main

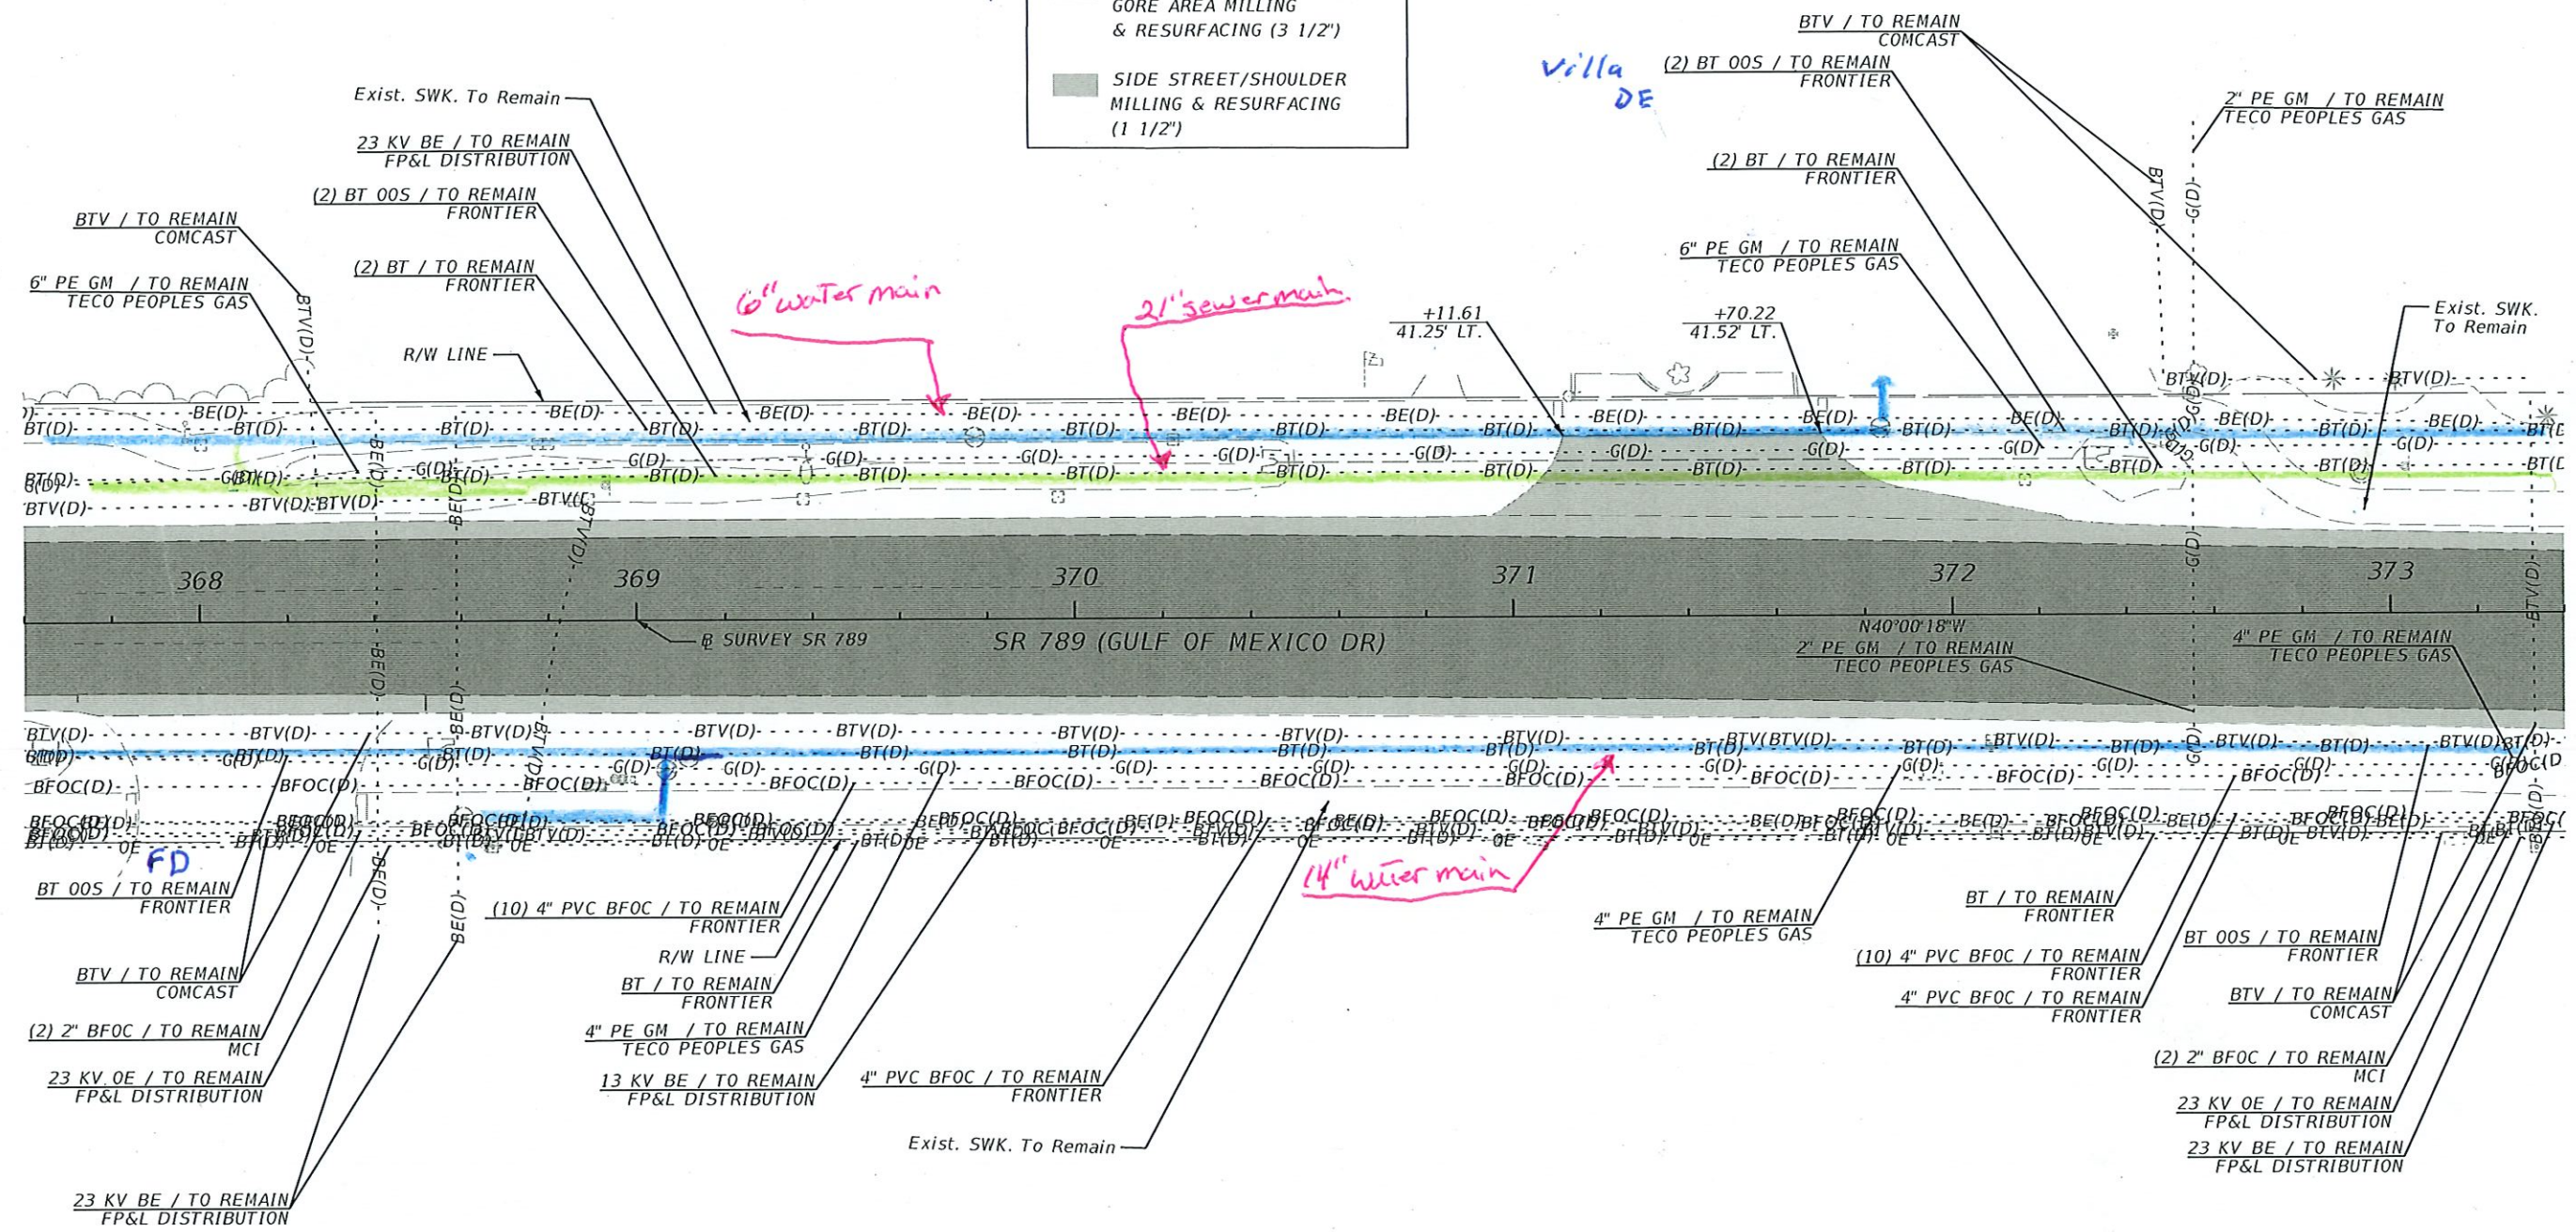


REVISIONS				ENGINEER OF RECORD		STATE OF FLORIDA DEPARTMENT OF TRANSPORTATION		ROADWAY PLAN (25)	SHEET NO. 60
DATE	DESCRIPTION	DATE	DESCRIPTION	MEGAN LERNER, P.E. LICENSE NUMBER: 72217 GARRETT ENGINEERING GROUP, INC. 120 10TH AVENUE NORTH SAINT PETERSBURG, FL 33701		ROAD NO.	COUNTY		
						SR 789	SARASOTA	451013-1-52-01	

THE OFFICIAL RECORD OF THIS SHEET IS THE ELECTRONIC FILE DIGITALLY SIGNED AND SEALED UNDER RULE 61G15-23.004, F.A.C.

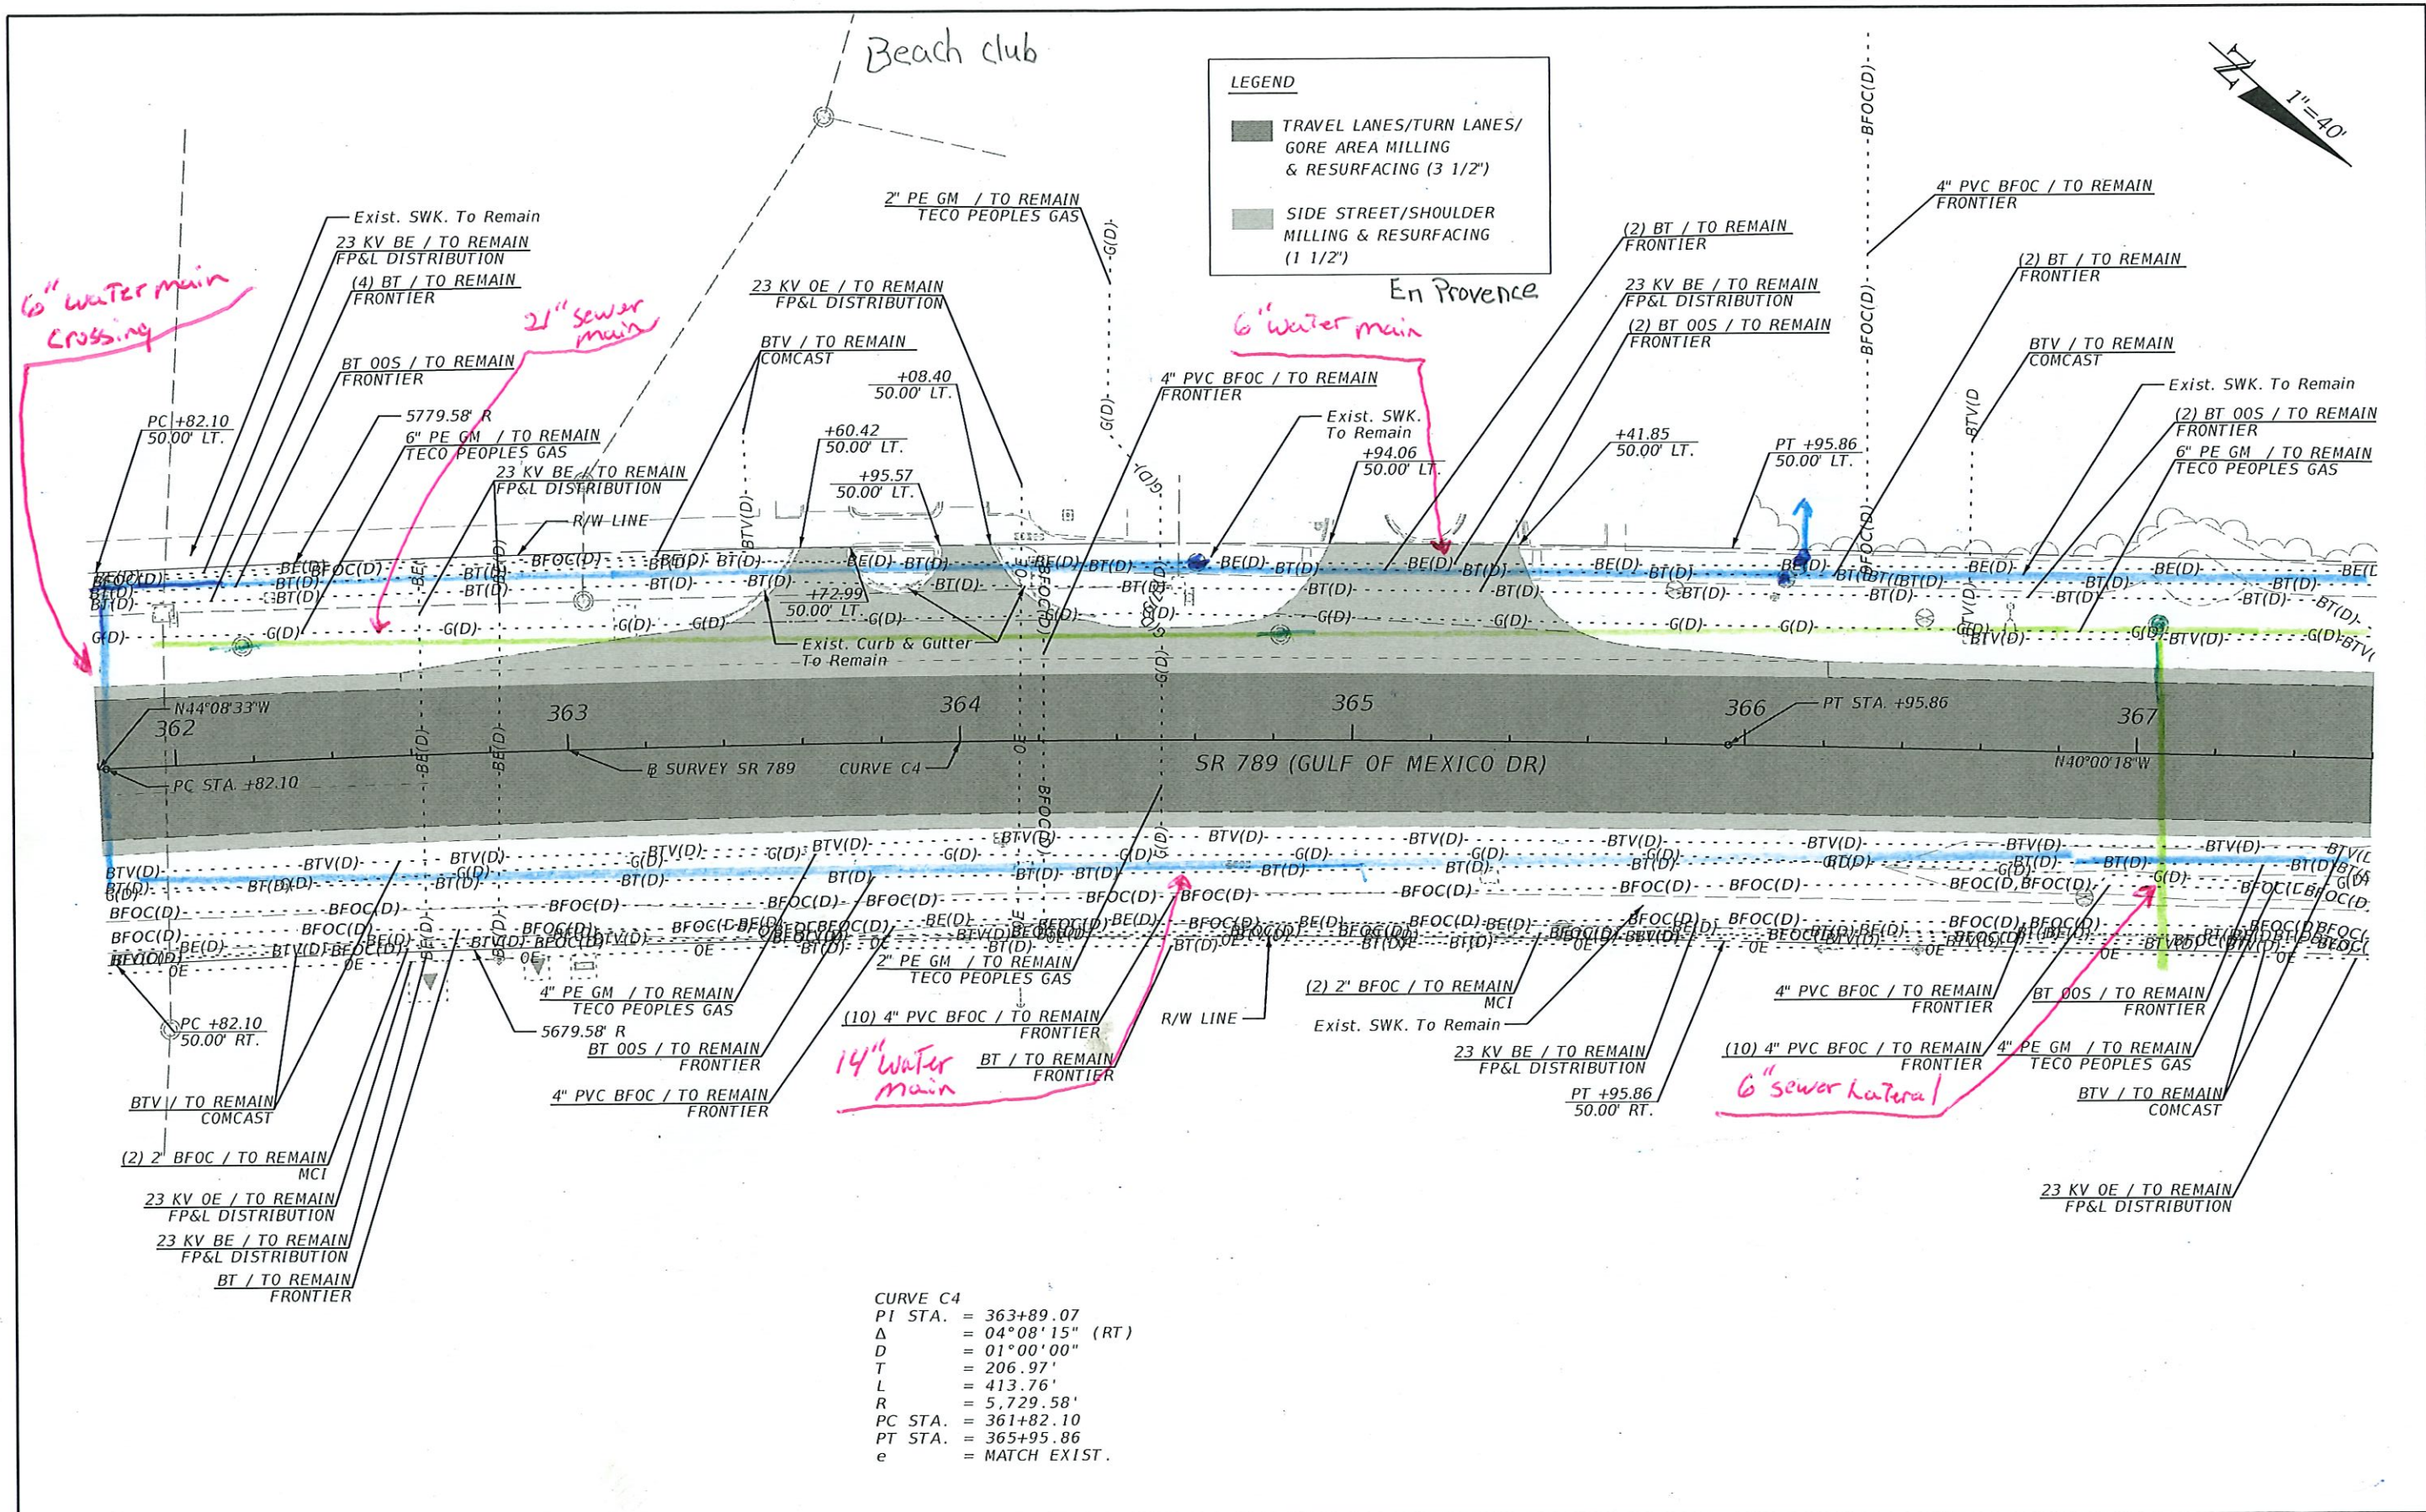


REVISIONS				ENGINEER OF RECORD		STATE OF FLORIDA DEPARTMENT OF TRANSPORTATION		ROADWAY PLAN (24)	SHEET NO. 59
DATE	DESCRIPTION	DATE	DESCRIPTION	MEGAN LERNER, P.E. LICENSE NUMBER: 72217 GARRETT ENGINEERING GROUP, INC. 120 10TH AVENUE NORTH SAINT PETERSBURG, FL 33701		ROAD NO.	COUNTY		
						SR 789	SARASOTA	451013-1-52-01	

A diagram showing a roof pitch of 12/12, indicated by a triangle with a vertical side of 12 and a horizontal side of 12. Below the triangle, a scale is given as 1"=40'.

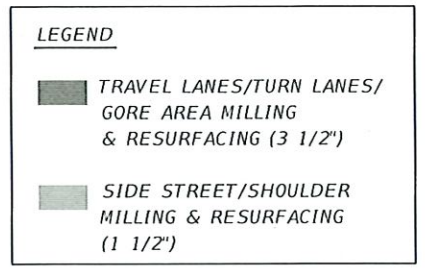


C:\Users\g3\Garrett Team Dropbox\GEG Projects\SR 789 from Longboat Club to Manatee CL\45101315201\Roadway\PLAHRD01.dgn : BLSR789 - PLAN-21 [SHEET]
g3 8/14/2025 1:43:29 PM

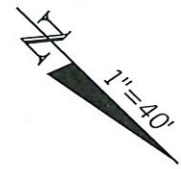

LEGEND


TRAVEL LANES/TURN LANES/
GORE AREA MILLING
& RESURFACING (3 1/2")

SIDE STREET/SHOULDER
MILLING & RESURFACING
(1 1/2")

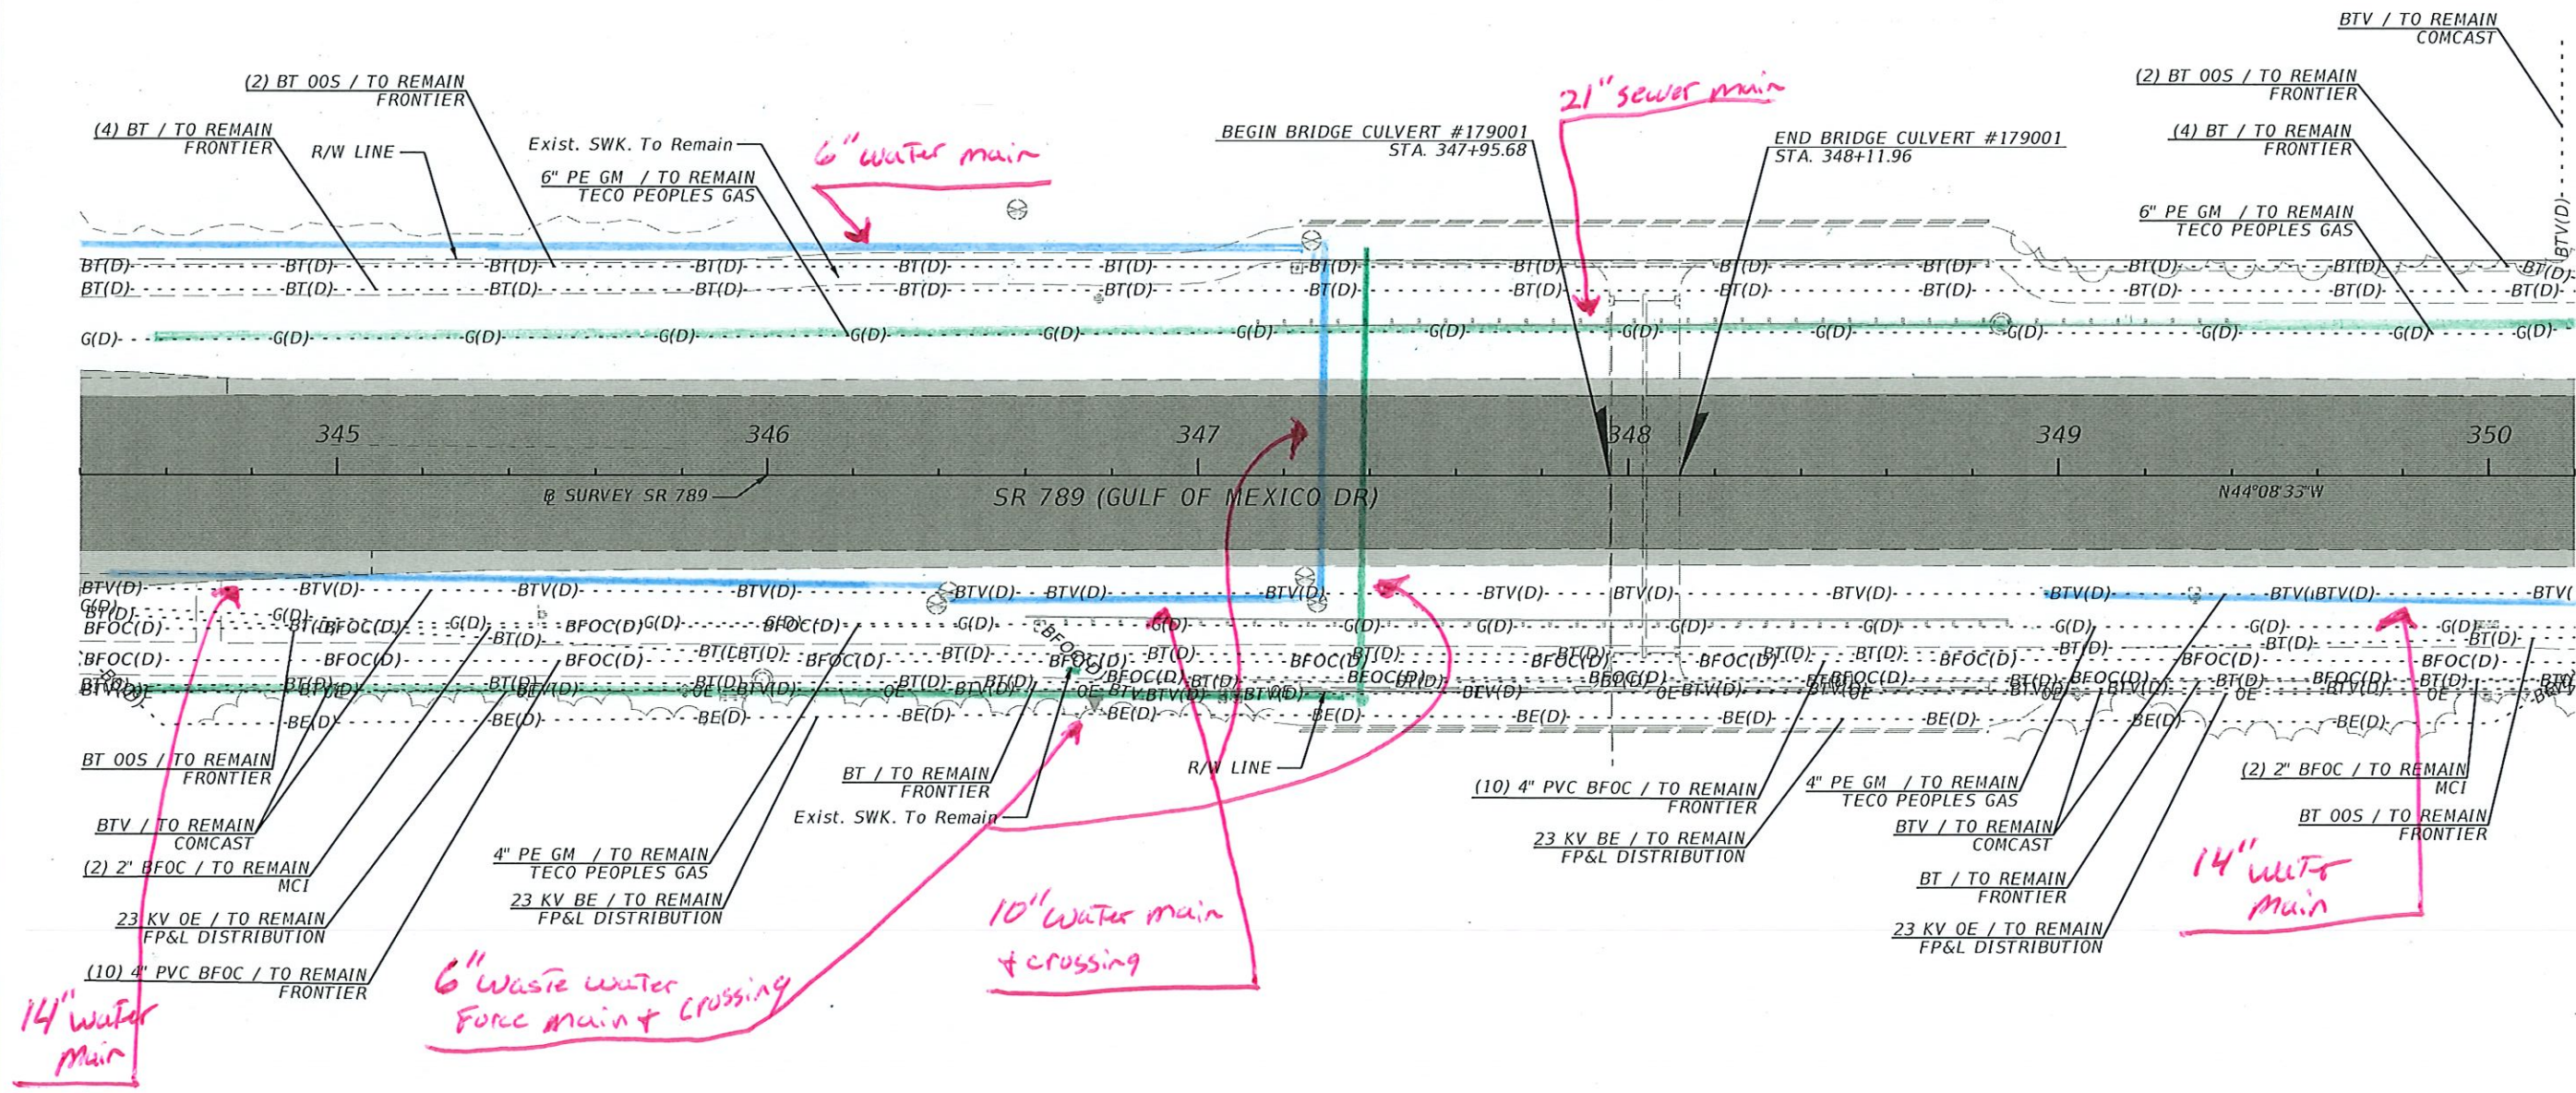


REVISIONS				ENGINEER OF RECORD			STATE OF FLORIDA DEPARTMENT OF TRANSPORTATION			ROADWAY PLAN (21)	SHEET NO. 56
DATE	DESCRIPTION	DATE	DESCRIPTION	MEGAN LERNER, P.E. LICENSE NUMBER: 72217 GARRETT ENGINEERING GROUP, INC. 120 10TH AVENUE NORTH SAINT PETERSBURG, FL 33701			ROAD NO.	COUNTY	FINANCIAL PROJECT ID		
							SR 789	SARASOTA	451013-1-52-01		

THE OFFICIAL RECORD OF THIS SHEET IS THE ELECTRONIC FILE DIGITALLY SIGNED AND SEALED UNDER RULE 61G15-23.004, F.A.C.

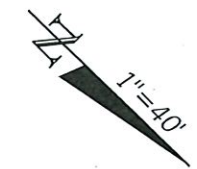


LEGEND

- TRAVEL LANES/TURN LANES/
GORE AREA MILLING
& RESURFACING (3 1/2')
- SIDE STREET/SHOULDER
MILLING & RESURFACING
(1 1/2')

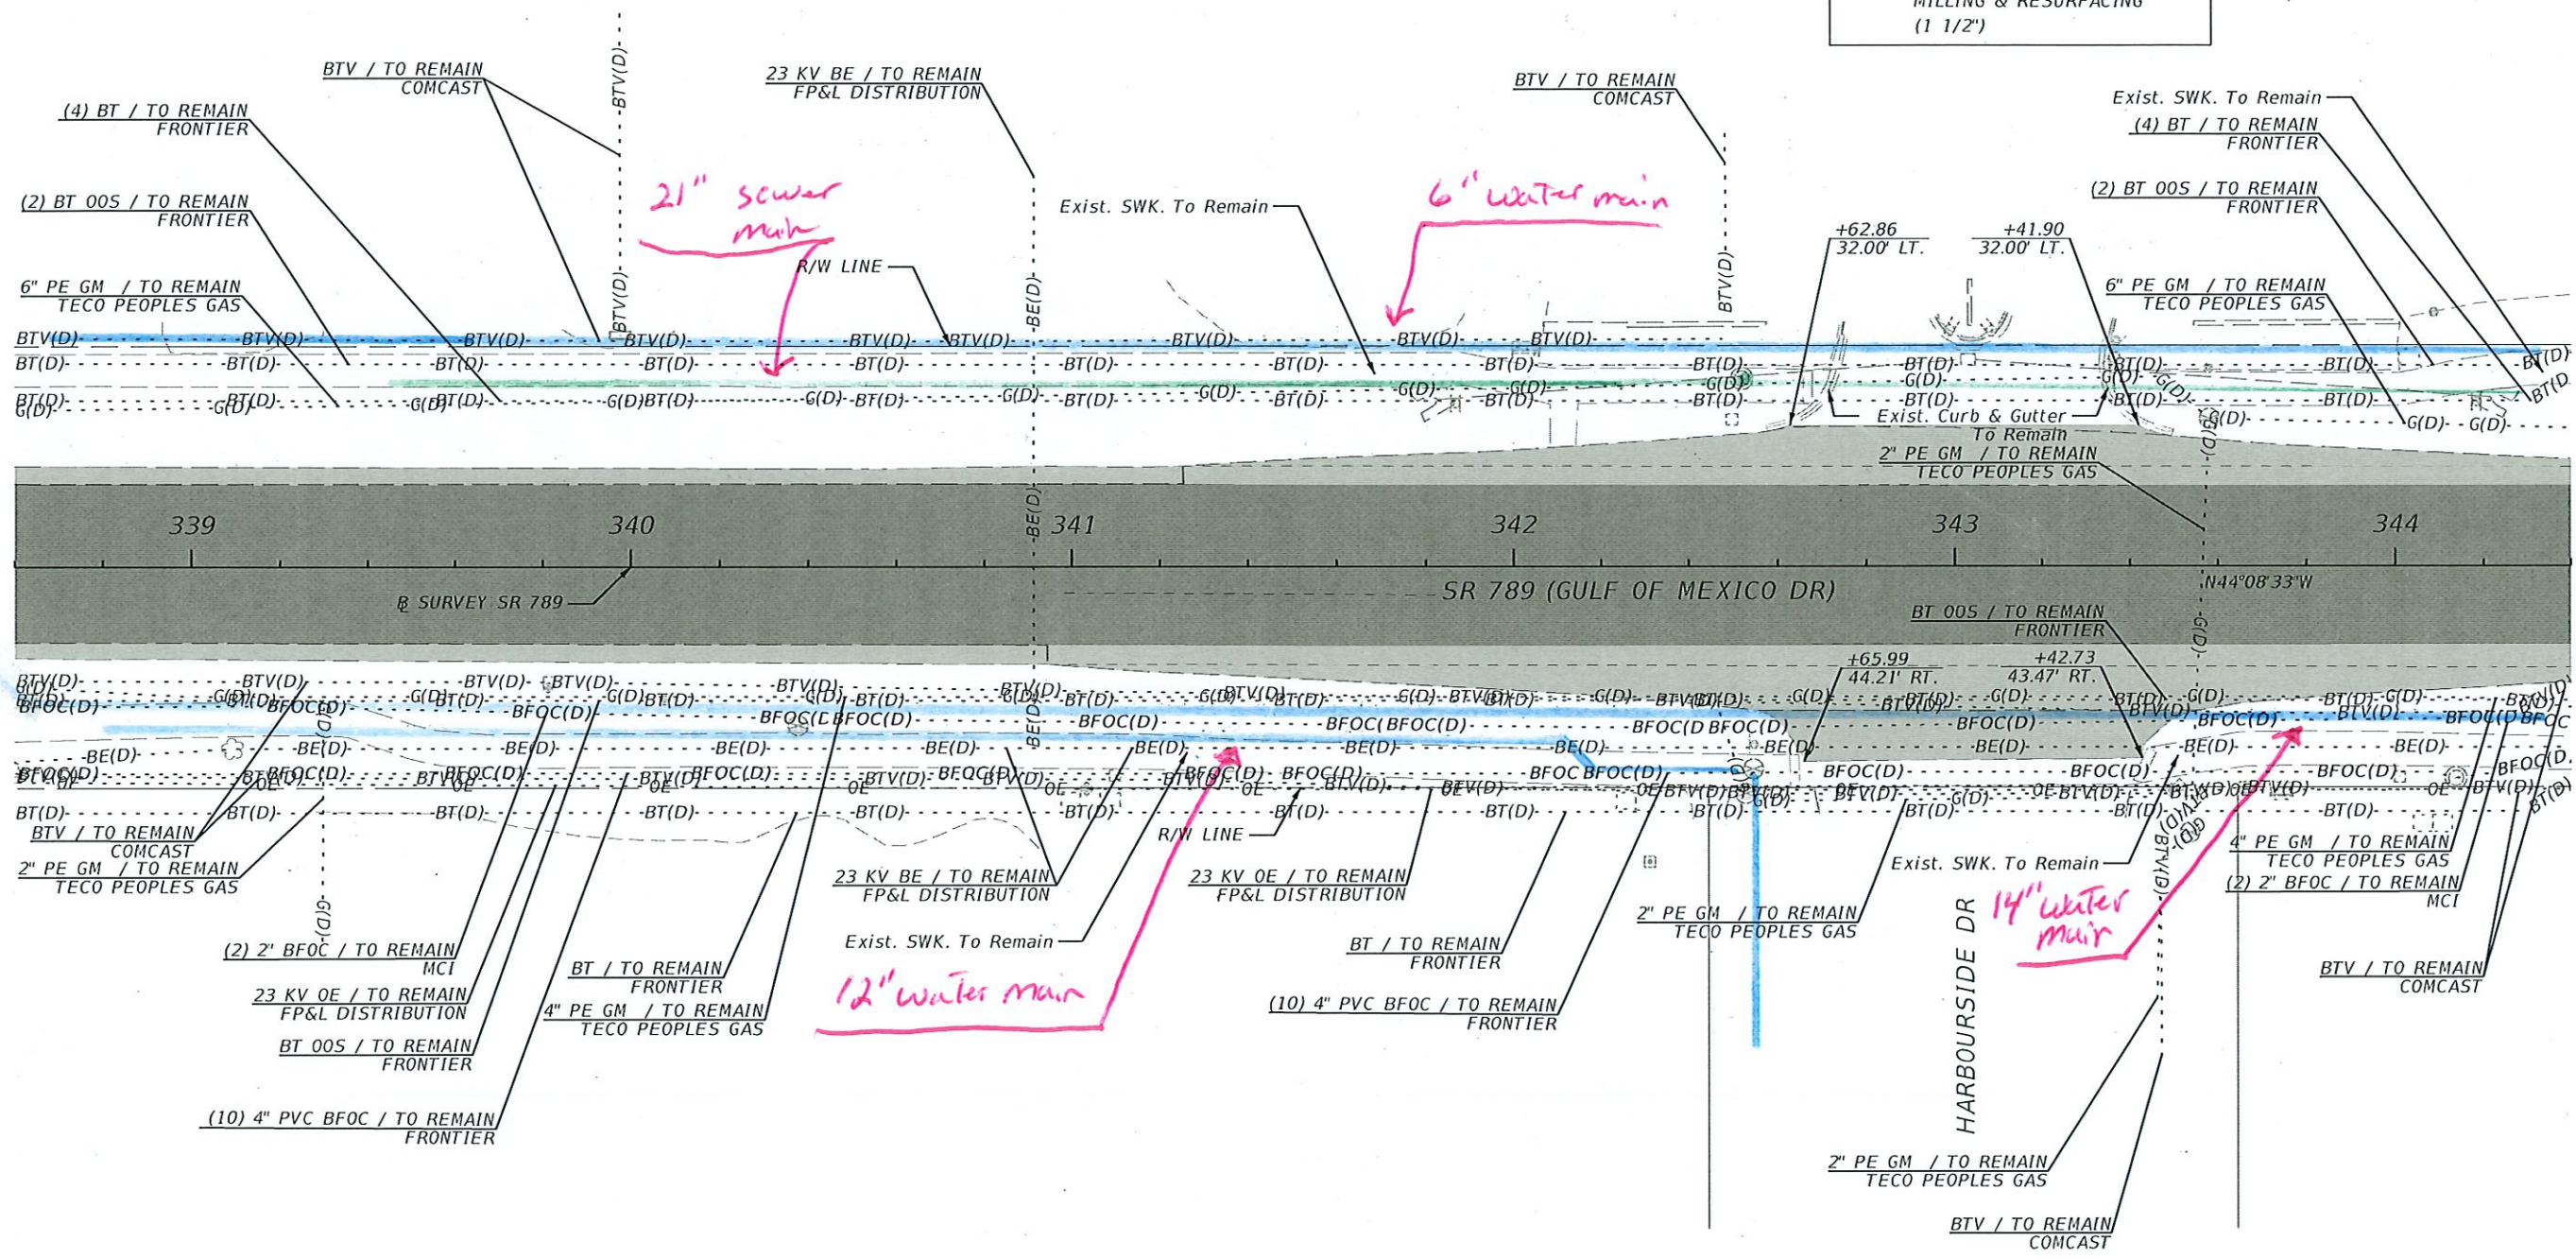


REVISIONS				ENGINEER OF RECORD			STATE OF FLORIDA DEPARTMENT OF TRANSPORTATION			ROADWAY PLAN (20)	SHEET NO. 55
DATE	DESCRIPTION	DATE	DESCRIPTION	MEGAN LERNER, P.E. LICENSE NUMBER: 72217 GARRETT ENGINEERING GROUP, INC. 120 10TH AVENUE NORTH SAINT PETERSBURG, FL 33701			ROAD NO.	COUNTY	FINANCIAL PROJECT ID		
							SR 789	SARASOTA	451013-1-52-01		

THE OFFICIAL RECORD OF THIS SHEET IS THE ELECTRONIC FILE DIGITALLY SIGNED AND SEALED UNDER RULE 61G15-23.004, F.A.C.

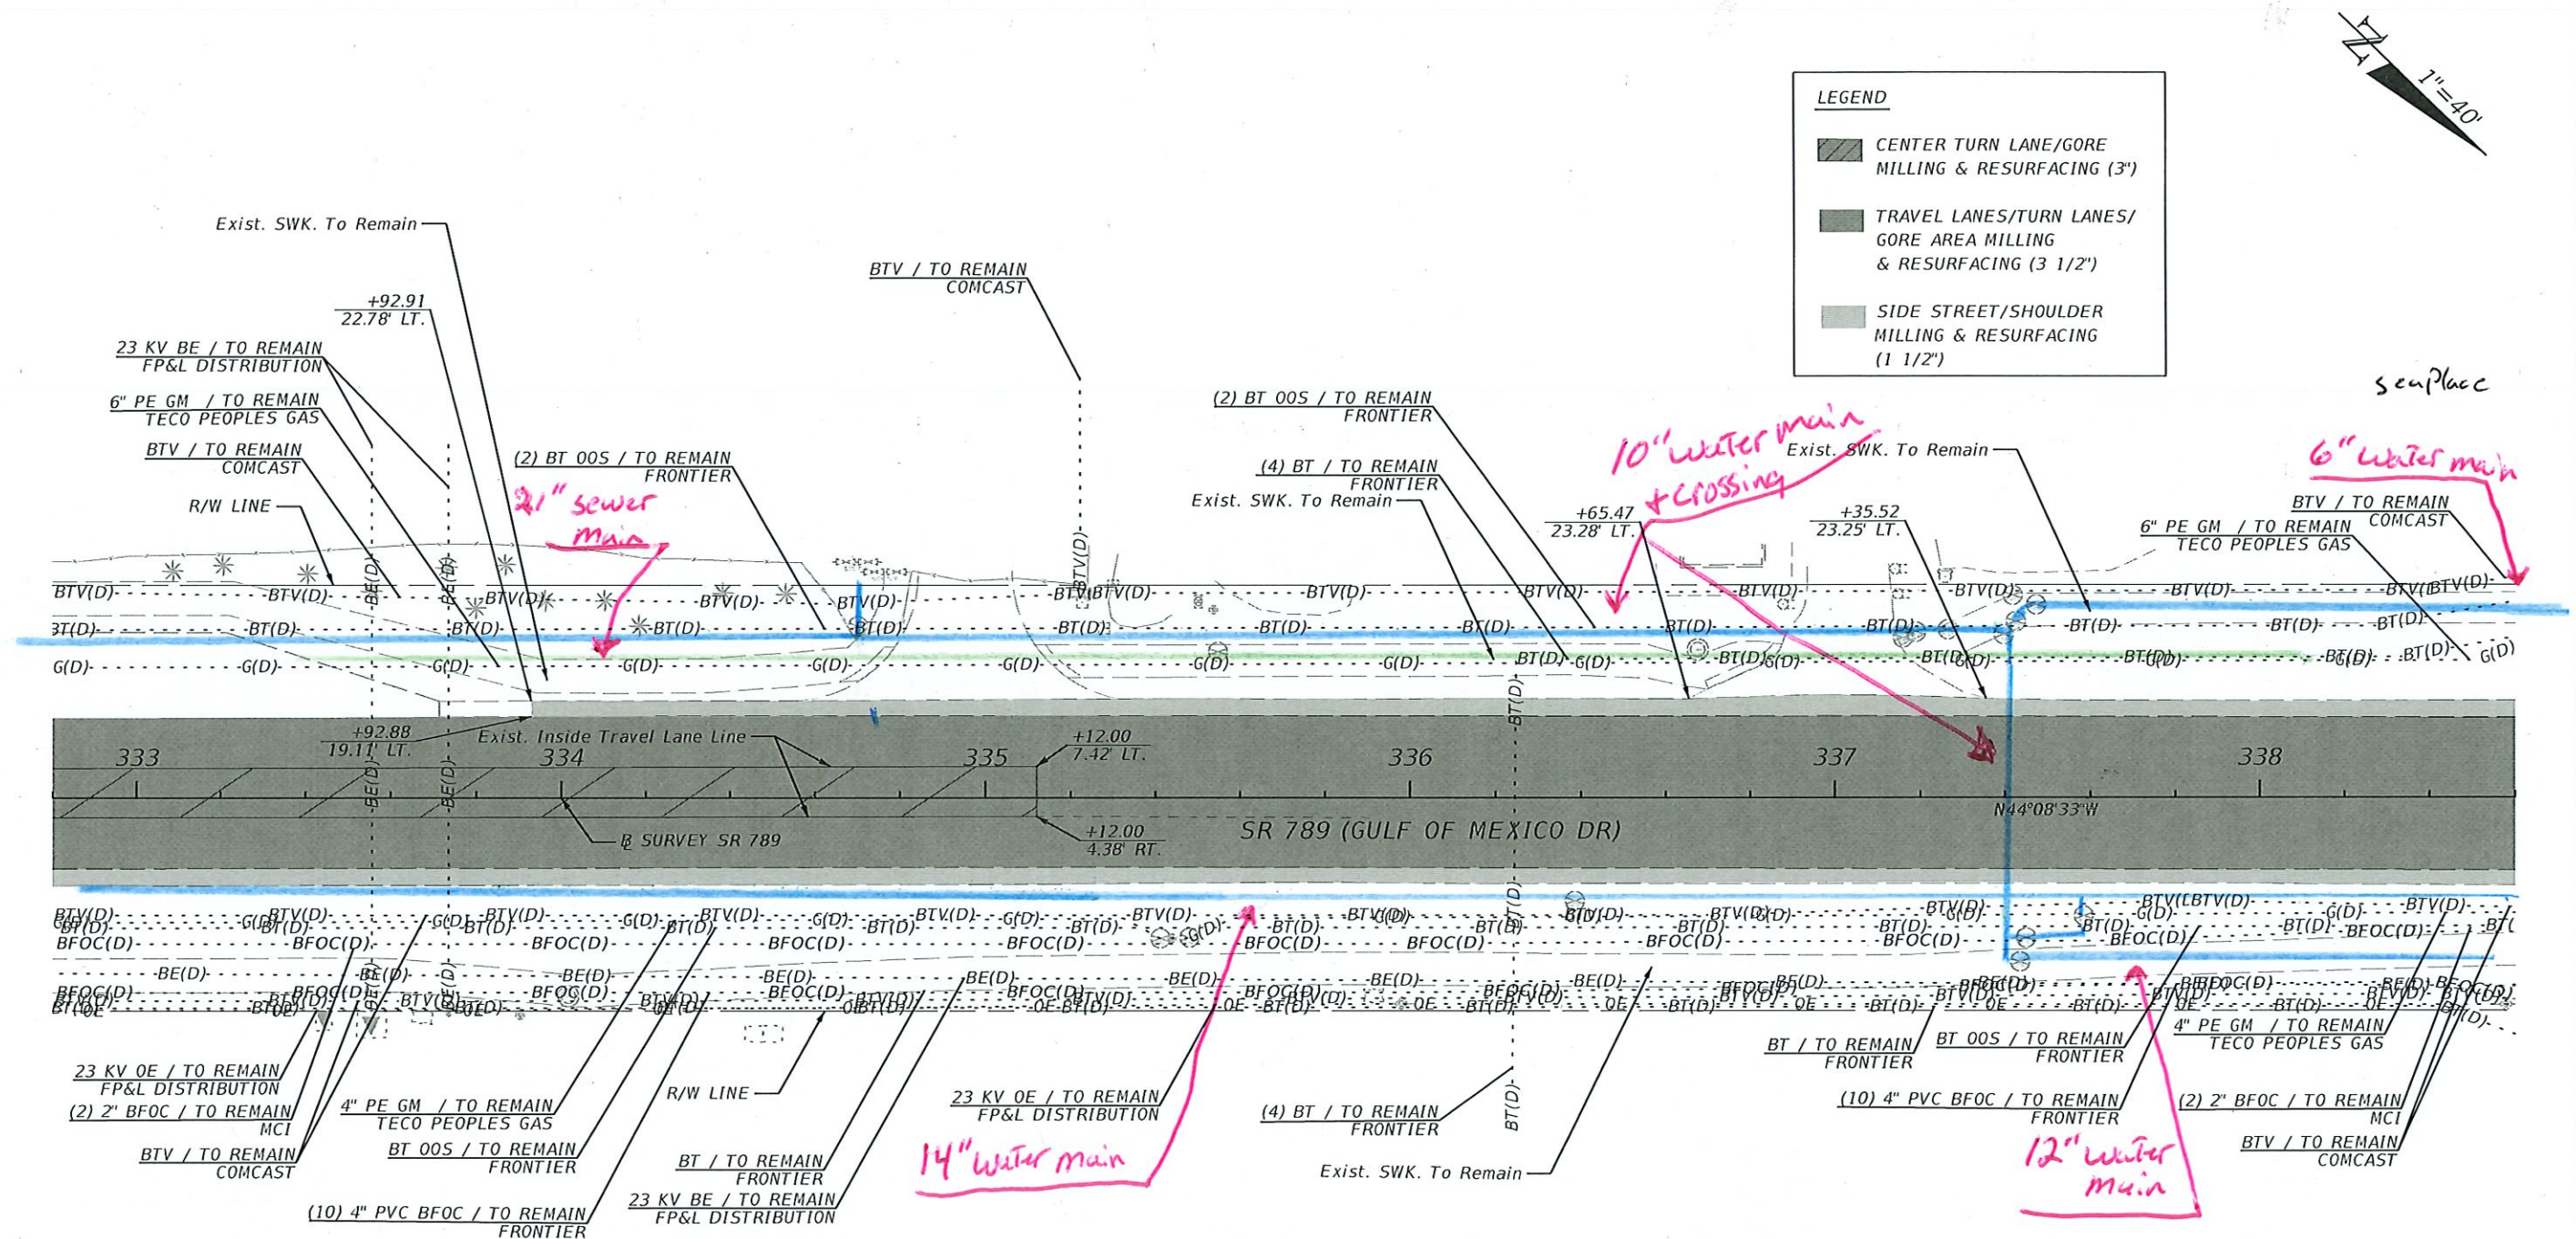


REVISIONS				ENGINEER OF RECORD	STATE OF FLORIDA DEPARTMENT OF TRANSPORTATION			ROADWAY PLAN (19)	SHEET NO.
DATE	DESCRIPTION	DATE	DESCRIPTION	MEGAN LERNER, P.E. LICENSE NUMBER: 72217 GARRETT ENGINEERING GROUP, INC. 120 10TH AVENUE NORTH SAINT PETERSBURG, FL 33701	ROAD NO.	COUNTY	FINANCIAL PROJECT ID		54
					SR 789	SARASOTA	451013-1-52-01		

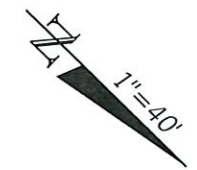

LEGEND

- CENTER TURN LANE/GORE
MILLING & RESURFACING (3")
- TRAVEL LANES/TURN LANES/
GORE AREA MILLING
& RESURFACING (3 1/2")
- SIDE STREET/SHOULDER
MILLING & RESURFACING
(1 1/2")

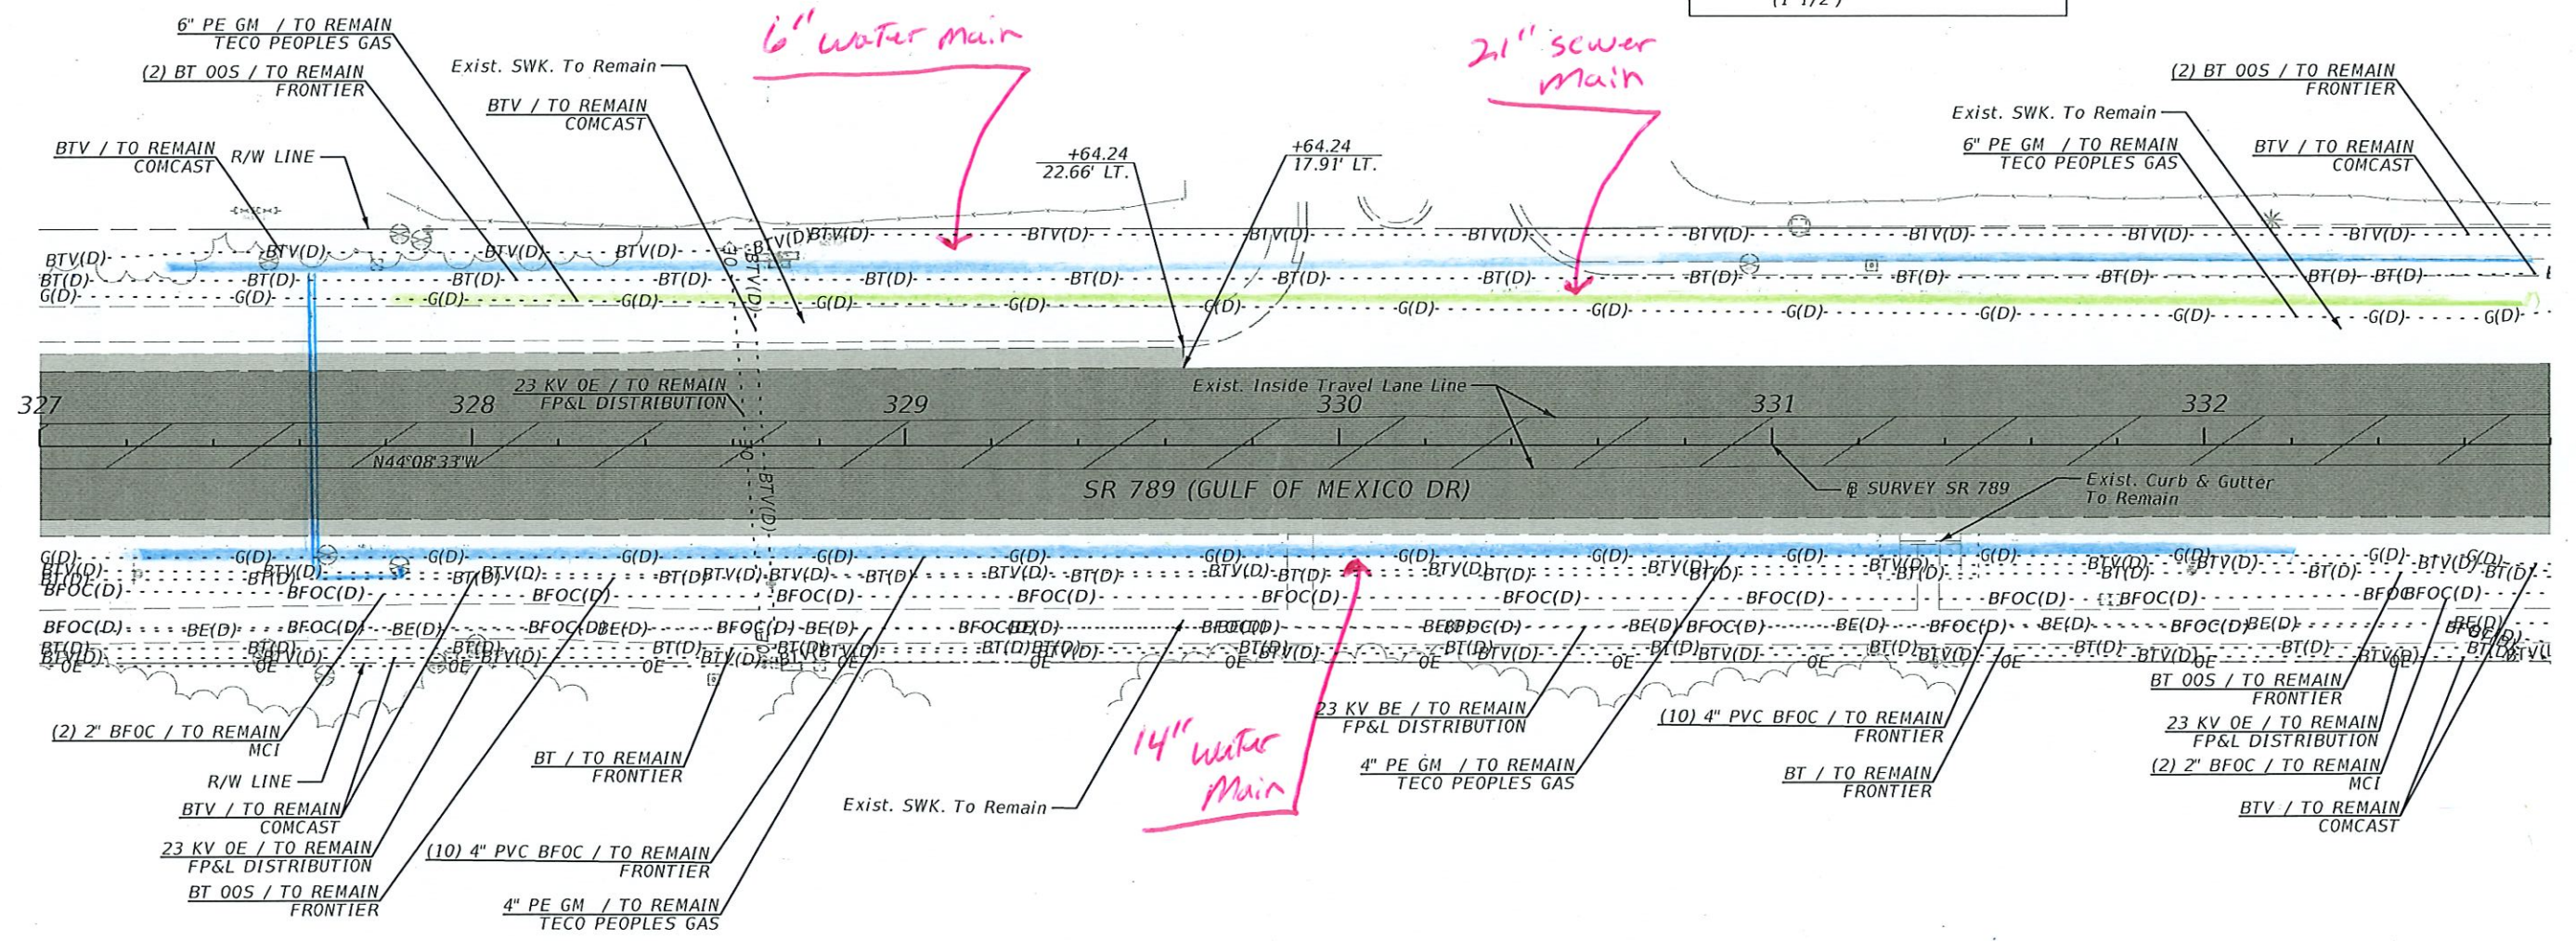


REVISIONS				ENGINEER OF RECORD		STATE OF FLORIDA DEPARTMENT OF TRANSPORTATION			ROADWAY PLAN (18)	SHEET NO. 53
DATE	DESCRIPTION	DATE	DESCRIPTION	MEGAN LERNER, P.E. LICENSE NUMBER: 72217 GARRETT ENGINEERING GROUP, INC. 120 10TH AVENUE NORTH SAINT PETERSBURG, FL 33701		ROAD NO.	COUNTY	FINANCIAL PROJECT ID		
						SR 789	SARASOTA	451013-1-52-01		

THE OFFICIAL RECORD OF THIS SHEET IS THE ELECTRONIC FILE DIGITALLY SIGNED AND SEALED UNDER RULE 61G15-23.004, F.A.C.




LEGEND

- CENTER TURN LANE/GORE
MILLING & RESURFACING (3")
- TRAVEL LANES/TURN LANES/
GORE AREA MILLING
& RESURFACING (3 1/2")
- SIDE STREET/SHOULDER
MILLING & RESURFACING
(1 1/2")

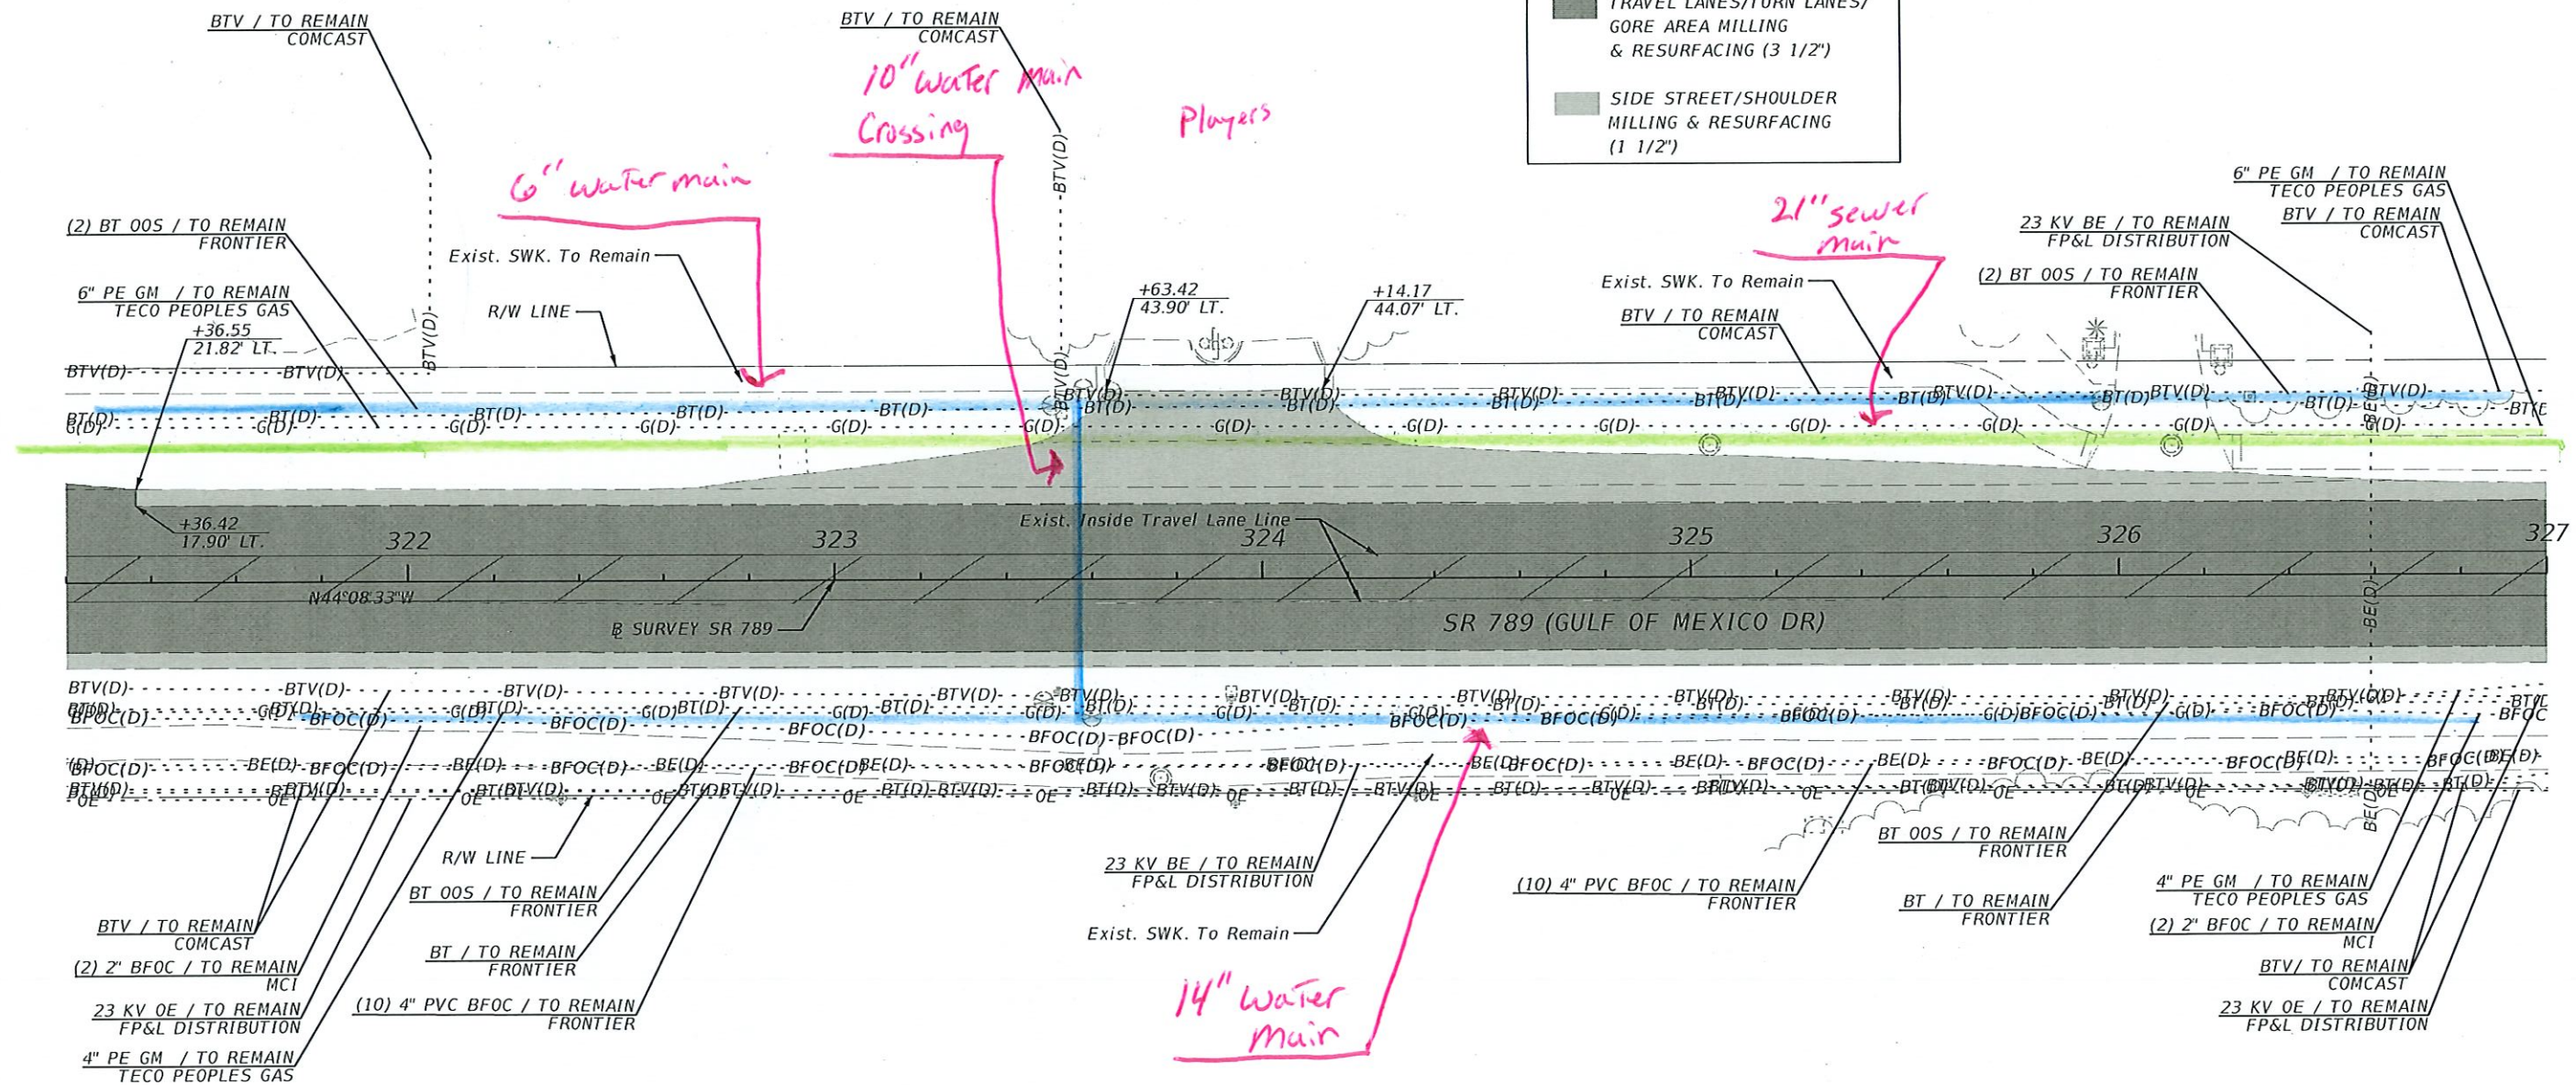


REVISIONS				ENGINEER OF RECORD	STATE OF FLORIDA DEPARTMENT OF TRANSPORTATION			ROADWAY PLAN (17)	SHEET NO. 52
DATE	DESCRIPTION	DATE	DESCRIPTION		ROAD NO.	COUNTY	FINANCIAL PROJECT ID		
				MEGAN LERNER, P.E. LICENSE NUMBER: 72217 GARRETT ENGINEERING GROUP, INC. 120 10TH AVENUE NORTH SAINT PETERSBURG, FL 33701	SR 789	SARASOTA	451013-1-52-01		

THE OFFICIAL RECORD OF THIS SHEET IS THE ELECTRONIC FILE DIGITALLY SIGNED AND SEALED UNDER RULE 61G15-23.004, F.A.C.

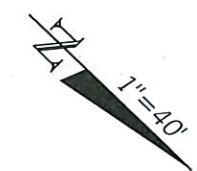

LEGEND


- CENTER TURN LANE/GORE
MILLING & RESURFACING (3")
- TRAVEL LANES/TURN LANES/
GORE AREA MILLING
& RESURFACING (3 1/2")
- SIDE STREET/SHOULDER
MILLING & RESURFACING
(1 1/2")

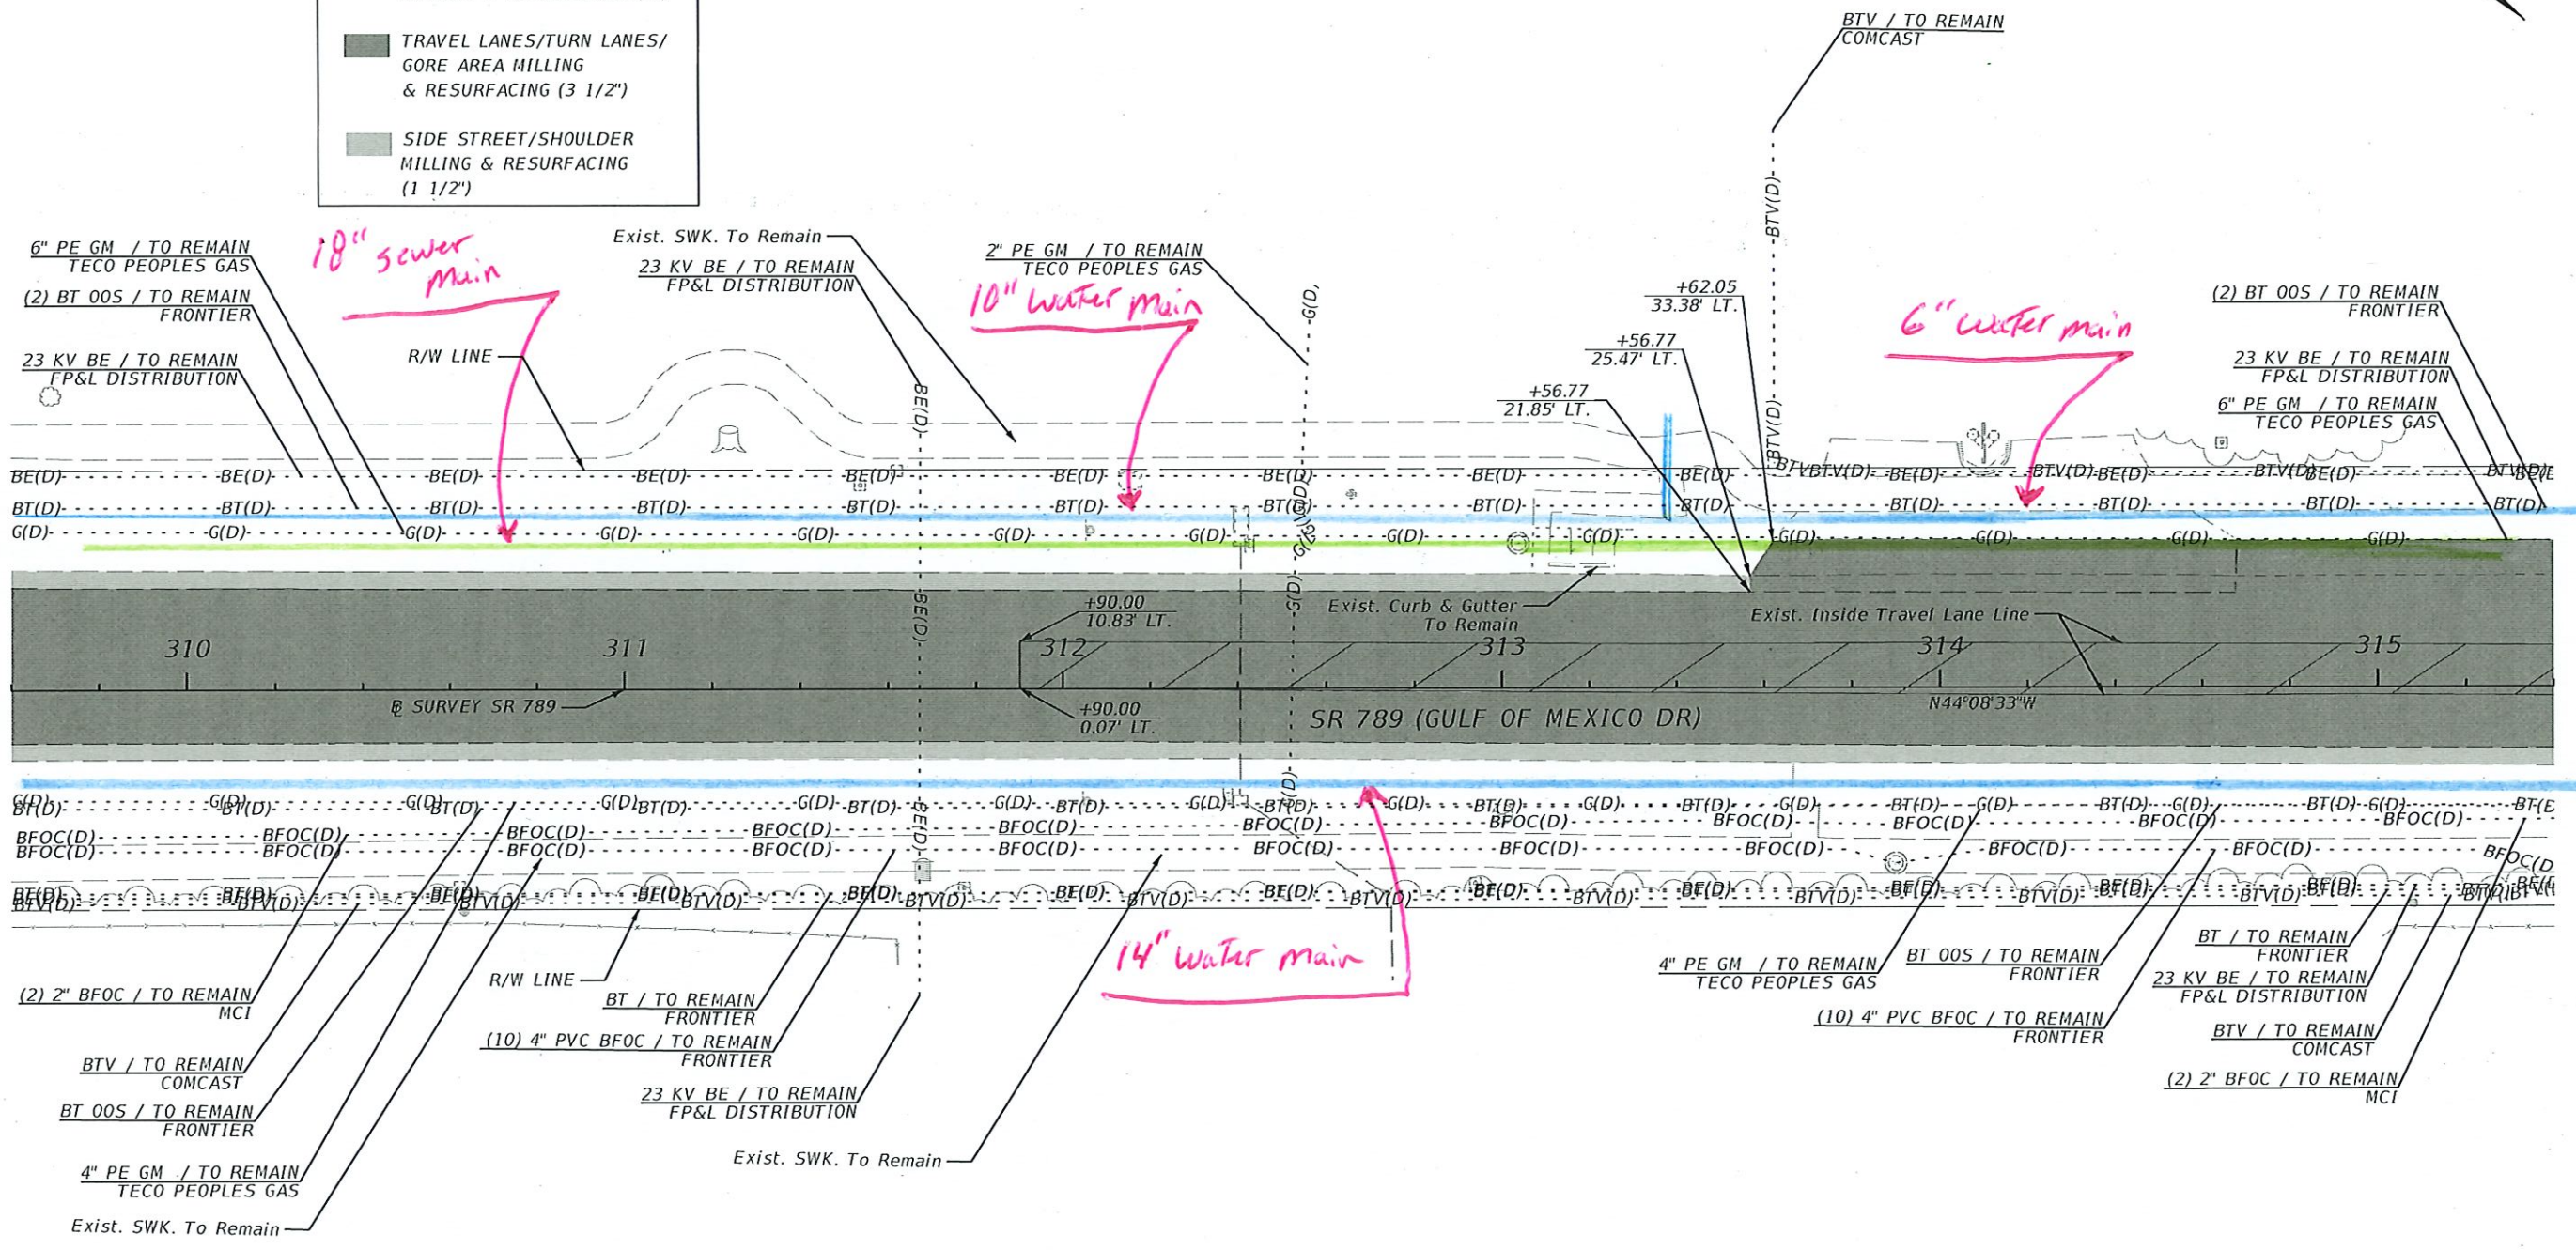


REVISIONS				ENGINEER OF RECORD	STATE OF FLORIDA DEPARTMENT OF TRANSPORTATION			ROADWAY PLAN (15)	SHEET NO. 50
DATE	DESCRIPTION	DATE	DESCRIPTION		ROAD NO.	COUNTY	FINANCIAL PROJECT ID		
					SR 789	SARASOTA	451013-1-52-01		

MEGAN LERNER, P.E.
LICENSE NUMBER: 72217
GARRETT ENGINEERING GROUP, INC.
120 10TH AVENUE NORTH
SAINT PETERSBURG, FL 33701

THE OFFICIAL RECORD OF THIS SHEET IS THE ELECTRONIC FILE DIGITALLY SIGNED AND SEALED UNDER RULE 61G15-23.004, F.A.C.

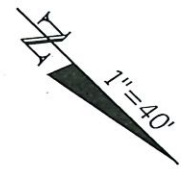


LEGEND	
	TRAVEL LANES/TURN LANES/ GORE AREA MILLING & RESURFACING (3 1/2")
	SIDE STREET/SHOULDER MILLING & RESURFACING (1 1/2")

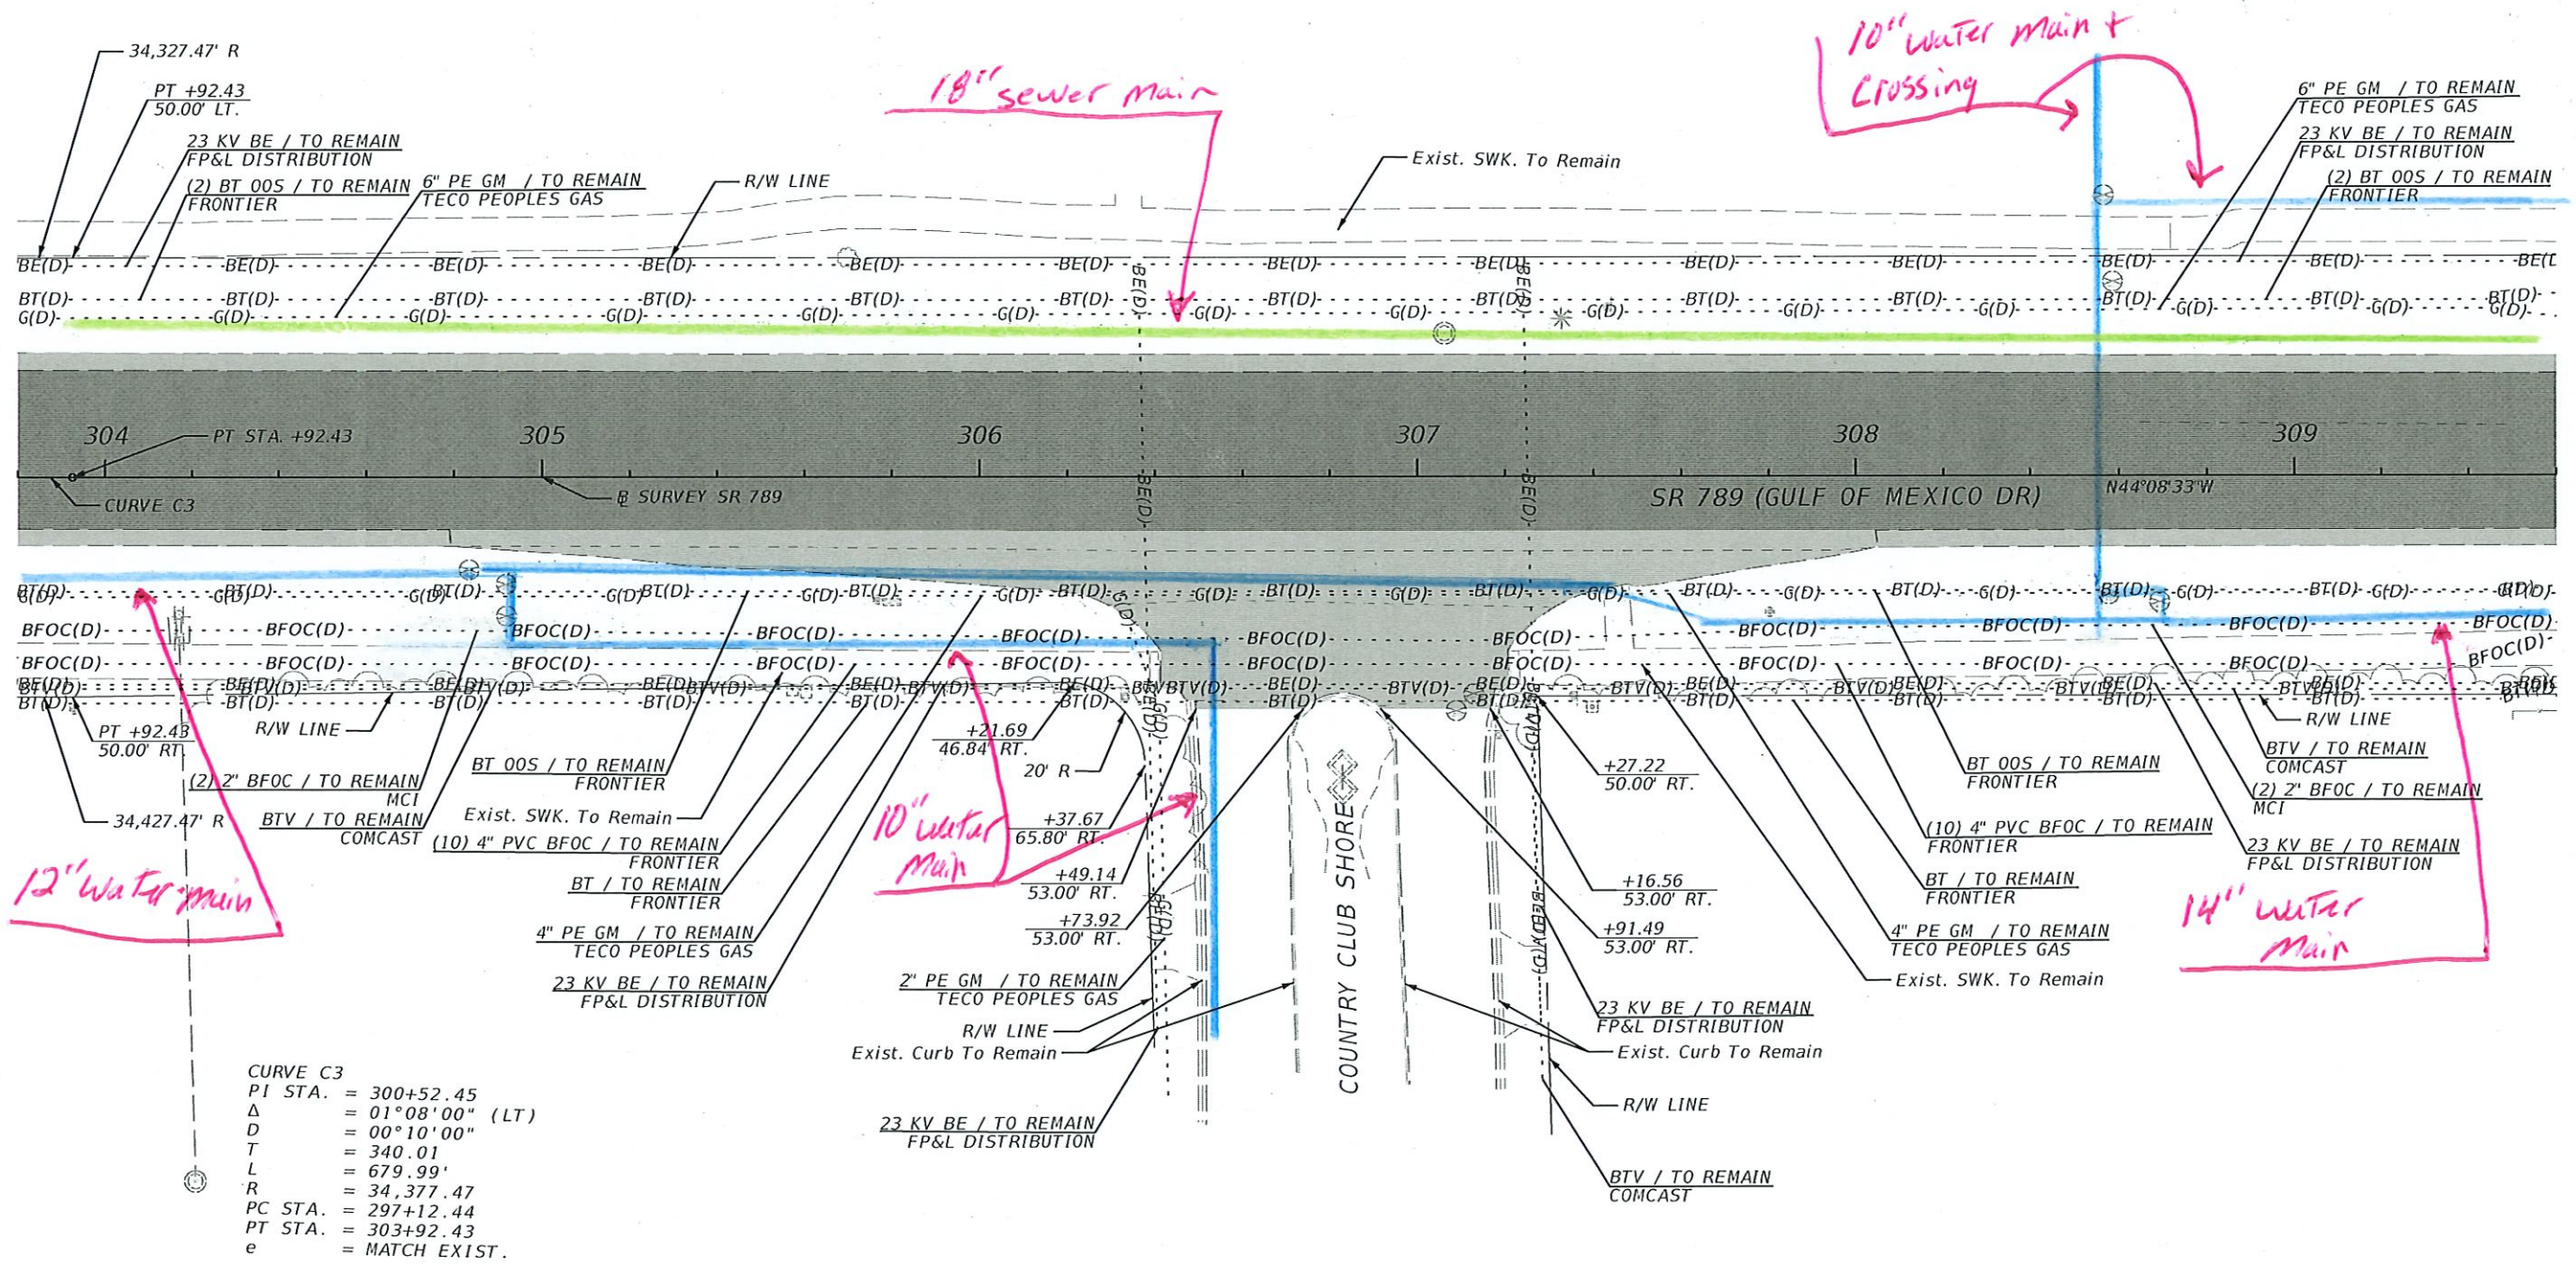

CURVE C3
PI STA. = 300+52.45
Δ = 01°08'00" (LT)
D = 00°10'00"
T = 340.01
L = 679.99'
R = 34,377.47
PC STA. = 297+12.44
PT STA. = 303+92.43
e = MATCH EXIST.


REVISIONS				ENGINEER OF RECORD			STATE OF FLORIDA DEPARTMENT OF TRANSPORTATION			ROADWAY PLAN (14)	SHEET NO. 49
DATE	DESCRIPTION	DATE	DESCRIPTION	MEGAN LERNER, P.E. LICENSE NUMBER: 72217 GARRETT ENGINEERING GROUP, INC. 120 10TH AVENUE NORTH SAINT PETERSBURG, FL 33701			ROAD NO.	COUNTY	FINANCIAL PROJECT ID		
							SR 789	SARASOTA	451013-1-52-01		

THE OFFICIAL RECORD OF THIS SHEET IS THE ELECTRONIC FILE DIGITALLY SIGNED AND SEALED UNDER RULE 61G15-23.004, F.A.C.

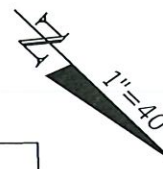

LEGEND


- TRAVEL LANES/TURN LANES/
GORE AREA MILLING
& RESURFACING (3 1/2")
- SIDE STREET/SHOULDER
MILLING & RESURFACING
(1 1/2")

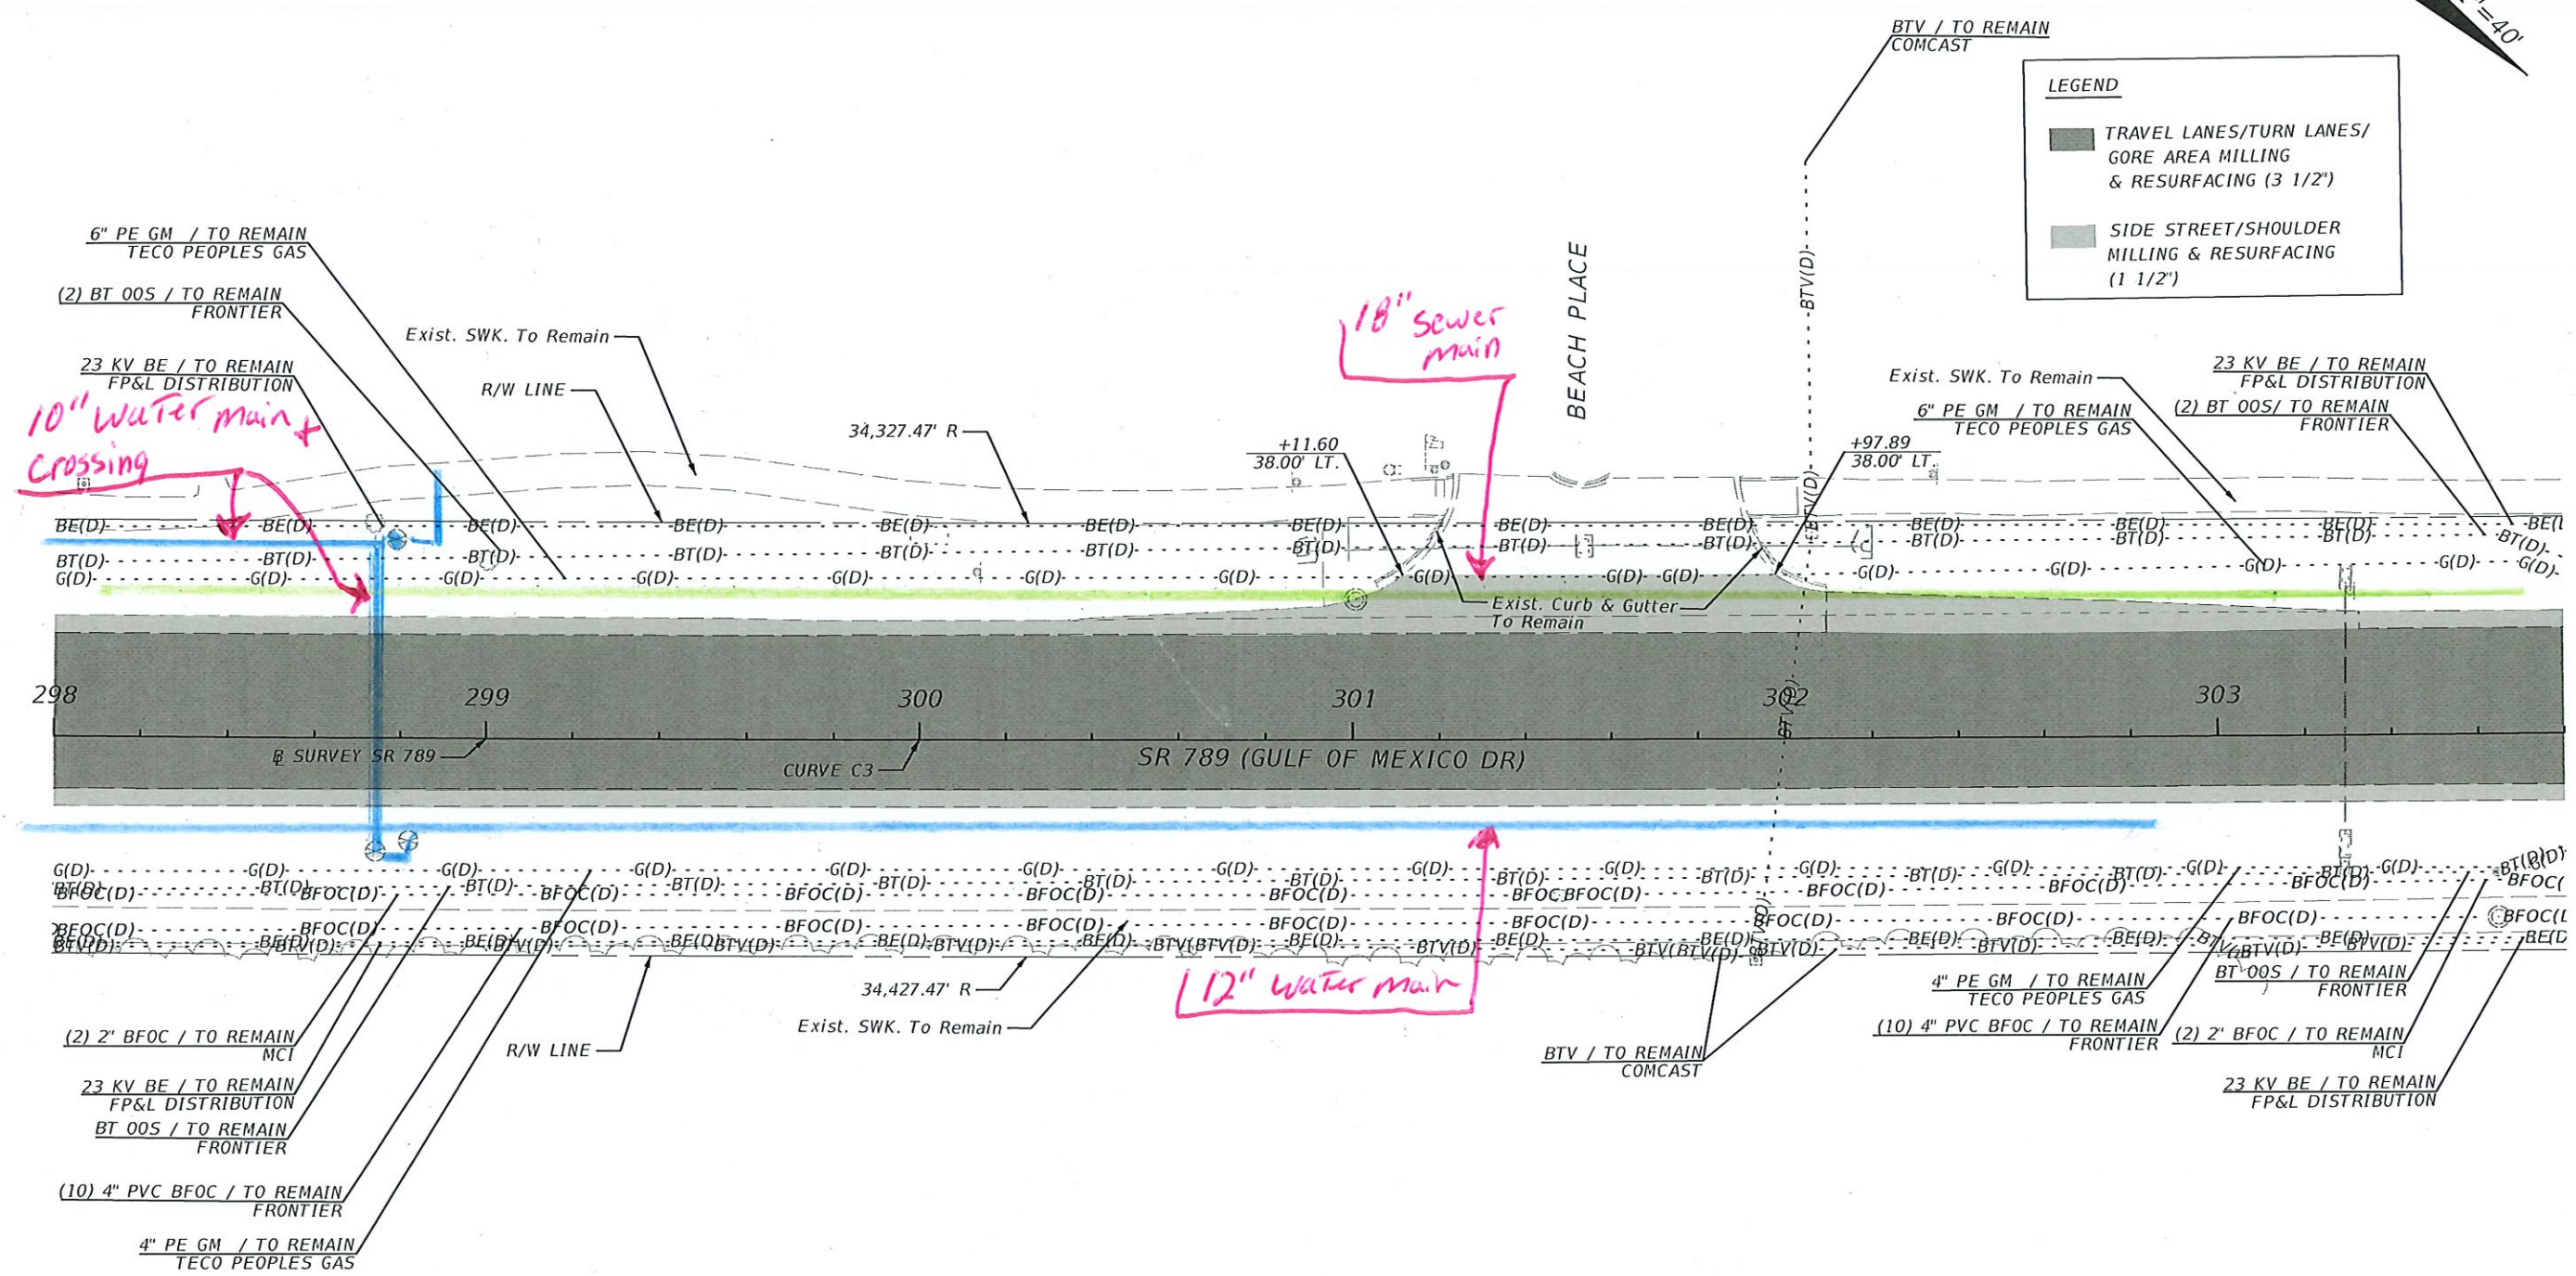

CURVE C3
PI STA. = 300+52.45
 Δ = 01°08'00" (LT)
D = 00°10'00"
T = 340.01
L = 679.99'
R = 34,377.47
PC STA. = 297+12.44
PT STA. = 303+92.43
e = MATCH EXIST.


REVISIONS				ENGINEER OF RECORD			STATE OF FLORIDA DEPARTMENT OF TRANSPORTATION			ROADWAY PLAN (13)	SHEET NO. 48
DATE	DESCRIPTION	DATE	DESCRIPTION	MEGAN LERNER, P.E. LICENSE NUMBER: 72217 GARRETT ENGINEERING GROUP, INC. 120 10TH AVENUE NORTH SAINT PETERSBURG, FL 33701			ROAD NO.	COUNTY	FINANCIAL PROJECT ID		
							SR 789	SARASOTA	451013-1-52-01		

THE OFFICIAL RECORD OF THIS SHEET IS THE ELECTRONIC FILE DIGITALLY SIGNED AND SEALED UNDER RULE 61G15-23.004, F.A.C.

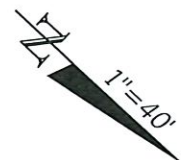

LEGEND


- TRAVEL LANES/TURN LANES/
GORE AREA MILLING
& RESURFACING (3 1/2")
- SIDE STREET/SHOULDER
MILLING & RESURFACING
(1 1/2")

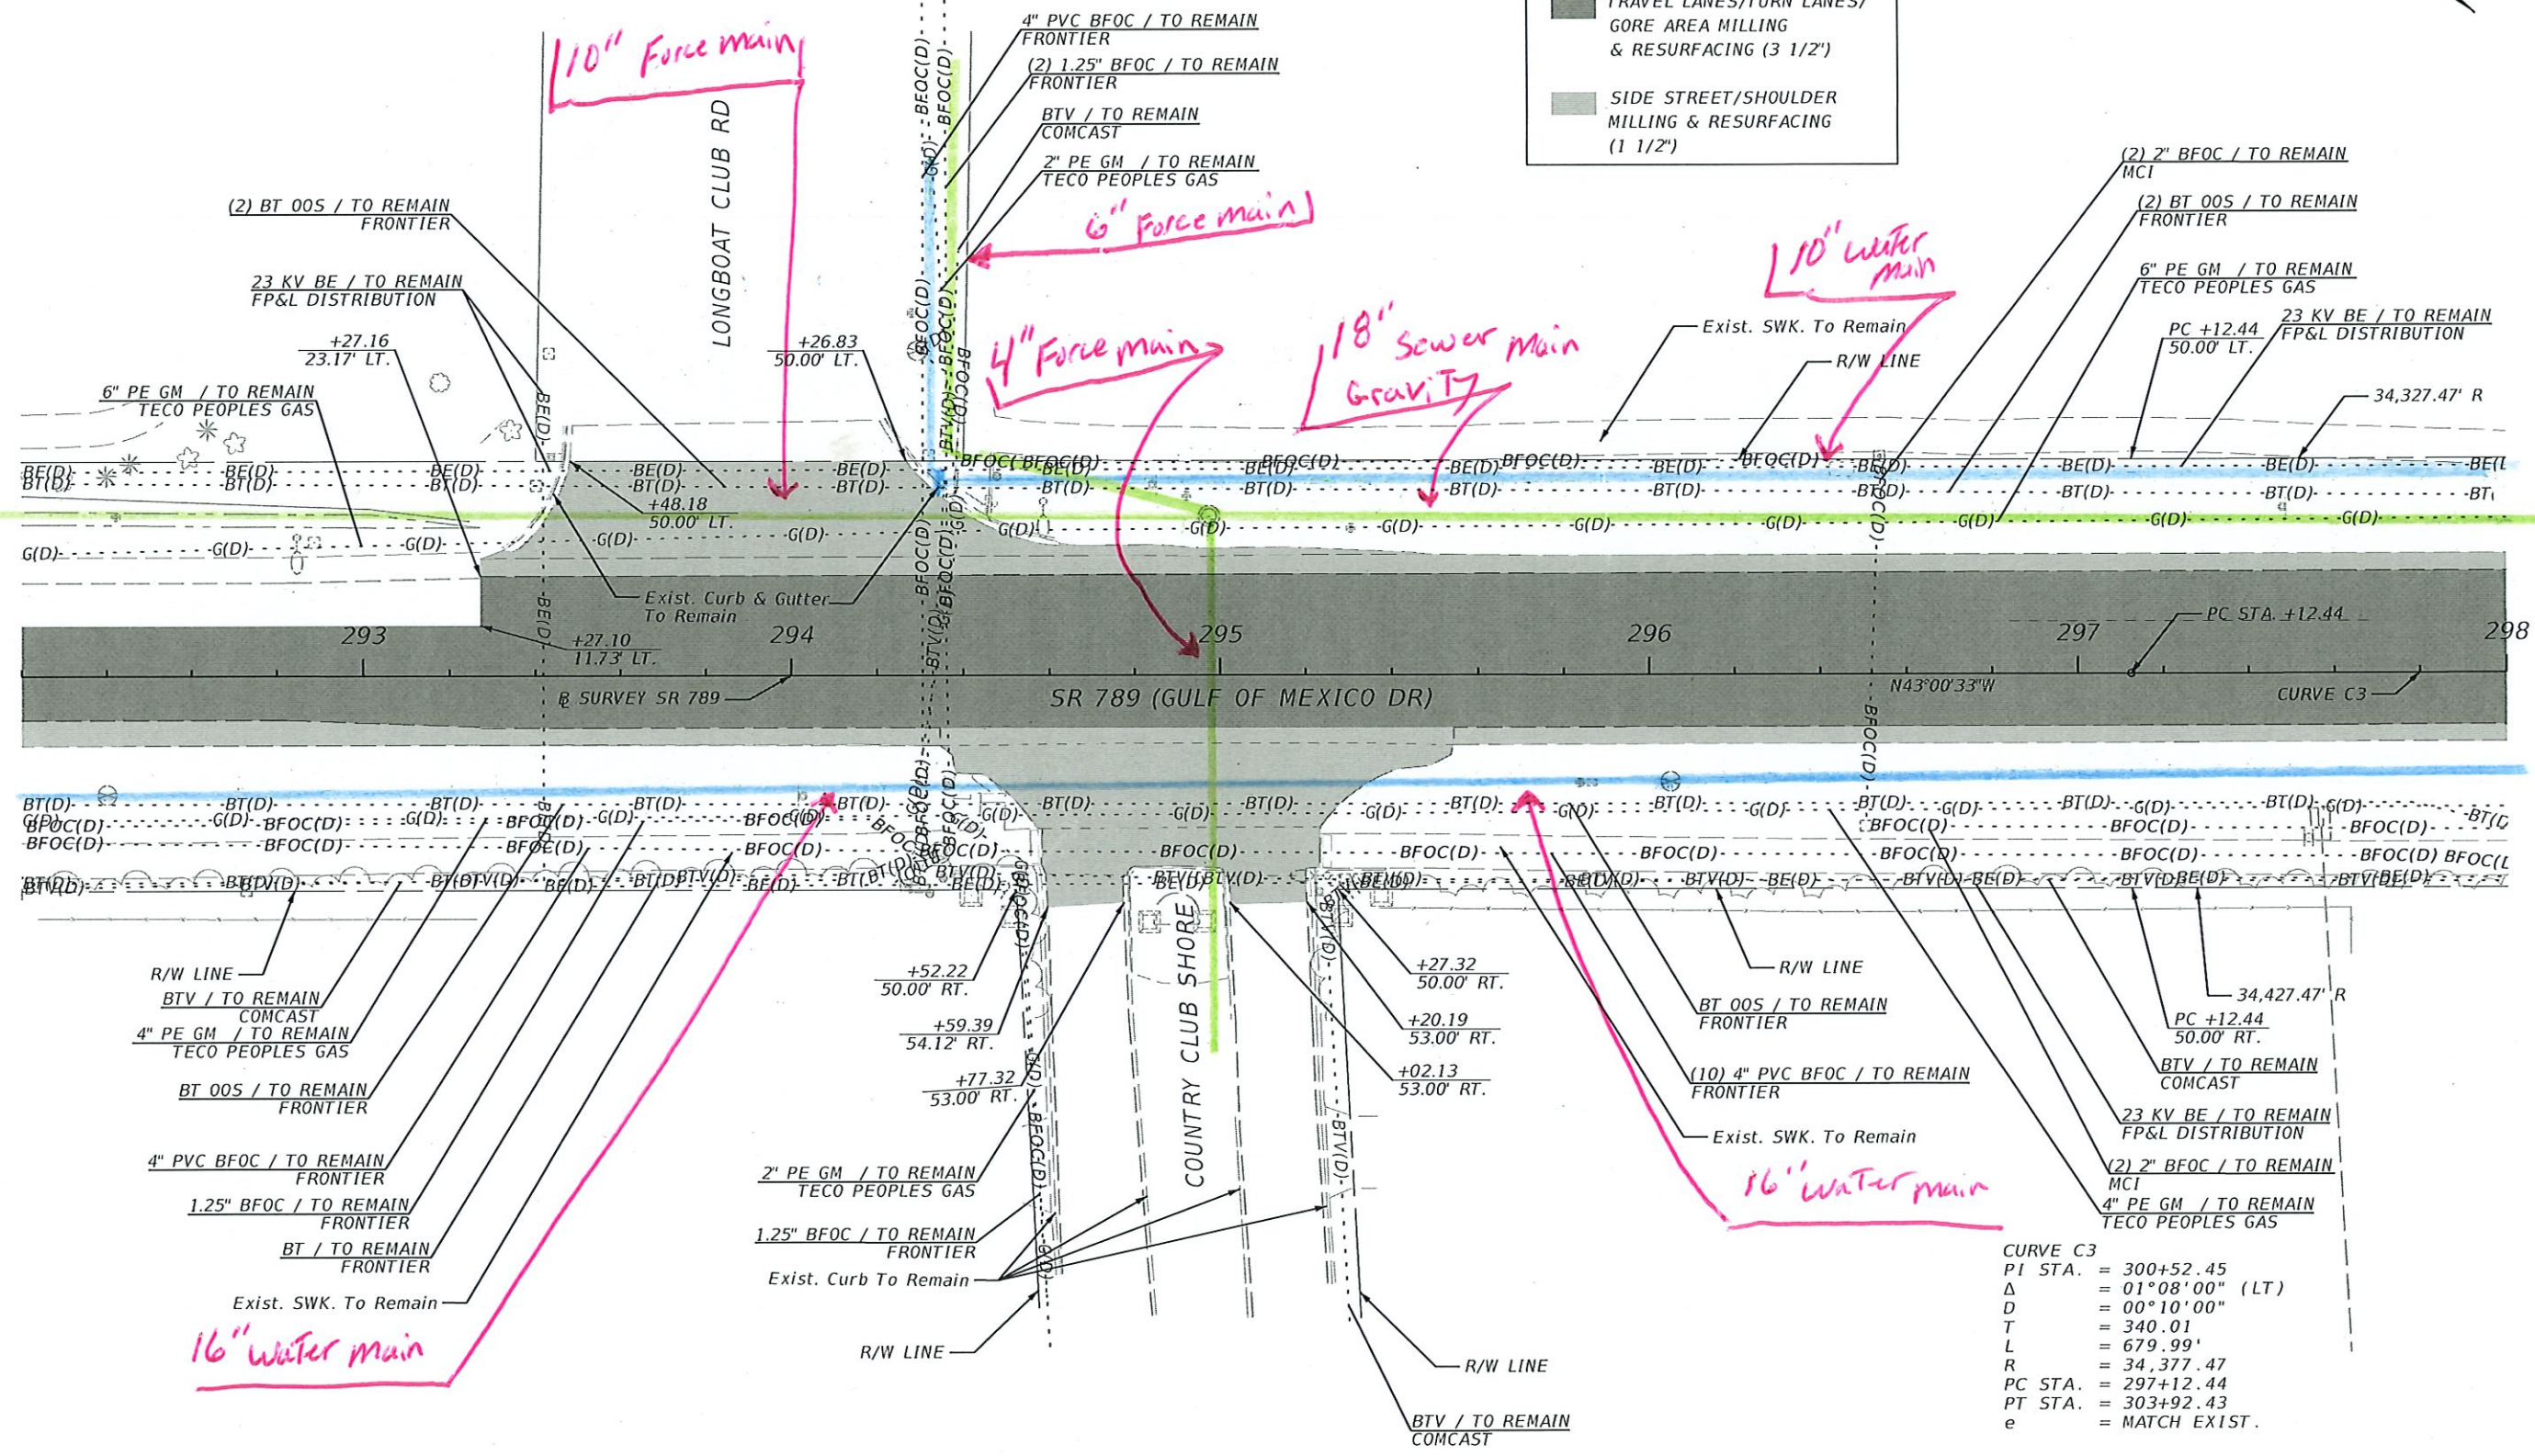

CURVE C3
PI STA. = 300+52.45
Δ = 01°08'00" (LT)
D = 00°10'00"
T = 340.01
L = 679.99'
R = 34,377.47
PC STA. = 297+12.44
PT STA. = 303+92.43
e = MATCH EXIST.

REVISIONS				ENGINEER OF RECORD			STATE OF FLORIDA DEPARTMENT OF TRANSPORTATION			ROADWAY PLAN (12)	SHEET NO. 47
DATE	DESCRIPTION	DATE	DESCRIPTION	MEGAN LERNER, P.E. LICENSE NUMBER: 72217 GARRETT ENGINEERING GROUP, INC. 120 10TH AVENUE NORTH SAINT PETERSBURG, FL 33701			ROAD NO.	COUNTY	FINANCIAL PROJECT ID		
							SR 789	SARASOTA	451013-1-52-01		

THE OFFICIAL RECORD OF THIS SHEET IS THE ELECTRONIC FILE DIGITALLY SIGNED AND SEALED UNDER RULE 61G15-23.004, F.A.C.

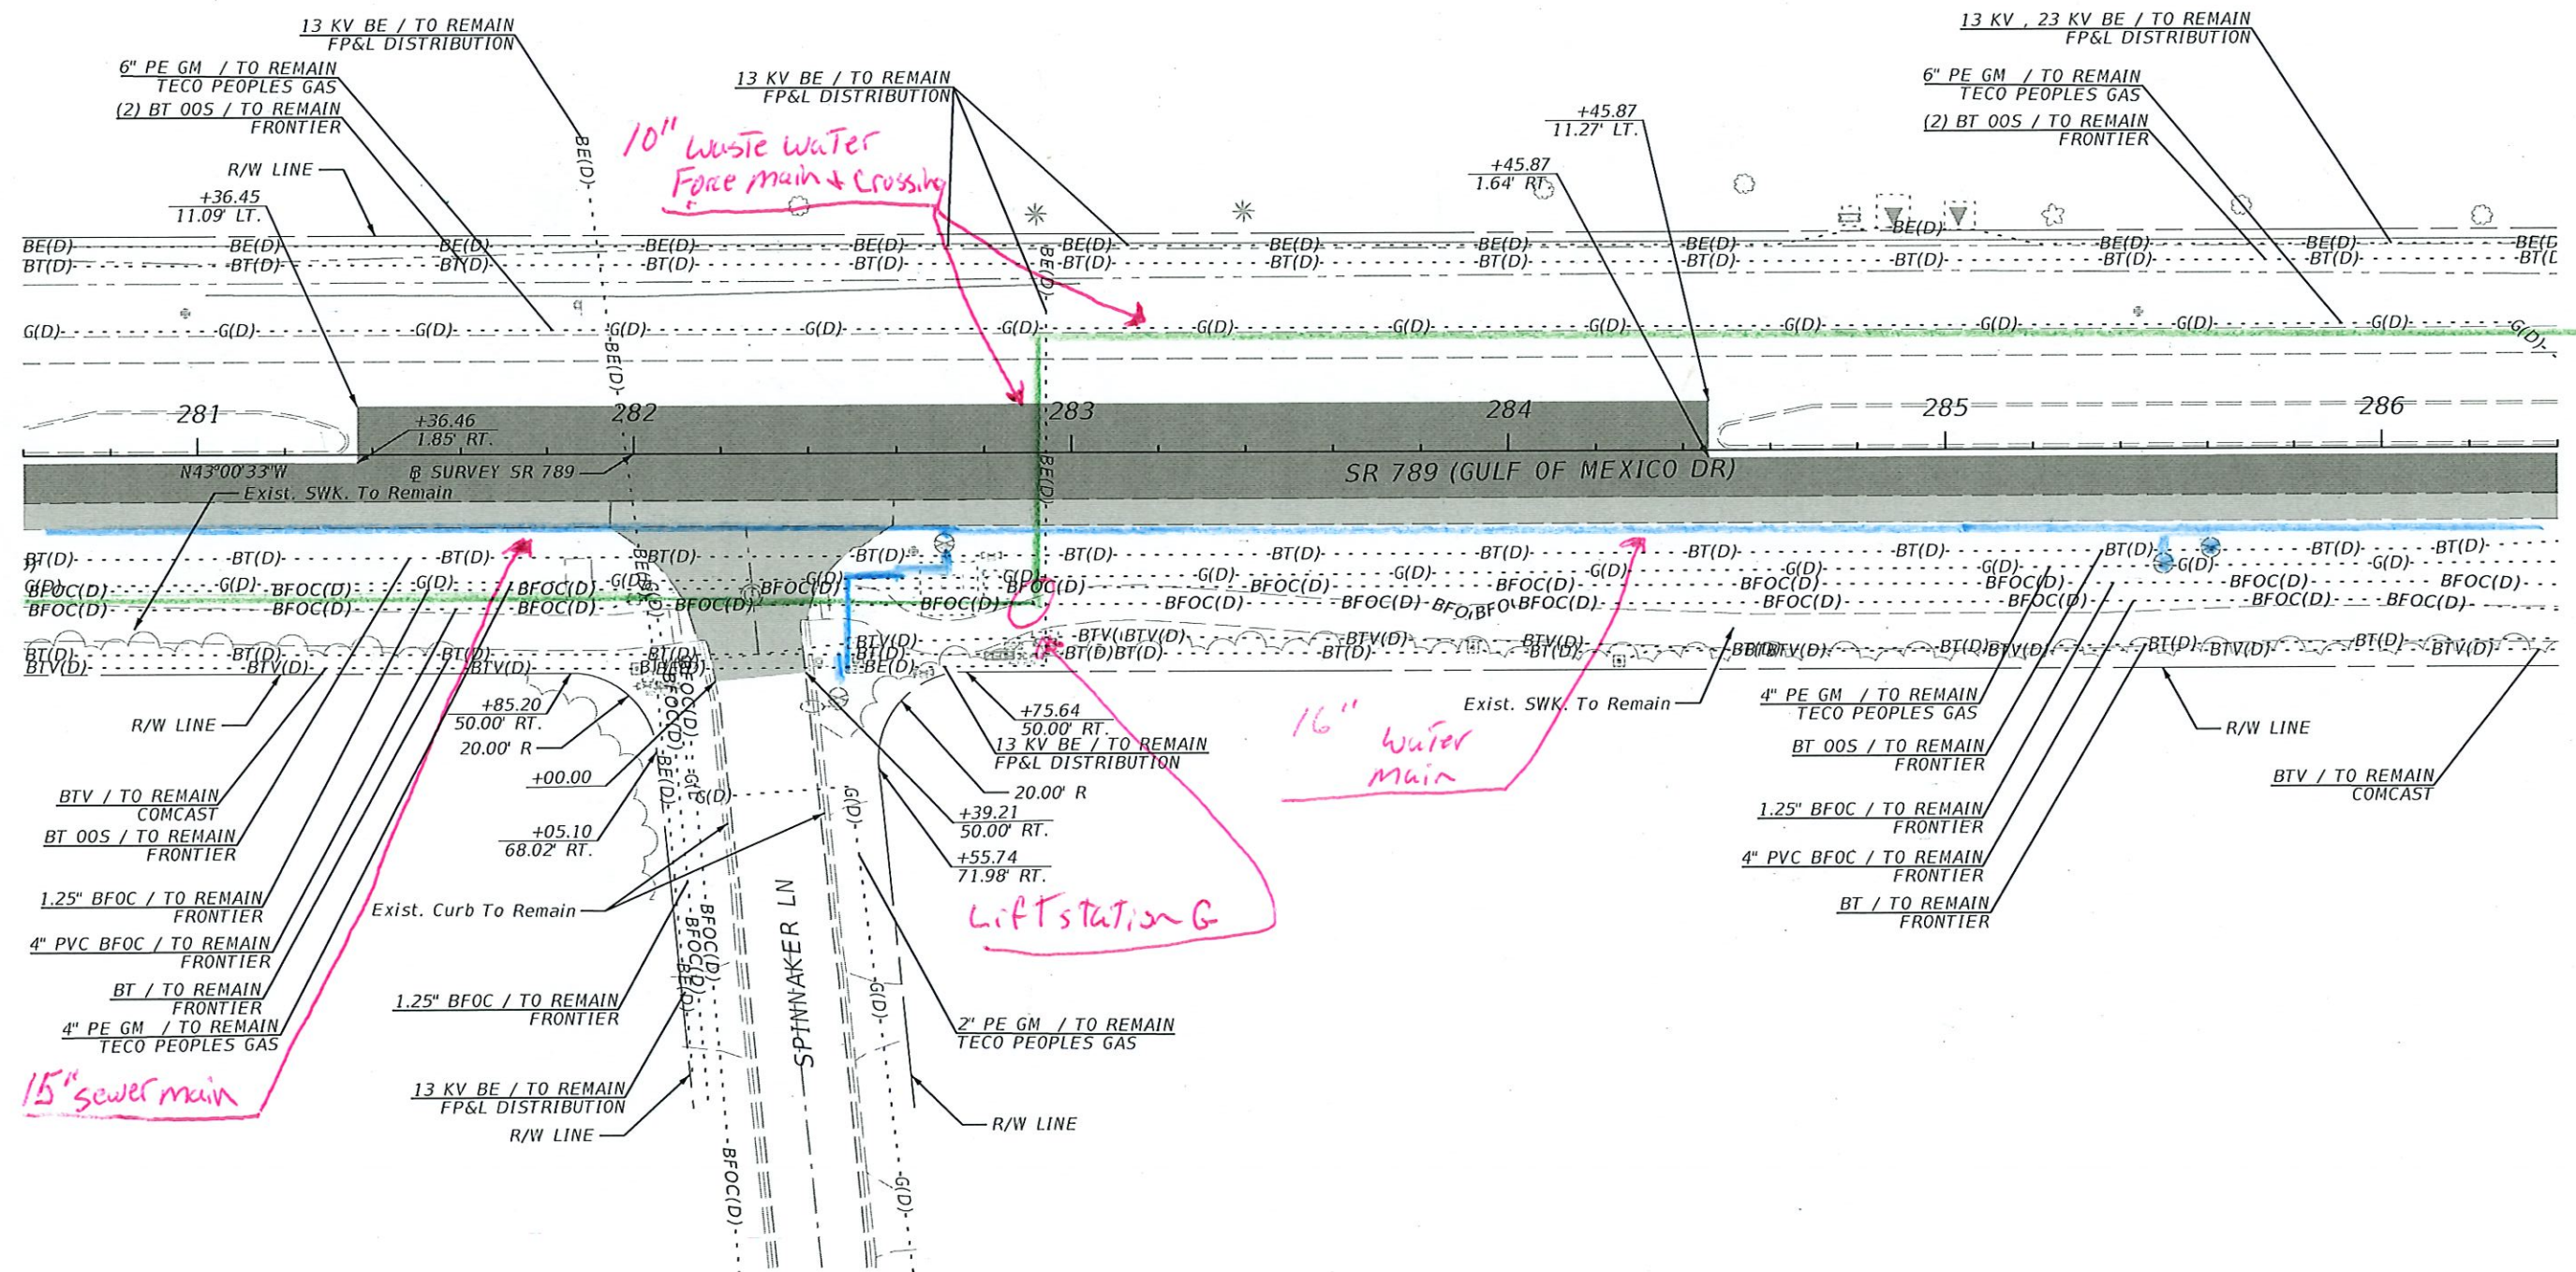


REVISIONS				ENGINEER OF RECORD	STATE OF FLORIDA DEPARTMENT OF TRANSPORTATION			ROADWAY PLAN (10)	SHEET NO.
DATE	DESCRIPTION	DATE	DESCRIPTION	MEGAN LERNER, P.E. LICENSE NUMBER: 72217 GARRETT ENGINEERING GROUP, INC. 120 10TH AVENUE NORTH SAINT PETERSBURG, FL 33701	ROAD NO.	COUNTY	FINANCIAL PROJECT ID		45
					SR 789	SARASOTA	451013-1-52-01		



LEGEND

- TRAVEL LANES/TURN LANES/
GORE AREA MILLING
& RESURFACING (3 1/2")
- SIDE STREET/SHOULDER
MILLING & RESURFACING
(1 1/2")

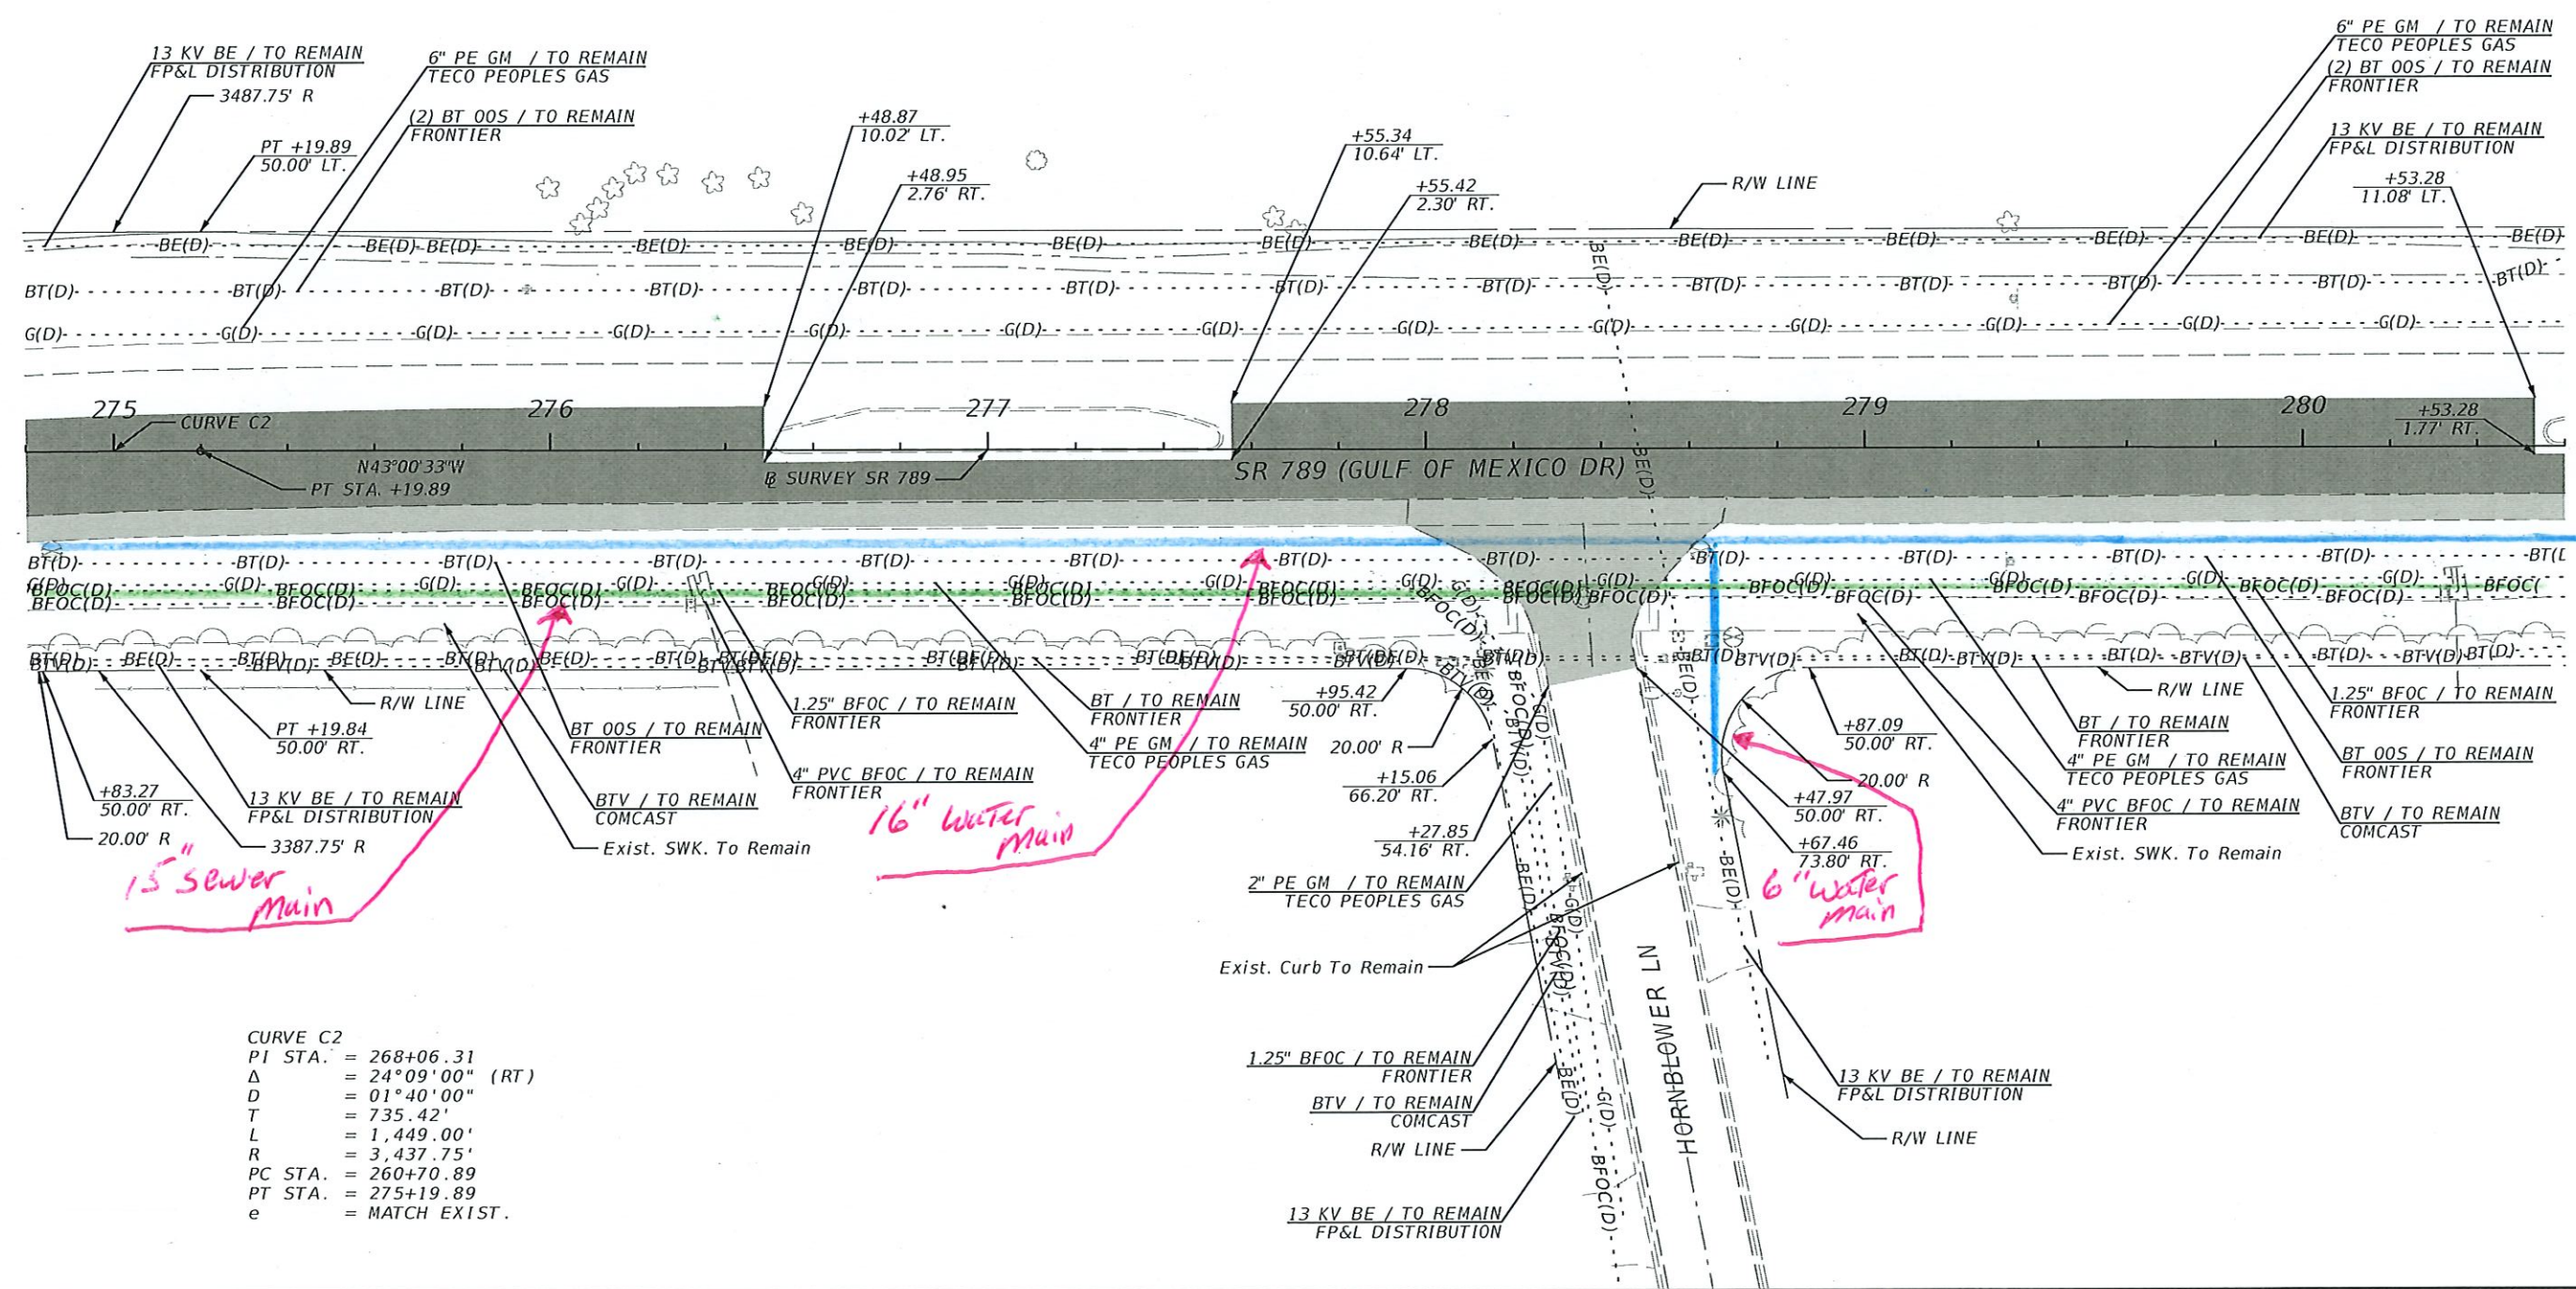

CURVE C2
PI STA. = 268+06.31
Δ = 24°09'00" (RT)
D = 01°40'00"
T = 735.42'
L = 1,449.00'
R = 3,437.75'
PC STA. = 260+70.89
PT STA. = 275+19.89
e = MATCH EXIST.

REVISIONS				ENGINEER OF RECORD	STATE OF FLORIDA DEPARTMENT OF TRANSPORTATION			SHEET NO. 44
DATE	DESCRIPTION	DATE	DESCRIPTION		ROAD NO.	COUNTY	FINANCIAL PROJECT ID	
					SR 789	SARASOTA	451013-1-52-01	

MEGAN LERNER, P.E
LICENSE NUMBER: 72217
GARRETT ENGINEERING GROUP, INC.
120 10TH AVENUE NORTH
SAINT PETERSBURG, FL 33701


ROADWAY PLAN (9)

THE OFFICIAL RECORD OF THIS SHEET IS THE ELECTRONIC FILE DIGITALLY SIGNED AND SEALED UNDER RULE 61G15-23.004, F.A.C.



LEGEND

- TRAVEL LANES/TURN LANES/
GORE AREA MILLING
& RESURFACING (3 1/2")
- SIDE STREET/SHOULDER
MILLING & RESURFACING
(1 1/2")

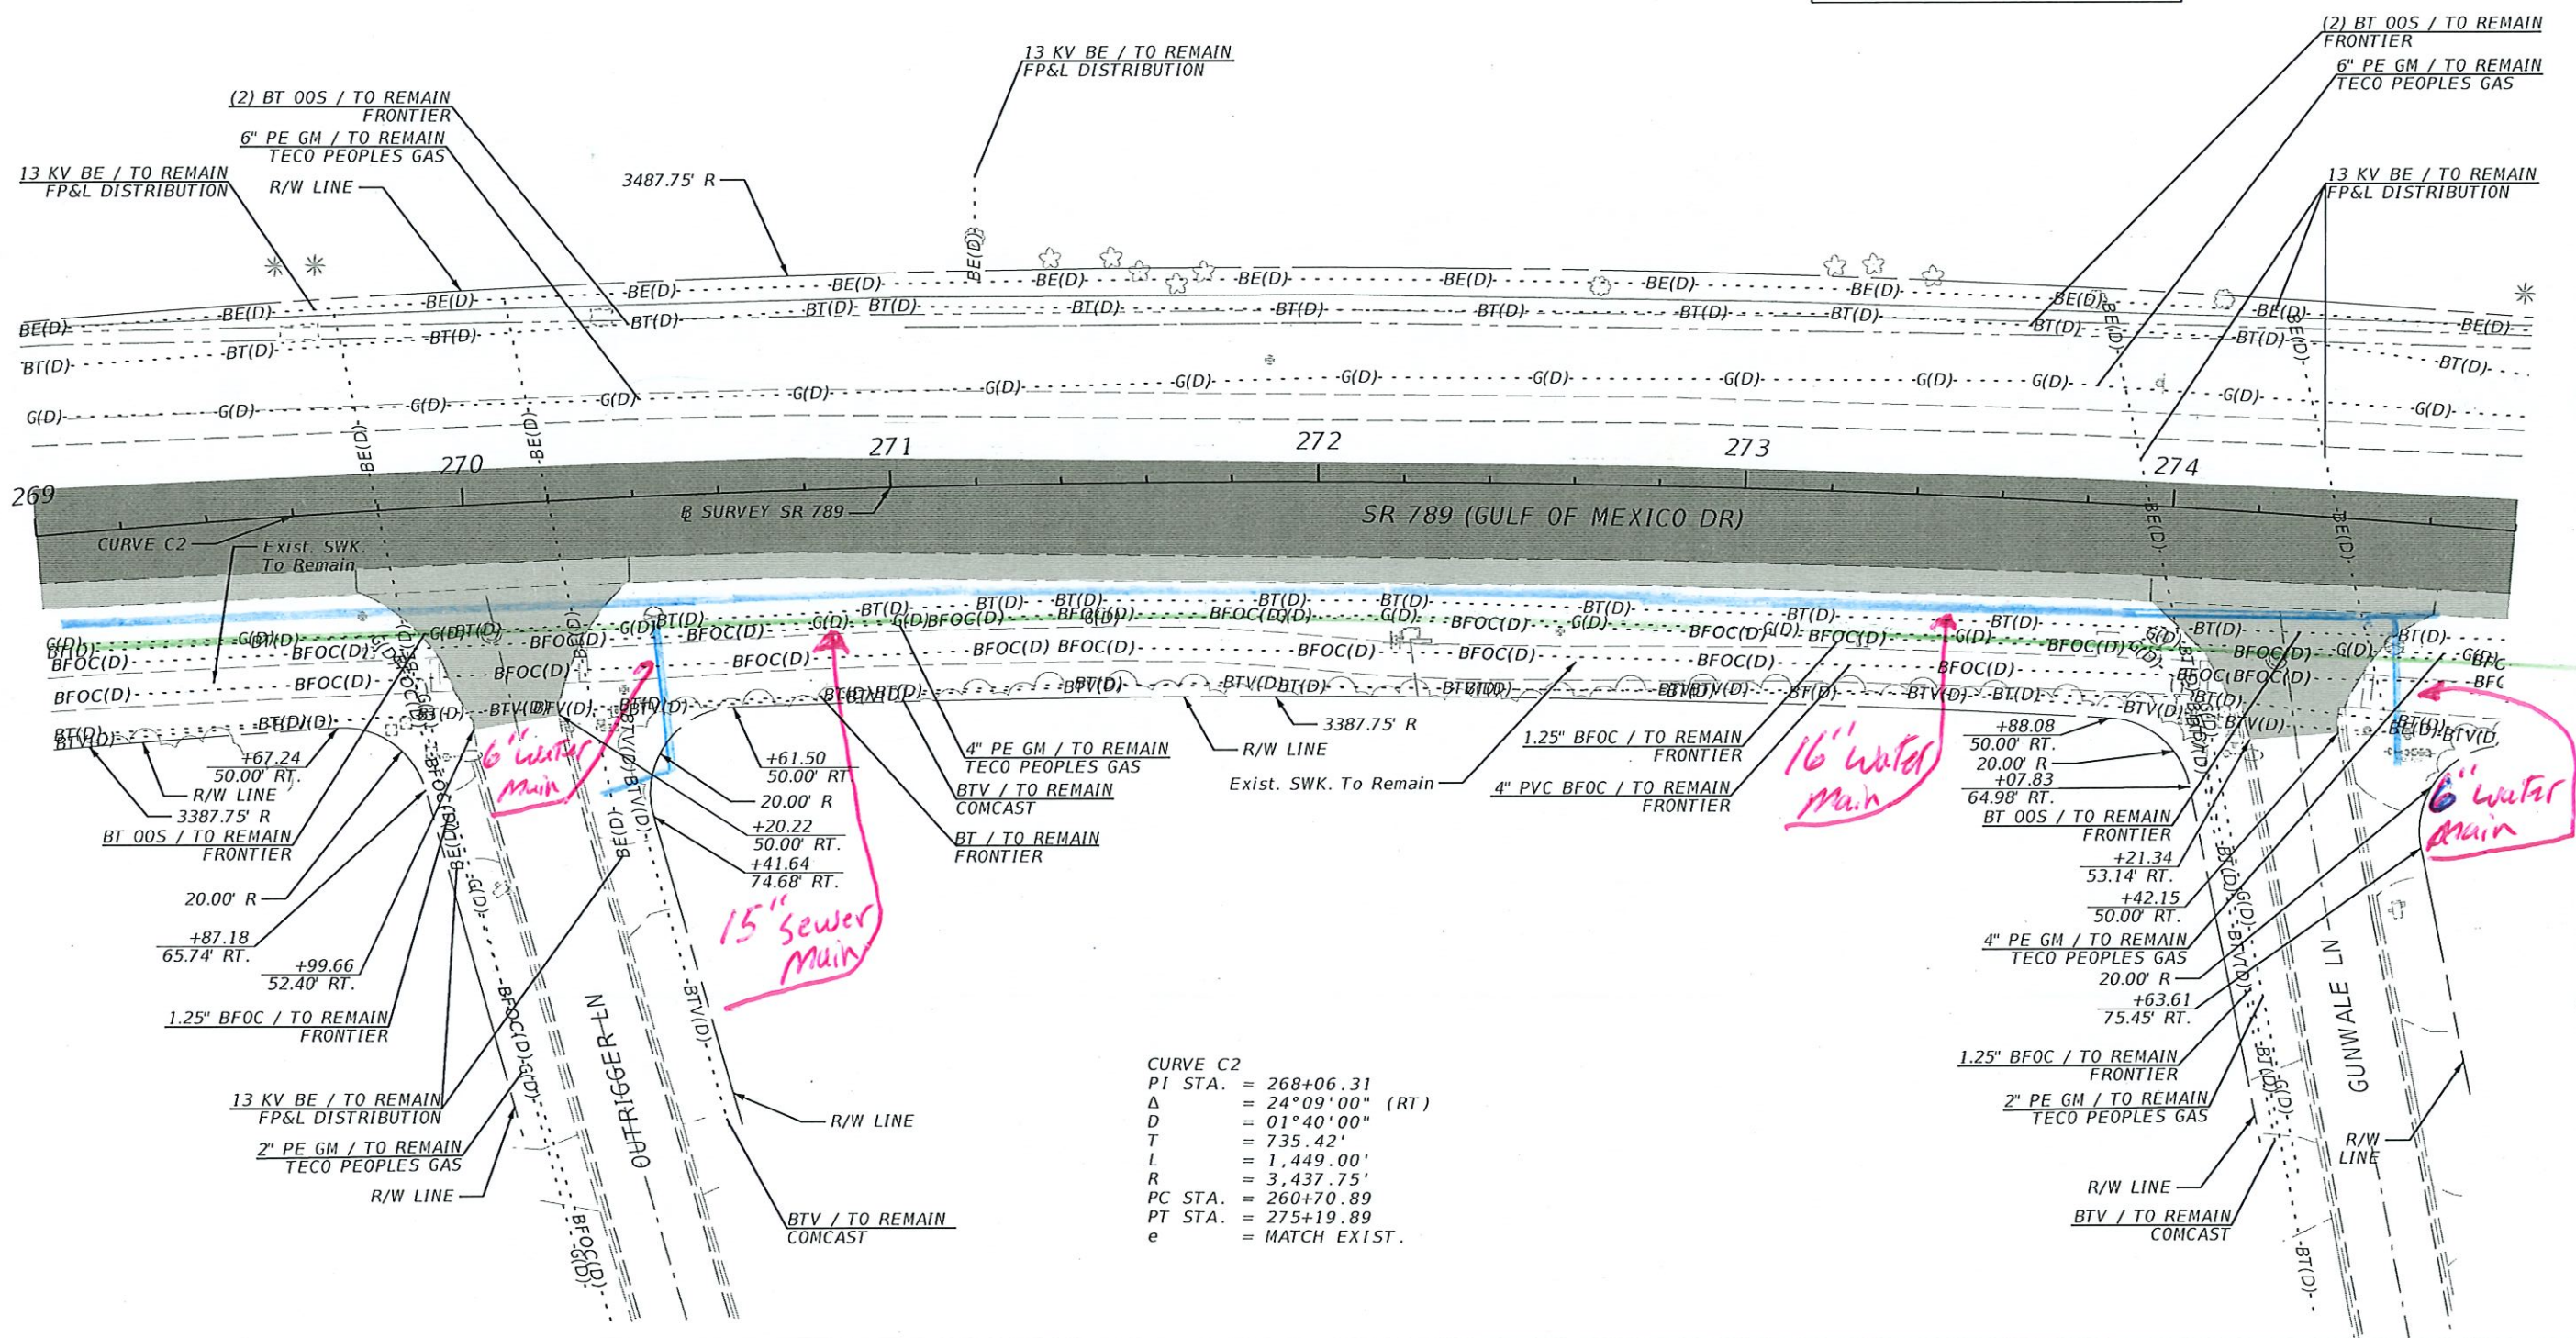

CURVE C2
PI STA. = 268+06.31
Δ = 24°09'00" (RT)
D = 01°40'00"
T = 735.42'
L = 1,449.00'
R = 3,437.75'
PC STA. = 260+70.89
PT STA. = 275+19.89
e = MATCH EXIST.

REVISIONS				ENGINEER OF RECORD	STATE OF FLORIDA DEPARTMENT OF TRANSPORTATION			ROADWAY PLAN (8)	SHEET NO. 43
DATE	DESCRIPTION	DATE	DESCRIPTION		ROAD NO.	COUNTY	FINANCIAL PROJECT ID		
					SR 789	SARASOTA	451013-1-52-01		


MEGAN LERNER, P.E.
LICENSE NUMBER: 72217
GARRETT ENGINEERING GROUP, INC.
120 10TH AVENUE NORTH
SAINT PETERSBURG, FL 33701

C:\Users\g3\Garrett Team Dropbox\GEG Projects\SR 789 from Longboat Club to Manatee CL\45101315201\Roadway\PLAINRD01.dgn : BLSR789 - PLAN-7 [SHEET]
g3 8/14/2025 1:43:20 PM



LEGEND

- TRAVEL LANES/TURN LANES/
GORE AREA MILLING
& RESURFACING (3 1/2")
- SIDE STREET/SHOULDER
MILLING & RESURFACING
(1 1/2")

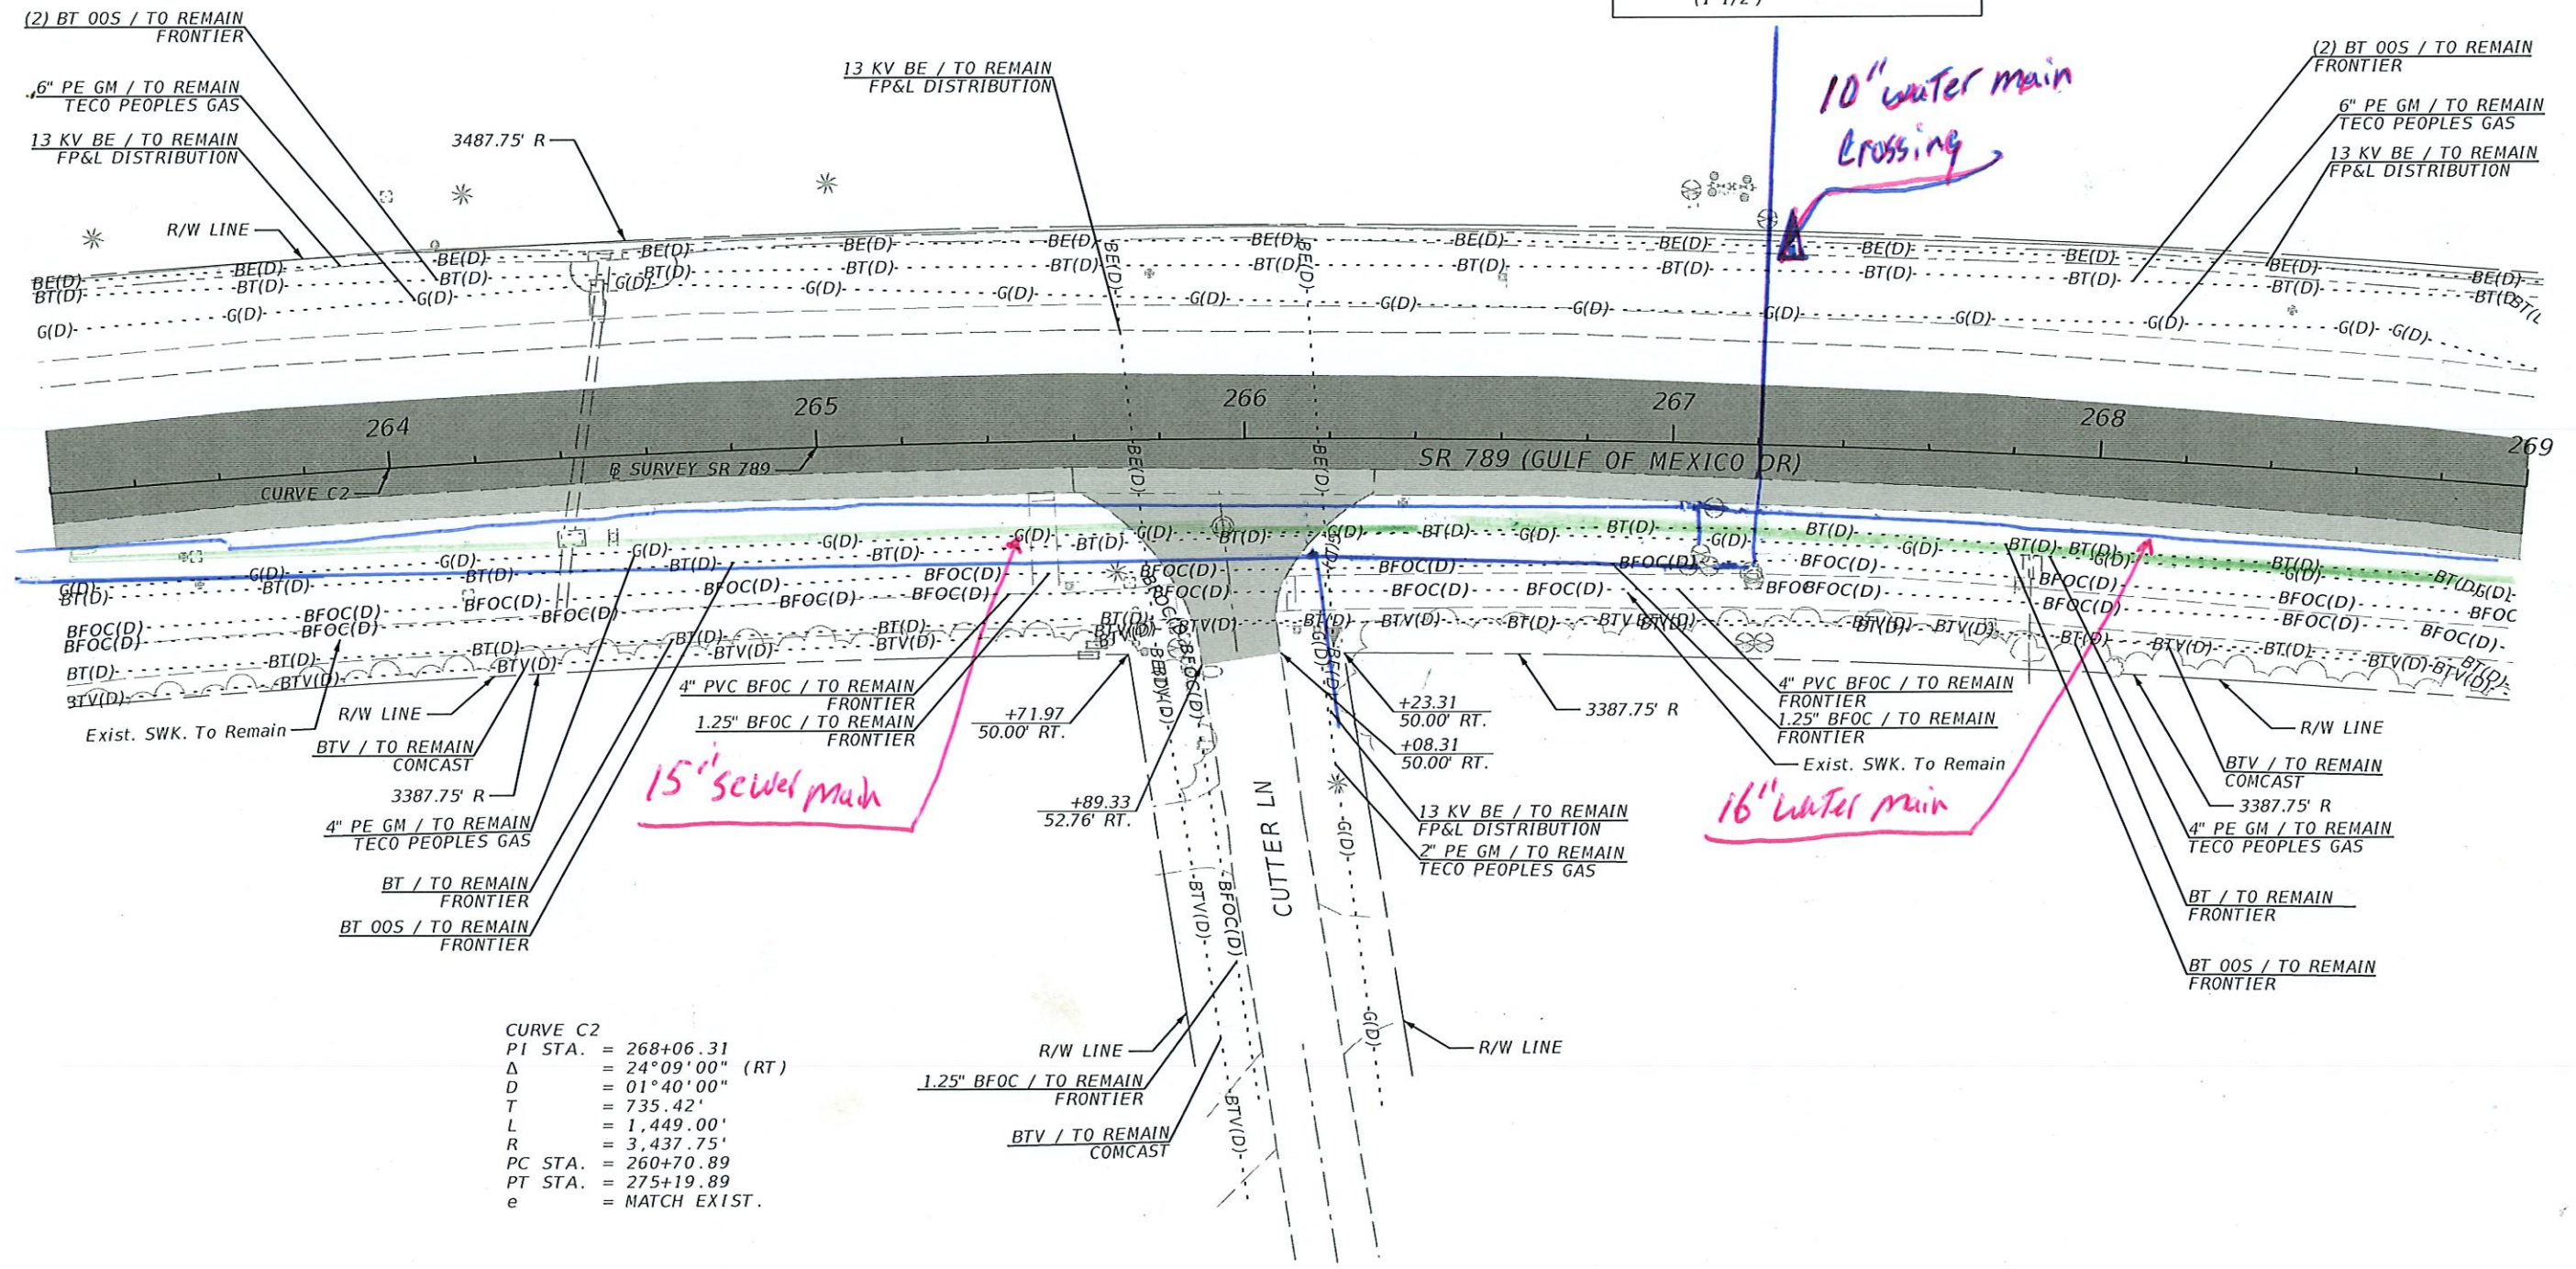

CURVE C2
PI STA. = 268+06.31
Δ = 24°09'00" (RT)
D = 01°40'00"
T = 735.42'
L = 1,449.00'
R = 3,437.75'
PC STA. = 260+70.89
PT STA. = 275+19.89
e = MATCH EXIST.

REVISIONS				ENGINEER OF RECORD	STATE OF FLORIDA DEPARTMENT OF TRANSPORTATION			ROADWAY PLAN (7)	SHEET NO. 42
DATE	DESCRIPTION	DATE	DESCRIPTION		ROAD NO.	COUNTY	FINANCIAL PROJECT ID		
					SR 789	SARASOTA	451013-1-52-01		


MEGAN LERNER, P.E.
LICENSE NUMBER: 72217
GARRETT ENGINEERING GROUP, INC.
120 10TH AVENUE NORTH
SAINT PETERSBURG, FL 33701

THE OFFICIAL RECORD OF THIS SHEET IS THE ELECTRONIC FILE DIGITALLY SIGNED AND SEALED UNDER RULE 61G15-23.004, F.A.C.



LEGEND

- TRAVEL LANES/TURN LANES/
GORE AREA MILLING
& RESURFACING (3 1/2")
- SIDE STREET/SHOULDER
MILLING & RESURFACING
(1 1/2")

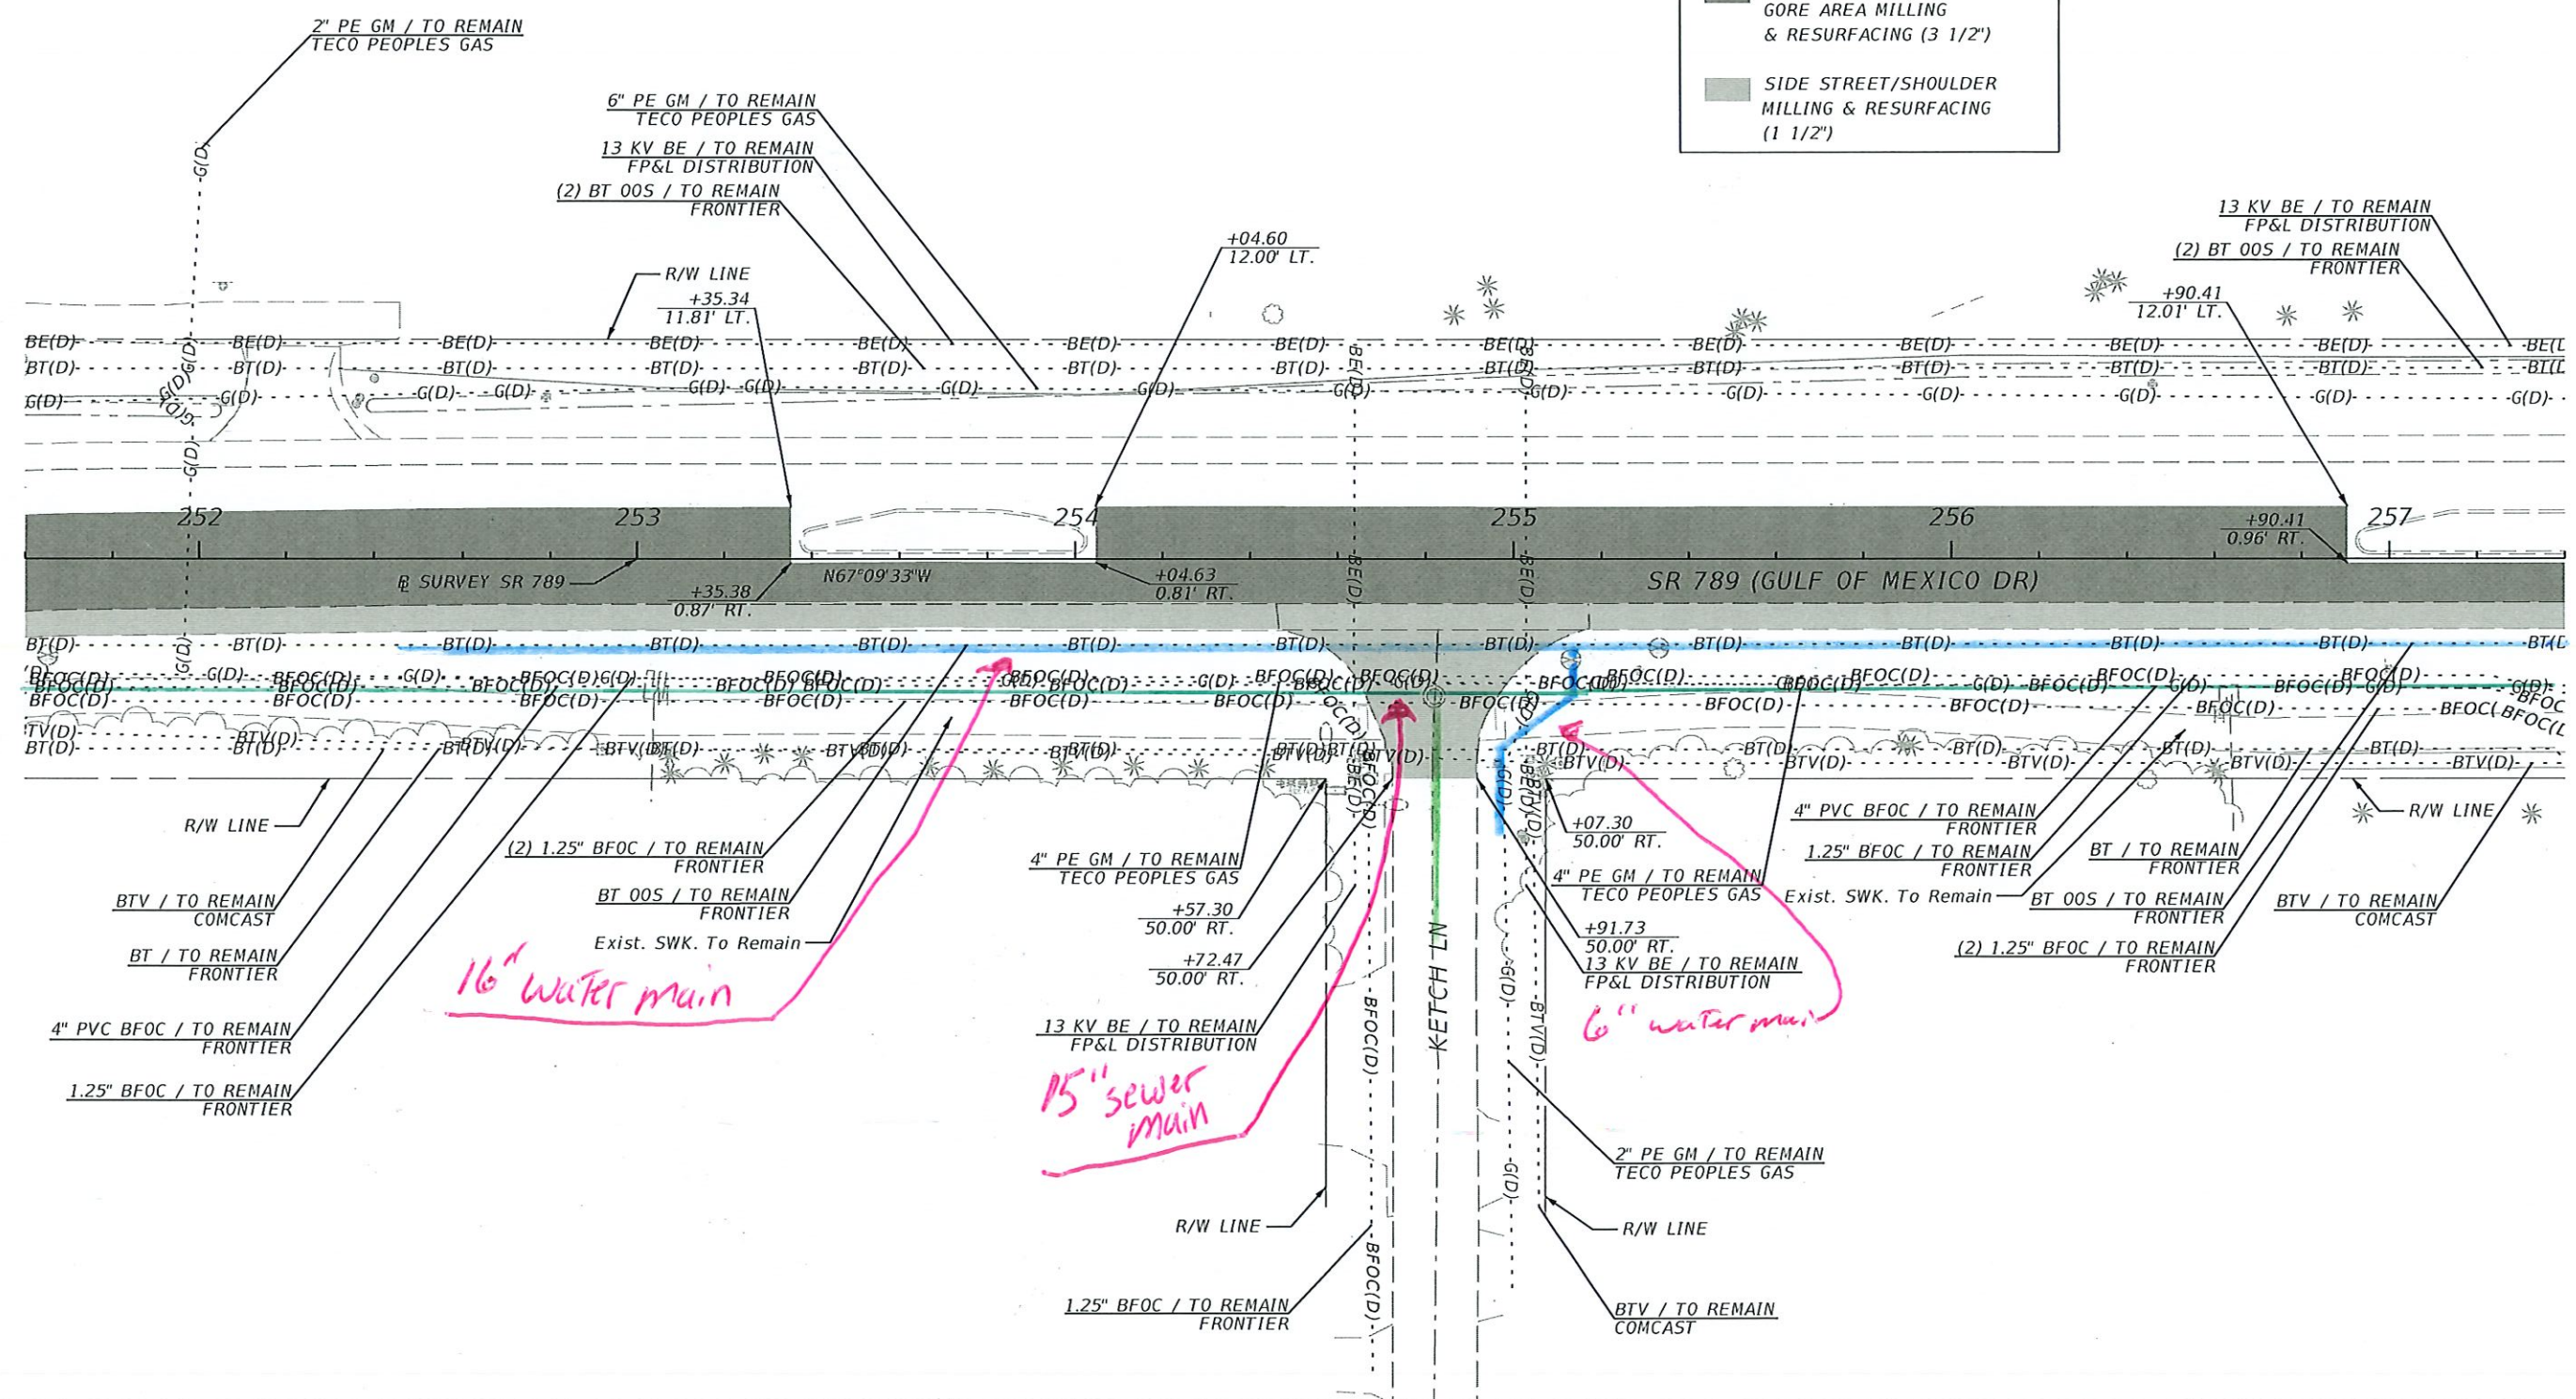

REVISIONS				ENGINEER OF RECORD	STATE OF FLORIDA DEPARTMENT OF TRANSPORTATION			ROADWAY PLAN (5)	SHEET NO. 40
DATE	DESCRIPTION	DATE	DESCRIPTION		ROAD NO.	COUNTY	FINANCIAL PROJECT ID		
					SR 789	SARASOTA	451013-1-52-01		


MEGAN LERNER, P.E.
LICENSE NUMBER: 72217
GARRETT ENGINEERING GROUP, INC.
120 10TH AVENUE NORTH
SAINT PETERSBURG, FL 33701

THE OFFICIAL RECORD OF THIS SHEET IS THE ELECTRONIC FILE DIGITALLY SIGNED AND SEALED UNDER RULE 61G15-23.004, F.A.C.



LEGEND

- TRAVEL LANES/TURN LANES/
GORE AREA MILLING
& RESURFACING (3 1/2")
- SIDE STREET/SHOULDER
MILLING & RESURFACING
(1 1/2")

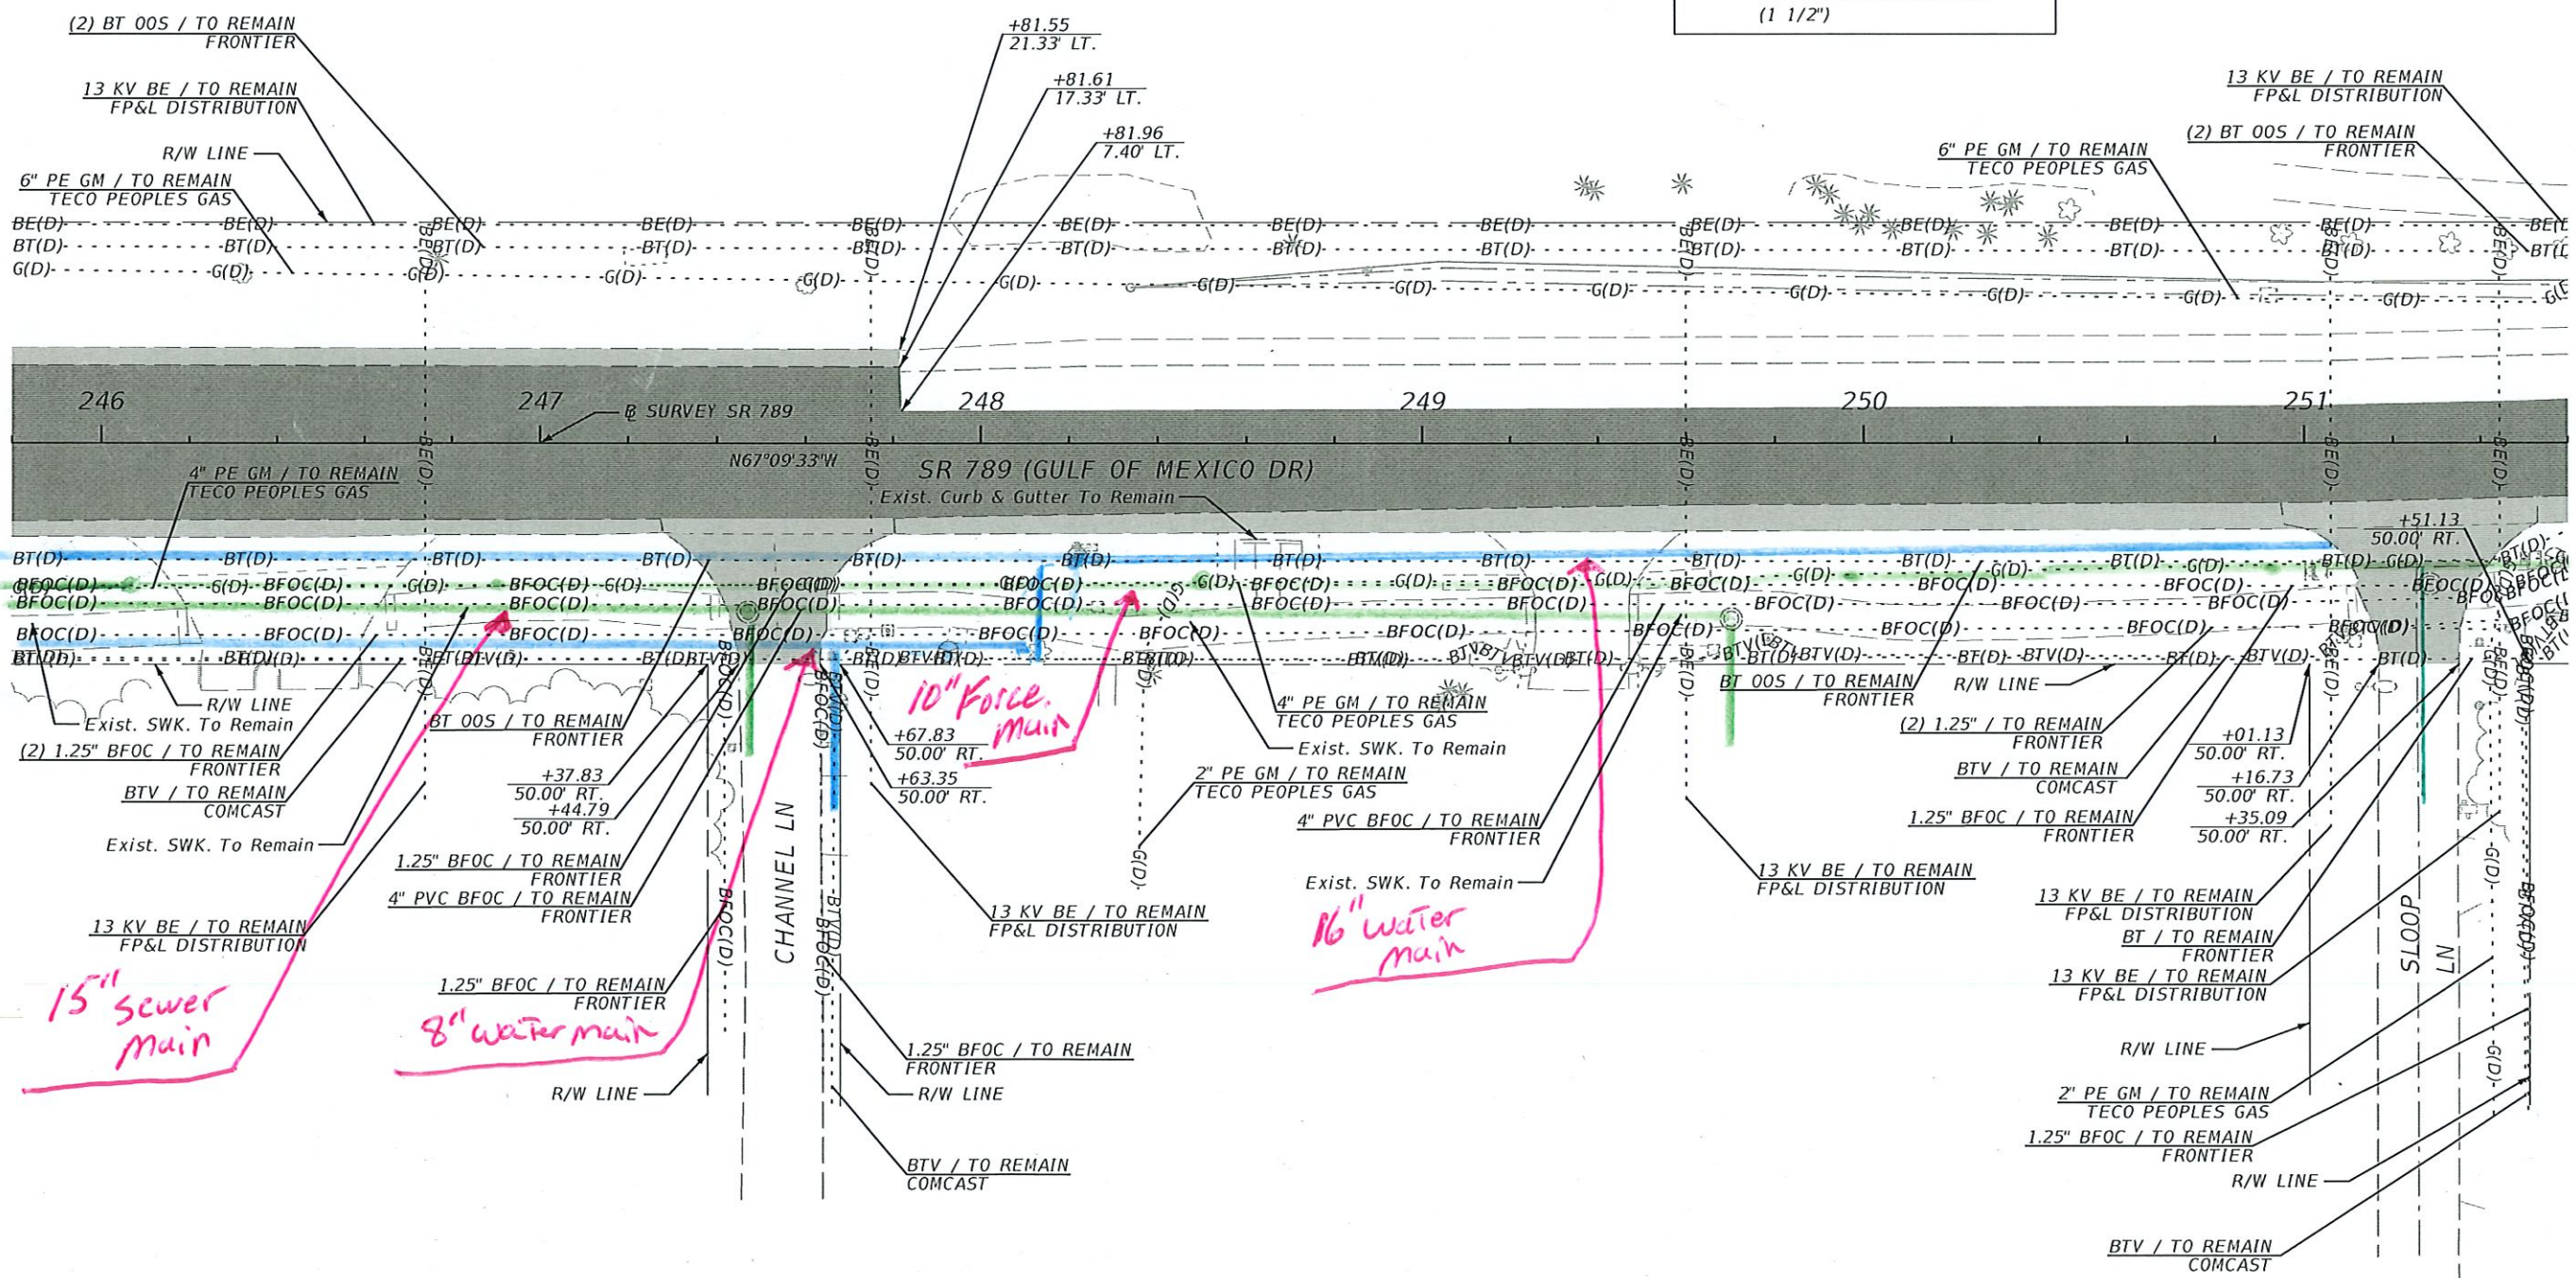


REVISIONS				ENGINEER OF RECORD			STATE OF FLORIDA DEPARTMENT OF TRANSPORTATION			ROADWAY PLAN (4)	SHEET NO. 39
DATE	DESCRIPTION	DATE	DESCRIPTION	MEGAN LERNER, P.E. LICENSE NUMBER: 72217 GARRETT ENGINEERING GROUP, INC. 120 10TH AVENUE NORTH SAINT PETERSBURG, FL 33701			ROAD NO.	COUNTY	FINANCIAL PROJECT ID		
							SR 789	SARASOTA	451013-1-52-01		

THE OFFICIAL RECORD OF THIS SHEET IS THE ELECTRONIC FILE DIGITALLY SIGNED AND SEALED UNDER RULE 61G15-23.004, F.A.C.




LEGEND

- TRAVEL LANES/TURN LANES/
GORE AREA MILLING
& RESURFACING (3 1/2")
- SIDE STREET/SHOULDER
MILLING & RESURFACING
(1 1/2")

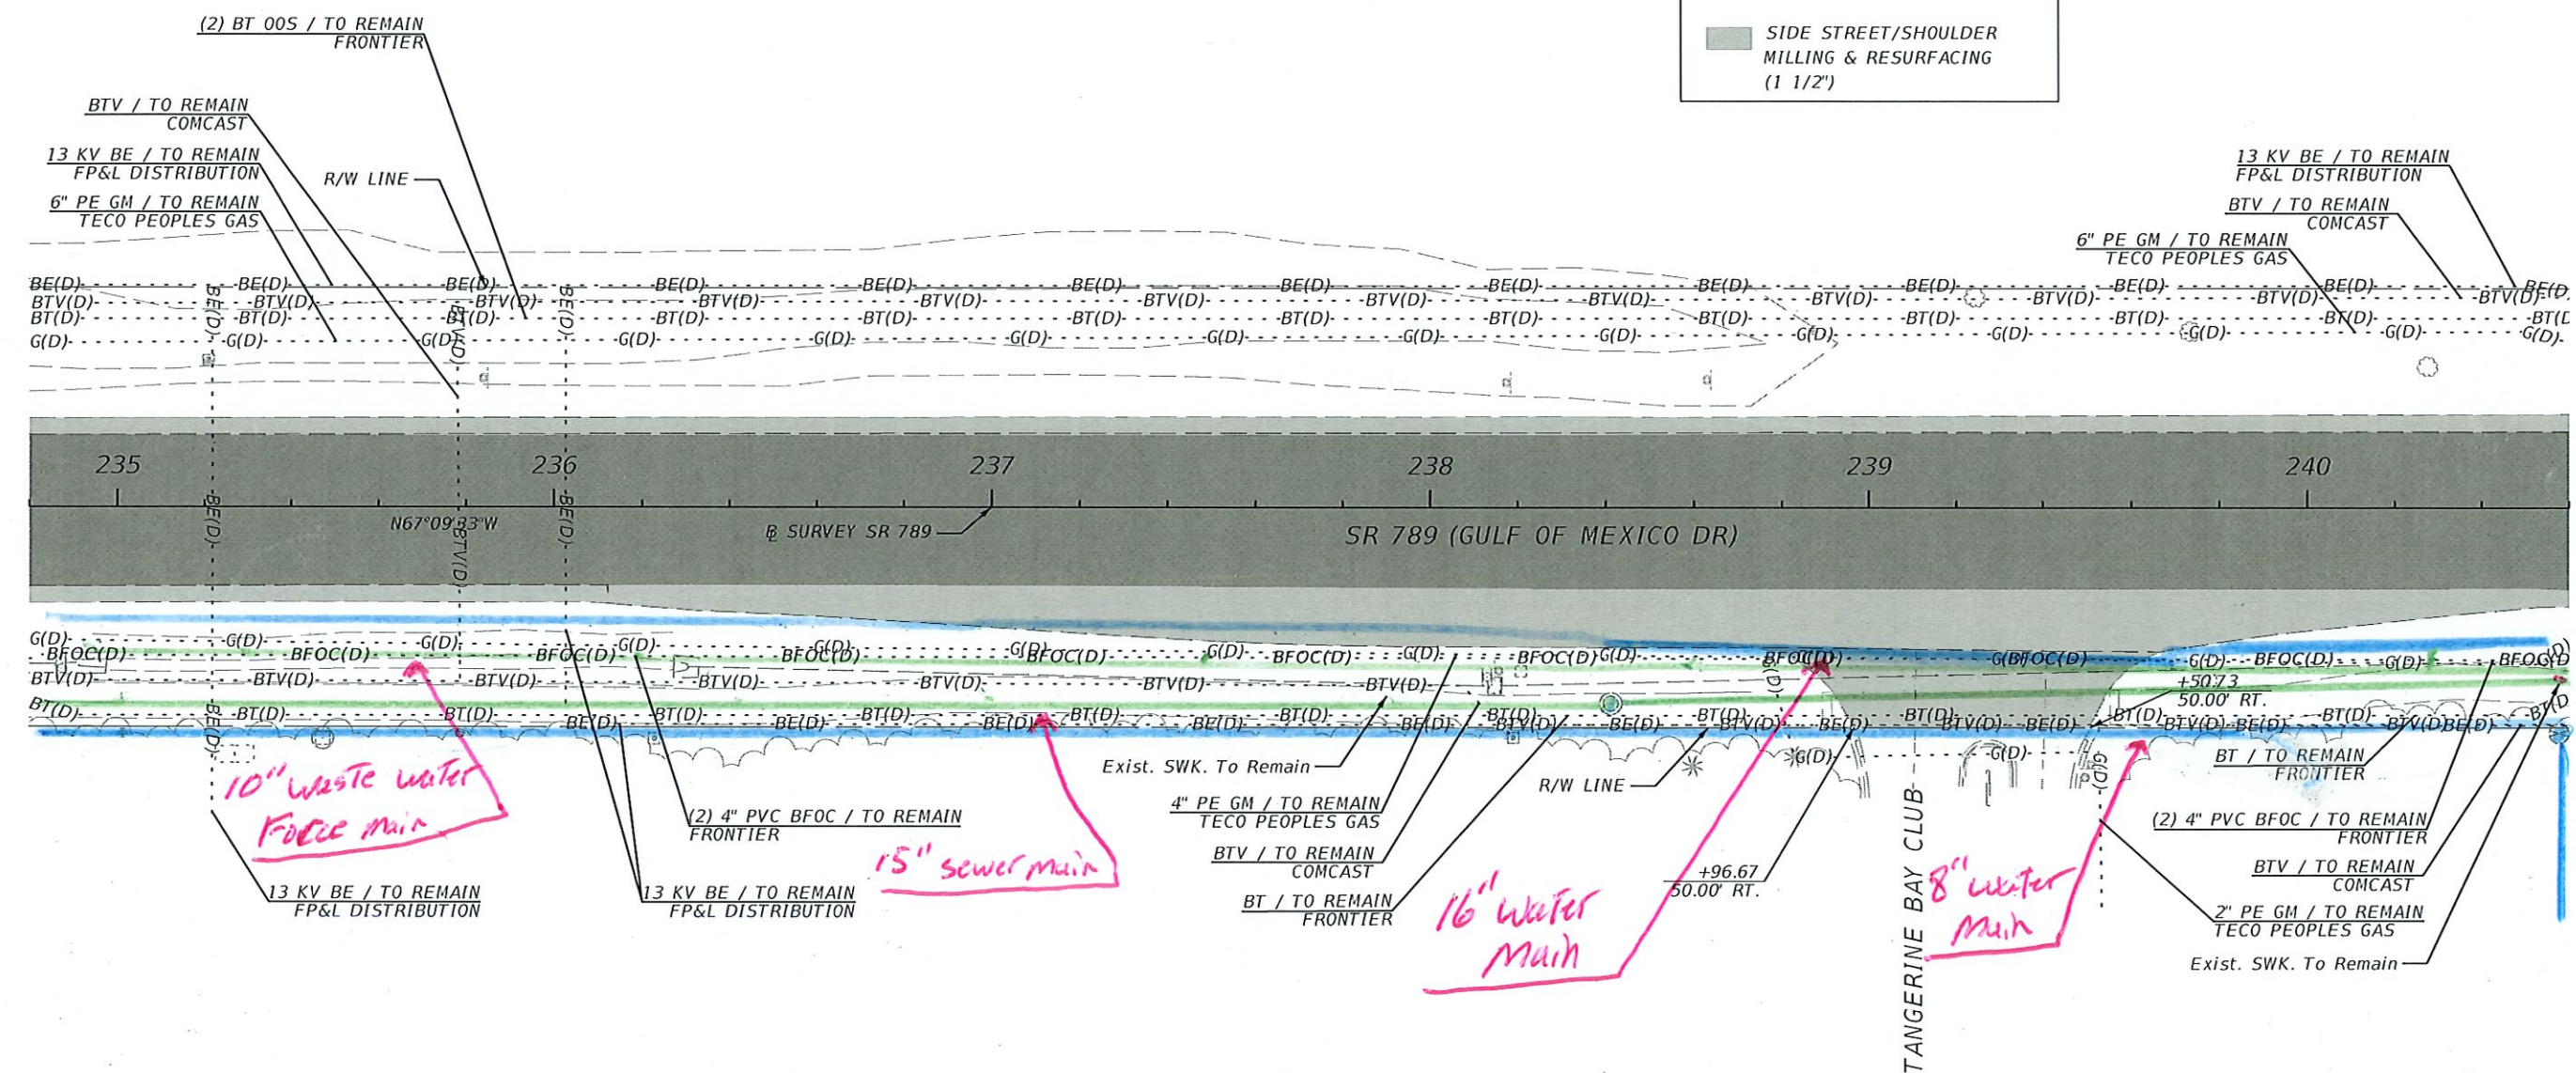

REVISIONS				ENGINEER OF RECORD			STATE OF FLORIDA DEPARTMENT OF TRANSPORTATION			ROADWAY PLAN (2)	SHEET NO. 37
DATE	DESCRIPTION	DATE	DESCRIPTION	MEGAN LERNER, P.E. LICENSE NUMBER: 72217 GARRETT ENGINEERING GROUP, INC. 120 10TH AVENUE NORTH SAINT PETERSBURG, FL 33701			ROAD NO.	COUNTY	FINANCIAL PROJECT ID		
							SR 789	SARASOTA	451013-1-52-01		

THE OFFICIAL RECORD OF THIS SHEET IS THE ELECTRONIC FILE DIGITALLY SIGNED AND SEALED UNDER RULE 61G15-23.004, F.A.C.

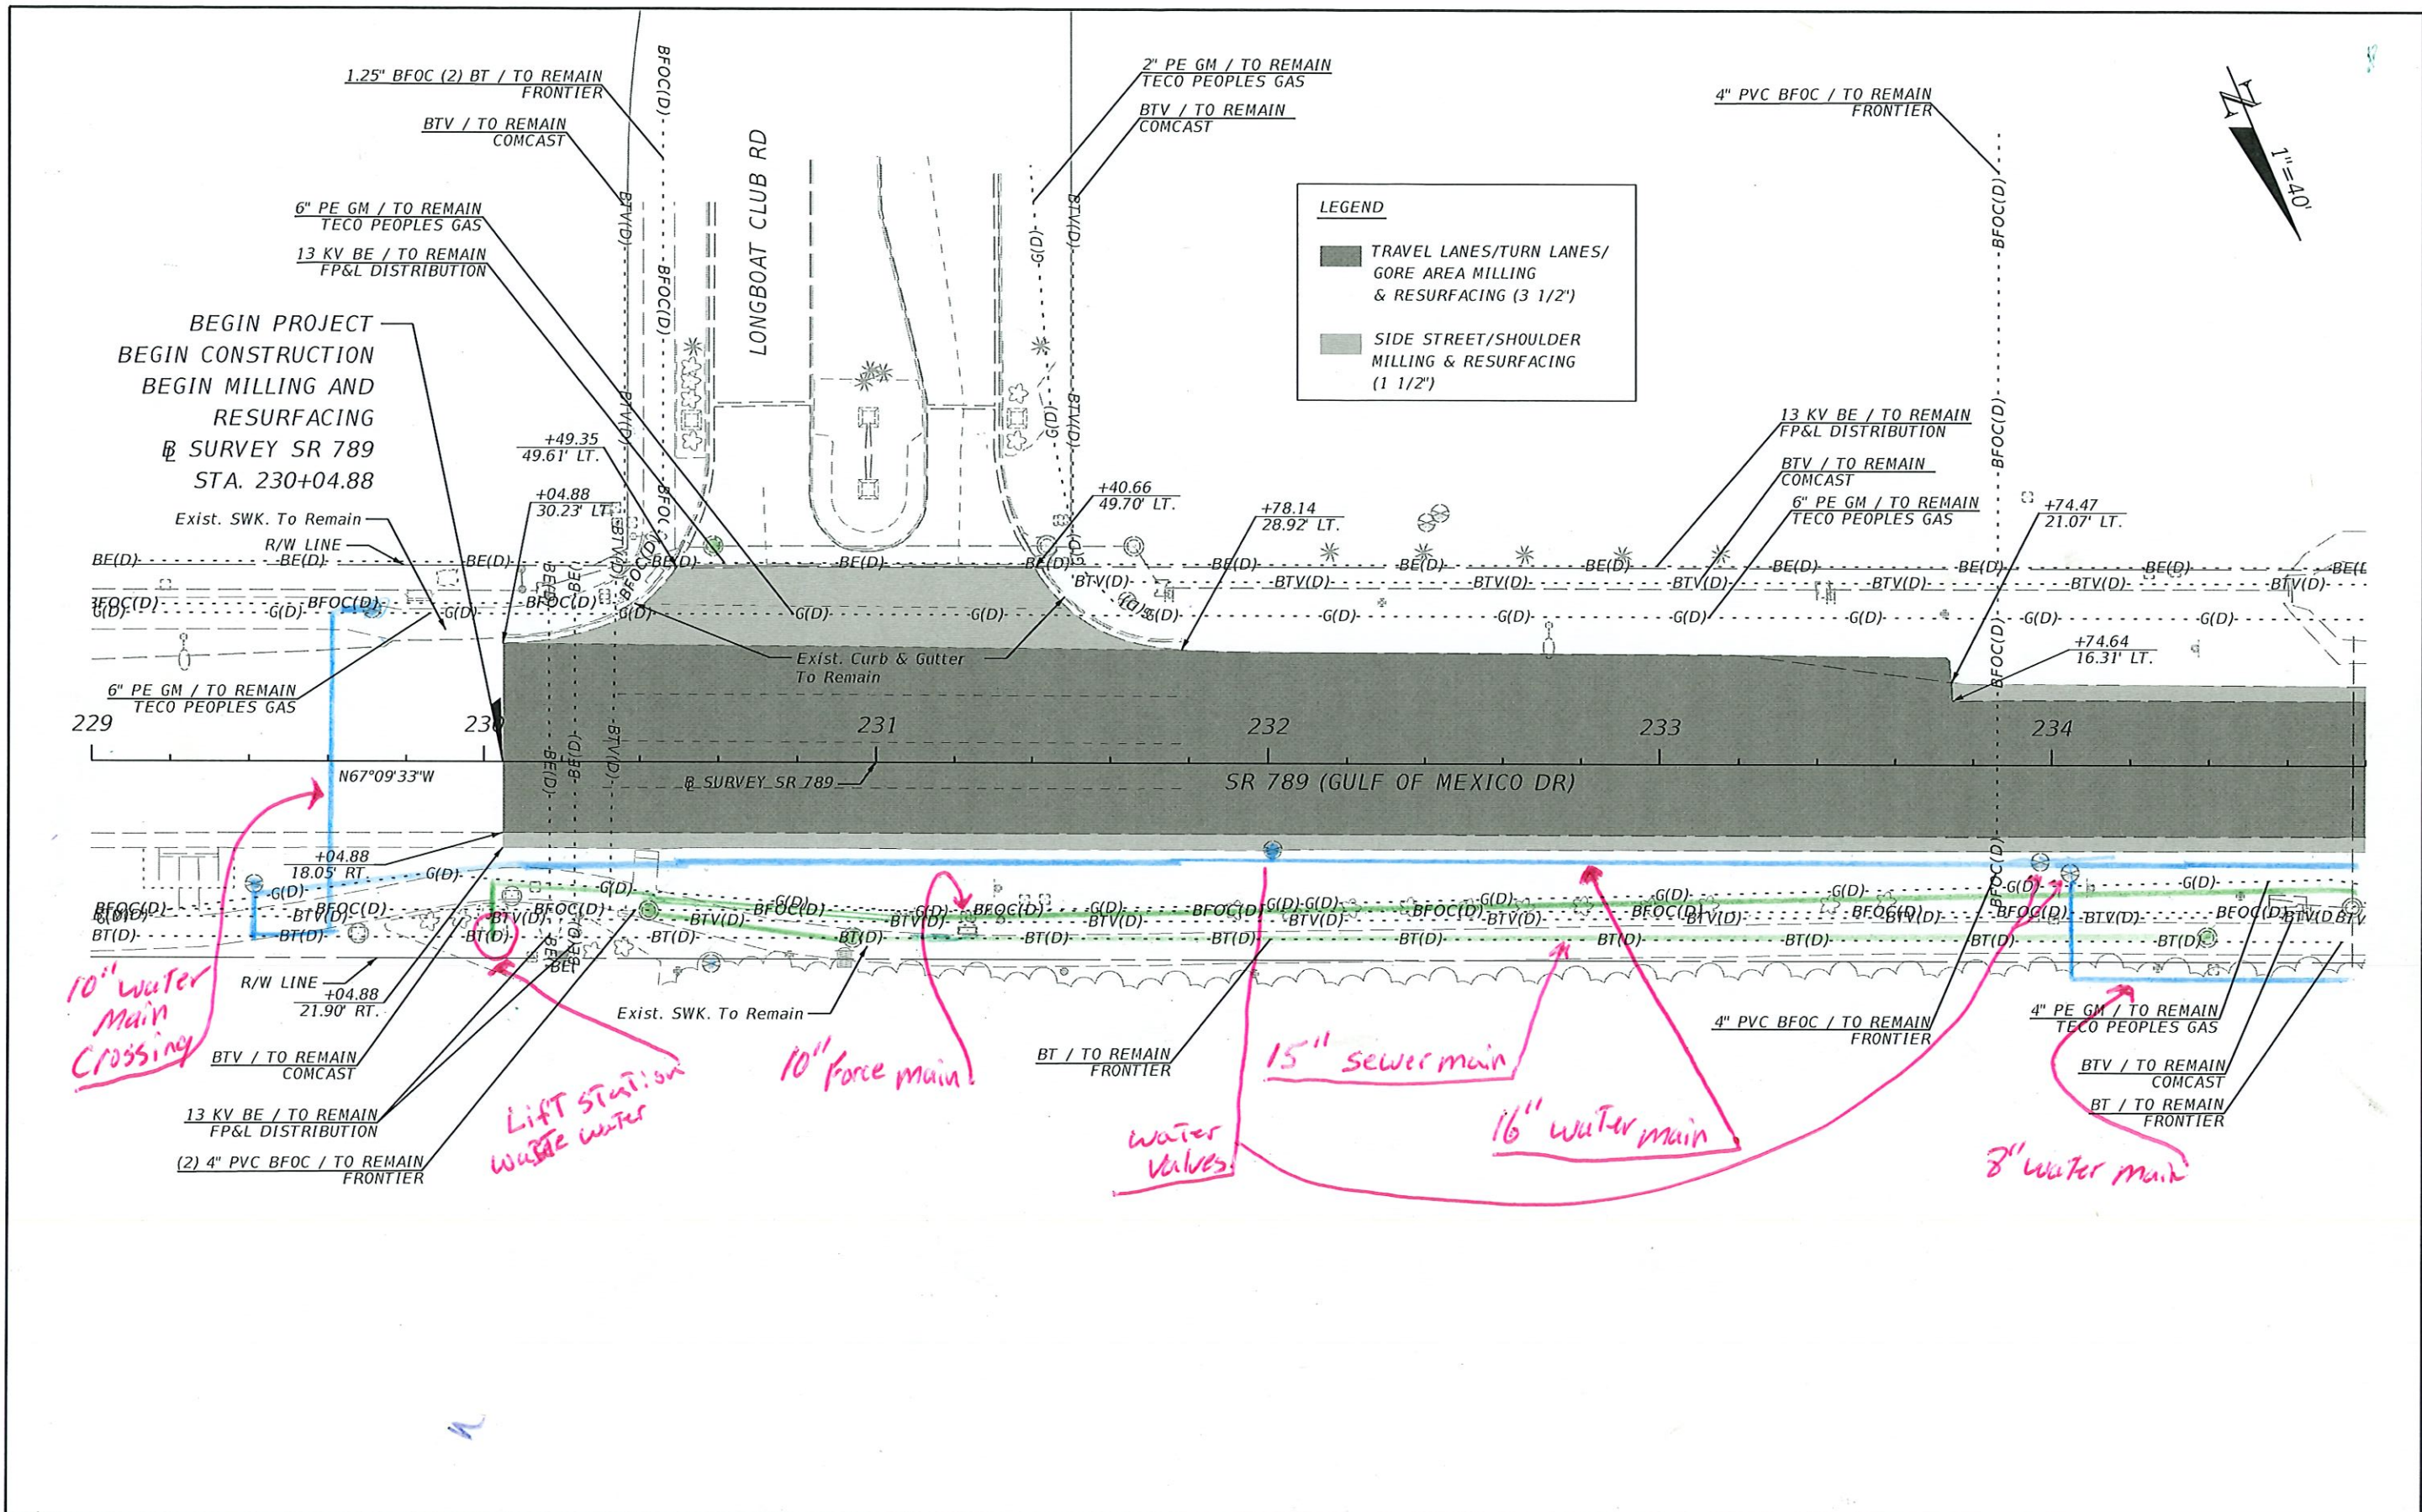

REVISIONS				ENGINEER OF RECORD			STATE OF FLORIDA DEPARTMENT OF TRANSPORTATION			ROADWAY PLAN (1)	SHEET NO. 36
DATE	DESCRIPTION	DATE	DESCRIPTION	MEGAN LERNER, P.E. LICENSE NUMBER: 72217 GARRETT ENGINEERING GROUP, INC. 120 10TH AVENUE NORTH SAINT PETERSBURG, FL 33701			ROAD NO.	COUNTY	FINANCIAL PROJECT ID		
							SR 789	SARASOTA	451013-1-52-01		