

Section 21, Township 36 South, Range 17 East
1001 Longboat Club Road, Longboat Key, Florida, 34228

Lot 3, LONGBOAT KEY CLUB, UNIT NO. 5, according to the plat thereof, as recorded in Plat Book 31, Pages 16, of the Public Records of Sarasota County, Florida.

Name Jai Jm Date 3/18/25



Notes:

1. This map represents a Boundary & Topographic Survey for the purpose of permitting a new house.
2. Bearings shown hereon refer to an assumed meridian, the Northeast Right of Way Line of Longboat Club Road, being S.44°45'17"W.
3. There may exist other underground fixed interior improvements that are not visible and are not a part of this survey.
4. Description shown hereon was obtained from Official Records Instrument #0200007707.
5. Subject to the rights and interests of record, if any.
6. This map has been prepared without the benefit of a Commitment for Title Insurance or a Title Policy.
7. Parcel is situated in Flood Zone "AE", base flood elevation is 11 feet, per Florida Insurance Code, Section 621.41 and 121.50(1)(2)(B), Revised March 27th, 2024 permitted as Flood Zone "AE", base flood elevation is 11 feet, per Florida Insurance Rate Map Number 12150(01)3.F, Effective Date November 4, 2016.
8. Elevations shown hereon are in feet and decimals referenced to the National Mean Sea Level, Geoidetic Survey Benchmark A 715, published elevation is 7.74' NAVD 88.

| LOT COVERAGE CALCULATION | |
|-----------------------------------|---------------------|
| Impervious Calculations | Square Feet: |
| Total Lot | 18,750 |
| House Footprint | 5,199 |
| Concrete Stairs, Pads, Planter | 524 |
| Border and Wood Retaining Wall | |
| Driveway and Walk | 2,348 |
| Elevated Pool | 1,094 |
| Total Impervious | 9,165 |
| Total Coverage | 48,888 |
| Max Allowable Impervious Coverage | 50% (9,375 S.F.) |
| Building Coverage Calculations | |
| House Footprint | 5,199 |
| Elevated Pool | 1,094 |
| Total House | 27,735 |
| Total Pool | 5,835 |
| Total Coverage House + Pool | 33.56% (6,293 S.F.) |
| Max Allowable Building Coverage | 30% (6,025 S.F.) |
| Plus 5% For Elevated Pool | 5% (835 S.F.) |
| Total Coverage House + Pool | 35% (6,662 S.F.) |

ISLANDSIDE GOLF COURSE

536 INTERSTATE COURT
SARASOTA, FLORIDA 34240
PHONE NO.: (941) 341-9935
CERTIFICATE OF AUTHORIZATION
DRAWN BY: RLB/RRG



RICHARD C ABERNATHY,
REGISTERED SURVEYOR & MAPPER, FLA. CERT. NO. LS 6589
NOTE: NOT VALID WITHOUT THE SIGNATURE AND THE ORIGINAL RAISED
OR ELECTRONIC SEAL OF A FLORIDA LICENSED SURVEYOR OR MAPPER.

200/8
4/42,54

DATE OF SURVEY 03/03/2025 FIELD BOOK/PAGE: 1

19
MBER






Revision: Final Survey, 03-05-2025, SWB
Revision: Foundation Location, 02-24-2024, RRG
Revision: Stem wall location, 11-21-2023, RLB
Revision: Removed Demolished Structure and Added Proposed Structure,
Revision: Add Topography, 04-26-2023, RRG

RECEIVED
MAR 16 2025
TOWN OF LONGBOAT KEY
Planning, Zoning & Building

Legend

- Denotes Cable Riser
- Denotes Light Pole
- Denotes Water Meter
- Denotes Water Back flow
- Denotes Well
- Denotes Gas Meter
- Denotes Sewer Clean Out

Z:\Drawings\1001 Longboat Club Road\1001 Longboat Club Road.dwg 7/16/2023 9:53 AM

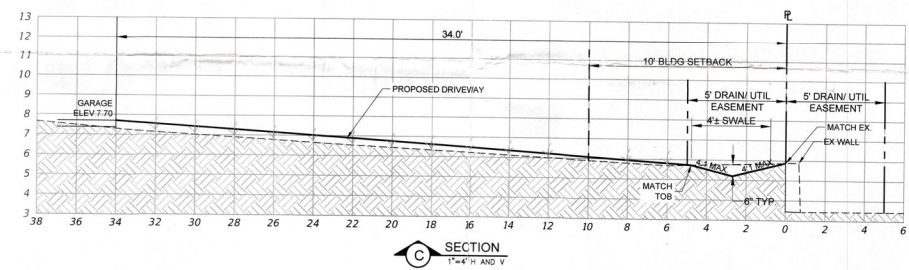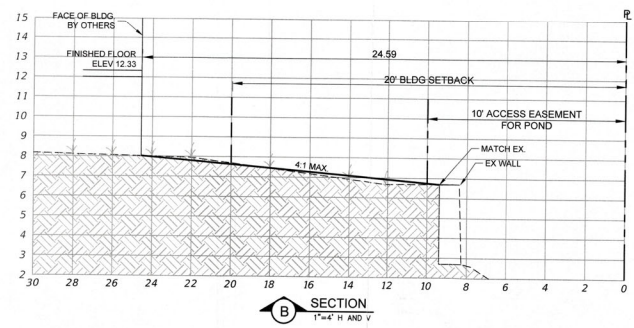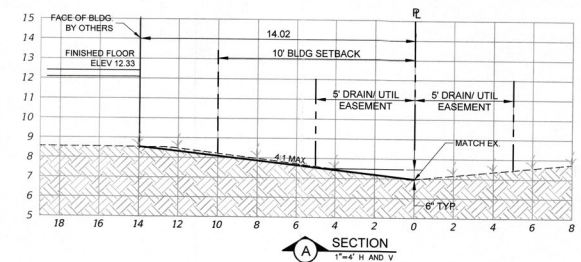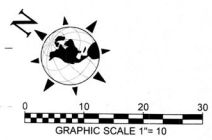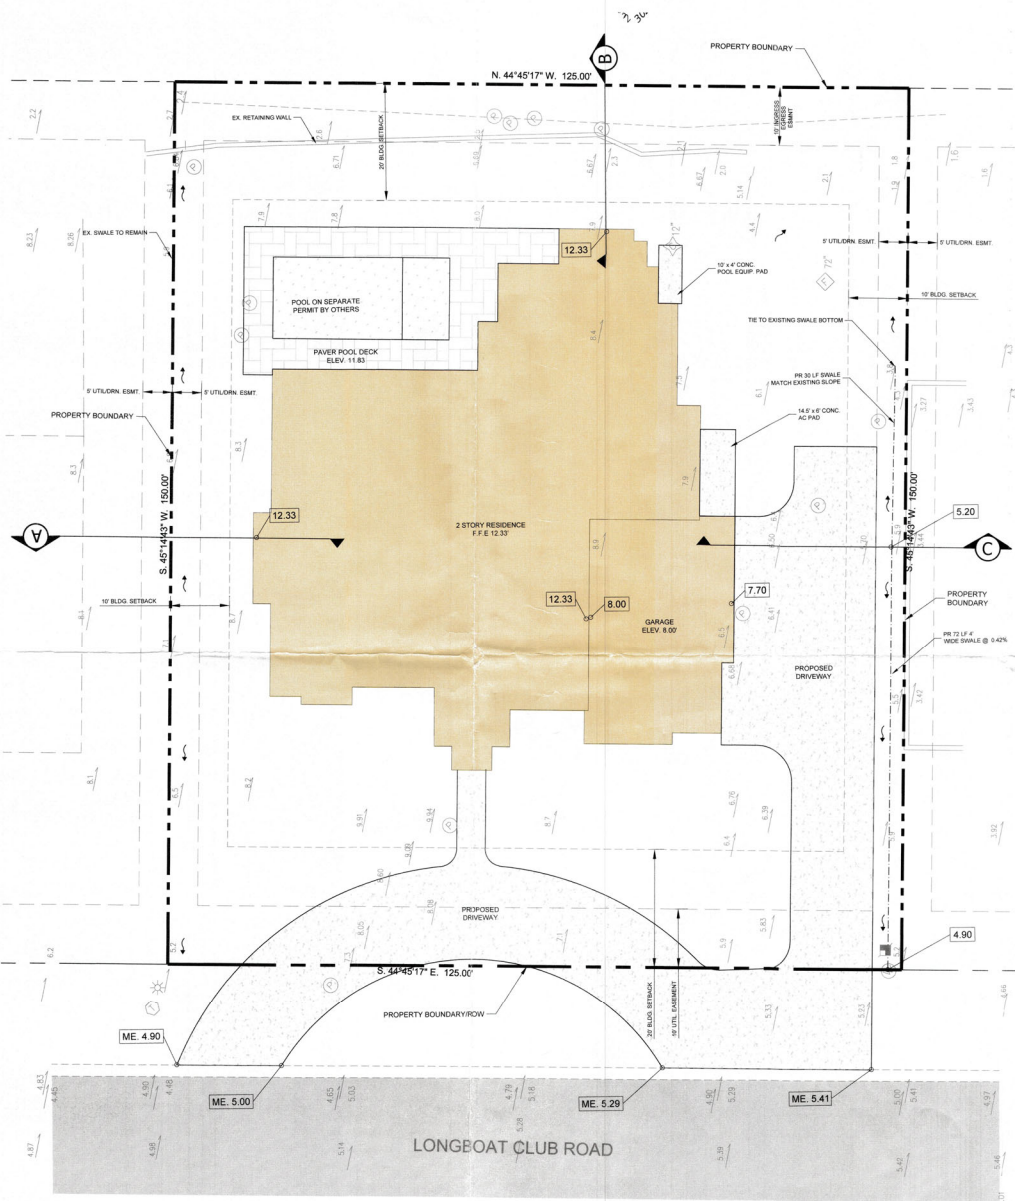

- PROPERTY ADDRESS:
1001 LONGBOAT CLUB ROAD
LONGBOAT KEY, FL 34228
- SITE NOTES:
1. SITE AREA: 18,750 S.F. OR (0.430) ACRES
 2. PROPERTY OWNER AND/OR CONTRACTOR MUST VERIFY FLOOD ZONE INFORMATION AND BUILDING RESTRICTIONS PRIOR TO DESIGN OR IMPROVEMENTS
 3. SUBJECT PROPERTY LOCATED IN FLOOD ZONE AE (EL11), #12115C0126F AND #12115C0128F; EFFECTIVE DATE 11/04/2016.
 4. ORIGINAL SURVEY CAD LINE WORK HAS BEEN ADJUSTED TO APPROXIMATELY STATE PLANE. OBTAIN ORIGINAL BOUNDARY/TOPO CAD DRAWINGS FROM SURVEYOR.

RECEIVED
AUG 14 2023
TOWN OF LONGBOAT KEY
Planning, Zoning & Building



MORRIS ENGINEERING AND CONSULTING, LLC
Civil Engineering and Land Development Consulting
8997 Professional Parkway East, Suite B, Lakewood Ranch, Florida 34240 C.A.23788 941-444-6644 www.morrisengr.com

| | |
|---------|--------------------|
| DATE | 6/23/23 |
| PROJECT | 1001 LONGBOAT CLUB |
| DRAWING | 1001 LCB RD OP |
| DRAWN | K.A. |
| CHECKED | E.L.T. |

DRAINAGE PLAN
1001 LONGBOAT CLUB ROAD
LONGBOAT KEY, FLORIDA


This item has been digitally signed and sealed by
Erin Leah Tumolo, P.E., on the date adjacent to the seal.
Printed copies of this document are not considered signed
and sealed and the signature must be verified on any
electronic copies.



Erin L. Tumolo
P.E.
No. 99073
State of Florida

Digitally signed by Erin L. Tumolo
Date: 2023.07.05 09:38:57 -0400
ERIN LEAH TUMOLO
FL LICENSE NO. 99073

SCALE: 1"=10'
DATUM: NAVD 1988
SEC: TSP-BNG-21-36S-17E
SHEET
C.01

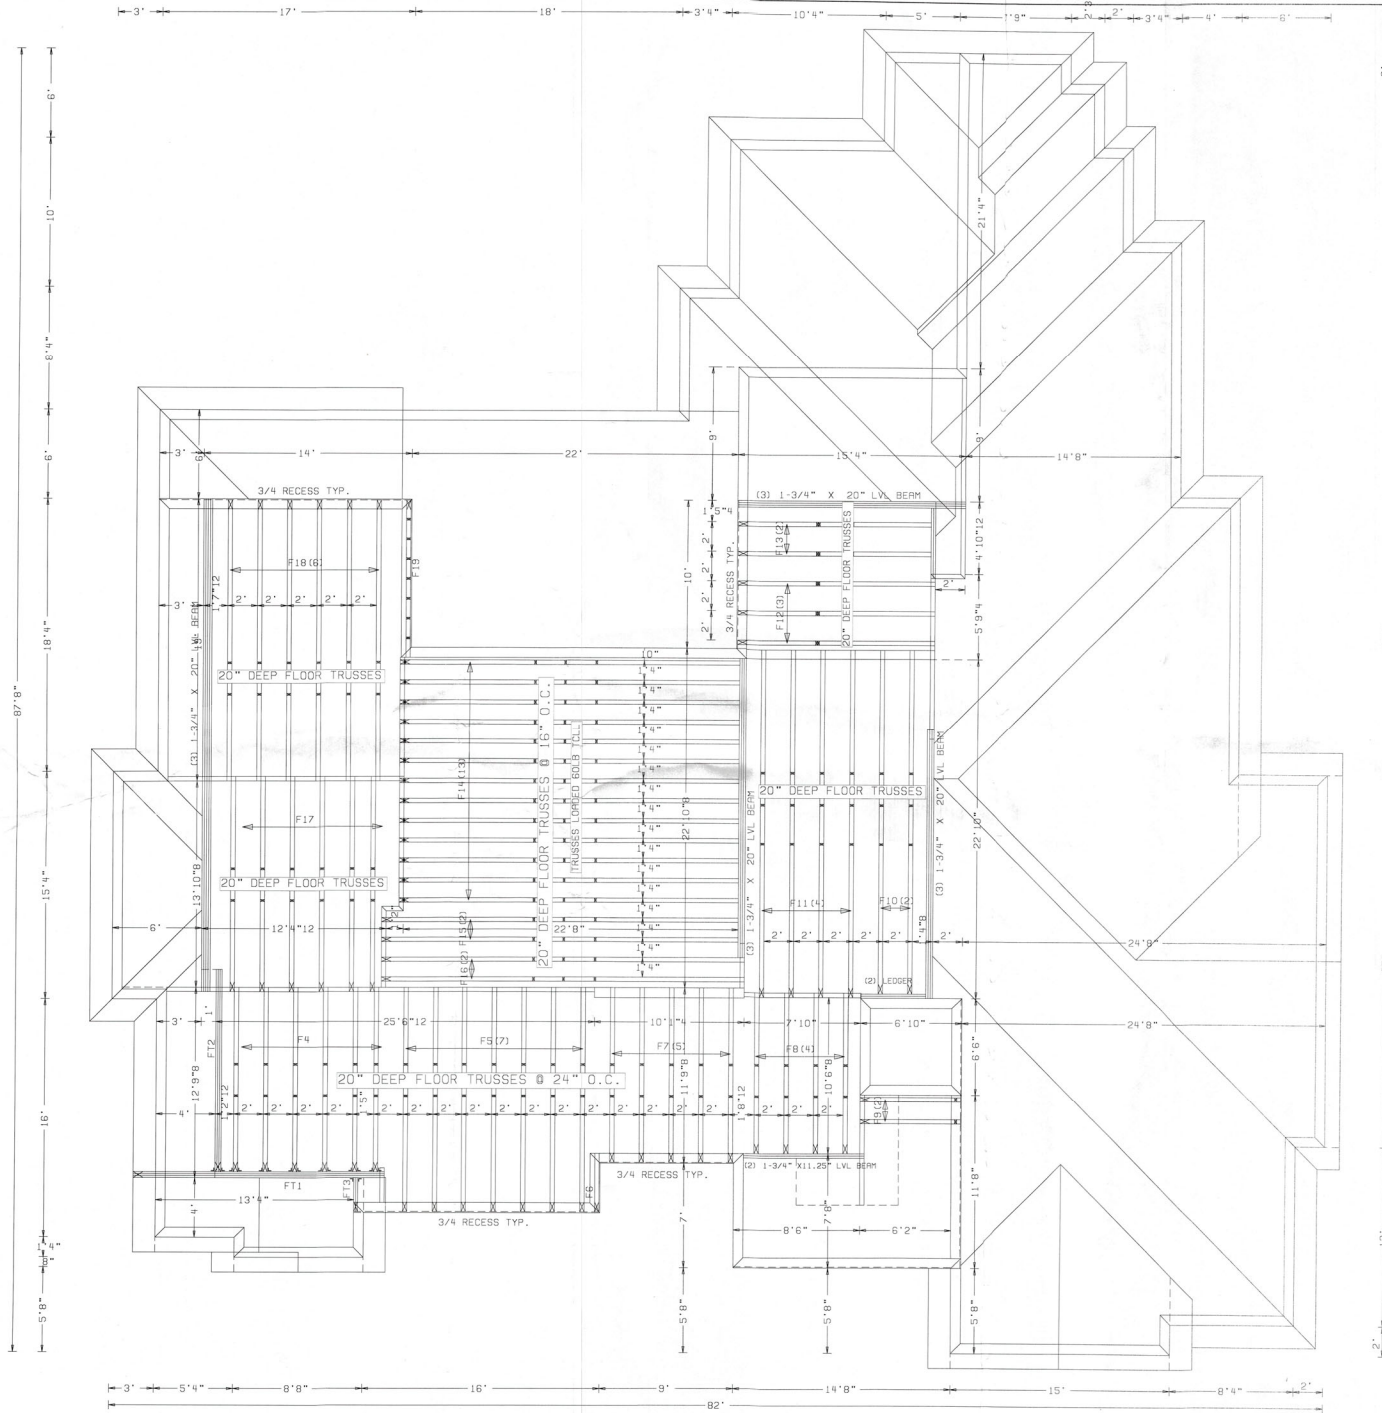

YODER HOMES LLC
LITTLE RESIDENCE
FLOOR TRUSS LAYOUT
KJ 231018

KIMAL LUMBER AND HARDWARE
ENGINEERED WOOD PROD. DIV.
VENICE, FL
ALPINE ENGINEERING

FINAL LAYOUT
FOR PERMIT PURPOSES

20" SY42 FLOOR TRUSSES
4X2 CHORDS
24" O.C. (MAX.)
7" BEARING
FBC2020 - 7TH EDITION
TPI 2014
55 PSF DESIGN LOAD
40 PSF TC/LL
10 PSF TC/DL
5 PSF BC/DL
1.00 DUR. FACTOR

LVL BEAMS BY OTHERS

REACTIONS DO NOT EXCEED 5000lbs.
UPLIFTS DO NOT EXCEED 1000lbs.

VERIFY TRUSS PLACEMENTS VS. PLUMBING,
A/C, etc.

NOTICE:
BACKCHARGES WILL NOT BE
ACCEPTED, REGARDLESS OF FAULT,
WITHOUT 48 HR. PRIOR NOTIFICATION
AND INSPECTION BY KIMAL LUMBER

VERIFY ALL DIMENSIONS, CONDITIONS,
ETC. AND RETURN APPROVED COPY TO KIMAL LUMBER

SIGNED: _____ DATE: _____

REQUESTED/ESTIMATED DELIVERY DATE: _____

DESIGNED: 12/12/23 RT.

Permit # PB23-0943
REVIEWED FOR CODE COMPLIANCE
LONGBOAT KEY BUILDING DEPT.

APR 30 2024

APPROVED
Reviewer: *[Signature]*

BLDG PERMIT PLANS
FILE
Copy of Record

RECEIVED


APR 29 2024
TOWN OF LONGBOAT KEY
Planning, Zoning & Building

YODER HOMES LLC
LITTLE RESIDENCE
LOWER ROOF TRUSS LAYOUT
KJ 231019

KIMAL LUMBER AND HARDWARE
ENGINEERED WOOD PROD. DIV.
VENICE, AL
ALPINE ENGINEERING

PRELIMINARY LAYOUT
FOR PERMIT ONLY

5/12 TC PITCH
FLAT CEILING
2X6 TOP CHORD
1'-6" O.H. (PL)
7" BEARING
FBC2023 - 8TH EDITION
TPI 2014
45 PSF DESIGN LOAD
20 PSF TC/LL
15 PSF TC/DL
10 PSF BC/DL
(10PSF BC/LL NON-CONCURRENT)
1.25 DUR. FACTOR
ASCE7-22 WINDLOAD
200 MPH
EXPOSURE "D"
ENCLOSED
10PSF DEADLOAD TO RESIST UPLIFT

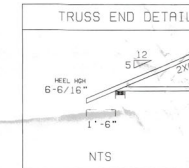

11'-0" ELEVAT.
10'-0" ELEVAT.
9'-8" ELEVAT.

CONVENTIONAL FRAMING REQUIRED TO FINISH
CEILINGS.

REACTIONS DO NOT EXCEED 5000lbs.
UPLIFTS DO NOT EXCEED 1000lbs.

NOTICE:
BACKCHARGES WILL NOT BE
ACCEPTED, REGARDLESS OF FAULT,
WITHOUT 48 HR. PRIOR NOTIFICATION
AND INSPECTION BY KIMAL LUMBER

BLDG PERMIT PLANS
FILE
Copy of Record

VERIFY ALL DIMENSIONS, CONDITIONS,
ETC. AND RETURN APPROVED COPY TO KIMAL LUMBER

SIGNED: _____ DATE: _____


REQUESTED/ESTIMATED DELIVERY DATE: _____

RECEIVED

APR 9 9 2024

TOWN OF LONGBEAT KEY
Planning, Zoning & Building

DESIGNED: 12/12/23 RT

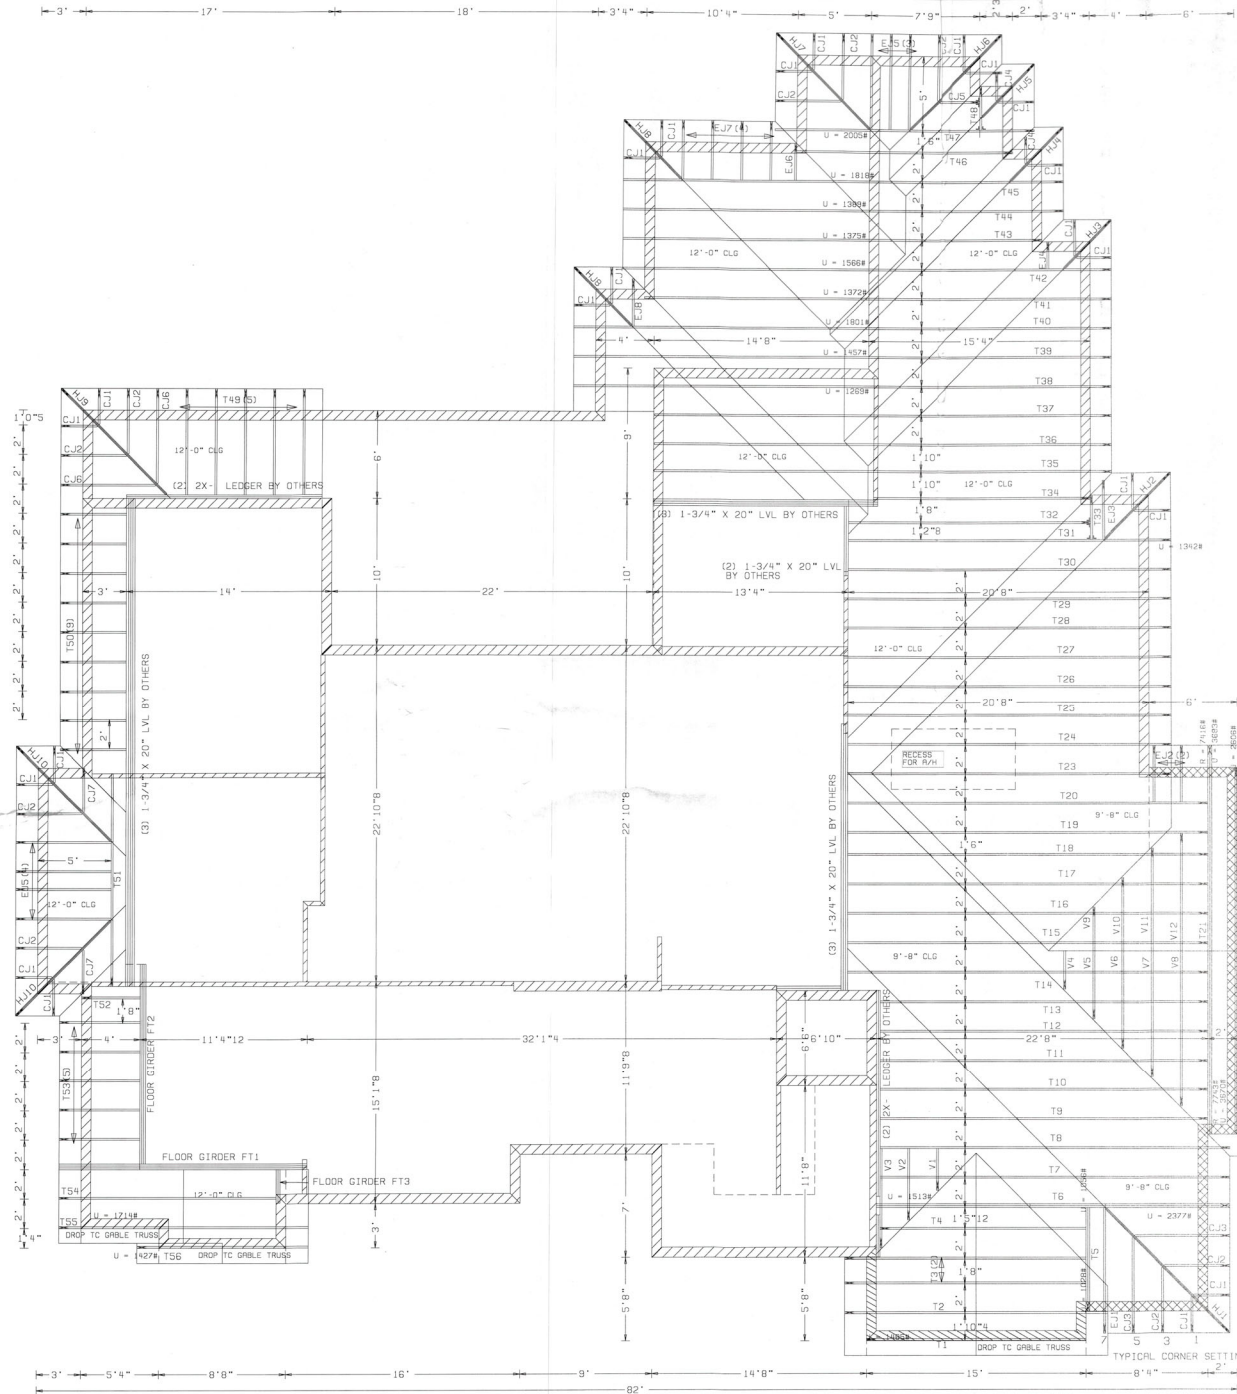


YODER HOMES LLC
LITTLE RESIDENCE
UPPER ROOF TRUSS LAYOUT
KJ 231020

KIMAL LUMBER AND HARDWARE
ENGINEERED WOOD PROD. DIV.
VENICE, FL
ALPINE ENGINEERING

4/12 TC PITCH
FLAT CEILING
2X6 TOP CHORD
1'-6" O.H. (PL)
7" BEARING
FBC2023 - 8TH EDITION
TPI 2014
45 PSF DESIGN LOAD
20 PSF TC/LL
15 PSF TC/DL
10 PSF BC/DL
(10PSF BC/LL NON-CONCURRENT)
1.25 DUR. FACTOR
ASCE7-22 WINDLOAD
200 MPH
EXPOSURE "D"
ENCLOSED
10PSF DEADLOAD TO RESIST UPLIFT

PRELIMINARY LAYOUT
FOR PERMIT ONLY

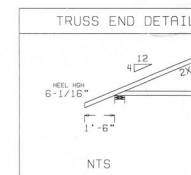

26'-3/4" ELEVAT.

CONVENTIONAL FRAMING REQUIRED TO FINISH
CEILINGS.

NOTICE:
BACKCHARGES WILL NOT BE
ACCEPTED, REGARDLESS OF FAULT,
WITHOUT 48 HR. PRIOR NOTIFICATION
AND INSPECTION BY KIMAL LUMBER

VERIFY ALL DIMENSIONS, CONDITIONS,
ETC. AND RETURN APPROVED COPY TO KIMAL LUMBER

SIGNED: _____ DATE: _____

REQUESTED/ESTIMATED DELIVERY DATE: _____

DESIGNED: 12/12/23 RT

BLDG PERMIT PL
FILE
Copy of Record

RECEIVED
APR 2 9 2024
TOWN OF LONGBOAT KEY
Planning, Zoning & Building

NPDES



YODER & HOMES
REMODELING
We Can Trust Our Experience

NPDES

1. THESE PLANS INCLUDE THE DETAILS AND NOTES SHOWING HOW COMPLIANCE WITH BEST MANAGEMENT PRACTICES (BMPs) WILL BE MAINTAINED THROUGHOUT THE LIFE OF THE PROJECT. BMPs WILL BE ACCORDING WITH THE 8 HOURS OF THE NATIONAL OILFIELD COMPLETION CENTER (NOCC) RECOMMENDATIONS FOR THE PROPOSED PROJECT. THE NOCC RECOMMENDATIONS FOR THE PROPOSED PROJECT ARE: FLOOD RESISTANT DESIGN, TOWNS OF LONDON, 600 AND 500 GAL WATER VENT OR 1000 GAL WATER VENT.
2. MECHANICAL, ELECTRICAL, PLUMBING EQUIPMENT WILL BE PLACED IN 6' ABOVE THE FLOOD PROTECTION ELEVATION AND WITH NO 25' TOWNS OF LONDON, 600 AND 500 GAL WATER VENT OR 1000 GAL WATER VENT.
3. FLOOD RESISTANT MATERIALS, ALL MATERIALS WILL BE SET IN 6' ABOVE THE FLOOD PROTECTION ELEVATION AND WITH NO 25' TOWNS OF LONDON, 600 AND 500 GAL WATER VENT OR 1000 GAL WATER VENT.
4. DRAINAGE RESISTANT MATERIALS, ALL MATERIALS WILL BE SET IN 6' ABOVE THE FLOOD PROTECTION ELEVATION AND WITH NO 25' TOWNS OF LONDON, 600 AND 500 GAL WATER VENT OR 1000 GAL WATER VENT.
5. THE LOWEST FLOOR WILL BE PLACED IN 6' ABOVE THE FLOOD PROTECTION ELEVATION AND WITH NO 25' TOWNS OF LONDON, 600 AND 500 GAL WATER VENT OR 1000 GAL WATER VENT.
6. THE BUILDING DESIGNER WILL BE RESPONSIBLE FOR THE DESIGN, LOW FLOOD ELEVATION WILL BE 11' ABOVE THE FLOOD PROTECTION ELEVATION AND WITH NO 25' TOWNS OF LONDON, 600 AND 500 GAL WATER VENT OR 1000 GAL WATER VENT.

[illegible]

SYMBOLS

A map of San Diego, California, showing the project location. The map is oriented with North at the top. A red dot marks the project location, with a black arrow pointing to it from the text "PROJECT LOCATION". The map shows the city grid, major roads, and the project location. The project location is in the northern part of the city, near the border with Imperial County. The map also shows the San Diego River and the San Diego Bay.

SCOPE OF WORK


[illegible]

NPDES

Printed # 1823-0143
 REVIEWED FOR CODE COMPLIANCE
 LONGBOAT KEY BUILDING DEPT.
 OCT 03 2023
 APPROVED
 [Signature]
 [Red line]
 RECEIVED

CONSTRUCTION TYPE V-B AND
OCCUPANCY R3-FBC 7TH EDITION (2020)

NPDES

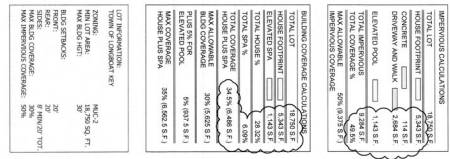

STAGING PLAN
SCALE: 1" = 20'

WATER MANAGEMENT PRACTICES WILL BE
IMPLEMENTED TO PREVENT POLLUTION
OF ADJACENT WATERSHEDS WITH
SPILLAGE AND RUNOFF.

BLDG PERMIT PLANS
FILE
Copy of Record

RECEIVED
JAN 13 2024
SARASOTA COUNTY
PLANNING & ZONING DEPARTMENT

LITTLE RESIDENCE
1001 LONGBOAT KEY CLUB RD
LONGBOAT KEY, FL

YODER & SONS
RESIDENTIAL
500 CENTRAL AVE.
SARASOTA, FL 34236
(941) 758-4028
LICENSE # CBC1254094

Jking
DESIGNS
1385 5th Street
Sarasota, FL 34236
(941) 465-0036

DO NOT SCALE
DIMENSIONS NOT
TO BE USED FOR
CONSTRUCTION
OR AS A RECORD

STAGING PLAN
ST-2



CONTRACTOR SHALL VISIT THE SITE AND ALLOW FOR ALL EXISTING CONDITIONS
HIS BID
IF NO HOSE BIBBS ARE CURRENTLY INSTALLED AT THE EXTERIOR OF THE HOUSE
NOTIFY DESIGNER IMMEDIATELY FOR LOCATION

[illegible][illegible]

WATER HEATER DRAIN PAN NOTES

[illegible][illegible]


ALL INFORMATION IS SUBJECT TO THE FOLLOWING CONDITIONS:

1. THIS INFORMATION IS PROVIDED FOR YOUR INFORMATION ONLY AND IS NOT TO BE USED FOR ANY OTHER PURPOSE.
2. THIS INFORMATION IS NOT TO BE DISCLOSED TO ANY OTHER PERSON OR ENTITY WITHOUT THE WRITTEN CONSENT OF THE ISSUING AGENCY.
3. THIS INFORMATION IS NOT TO BE USED FOR ANY PURPOSE OTHER THAN THAT FOR WHICH IT WAS PROVIDED.
4. THIS INFORMATION IS NOT TO BE REPRODUCED OR TRANSMITTED IN ANY FORM OR BY ANY MEANS, ELECTRONIC OR MECHANICAL, INCLUDING PHOTOCOPYING, RECORDING, OR BY ANY INFORMATION STORAGE AND RETRIEVAL SYSTEM.
5. THIS INFORMATION IS NOT TO BE USED FOR ANY PURPOSE OTHER THAN THAT FOR WHICH IT WAS PROVIDED.
6. THIS INFORMATION IS NOT TO BE DISCLOSED TO ANY OTHER PERSON OR ENTITY WITHOUT THE WRITTEN CONSENT OF THE ISSUING AGENCY.
7. THIS INFORMATION IS PROVIDED FOR YOUR INFORMATION ONLY AND IS NOT TO BE USED FOR ANY OTHER PURPOSE.

ALL INFORMATION IS SUBJECT TO THE FOLLOWING CONDITIONS:

1. THIS INFORMATION IS PROVIDED FOR YOUR INFORMATION ONLY AND IS NOT TO BE USED FOR ANY OTHER PURPOSE.
2. THIS INFORMATION IS NOT TO BE DISCLOSED TO ANY OTHER PERSON OR ENTITY WITHOUT THE WRITTEN CONSENT OF THE ISSUING AGENCY.
3. THIS INFORMATION IS NOT TO BE USED FOR ANY PURPOSE OTHER THAN THAT FOR WHICH IT WAS PROVIDED.
4. THIS INFORMATION IS NOT TO BE REPRODUCED OR TRANSMITTED IN ANY FORM OR BY ANY MEANS, ELECTRONIC OR MECHANICAL, INCLUDING PHOTOCOPYING, RECORDING, OR BY ANY INFORMATION STORAGE AND RETRIEVAL SYSTEM.
5. THIS INFORMATION IS NOT TO BE USED FOR ANY PURPOSE OTHER THAN THAT FOR WHICH IT WAS PROVIDED.
6. THIS INFORMATION IS NOT TO BE DISCLOSED TO ANY OTHER PERSON OR ENTITY WITHOUT THE WRITTEN CONSENT OF THE ISSUING AGENCY.
7. THIS INFORMATION IS PROVIDED FOR YOUR INFORMATION ONLY AND IS NOT TO BE USED FOR ANY OTHER PURPOSE.

| | |
|-----------------------------|---------------|
| GRAND TOTAL FLOOR HABITABLE | 3,346 SQ. FT. |
| UPPER FLOOR HABITABLE | 2,010 SQ. FT. |
| TOTAL HABITABLE SPACE | 5,336 SQ. FT. |
| GARAGE | 946 SQ. FT. |
| COVERED ENTRY | 151 SQ. FT. |
| COVERED LAUN. | 746 SQ. FT. |
| FRONT COVERED DECK | 152 SQ. FT. |
| UPPER COVERED DECK | 366 SQ. FT. |
| TOTAL UNDER ROOF | 7,736 SQ. FT. |

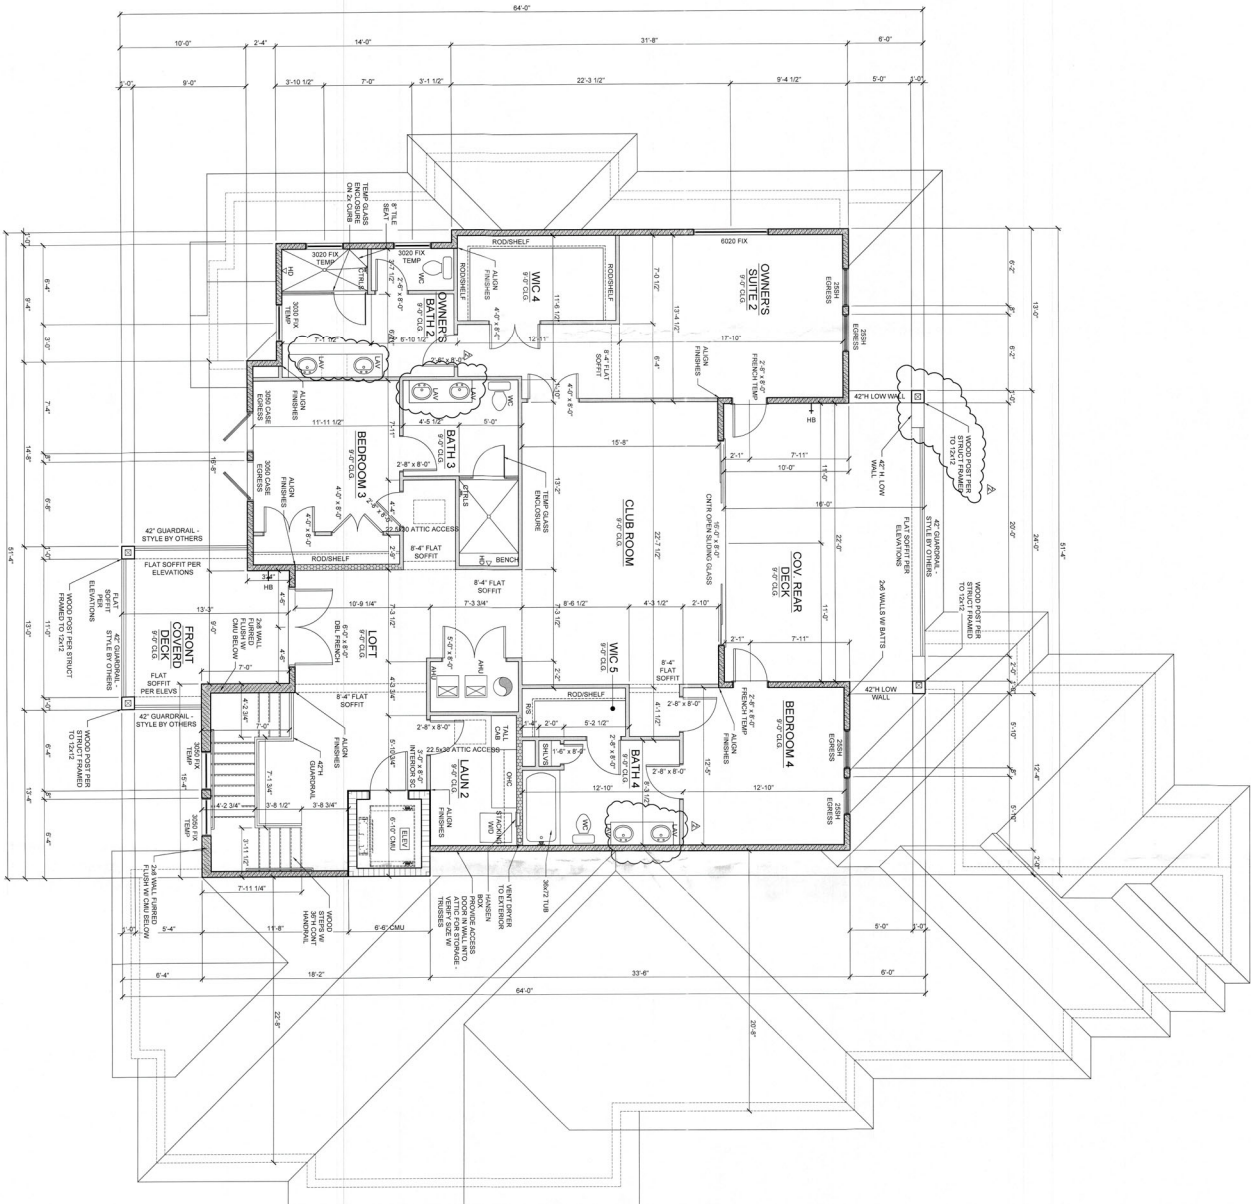

WALL LEGEND

- 3.5" W/ REINFORC. ST. 10 D WALL
- 5" W/ REINFORC. ST. 10 D WALL
- 7" W/ REINFORC. ST. 10 D WALL
- 8" W/ CASH WALL, 1/2" @ 16"
- 8" W/ CASH WALL, 1/2" @ 24"
- 8" W/ CASH WALL, 1/2" @ 48"
- 8" W/ CASH WALL, 3/4" @ 16"
- 8" W/ CASH WALL, 3/4" @ 24"
- 8" W/ CASH WALL, 3/4" @ 48"
- 5" W/ REINFORC. BARS 10 WALL

REQUIRED SAFETY GLAZING IN HAZ LOCATIONS

3. LOOK AT THE FOLLOWING TABLE. BE COMBINED GROUPS: HAYWARD
4. HAYWARD, CALIFORNIA
5. BURNED BY FIRE
6. BURNED BY FIRE
ROUGH OPENING NOTE

- [illegible]

AREA CALCULATIONS

| AREA CALCULATIONS | |
|------------------------|------------------|
| GROUND FLOOR HABITABLE | 3,341.90 SQ. FT. |
| UPPER FLOOR HABITABLE | 2,019.50 SQ. FT. |
| TOTAL HABITABLE SPACE | 5,361.40 SQ. FT. |
| GARAGE | |
| COVERED ENTRY | 841.50 SQ. FT. |
| COVERED PLANT | 151.50 SQ. FT. |
| FRONT COVERED DECK | 151.50 SQ. FT. |
| UPPER COVERED DECK | 351.50 SQ. FT. |
| TOTAL UNDER ROOF | 1,726.00 SQ. FT. |

BLDG PERMIT PLANS
FILE
Copy of Record

LITTLE RESIDENCE
1001 LONGBOAT KEY CLUB RD
LONGBOAT KEY, FL




500 CENTRAL AVE,
SARASOTA, FL 34236
(941) 758-4028
LICENSE # CBC1254094



DO NOT SCALE
DRAWINGS FOR
DIMENSIONS NOT
SHOWN CONTACT
PLAN COORDINATE
FOR CLARIFICATION

ROOF LAYOUT
SCALE: 1/4" = 1'-0"

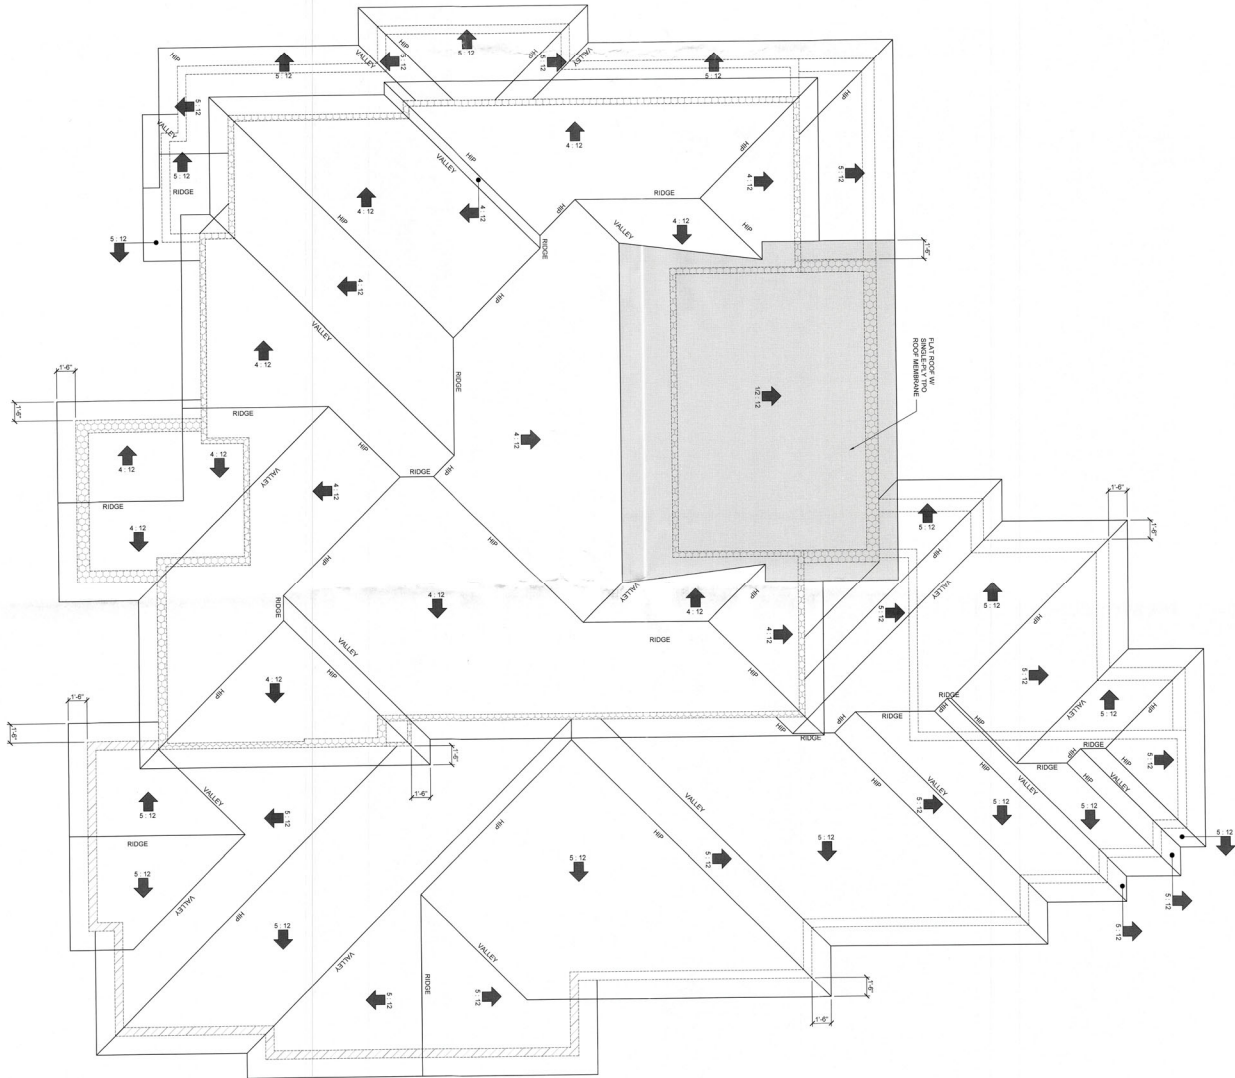

INDICATES BREAKING AT 12'-0" (NEW FINISHED FLOOR)
INDICATES BREAKING AT 22'-0" (NEW FINISHED FLOOR)
INDICATES BREAKING AT 8'-0" (NEW FINISHED FLOOR)

BUDG PERMIT PLANS
Copy of Record

RECEIVED
JAN 03 2020
TOWN OF LONGBOAT KEY
Planning & Zoning


LITTLE RESIDENCE
1001 LONGBOAT KEY CLUB RD
LONGBOAT KEY, FL

500 CENTRAL AVE.
SARASOTA, FL 34236
(941) 758-4028
LICENSE # CBC1254094


Jking
DESIGNS
1385 8th Street
Sarasota, FL 34236
(941) 465-0036

REVISIONS
DATE
BY
REASON
1
2
3
PROJECT NUMBER
AS

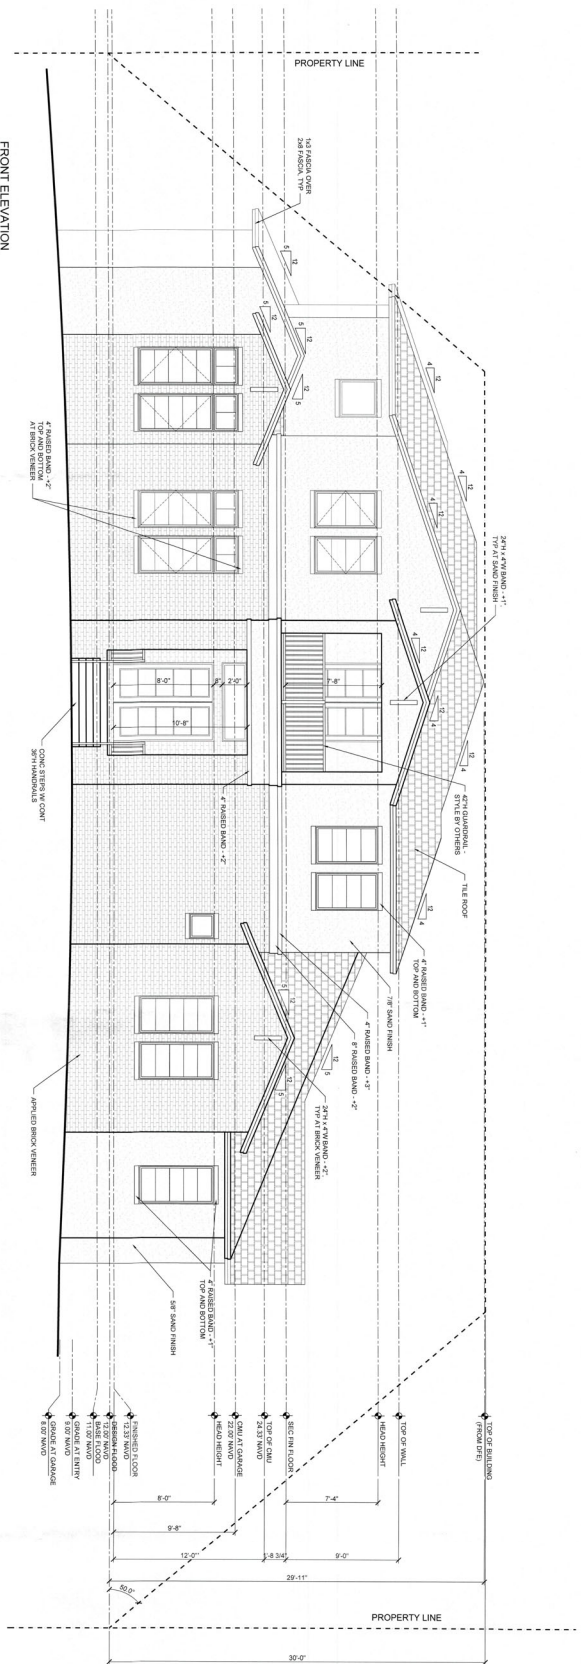

DO NOT SCALE
DRAWINGS FOR
DIMENSIONS NO
SHOWN CONTACT
PLAN COORDINATE
FOR CLARIFICATION

 500 CENTRAL AVE,
SARASOTA, FL 34236
(941) 758-4028
LICENSE # CBC1254094

RECEIVED
JAN 03 2024
TOWN OF LONGBOAT KEY
Sustaining, Zoning & Building

| | |
|---------------|------------|
| REVISION DATE | 12/07/2023 |
| ISSUE DATE | 07/11/2023 |
| COVER PAGE | |
| SHEET NUMBER | A6 |

[illegible][illegible]

- Jking**
DESIGNS
- 1385 5th Street
Sarasota, FL 34236
(91) 941.465.0036
- DESIGNING FOR
DIMENSIONS MOST
SHOWN CONTACT
PLAN COORDINATOR
FOR CLERK/CAHO



YODER & HOMES
▲ REMODELING ▲
You Can Trust Our Experience


△
△
△
△
△ GENERATOR
TENU - 07/6/2024

Jking
DESIGNS

1385 5th Street
Sarasota, FL 34234
(941) 465-0036

**DRAWINGS FOR
DIMENSIONS NOT
SHOWN CONTACT
PLAN COORDINATE
FOR CLARIFICATION**

| | | | |
|-----------------------------|--------------------------|------------|--------------------|
| REVISION DATE 12/07/2023 | ISSUE DATE 07/11/2023 | COVER PAGE | SHEET NUMBER A7 |
|-----------------------------|--------------------------|------------|--------------------|

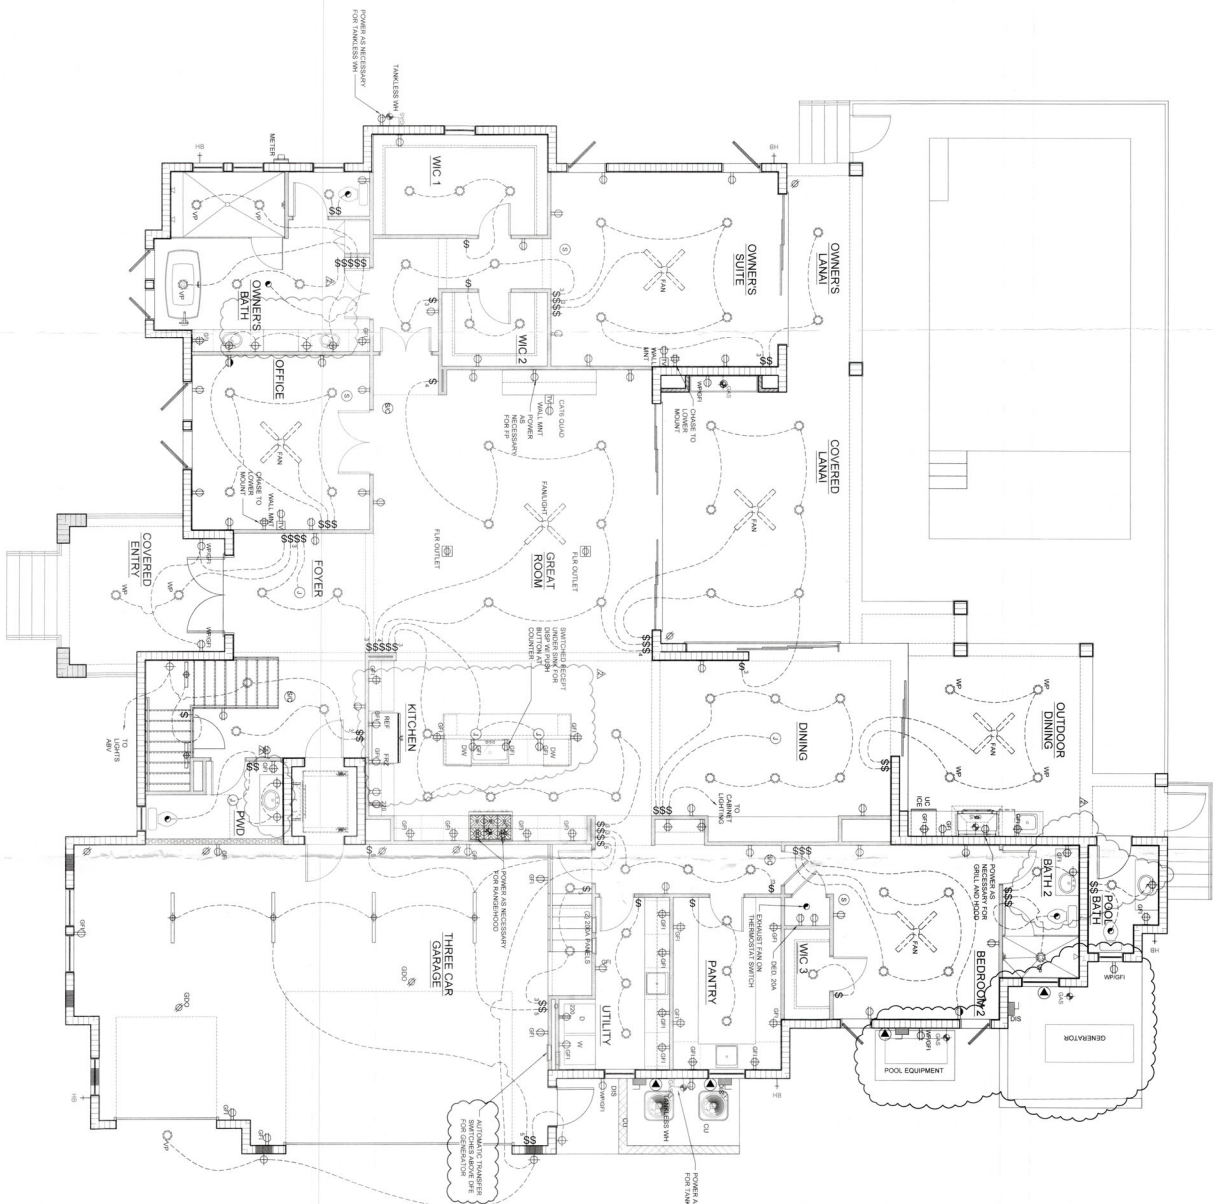

GENERAL ELECTRICAL NOTES

- [illegible]

ELECTRICAL SYMBOL KEY

[illegible]

LITTLE RESIDENCE
1001 LONGBOAT KEY CLUB RD
LONGBOAT KEY, FL



YODER & HOMES
REMODELING
You Can Trust Our Experience

500 CENTRAL AVE,
SARASOTA, FL 34236
(941) 758-4028
LICENSE # CBC1254094



Jking
DESIGNS


1385 5th Street
Sarasota, FL 34236
(O) 941.465.0036

DO NOT SCALE
DRAWINGS FOR
DIMENSIONS NOT
SHOWN CONTACT
PLAN COORDINATOR
FOR CLARIFICATION

RECEIVED

JUL 17 2024

E1

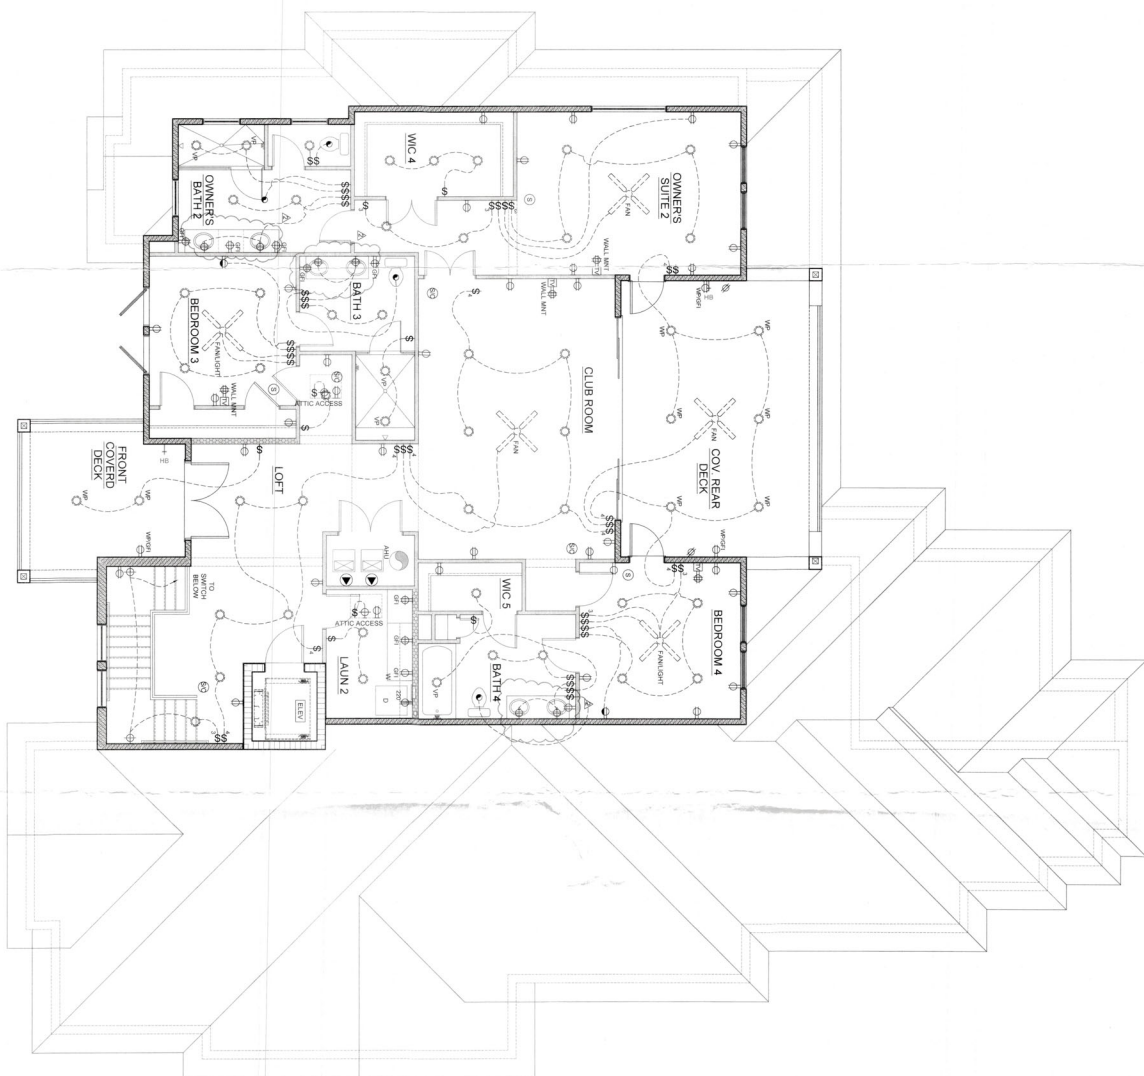

GENERAL ELECTRICAL NOTES

- [illegible]

ELECTRICAL SYMBOL KEY

[illegible]

LITTLE RESIDENCE
1001 LONGBOAT KEY CLUB RD
LONGBOAT KEY, FL



YODER & HOMES
REMODELING
You Can Trust Our Experience

500 CENTRAL AVE,
SARASOTA, FL 34236
(941) 758-4028
LICENSE # CBC1254094



1385 5th Street
Sarasota, FL 3423
(O) 941.465.0036

**DRAWINGS FOR
DIMENSIONS NOT
SHOWN CONTACT
PLAN COORDINATOR
FOR CLARIFICATION**

RECEIVED
JUL 17 2024
TOWN OF LONGSBATKEY
Planning, Zoning & Building
BLDG PERMIT PLANS
FILE
Copy of Record

| | | |
|-----------------------------|-------------------------------------|---------------------------|
| REVISION DATE 12/07/2023 | UPPER FLOOR ELECTRICAL LAYOUT | SHEET NUMBER E2 |
|-----------------------------|-------------------------------------|---------------------------|



SEE CONCRETE AND SOIL GENERAL NOTES SHEET 20.0 FOR ALL ADDITIONAL SPECIFICATIONS. ALL FTG. ASSIGNED TO BE ONE-STORY AND ON PLAN BT.

TWO-STORY MATCH

SLAB ON GROUND

1. MINIMUM COMPRESSIVE STRENGTH

2. MINIMUM THICKNESS

3. REINFORCED W/ EITHER:

For 2.500ps AT 28 DAYS

3/8"

5. SEE FOUNDATION DETAILS FOR FOOTING THICKNESS, WIDTH AND REINFORCEMENT.

6. REINFT SHALL BE MIN GRADE 60 AND LAPPED AS FOLLOWS:

| | MIN 2' LAP |
|----------|------------|
| 6. #6-4 | MIN 2' LAP |
| 7. #6-8 | MIN 2' LAP |
| 8. #6-10 | MIN 2' LAP |

7. COORDINATE REINFT BARS WITH OTHERS TO AVOID CORNER ANGLE.

8. PROVIDE REINFT SHALL EXCEED MINIMUM REQUIREMENTS.

9. PROVIDE REINFT ANCHOR CORNER REINFT AS REINFT PER REINFT ANCHOR CONNECTION DETAIL, SHEET 50-0.

STEMWALL FOUNDATIONS

9. ALL MASSIVE UNITS SHALL BE 8" NOMINAL WIDTH AND Laid IN RUNNING BOND PATTERN
10. SEE FOUNDATION DETAILS FOR ALL REINFT. SIZE AND SPACING
11. SEE FOUNDATION DETAILS FOR FLOOR, STORY AND SPACING
12. ALL VERTICAL DOWNES TO HAVE STANDARD HOOK AND THE INTO FOOTING REINFT.
13. ALL VERTICAL DOWNES SHALL EXTEND MIN. 22" OUT OF FOOTING TO LAP WITH VERTICAL REINFT.
14. VERTICAL REINFT TO HAVE STANDARD HOOK AND THE INTO CHAIR
15. REINFORCED BELLMAN HORIZONTAL REINFT.

| | |
|-----|---|
| F24 | 24'x24"x18" DEEP W/ (4) No. 4 CR (3) No. 5 EV |
| F30 | 30'x30"x18" DEEP W/ (3) No. 4 CR (4) No. 5 EV |
| F36 | 36'x36"x18" DEEP W/ (3) No. 4 CR (3) No. 5 EV |
| F40 | 40'x40"x20" DEEP W/ (3) No. 4 CR (3) No. 5 EV |

ROOFBOARD INSTALLATION PER MANUFACTURER'S SPECIFICATIONS
VENTS TO BE INSTALLED W/ BOTTOM OF VENT APPROXIM OF 12"
FROM FINISHED GRADE
EACH VENT PROVIDES 202 SQ FT OF HYPOVENTILATING RELIEF
VENTED AREAS. VENTS TO BE LOCATED ON AT LEAST 21 SEPARATE
WALLS
MIN 8" VENTS REQUIRED
ALL VENTS ABOVE FLOOD ELEVATION = 962.50 FT.
SEE ARCH PLAN FOR WALL LOCATIONS & DETAILS
1250.0 FOR STRUCTURAL
REINFORCEMENT WALL OPENINGS

FLOOD RESISTANT CONSTRUCTION

▲ FLOOD RESISTANT DESIGN
FLOOD ELEVATION (12'00") SHALL BE FLOOD DAMAGE RESISTANT MATERIALS PER FEMA TECHNICAL BULLETIN #2 AND FRC 322.18

▲ ELEVATOR COMPONENTS LOCATED BELOW DESIGN FLOOD ELEVATION (12'00") SHALL BE CONSTRUCTED WITH FLOOD DAMAGE-RESISTANT MATERIALS AND PROTECT PHYSICAL DAMAGE DURING FLOODING. (FRC 322.18)

▲ BUILDING HAS BEEN DESIGNED TO RESIST FLOODING COLLAPSE OR PERMANENT LATERAL MOVEMENT DUE TO STRUCTURAL FLOOD LOADING PER ASCE 24-14 & FRC 322.12

1001 LONGBOAT CLUB ROAD
LONGBOAT KEY, FL 34228
SARASOTA COUNTY

SHEET NUMBER

S0.1

SHEET NAME

PLAN

REVISIONS

| DATE | DESCRIPTION |
|------|-------------|
| | PLAN REVIEW |

| | |
|------------|---------------|
| 12-22-2023 | 71 COMMENTS |
| | SHORTENED INT |

| | |
|--|--|
| | |
| | |

| | |
|----------|--|
| DESIGNED | |
|----------|--|

| |
|----------|
| BDP |
| REVIEWED |

AKR

d

11
n
01
Me
la
VD #
258
V COSS
W
K BL
FL 32
SRC

us:
OV
M PA
LLE,
RUS

RR
TRA
ONV
3281

BAI
ACK
1-501

1324
P 90

PLATE 1

Copy of Record


1000

No. 91021


STATE OF
PRO

BENJAMIN D. PEARSON, I
FL LICENSE NO. 91021


C703.11-10

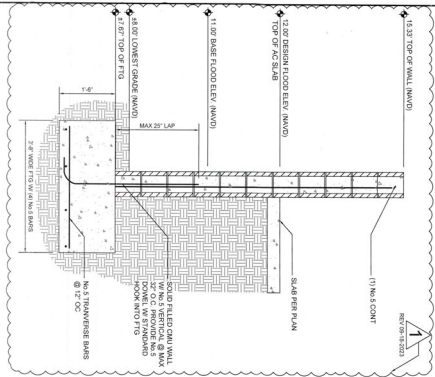


11. TYPICAL WALL FOOTING - MONOLITHIC (CMU)

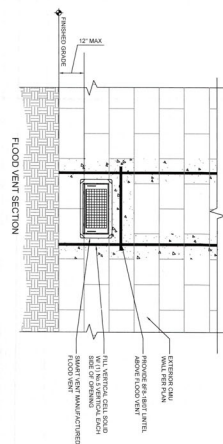


12. TYPICAL WALL FOOTING - MONOLITHIC (CMU)

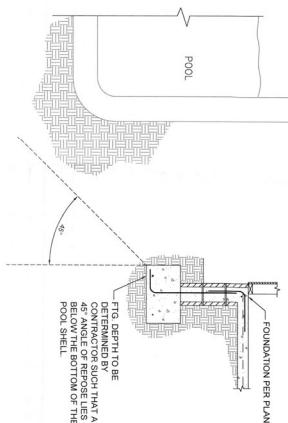


13. POOL INTERACTION DETAIL

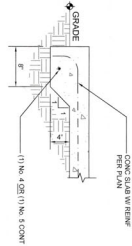


6. THICKENED EDGE FOOTING

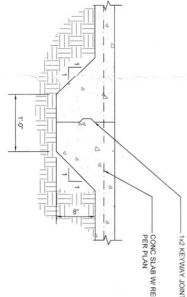


7. CONSTRUCTION JOINT

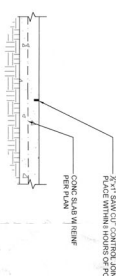


8. CONTROL JOINT

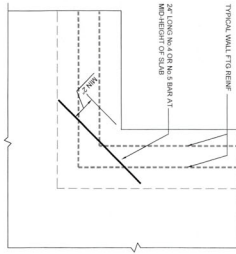


9. RE-ENTRANT CORNER REINFORCEMENT

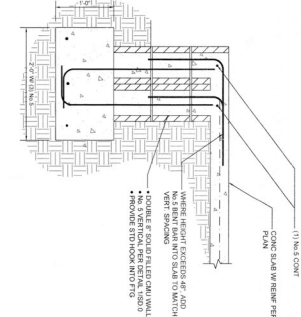


10. DBL STEMWALL DETAIL

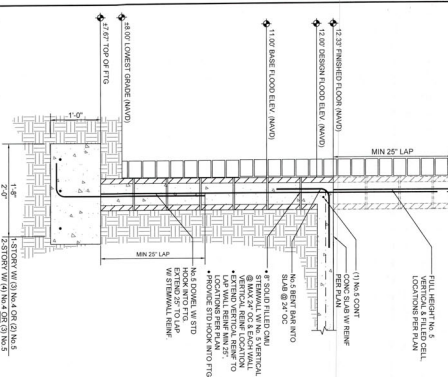


1. WALL FOOTING W/ BRICK

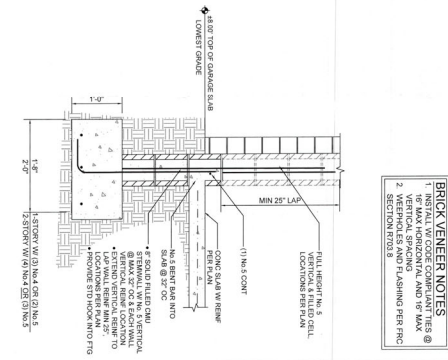


2. WALL FOOTING W/ CURB @ BRICK

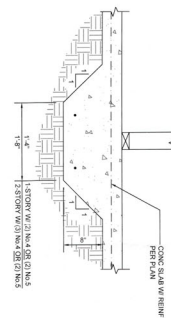

3. INTERIOR BEARING FOOTING

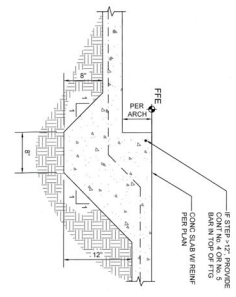

4. NON-BEARING CURB STEP

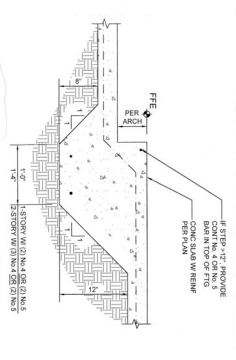

5. BEARING CURB STEP



Russell Rowland
13241 BARTRAM PARK BLVD #601
JACKSONVILLE, FL 32258
P 904-503-3283 RUSSROW@COM
C.A. No. 32756



PROJECT NUMBER
23-0736
SHEET NUMBER
SD.0
SHEET NAME
FOUNDATION
DETAILS
REVISIONS
DATE DESCRIPTION
9-18-2023 PLAN REVIEW
COMMENTS

LITTLE RESIDENCE
1001 LONGBOAT CLUB ROAD
LONGBOAT KEY, FL 34228
SARASOTA COUNTY



1. SEE BEAM SCHEDULES ON PLAN FOR SIZE AND REINFORCEMENT REQUIREMENTS.
2. ALL REINFORCEMENT SHALL BE MIN GRADE 60 (FY=60KSI) AND HAVE MIN 30' LAP WHERE APPLICABLE.
3. PROVIDE (2) NO. 5 STD. HOOK INTO ALL SUPPORTING MEMBERS.
4. LAP ALL BEAM CORNERS PER DETAIL 3023.

| BLKID # | COORD. BLKID SIZE | TOP AND BOTTOM | SIGNAL NAME (IF RECD) |
|---------|-------------------|---|--|
| B01 | FW 2.43 | (1) BT TOP (2) BT BOTTOM | BT STEERING @ MAX V _{OC} SPACING |
| B02 | FW 2.43 | (1) BT TOP (2) BT BT TOP (3) BT BT BOTTOM (4) BT TOTAL | BT STEERING @ MAX V _{OC} SPACING |
| B03 | FW 2.43 | (1) BT TOP (2) BT BT TOP (3) BT BT BOTTOM (4) BT TOTAL | BT STEERING @ MAX V _{OC} SPACING |

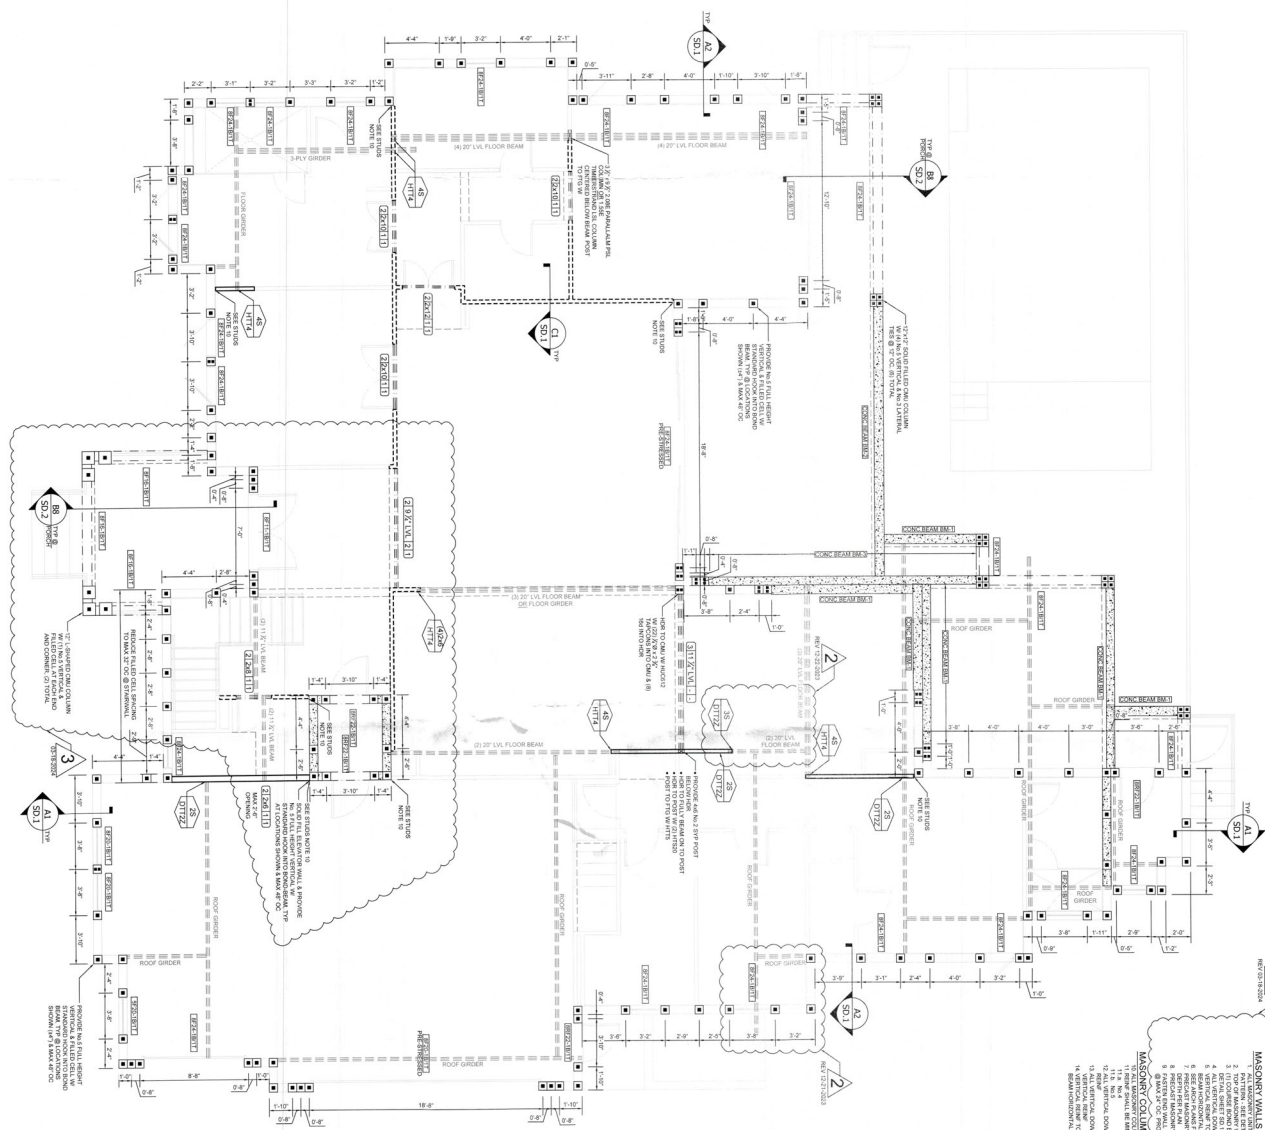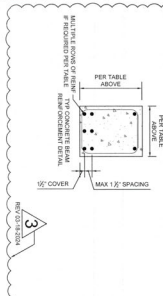

1. ALL MASONRY UNITS SHALL BE 8" NOMINAL WIDTH AND LAID IN RUNNING BOND PATTERN - SEE DETAILS SHEETS.
2. TOP OF MASONRY WALL PER ARCH PLANS
3. (1) COARSE IRON BEAM @ TOP OF ALL WALLS W/ (1) CONT. NO. 5, UNO. SEE DETAIL SHEET SD-1

4. ALL VERTICAL DOMES SHALL HAVE A MIN. 2" X 4" ANCHOR
5. ALL VERTICAL DOMES SHALL BE SET INTO STANDING ROCK OR BE REINFORCED
6. REINFORCEMENT SHALL BE 2" X 4" ANCHOR
7. REINFORCEMENT SHALL BE 2" X 4" ANCHOR
8. REINFORCEMENT SHALL BE 2" X 4" ANCHOR
9. REINFORCEMENT SHALL BE 2" X 4" ANCHOR
10. REINFORCEMENT SHALL BE 2" X 4" ANCHOR
11. REINFORCEMENT SHALL BE 2" X 4" ANCHOR
12. ALL VERTICAL DOMES SHALL BE SET INTO STANDING ROCK OR BE REINFORCED
13. REINFORCEMENT SHALL BE 2" X 4" ANCHOR
14. REINFORCEMENT SHALL BE 2" X 4" ANCHOR

OR 2" & AS6 (36KSI) ATR EPOXY ANCHOR W/ NOT AND 3" SQUARE x 0.225" WASHERS
2 ANCHORS TO BE INSTALLED EACH SIDE OF OPENING (MIN 6" FROM JACK GROUP), WITHIN 12" OF THE PLT BREAK AND @ MAX 48" OC. SEE NOTE 11
SHEARWALL ANCHOR SPACING

- STUDS**
1. FASTEN 1 IN. STUDS TO TOP AND BOTTOM TRACK WITH 16 D. NAILS
2. FASTEN 1/2 IN. STUDS TO TOP AND BOTTOM TRACK WITH 16 D. NAILS
3. FASTEN 1/4 IN. STUDS TO TOP AND BOTTOM TRACK WITH 16 D. NAILS
4. FASTEN 1/8 IN. STUDS TO TOP AND BOTTOM TRACK WITH 16 D. NAILS
5. FASTEN 1/16 IN. STUDS TO TOP AND BOTTOM TRACK WITH 16 D. NAILS
6. FASTEN 1/32 IN. STUDS TO TOP AND BOTTOM TRACK WITH 16 D. NAILS
7. FASTEN 1/64 IN. STUDS TO TOP AND BOTTOM TRACK WITH 16 D. NAILS
8. FASTEN 1/128 IN. STUDS TO TOP AND BOTTOM TRACK WITH 16 D. NAILS
93. FASTEN 1/495176015714152109

| | | |
|-----------------------|----------|------------------------------|
| EXTERIOR | V-1-1/8" | 2x6 @ 16 O.C. |
| INTERIOR LOAD BRG | ALL | 2x _L @ MAX 16" OC |
| INTERIOR NON-LOAD BRG | ALL | 2x _L @ MAX 24" OC |

13 FASTEN HEADER TO KIND STUDS PER THE FOLLOWING:

| | |
|---------------------------|-------------------------|
| a. 2x4 OR 2x6 HEADER | (f) 10 TOE NAILS OR FAC |
| b. 2x6 OR 2x8 HEADER | (g) 10 TOE NAILS OR FAC |
| c. 2x12 LSL OR LVL HEADER | (h) 10 TOE NAILS OR FAC |

14 NAIL (2) JACK STUDS REQ BETWEEN JOISTS. SEE DETAIL 94-505.

13. FASTEN HEADER TO KID STUDS PER THE FOLLOWING:
- | | |
|------------------------|-----------------------------|
| a. 2x4 OR 2x6 HEADER | (4) 10# TOE NAILS OR FASTER |
| b. 2x8 OR 2x10 HEADER | (4) 10# TOE NAILS OR FASTER |
| c. 2x12 OR 2x14 HEADER | (4) 10# TOE NAILS OR FASTER |
14. MIN. (2) JACK STUDS REQ. BETWEEN OPENINGS. SEE DETAIL BASIS.

| INSTALLATION SPECIFICATIONS | | MAX |
|-----------------------------|--------|-------|
| PLANK HOR | SIZE | CLEAR |
| | | SPAN |
| 2x4 | 3'-6" | |
| 2x6 | 5'-6" | |
| (2) 2x4 | 6'-4" | |
| (2) 2x6 | 7'-10" | |

54. BLOCKING AT ALL HORIZONTAL PAUL EDGES;
56. FASTEN BREATHING TO WALL FRAMING W/ 6d COMMON @ 6" OC
EDGES AND 12" OC IN THE FIELD. UNO ON PLAN
17. FASTEN BREATHING TO EACH STUD OF MULTIPLE STUD GROUP
KING STUD W/ 6d COMMON @ 12" OC

- SLATHING SHALL BE INSTALLED HORIZONTALLY OR VERTICALLY
SPACING AT ALL HORIZONTAL PANEL JOINTS
16" FASTEN BREATHING TO WALL FRAMING W/ 6d COMMON @ 6" OC
EEDS AND 12" OC IN THE FIELD. JOINTS ON PLAN
17" FASTEN BREATHING TO EACH STUD OR MULTIPLE STUD GROUP
KING STUD W/ 6d COMMON @ 12" OC

LOAD BRO WALL TWO UPLIFT
HDRBEAM
PRE-CAST INTEL

- | | |
|---|---------------------------|
|  | LOAD BERO WALL W/ UNFILT |
|  | LOAD BERO WALL W/O UNFILT |
| | HYDROEAM |
|  | PRE-CAST UNIT |

☒ FILLED CELL
☐ (2) No. 5 VERTICAL REINF. & FILLED CELL

- ☒ No. 5 VERTICAL REINF. & FILED CELL
- ☒ (2) No. 5 VERTICAL REINF. & FILED CELL

HEADER IPI LEFT CONNECTION CALLOUT

- 21206111
- NO. OF JACK STUDS
NO. OF KING STUDS
- HEADER LIP/ LEFT CONNECTION CALL OUT

—NO. OF HOLD-DOWN STRAPS
FRAMING BELOW
REQ.

- ```

 110102 TYPE OF STRAP REQ
 110102 → HOLLOWSTRAP TO
 110102 FRAMING BELOW
 110102 NO OF HOLLOWSTRAPS
 110102 REQ
 110102 → EXTEND UPPER LEVEL HOLD-DOWN
 110102 ANCHORS THROUGH FLOOR SYSTEM INTO

```

2S  
IF (4) SHOWN, (2) SHOWS 15000 HZ  
TOP PLT TO STUD  
2 CS18  
HOLD/DOWN/STRAP TO

- NO OF STUDS REQ. MATCH WALL  
WIDTH UNO  
IF (+) SHOW, (2) SPWC19500 REQ  
TOP PLET TO STUD  
2S  
CS18  
HOLD DOWN STRAP TO

**INTEL CALLOUT**

INTEL (WITH INCHES)

F = FILLED, R=RECESSED

INTEL DEPTH (INCHES)

INTEL BOTTOM HOLE

- 
- LINTEL WIDTH (INCHES)  
 F- FILLED, R-INCHESSED  
 LINTEL DEPTH (INCHES)  
 LINTEL TYPE (see page 100)

| SIZE OF<br>STEEL ANGLE | NO STORY<br>ABOVE | 1 STORY<br>ABOVE | 2 STORES<br>ABOVE |
|------------------------|-------------------|------------------|-------------------|
|------------------------|-------------------|------------------|-------------------|

- | STEEL BRICK LINTEL SPAN SCHEDULE |                   |                  |                   |
|----------------------------------|-------------------|------------------|-------------------|
| SIZE OF<br>STEEL ANGLE           | NO STORY<br>ABOVE | 1 STORY<br>ABOVE | 2 STORES<br>ABOVE |

| 6"x6"x1/2"                                                                                                                                                                               | 16"x6" | 10"x6" | 8"x6" |
|------------------------------------------------------------------------------------------------------------------------------------------------------------------------------------------|--------|--------|-------|
| <p><b>INTEL NOTES</b></p> <p>1. ALL STEEL UNITS TO BE MIN A36 STEEL (Y = 36 KS)</p> <p>2. UNITS SHALL BE COATED W/ RUST-INHIBITIVE PAINT OR OTHER CODE APPROVED CORROSION PROTECTION</p> |        |        |       |

- | UNIT NOTES                                                                                    |        |        |
|-----------------------------------------------------------------------------------------------|--------|--------|
| 1. ALL STEEL UNITS TO BE MIN. AS STEEL (Y = 36 ksi)                                           | 14'-0" | 9'-0"  |
| 2. UNITS SHALL BE COATED W/ RUST-INHIBITIVE PAINT OR OTHER CODE APPROVED CORROSION PROTECTION | 16'-0" | 10'-0" |

**BRICK VENEER NOTES**

1. INSTALL W/ CODE COMPLIANT TIES @ 16" MAX HORIZONTAL AND 16" MAX VERTICAL SPACING

- BRICK VENEER NOTES**
1. INSTALL W/ CODE COMPLIANT TIES @  
16" MAX HORIZONTAL AND 16" MAX  
VERTICAL SPACING

PRINTED COPIES OF THIS DOCUMENT  
CONSIDERED SIGNED AND SEALED

- THIS ITEM HAS BEEN DIGITALLY SIGNED  
BY BENJAMIN D. PEARSON, PE ON  
DIGITAL SIGNATURE.

LITTLE RESIDENCE  
001 LONGBOAT CLUB ROAD  
LONGBOAT KEY, FL 34228  
SARASOTA COUNTY




Russell  
Rowland

13241 BARTRAM PARK BLVD #601  
JACKSONVILLE, FL 32258  
P 904-503-3283 RUSSROW.COM  
C A No. 32756



BLDG PERMIT PLANS  
FILE  
Copy of Record




Beginnings of Plastic



BENJAMIN D. PEARSON, PE

FL LICENSE NO. 91021  
07-11-2023

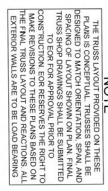

[illegible]

**Russell Rowland**  
13241 BARTRAM PARK BLVD #601  
JACKSONVILLE, FL 32258  
P 904-503-3283 RUSSROW.COM  
C.A. No. 32756


**Copy of Record  
FILE**

*Signature of licensee*

**BENJAMIN D. PEARSON  
FLORIDA  
PROFESSIONAL ENGINEER  
STATE OF  
No. 91021  
LICENSE**

**BENJAMIN D. PEARSON, PE  
FL LICENSE NO. 91021  
07-11-2023**

LITTLE RESIDENCE  
1001 LONGBOAT CLUB ROAD  
LONGBOAT KEY, FL 34228  
SARASOTA COUNTY



**YODER & HOMES**  
▲ REMODELING ▲  
*You Can Trust Our Experience*

## Scale: 1/4"=1'-0"



## 3

## MASONRY NOTES

1. WINDOW SILL  
2. WINDOW JAMB  
3. WINDOW HEAD  
4. WINDOW FRAME  
5. WINDOW GLASS  
6. WINDOW SEALS  
7. WINDOW COORDINATES  
8. WINDOW COORDINATES  
FRAMING NOTES:

[illegible]

**HEADER FRAMING**  
11. SEE FRAMING PLAN

REPLENISHMENTS. SEE JOHN CALLOUT BELOW FOR ADDITIONAL INFORMATION.  
 12 FASTENERS ALL PLIES OF JOINT TOGETHER W/ 21 ROWS 10d @ 12" OC STRIPS  
 13 FASTENER HEADER TO KING STUDS PER THE FOLLOWING:  
     a. 2x4 OR 2x6 HEALER  
     b. 2x6 OR 2x10 HEADER  
     c. 2x12, 12x8 OR 1x1 HEADER  
 14 NAIL 21 JACK STUDS INTO BETWEEN OPENINGS. SEE DETAIL, PAGED 1 FOR  
 INSTALLATION SPECIFICATIONS

| PLANK HDR<br>SIZE | MOCK<br>CLEAR<br>SPAN |
|-------------------|-----------------------|
| 2x4               | 3' 6"                 |
| 2x6               | 6' 6"                 |
| (2) 2x4           | 6' 4"                 |
| (2) 2x6           | 7' 10"                |

WALL SHEATHING

| PASADENE | LEVEL   | REC'D<br>END | HS GROSS<br>STAYING REG<br>EACH REG | NOTION T<br>SPENDING<br>SPENDING |
|----------|---------|--------------|-------------------------------------|----------------------------------|
| MORT 1A  | LEVEL 1 | 2            | 111.75                              | 48.00                            |
| MORT 1B  | LEVEL 1 | 2            | 117.14                              | 47.00                            |
| MORT 1C  | LEVEL 1 | 2            | 121.18                              | 47.00                            |
| MORT 1D  | LEVEL 1 | 2            | 121.18                              | 47.00                            |
| MORT 1E  | LEVEL 1 | 2            | 121.18                              | 47.00                            |
| MORT 1F  | LEVEL 1 | 2            | 121.18                              | 47.00                            |
| MORT 1G  | LEVEL 1 | 2            | 121.18                              | 47.00                            |
| MORT 1H  | LEVEL 1 | 2            | 121.18                              | 47.00                            |
| MORT 1I  | LEVEL 1 | 2            | 121.18                              | 47.00                            |
| MORT 1J  | LEVEL 1 | 2            | 121.18                              | 47.00                            |
| MORT 1K  | LEVEL 1 | 2            | 121.18                              | 47.00                            |
| MORT 1L  | LEVEL 1 | 2            | 121.18                              | 47.00                            |
| MORT 1M  | LEVEL 1 | 2            | 121.18                              | 47.00                            |
| MORT 1N  | LEVEL 1 | 2            | 121.18                              | 47.00                            |
| MORT 1O  | LEVEL 1 | 2            | 121.18                              | 47.00                            |
| MORT 1P  | LEVEL 1 | 2            | 121.18                              | 47.00                            |
| MORT 1Q  | LEVEL 1 | 2            | 121.18                              | 47.00                            |
| MORT 1R  | LEVEL 1 | 2            | 121.18                              | 47.00                            |
| MORT 1S  | LEVEL 1 | 2            | 121.18                              | 47.00                            |
| MORT 1T  | LEVEL 1 | 2            | 121.18                              | 47.00                            |
| MORT 1U  | LEVEL 1 | 2            | 121.18                              | 47.00                            |
| MORT 1V  | LEVEL 1 | 2            | 121.18                              | 47.00                            |
| MORT 1W  | LEVEL 1 | 2            | 121.18                              | 47.00                            |
| MORT 1X  | LEVEL 1 | 2            | 121.18                              | 47.00                            |
| MORT 1Y  | LEVEL 1 | 2            | 121.18                              | 47.00                            |
| MORT 1Z  | LEVEL 1 | 2            | 121.18                              | 47.00                            |
| MORT 2A  | LEVEL 2 | 2            | 121.18                              | 47.00                            |
| MORT 2B  | LEVEL 2 | 2            | 121.18                              | 47.00                            |
| MORT 2C  | LEVEL 2 | 2            | 121.18                              | 47.00                            |
| MORT 2D  | LEVEL 2 | 2            | 121.18                              | 47.00                            |
| MORT 2E  | LEVEL 2 | 2            | 121.18                              | 47.00                            |
| MORT 2F  | LEVEL 2 | 2            | 121.18                              | 47.00                            |
| MORT 2G  | LEVEL 2 | 2            | 121.18                              | 47.00                            |
| MORT 2H  | LEVEL 2 | 2            | 121.18                              | 47.00                            |
| MORT 2I  | LEVEL 2 | 2            | 121.18                              | 47.00                            |
| MORT 2J  | LEVEL 2 | 2            | 121.18                              | 47.00                            |
| MORT 2K  | LEVEL 2 | 2            | 121.18                              | 47.00                            |
| MORT 2L  | LEVEL 2 | 2            | 121.18                              | 47.00                            |
| MORT 2M  | LEVEL 2 | 2            | 121.18                              | 47.00                            |
| MORT 2N  | LEVEL 2 | 2            | 121.18                              | 47.00                            |
| MORT 2O  | LEVEL 2 | 2            | 121.18                              | 47.00                            |
| MORT 2P  | LEVEL 2 | 2            | 121.18                              | 47.00                            |
| MORT 2Q  | LEVEL 2 | 2            | 121.18                              | 47.00                            |
| MORT 2R  | LEVEL 2 | 2            | 121.18                              | 47.00                            |
| MORT 2S  | LEVEL 2 | 2            | 121.18                              | 47.00                            |
| MORT 2T  | LEVEL 2 | 2            | 121.18                              | 47.00                            |
| MORT 2U  | LEVEL 2 | 2            | 121.18                              | 47.00                            |
| MORT 2V  | LEVEL 2 | 2            | 121.18                              | 47.00                            |
| MORT 2W  | LEVEL 2 | 2            | 121.18                              | 47.00                            |
| MORT 2X  | LEVEL 2 | 2            | 121.18                              | 47.00                            |
| MORT 2Y  | LEVEL 2 | 2            | 121.18                              | 47.00                            |
| MORT 2Z  | LEVEL 2 | 2            | 121.18                              | 47.00                            |
| MORT 3A  | LEVEL 3 | 2            | 121.18                              | 47.00                            |
| MORT 3B  | LEVEL 3 | 2            | 121.18                              | 47.00                            |
| MORT 3C  | LEVEL 3 | 2            | 121.18                              | 47.00                            |
| MORT 3D  | LEVEL 3 | 2            | 121.18                              | 47.00                            |
| MORT 3E  | LEVEL 3 | 2            | 121.18                              | 47.00                            |
| MORT 3F  | LEVEL 3 | 2            | 121.18                              | 47.00                            |
| MORT 3G  | LEVEL 3 | 2            | 121.18                              | 47.00                            |
| MORT 3H  | LEVEL 3 | 2            | 121.18                              | 47.00                            |
| MORT 3I  | LEVEL 3 | 2            | 121.18                              | 47.00                            |
| MORT 3J  | LEVEL 3 | 2            | 121.18                              | 47.00                            |
| MORT 3K  | LEVEL 3 | 2            | 121.18                              | 47.00                            |
| MORT 3L  | LEVEL 3 | 2            | 121.18                              | 47.00                            |
| MORT 3M  | LEVEL 3 | 2            | 121.18                              | 47.00                            |
| MORT 3N  | LEVEL 3 | 2            | 121.18                              | 47.00                            |
| MORT 3O  | LEVEL 3 | 2            | 121.18                              | 47.00                            |
| MORT 3P  | LEVEL 3 | 2            | 121.18                              | 47.00                            |
| MORT 3Q  | LEVEL 3 | 2            | 121.18                              | 47.00                            |
| MORT 3R  | LEVEL 3 | 2            | 121.18                              | 47.00                            |
| MORT 3S  | LEVEL 3 | 2            | 121.18                              | 47.00                            |
| MORT 3T  | LEVEL 3 | 2            | 121.18                              | 47.00                            |
| MORT 3U  | LEVEL 3 | 2            | 121.18                              | 47.00                            |
| MORT 3V  | LEVEL 3 | 2            | 121.18                              | 47.00                            |
| MORT 3W  | LEVEL 3 | 2            | 121.18                              | 47.00                            |
| MORT 3X  | LEVEL 3 | 2            | 121.18                              | 47.00                            |
| MORT 3Y  | LEVEL 3 | 2            | 121.18                              | 47.00                            |
| MORT 3Z  | LEVEL 3 | 2            | 121.18                              | 47.00                            |

LEGEND & SYMBOLS

 LOAD BRG WALL W/ UPLIFT  
 LOAD BRG WALL W/O UPLIFT  
 HOORBEAM  
 PRE-CAST LINTEL  
 INTERIOR CHAM WALL (SEE MASSWORK NOTE)  
 EX. FOUNDATION

HEADER CALLOUT

**HEADER UPLIFT CONNECTION CALLOUT**

1 No. OF HORN PULLS  
2 HDR SIZE  
3 No. OF JACK STUDS  
4 No. OF KING STUDS  
5 No. OF HORN TO JACK STRAPS REQ  
6 STRAPS REQ

REF  
"EXTEND UPPER LEVEL HOLD-  
ANCHORS THROUGH FLOOR SYSTEM  
MAINTAINING ANCHORING

**STUD GROUP CALLOUT**

NO. OF STUDS REQ. SWITCH WALL  
IF (1) SHOWN, (2) SPACED 1550 REQ.  
TOP FL. TO STUD

HOLD-DOWN STRAP TO  
FRAMING BELOW

NO. OF HOLD-DOWN STRAPS  
REQ.

UNTEL WIDTH (INCHES)  
F= FILLED, R=RECESSED  
UNTEL DEPTH (INCHES)  
NO. OF PORTS

Diagram of a 16-bit register. The register is represented as a horizontal bar with 16 input lines. The top 5 lines are labeled "LOW 5 BITS" and the bottom 11 lines are labeled "NO. OF TOP NO. 2 BITS".



LITTLE RESIDENCE  
1001 LONGBOAT CLUB ROAD  
LONGBOAT KEY, FL 34228  
SARASOTA COUNTY

PROJECT NUMBER  
23-0736  
SHEET NUMBER  
S2.0

## 2ND LEVEL FRAMING

| DATE       | DESCRIPTION                                               |
|------------|-----------------------------------------------------------|
| 03-18-2024 | <div> <div>3</div> <div>UPDATE MISSION NOTES</div> </div> |

|          |  |  |  |
|----------|--|--|--|
| DECEMBER |  |  |  |
|----------|--|--|--|

REVIEWED  
AKR


ell  
and  
#601  
OM

MISS  
OW.  
PARK BLV  
LE, FL 32  
RUSSROW  
32756

1 BARTRA  
ACKSON  
4-503-328  
C.A.

13  
PRECEIVED  
MAR 19 2024RECEIVED  
MAR 19 2024



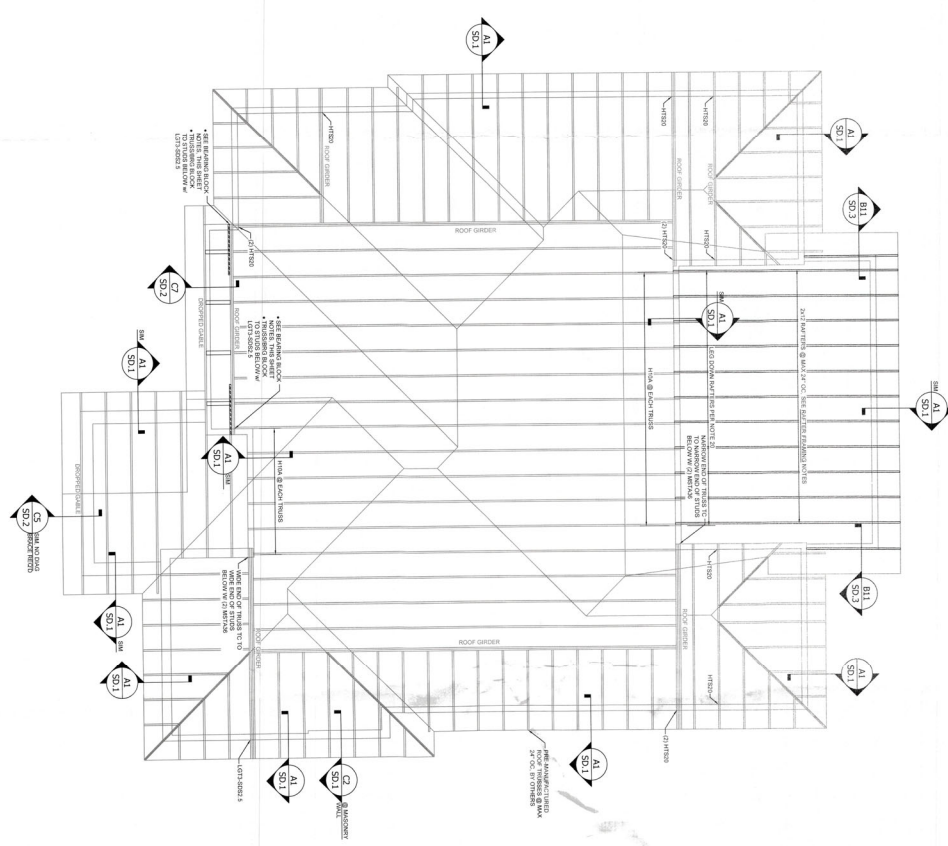

**NOTE:**  
THE TRUSS LAYOUT SHOWN ON THESE PLANS IS CONCEPTUAL. TRUSSES SHALL BE DESIGNED BY A QUALIFIED ENGINEER. THE SPACING OF LAYOUT SHOWN ON FINAL TRUSSES TO BE FOR APPROVAL PRIOR TO CONSTRUCTION. ECR RESERVES THE RIGHT TO THE FINAL TRUSS LAYOUT AND REVISIONS. ALL EXTENSION WALLS ARE TO BE CONSIDERED.

**2.1 2ND LEVEL ROOF PLAN**  
Scale: 1/4" = 1'-0"

**TRUSS FRAMING NOTES:**

1. TRUSS LAYOUT SHALL BE TOP OF TRUSS TO 1/2" TYP. WALLS.
2. TRUSS LAYOUT SHALL BE TOP OF TRUSS TO 1/2" TYP. WALLS.
3. TRUSS LAYOUT SHALL BE TOP OF TRUSS TO 1/2" TYP. WALLS.
4. TRUSS LAYOUT SHALL BE TOP OF TRUSS TO 1/2" TYP. WALLS.

**ROOF SHEETING**

ROOF SHEETING SHALL BE INSTALLED ON CHANGING TRUSS JOINTS. SHEETING SHALL BE INSTALLED ON CHANGING TRUSS JOINTS. SHEETING SHALL BE INSTALLED ON CHANGING TRUSS JOINTS.

**OVERLAPPING NOTES**

OVERLAPPING NOTES SHALL BE INSTALLED ON CHANGING TRUSS JOINTS. OVERLAPPING NOTES SHALL BE INSTALLED ON CHANGING TRUSS JOINTS. OVERLAPPING NOTES SHALL BE INSTALLED ON CHANGING TRUSS JOINTS.

**BEARING BLOCK NOTES - No. 2 SYP**

BEARING BLOCK NOTES SHALL BE INSTALLED ON CHANGING TRUSS JOINTS. BEARING BLOCK NOTES SHALL BE INSTALLED ON CHANGING TRUSS JOINTS. BEARING BLOCK NOTES SHALL BE INSTALLED ON CHANGING TRUSS JOINTS.

| SPACING | 2x6 | 2x8 | 2x10 | 2x12 |
|---------|-----|-----|------|------|
| 16"     | 16" | 16" | 16"  | 16"  |
| 24"     | 24" | 24" | 24"  | 24"  |
| 32"     | 32" | 32" | 32"  | 32"  |

**TRUSS FRAMING NOTES - No. 2 SYP**

TRUSS FRAMING NOTES SHALL BE INSTALLED ON CHANGING TRUSS JOINTS. TRUSS FRAMING NOTES SHALL BE INSTALLED ON CHANGING TRUSS JOINTS. TRUSS FRAMING NOTES SHALL BE INSTALLED ON CHANGING TRUSS JOINTS.



**LITTLE RESIDENCE**  
1001 LONGBOAT CLUB ROAD  
LONGBOAT KEY, FL 34228  
SARASOTA COUNTY




|                |                |
|----------------|----------------|
| PROJECT NUMBER | 23-0736        |
| SHEET NUMBER   | S2.1           |
| SHEET NAME     | 2ND LEVEL ROOF |
| REVISIONS      |                |
| DATE           |                |
| DESCRIPTION    |                |
| DESIGNED       | BDP            |
| REVIEWED       | AKR            |

**Russell Rowland**  
13241 BARTRAM PARK BLVD #601  
JACKSONVILLE, FL 32258  
P 904-503-3283  
C.A. No. 32756

**RECEIVED**  
MAY 13 2024  
TOWN OF LONGBOAT KEY  
COMMUNITY DEVELOPMENT  
FL LICENSE NO. 91021  
BENJAMIN D. PEARSON, PE  
07-11-2023





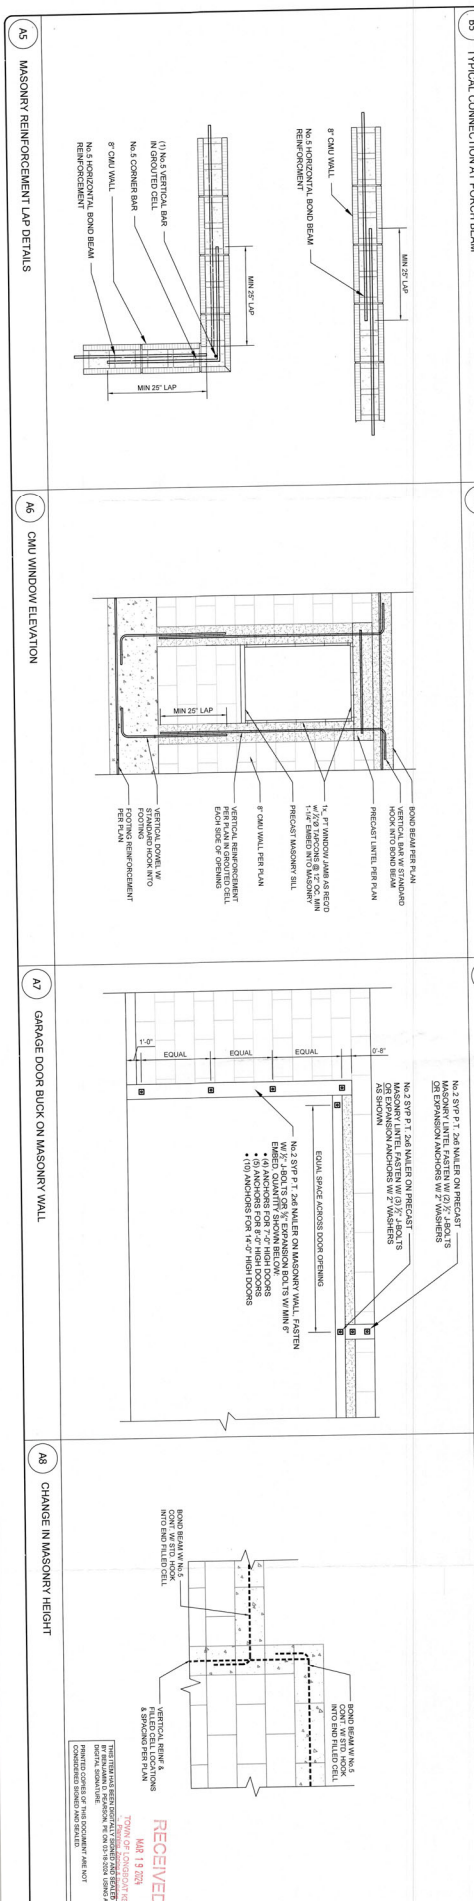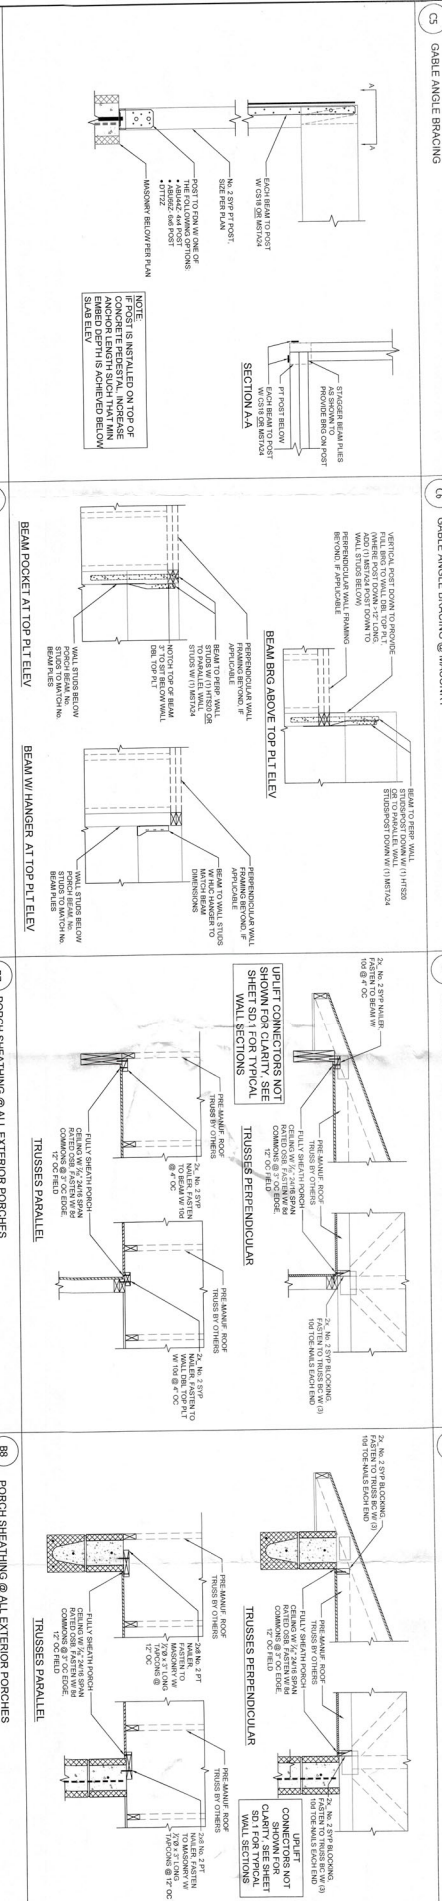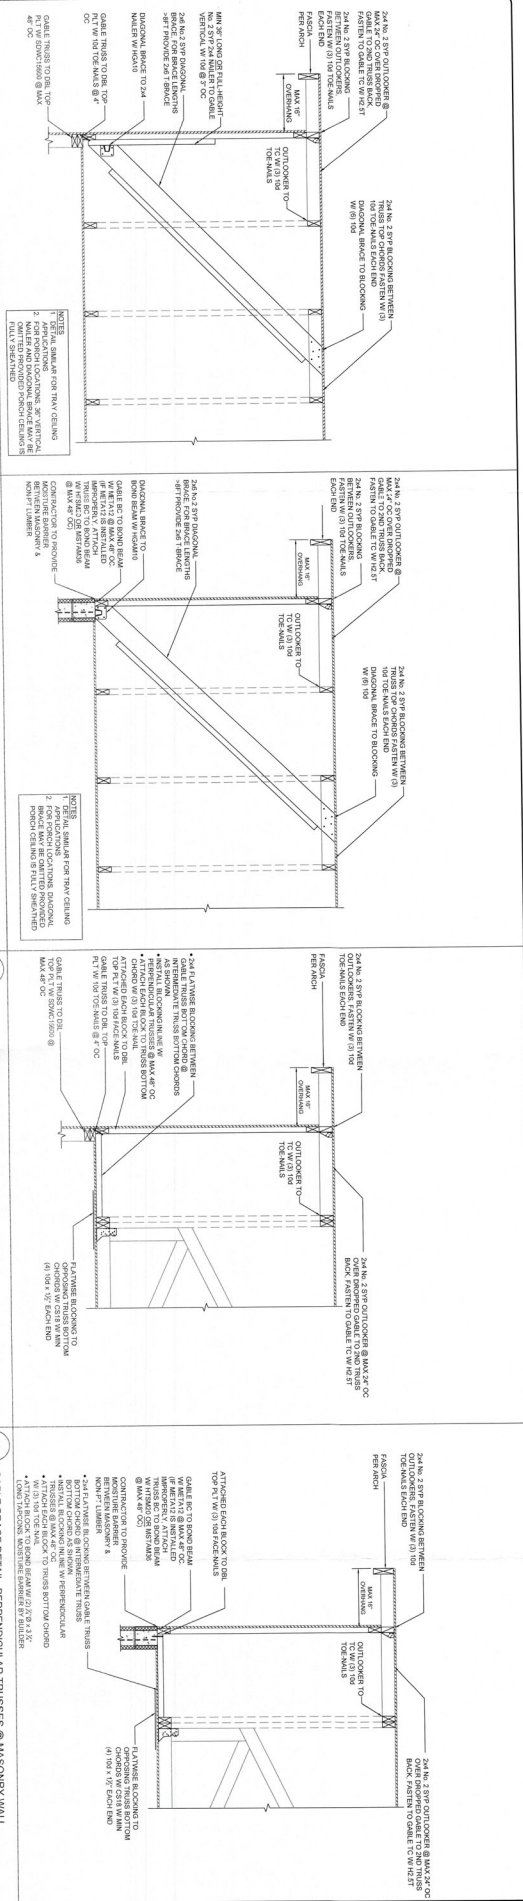

**REVISIONS**

| DATE | DESCRIPTION |
|------|-------------|
|      |             |

DESIGNED: BDP  
REVIEWED: AKR

**PROJECT NUMBER**  
23-0736

**SHEET NUMBER**  
SD 2

**SHEET NAME**  
DETAILS

**LITTLE RESIDENCE**

1001 LONGBOAT CLUB ROAD  
LONGBOAT KEY, FL 34228  
SARASOTA COUNTY

**Russell Rowland**

13241 BARTRAM PARK BLVD #001  
JACKSONVILLE, FL 32218  
P 904-503-8833 RUSSROW.COM  
C.A. No. 32756

**YODER & HOMES**

REMODELING


You Can Trust Our Experience

**RECEIVED**


MAR 19 2024

TOWN OF LONGBOAT KEY


THIS DRAWING IS THE PROPERTY OF YODER & HOMES REMODELING. IT IS TO BE USED ONLY FOR THE PROJECT AND SITE SPECIFICALLY IDENTIFIED HEREON. IT IS NOT TO BE REPRODUCED, COPIED, OR TRANSMITTED IN ANY FORM OR BY ANY MEANS, ELECTRONIC OR MECHANICAL, INCLUDING PHOTOCOPYING, RECORDING, OR BY ANY INFORMATION STORAGE AND RETRIEVAL SYSTEM, WITHOUT THE WRITTEN PERMISSION OF YODER & HOMES REMODELING.

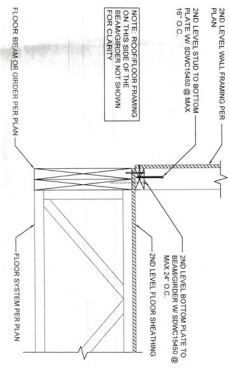


C9 UPPER LEVEL WALL ABOVE BEAM/SLIDER

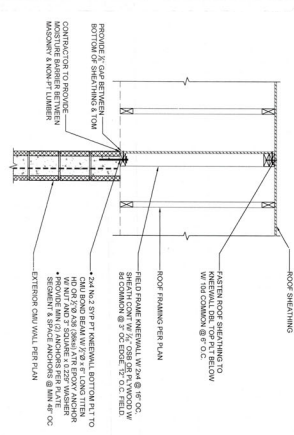


C10 KNEE WALL FRAMING DETAIL

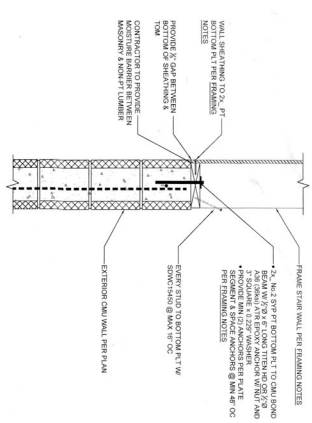


B9 EXTERIOR STAIR WALL @ CMU

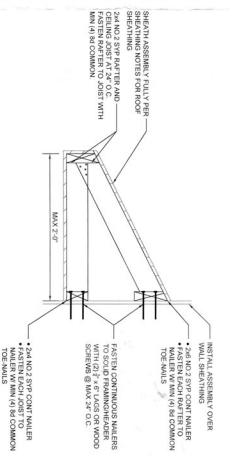


B10 FIELD-FRAMED SHED ROOF - MAX 2FT

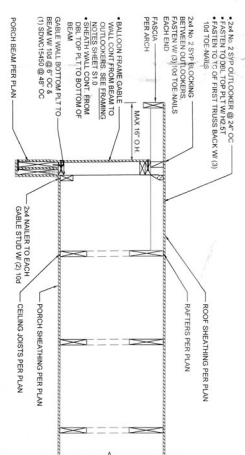


B11 CABLE FRAMING DETAIL OVER PORCH BEAM

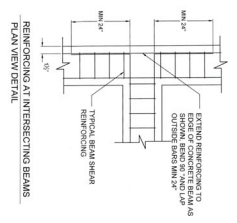

A9 CONCRETE BEAM INTERSECTION DETAIL

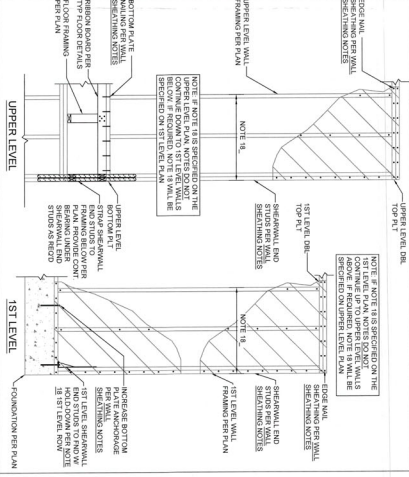

A10 TYPICAL SHEARWALL FRAMING ELEVATION

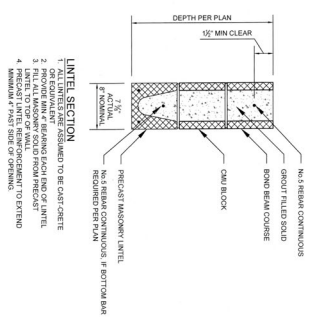

A11 PRE-CAST LINTIL



LITTLE RESIDENCE  
1001 LONGBOAT CLUB ROAD  
LONGBOAT KEY, FL 34228  
SARASOTA COUNTY

|                |             |
|----------------|-------------|
| PROJECT NUMBER | 23-0736     |
| SHEET NUMBER   | SD 3        |
| SHEET NAME     | DETAILS     |
| REVISIONS      |             |
| DATE           | DESCRIPTION |
| DESIGNED       | BDP         |
| REVIEWED       | AKR         |

**Russell Rowland**  
13241 BARTRAM PARK BLVD #601  
JACKSONVILLE, FL 32258  
P 904-503-3283 RUSSROW.COM  
C.A. No. 32756

**BRIDGEMAN ENGINEERING**  
Professional Engineer  
No. 91021  
State of Florida  
BRIDGEMAN ENGINEERING, P.C.  
FL LICENSE NO. 91021  
07-11-2023

RECEIVED  
MAY 13 2024  
TOWN OF JACKSONVILLE  
PLANNING DEPARTMENT  
100 N. GULF BLVD., SUITE 200  
JACKSONVILLE, FL 32202  
PROJECT: 23-0736  
SHEET: SD 3